



SCALE: HOR. 1"=40'
VERT. 1"=4'

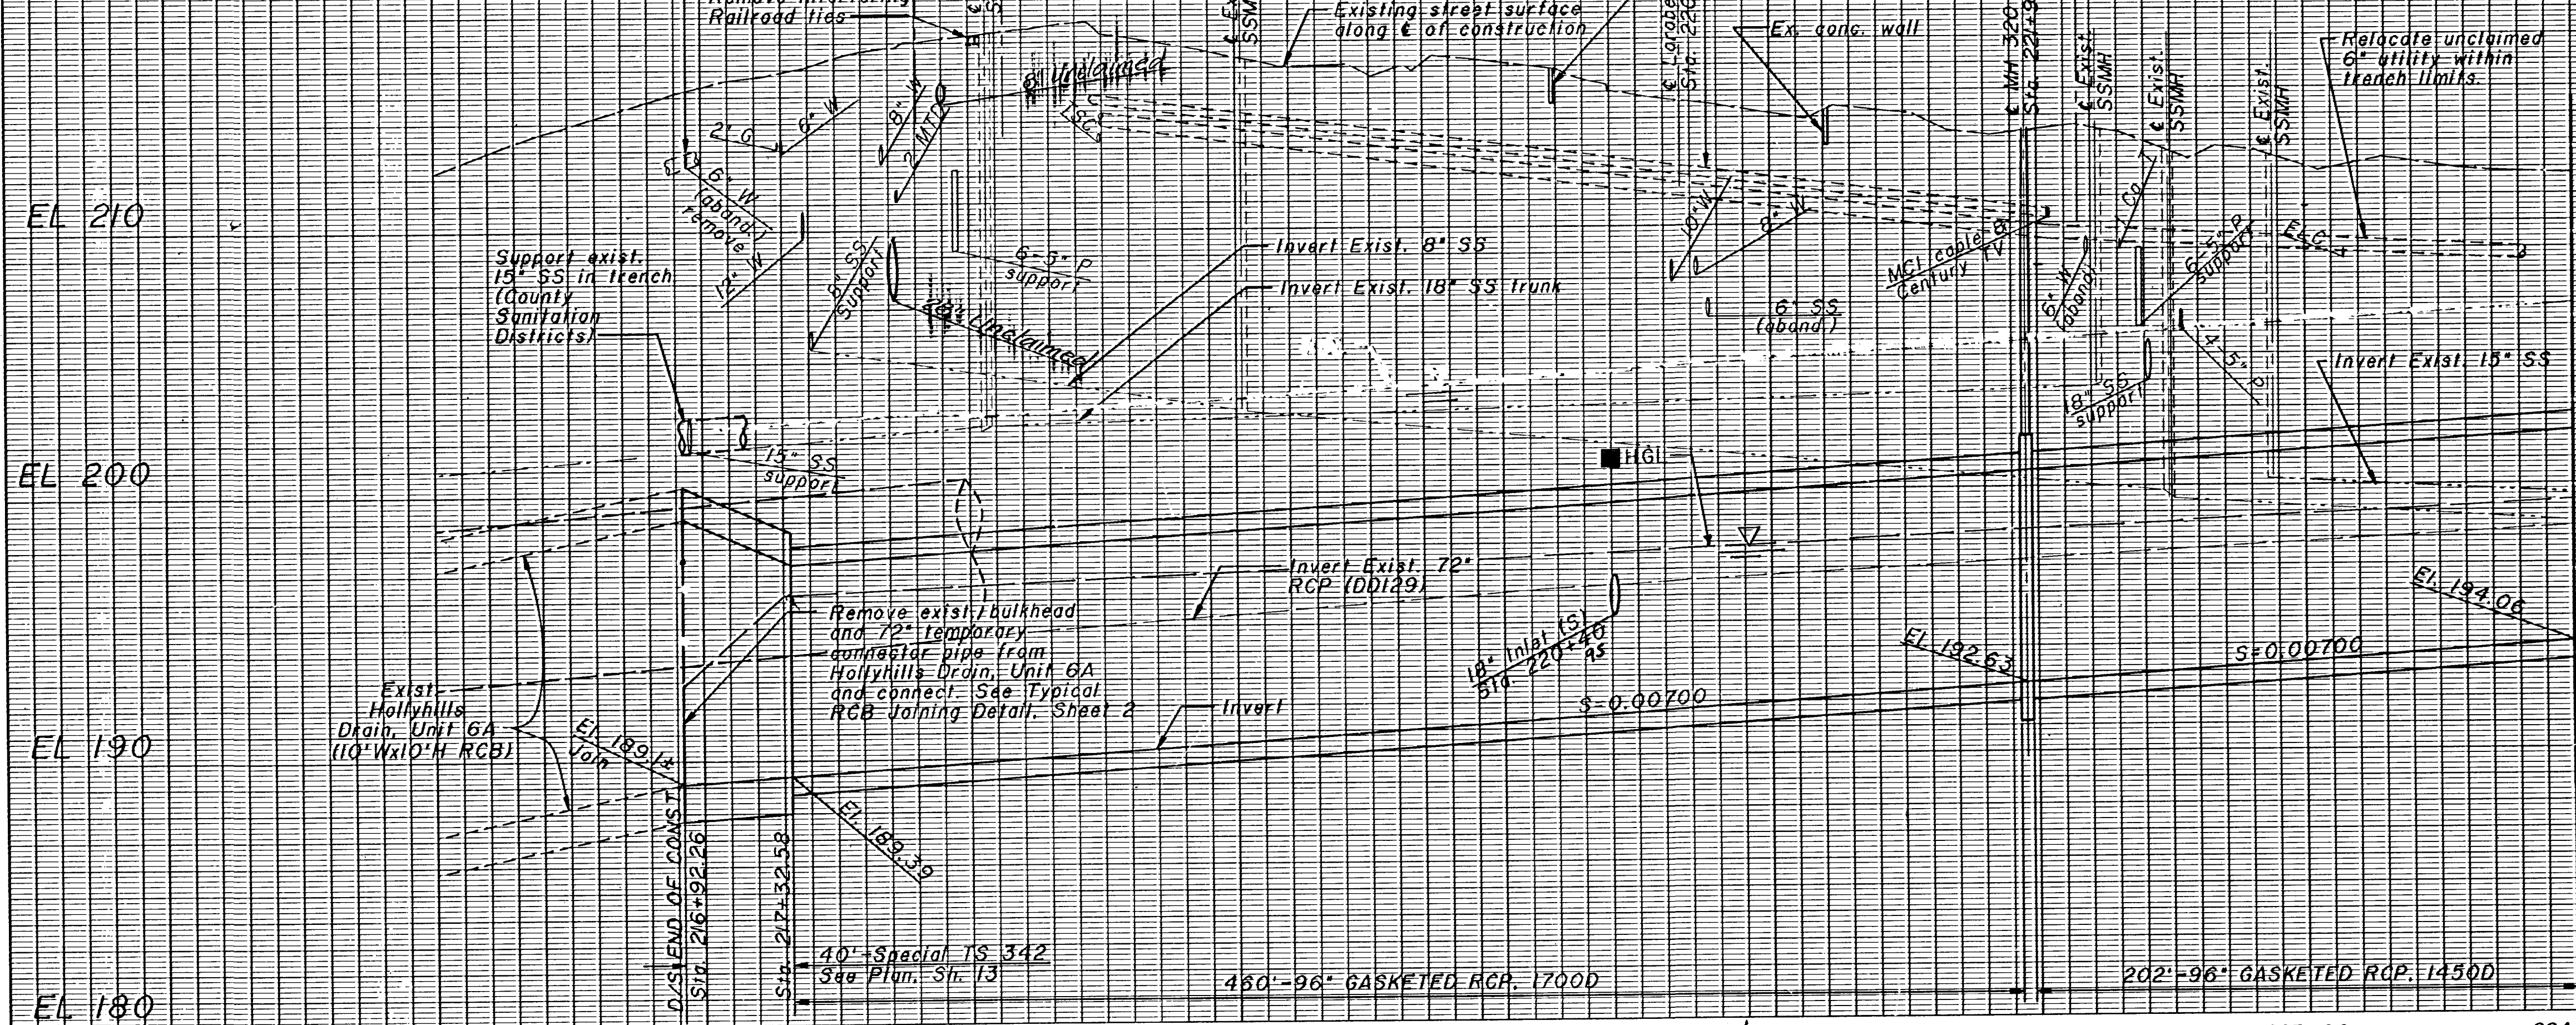

MATCH LINE STA. 224+00 SEE SH. 4

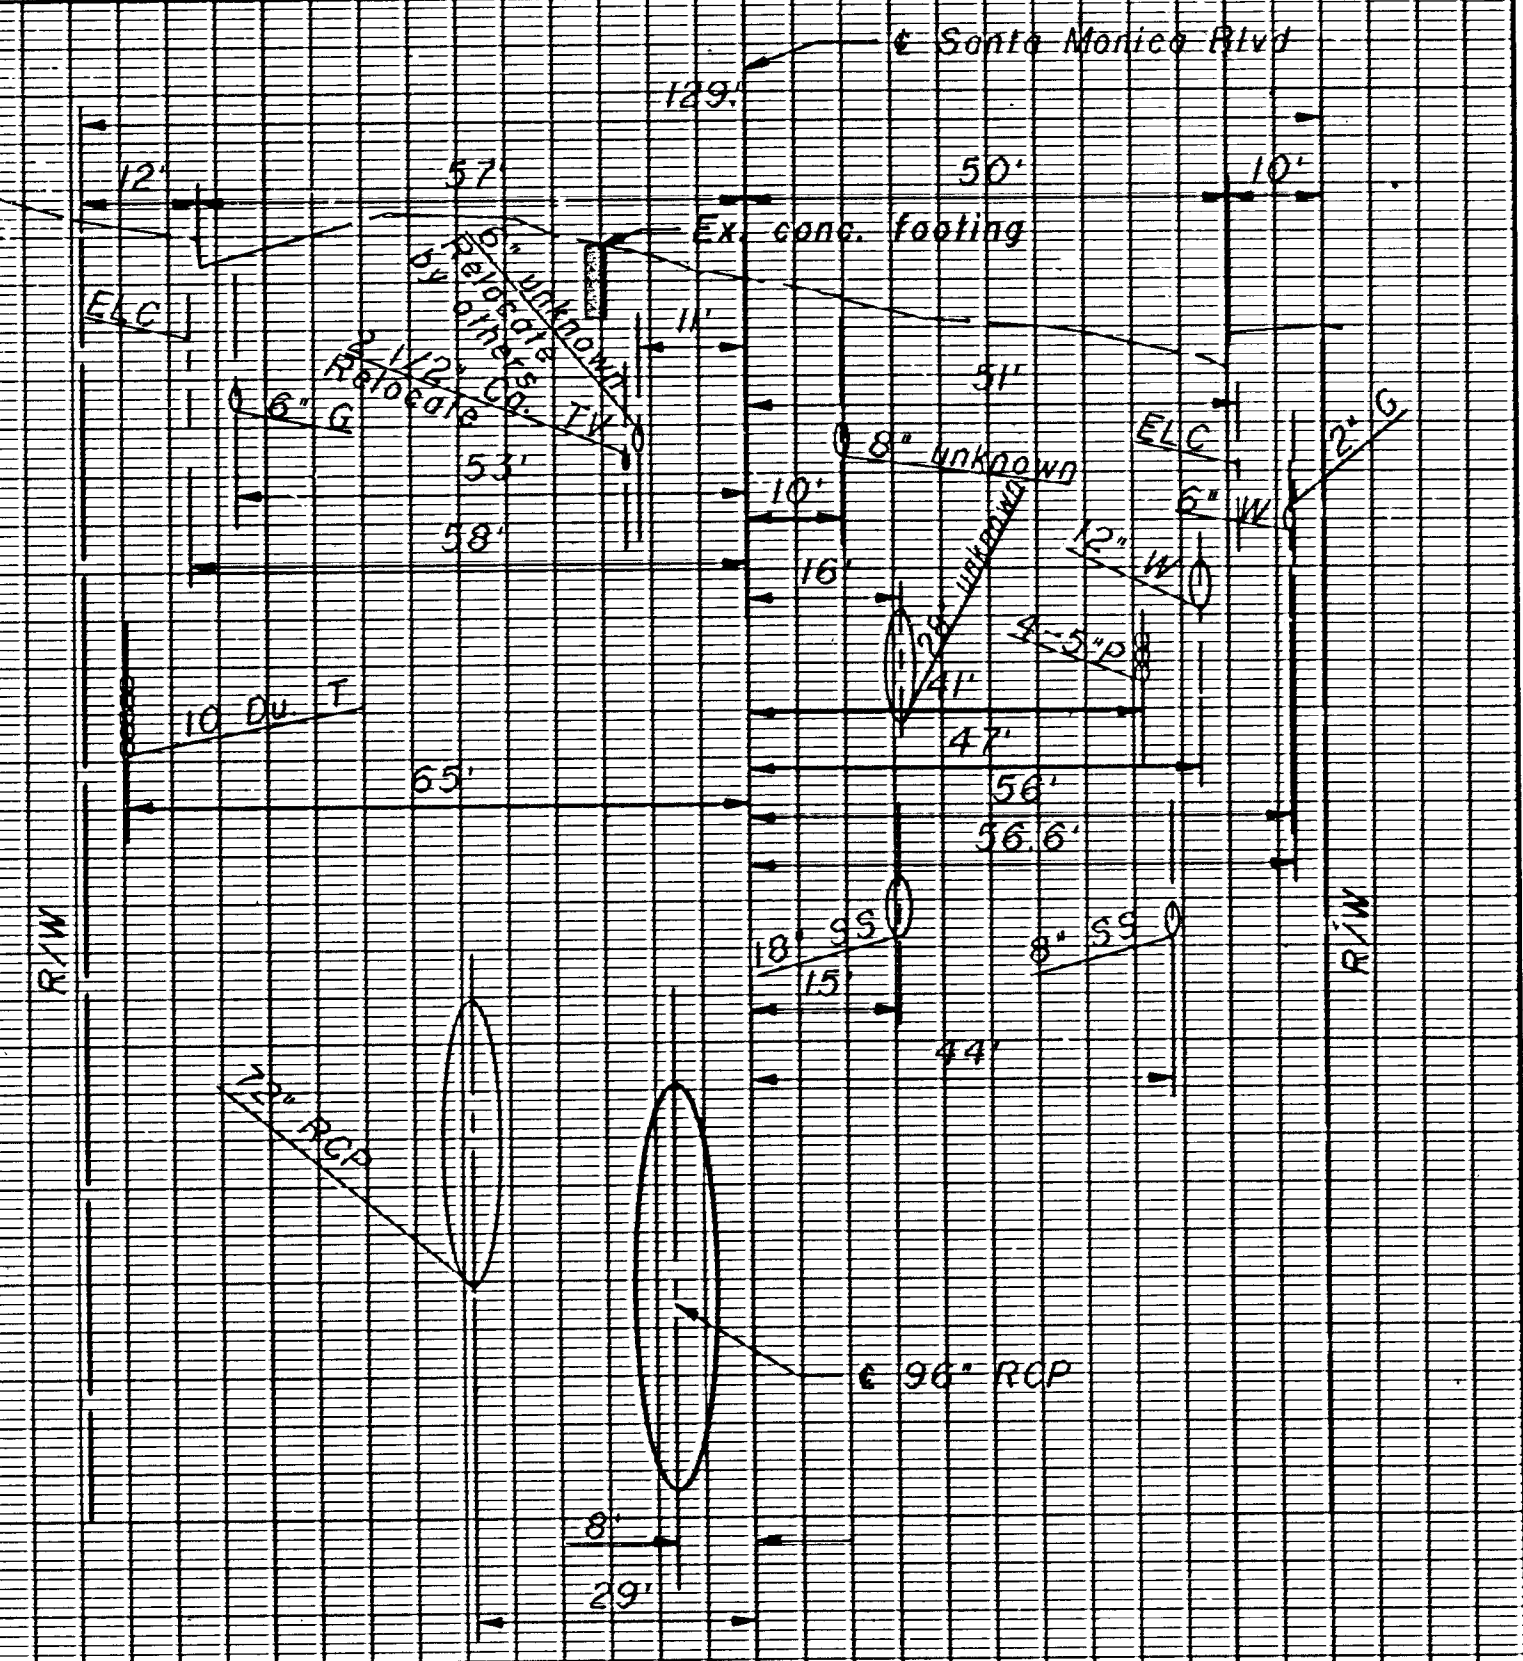

CROSS SECTION
STA. 219+00
SCALE: HOR. 1"=20'
VERT. 1"=4'

BENCH MARKS


BM - 54 Elev. 219.476
CHIS SQ IN CB RET 2FT S/O BCR @
NE COR SANTA MONICA BLVD & SAN
VICENTE BLVD
PWL 1417 PGS. 1703-1704

NOTES

- The irrigation facilities located in the center median on Santa Monica Blvd. from Sta. 218+25 to Sta. 227+70 shall be removed within trench limits and the remaining system shall be capped and abandoned in place.
- Refer to City of West Hollywood Street Improvement Plans in Santa Monica Boulevard for the locations of the proposed curb, gutter, median, sidewalk and any other street improvements.

Construction Curve Data
 $\Delta_9 = 49^\circ 23' 21''$
 $R = 60'$
 $T = 27.59'$
 $L = 51.72'$
 $BC = \text{Sta. } 217+32.58$
 $EC = \text{Sta. } 217+84.30$
 $PI_9 = N 28.047.696$
 $E 17.628.508$

Construction Curve Data
 $\Delta_{10} = 27^\circ 24' 48''$
 $R = 90'$
 $T = 21.95'$
 $L = 43.06'$
 $BC = \text{Sta. } 218+07.71$
 $EC = \text{Sta. } 218+50.77$
 $PI_{10} = N 28.114.839$
 $E 17.657.066$

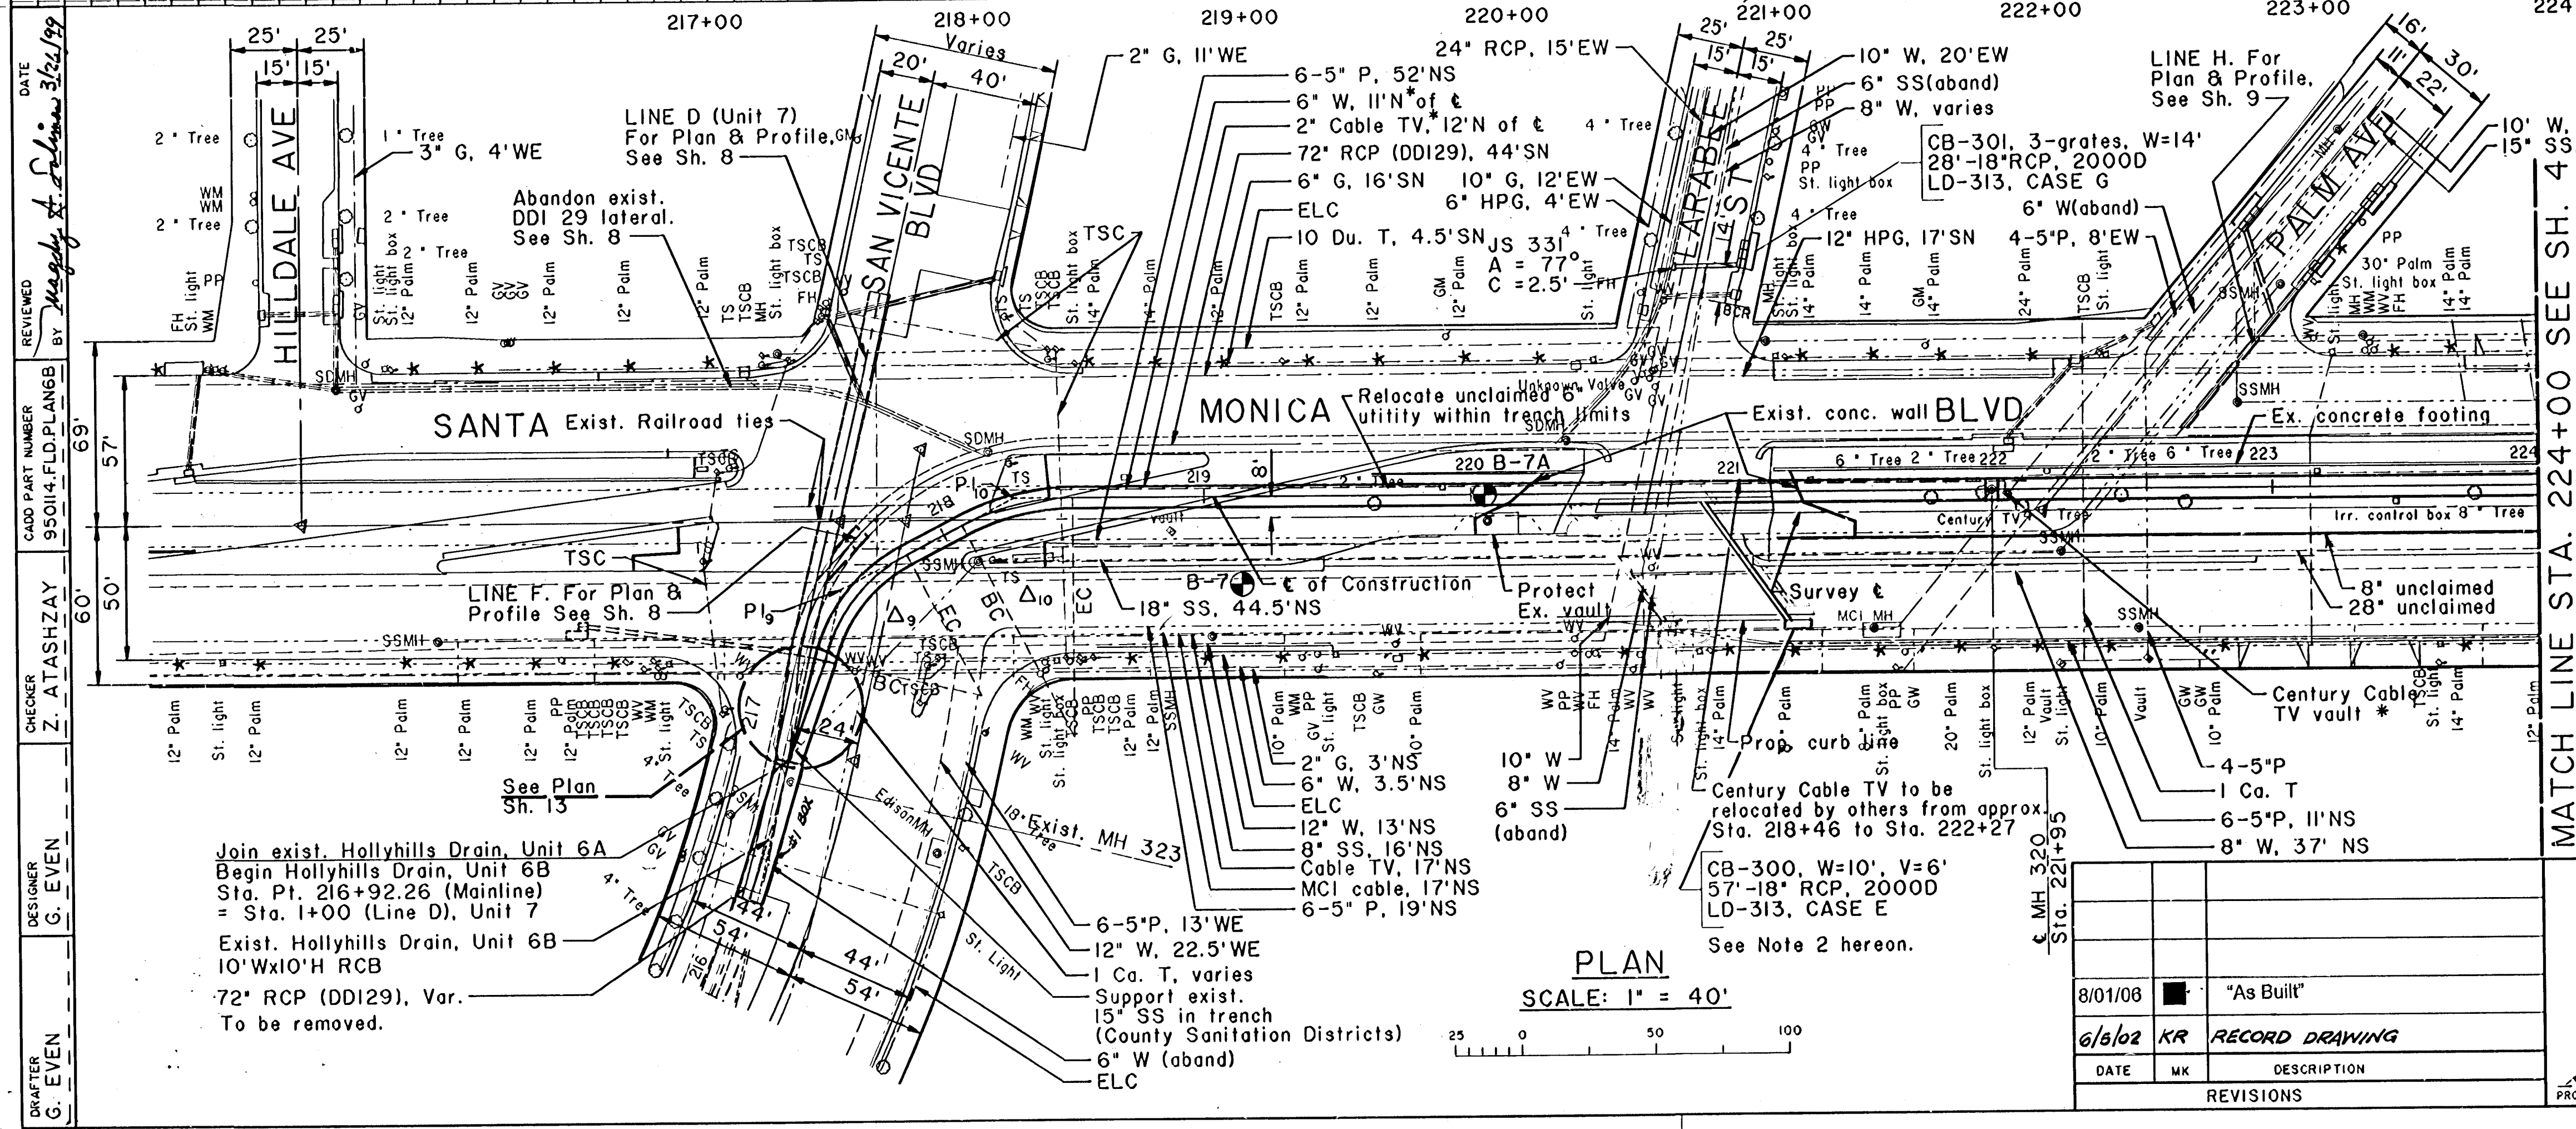


MATCH LINE STA. 224+00 SEE SH. 4

PLAN
SCALE: 1" = 40'



8/01/08	As Built
6/8/02	KR RECORD DRAWING
DATE	REVISIONS

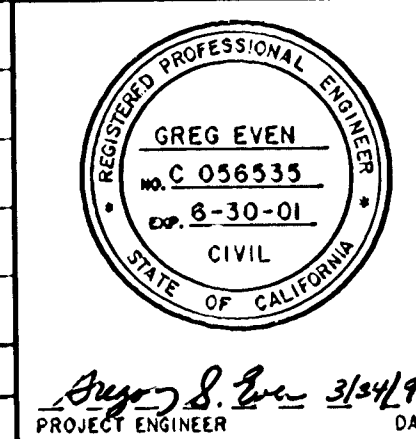

COUNTY OF LOS ANGELES DEPARTMENT OF PUBLIC WORKS

HOLLYHILLS DRAIN UNIT 6B
REINFORCED CONCRETE CONDUIT

PLAN AND PROFILE
STA. 216+92.26 TO 224+00

JOB X5009109 DWG 992-011.3 SHEET 3 OF 16

175 OF 201