





SCALES:  
 HOR. 1"=20'  
 VERT. 1"=4'

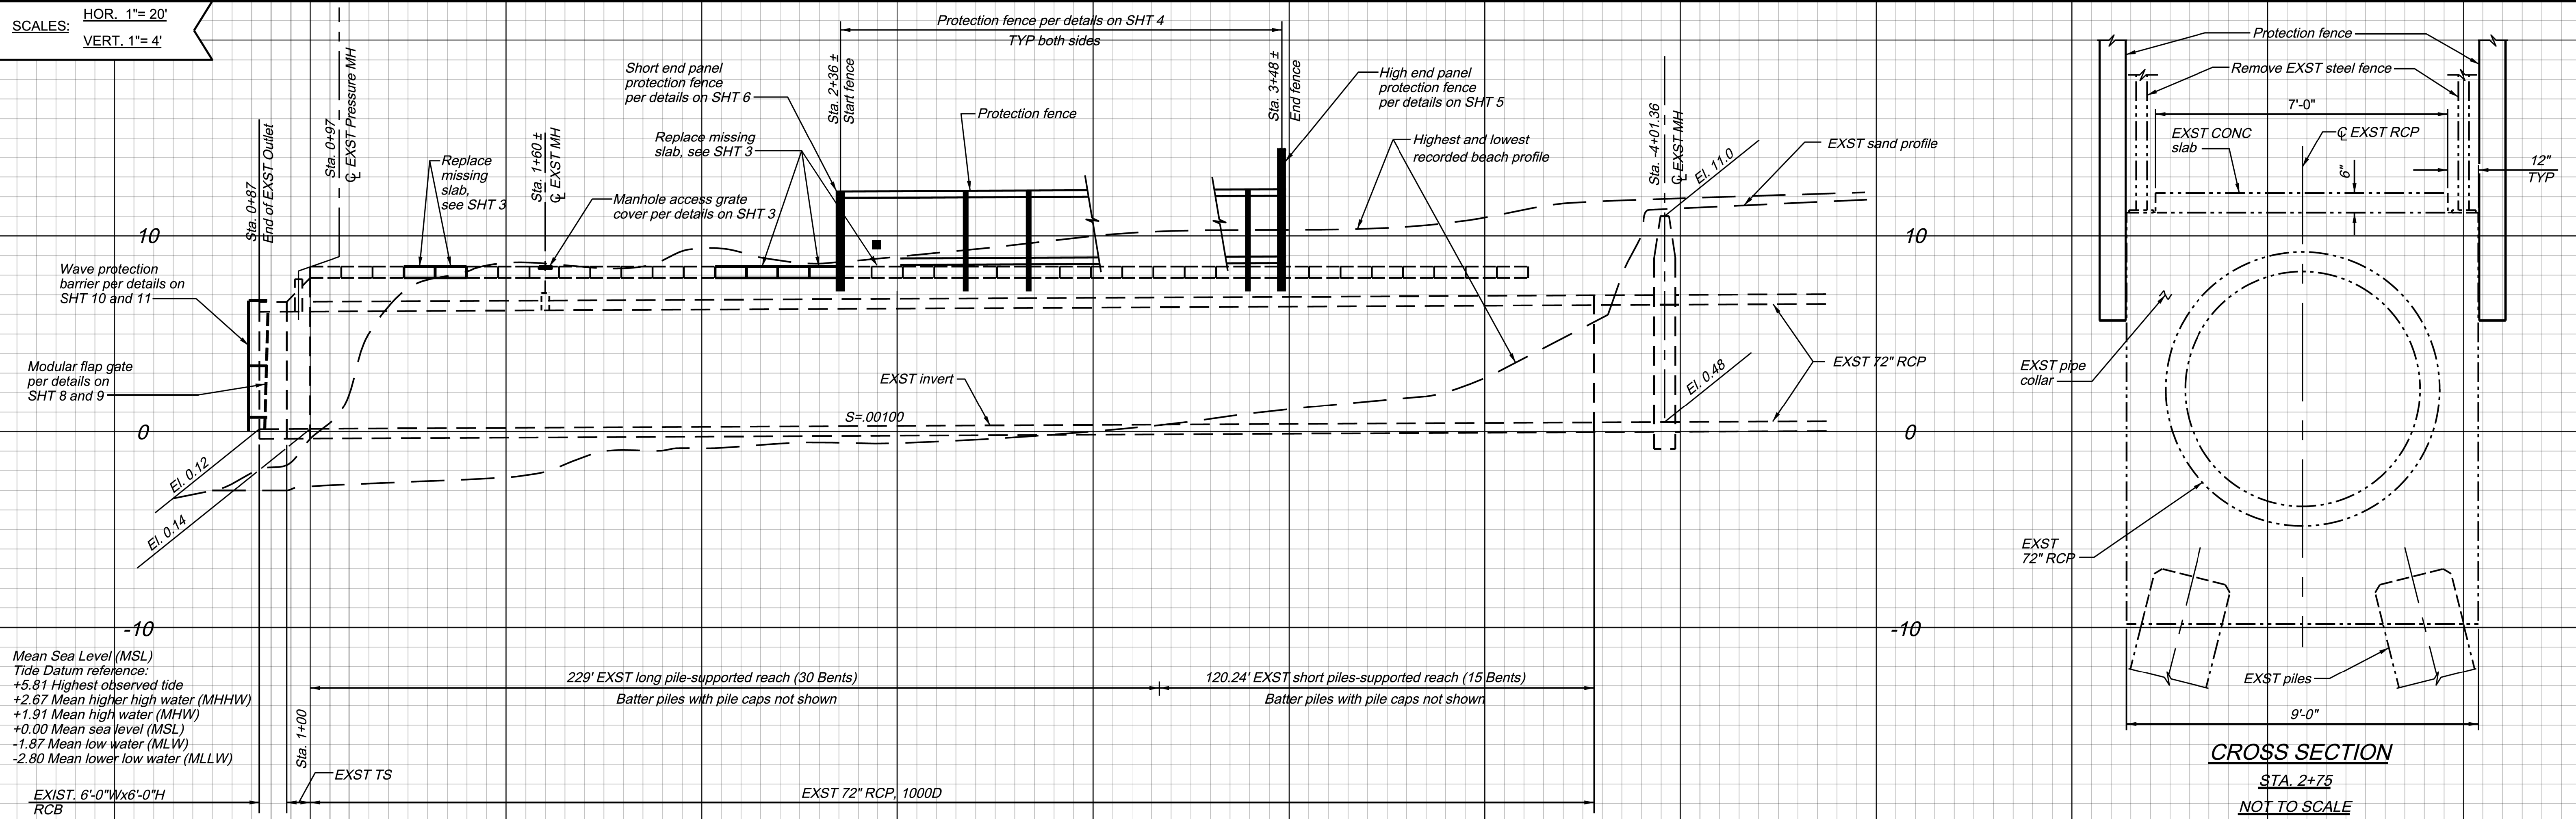

**CROSS SECTION**  
 STA. 2+75  
 NOT TO SCALE

**PROFILE NOTES:**  
 1. Elevations shown are in feet above Mean Sea Level (MSL) based on the National Tidal Datum Epoch of 1960-1978.  
 2. Tide datum references based on recorded observations from National Oceanic and Atmospheric Administration (NOAA) Santa Monica Station (Station No. 9410840)

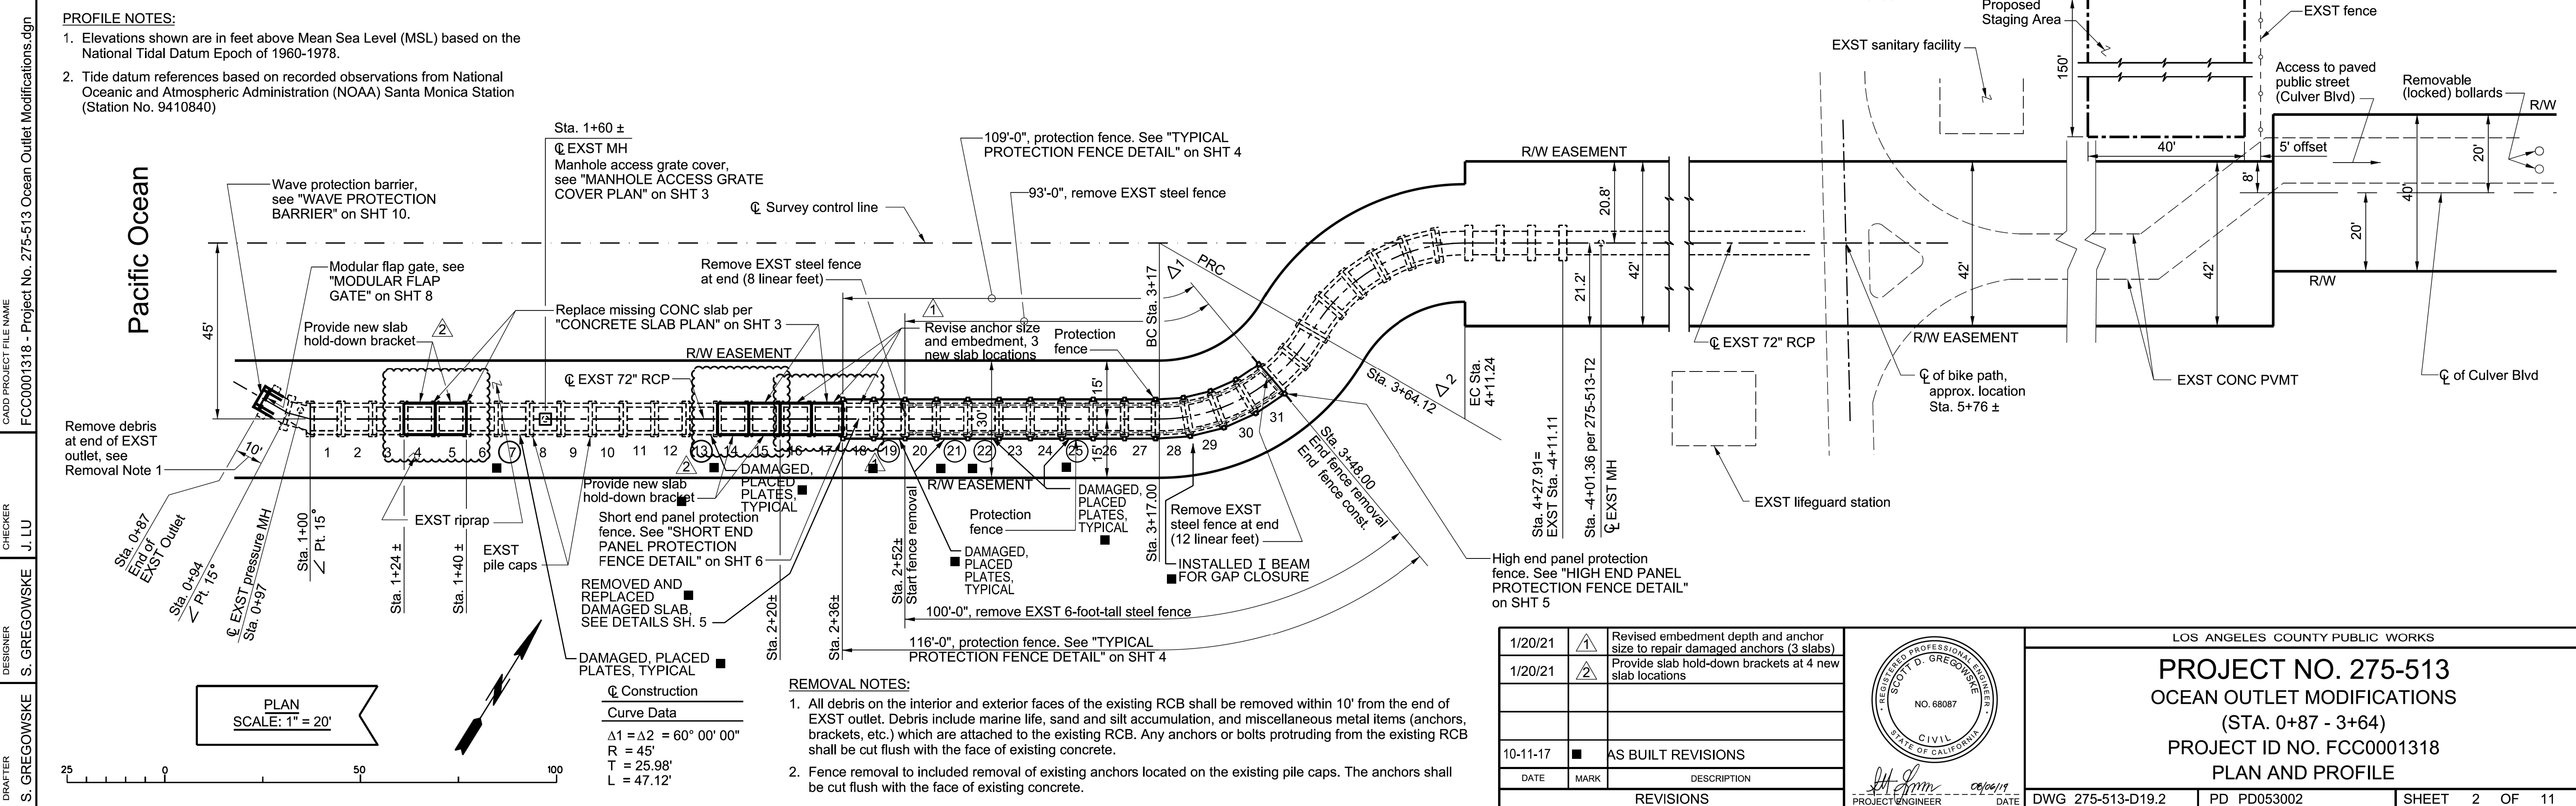


**PLAN**  
 SCALE: 1"=20'

REMOVAL NOTES:

- All debris on the interior and exterior faces of the existing RCB shall be removed within 10' from the end of EXST outlet. Debris include marine life, sand and silt accumulation, and miscellaneous metal items (anchors, brackets, etc.) which are attached to the existing RCB. Any anchors or bolts protruding from the existing RCB shall be cut flush with the face of existing concrete.
- Fence removal to included removal of existing anchors located on the existing pile caps. The anchors shall be cut flush with the face of existing concrete.

DATE	MARK	DESCRIPTION
1/20/21	A	Revised embedment depth and anchor size to repair damaged anchors (3 slabs)
1/20/21	B	Provide slab hold-down brackets at 4 new slab locations
10-11-17	■	AS BUILT REVISIONS

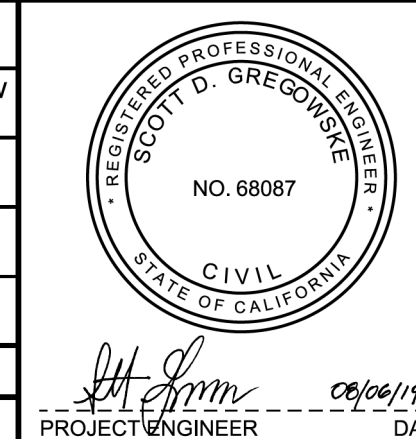


LOS ANGELES COUNTY PUBLIC WORKS

**PROJECT NO. 275-513**  
 OCEAN OUTLET MODIFICATIONS  
 (STA. 0+87 - 3+64)  
 PROJECT ID NO. FCC0001318  
 PLAN AND PROFILE


DWG 275-513-D19.2 | PD PD053002 | SHEET 2 OF 11

CAD PROJECT FILE NAME: FCC0001318 - Project No. 275-513 Ocean Outlet Modifications.dgn  
 CHECKER: J. LU  
 DESIGNER: S. GREGOWSKIE  
 DRAFTER: S. GREGOWSKIE


CAD PROJECT FILE NAME: FCC0001318 - Project No. 275-513 Ocean Outlet Modifications.dgn  
 CHECKER: J. LU  
 DESIGNER: S. GREGOWSKIE  
 DRAFTER: S. GREGOWSKIE

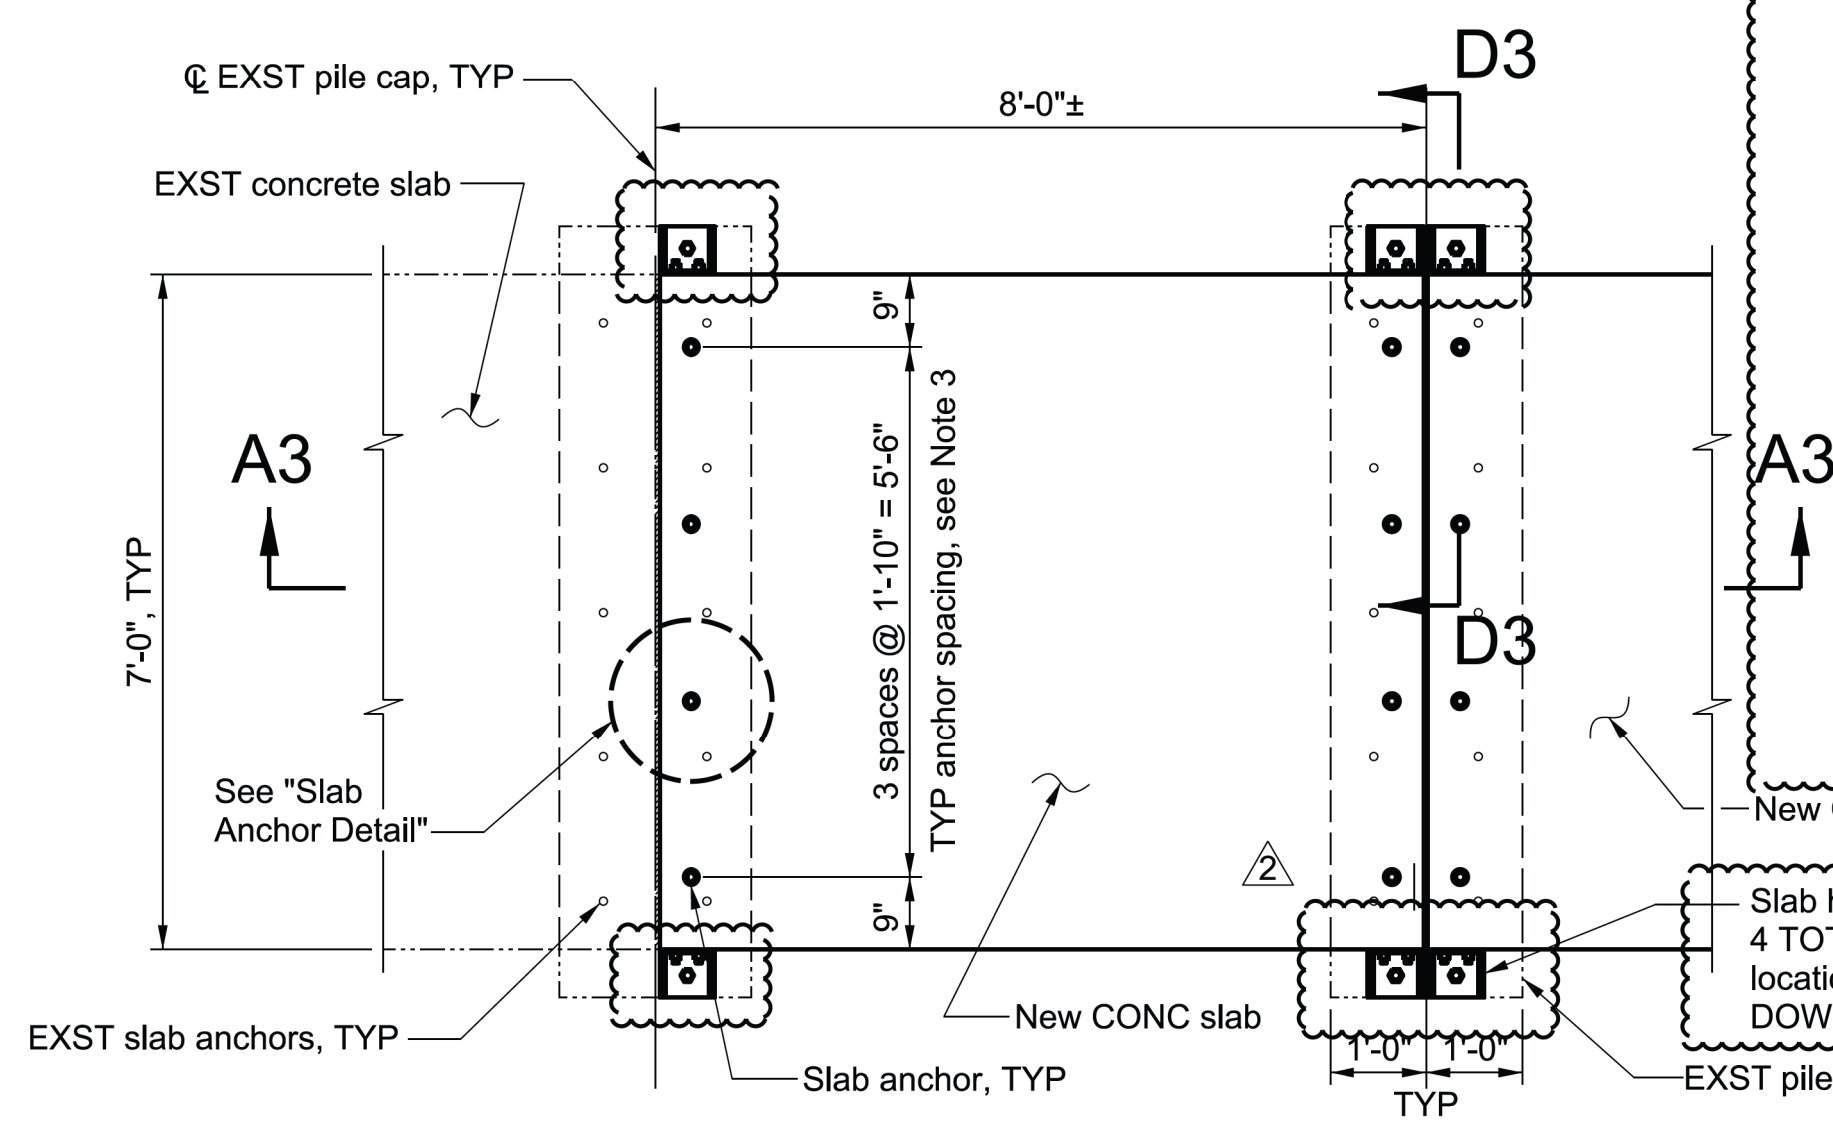


**CONCRETE SLAB PLAN (SHT 2)**  
SCALE: 1/2"=1'-0"

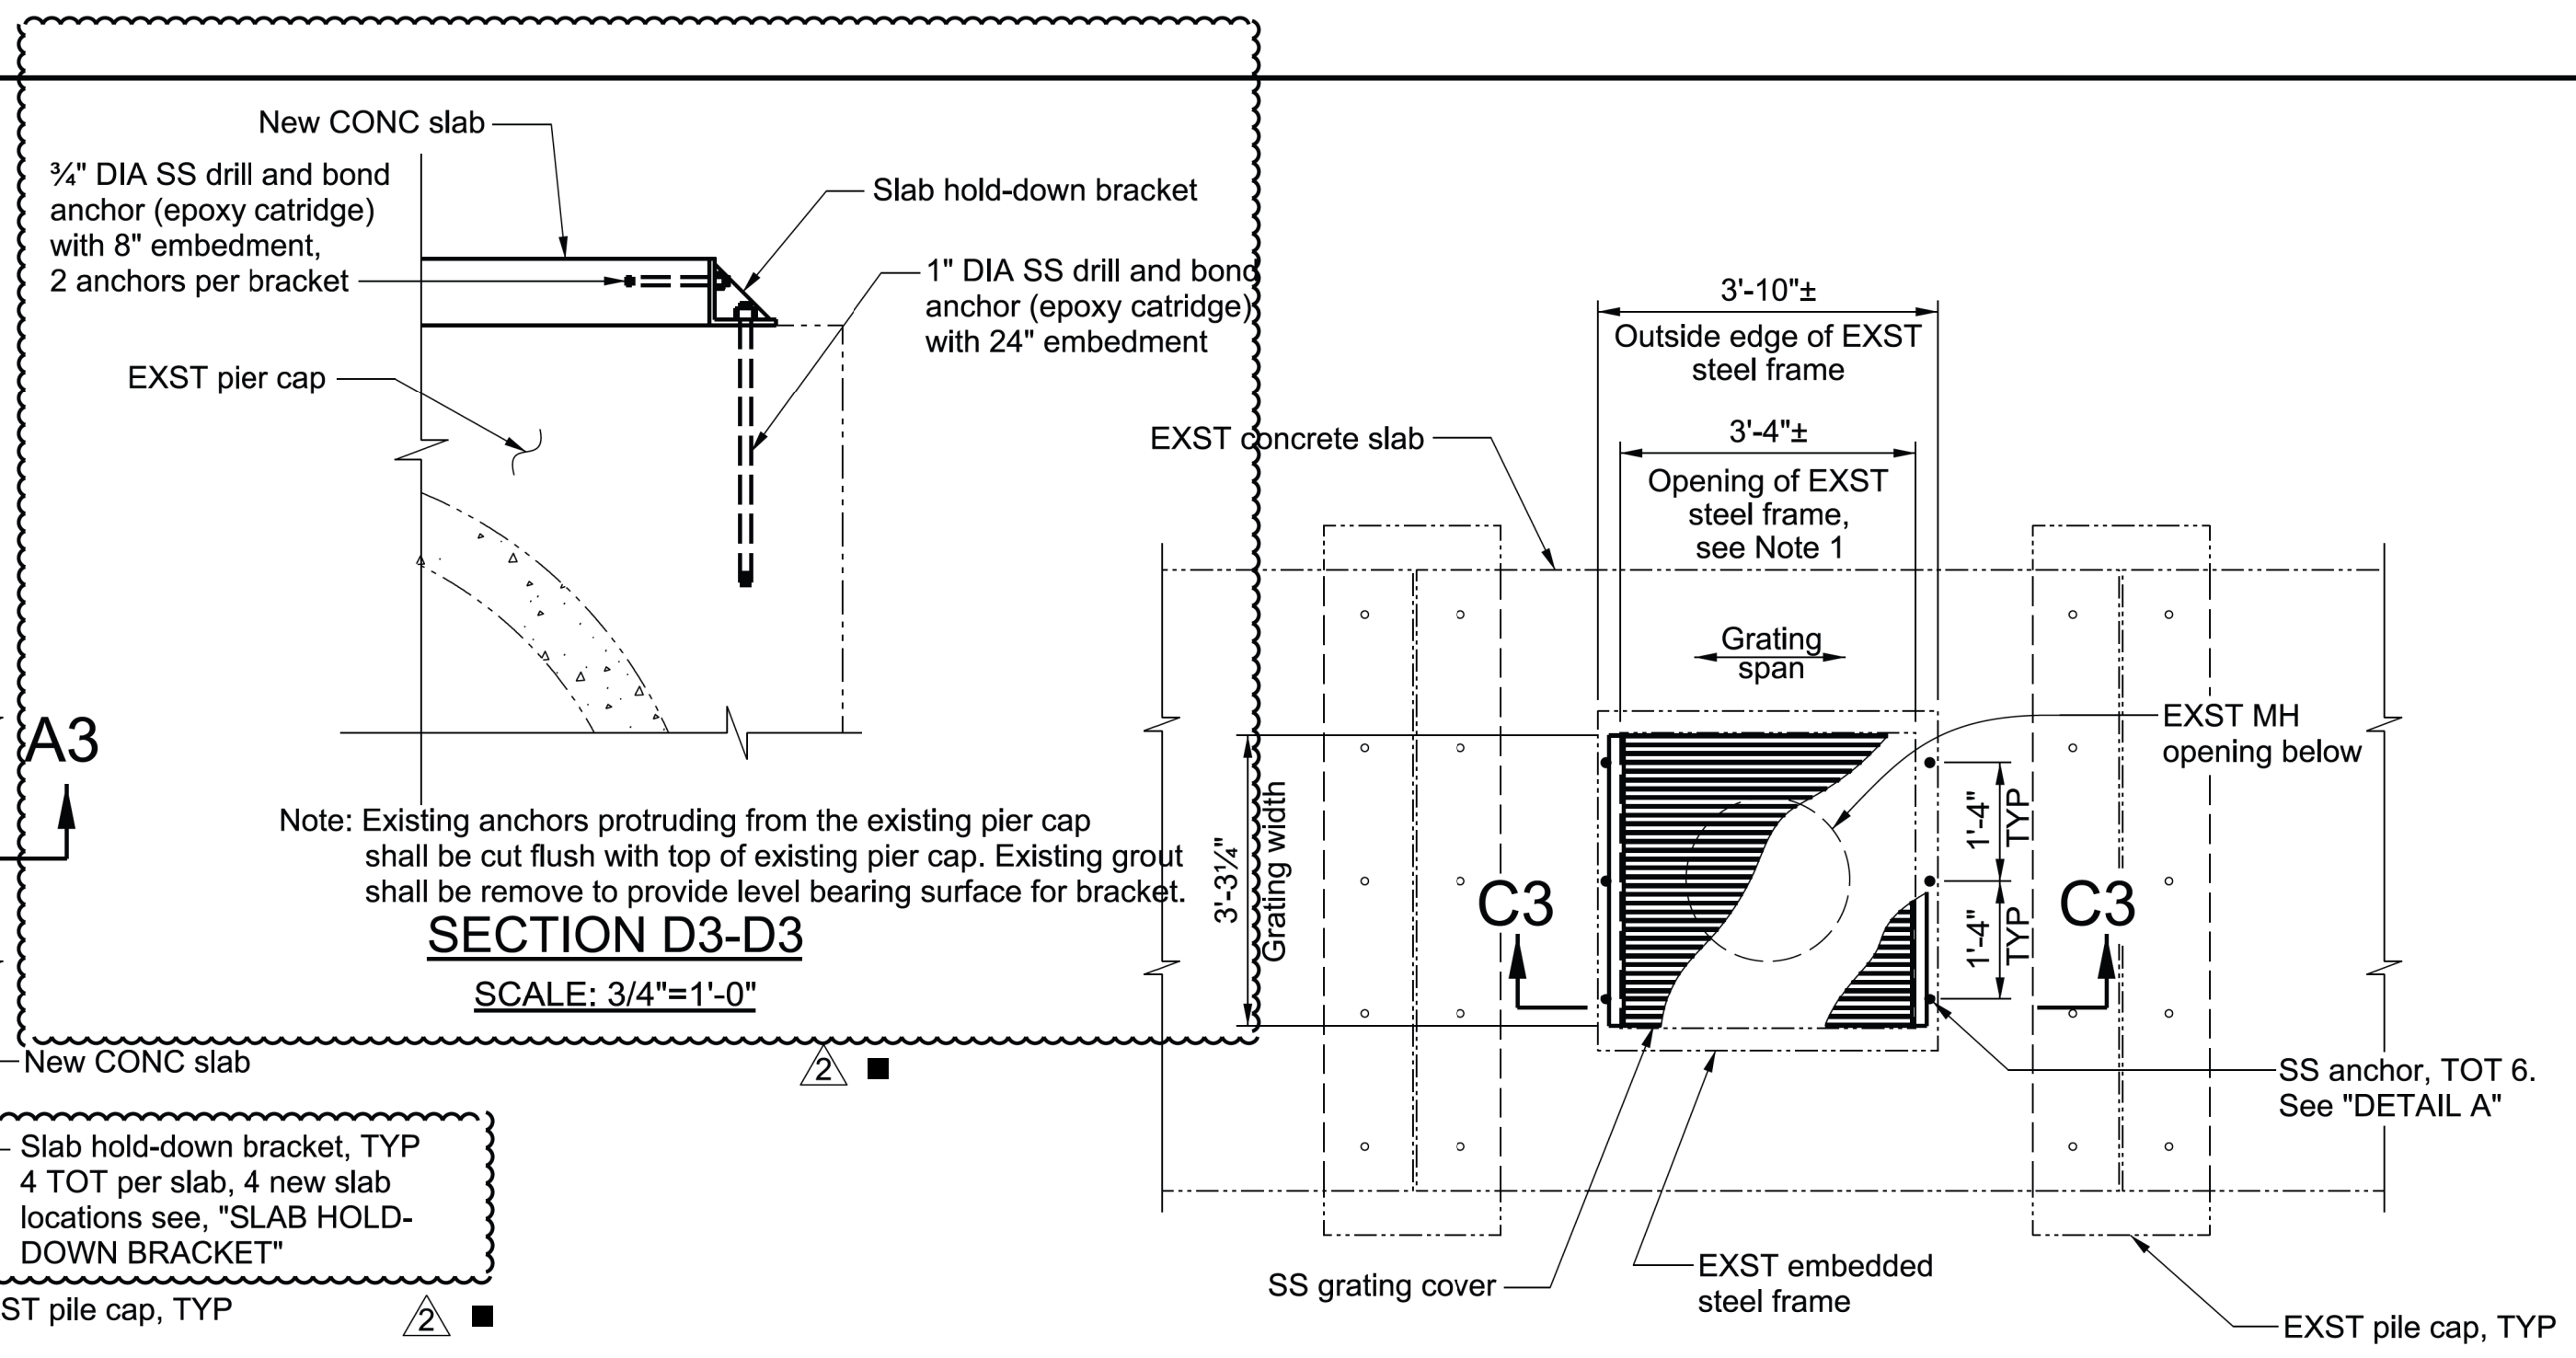


**MANHOLE ACCESS GRATE COVER PLAN (SHT 2)**  
SCALE: 1/2"=1'-0"

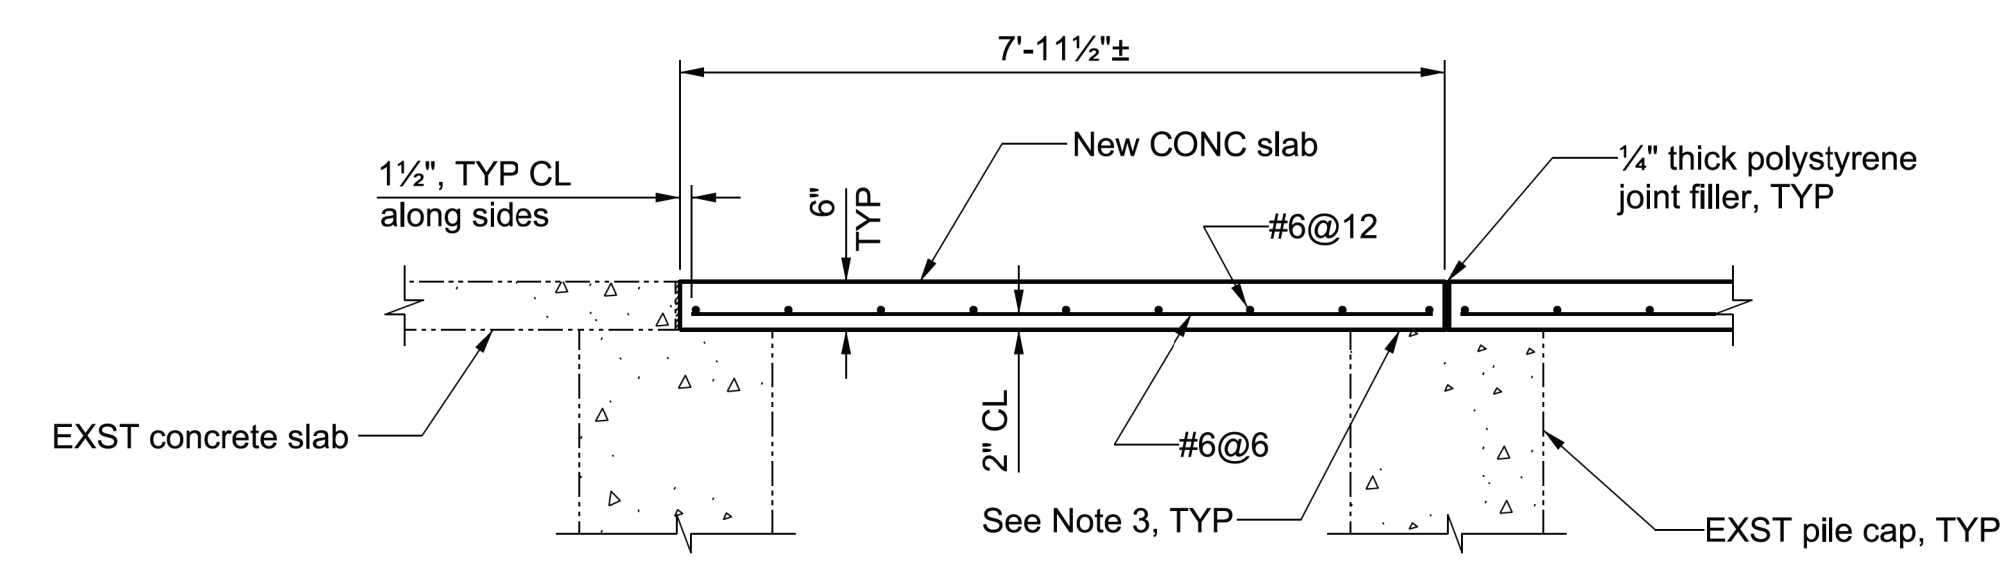


**SECTION A3-A3**  
SCALE: 1/2"=1'-0"

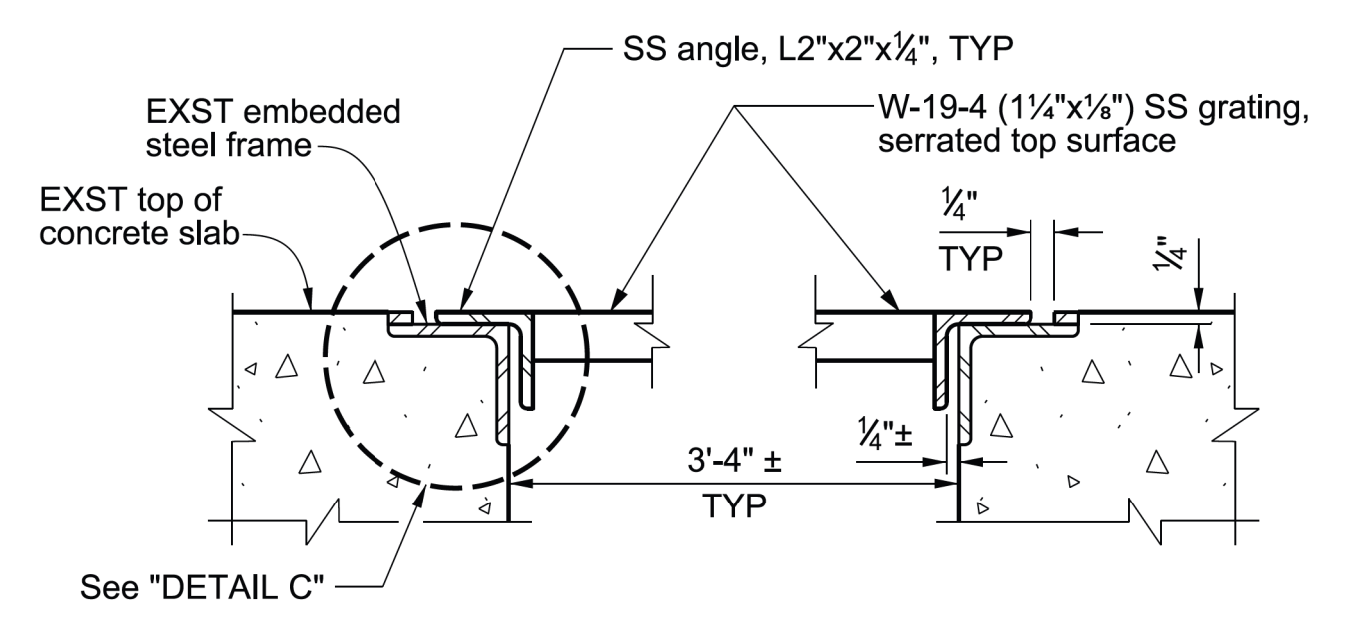


**SECTION C3-C3**  
NOT TO SCALE

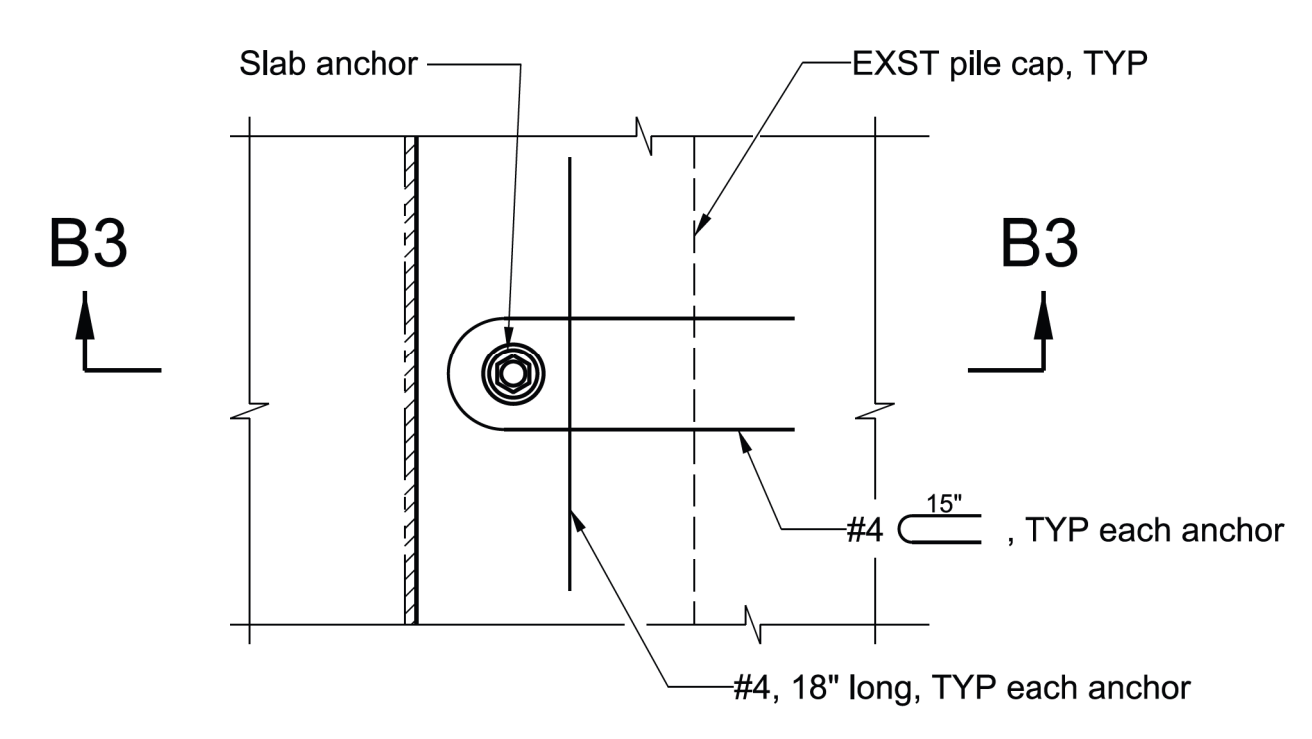


**SLAB ANCHOR DETAIL**  
NOT TO SCALE

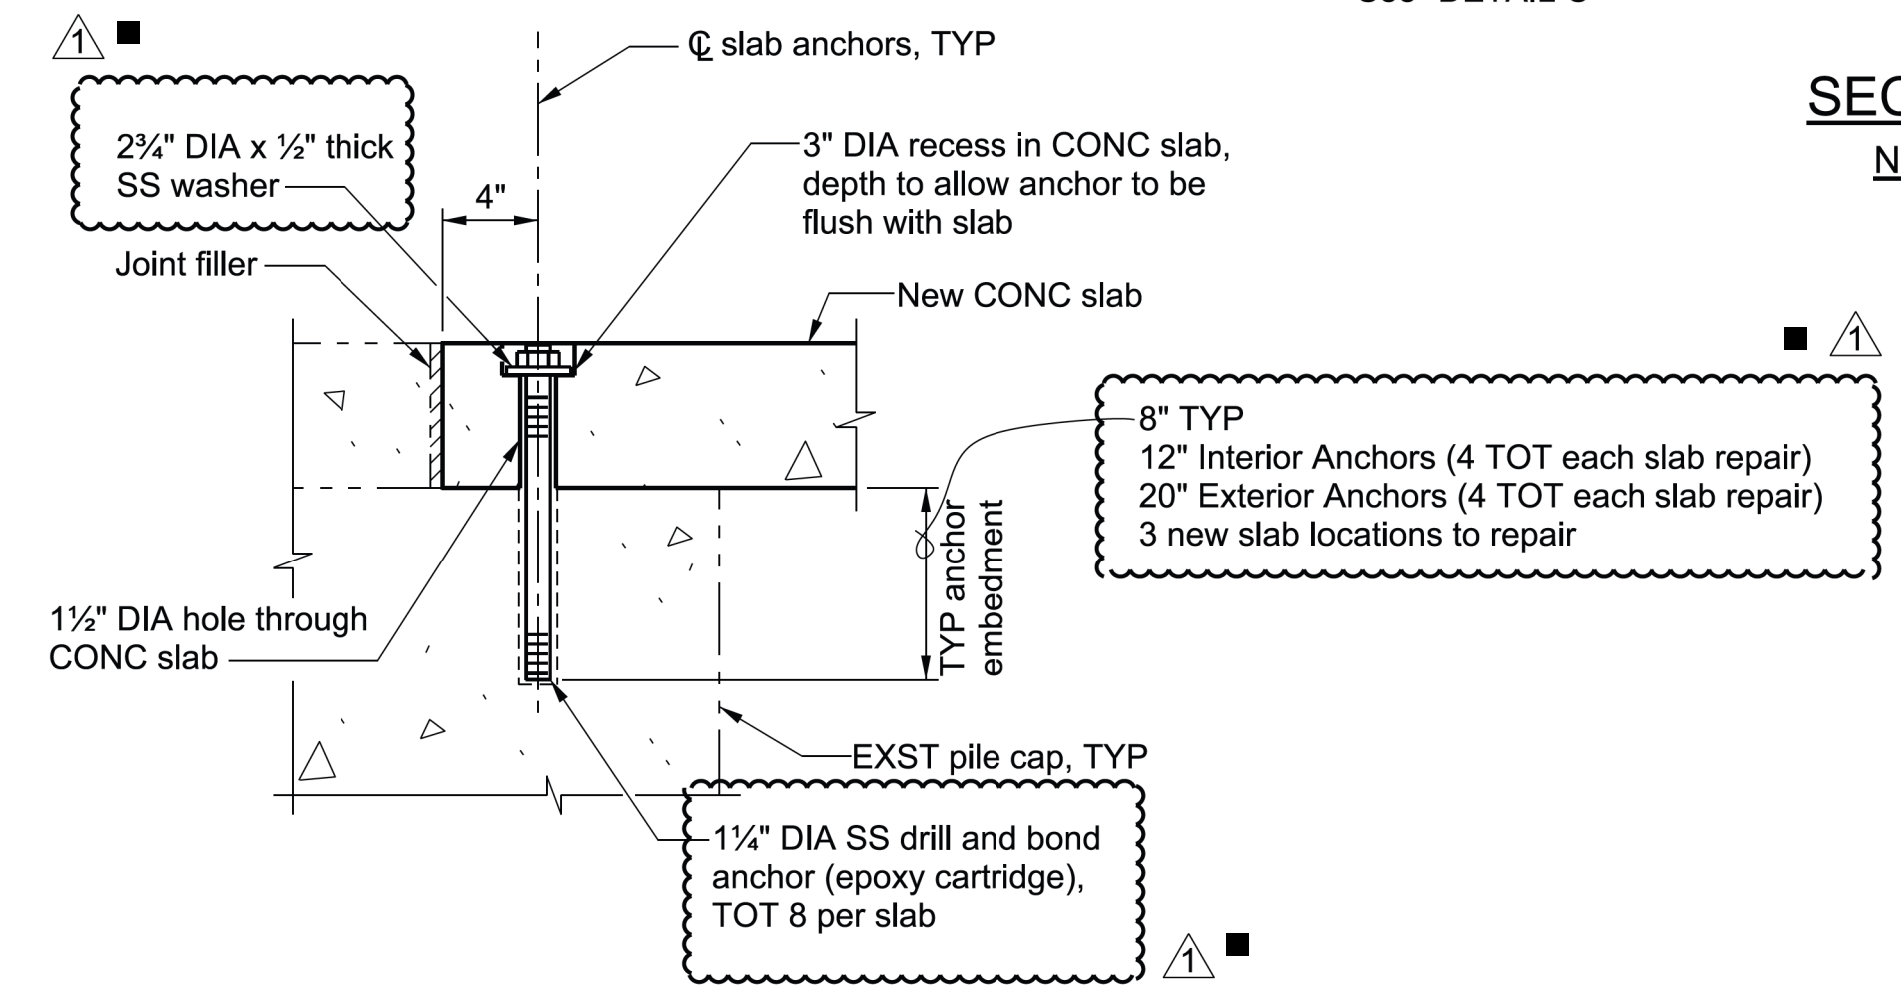


**SECTION B3-B3**  
NOT TO SCALE

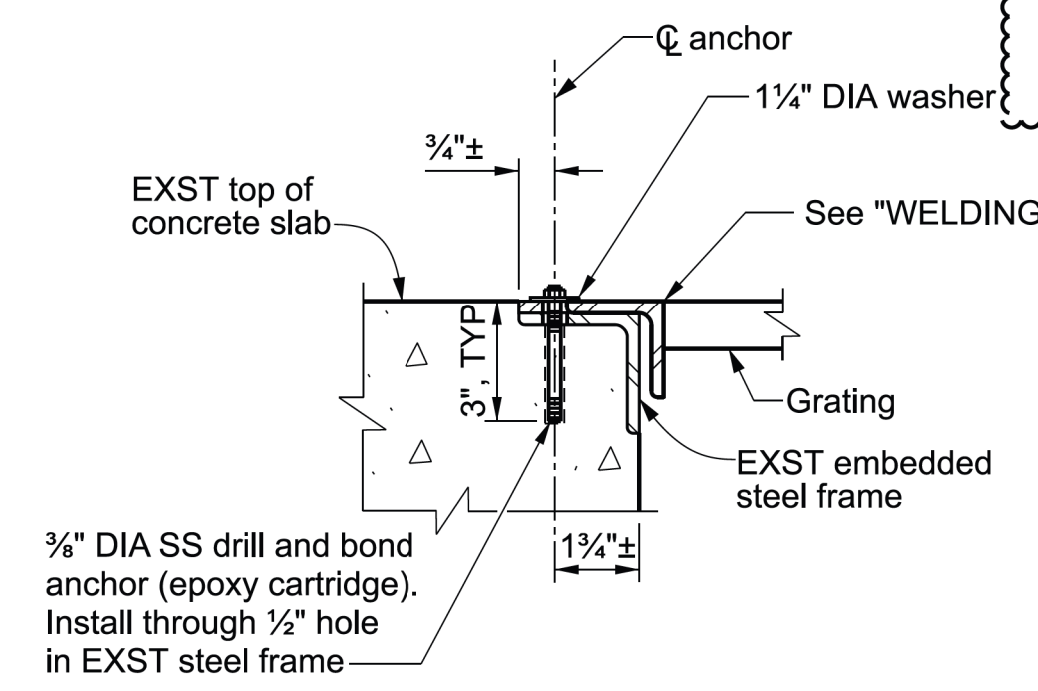

**DETAIL C**  
NOT TO SCALE

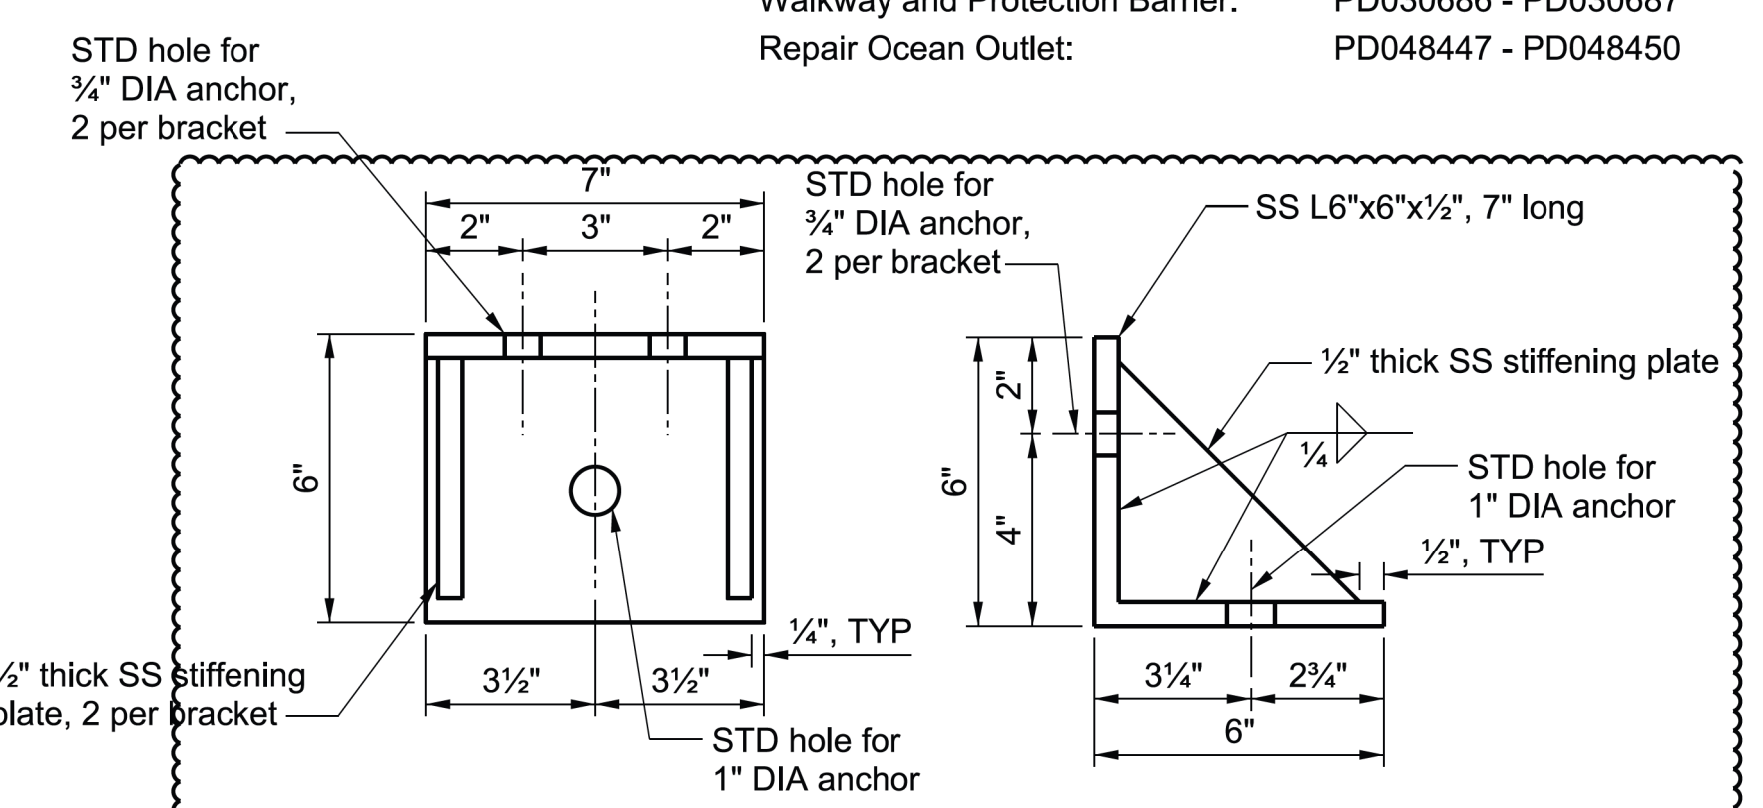

**SLAB HOLD-DOWN BRACKET**  
SCALE: 3"=1'-0"

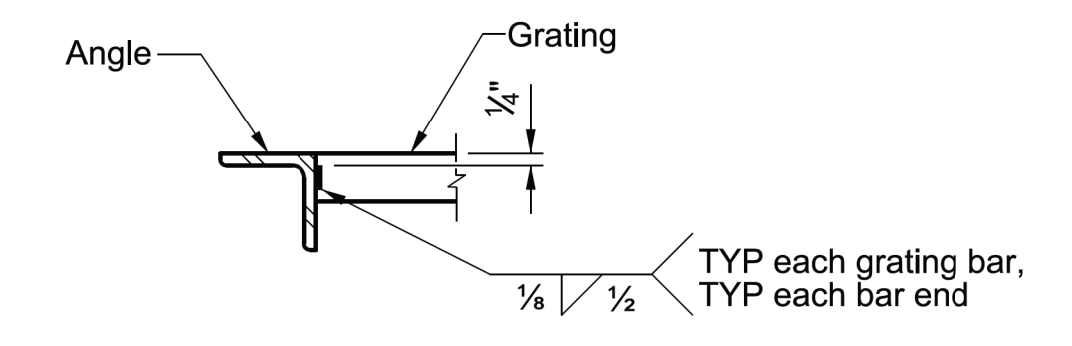

**GRATE WELDING DETAIL**  
NOT TO SCALE

**GENERAL NOTES**


- DESIGN:** American Society of Civil Engineers (ASCE) 7-16: Minimum Design Loads and Associated Criteria for Buildings and Other Structures.  
 American Concrete Institute: Building Code Requirements For Structural Concrete (ACI 318-14) and Commentaries (ACI 318R-14)  
 American Institute of Steel Construction (AISC): Steel Design Guide 27 - Structural Stainless Steel
- DESIGN STRESSES:** Concrete:  $f_c = 5,000$  psi  
 Stainless Steel Reinforcing (A955):  $f_y = 60,000$  psi  
 Structural Stainless Steel (Type 316L):  $f_y = 30,000$  psi  
 Structural Fiberglass Reinforced Plastic:  $f_b = 30,000$  psi  
 Welding Structural Stainless Steel per AWS D1.6-2017  
 Welding Structural Stainless Steel Electrodes -  $F_{EXX} = 70$  ksi minimum
- CONSTRUCTION:** Standard Specifications for Public Works Construction (Greenbook), 2018 Edition.
- GENERAL:**
- All steel members shall be Type 316L stainless steel.
  - All anchors shall be Type 316 stainless steel threaded rods. Each anchor shall have a Type 316 stainless steel nut and washer.
  - All bolts shall be Type 316 stainless steel. Each bolt shall have a Type 316 stainless steel nut and washer.
  - Steel grating shall be stainless steel, Type 316 or 316L.

**REFERENCES**

AS-BUILT DRAWINGS:	Description	Drawing Numbers
	Reconstruction of Ocean Outlet:	PD030680 - PD030685
	Reconstruction of Pier Walkway and Protection Barrier:	PD030686 - PD030687
	Repair Ocean Outlet:	PD048447 - PD048450

- NOTES:**
- Contractor shall verify existing field dimensions of the existing steel frame at the manhole. Shop drawings based on verified field dimensions shall be submitted in accordance with 3-8.
  - Contractor shall measure existing anchor locations to verify existing anchors will not conflict with proposed anchor locations. Where existing anchors are located within a 3 inch radius of a proposed anchor, as measured from center of anchors, proposed anchor locations shall be shifted at the direction of the Engineer.
  - Apply 30 lb. felt paper at interface between top of EXST pile cap and bottom of new concrete slab.

DATE	MARK	DESCRIPTION
1/20/21		Revised embedment depth and anchor diameter to retrofit damaged anchors
1/20/21		Provide slab hold-down brackets at 4 new slab locations
02-16-22	■	AS BUILT REVISIONS
REVISIONS		

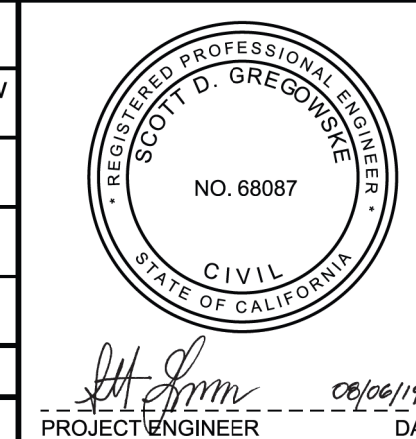


LOS ANGELES COUNTY PUBLIC WORKS

**PROJECT NO. 275-513**  
**OCEAN OUTLET MODIFICATIONS**  
 (STA. 0+87 - 3+64)  
 PROJECT ID NO. FCC0001318  
 CONCRETE SLAB AND ACCESS GRATE - DETAILS


DWG 275-513-D19.3 | PD PD053002 | SHEET 3 OF 11

**AS BUILT DRAWINGS**

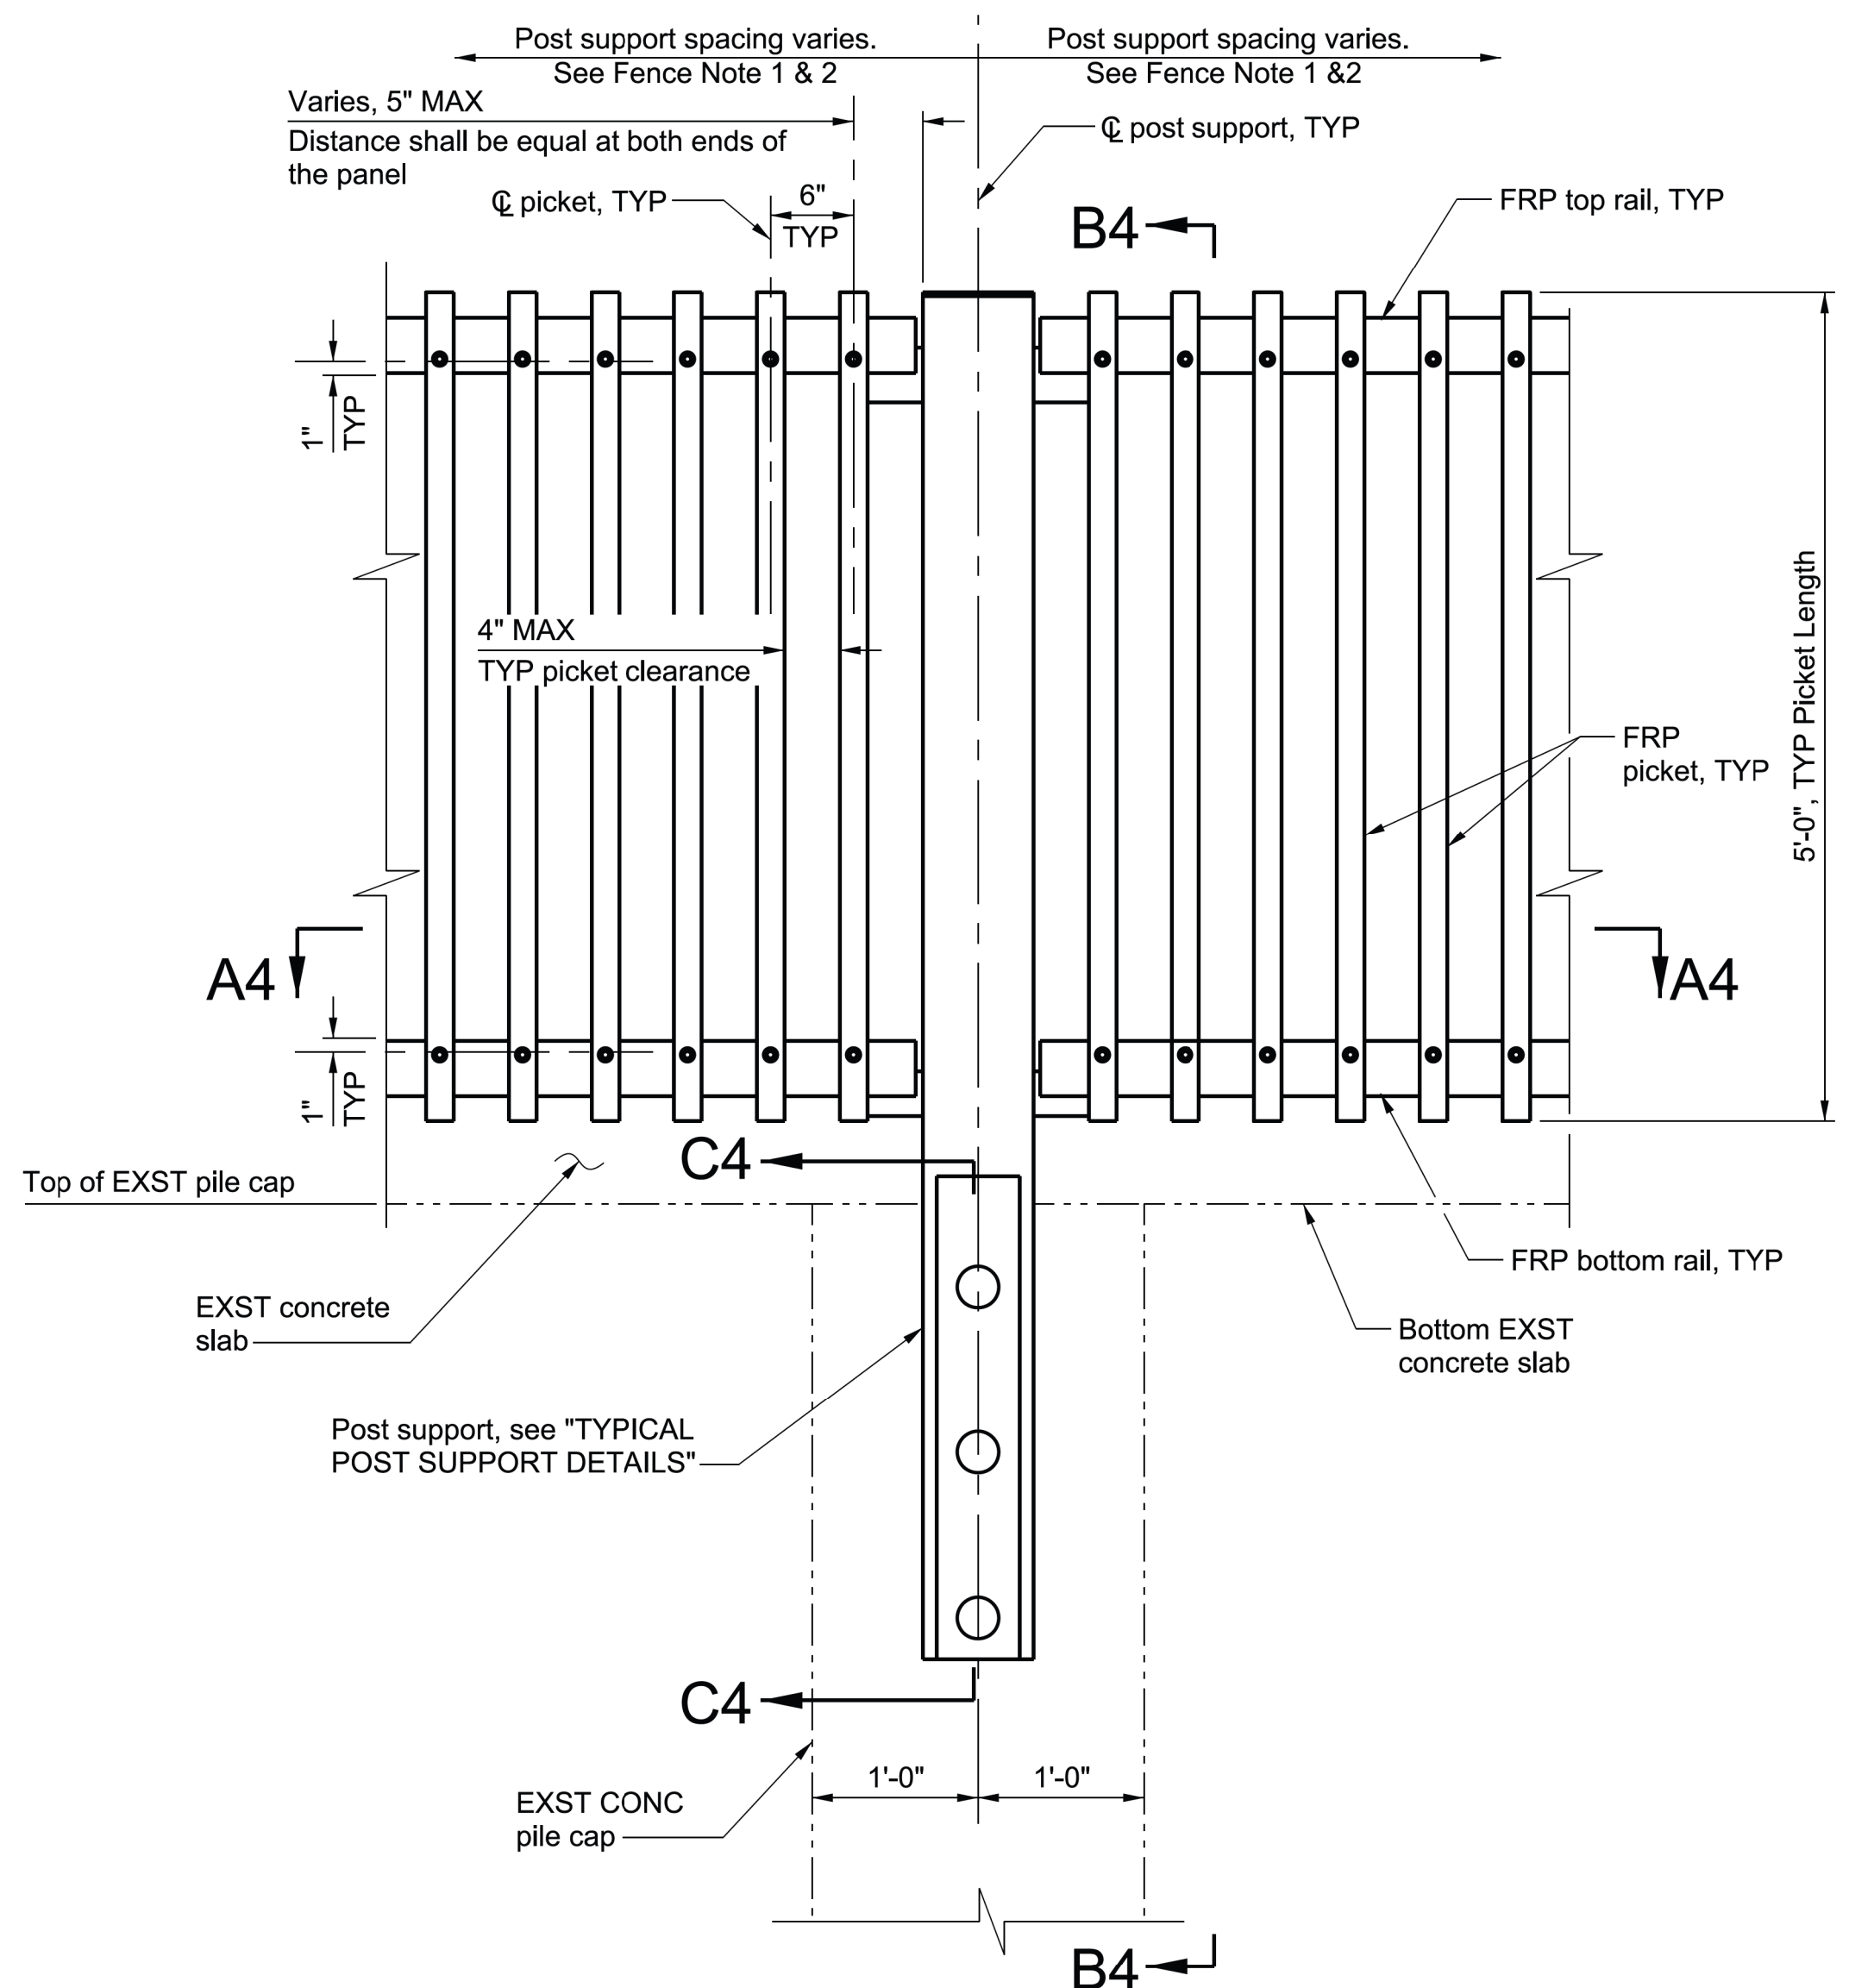


**TYPICAL PROTECTION FENCE DETAIL (SHT 2)**  
SCALE: 1"=1'-0"


NOTE: Front elevation view is shown.

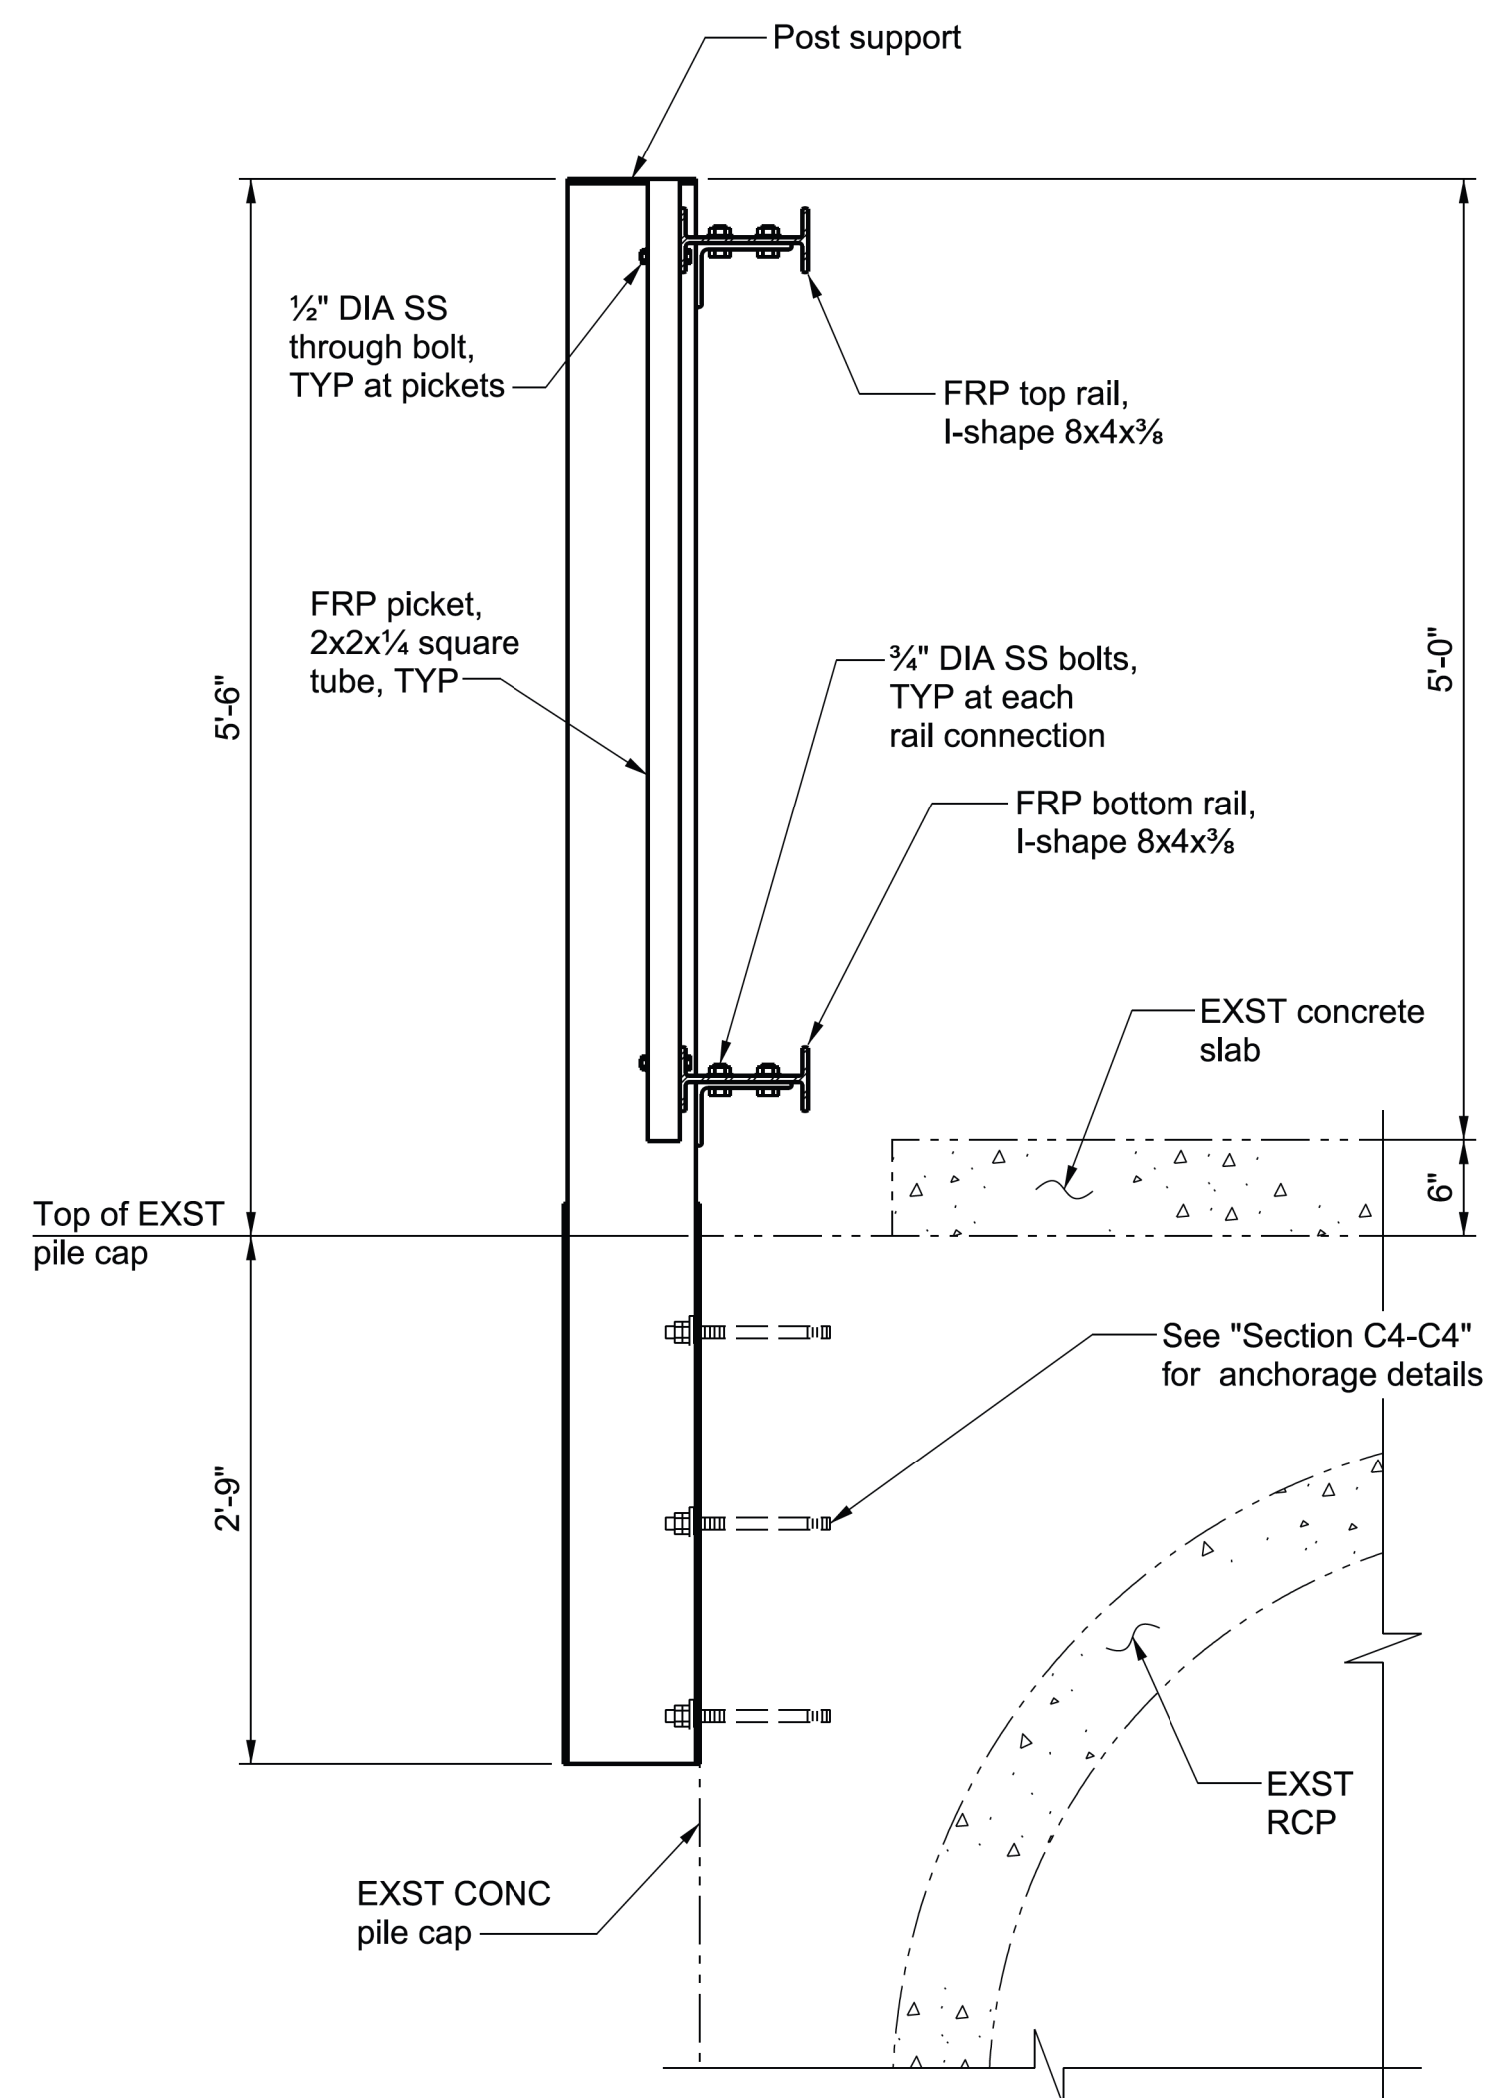


**SECTION B4-B4**  
SCALE: 1"=1'-0"

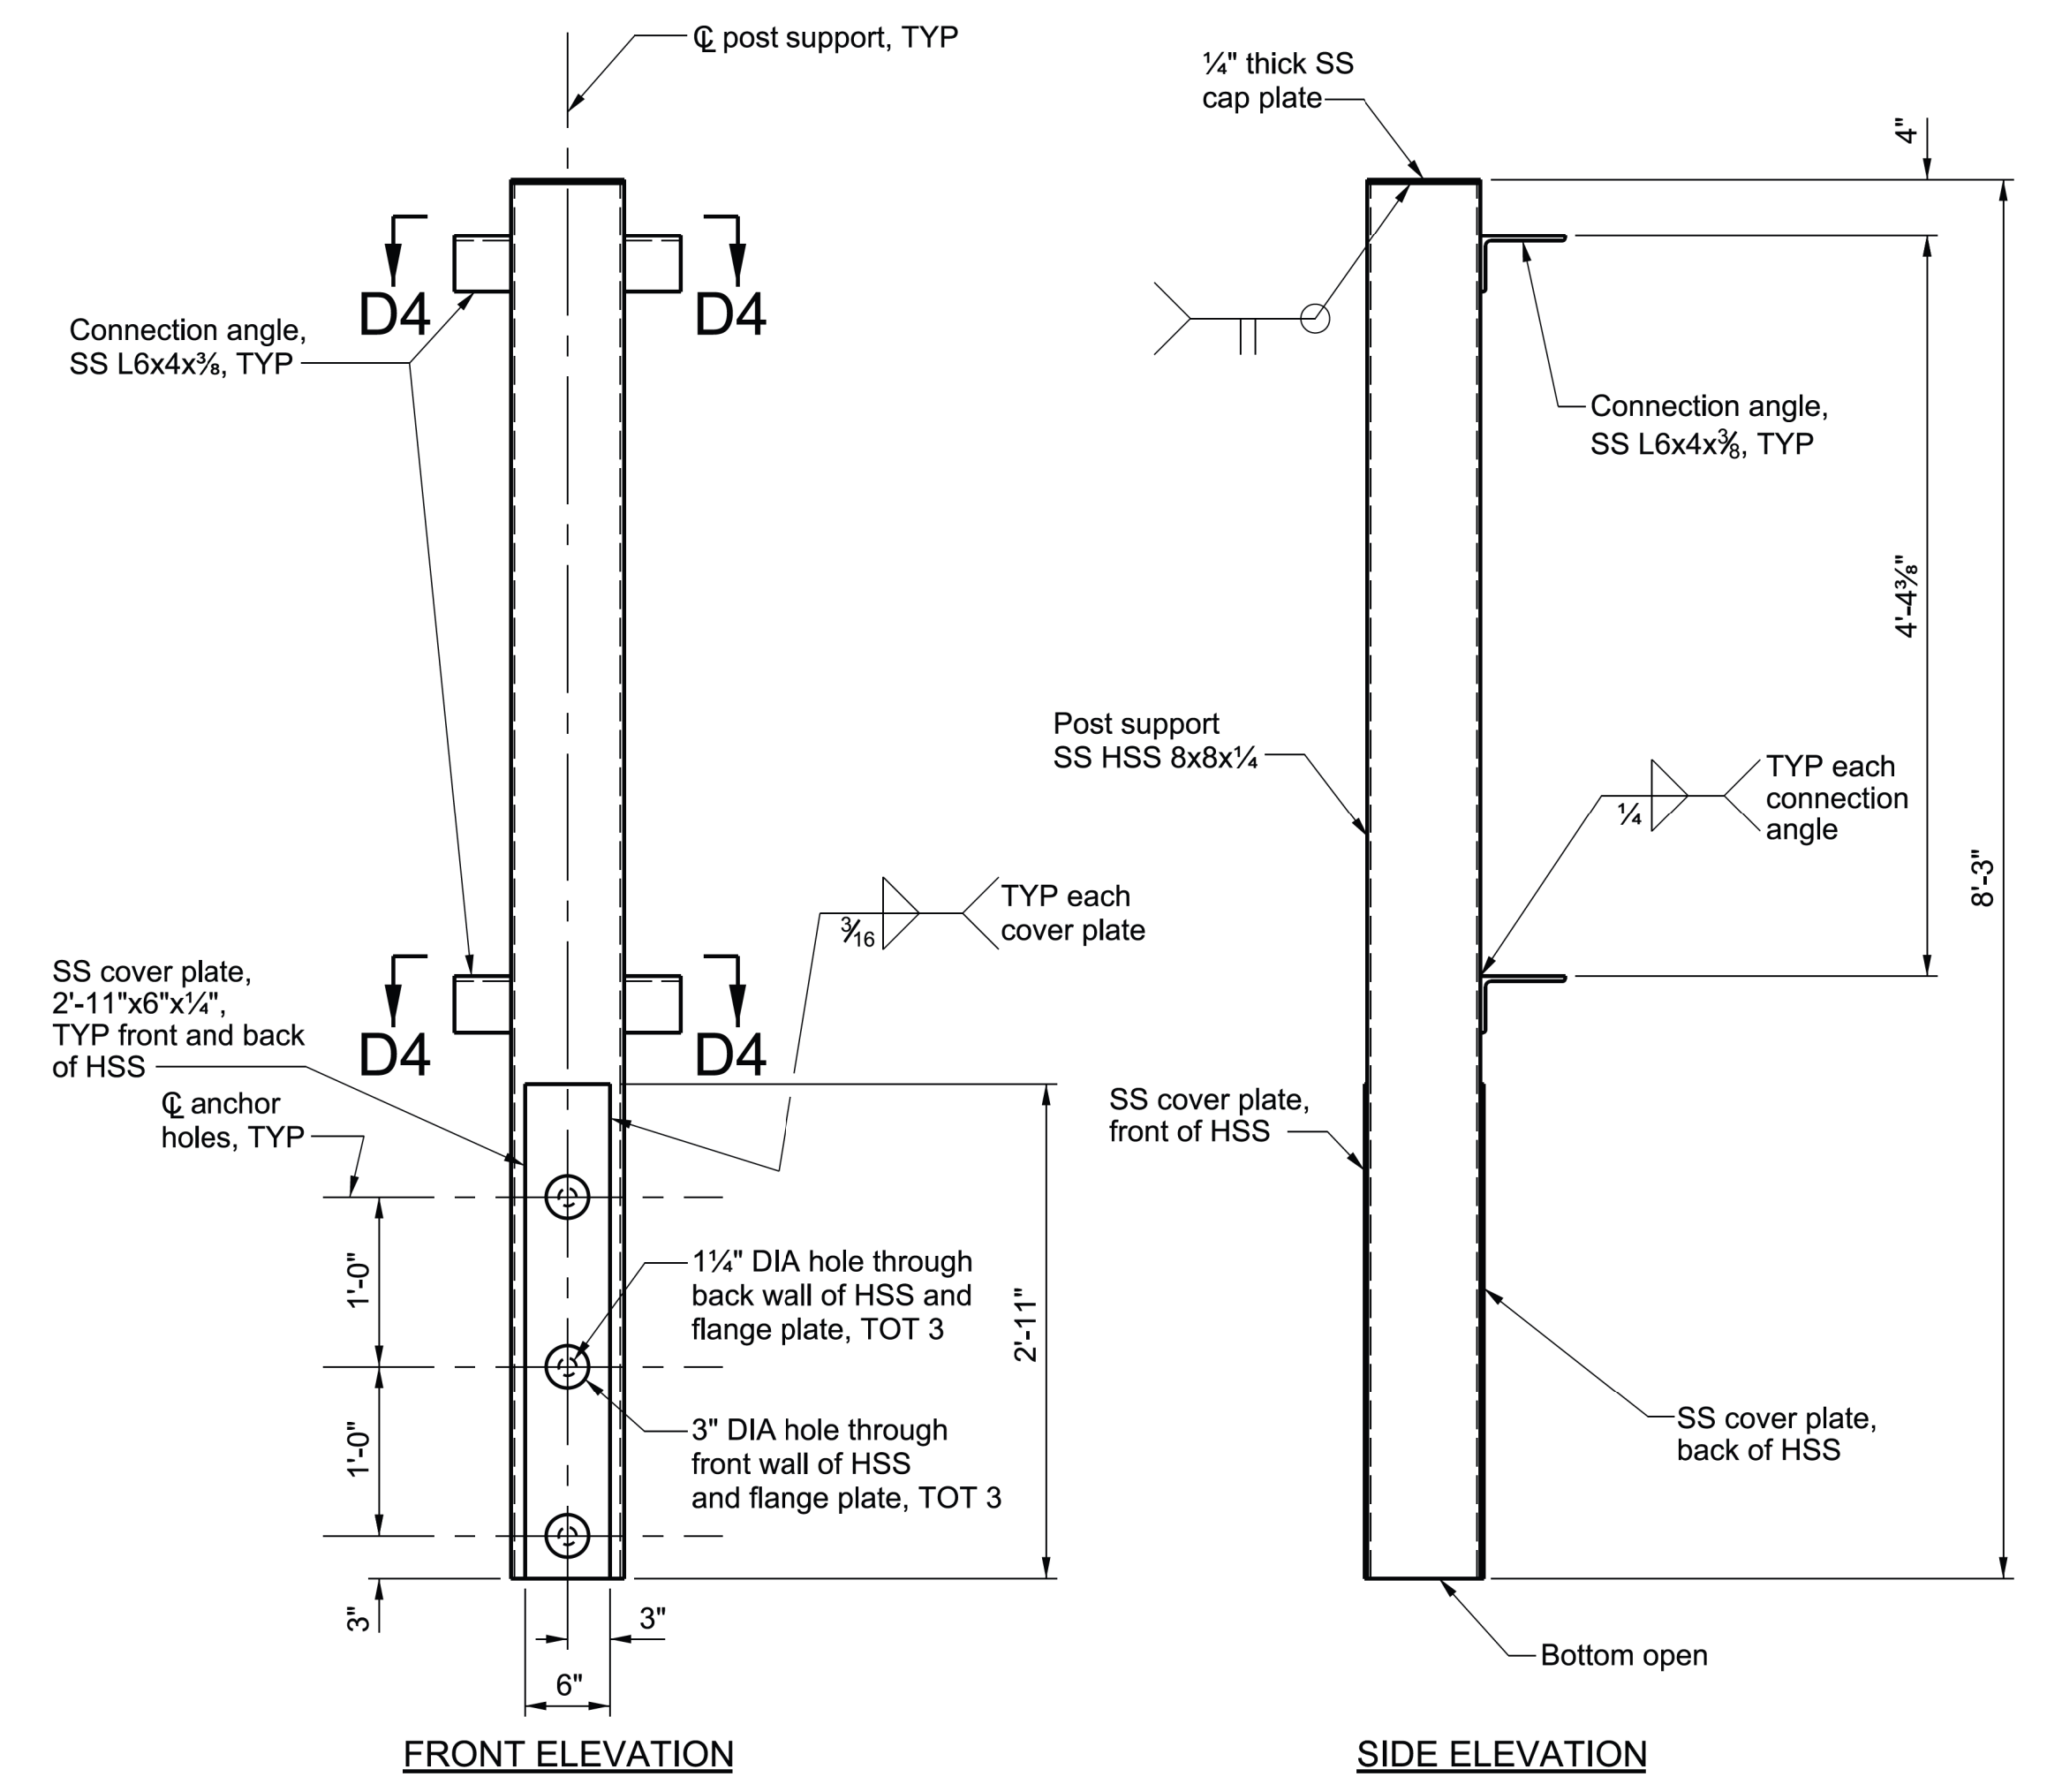


**TYPICAL POST SUPPORT DETAILS**  
SCALE: 1"=1'-0"

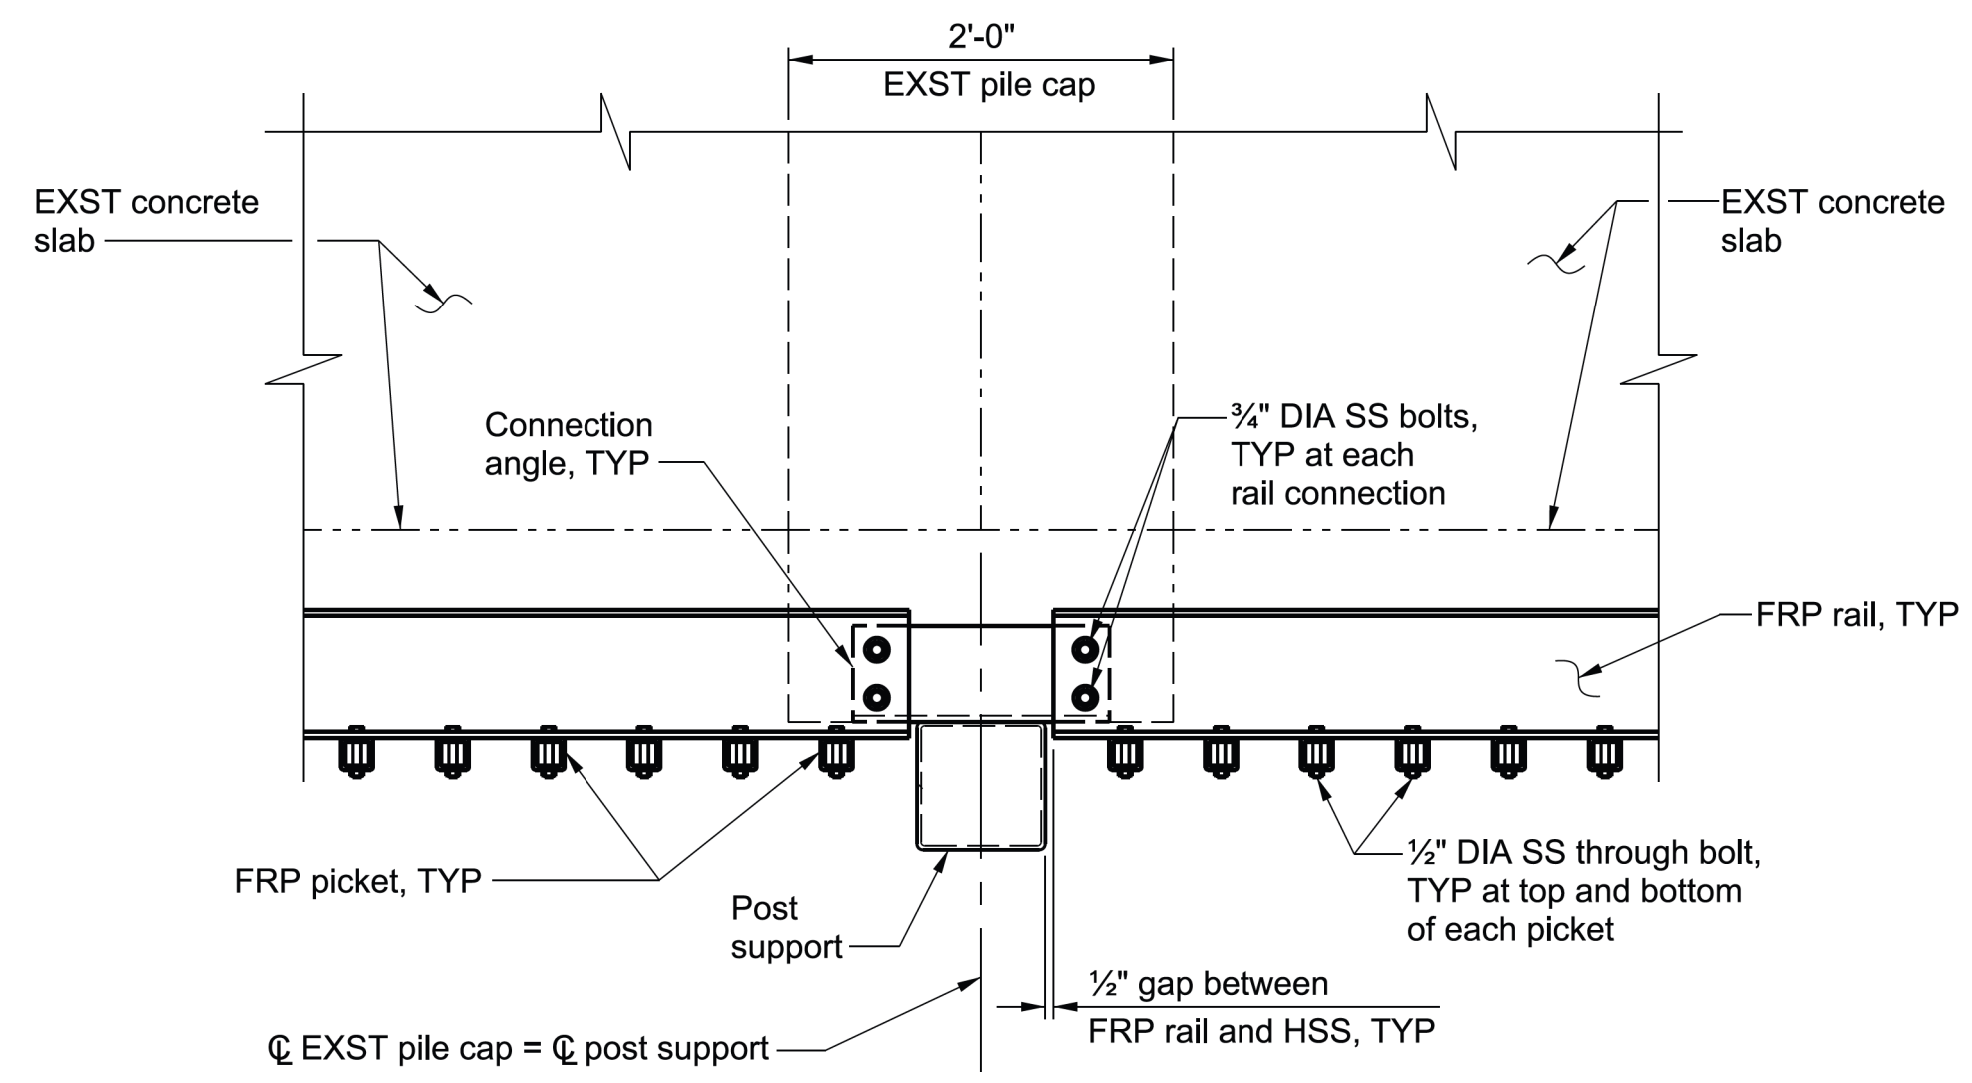

**SECTION A4-A4**  
SCALE: 1"=1'-0"

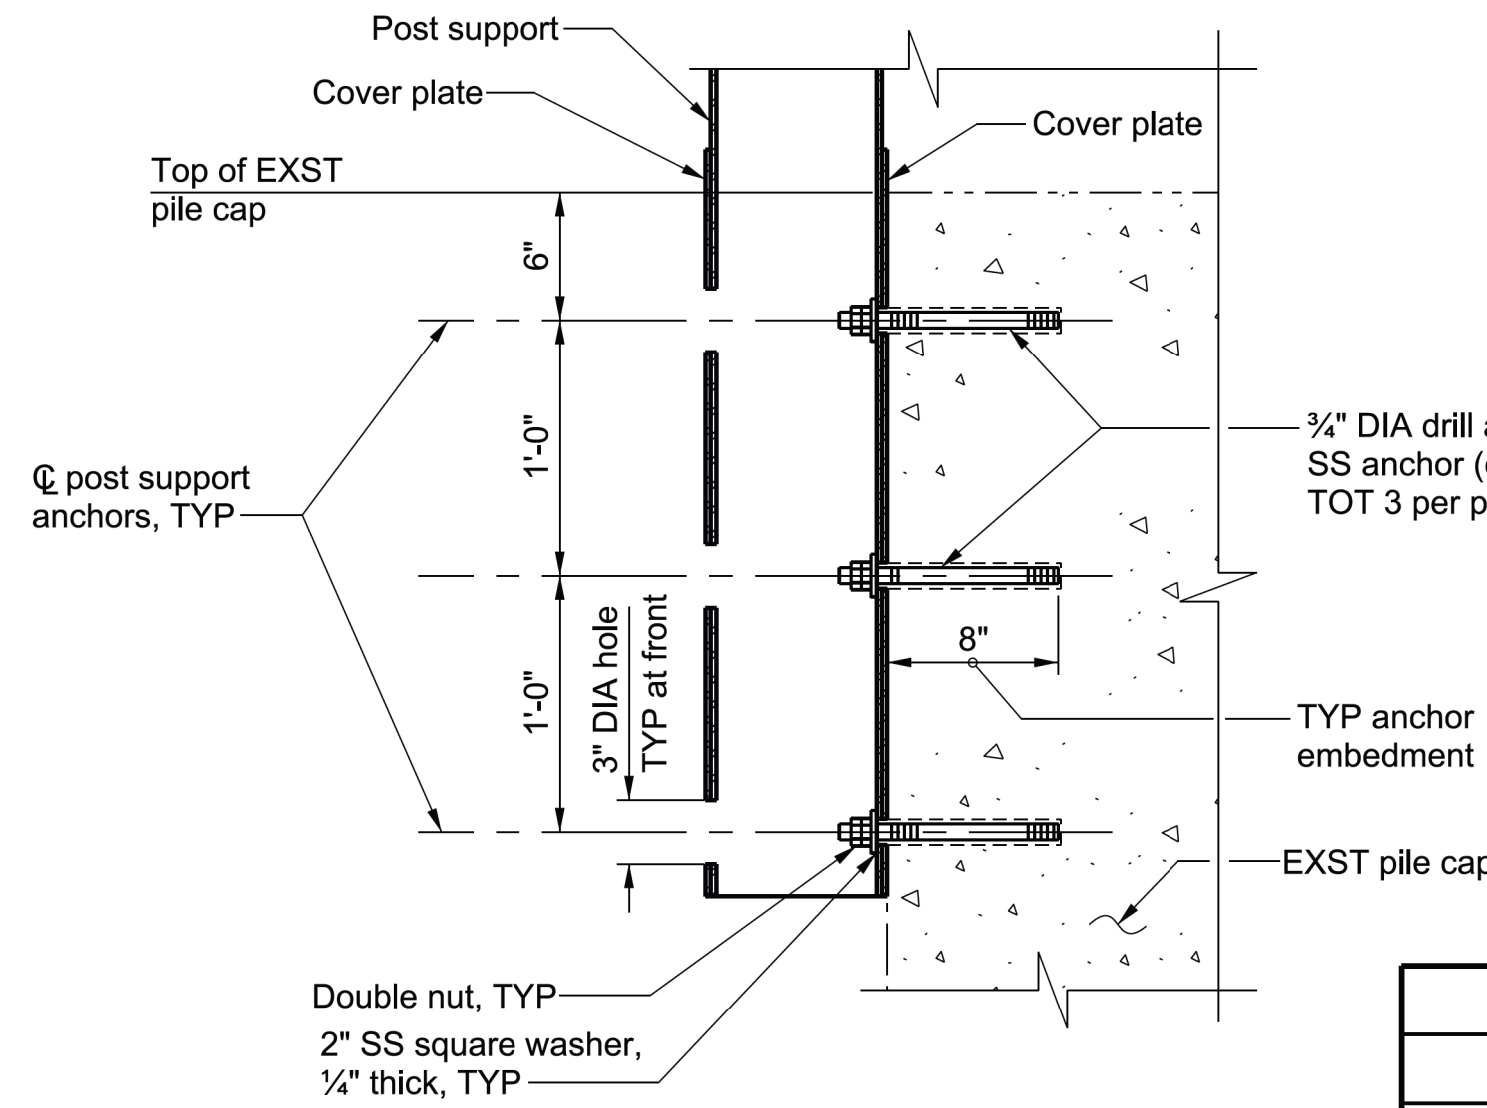

**SECTION C4-C4**  
NOT TO SCALE

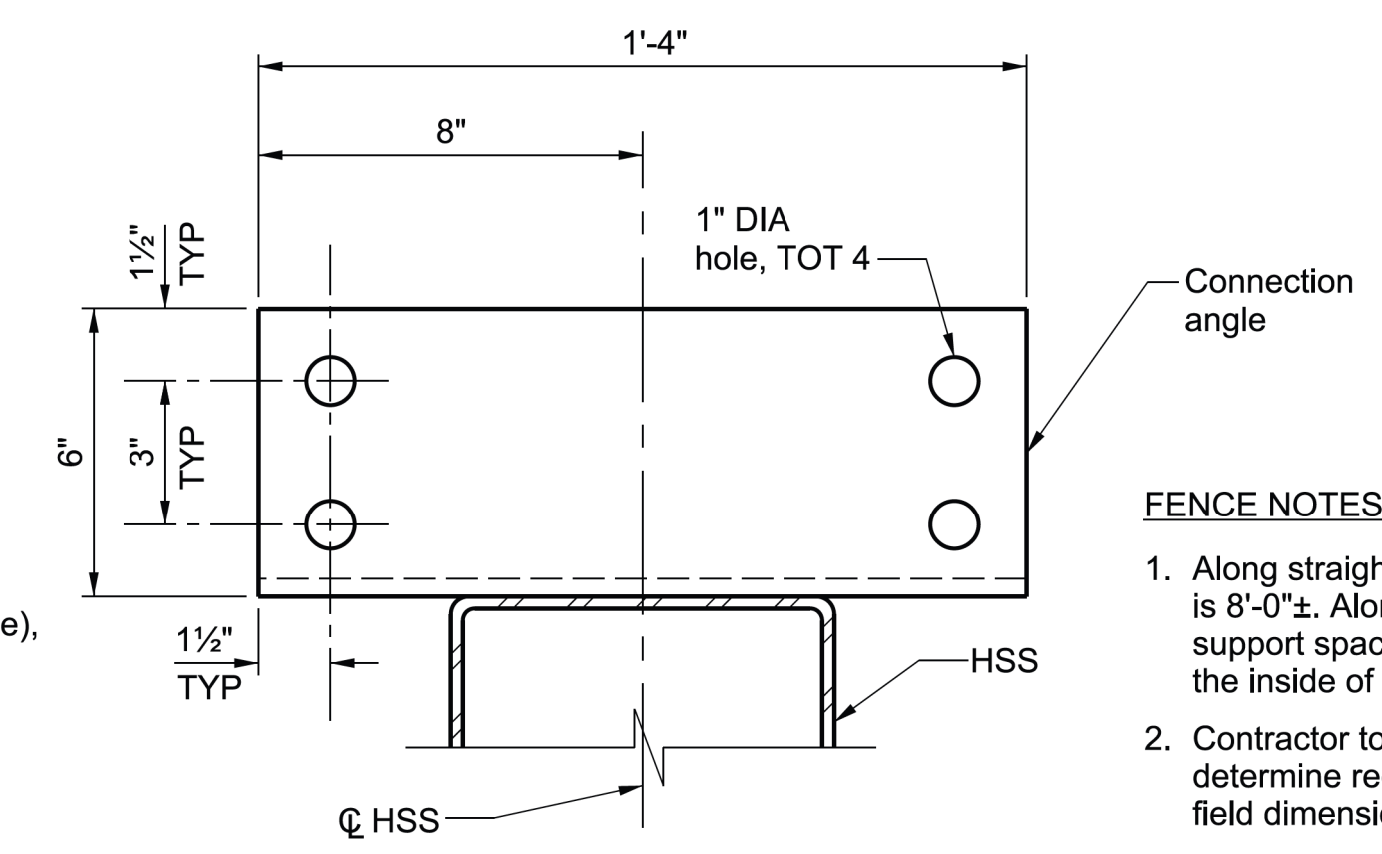


**SECTION D4-D4**  
SCALE: 3"=1'-0"

- FENCE NOTES:**
1. Along straight portions of the fence alignment, the post support spacing is 8'-0"±. Along the curved portions of the fence alignment, the post support spacing is 8'-9 1/2"± on the outside of the curve and 7'-2 1/2"± on the inside of the curve.
  2. Contractor to verify existing field dimensions of the outlet structure and determine required post support spacing. Shop drawings based on verified field dimensions shall be submitted in accordance with 3-8.

CAD/DRAWING FILE NAME: FCC0001318 - Project No. 275-513 Ocean Outlet Modifications.dgn  
 CHECKER: J. LU  
 DESIGNER: S. GREGOWSKIE  
 DRAFTER: S. GREGOWSKIE


DATE	MARK	DESCRIPTION

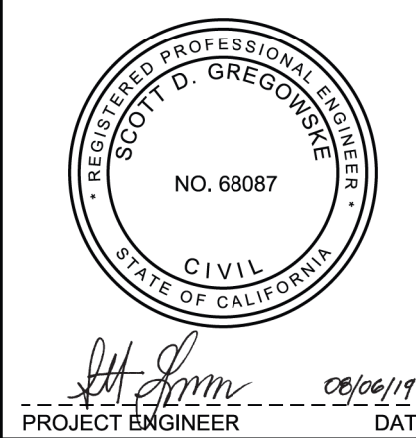


LOS ANGELES COUNTY PUBLIC WORKS  
**PROJECT NO. 275-513**  
 OCEAN OUTLET MODIFICATIONS  
 (STA. 0+87 - 3+64)  
 PROJECT ID NO. FCC0001318  
 PROTECTION FENCE - TYPICAL PANEL DETAILS

DWG 275-513-D19.4    PD PD053002    SHEET 4 OF 11


**AS BUILT DRAWINGS**

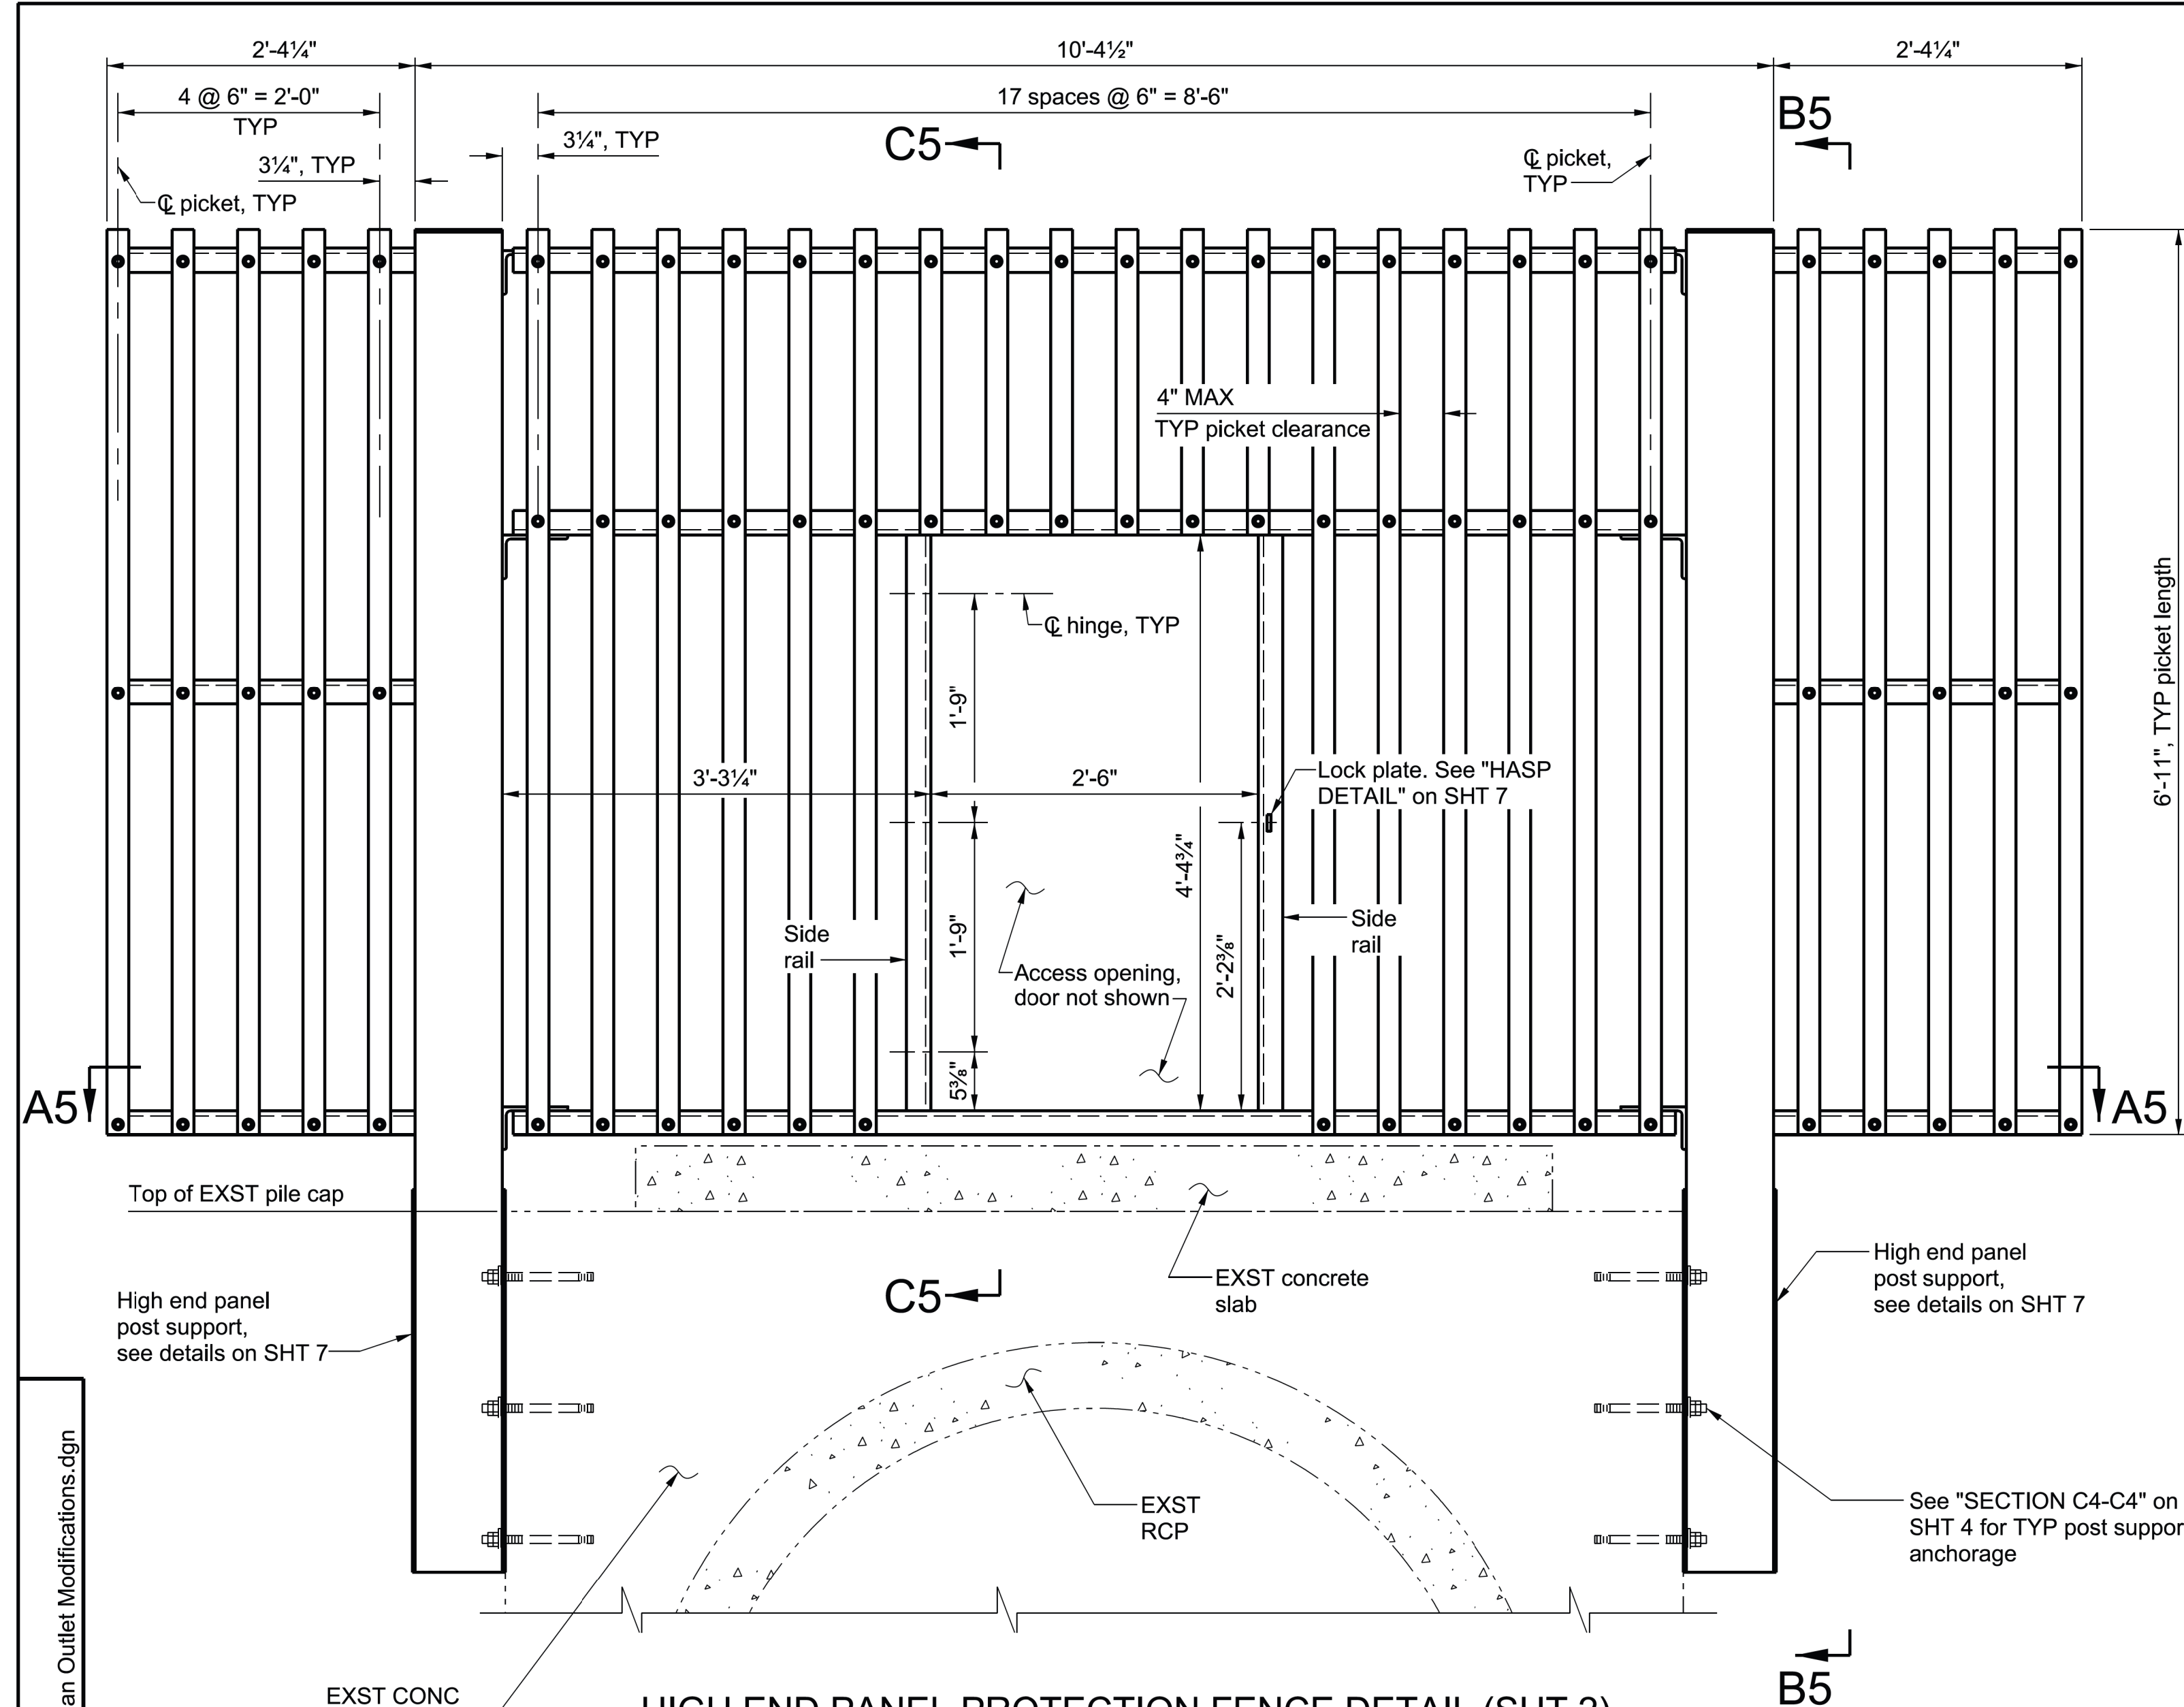


**HIGH END PANEL PROTECTION FENCE DETAIL (SHT 2)**  
 SCALE: 1"=1'-0"  
 NOTE: Front elevation view is shown.

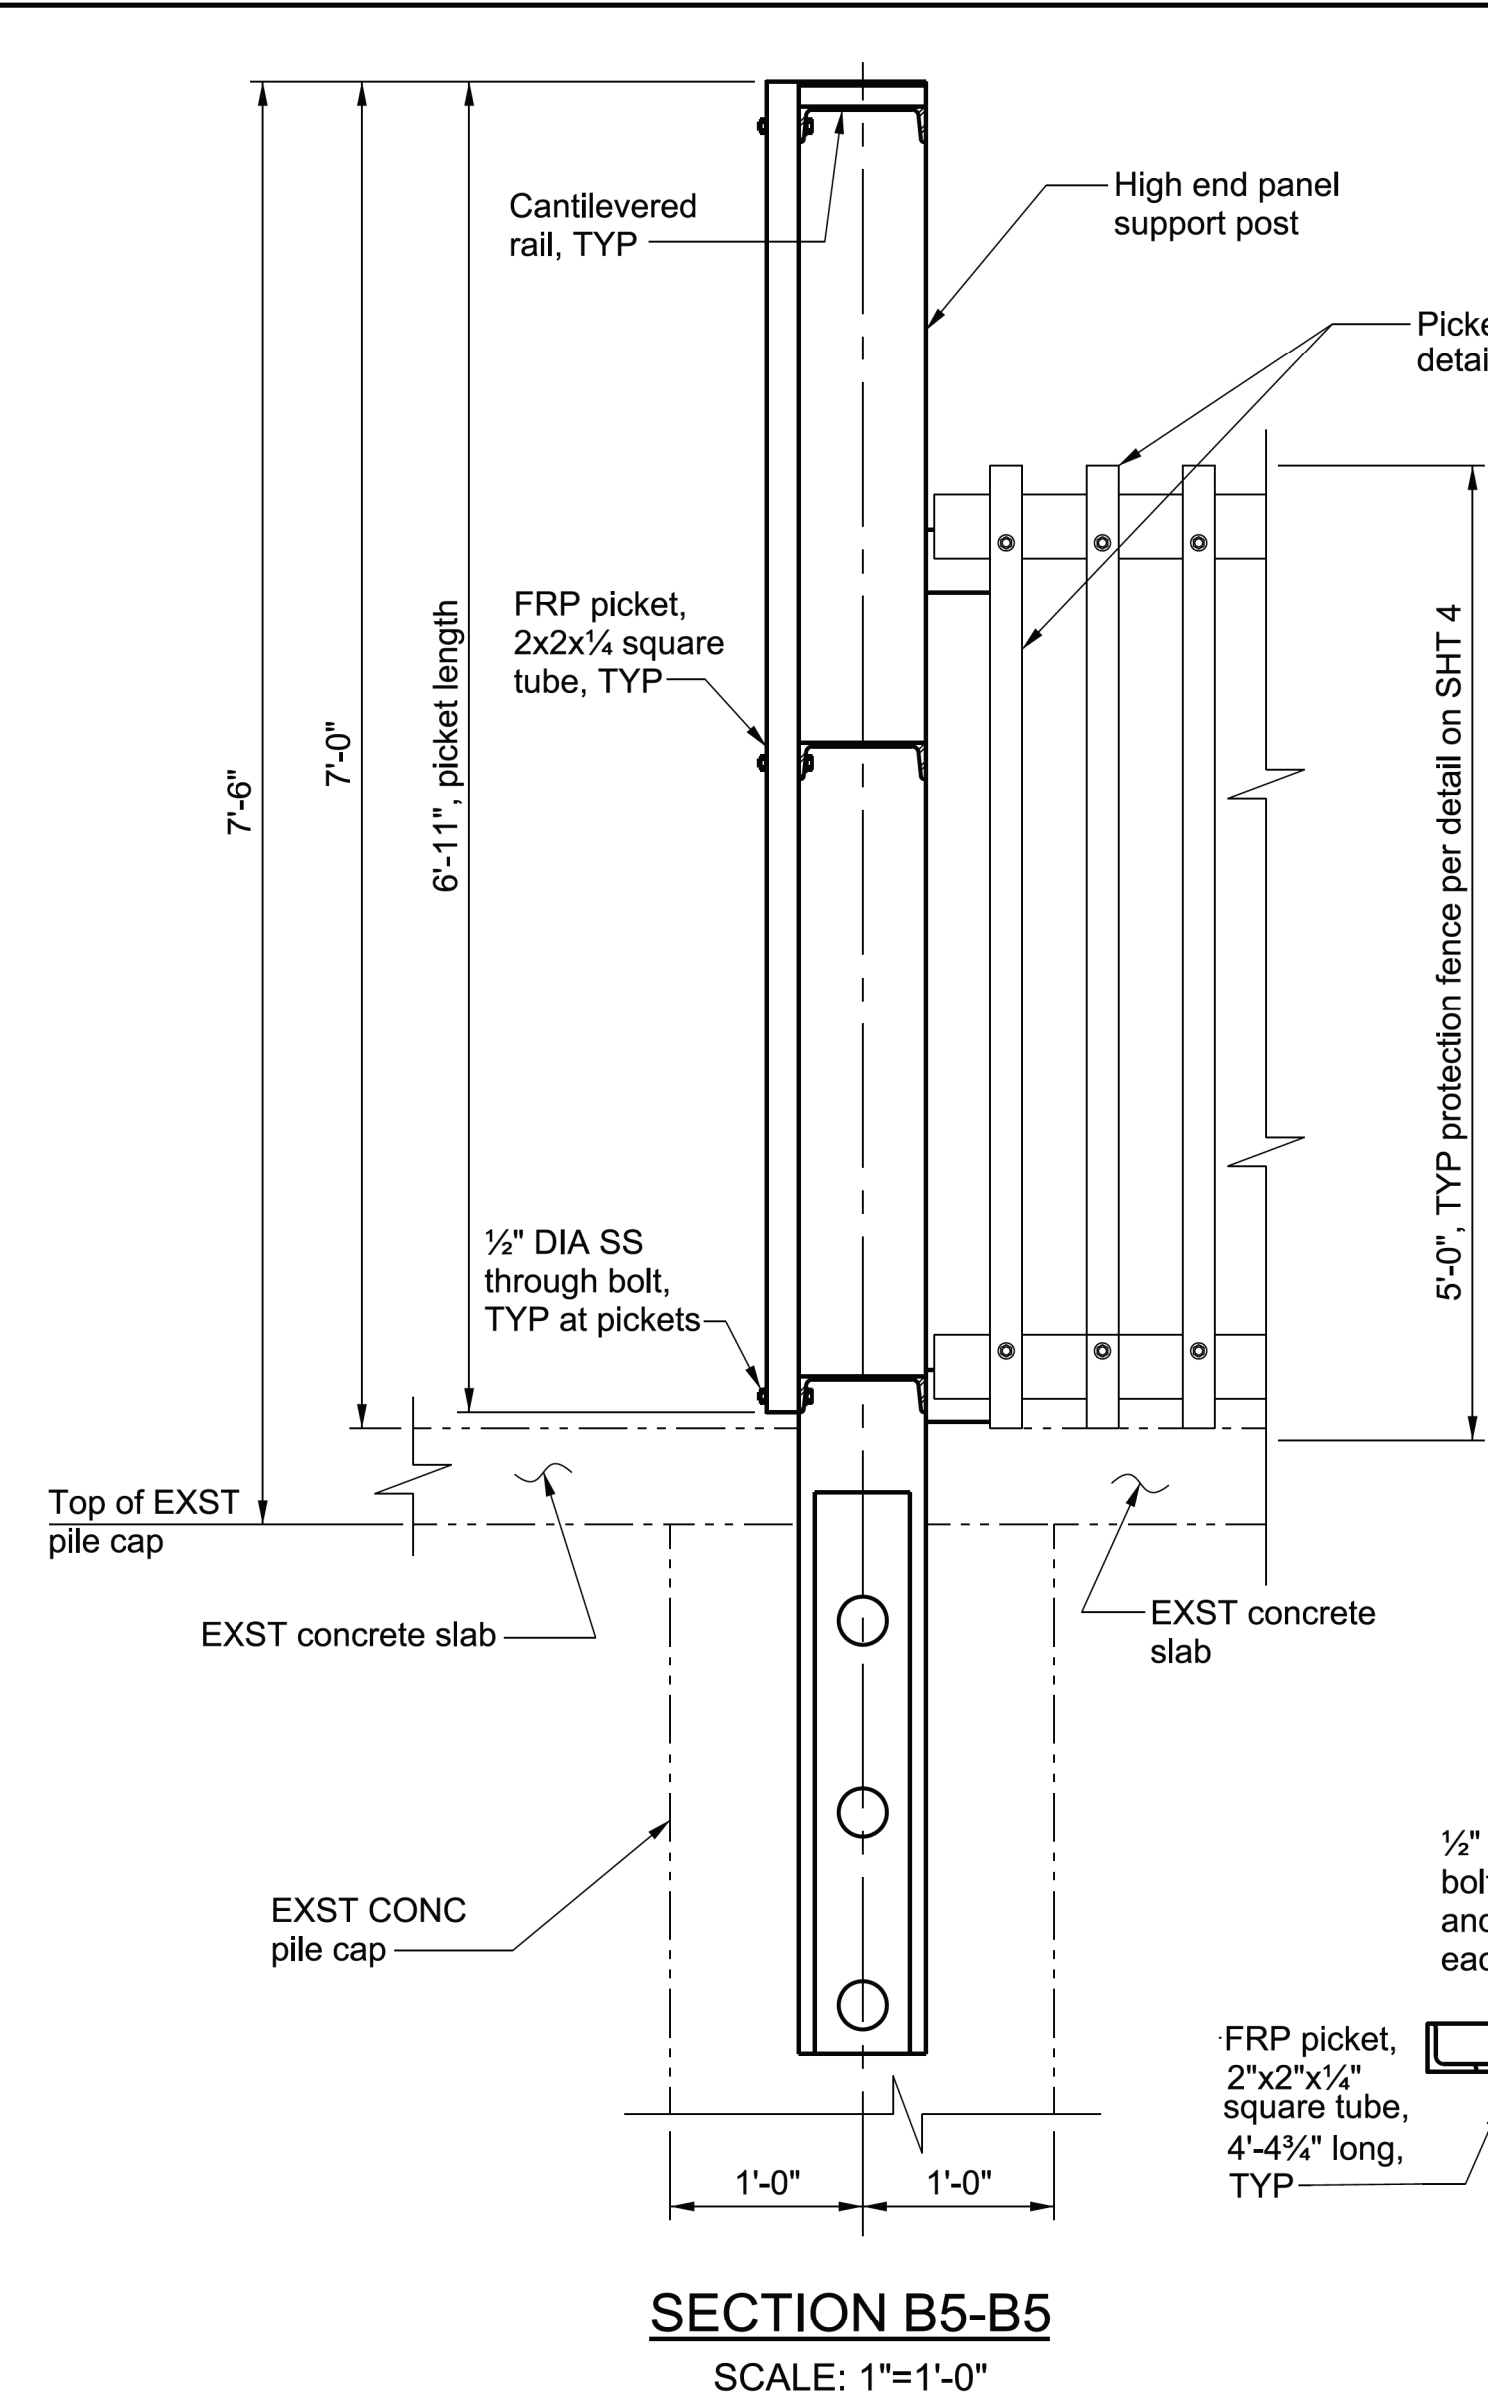


**SECTION B5-B5**  
 SCALE: 1"=1'-0"

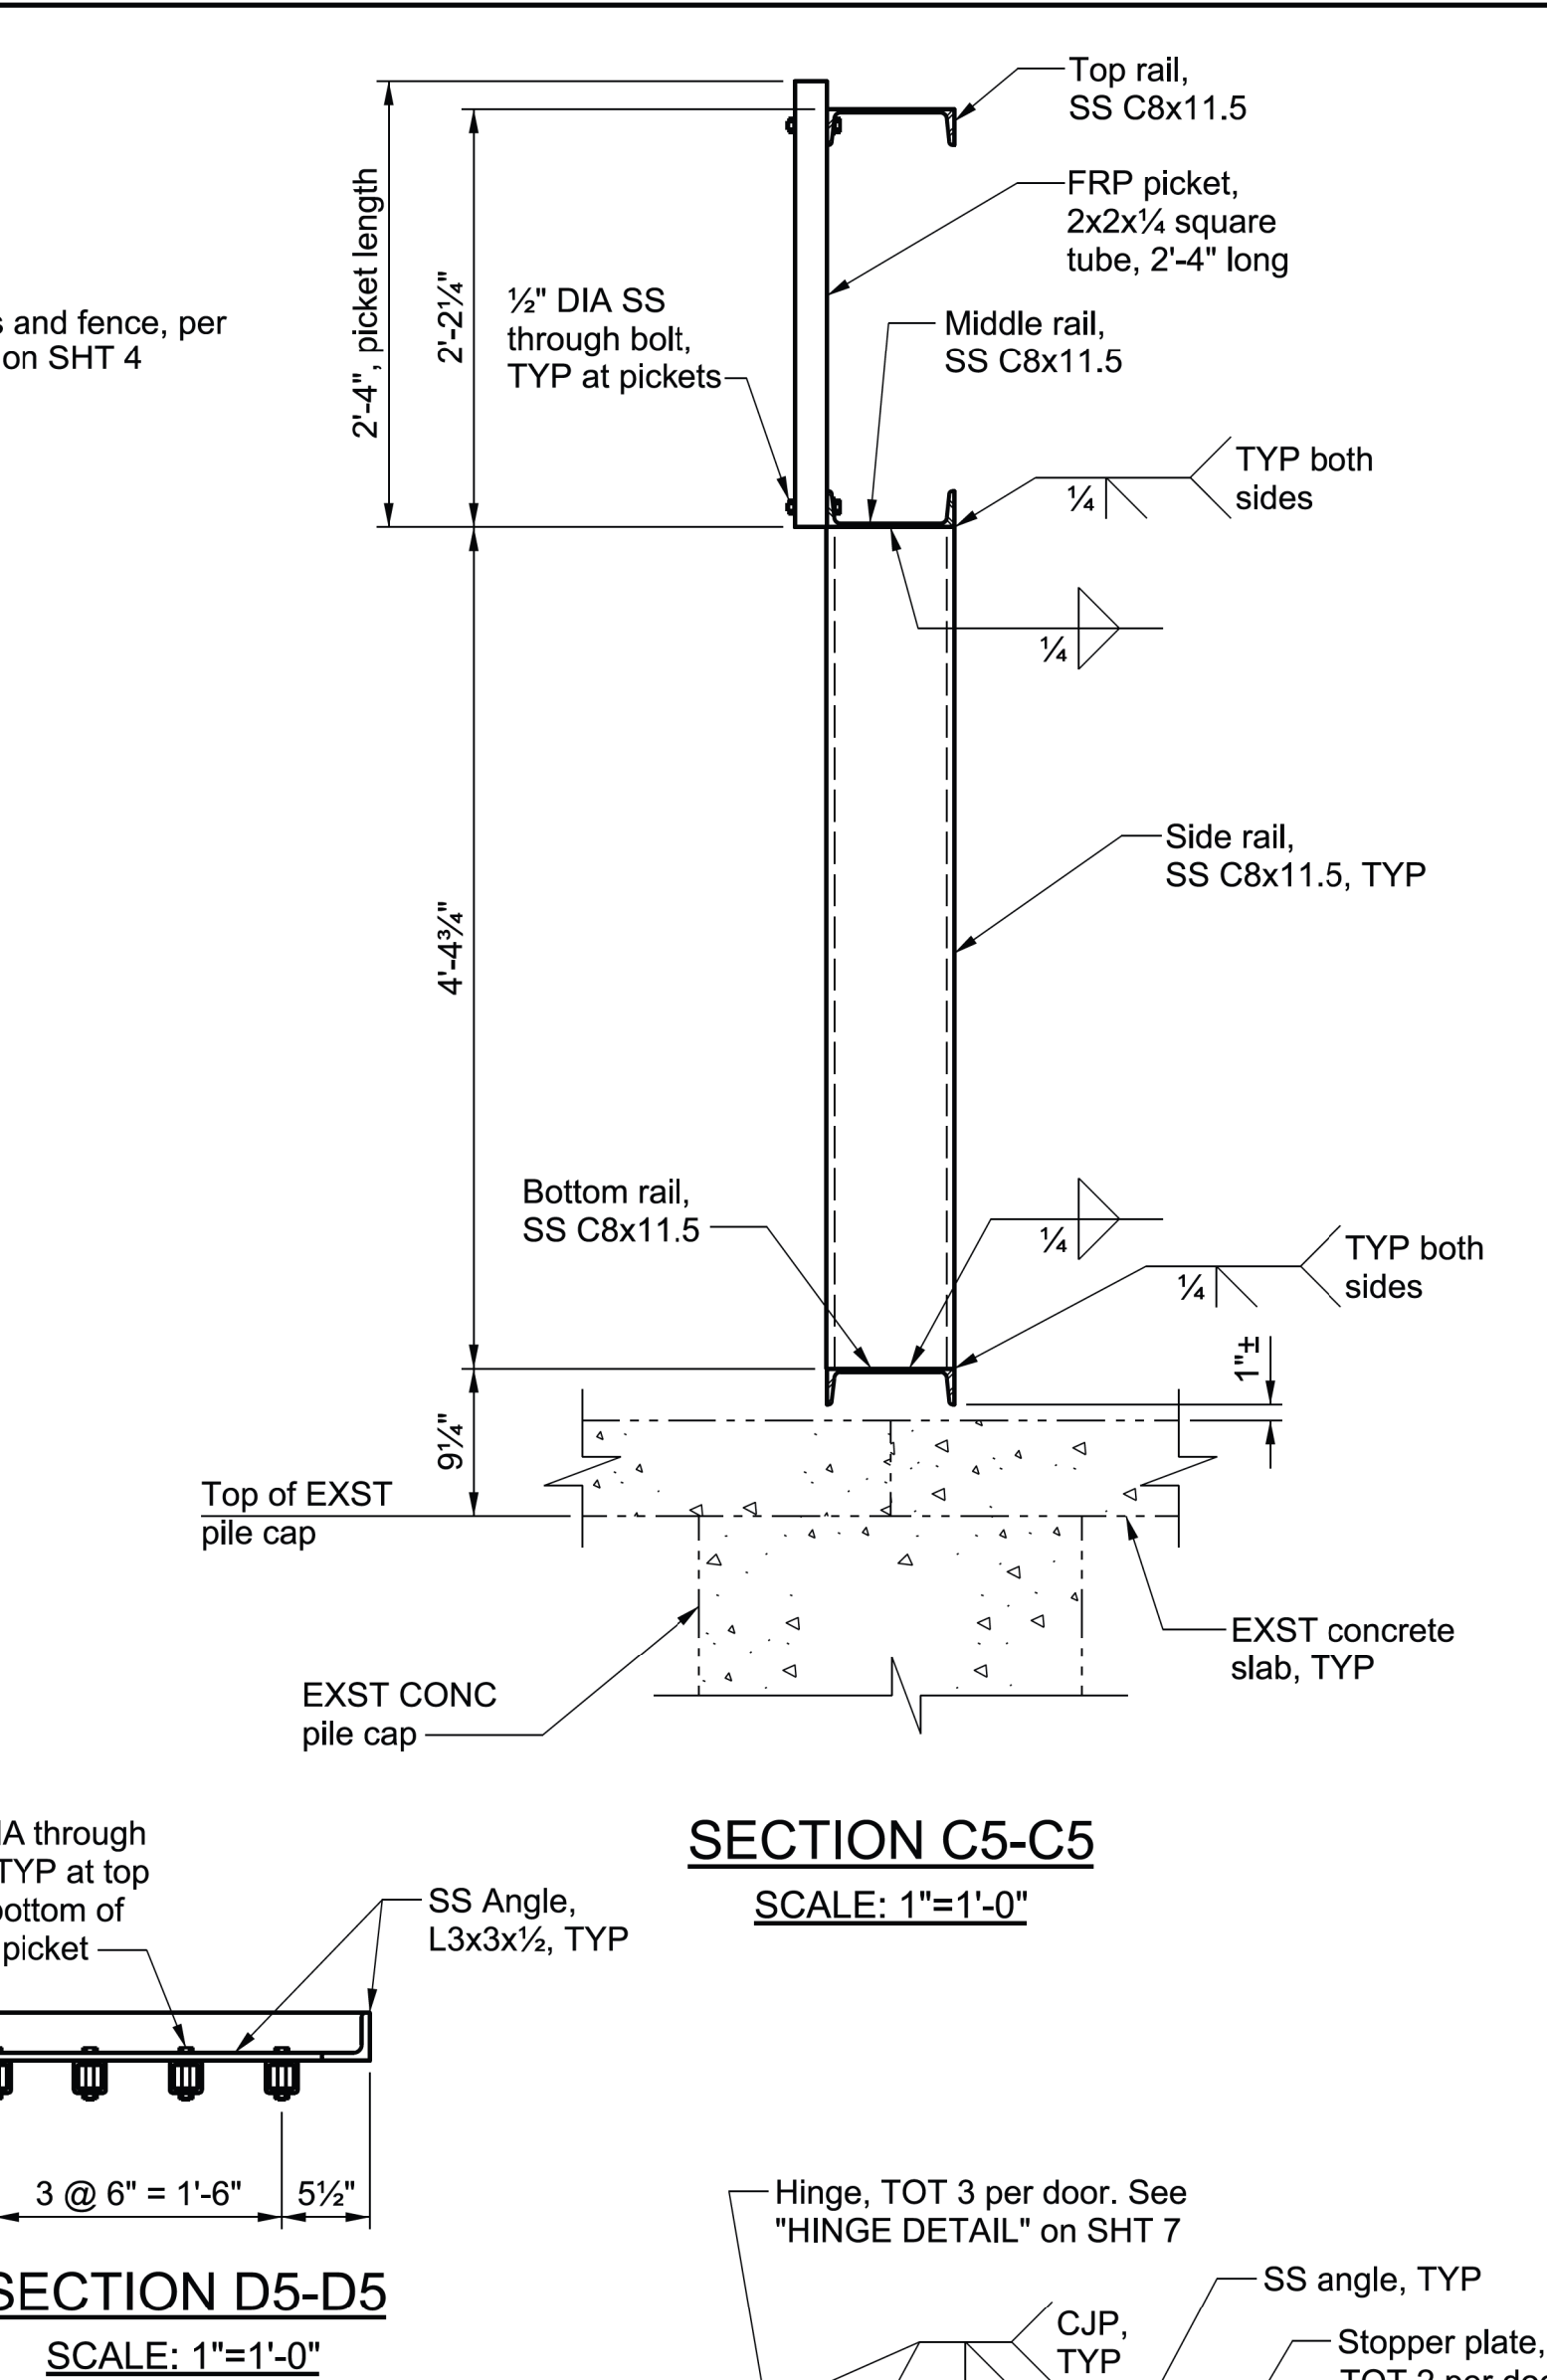

**SECTION C5-C5**  
 SCALE: 1"=1'-0"

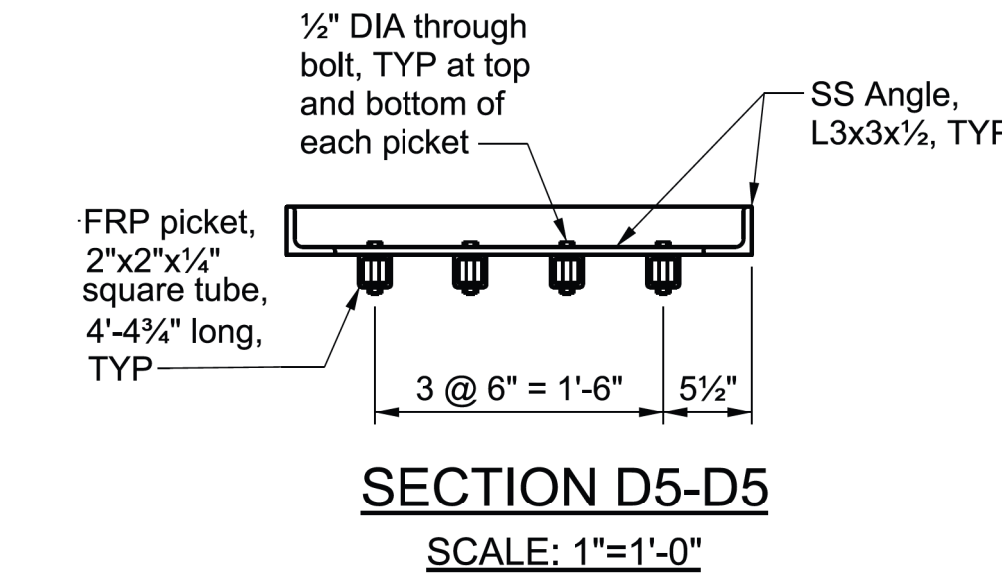


**SECTION D5-D5**  
 SCALE: 1"=1'-0"

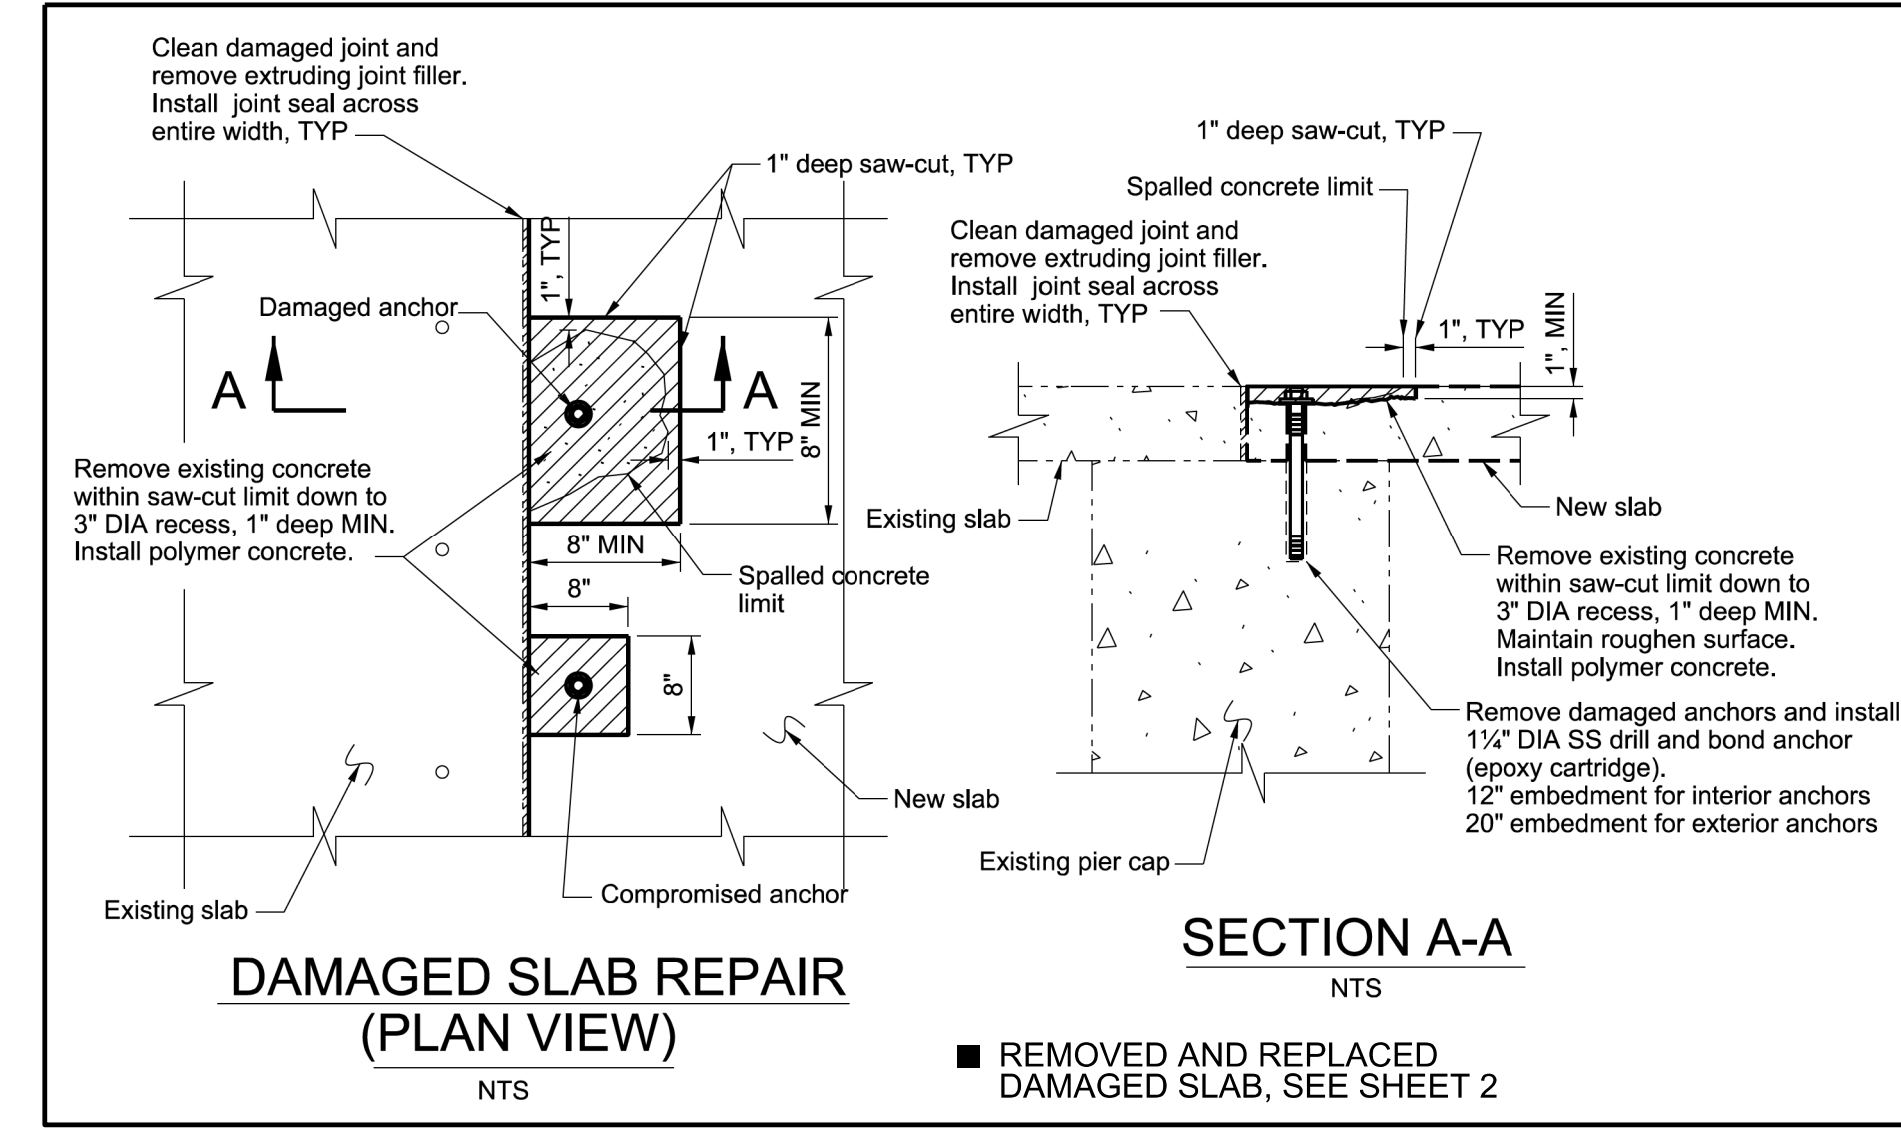


**DAMAGED SLAB REPAIR (PLAN VIEW)**  
 NTS

**SECTION A-A**  
 NTS

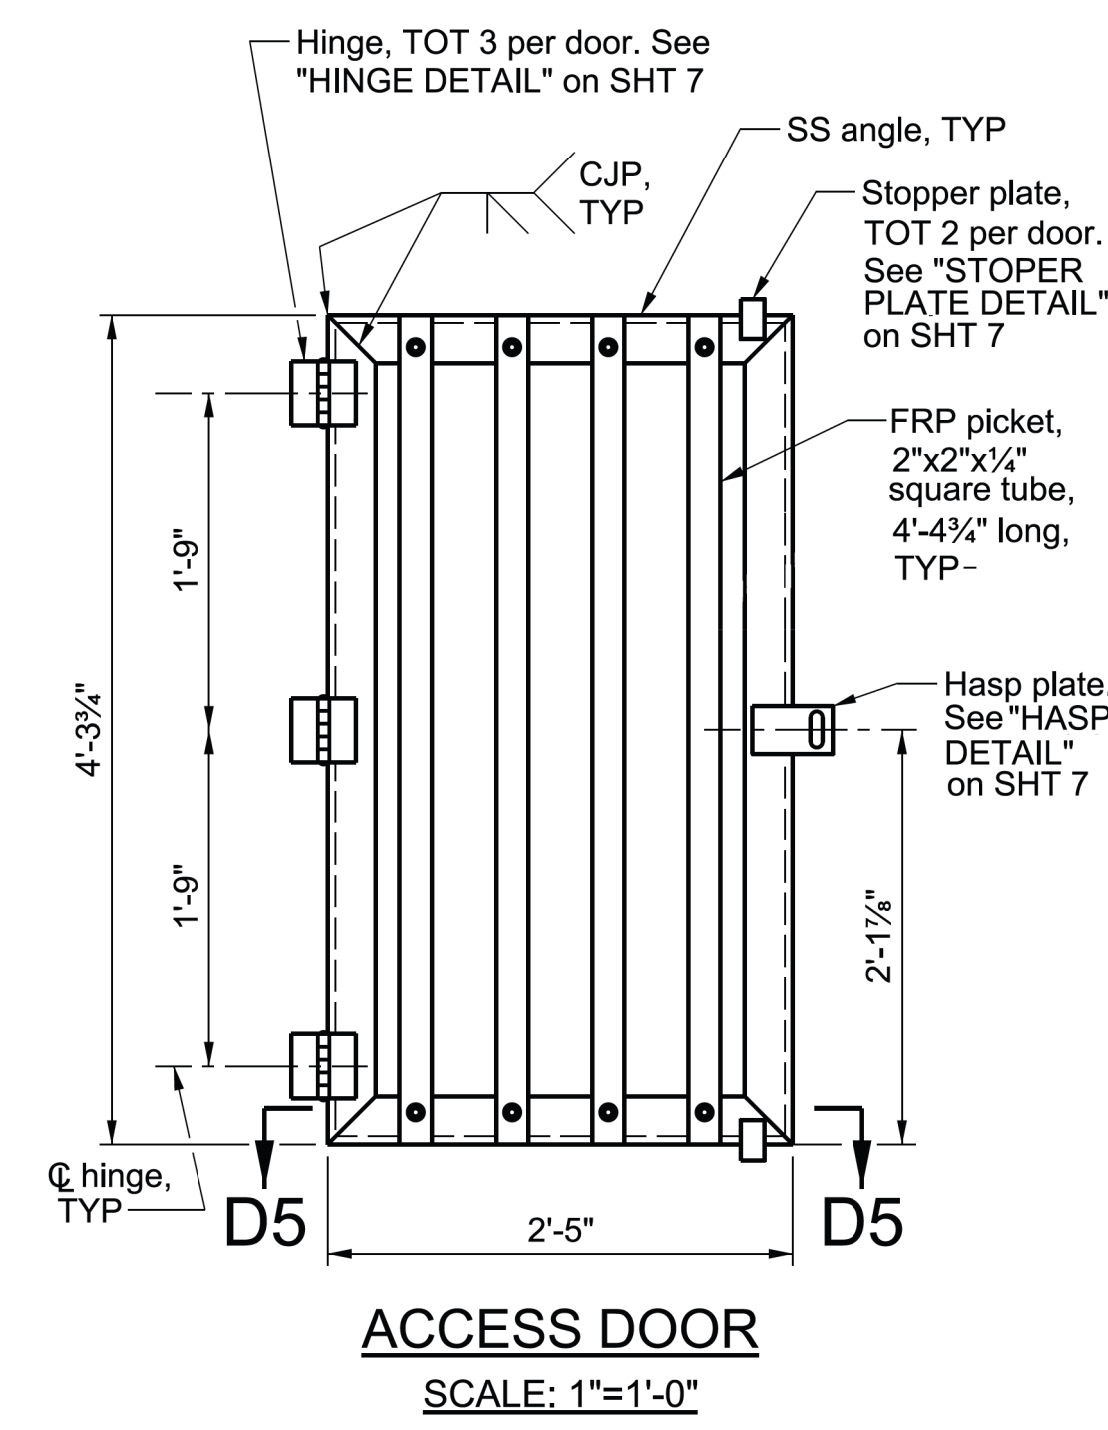


**ACCESS DOOR**  
 SCALE: 1"=1'-0"

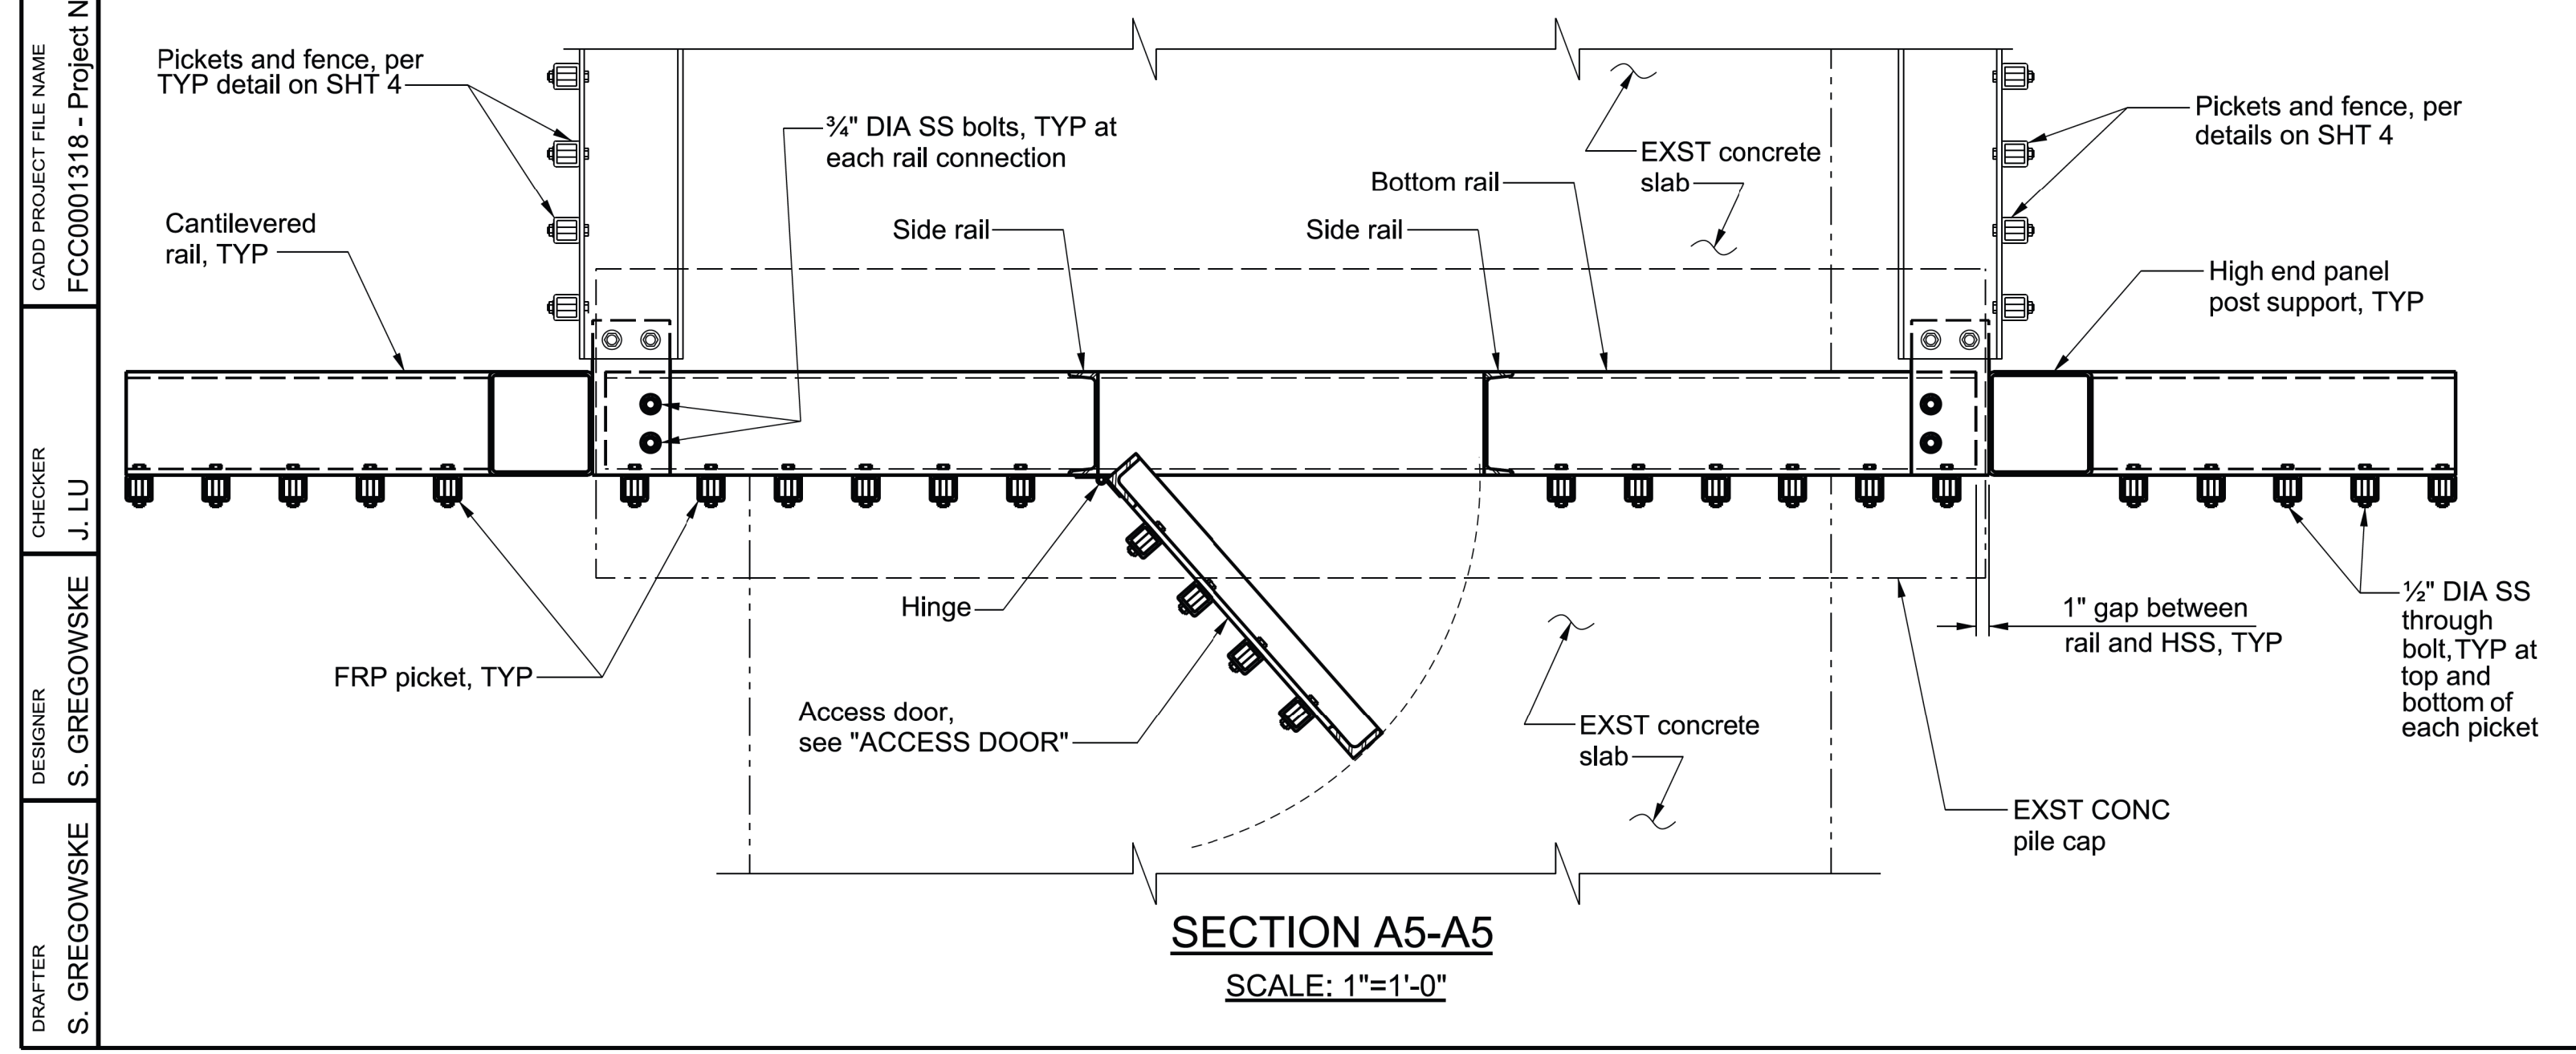

**SECTION A5-A5**  
 SCALE: 1"=1'-0"

DRAFTER: S. GREGOWSKIE  
 DESIGNER: S. GREGOWSKIE  
 CHECKER: J. LU  
 CADD PROJECT FILE NAME: FCC0001318 - Project No. 275-513 Ocean Outlet Modifications.dgn

DATE	MARK	DESCRIPTION
02/17/2022	■	AS BUILT REVISIONS
REVISIONS		

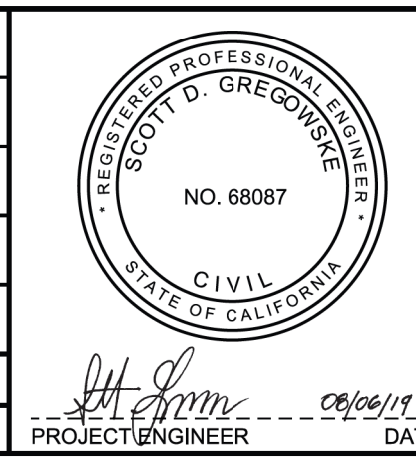

LOS ANGELES COUNTY PUBLIC WORKS

**PROJECT NO. 275-513**  
 OCEAN OUTLET MODIFICATIONS  
 (STA. 0+87 - 3+64)


PROJECT ID NO. FCC0001318  
**PROTECTION FENCE - HIGH END PANEL DETAILS**

DWG 275-513-D19.5 PD PD053002 SHEET 5 OF 11

AS BUILT DRAWINGS




DRAFTER: S. GREGOWSKIE  
 DESIGNER: S. GREGOWSKIE  
 CHECKER: J. LU  
 CADD PROJECT FILE NAME: FCC0001318 - Project No. 275-513 Ocean Outlet Modifications.dgn

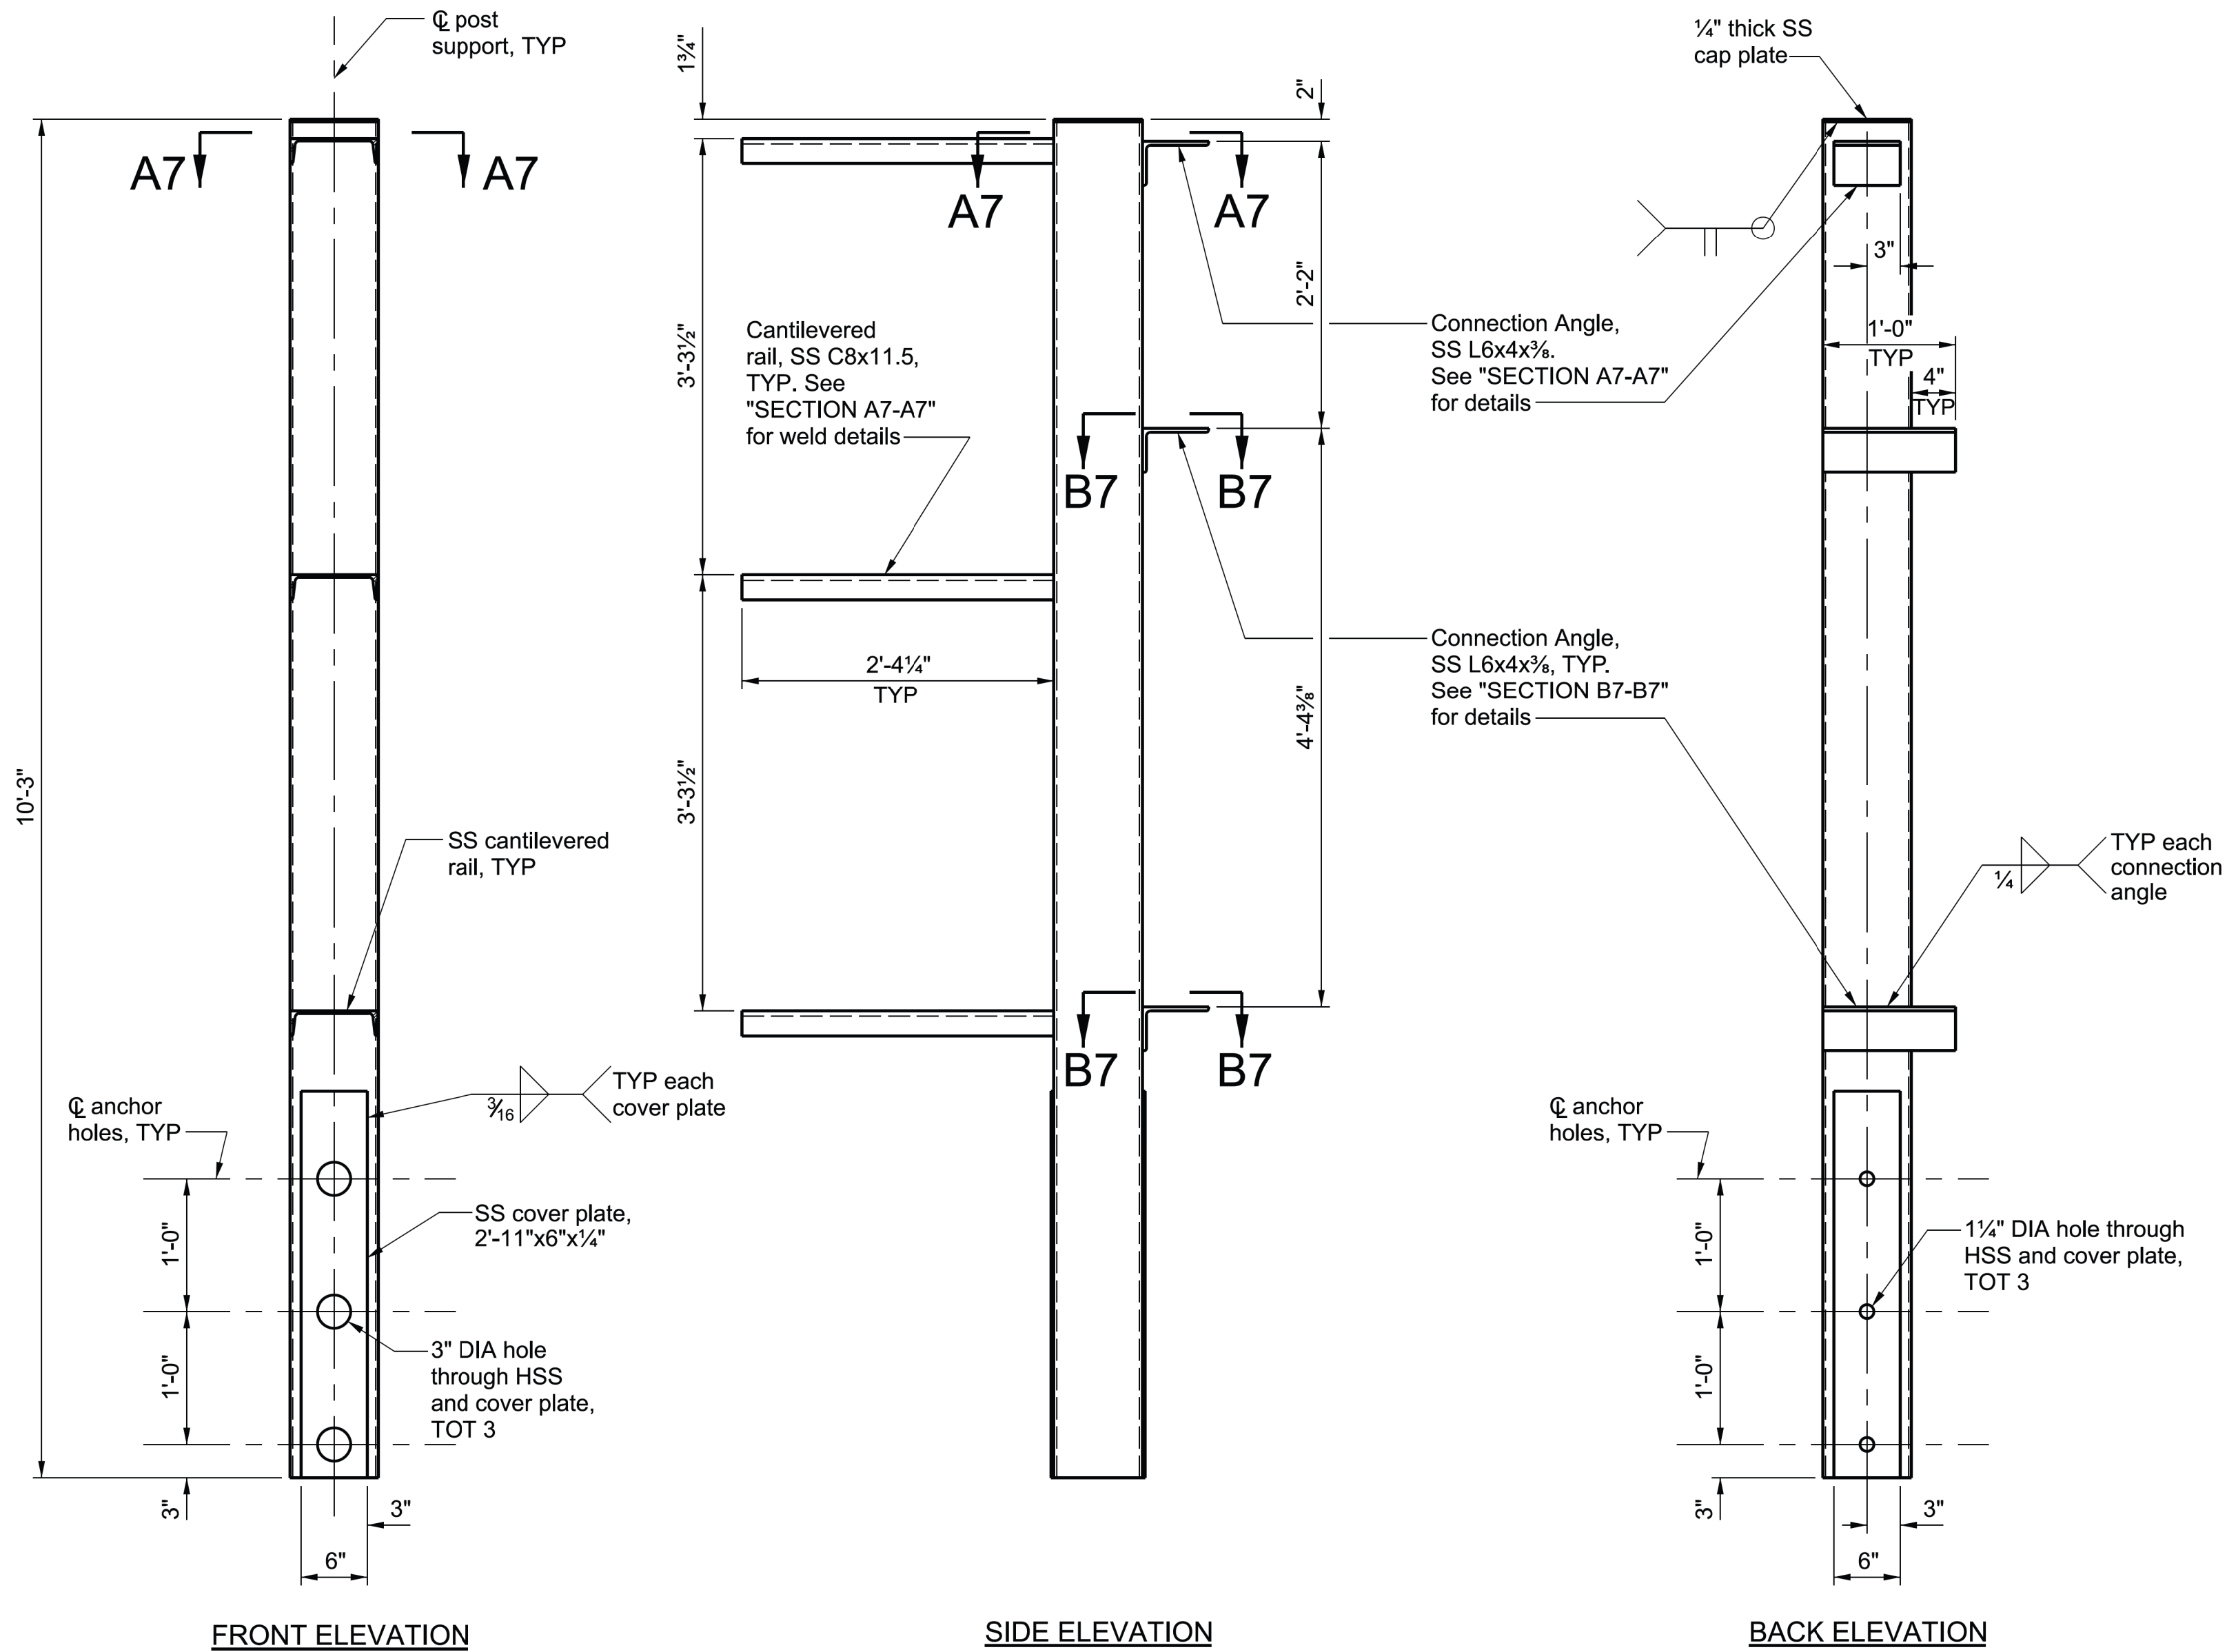


**HIGH END PANEL POST SUPPORT DETAILS (SHT 5)**


SCALE: 1"=1'-0"  
 NOTE: Fabricate one high end panel post support as shown. Fabricate one high end panel post support with connection angles and cantilevered rails installed on the opposite hand.

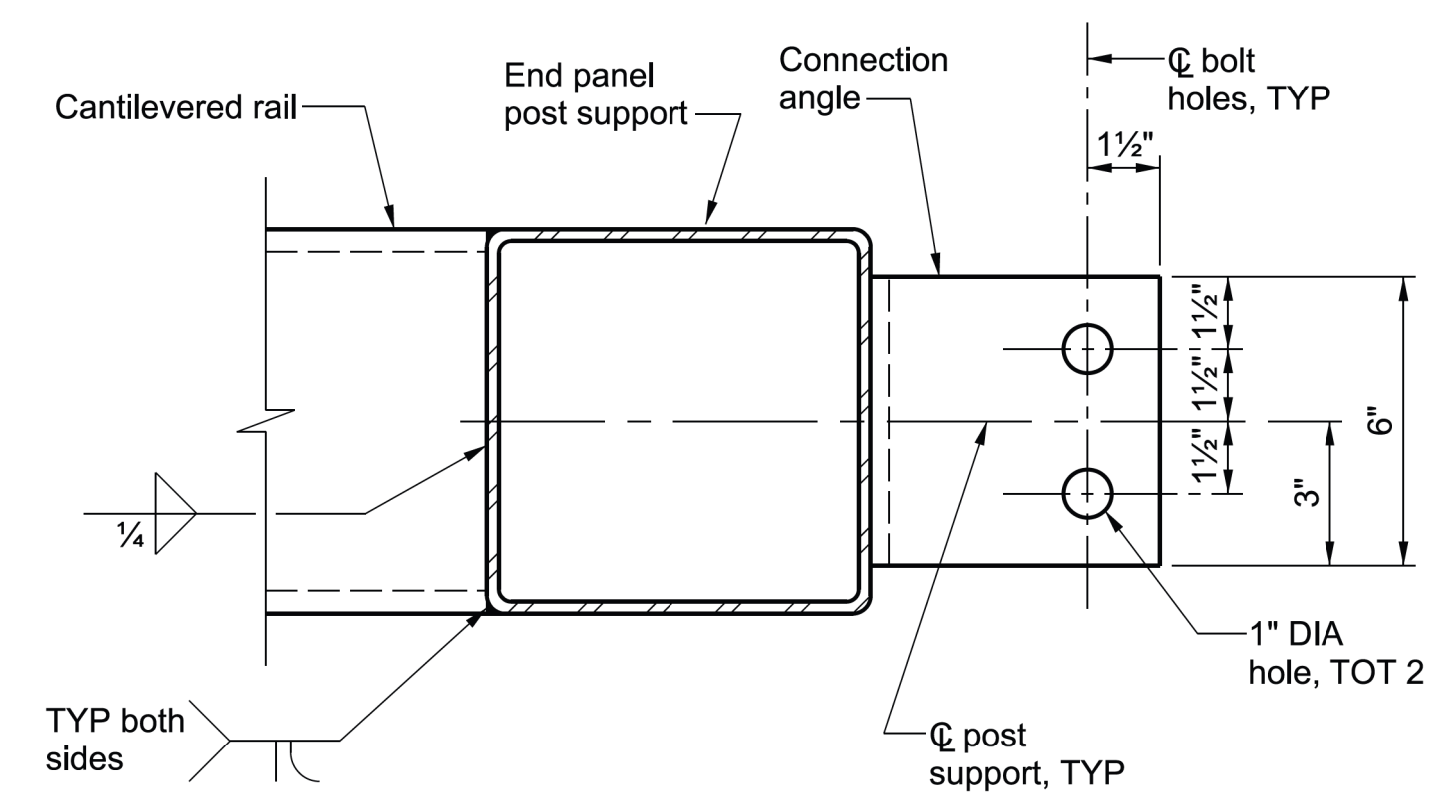

**SECTION A7-A7**  
SCALE: 3"=1'-0"

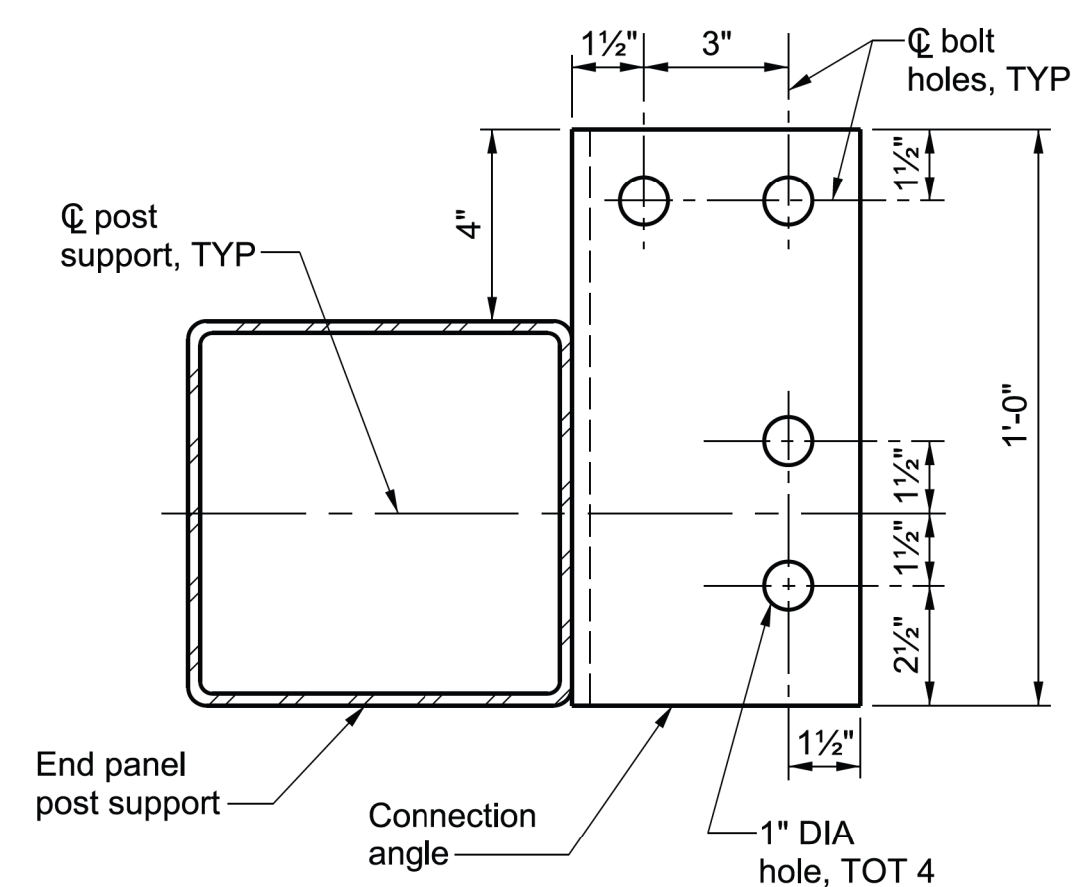


**SECTION B7-B7**  
SCALE: 3"=1'-0"

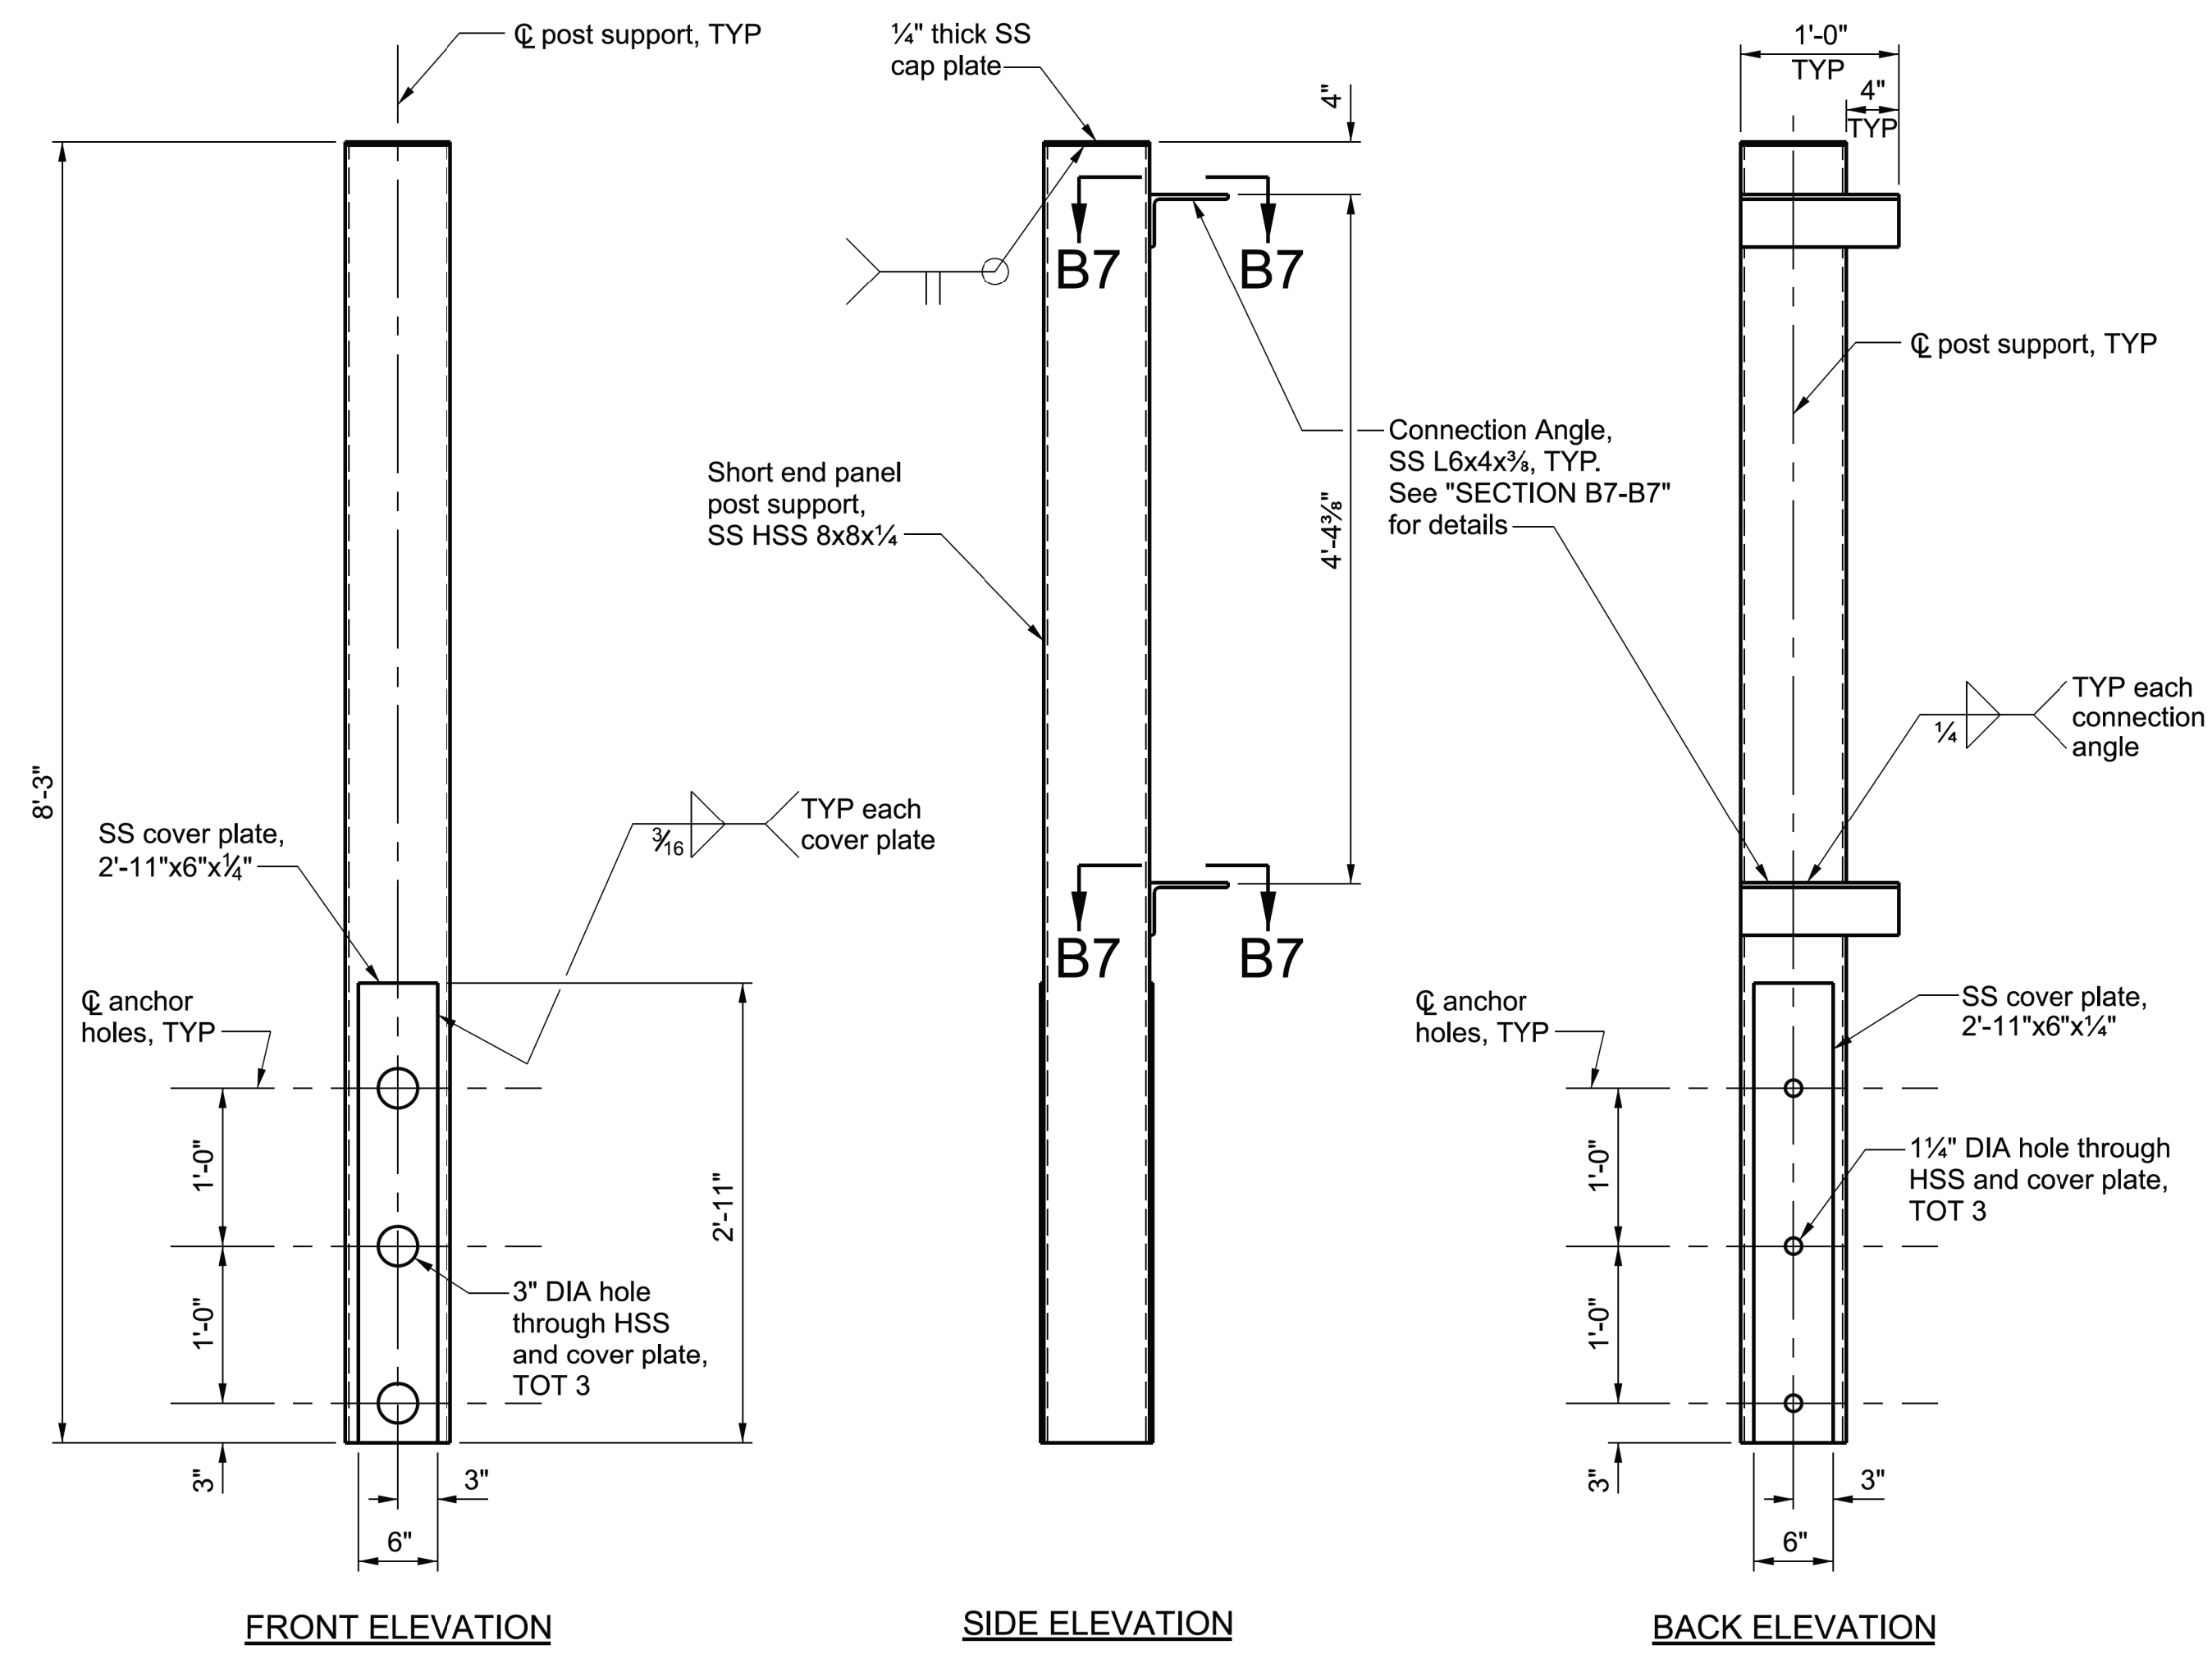


**SHORT END PANEL POST SUPPORT DETAILS (SHT 6)**

SCALE: 1"=1'-0"  
 NOTE: Fabricate one short end panel post support as shown. Fabricate one short end panel post support with connection angles and cantilevered rails installed on the opposite hand.

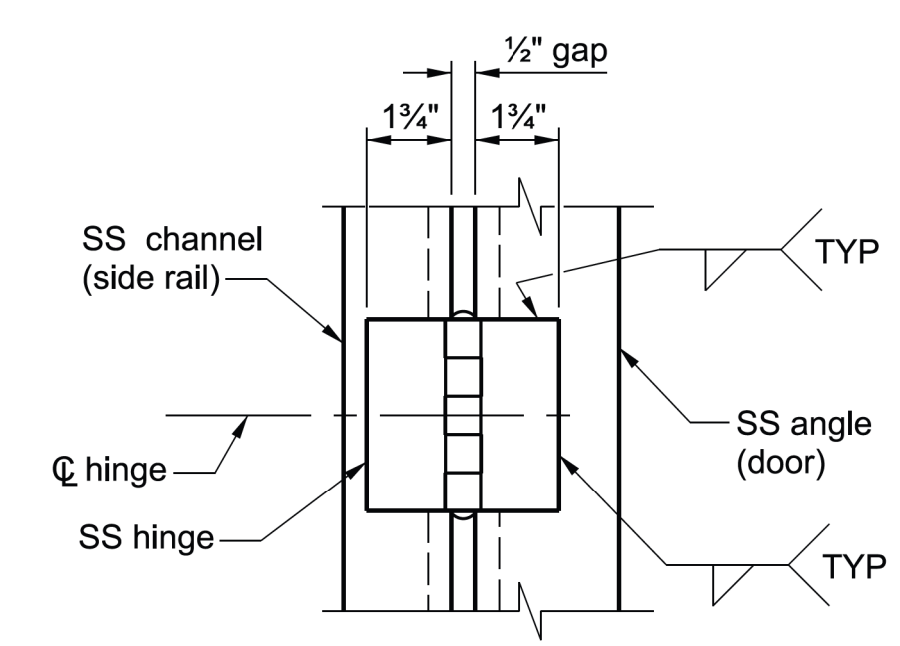


**HINGE DETAIL (SHT 5)**  
SCALE: 3"=1'-0"

NOTE: Hinge shall be 316 SS, nonremovable pin, 4" x 2" x 0.180" leaves with no holes, 3/8" DIA pin, 4" Overall Width.

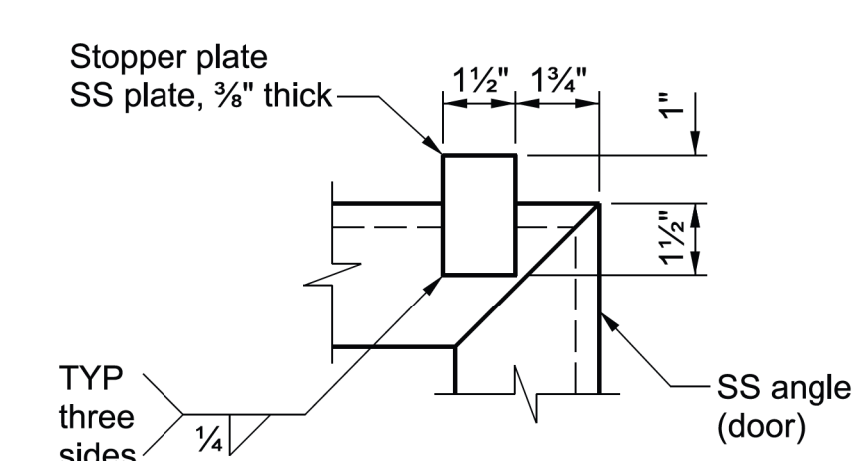


**STOPPER PLATE DETAIL (SHT 5)**  
SCALE: 3"=1'-0"

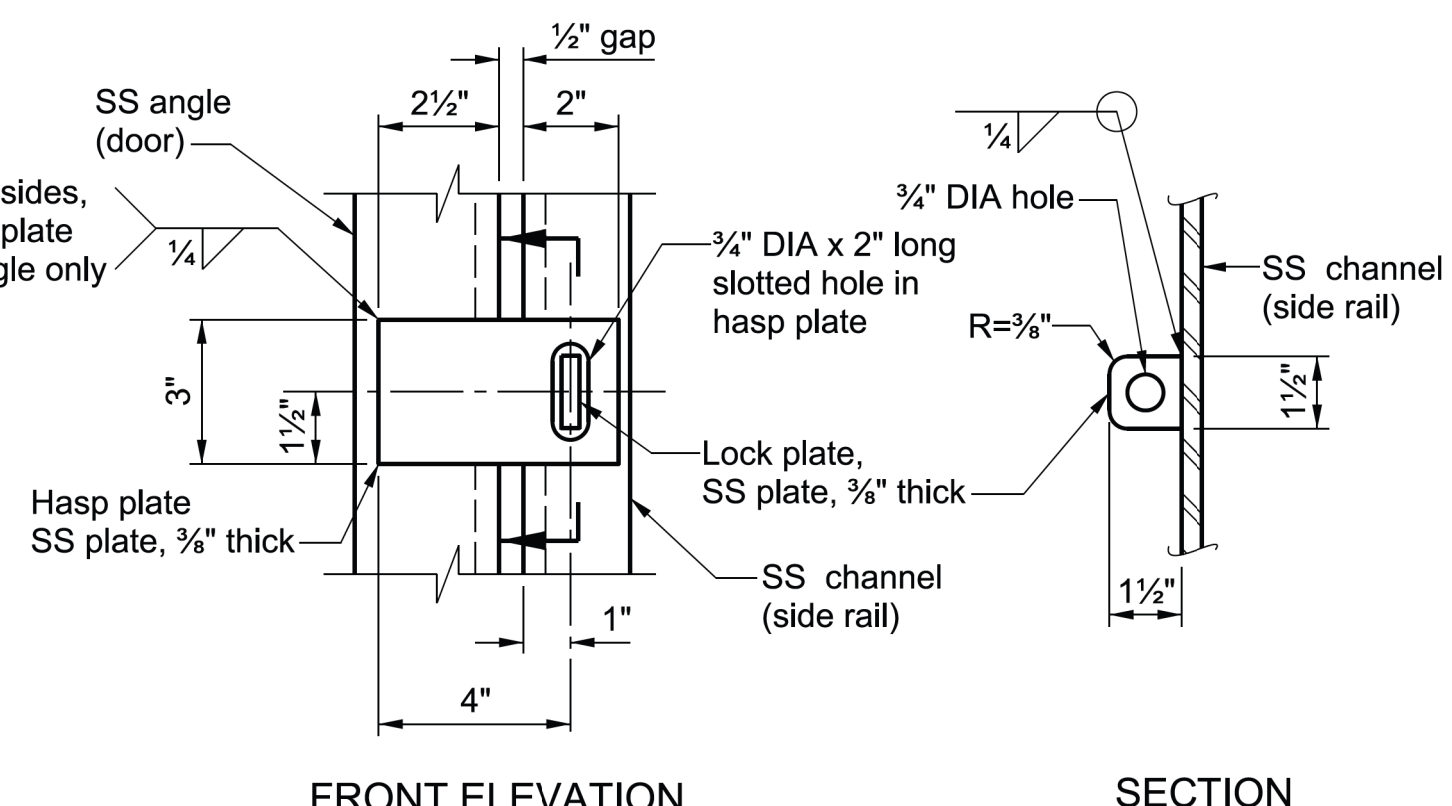

**HASP DETAIL (SHT 5, 6)**  
SCALE: 3"=1'-0"

DATE	MARK	DESCRIPTION

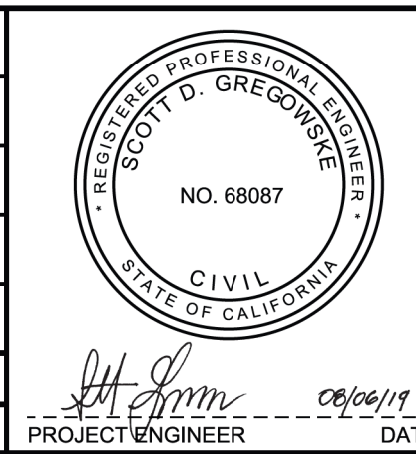


LOS ANGELES COUNTY PUBLIC WORKS  
**PROJECT NO. 275-513**  
 OCEAN OUTLET MODIFICATIONS  
 (STA. 0+87 - 3+64)  
 PROJECT ID NO. FCC0001318  
 PROTECTION FENCE - STRUCTURAL DETAILS


DWG 275-513-D19.7 | PD PD053002 | SHEET 7 OF 11

**AS BUILT DRAWINGS**


CAD PROJECT FILE NAME: FCC0001318 - Project No. 275-513 Ocean Outlet Modifications.dgn  
 CHECKER: S. GREGOWSKIE  
 DESIGNER: J. LU  
 DRAFTER: N. NGUYEN

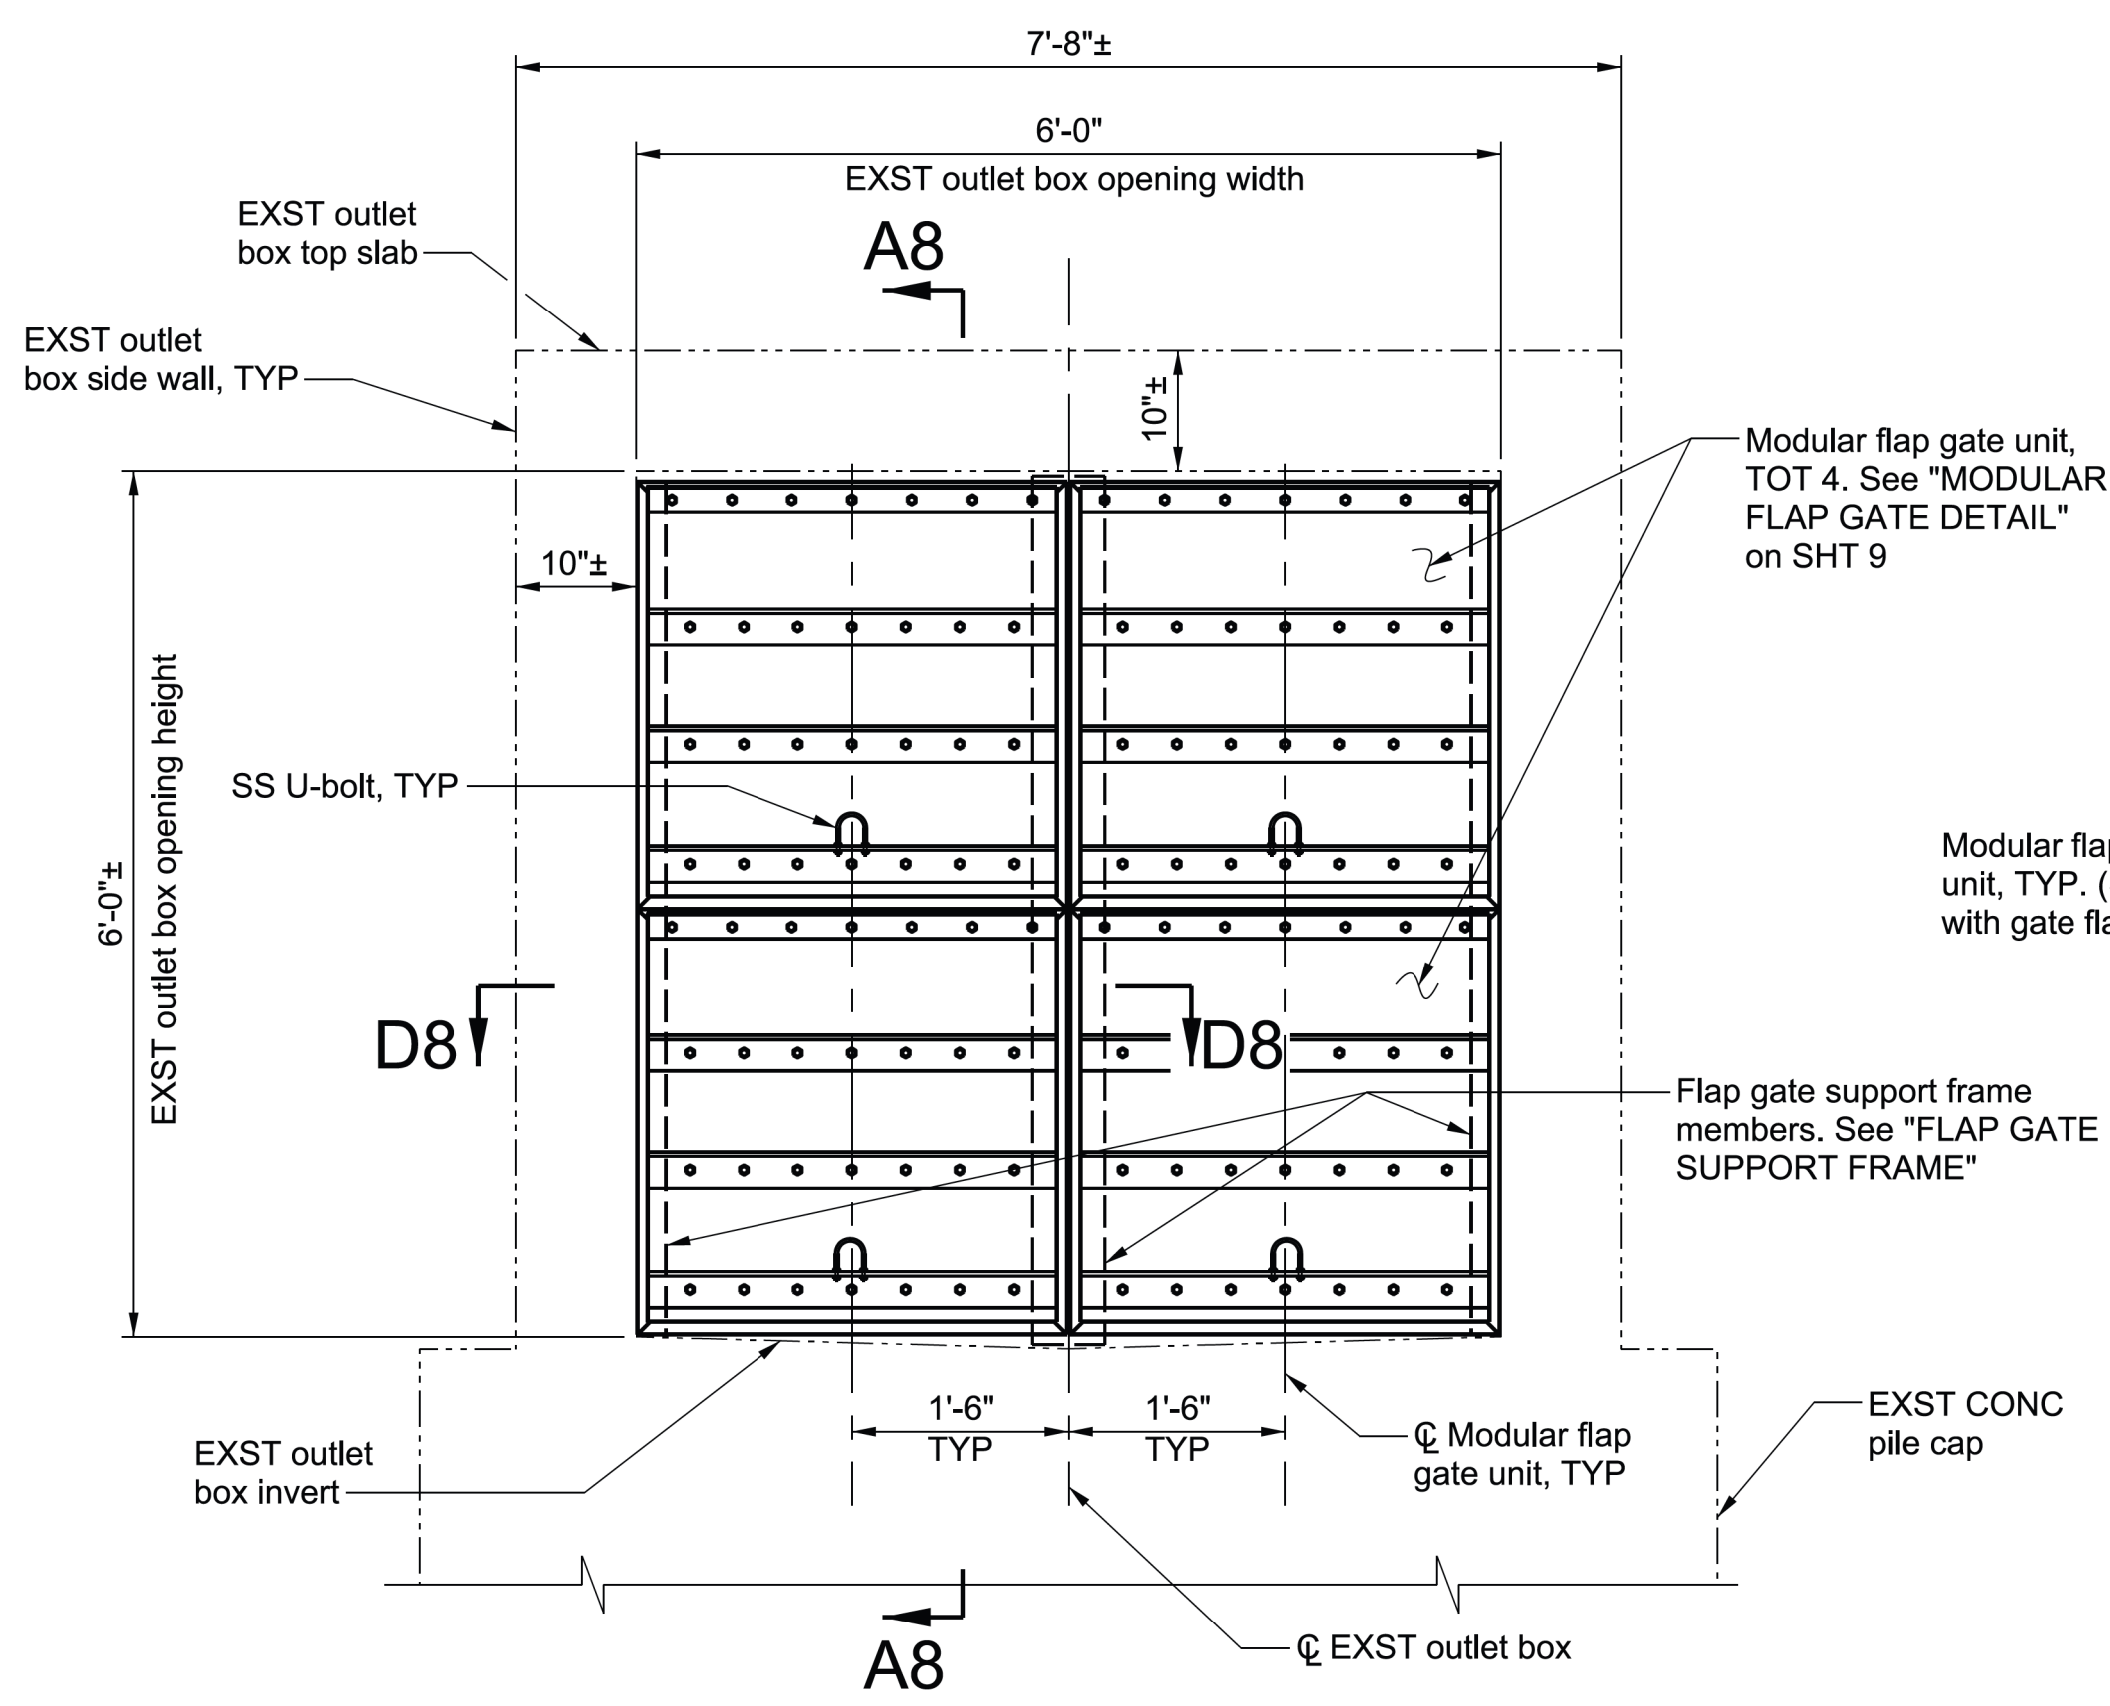


**MODULAR FLAP GATE (SHT 2)**  
 SCALE: 3/4"=1'-0"  
 NOTE: Front elevation view is shown.

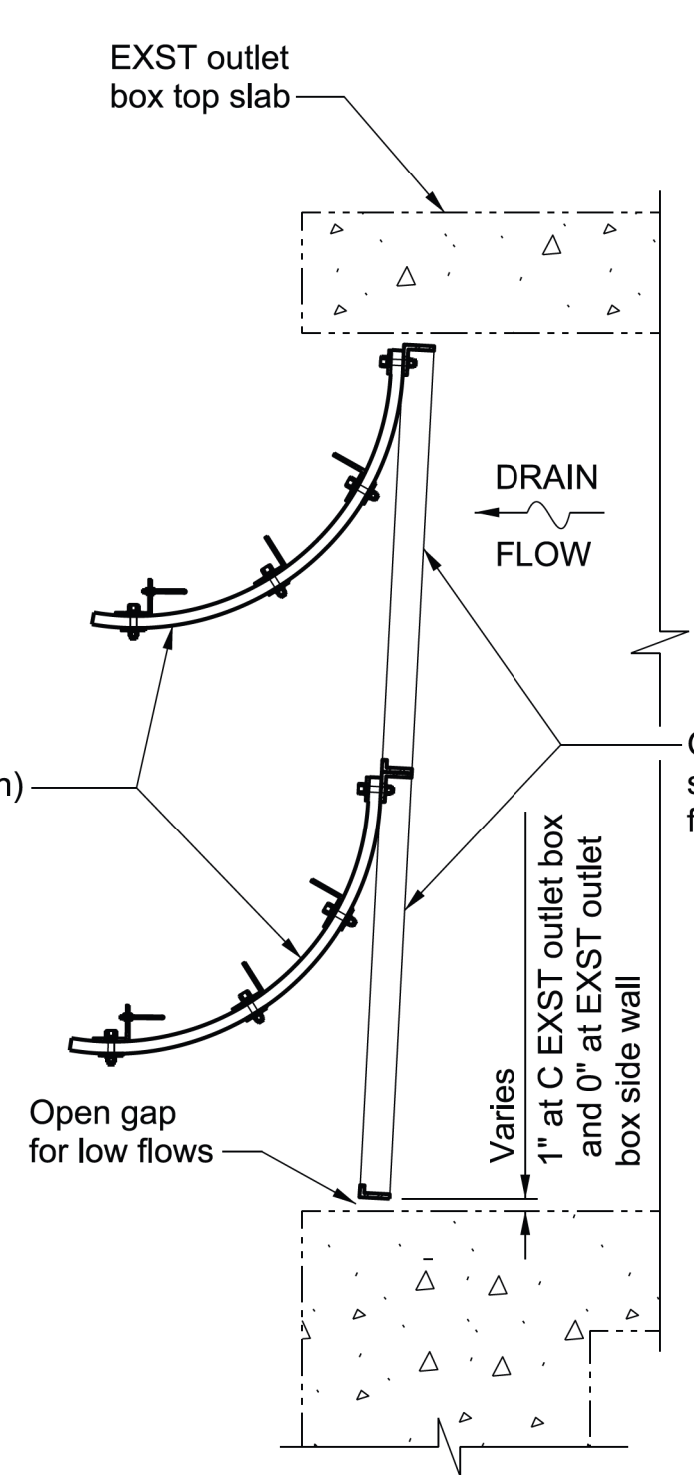


**SECTION A8-A8**  
 SCALE: 3/4"=1'-0"

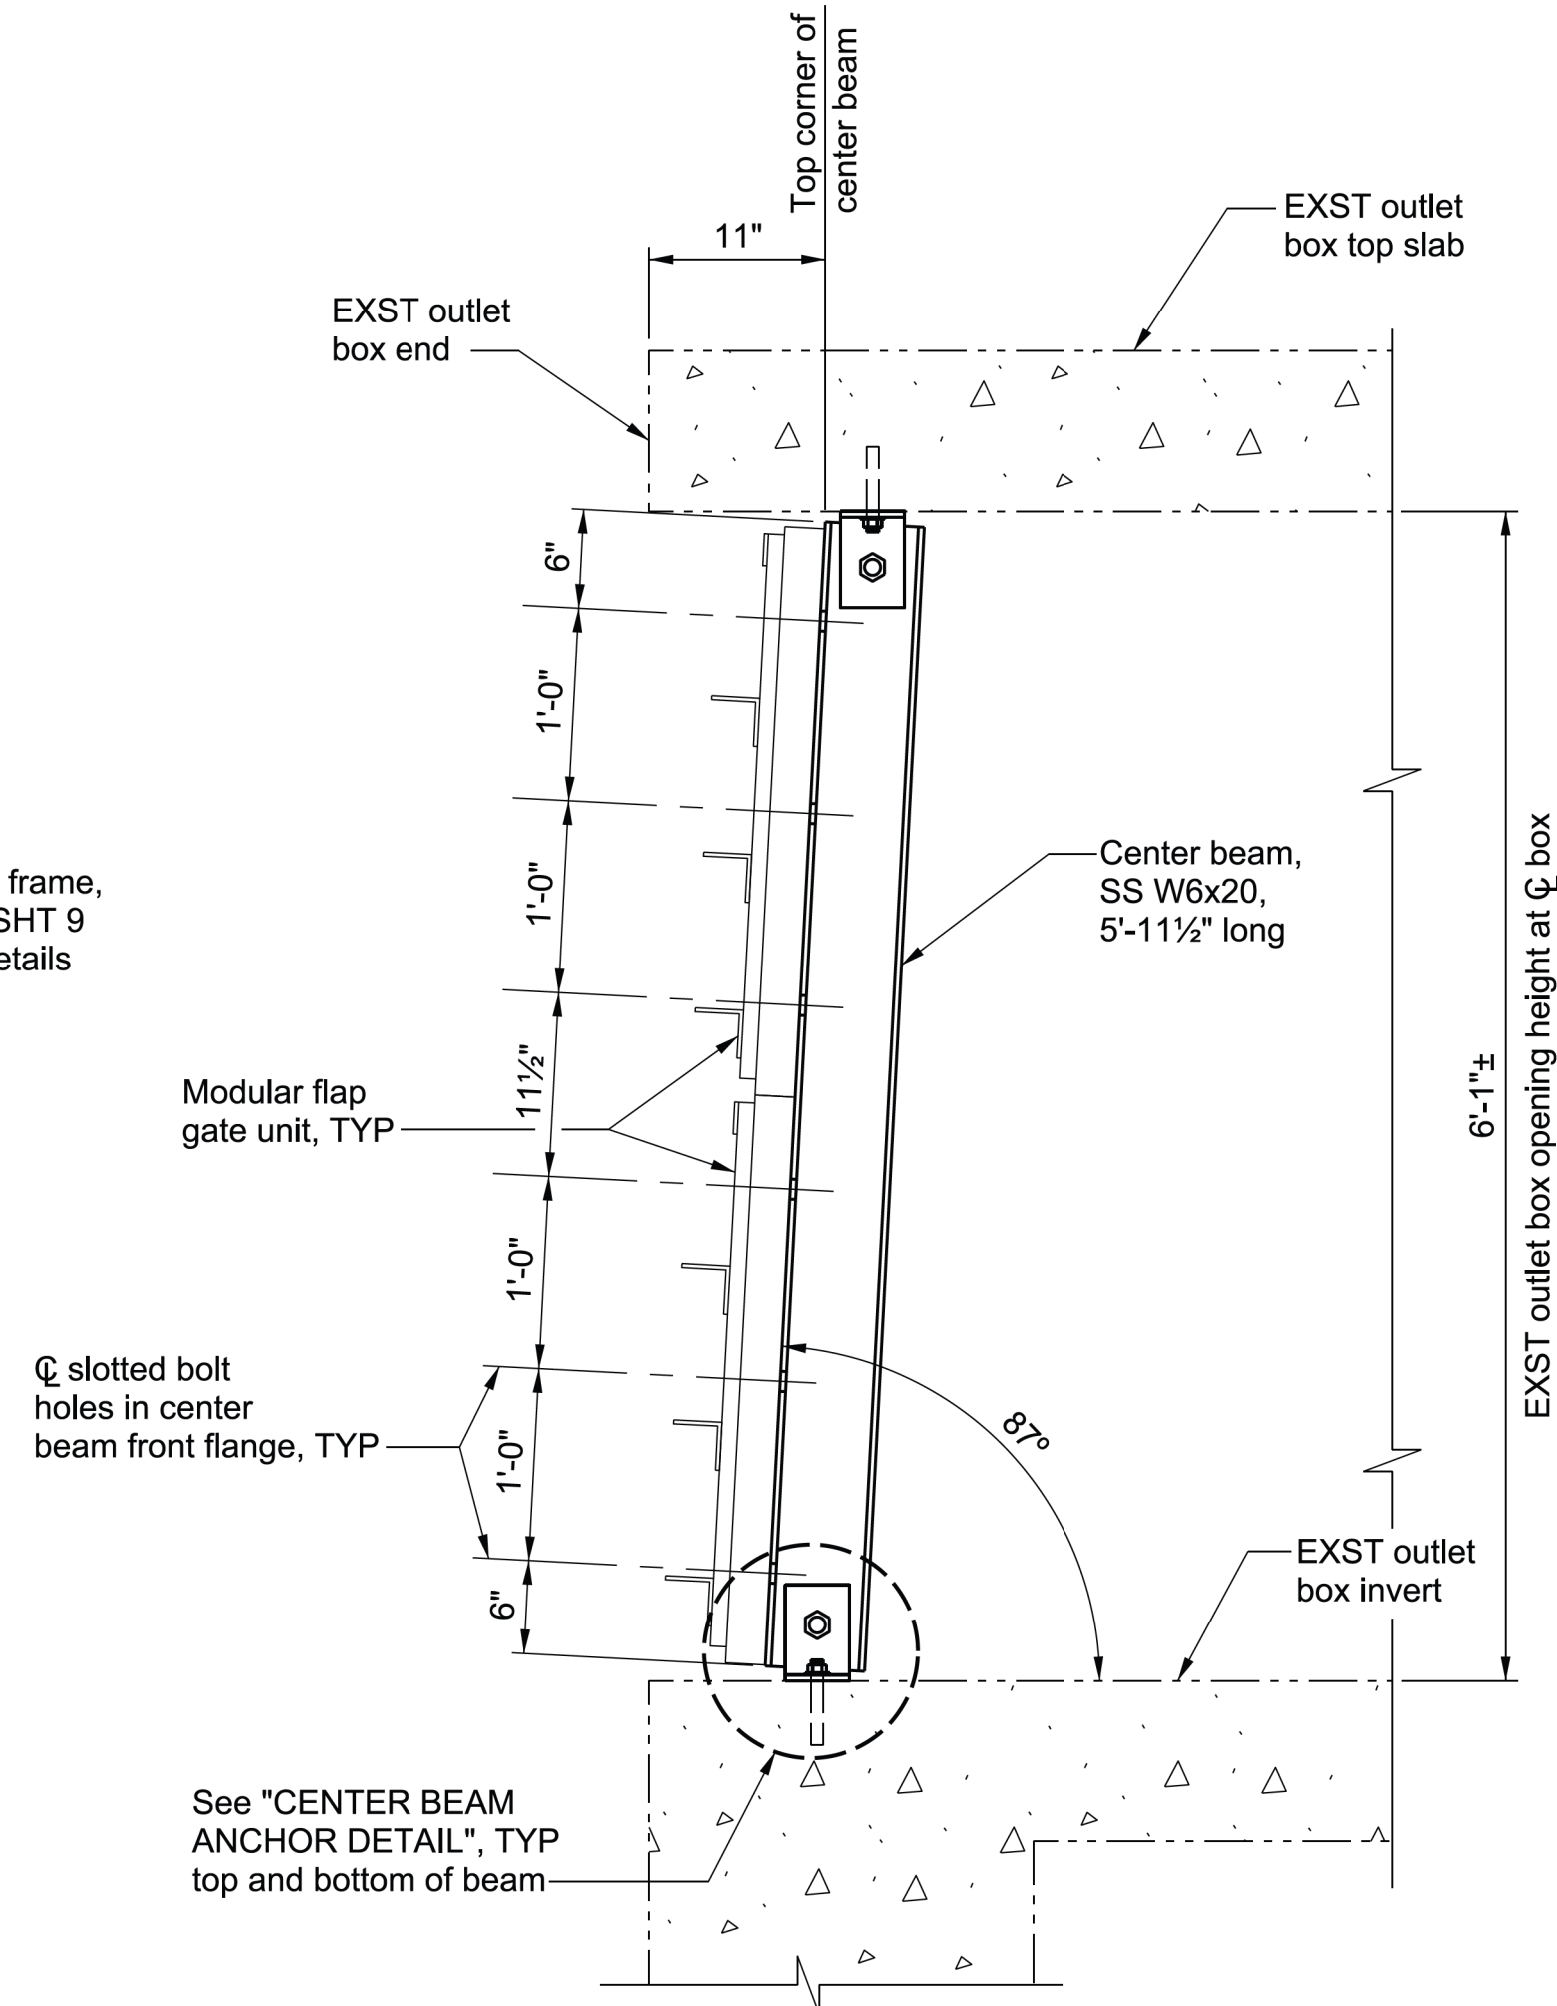

**SECTION B8-B8**  
 SCALE: 1"=1'-0"

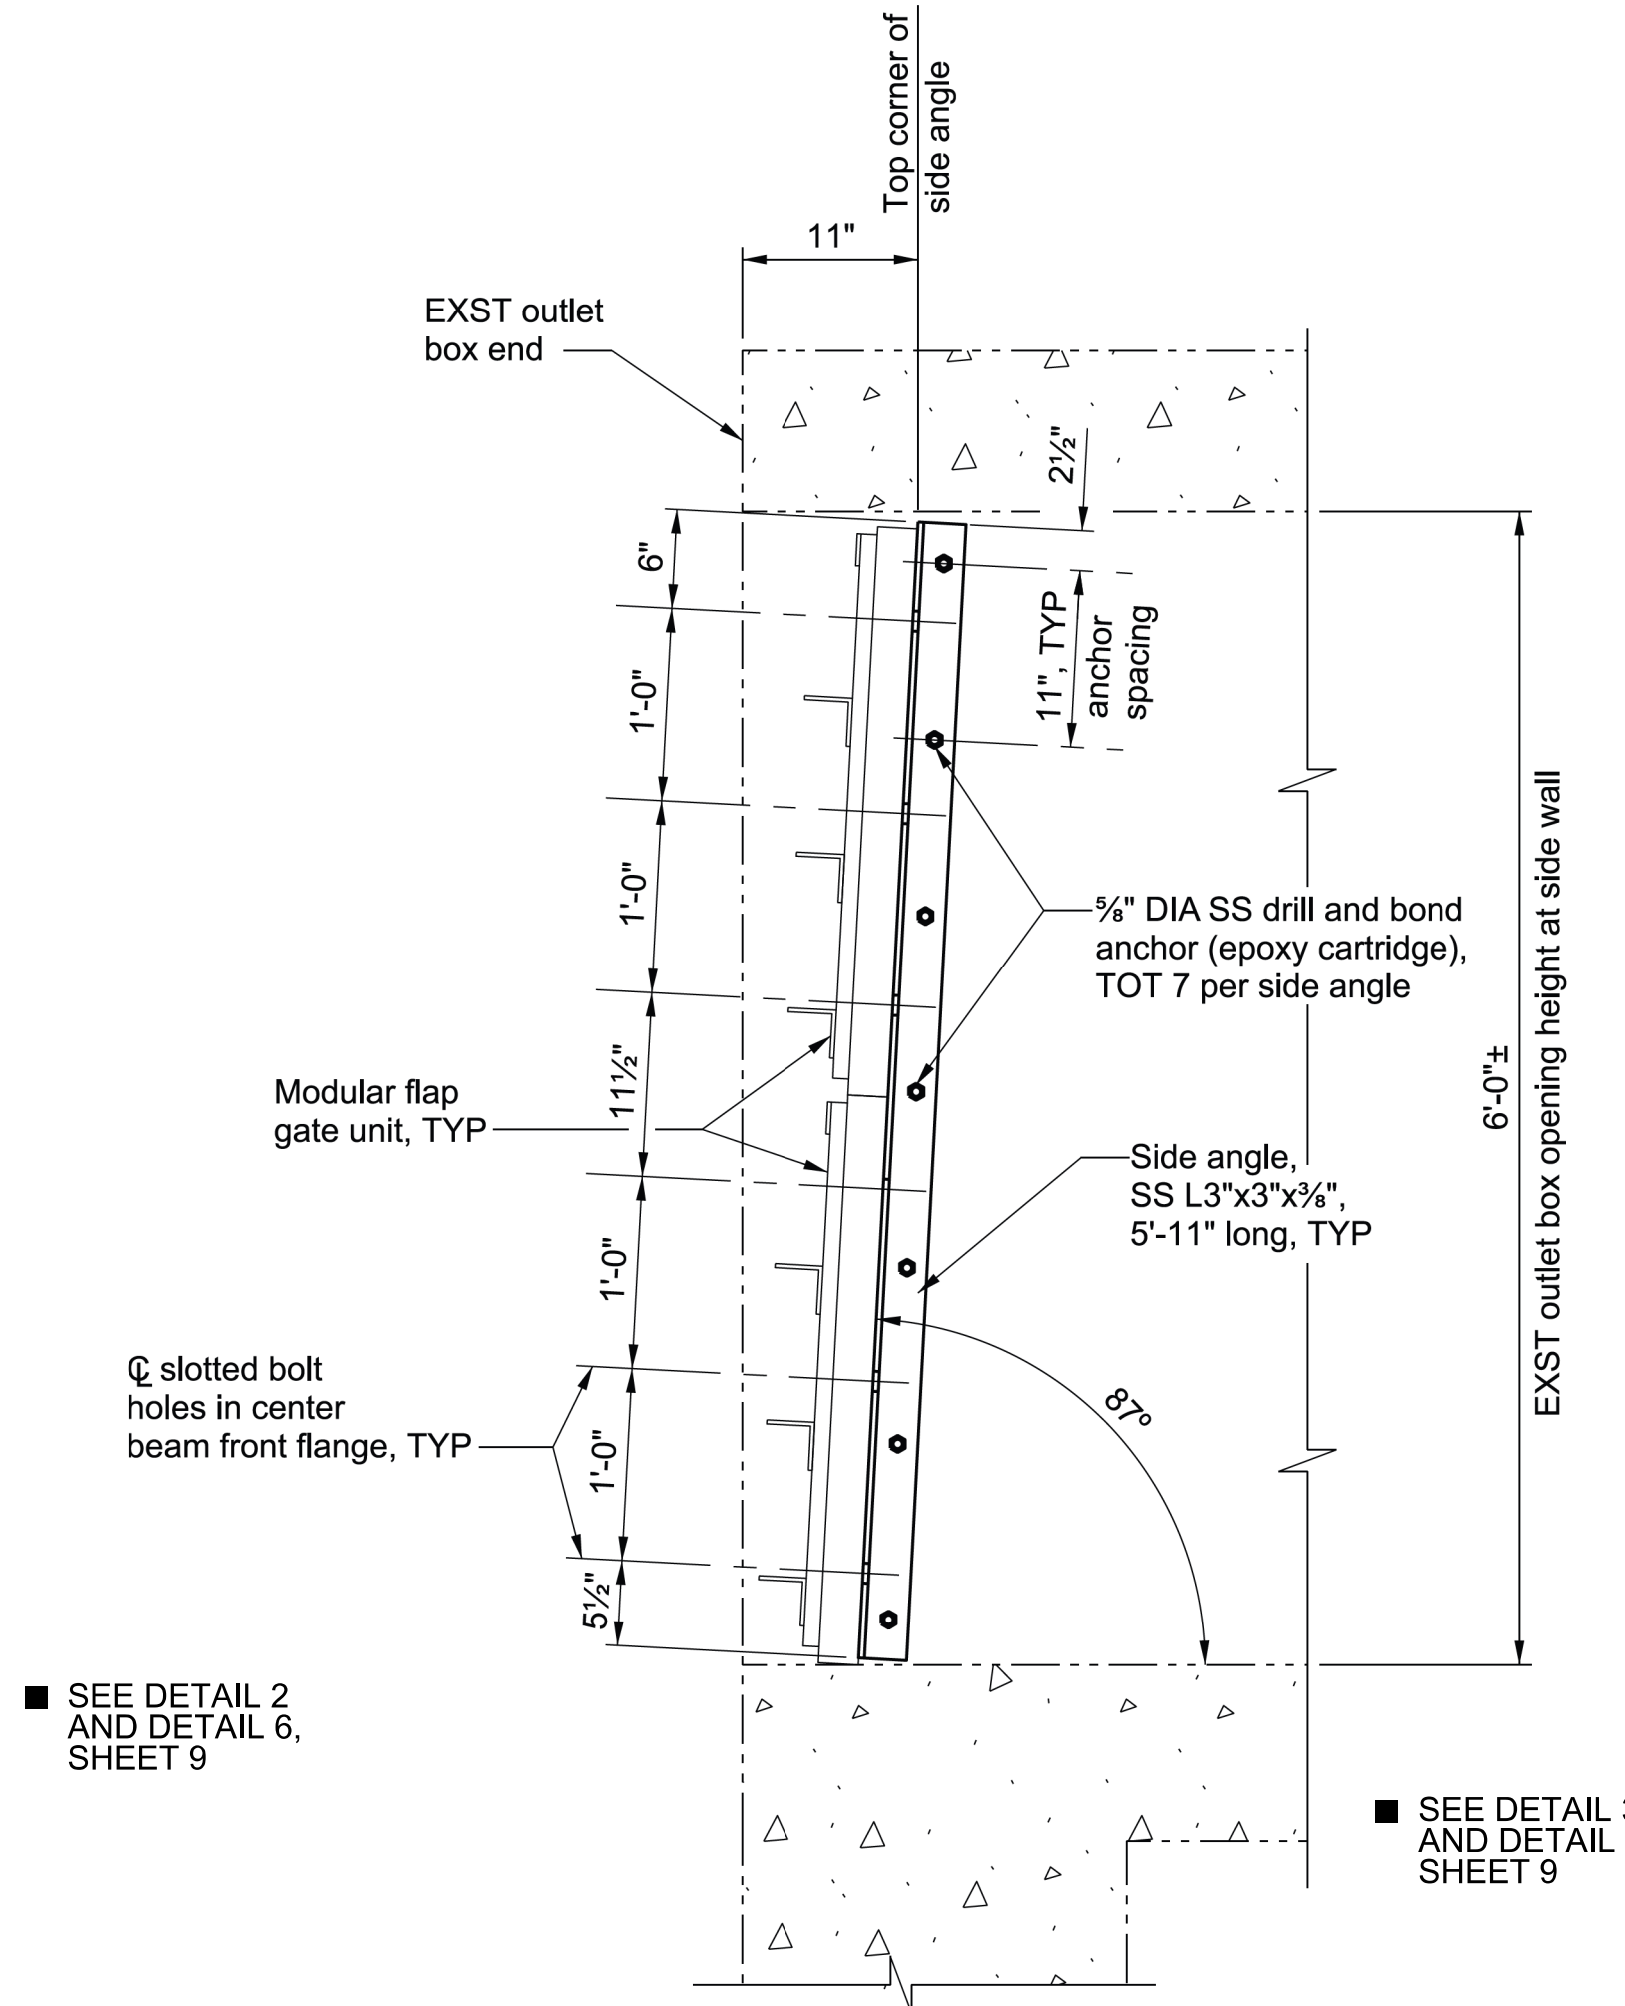


**SECTION C8-C8**  
 SCALE: 1"=1'-0"

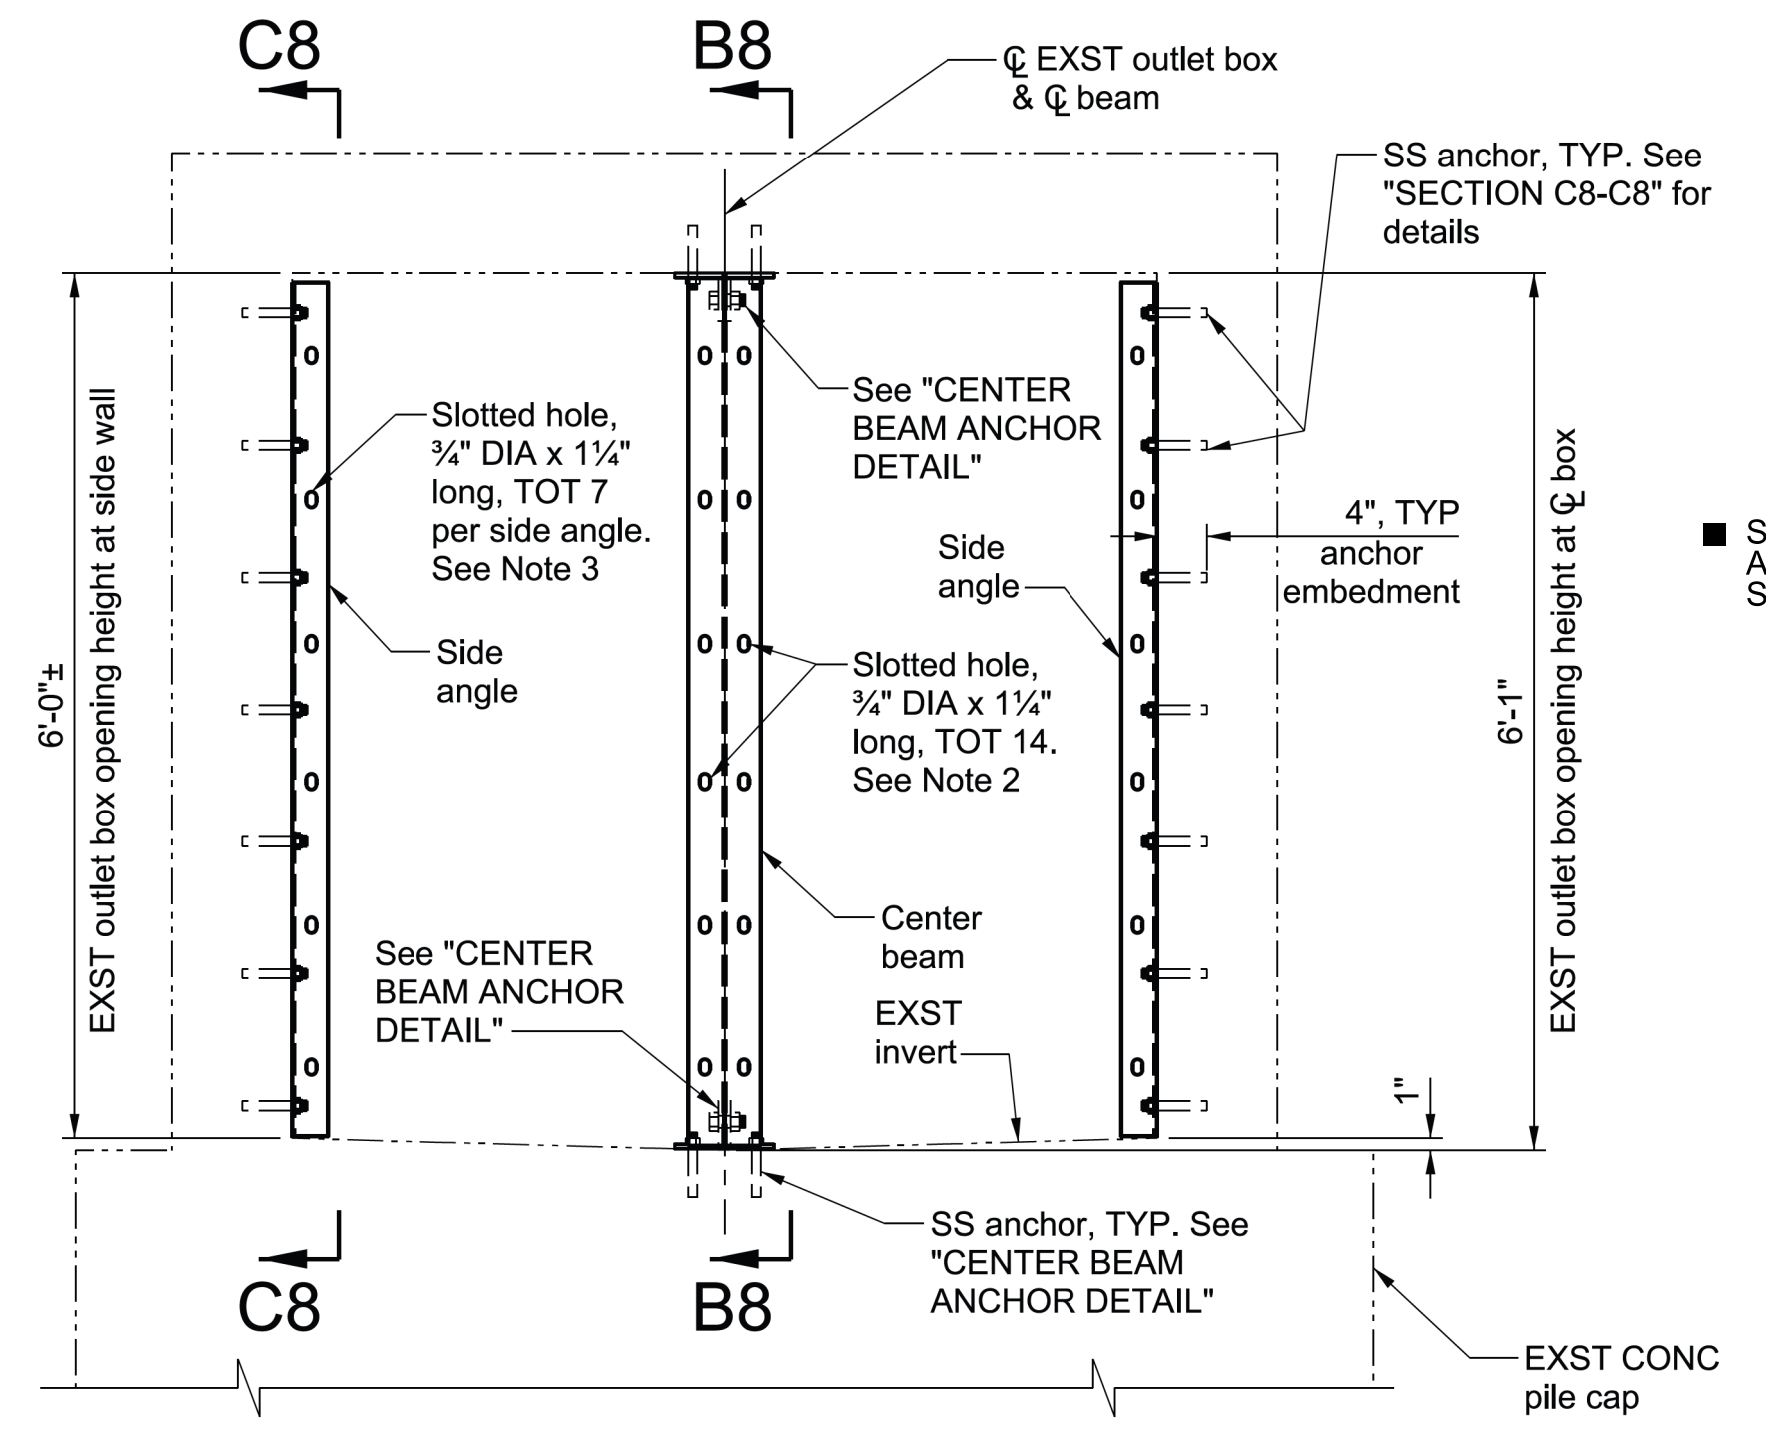


**FLAP GATE SUPPORT FRAME**  
 SCALE: 3/4"=1'-0"

- NOTES:**
1. Front elevation view is shown.
  2. See "SECTION B8-B8" and "SECTION D8-D8" for slotted hole spacing on center beam. Slotted holes only on front flange of beam.
  3. See "SECTION C8-C8" and "SECTION D8-D8" for slotted hole spacing on side angle.

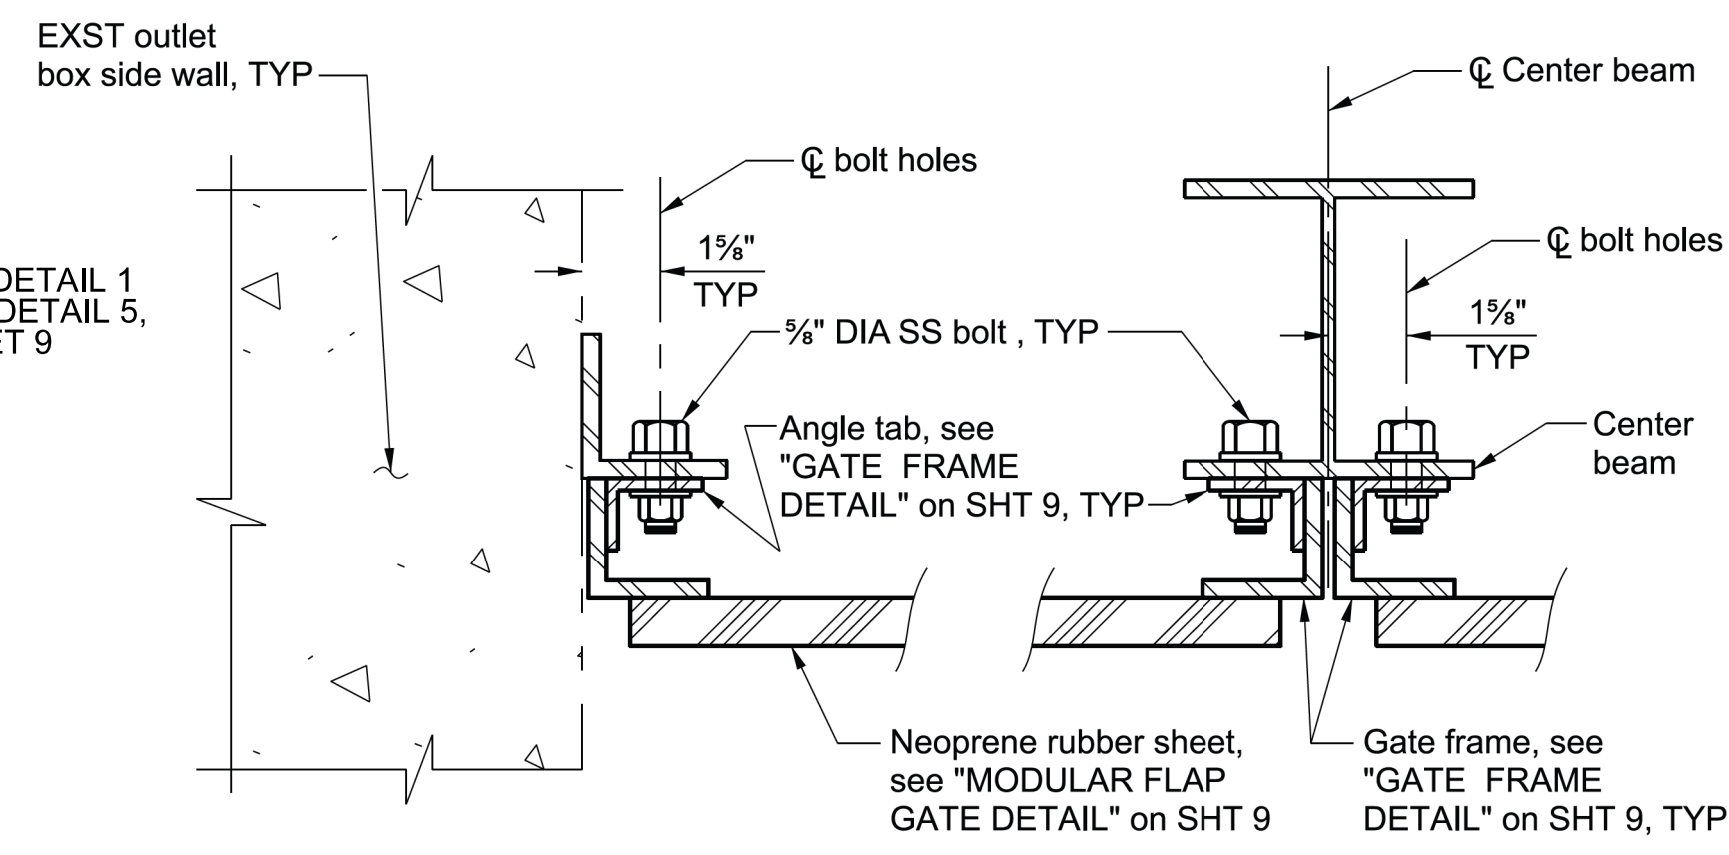


**SECTION D8-D8**  
 SCALE: 1 1/2"=1'-0"

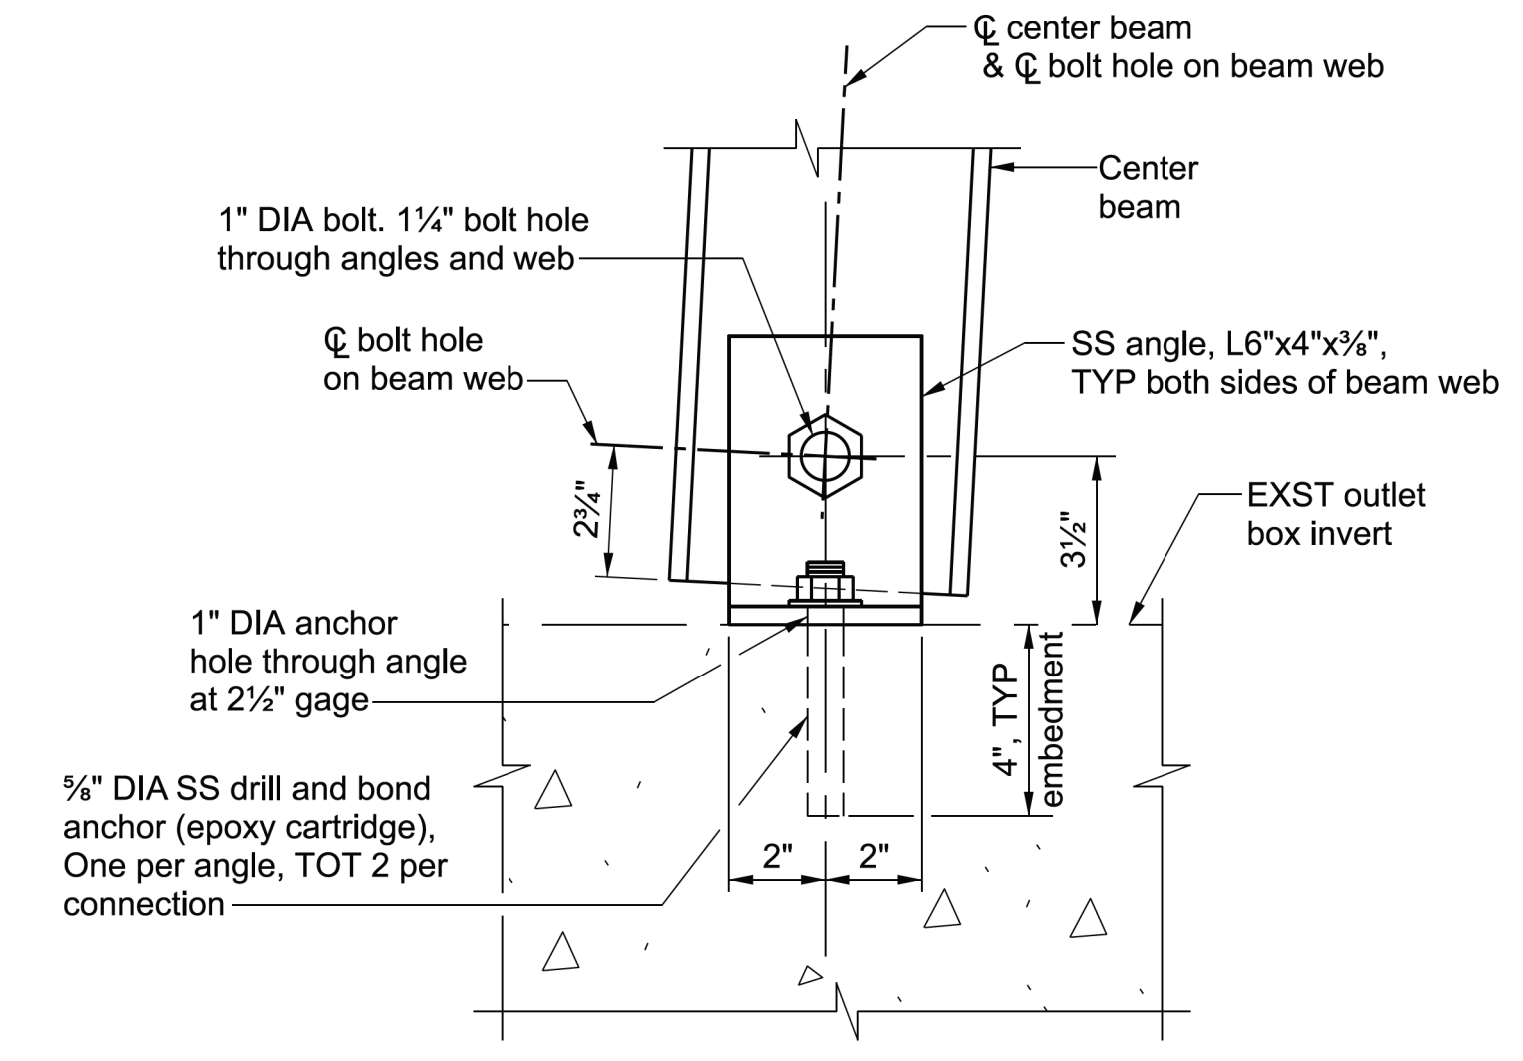

**CENTER BEAM ANCHOR DETAIL**  
 SCALE: 3"=1'-0"

DATE	MARK	DESCRIPTION
02/17/2022	■	AS BUILT REVISIONS
REVISIONS		

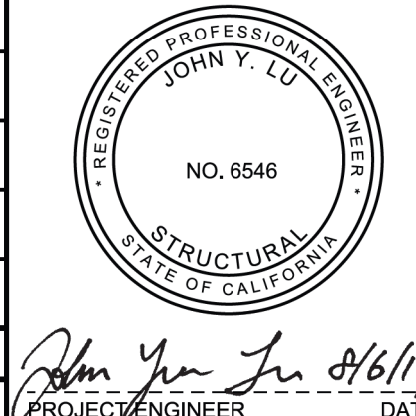


LOS ANGELES COUNTY PUBLIC WORKS  
**PROJECT NO. 275-513**  
 OCEAN OUTLET MODIFICATIONS  
 (STA. 0+87 - 3+64)  
 PROJECT ID NO. FCC0001318  
 MODULAR FLAP GATE - SECTIONS AND DETAILS I  
 DWG 275-513-D19.8 | PD PD053002 | SHEET 8 OF 11


**AS BUILT DRAWINGS**




CADD PROJECT FILE NAME: FCC0001318 - Project No. 275-513 Ocean Outlet Modifications.dgn  
 CHECKER: S. GREGOWSKIE  
 DESIGNER: J. LU  
 DRAFTER: N. NGUYEN

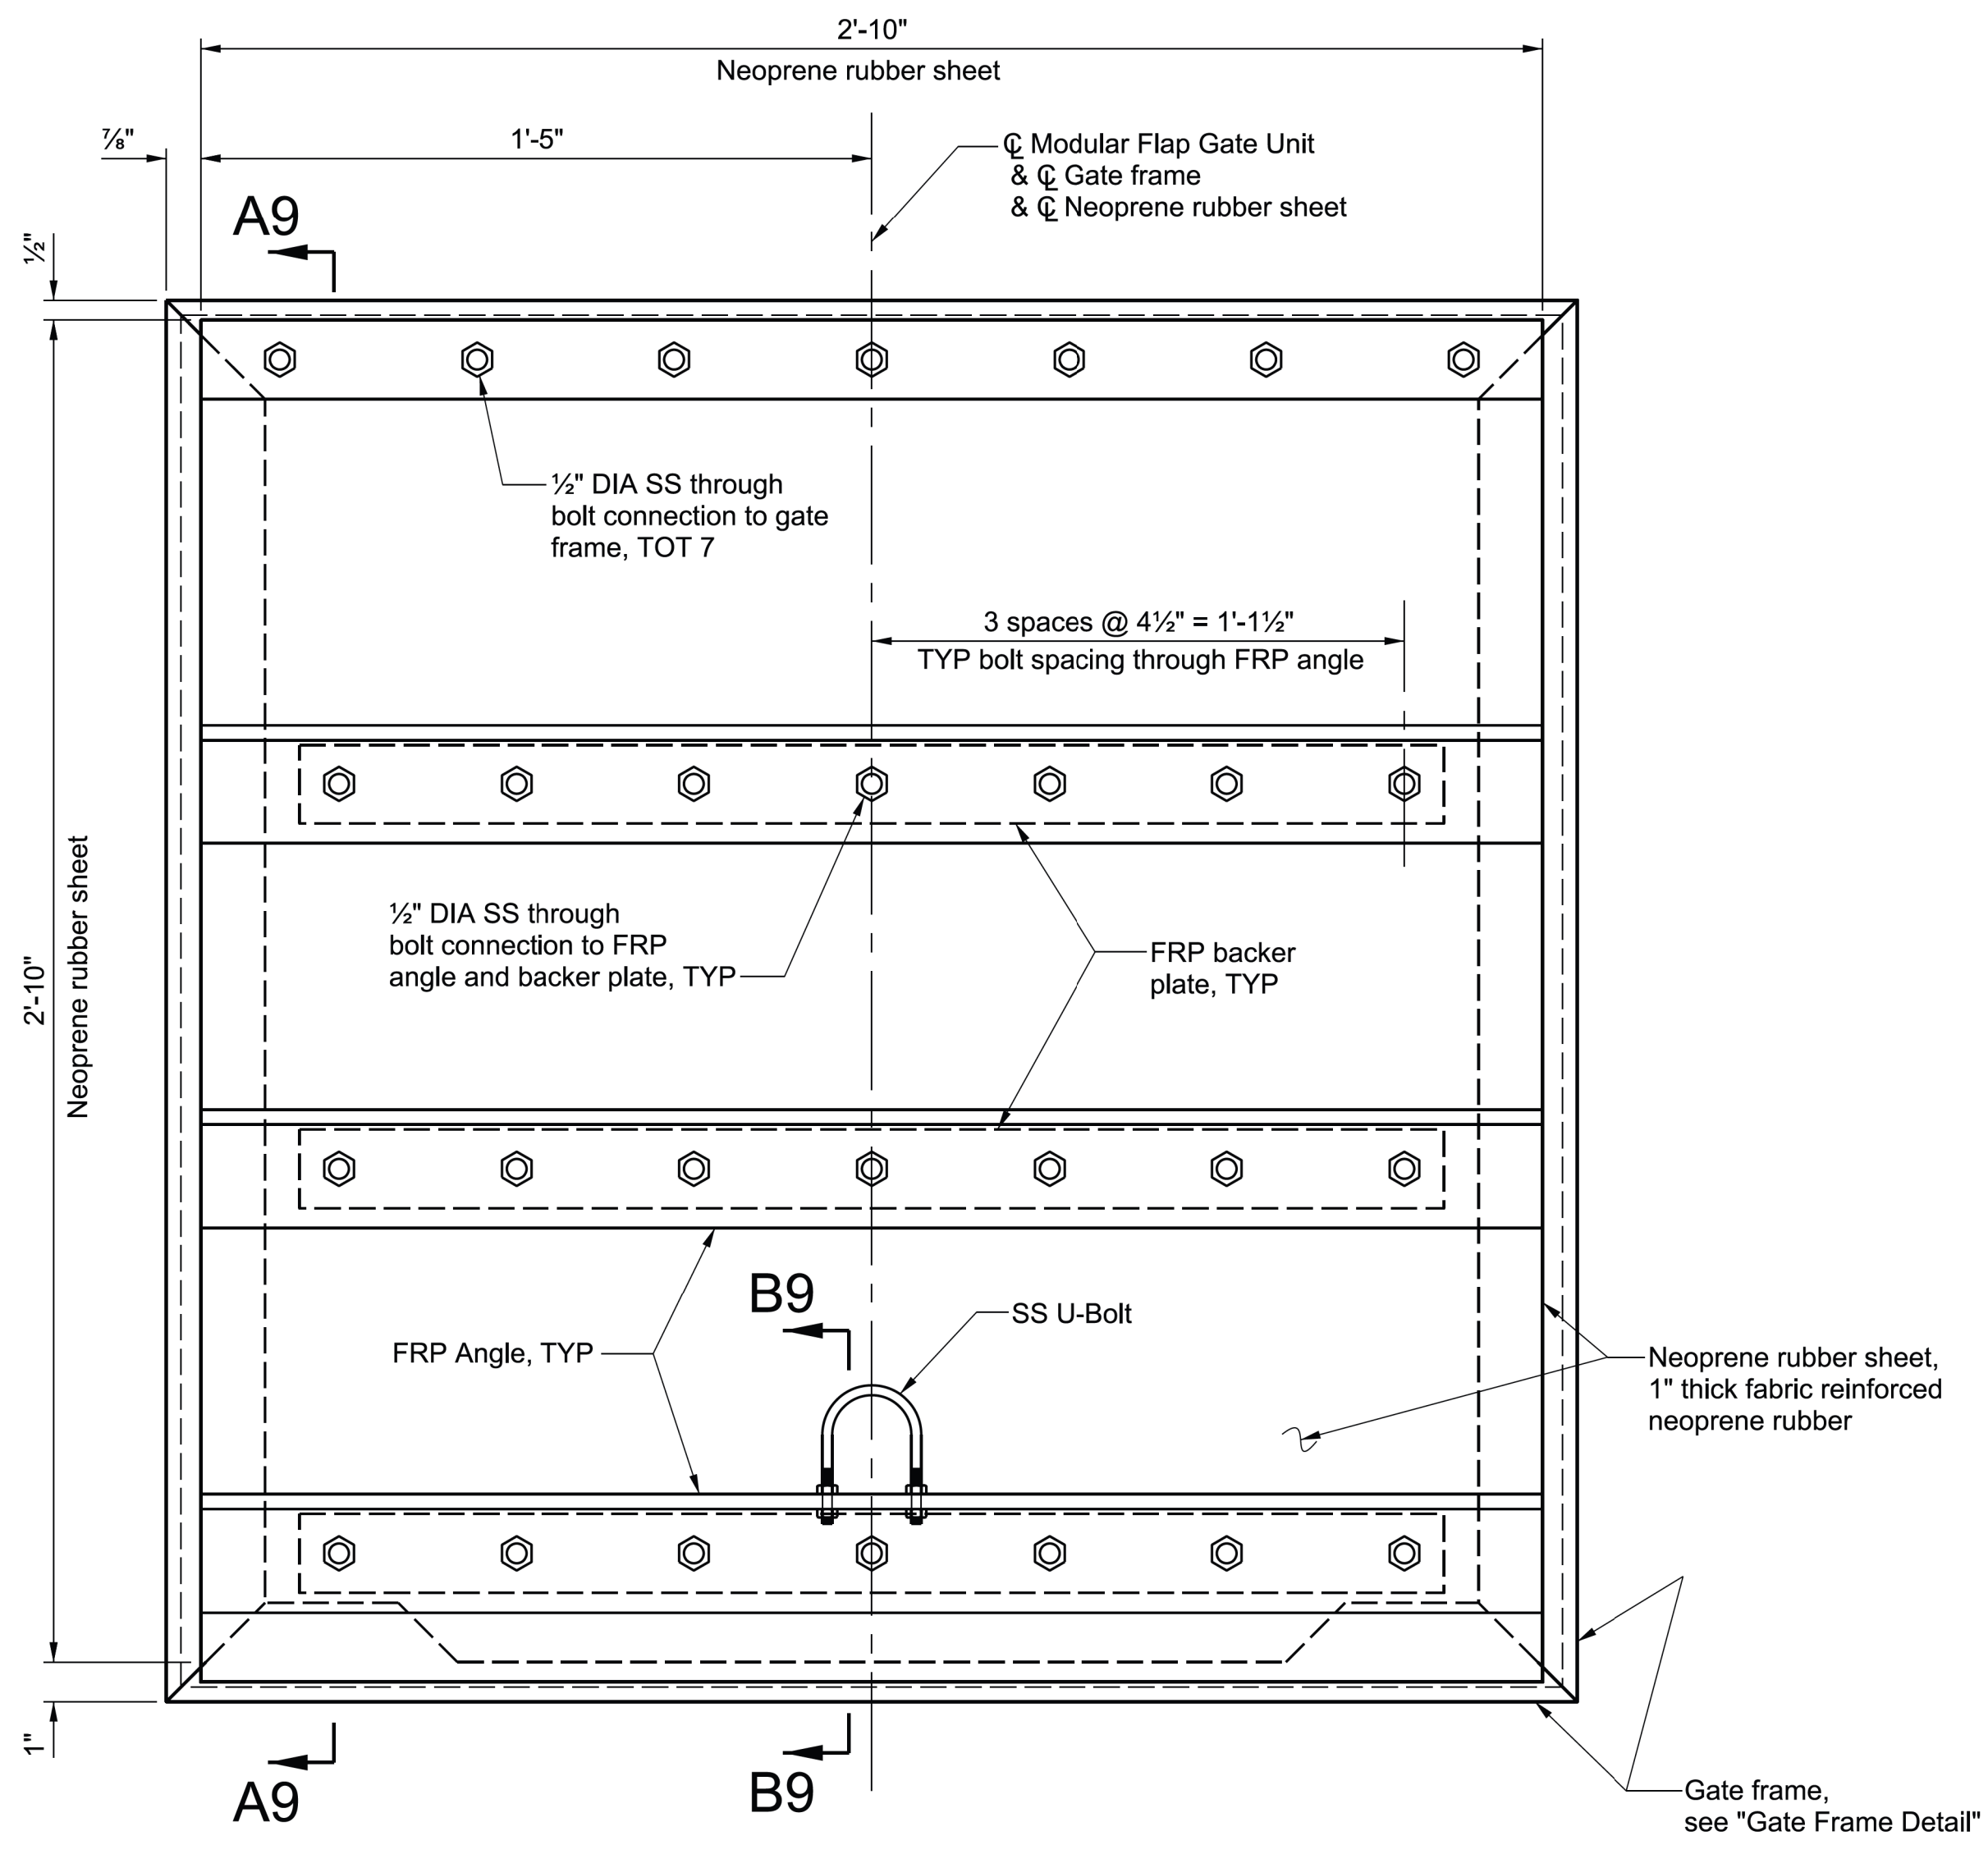


**MODULAR FLAP GATE DETAIL**  
 SCALE: 3"=1'-0"

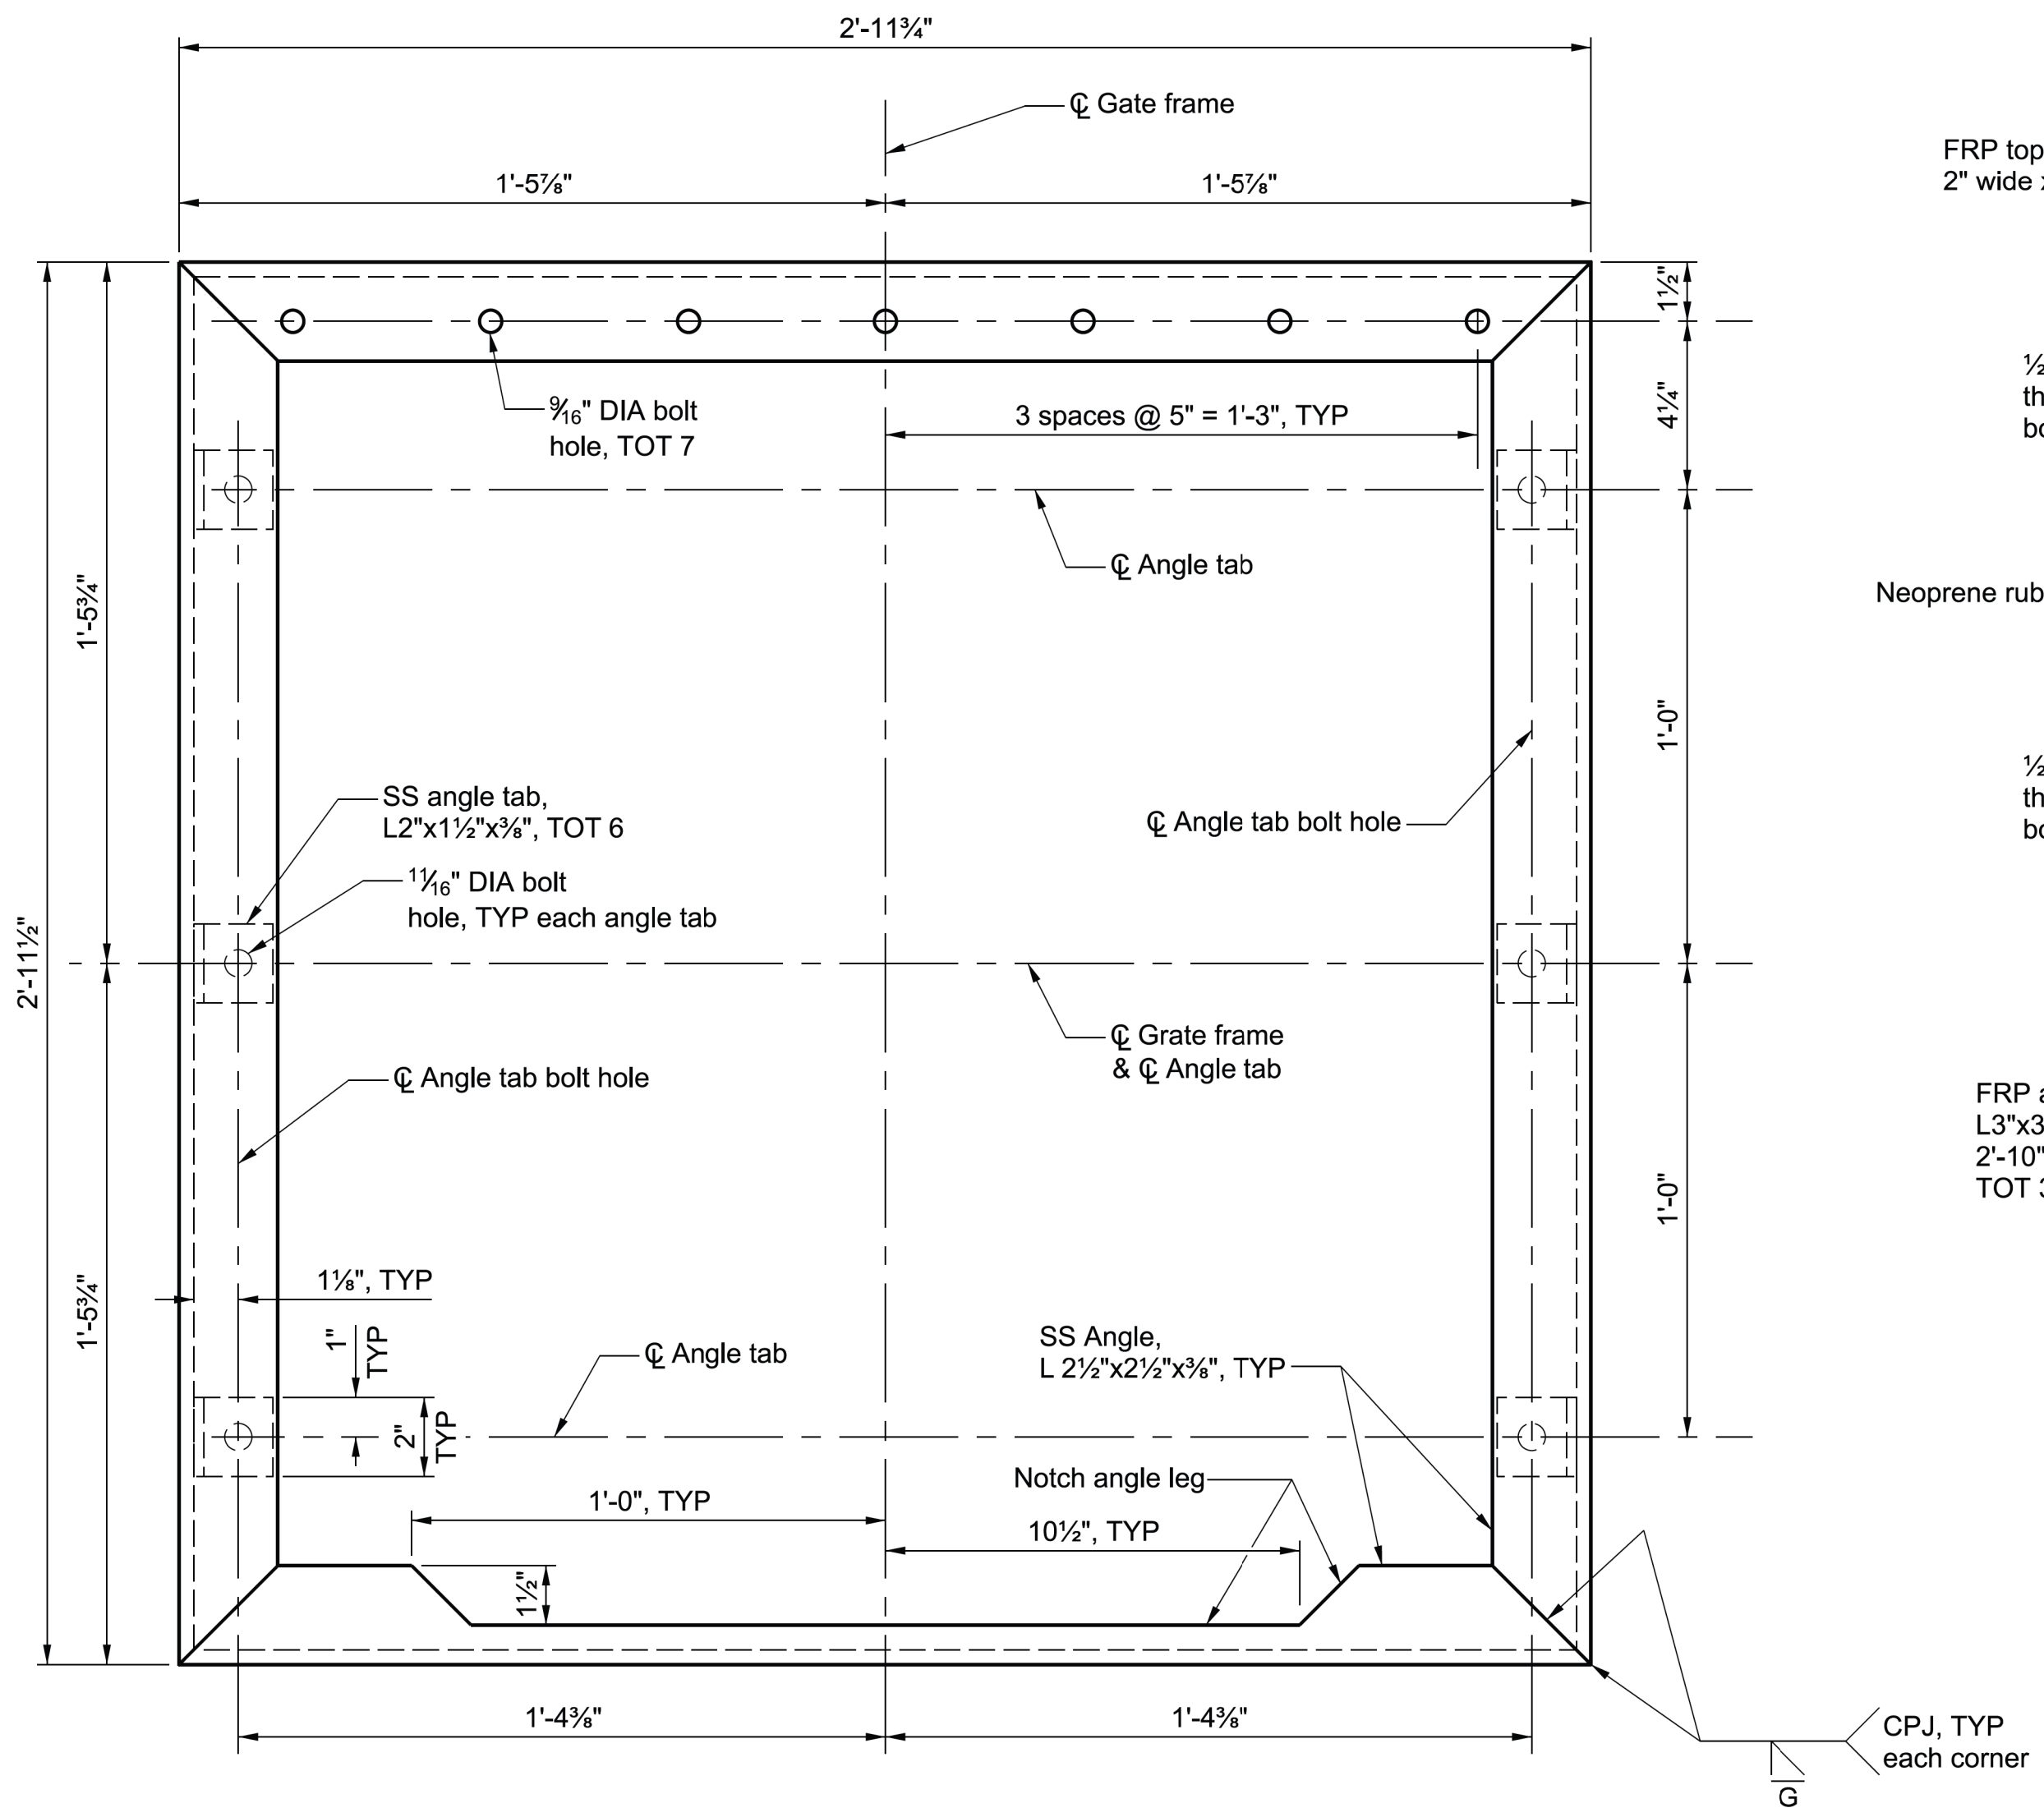

**GATE FRAME DETAIL**  
 SCALE: 3"=1'-0"

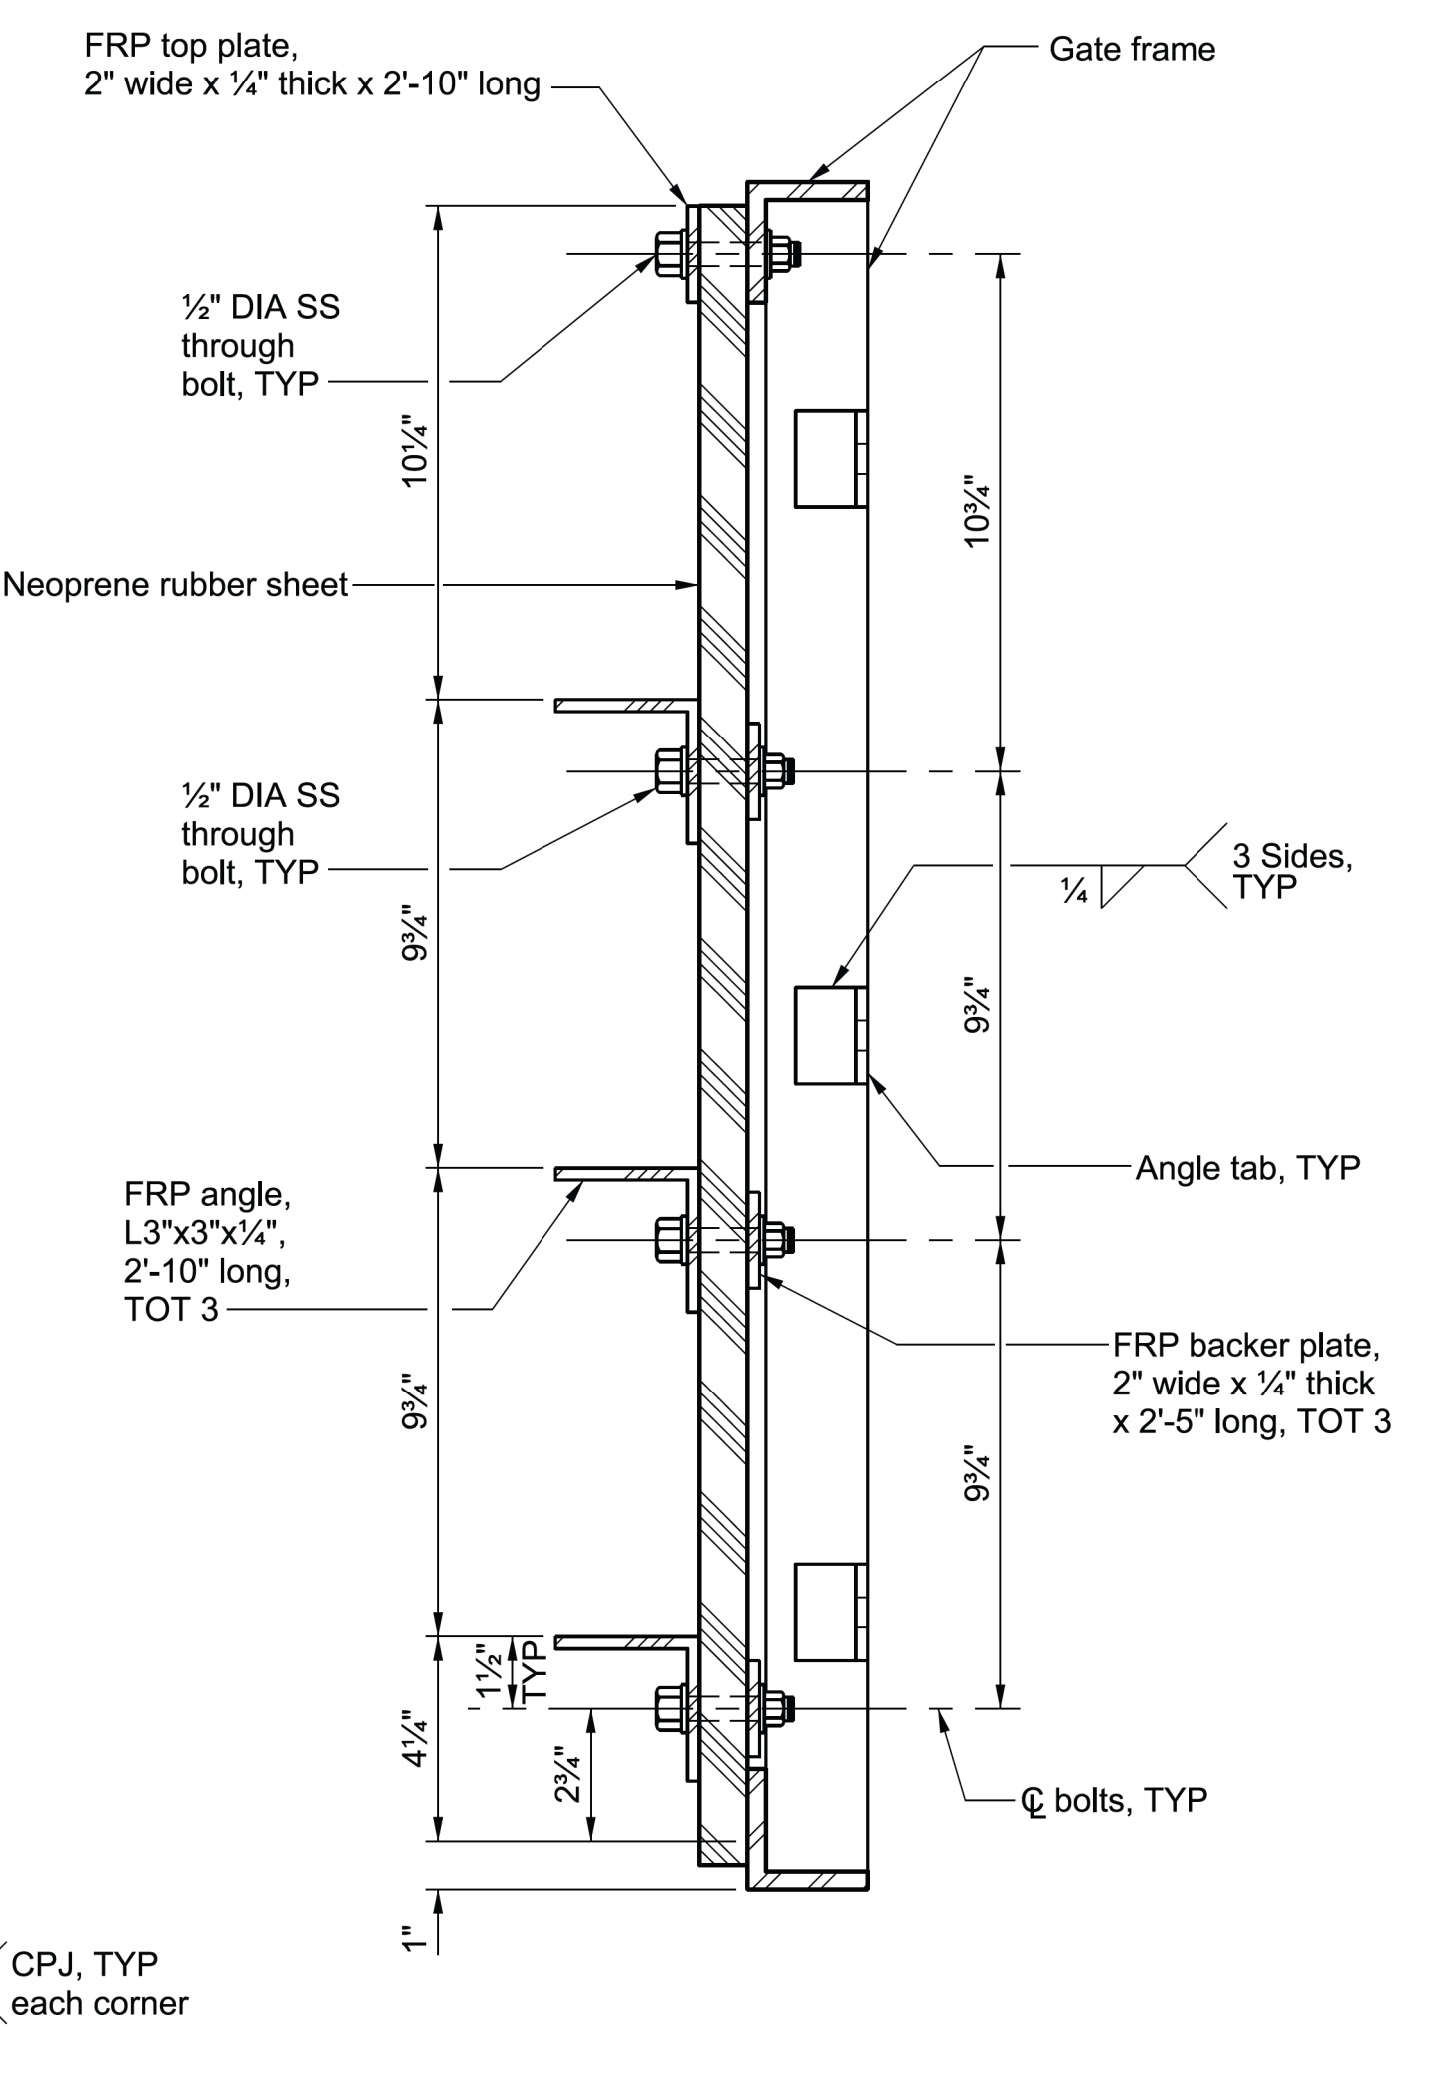


**SECTION A9-A9**  
 SCALE: 3"=1'-0"

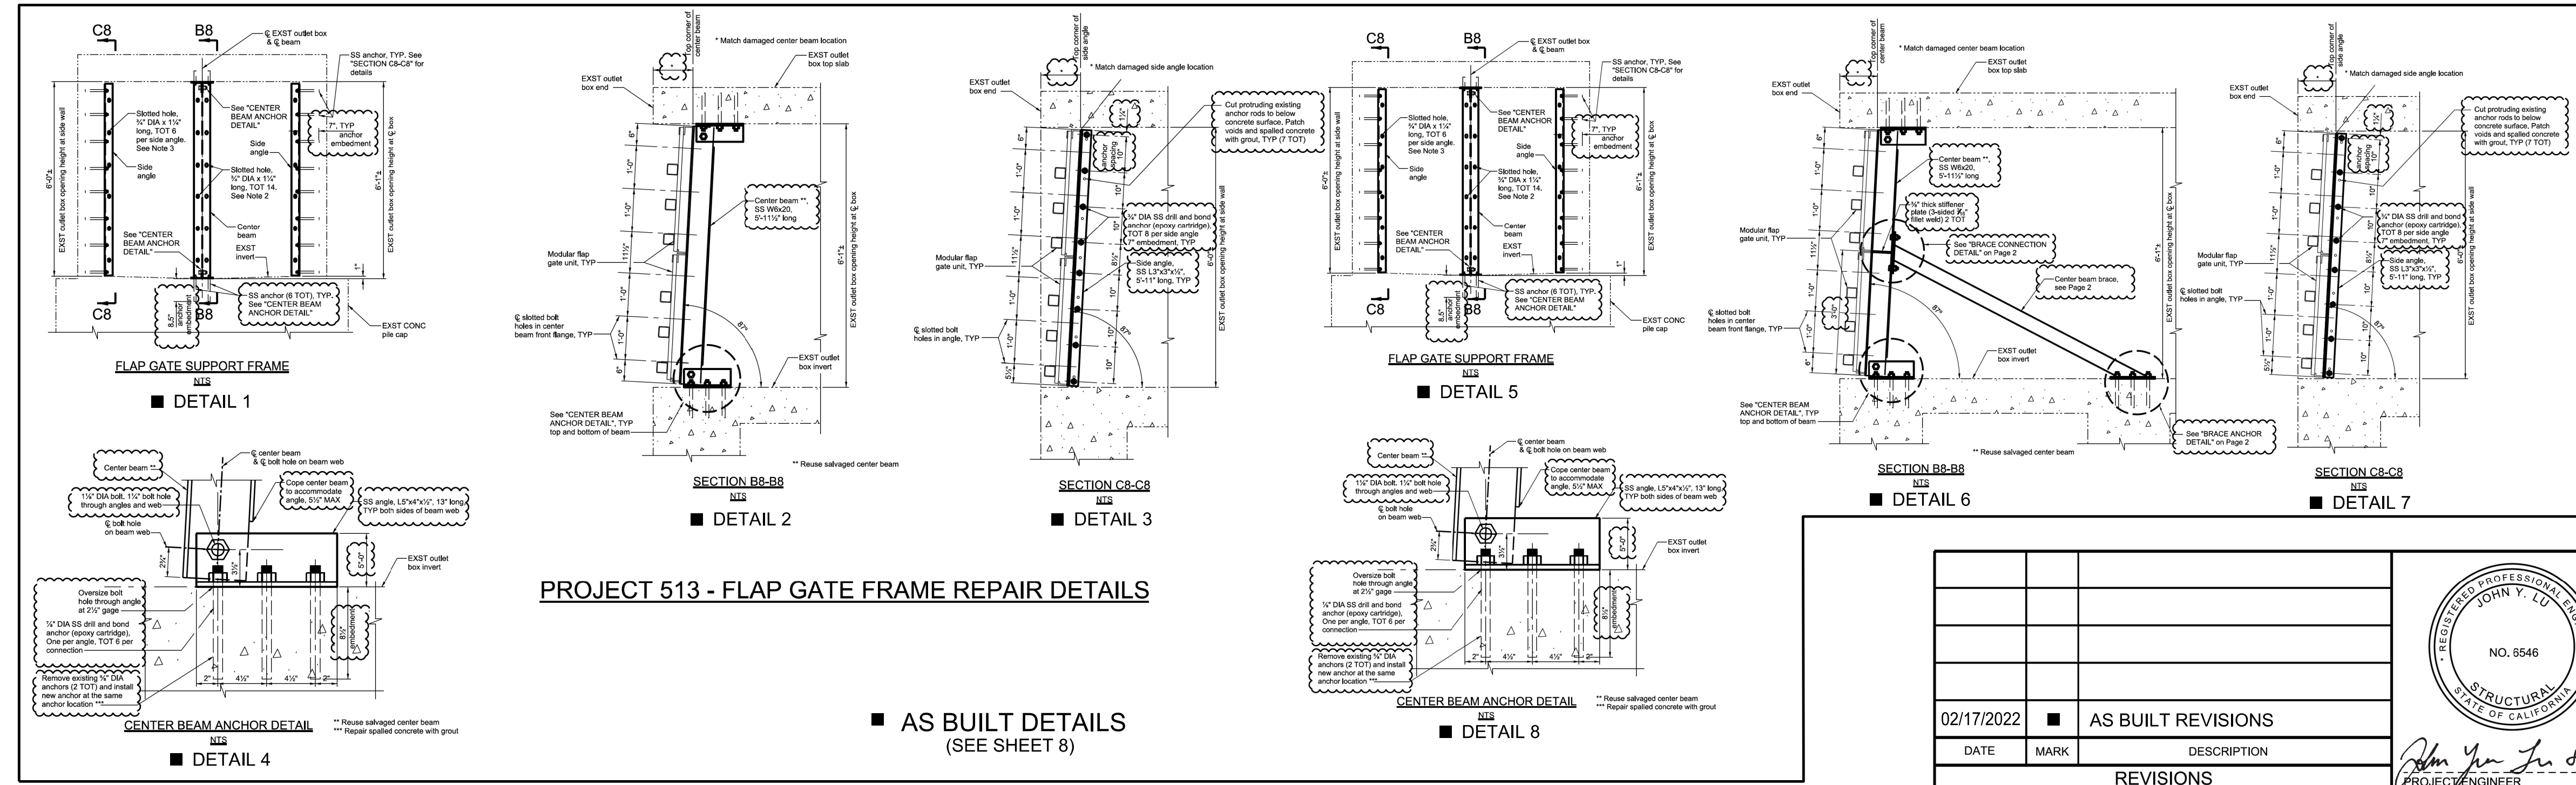

**PROJECT 513 - FLAP GATE FRAME REPAIR DETAILS**

AS BUILT DETAILS (SEE SHEET 8)

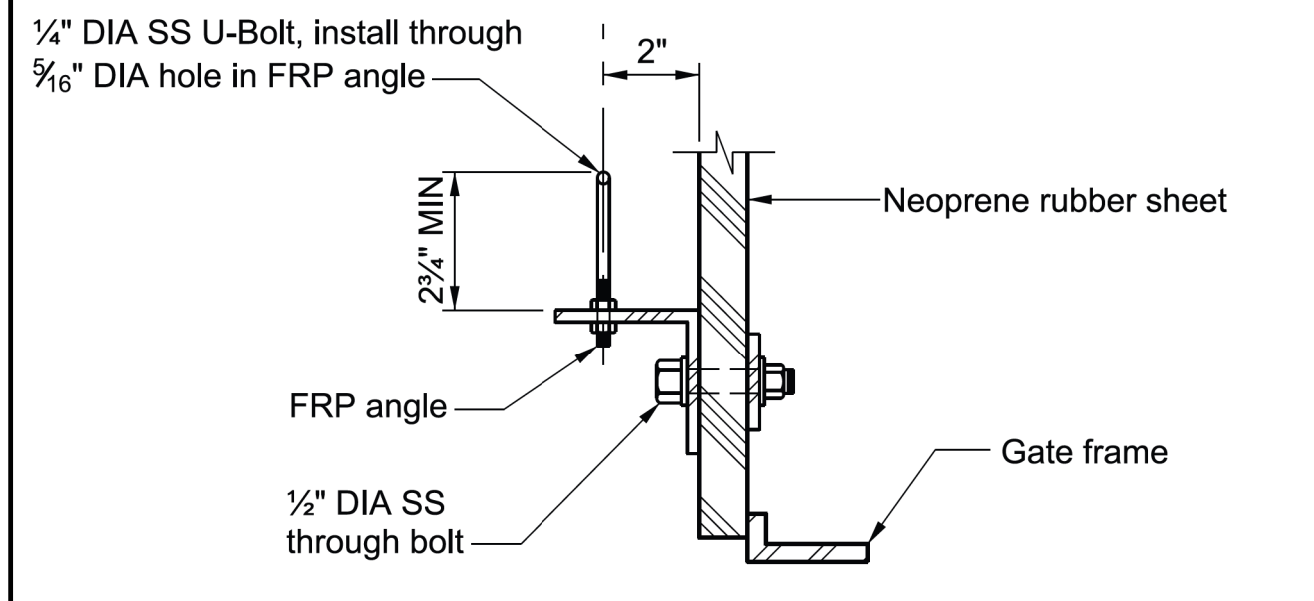

**SECTION B9-B9**  
 SCALE: 3"=1'-0"

NOTE: U-bolt shall be 316 SS, 1/2" DIA leg, 2" interior diameter of U bend, 3 1/2" overall length, and 1 1/2" threaded length.


DATE	MARK	DESCRIPTION
02/17/2022		AS BUILT REVISIONS

REGISTERED PROFESSIONAL ENGINEER  
 JOHN Y. LU  
 NO. 8546  
 STATE OF CALIFORNIA  
 STRUCTURAL  
 PROJECT ENGINEER DATE: 4/6/19

LOS ANGELES COUNTY PUBLIC WORKS  
**PROJECT NO. 275-513**  
 OCEAN OUTLET MODIFICATIONS  
 (STA. 0+87 - 3+64)  
 PROJECT ID-NR. FCC0001318  
 MODULAR FLAP GATE - SECTIONS AND DETAILS II  
 DWG 275-513-D19.9 PD PD053002 SHEET 9 OF 11


**AS BUILT DRAWINGS**

SEE PENDAVIS' SHOP DRAWINGS FOR PRECISE MEASUREMENTS

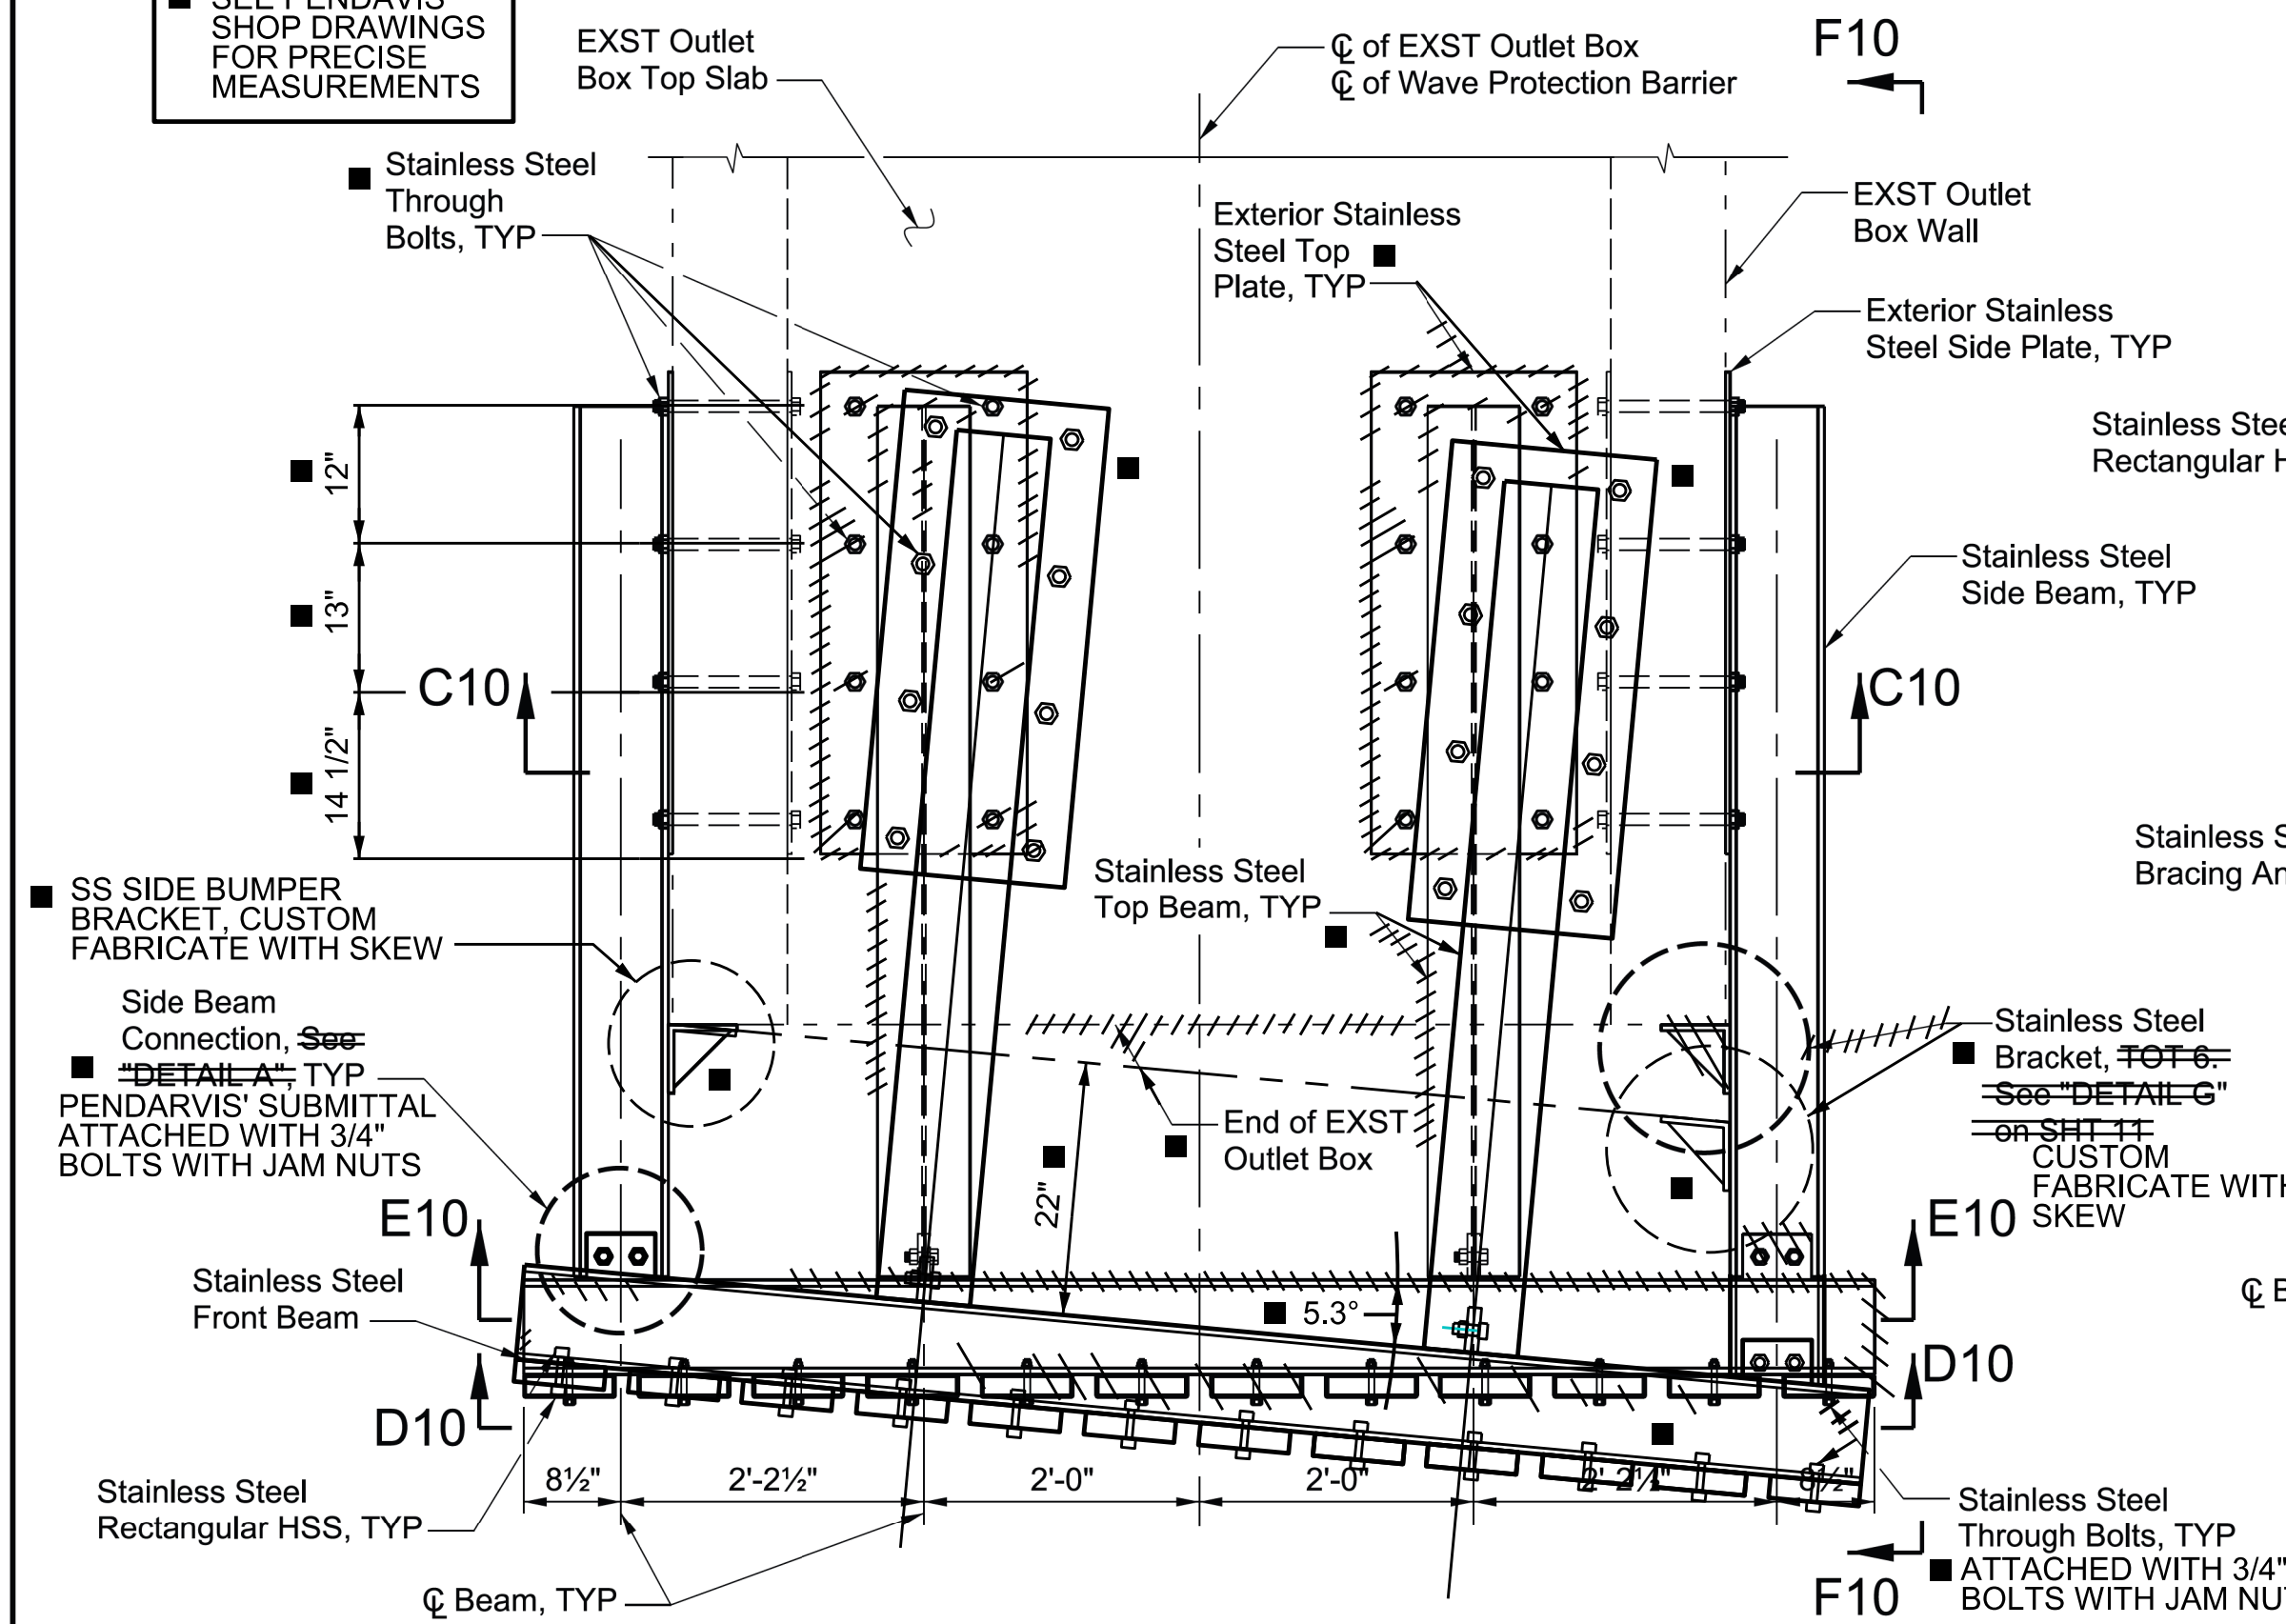


**WAVE PROTECTION BARRIER (SHT 2)**  
SCALE: 3/4"=1'-0"

- NOTES:
1. Top plan view is shown.
  2. See "SECTION D10-D10" and "SECTION E10-E10" on SHT 11.
  3. Contractor to verify controlling field dimensions of the outlet structure. Shop drawings based on verified field dimensions shall be submitted in accordance with 3-5.
  4. OUTER FRAME TO BE FABRICATE TO FIT THE 6 EACH W8x40 SIDE AND TOP BEAMS AS INSTALLED.
  5. GROUT BETWEEN STEEL AND CONCRETE AS NECESSARY.
  6. ALL BOLT CONNECTIONS FOR THE WAVE PROTECTION BARRIER, EXCEPT HSS TO BEAM AND GUSSET PLATE CONNECTIONS, SHALL BE PROVIDED WITH JAM NUTS, WHERE THE HEIGHT OF JAM NUTS ARE HALF AS TALL AS THE REGULAR NUTS. JAM NUTS SHALL BE INSTALLED PRIOR TO INSTALLING THE REGULAR NUTS.

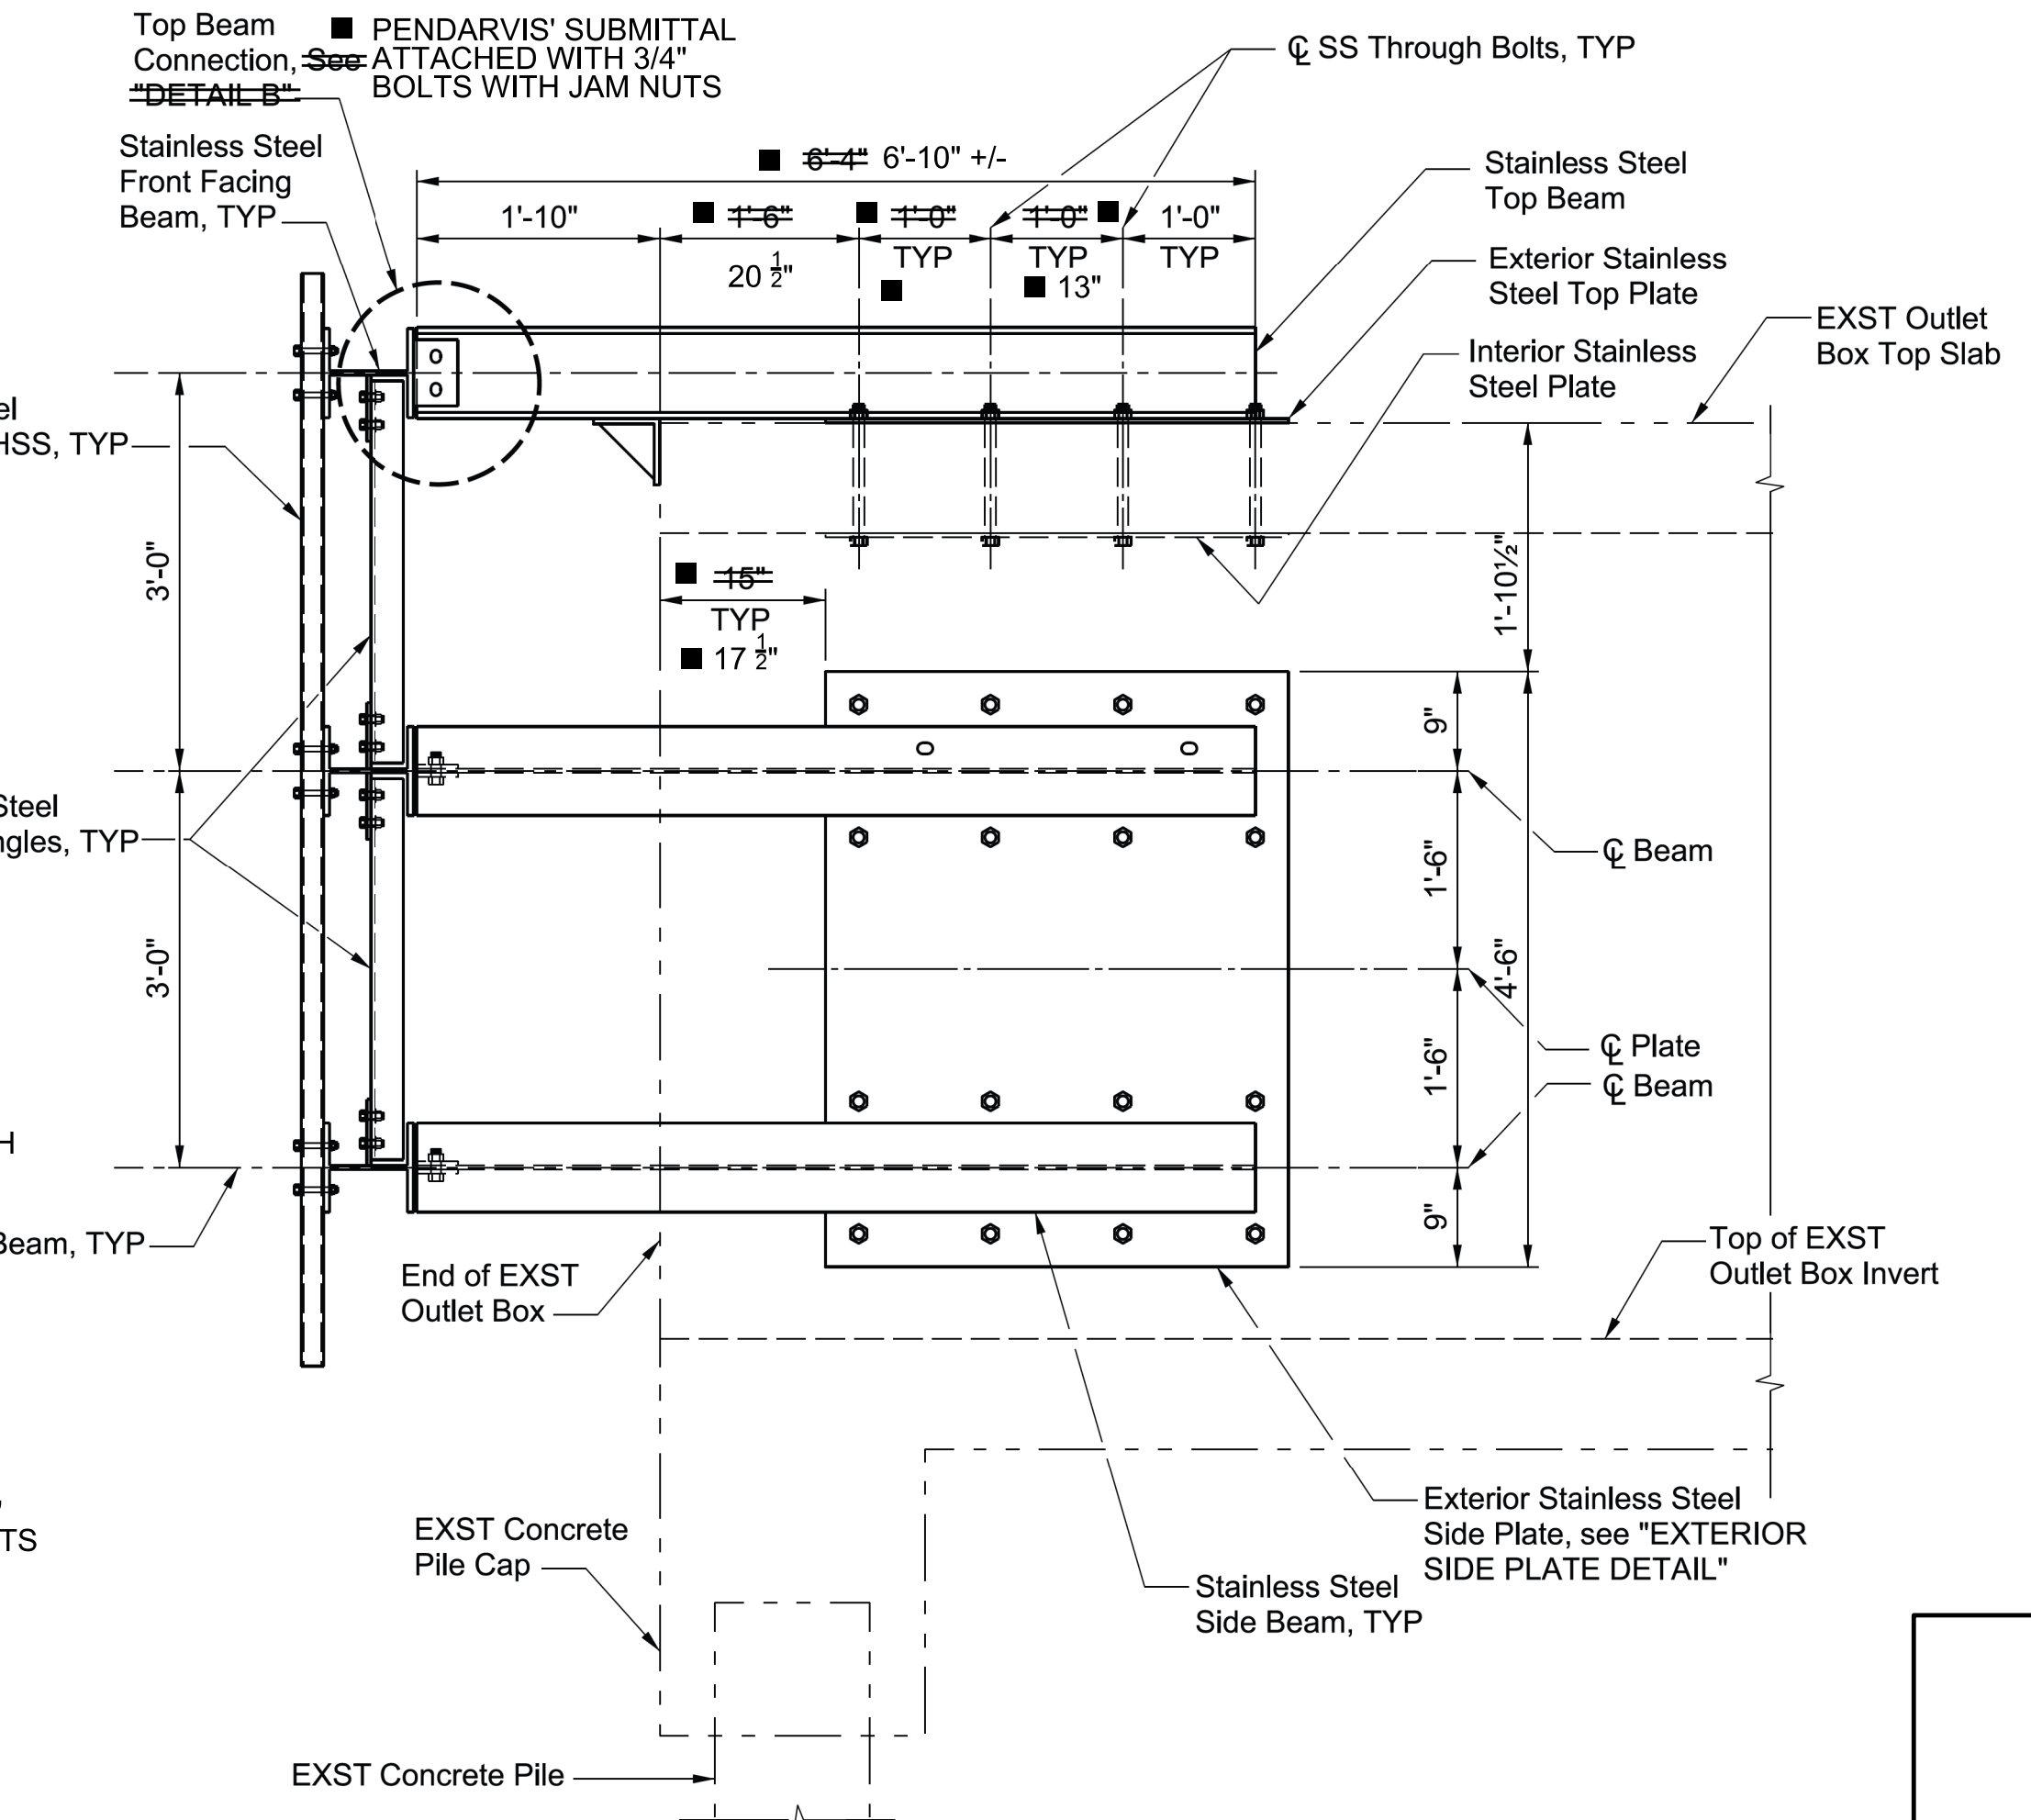


**ELEVATION F10-F10**  
SCALE: 3/4"=1'-0"

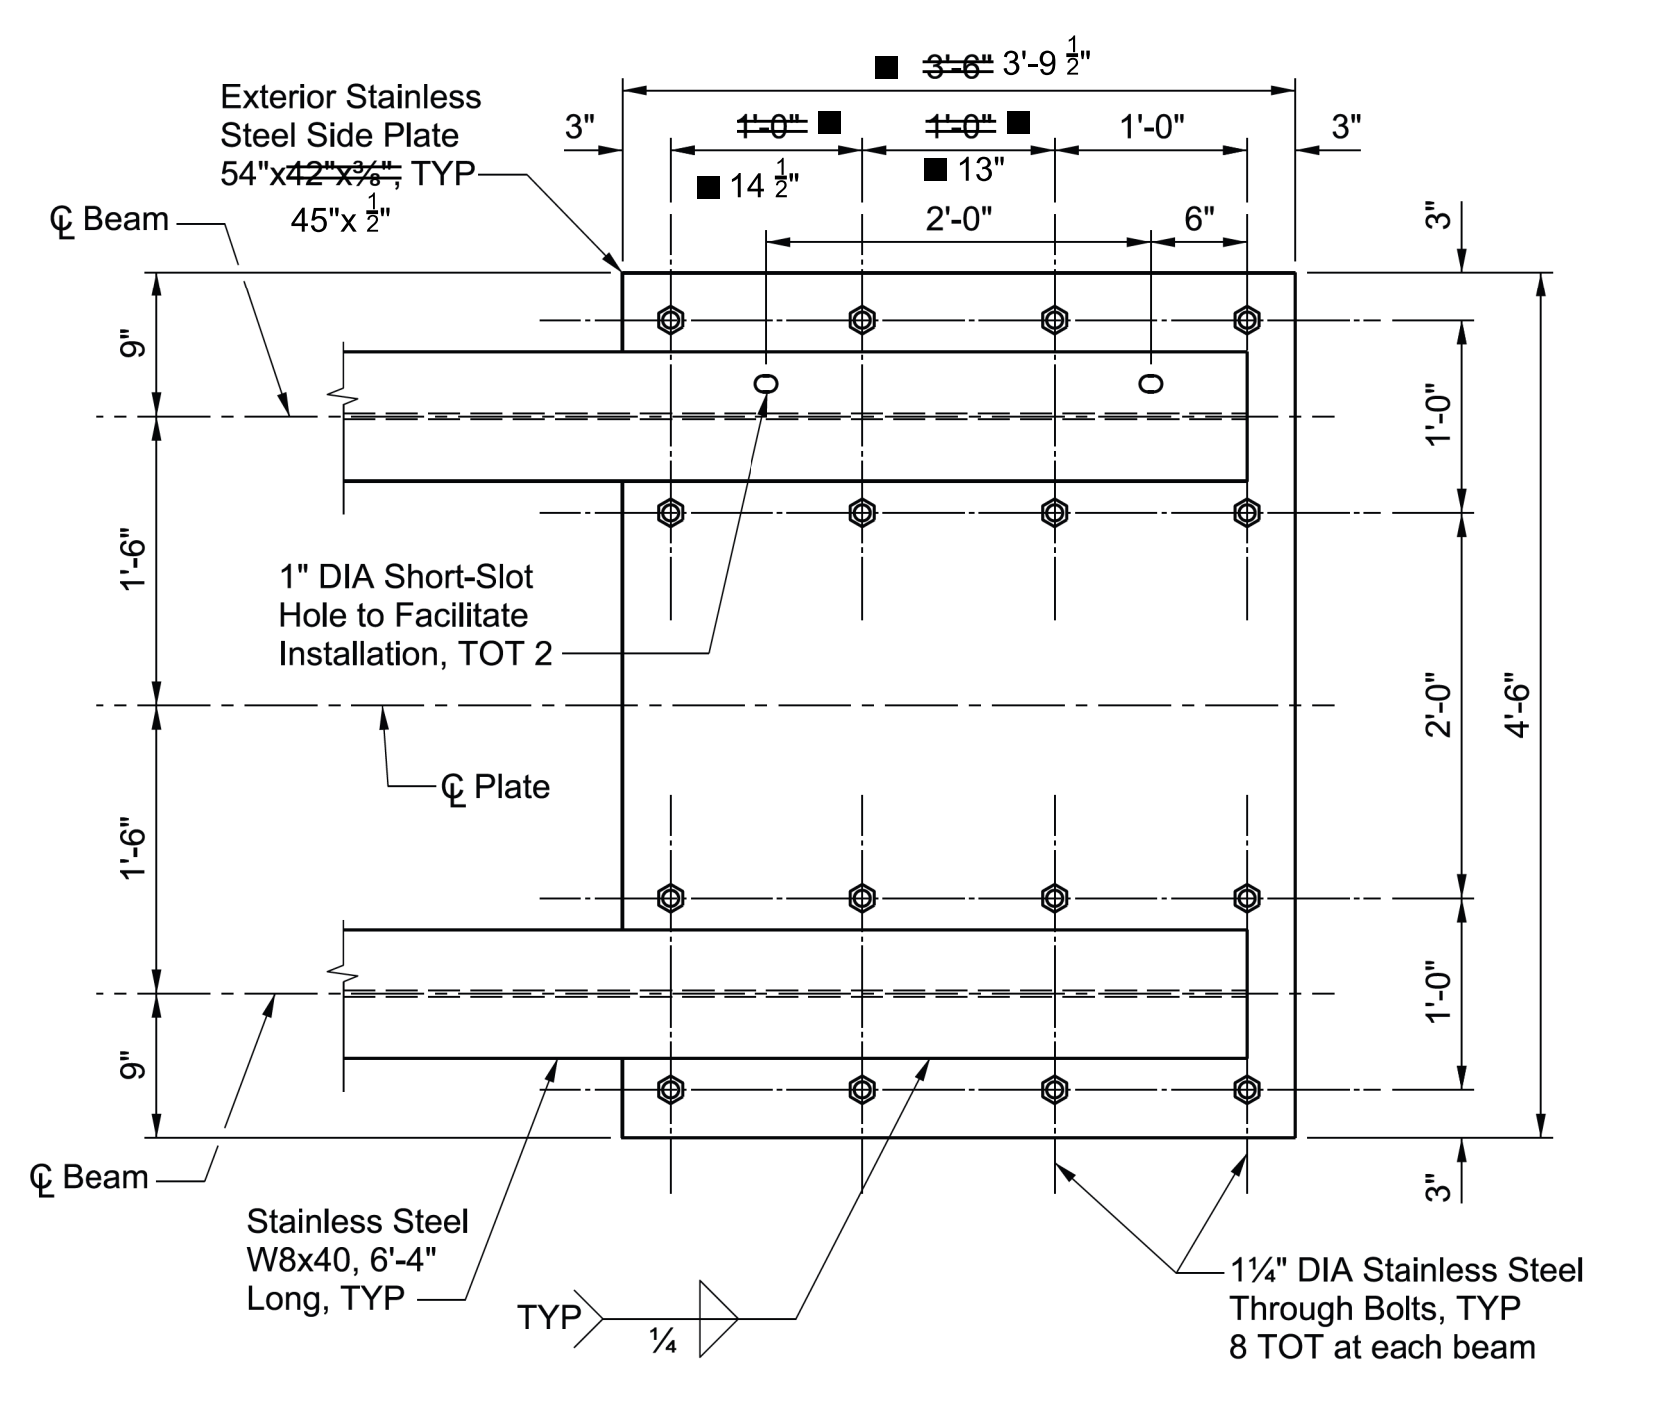


**EXTERIOR SIDE PLATE DETAIL**  
SCALE: 1"=1'-0"


- NOTES:
1. Exterior stainless steel side plate on the opposite side is symmetrical to the details shown.
  2. Exterior stainless steel top plate is similar with bolt edge distance of 3" and plate width of 18".

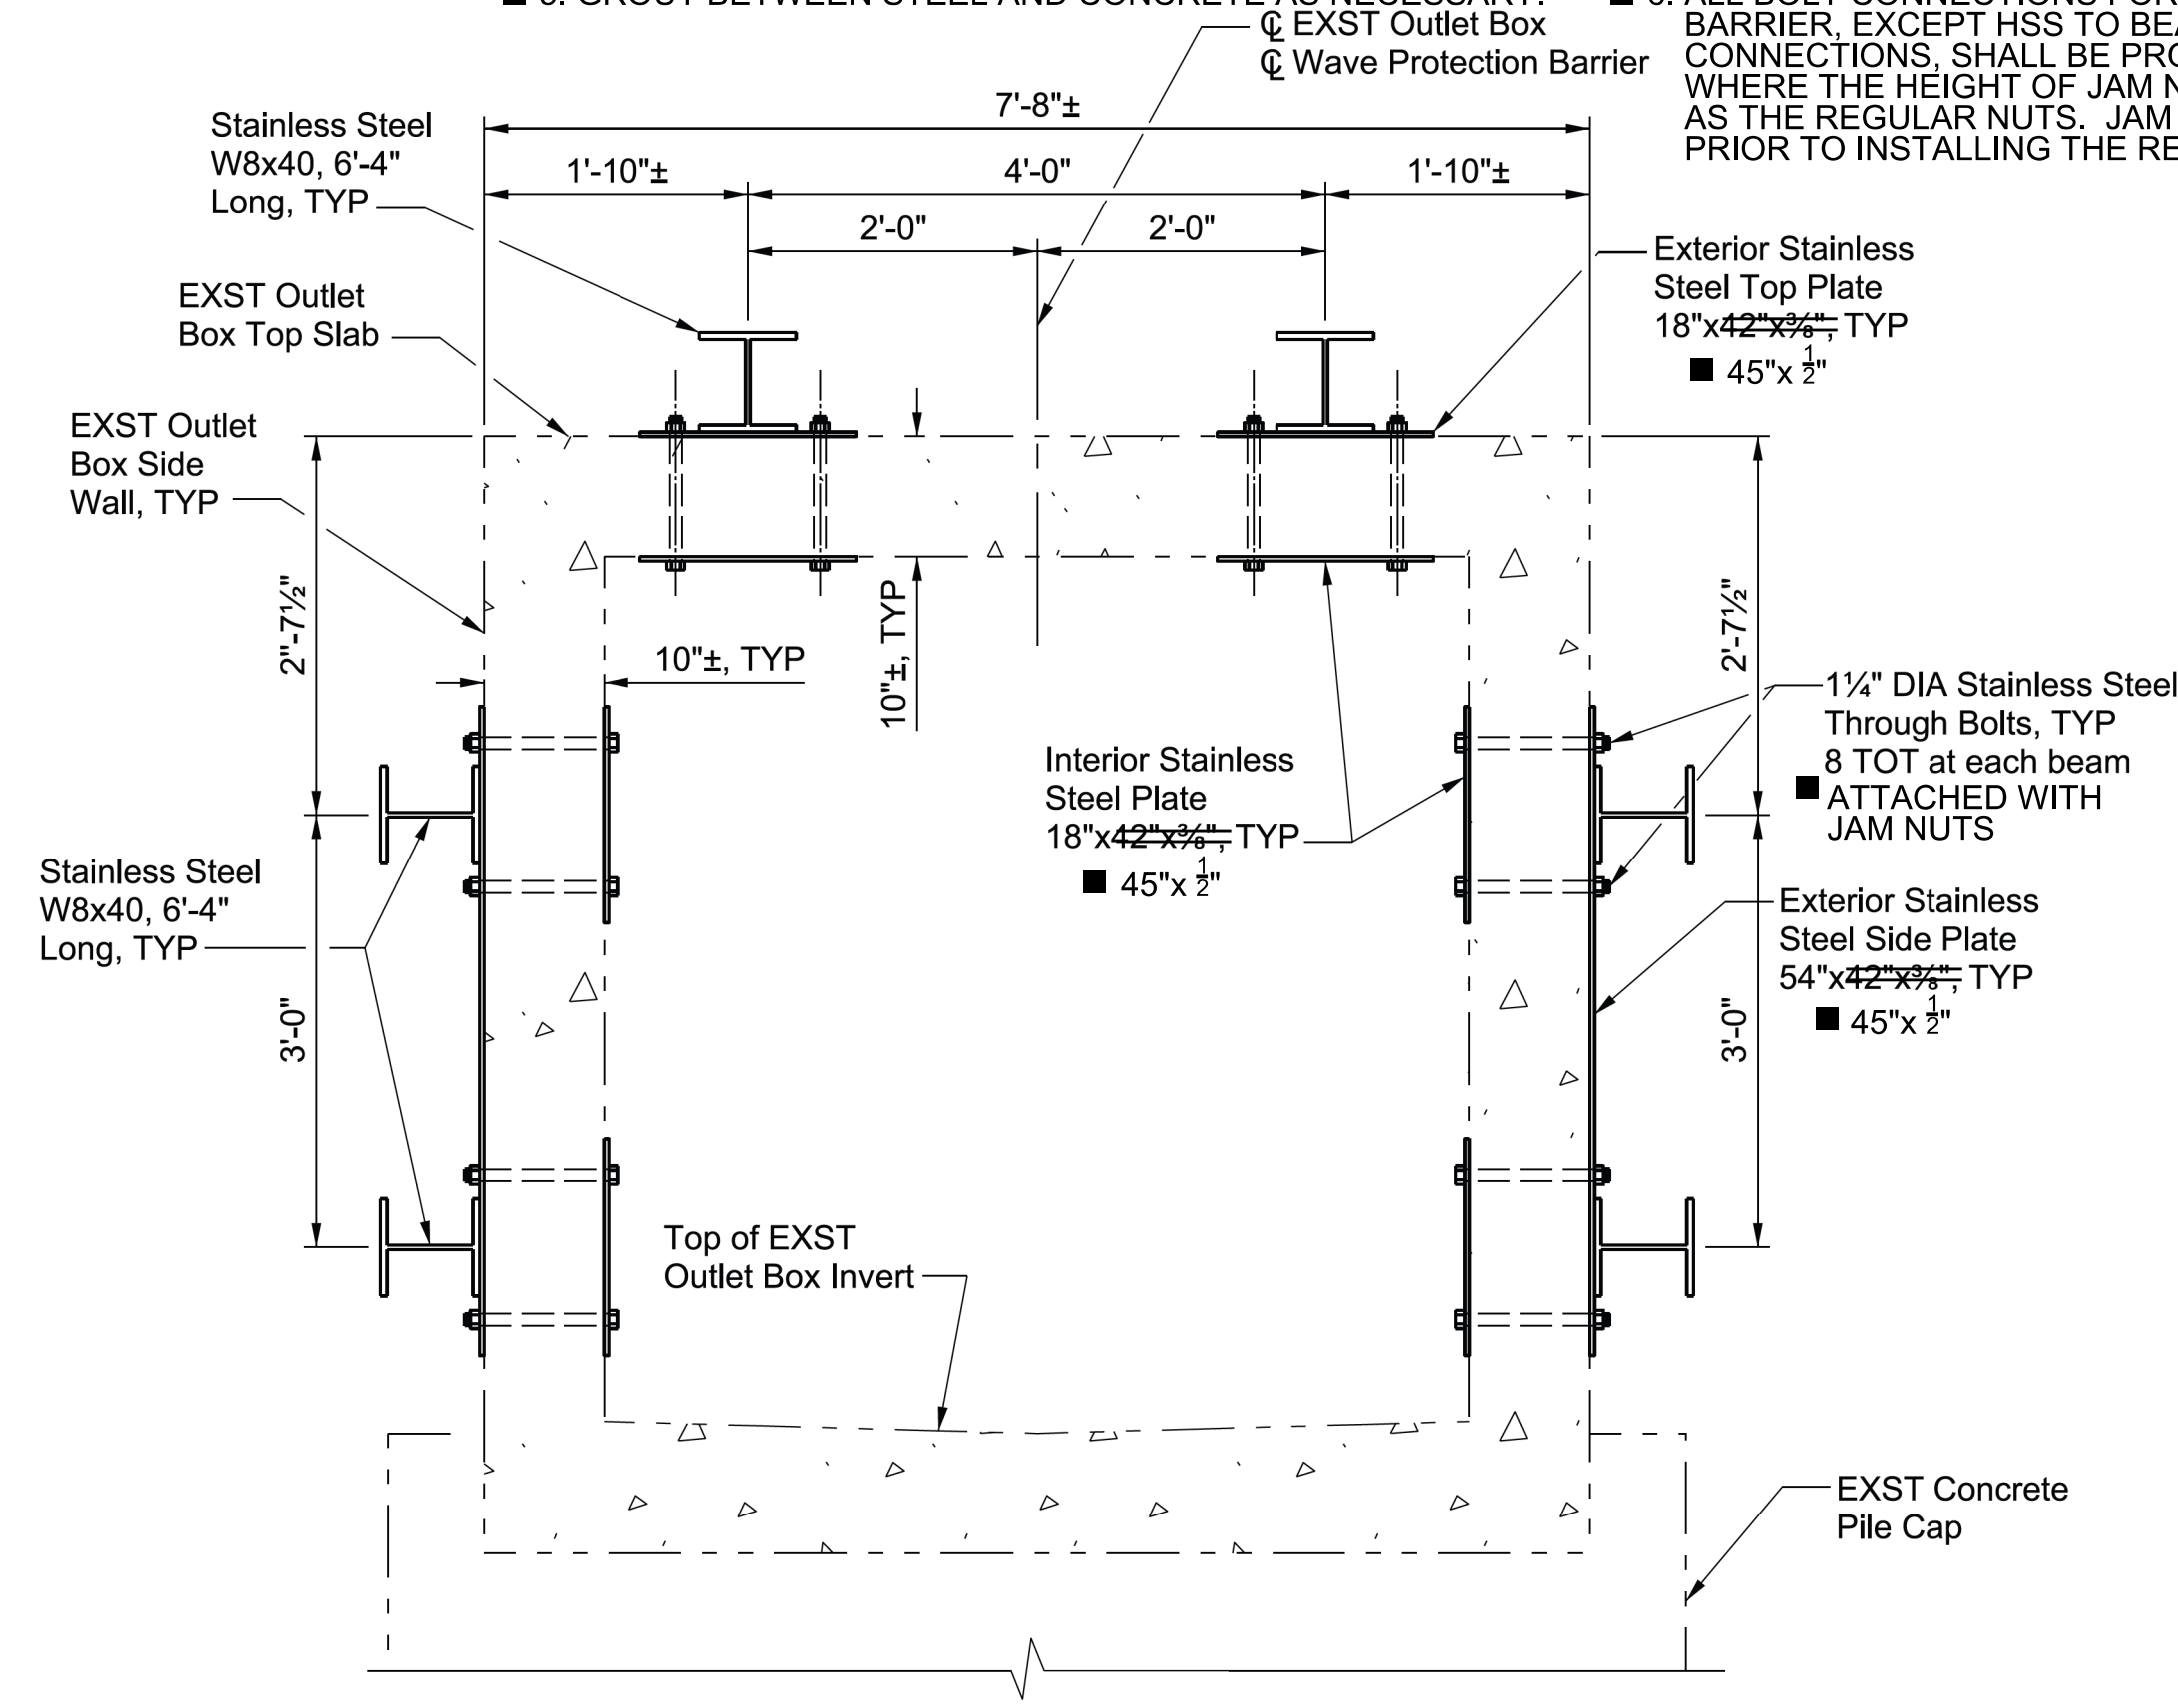


**SECTION C10-C10**  
SCALE: 3/4"=1'-0"

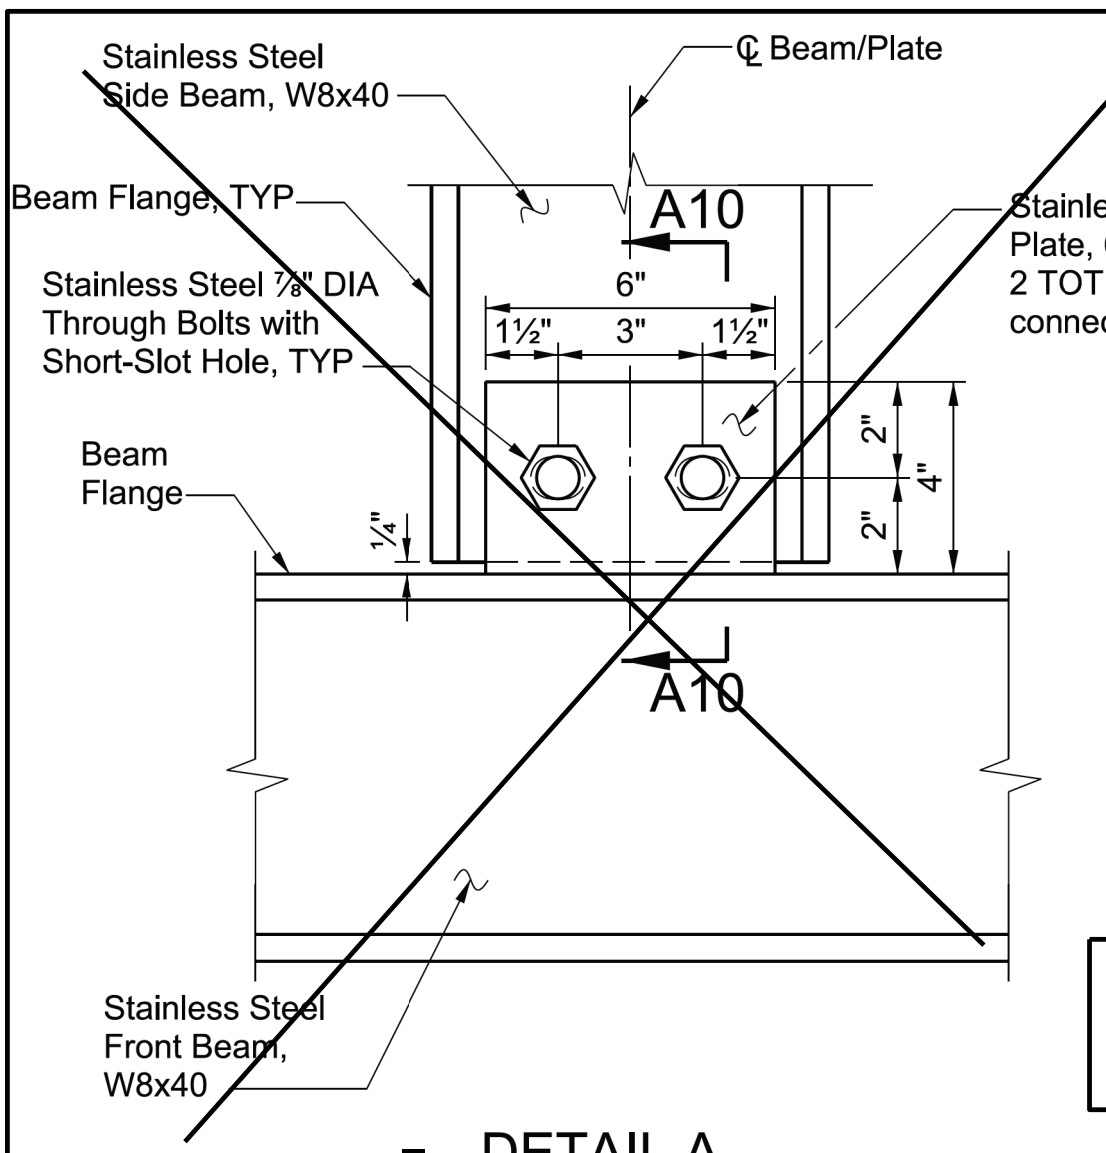


**DETAIL A**  
SCALE: 3"=1'-0"

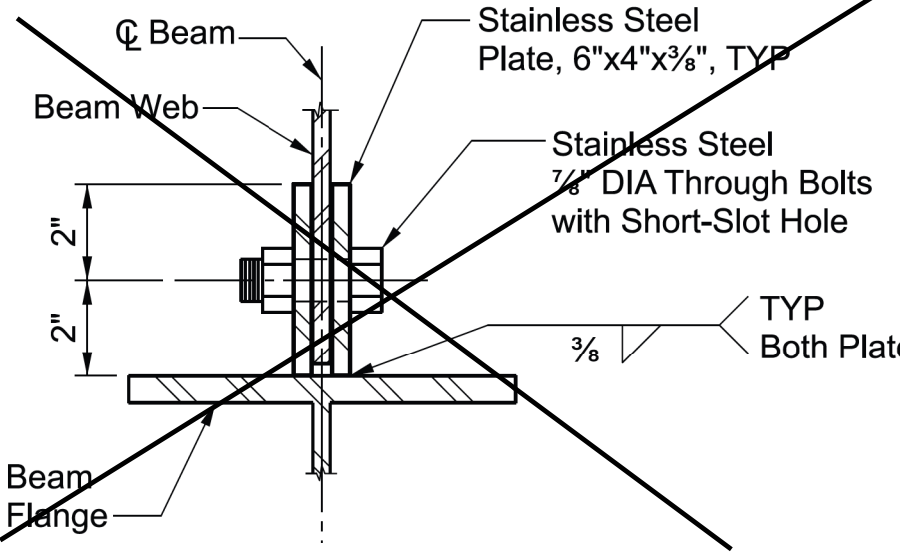

**SECTION A10-A10**  
SCALE: 3"=1'-0"

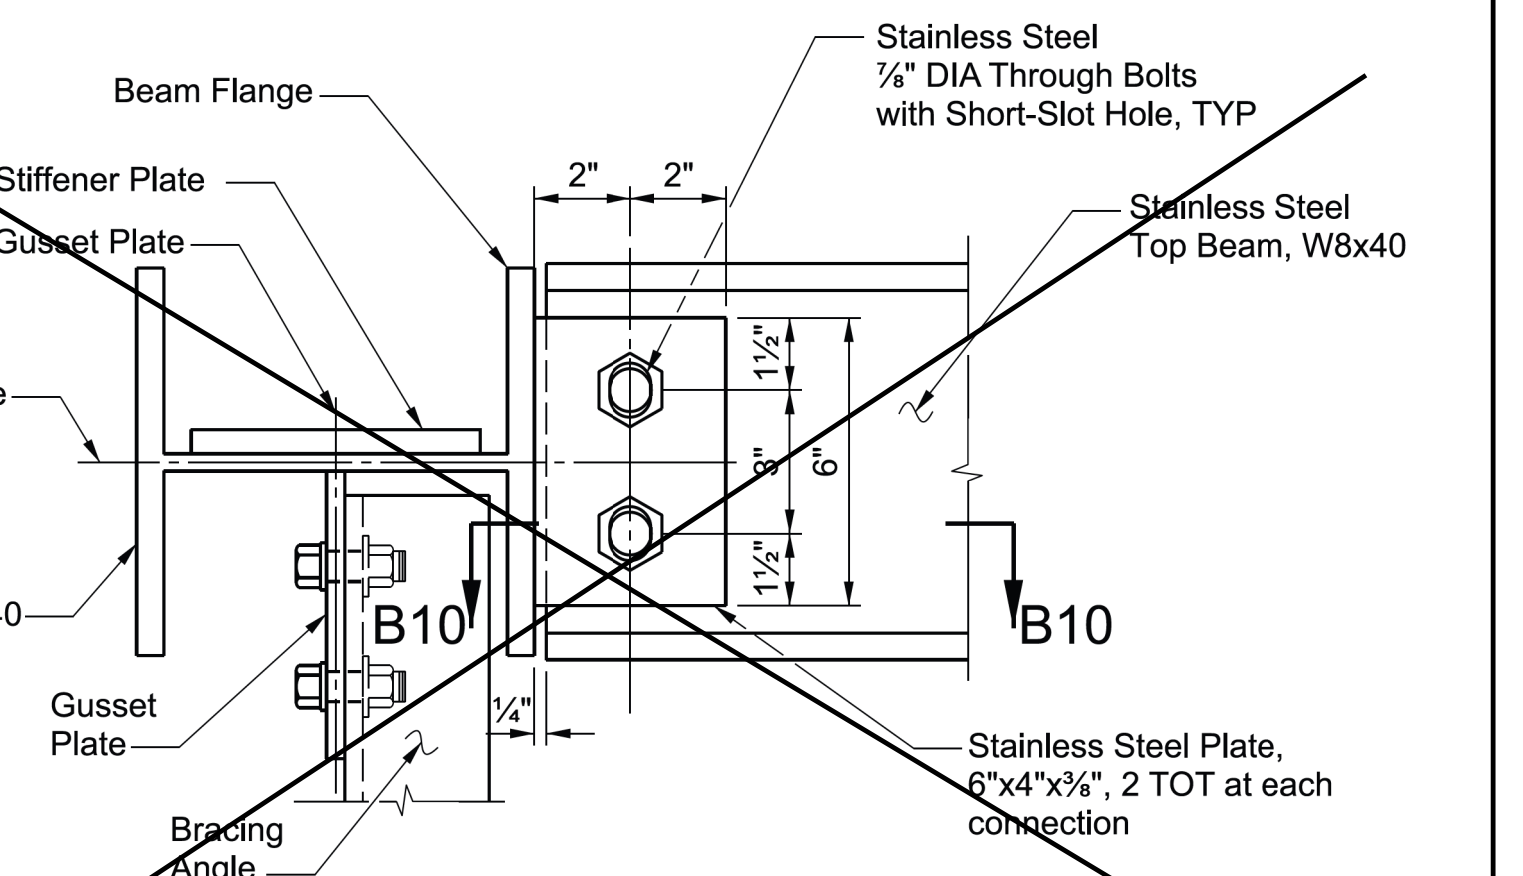

**DETAIL B**  
SCALE: 3"=1'-0"

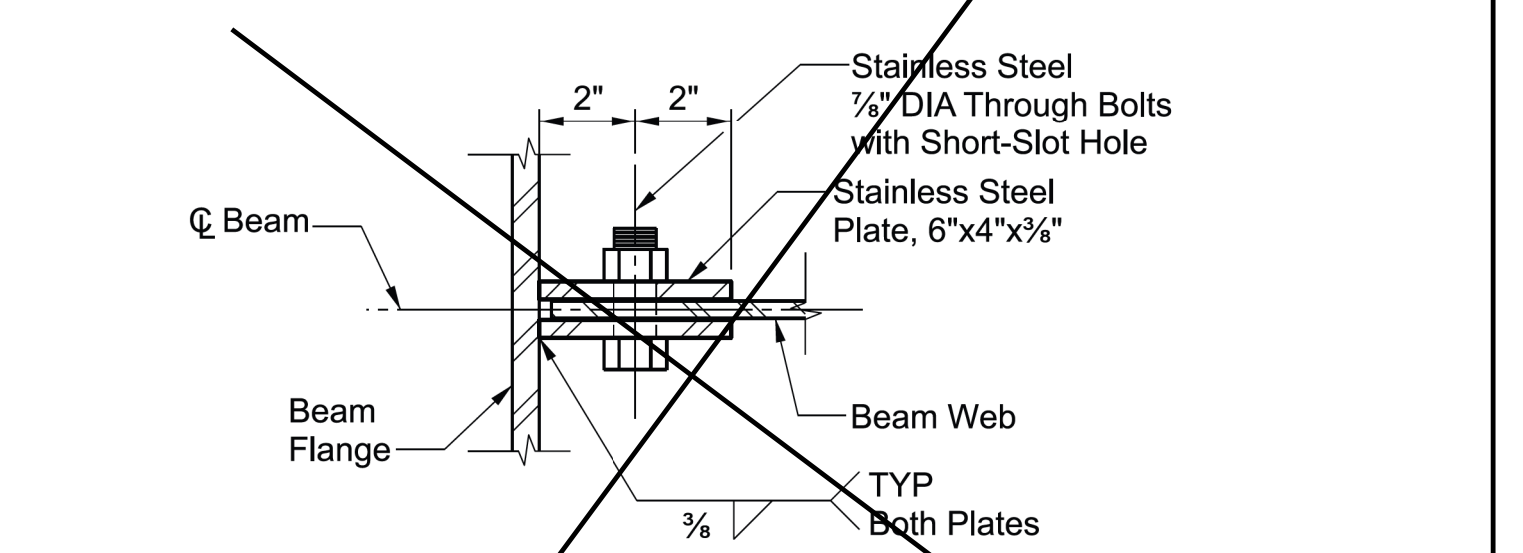


**SECTION B10-B10**  
SCALE: 3"=1'-0"

SEE PENDAVIS' SHOP DRAWINGS

NOTE: Gap between stainless steel plates shall be 1/16" wider than beam web thickness

CADD PROJECT FILE NAME: FCC0001318 - Project No. 275-513 Ocean Outlet Modifications.dgn  
CHECKER: S. GREGOWSKIE  
DESIGNER: J. LU  
DRAFTER: J. LU


DATE	MARK	DESCRIPTION
02/17/2022		AS BUILT REVISIONS

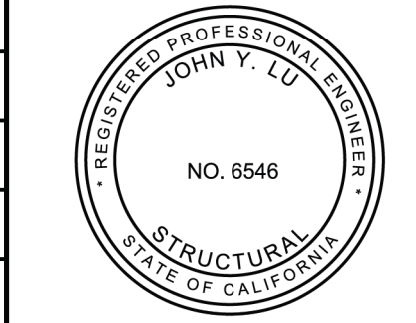


LOS ANGELES COUNTY PUBLIC WORKS  
**PROJECT NO. 275-513**  
OCEAN OUTLET MODIFICATIONS  
(STA. 0+87 - 3+64)  
PROJECT ID NO. FCC0001318  
WAVE PROTECTION BARRIER - SECTIONS AND DETAILS I  
DWG 275-513-D19.1 PD P053002 SHEET 10 OF 11

AS BUILT DRAWINGS

■ ADJUST BOLT LOCATION FOR INSTALLATION PER TEMPLATE

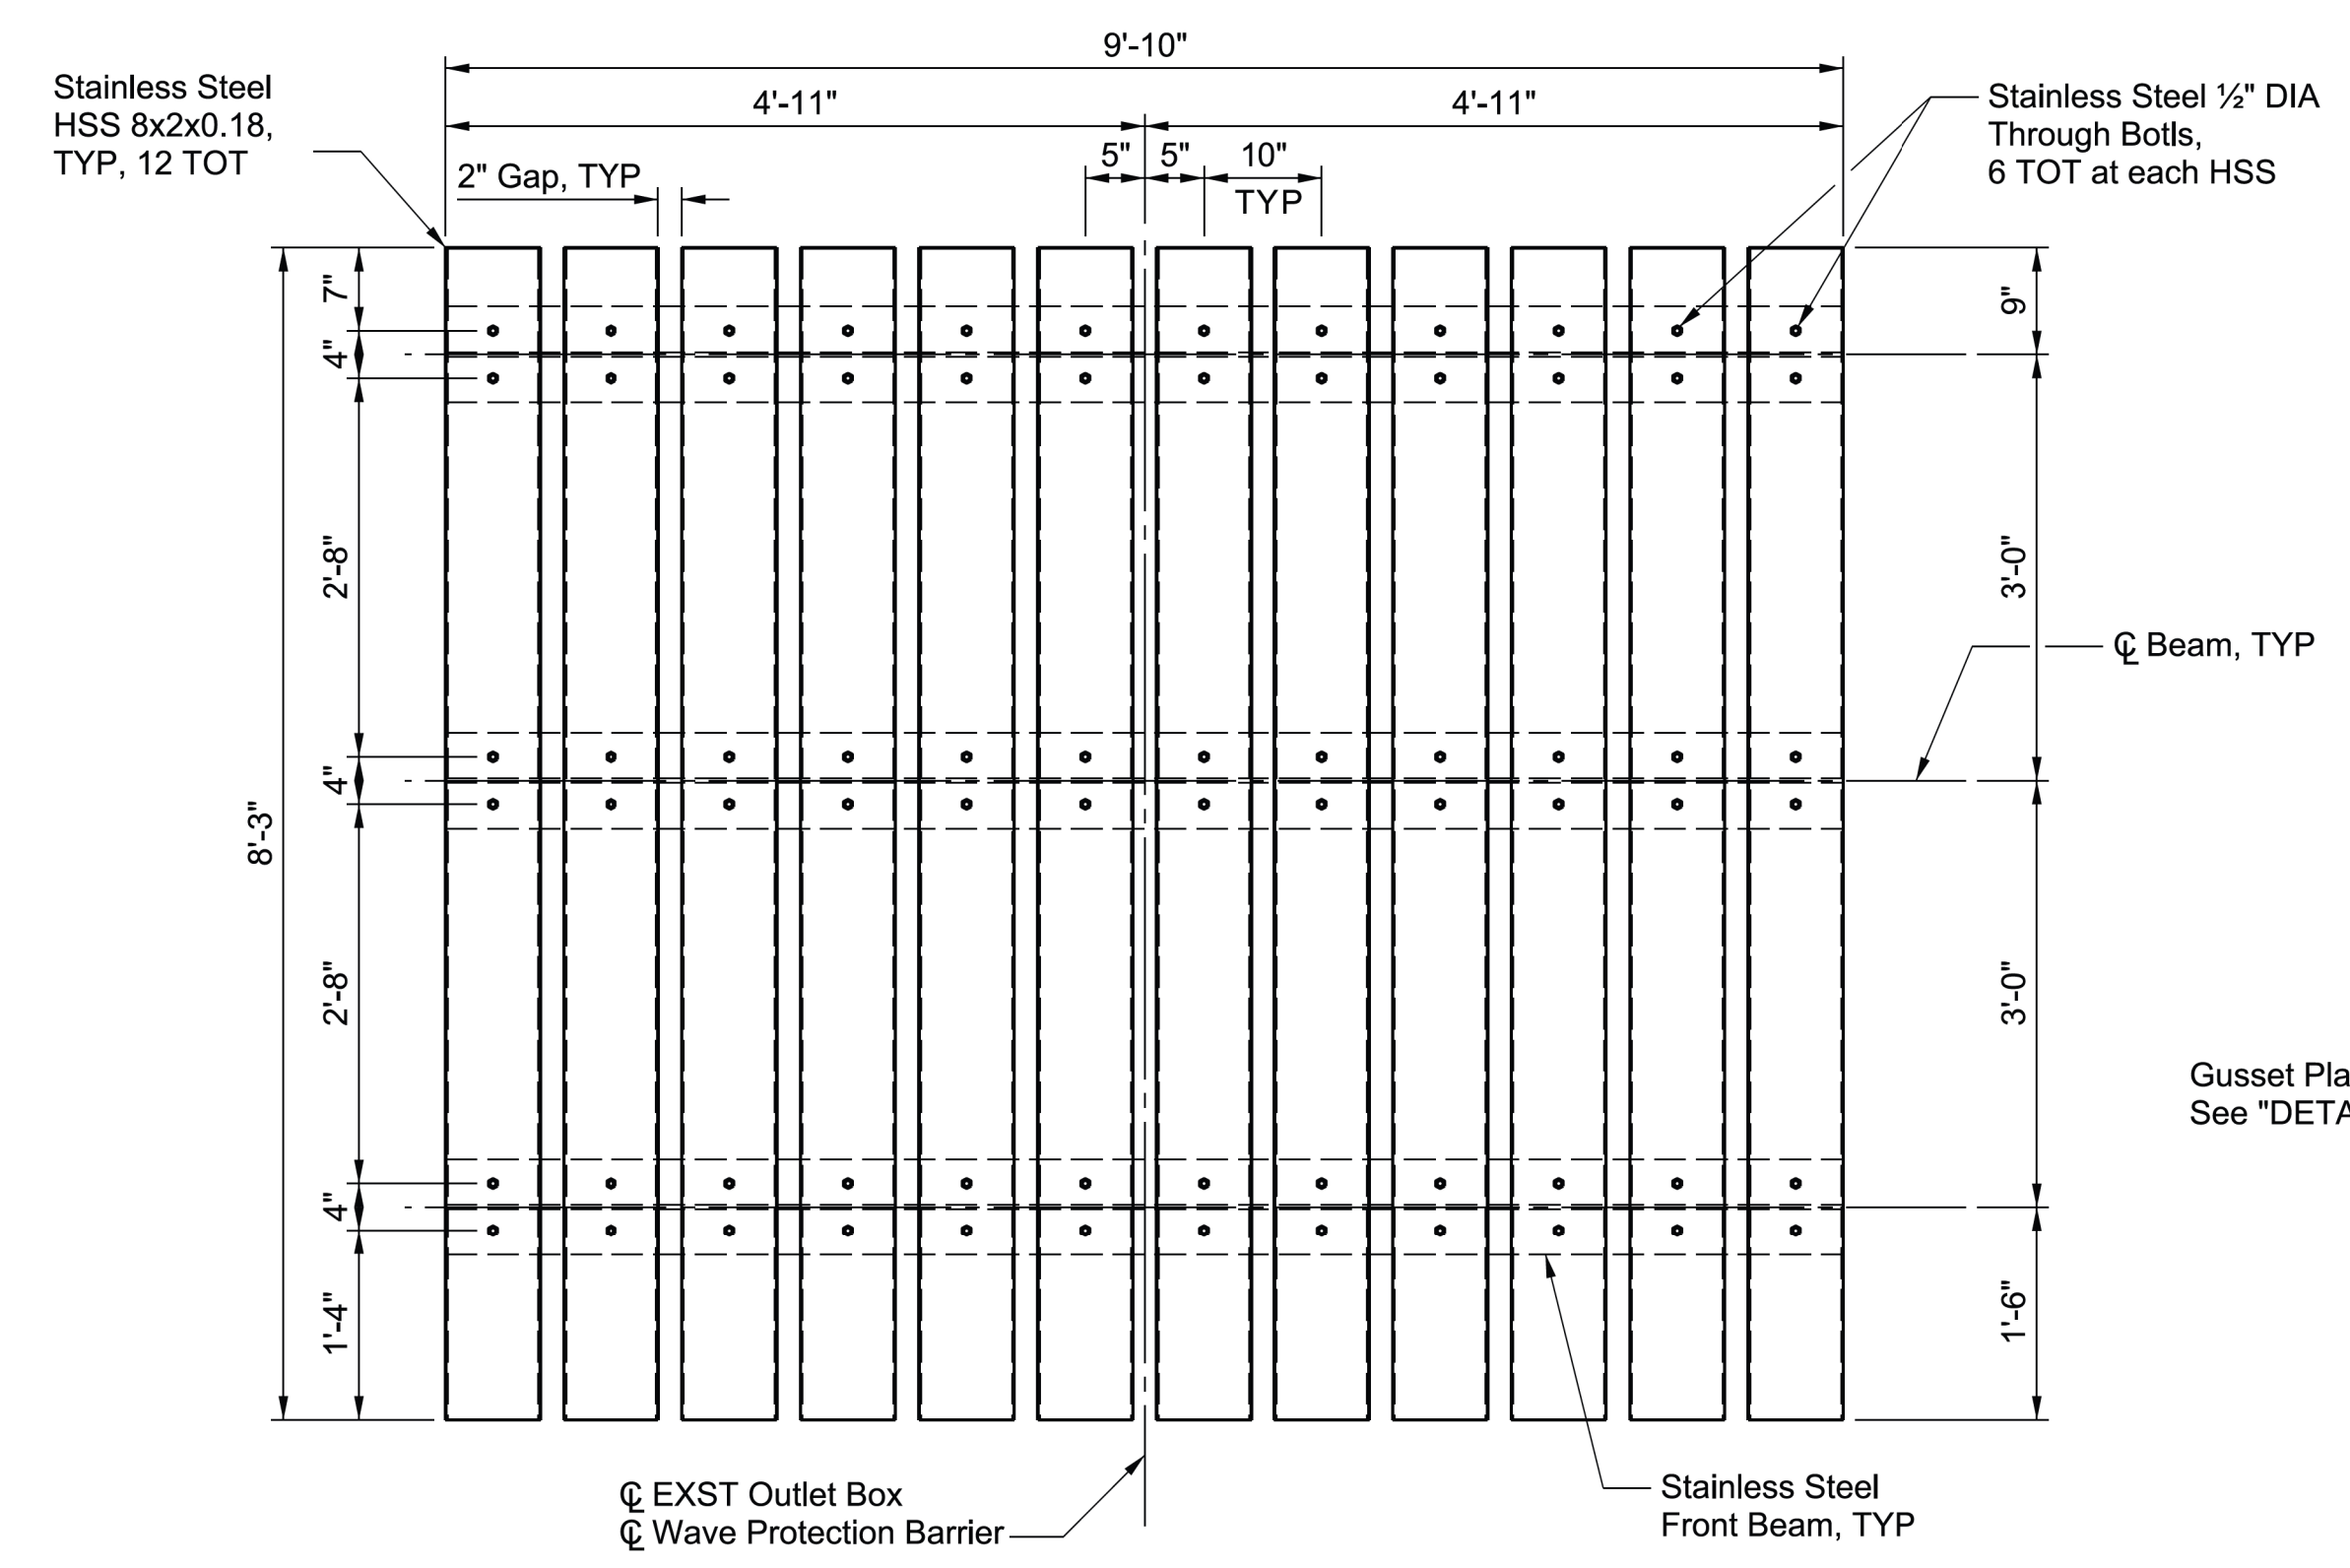


**ELEVATION D10-D10 (SHT 10)**  
SCALE: 3/4"=1'-0"

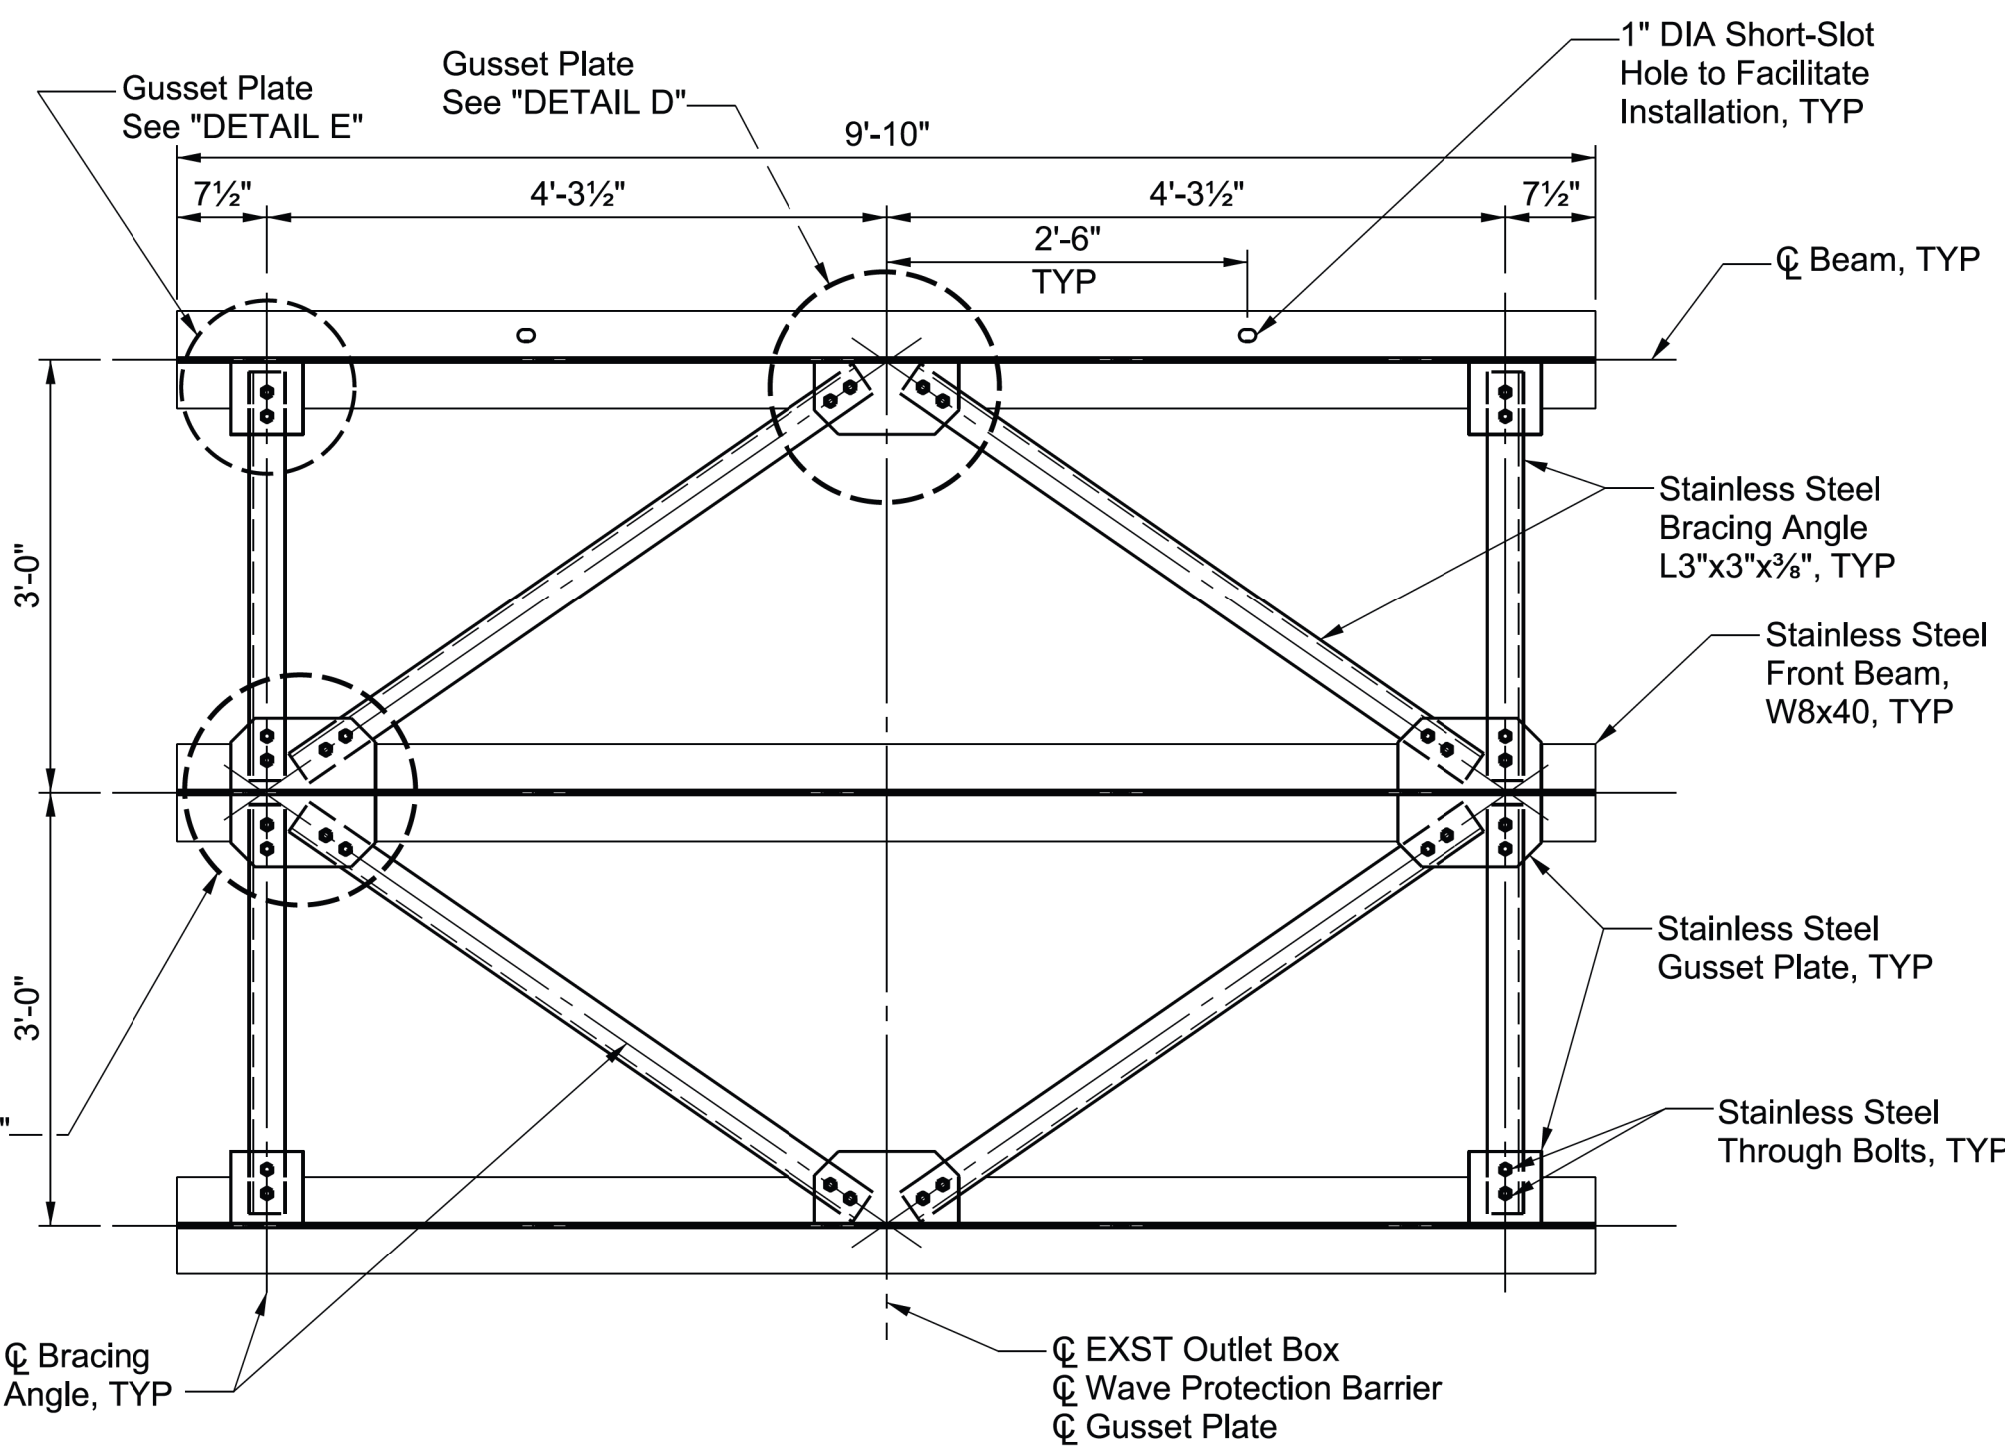


**SECTION E10-E10 (SHT 10)**  
SCALE: 3/4"=1'-0"

NOTE: Gusset plates shall be installed along the center of the web

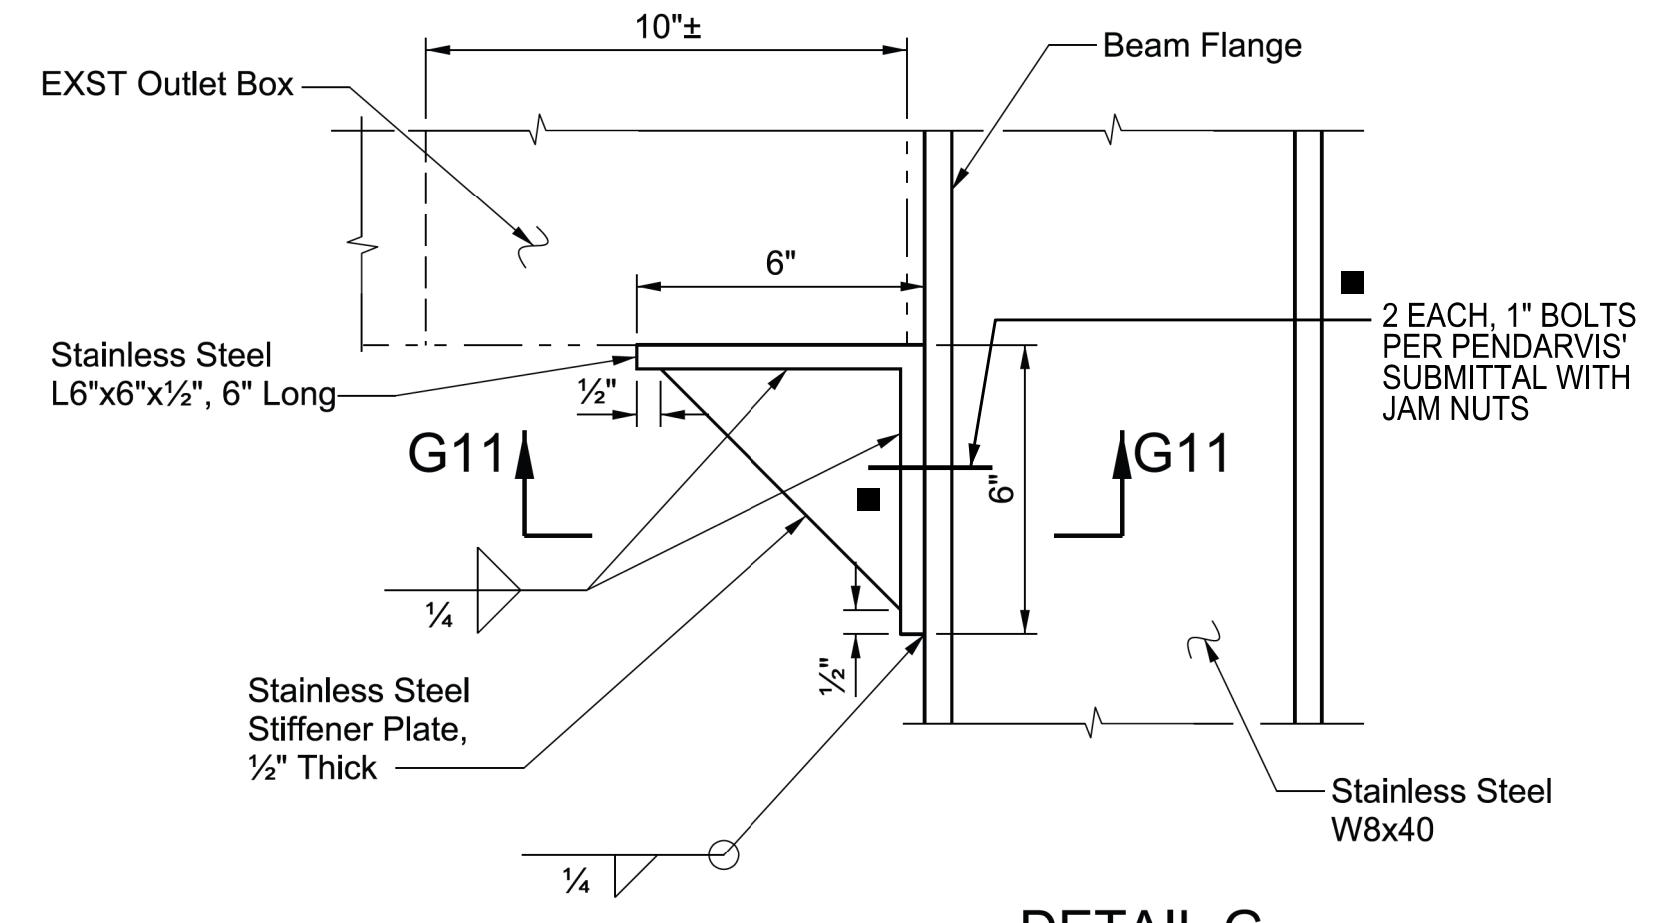


**DETAIL G**  
SCALE: 3"=1'-0"


NOTE: Stainless steel angle shall be in full contact with the exterior face of EXST outlet box

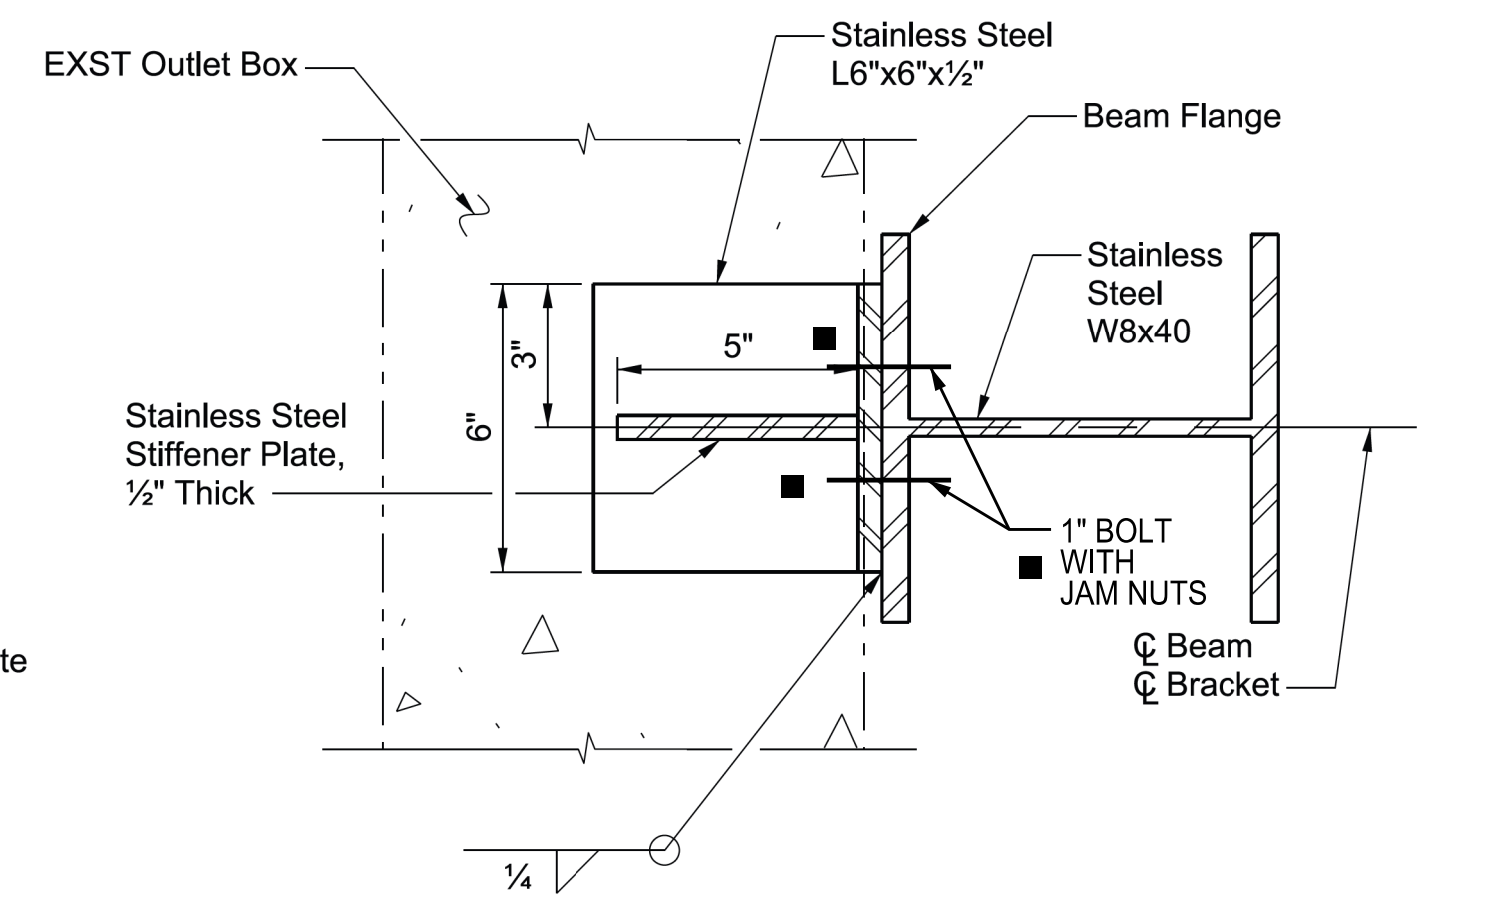


**SECTION G11-G11**  
SCALE: 3"=1'-0"

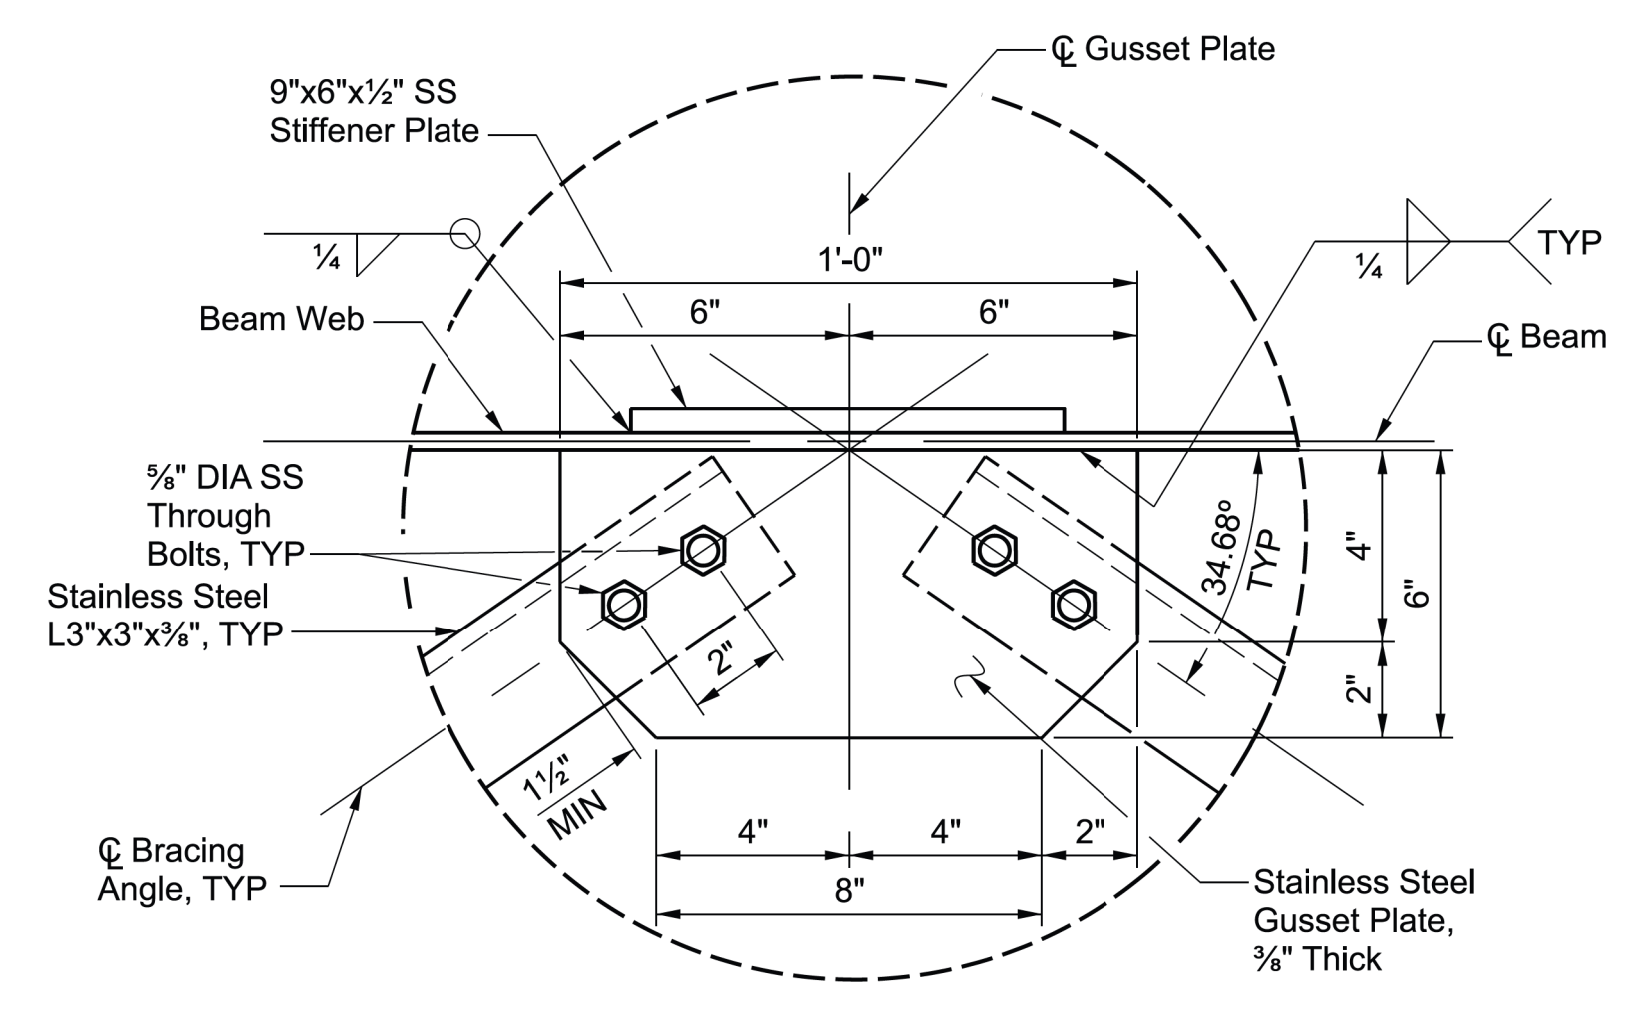

**DETAIL D**  
SCALE: 3"=1'-0"

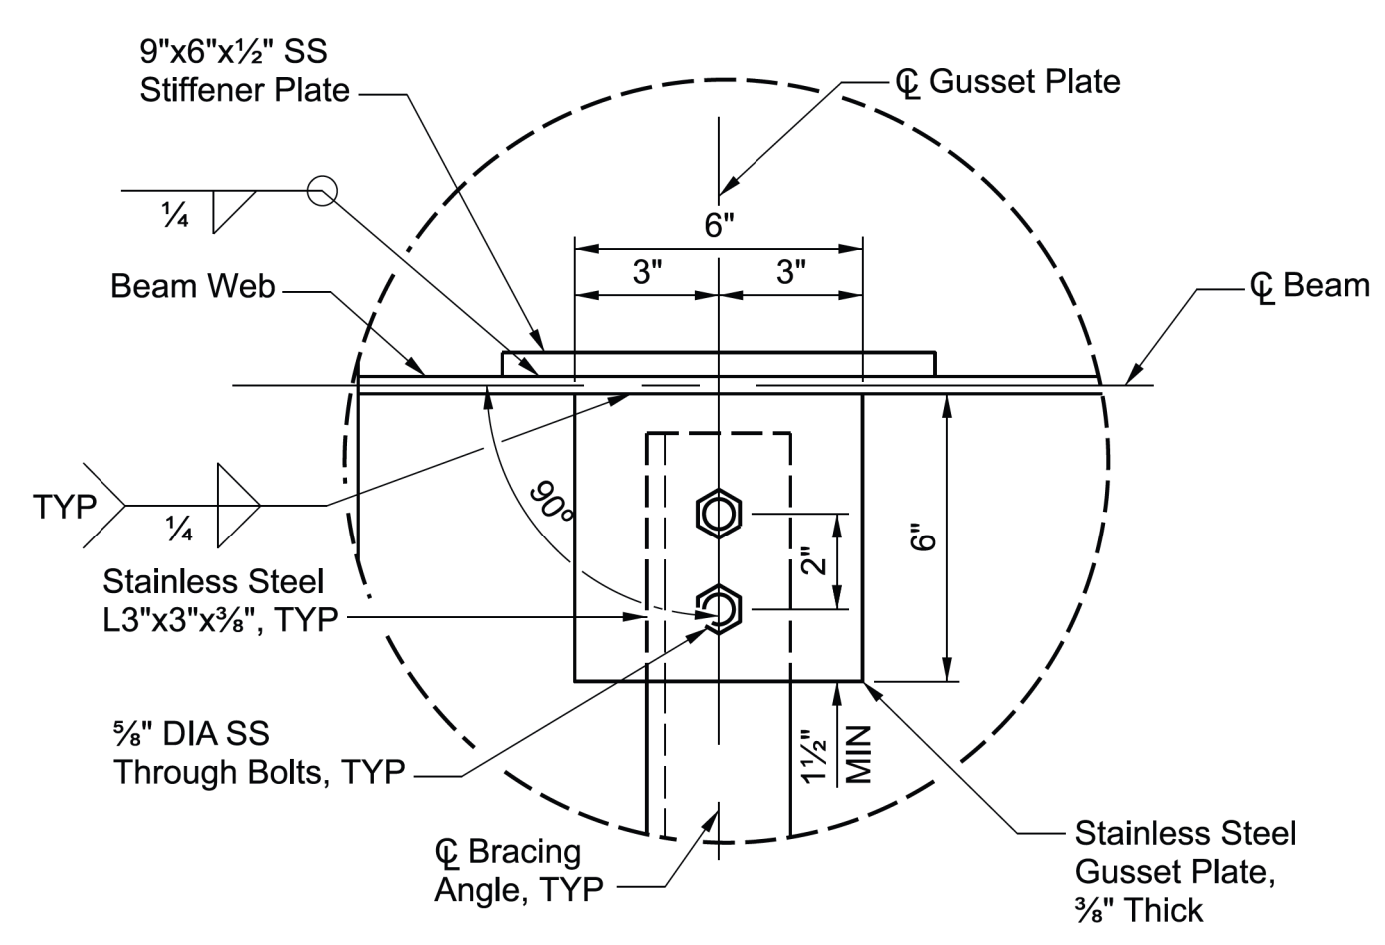

**DETAIL E**  
SCALE: 3"=1'-0"

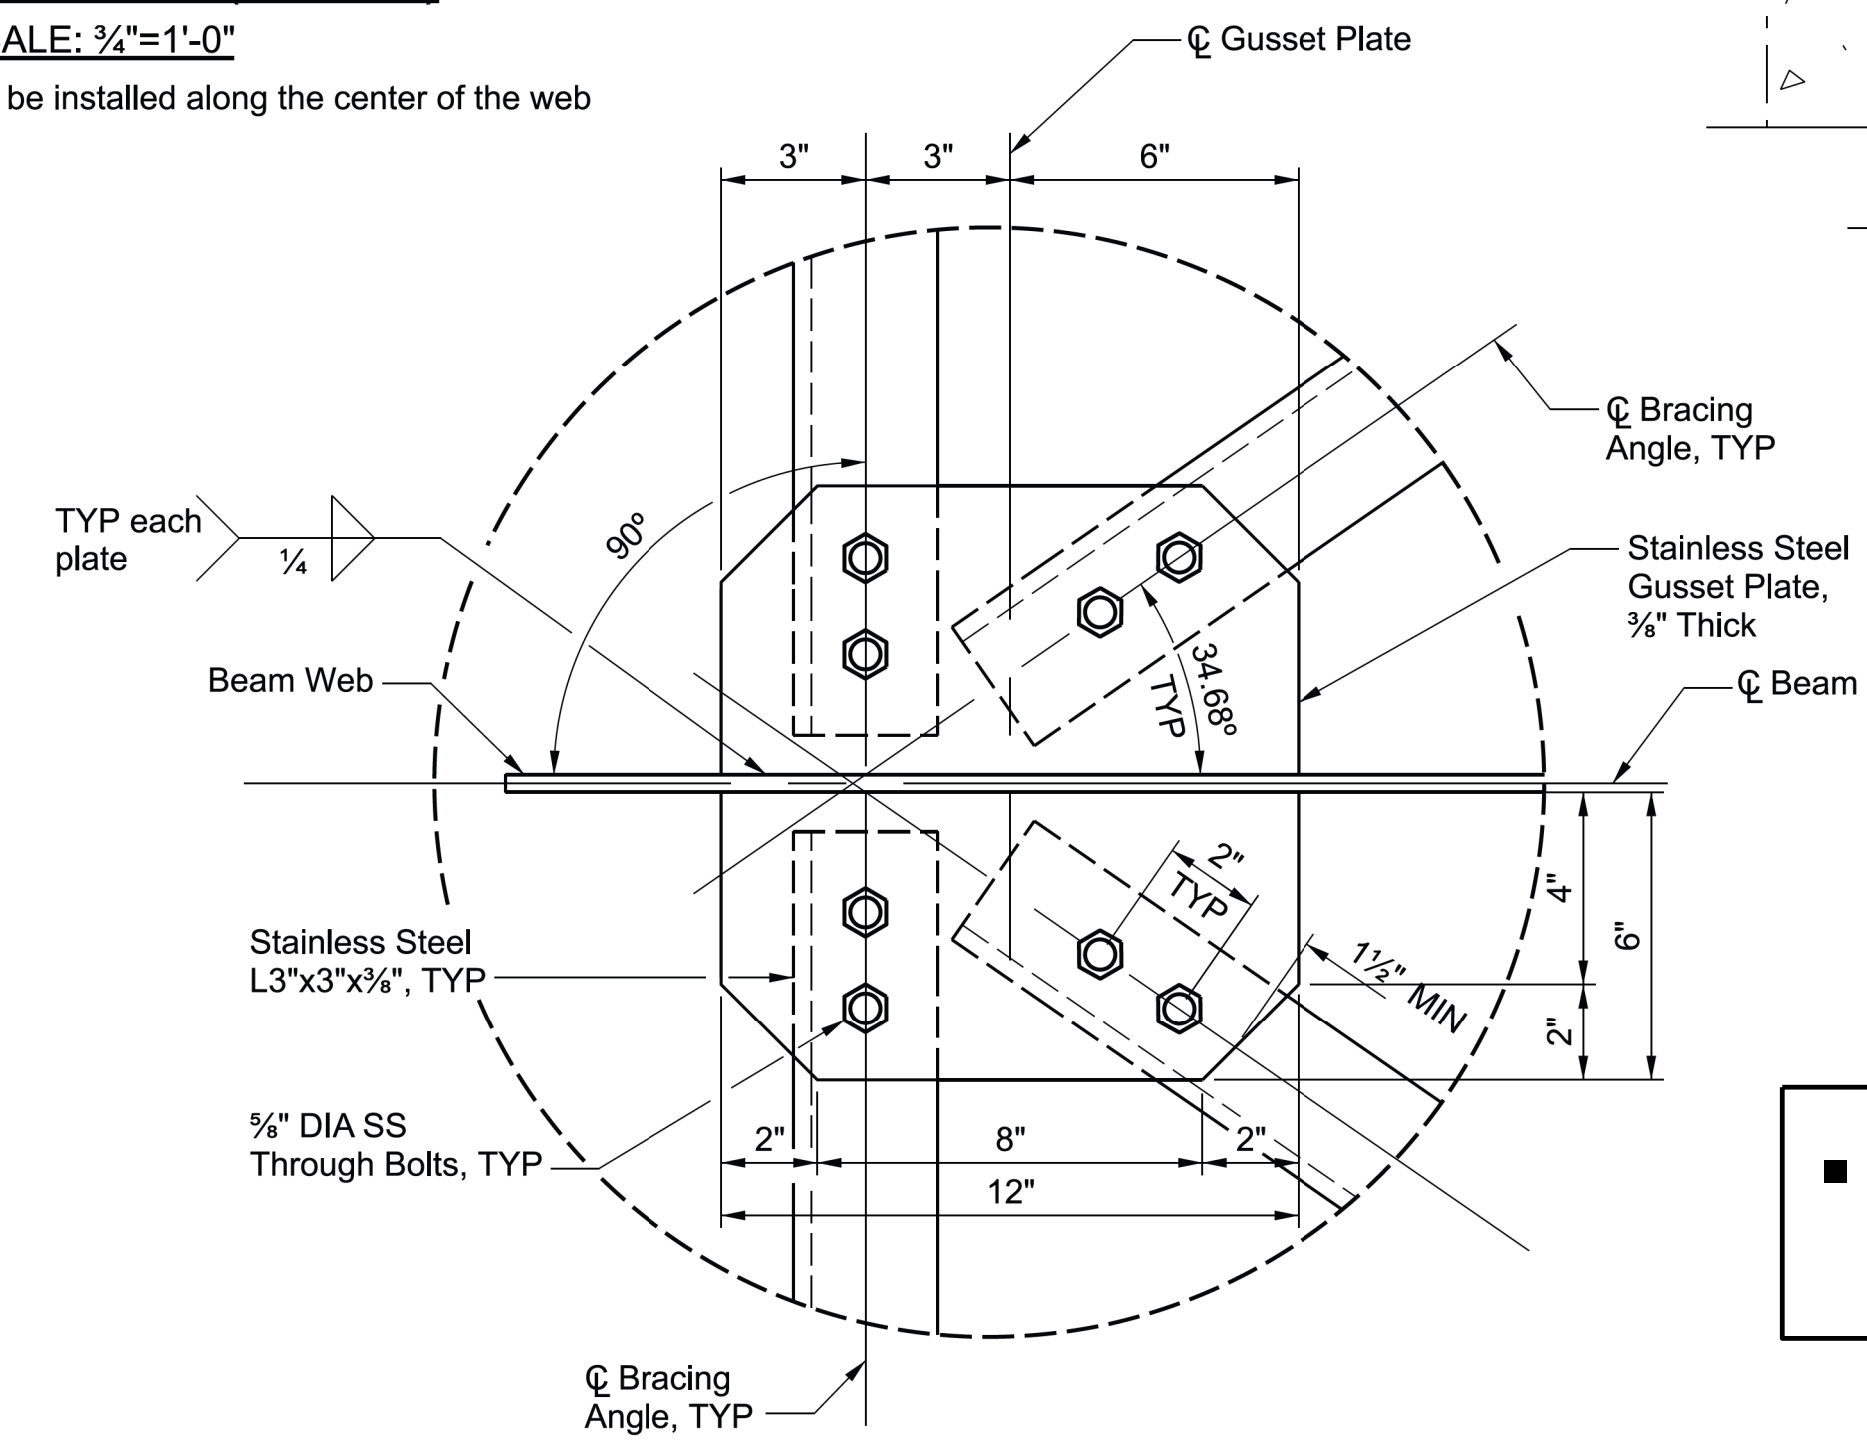


**DETAIL F**  
SCALE: 3"=1'-0"

NOTE:  
■ 1. FRAME TO BE FABRICATED TO FIT 6 EACH W8x40 BEAMS AS INSTALLED PER TEMPLATE.  
2. GROUT BETWEEN SS AND CONCRETE TO FILL VOIDS AS NECESSARY.


CADD PROJECT FILE NAME: FCC0001318 Project No. 275-513 Ocean Outlet Modifications.dgn  
CHECKER: S. GREGOWSKIE  
DESIGNER: J. LU  
DRAFTER: J. LU

DATE	MARK	DESCRIPTION
02/17/2022	■	AS BUILT REVISIONS
REVISIONS		

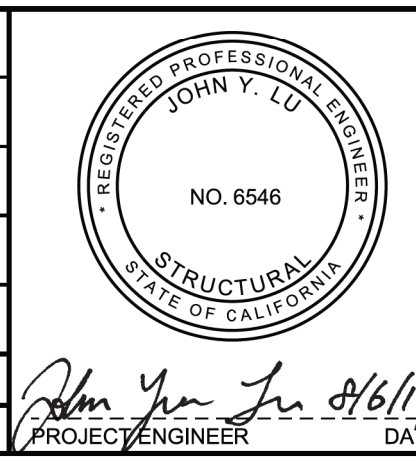


LOS ANGELES COUNTY PUBLIC WORKS  
**PROJECT NO. 275-513**  
OCEAN OUTLET MODIFICATIONS  
(STA. 0+87 - 3+64)  
PROJECT ID NO. FCC0001318  
WAVE PROTECTION BARRIER - SECTIONS AND DETAILS II  
DWG 275-513-D19.11 PD PD053002 SHEET 11 OF 11


AS BUILT DRAWINGS

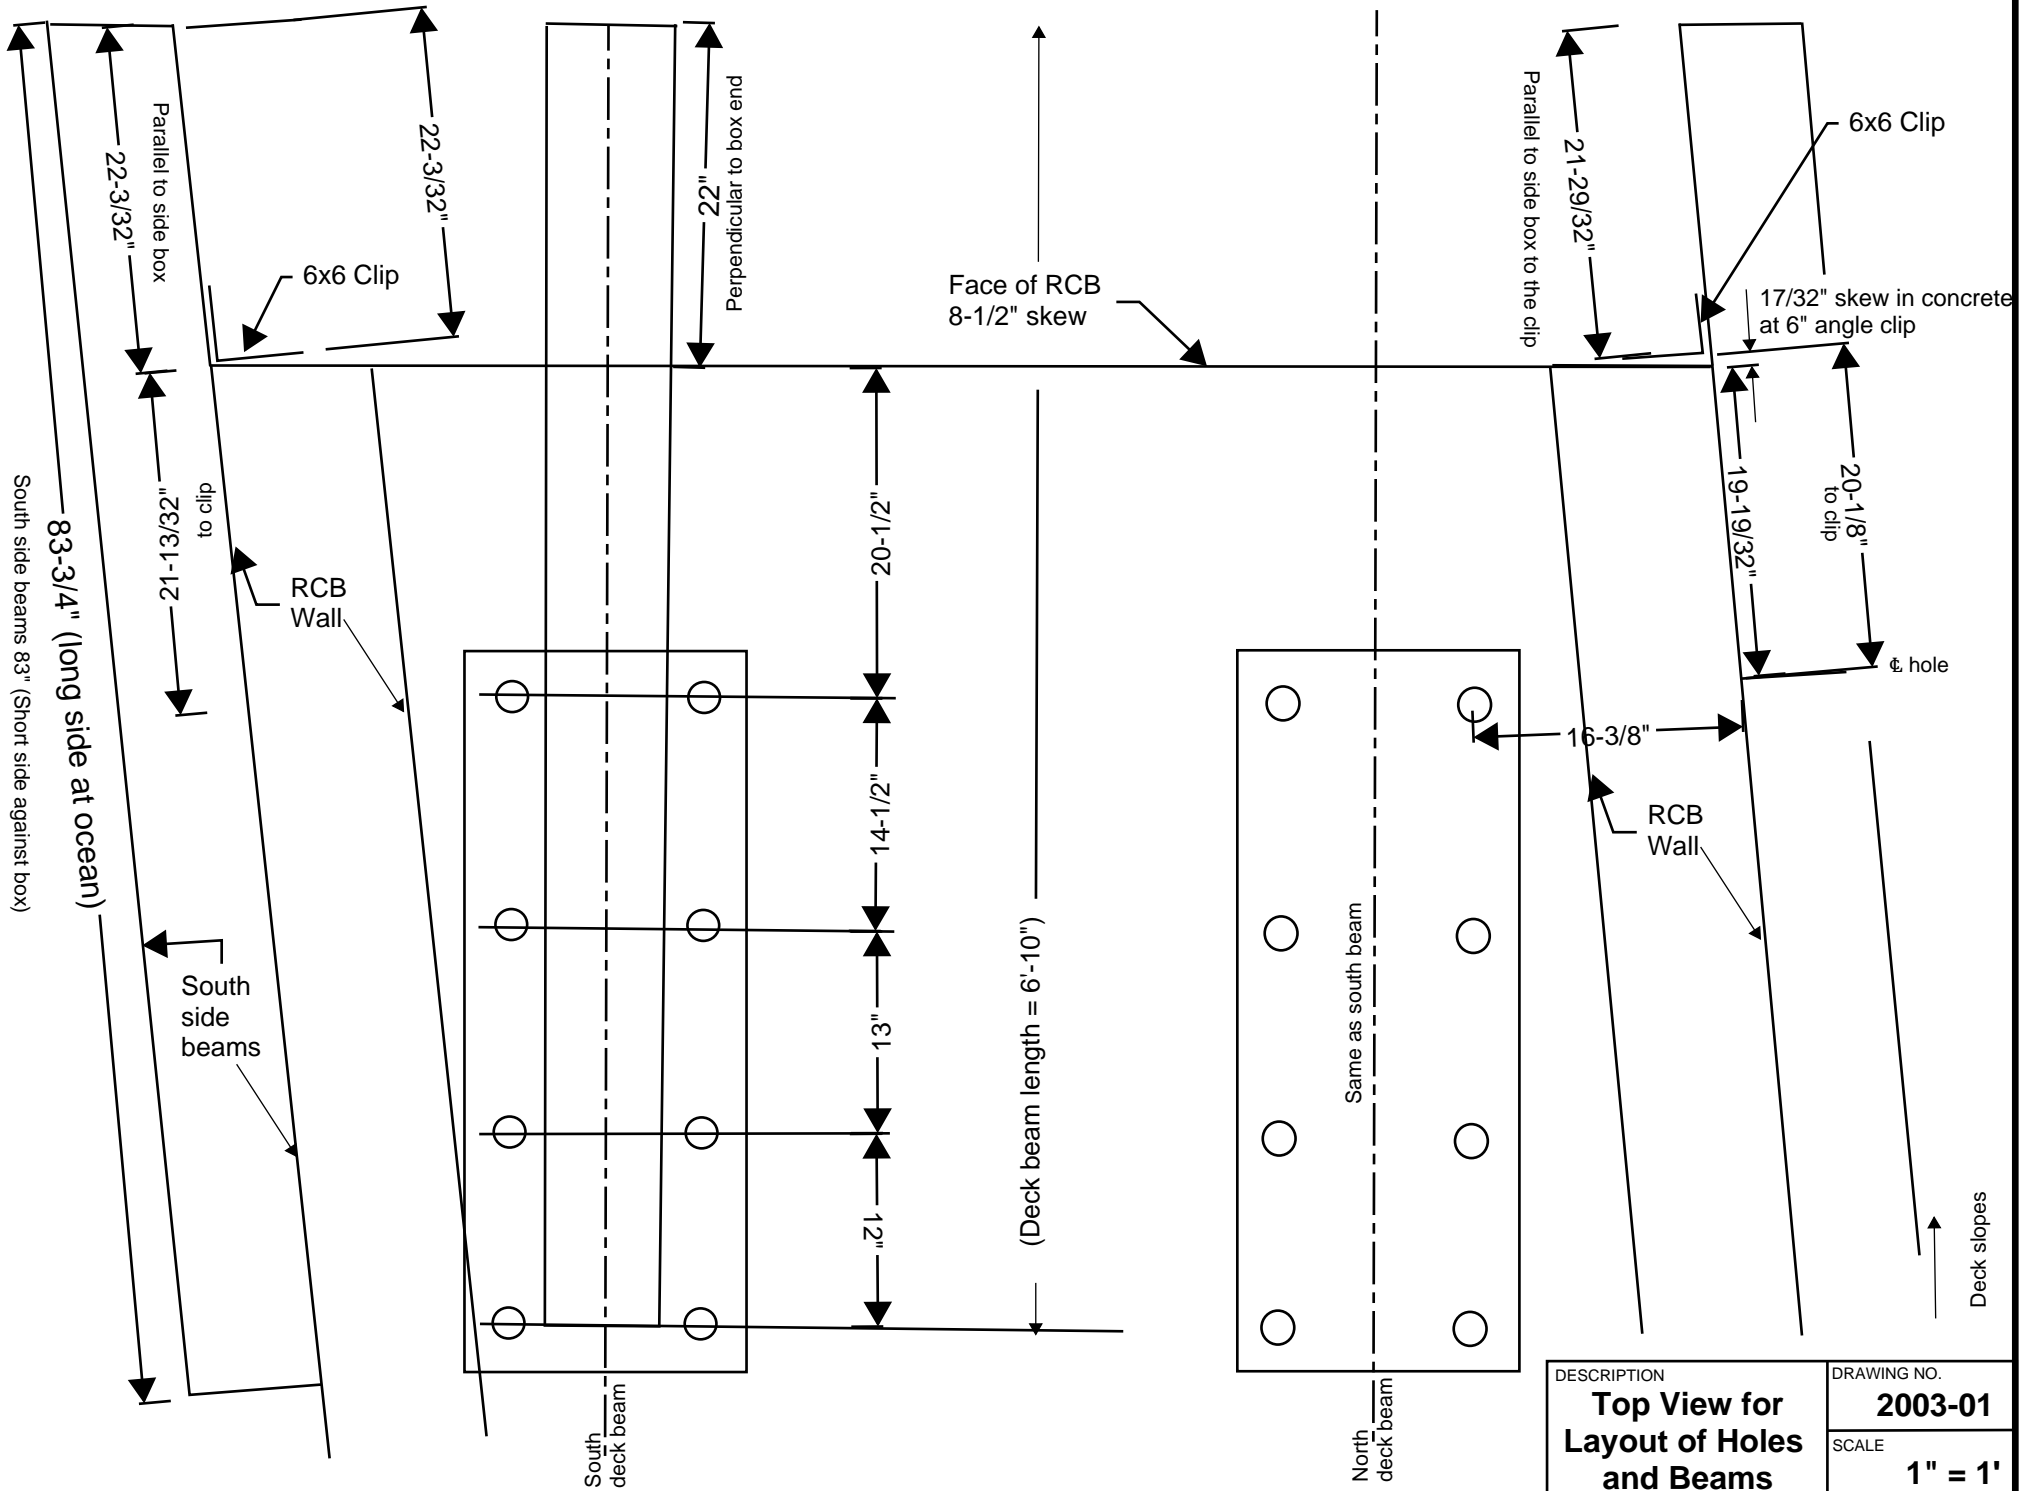


DESCRIPTION	DRAWING NO.
<b>Top View for Layout of Holes and Beams</b>	<b>2003-01</b>
SCALE	<b>1" = 1'</b>

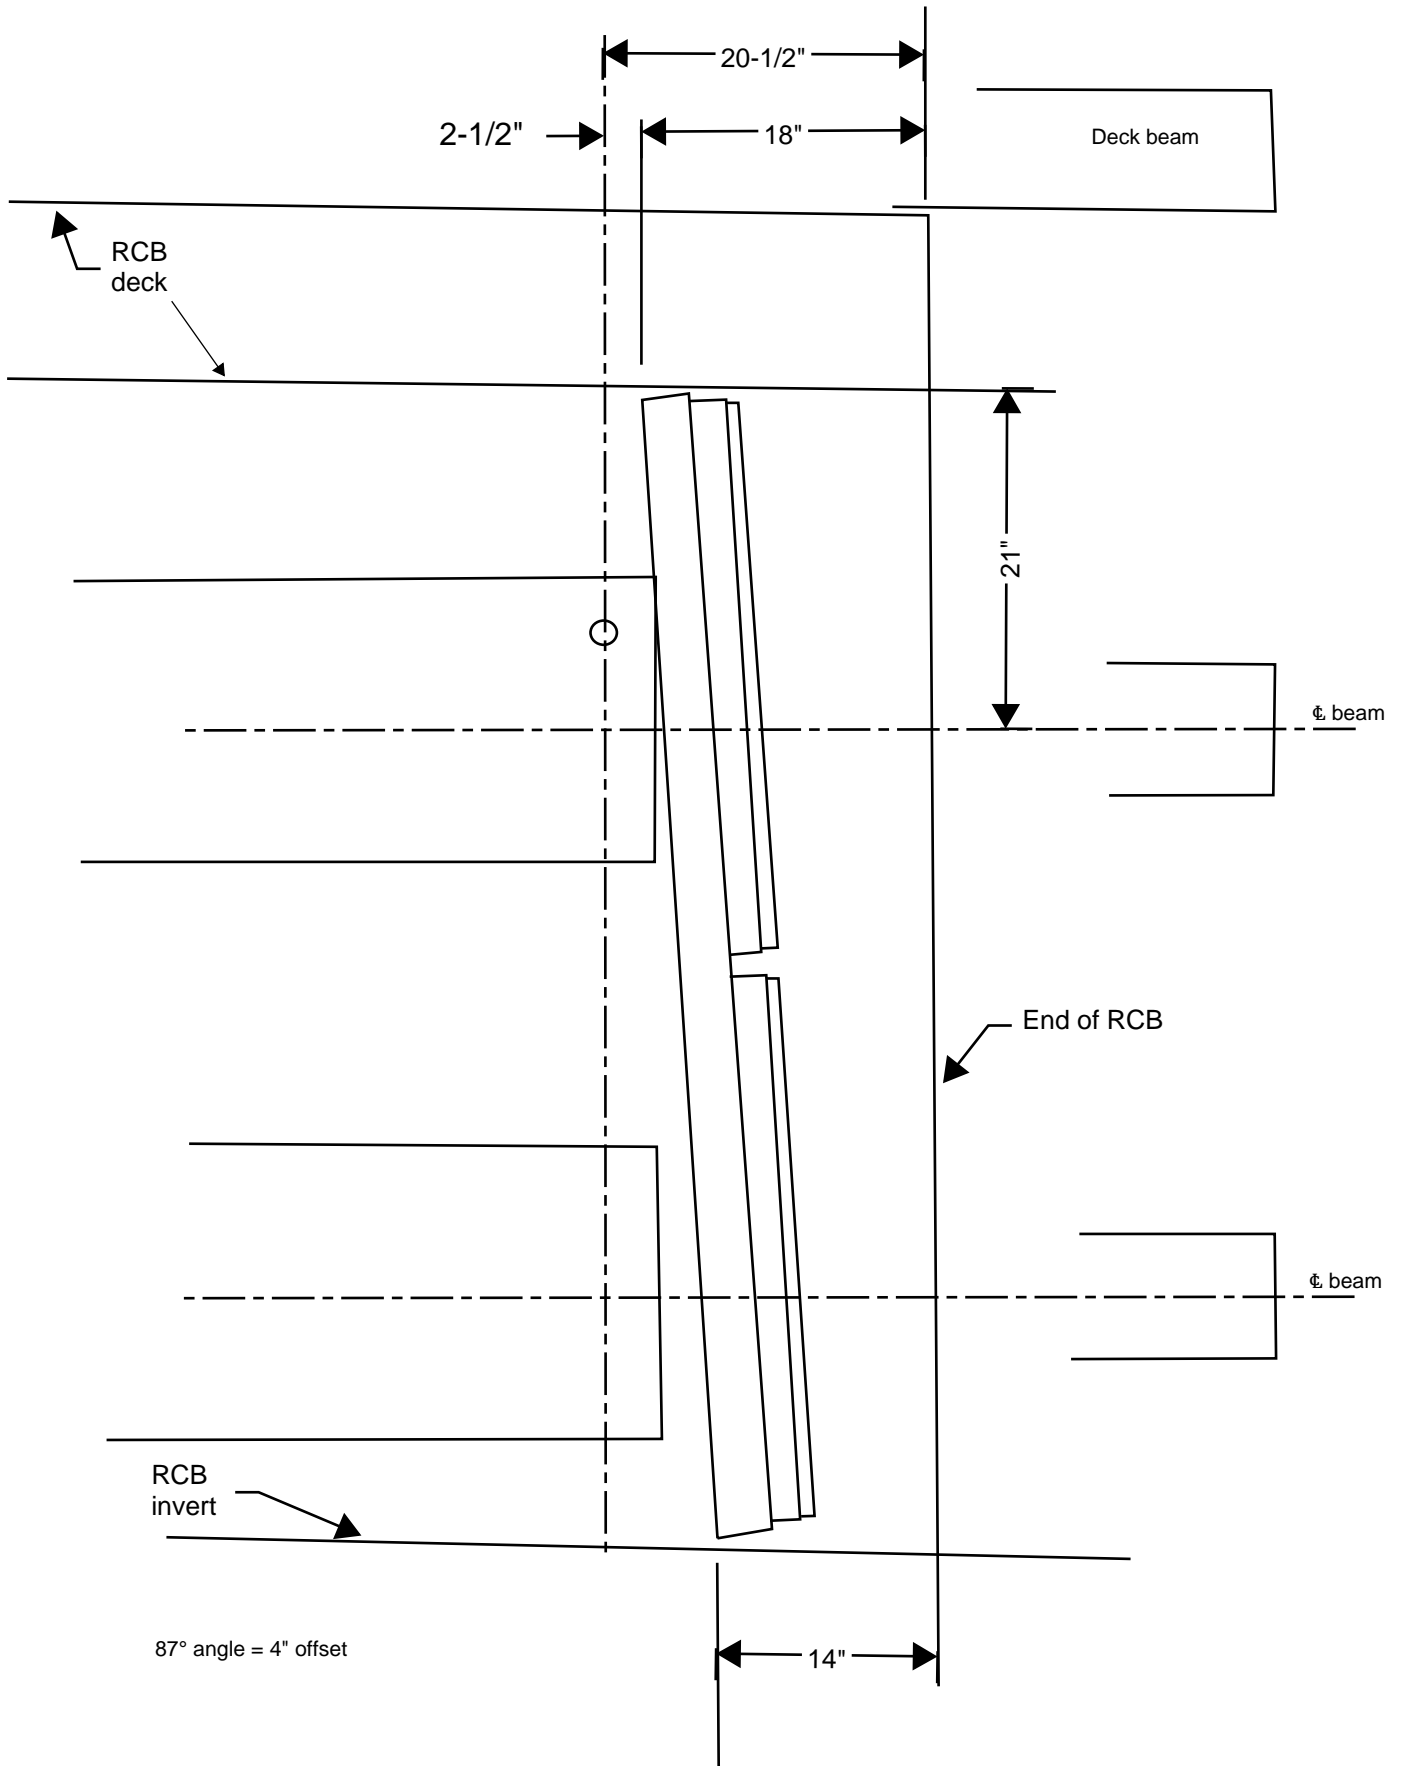


DESCRIPTION	DRAWING NO.
<b>Inside South Wall RCB Flap Gate Position</b>	<b>2003-02</b>
	SCALE
	<b>1" = 1'</b>

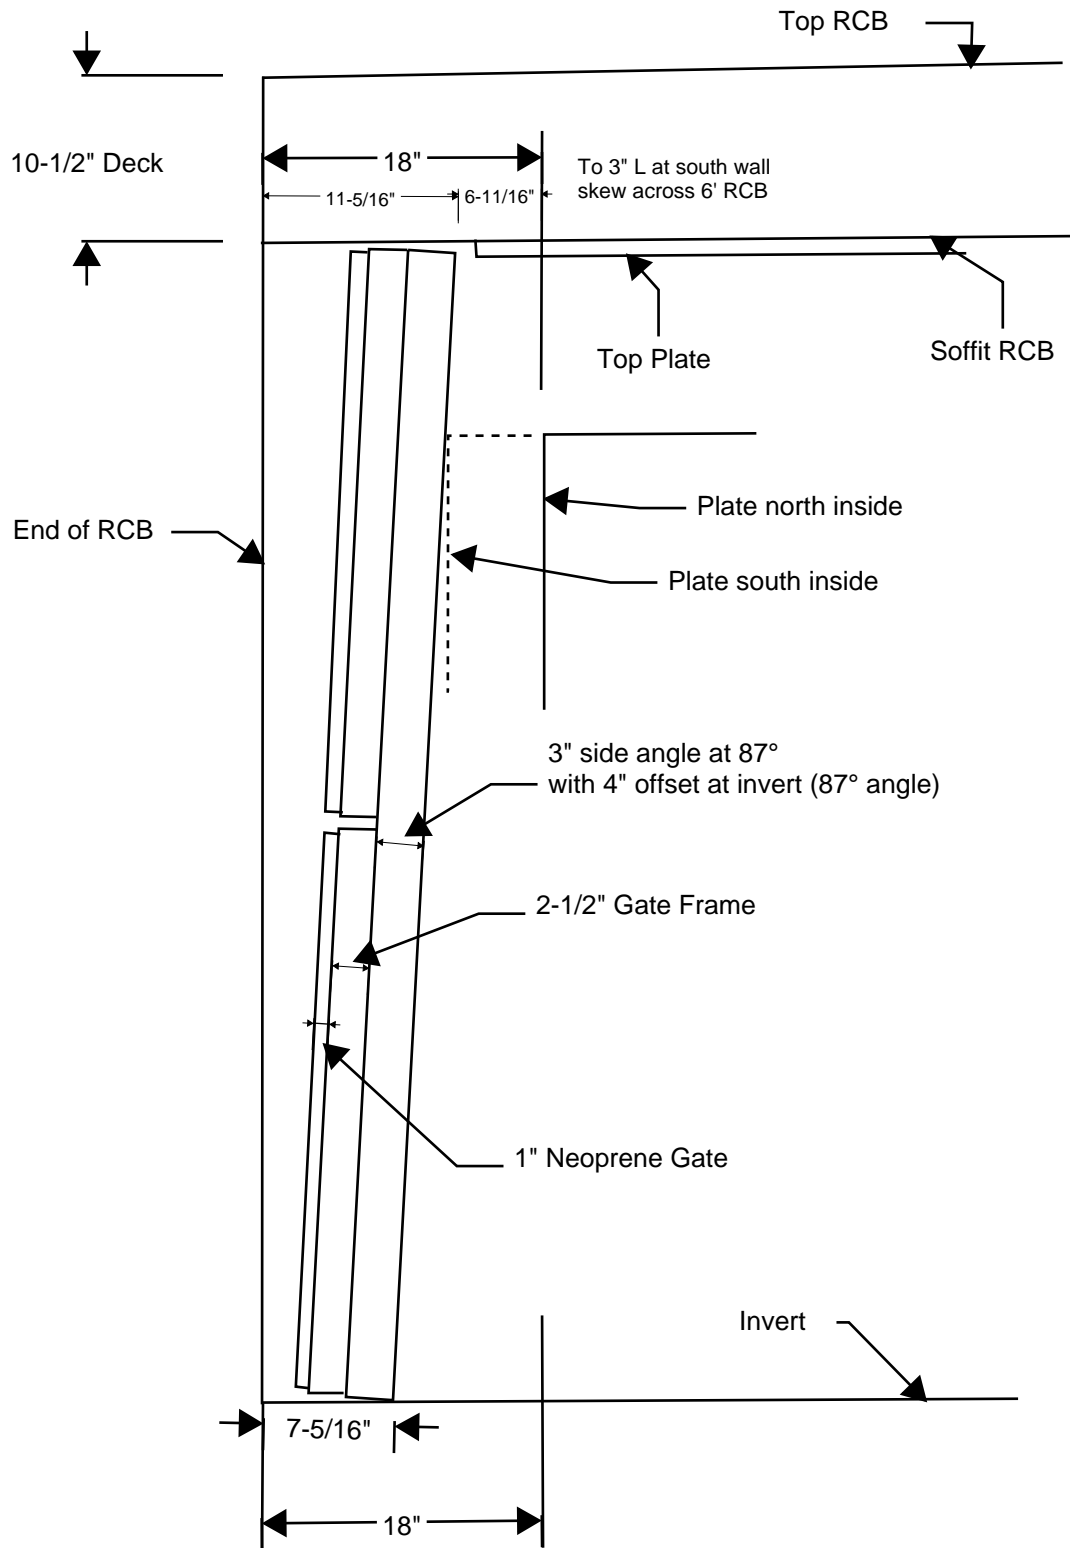

DESCRIPTION	DRAWING NO.
<b>Flap Gate Position Inside North Wall RCB</b>	<b>2003-03</b>
	SCALE
	<b>1" = 1'</b>

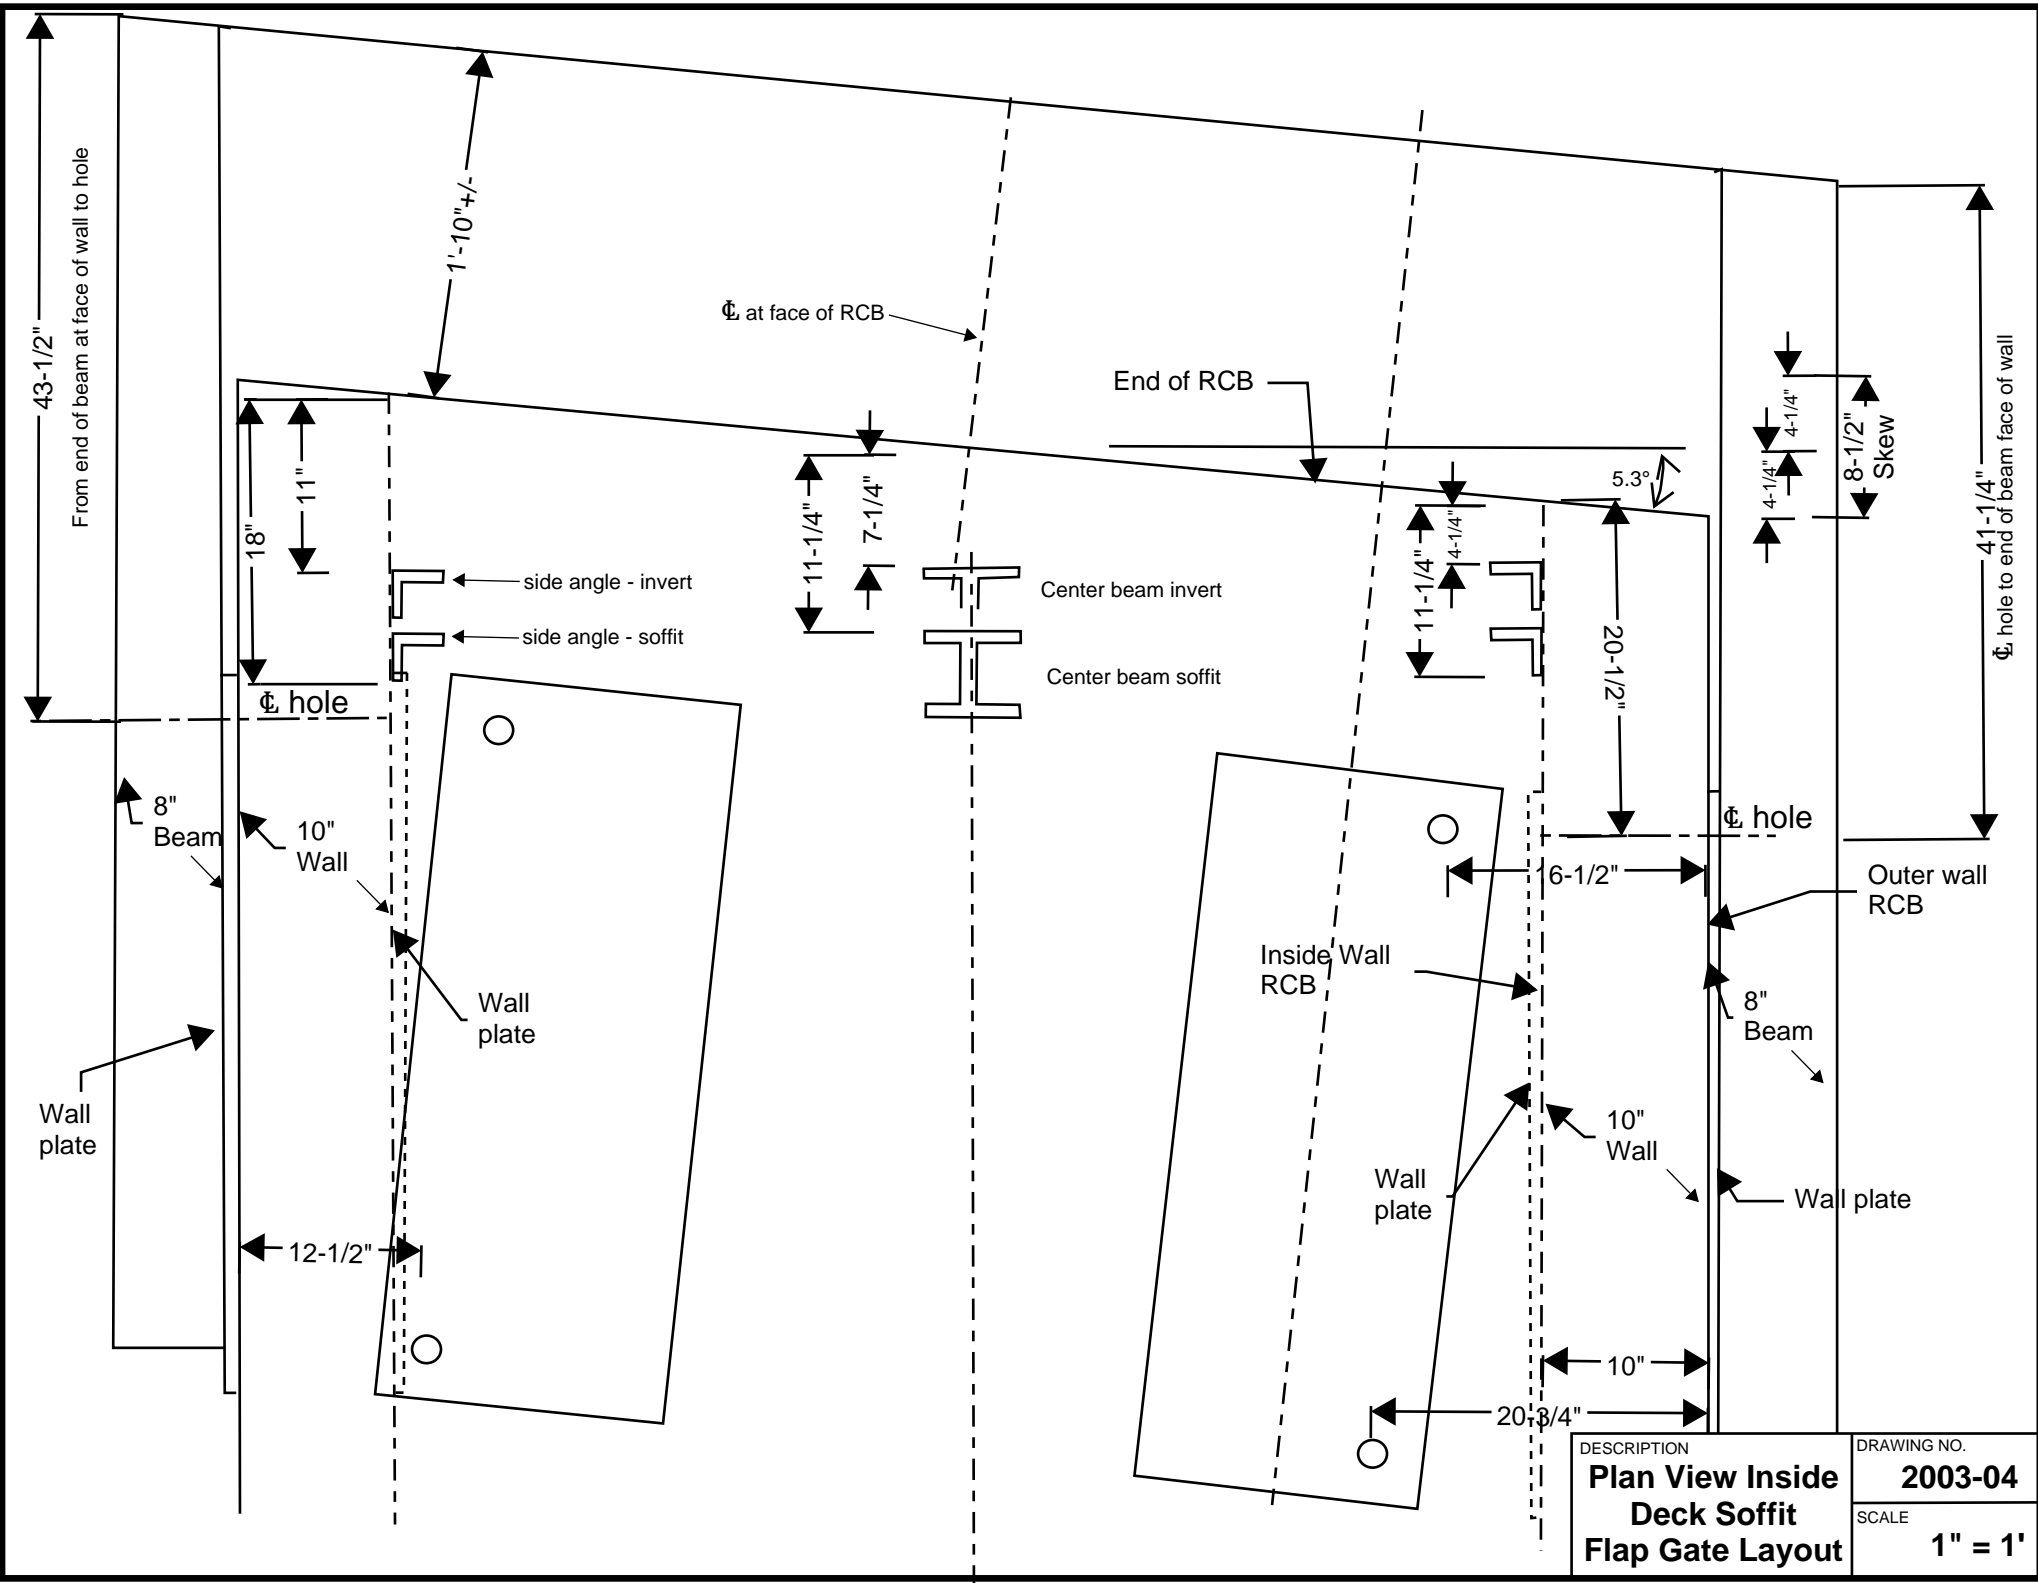


DESCRIPTION <b>Plan View Inside          Deck Soffit          Flap Gate Layout</b>	DRAWING NO. <b>2003-04</b>
	SCALE <b>1" = 1'</b>

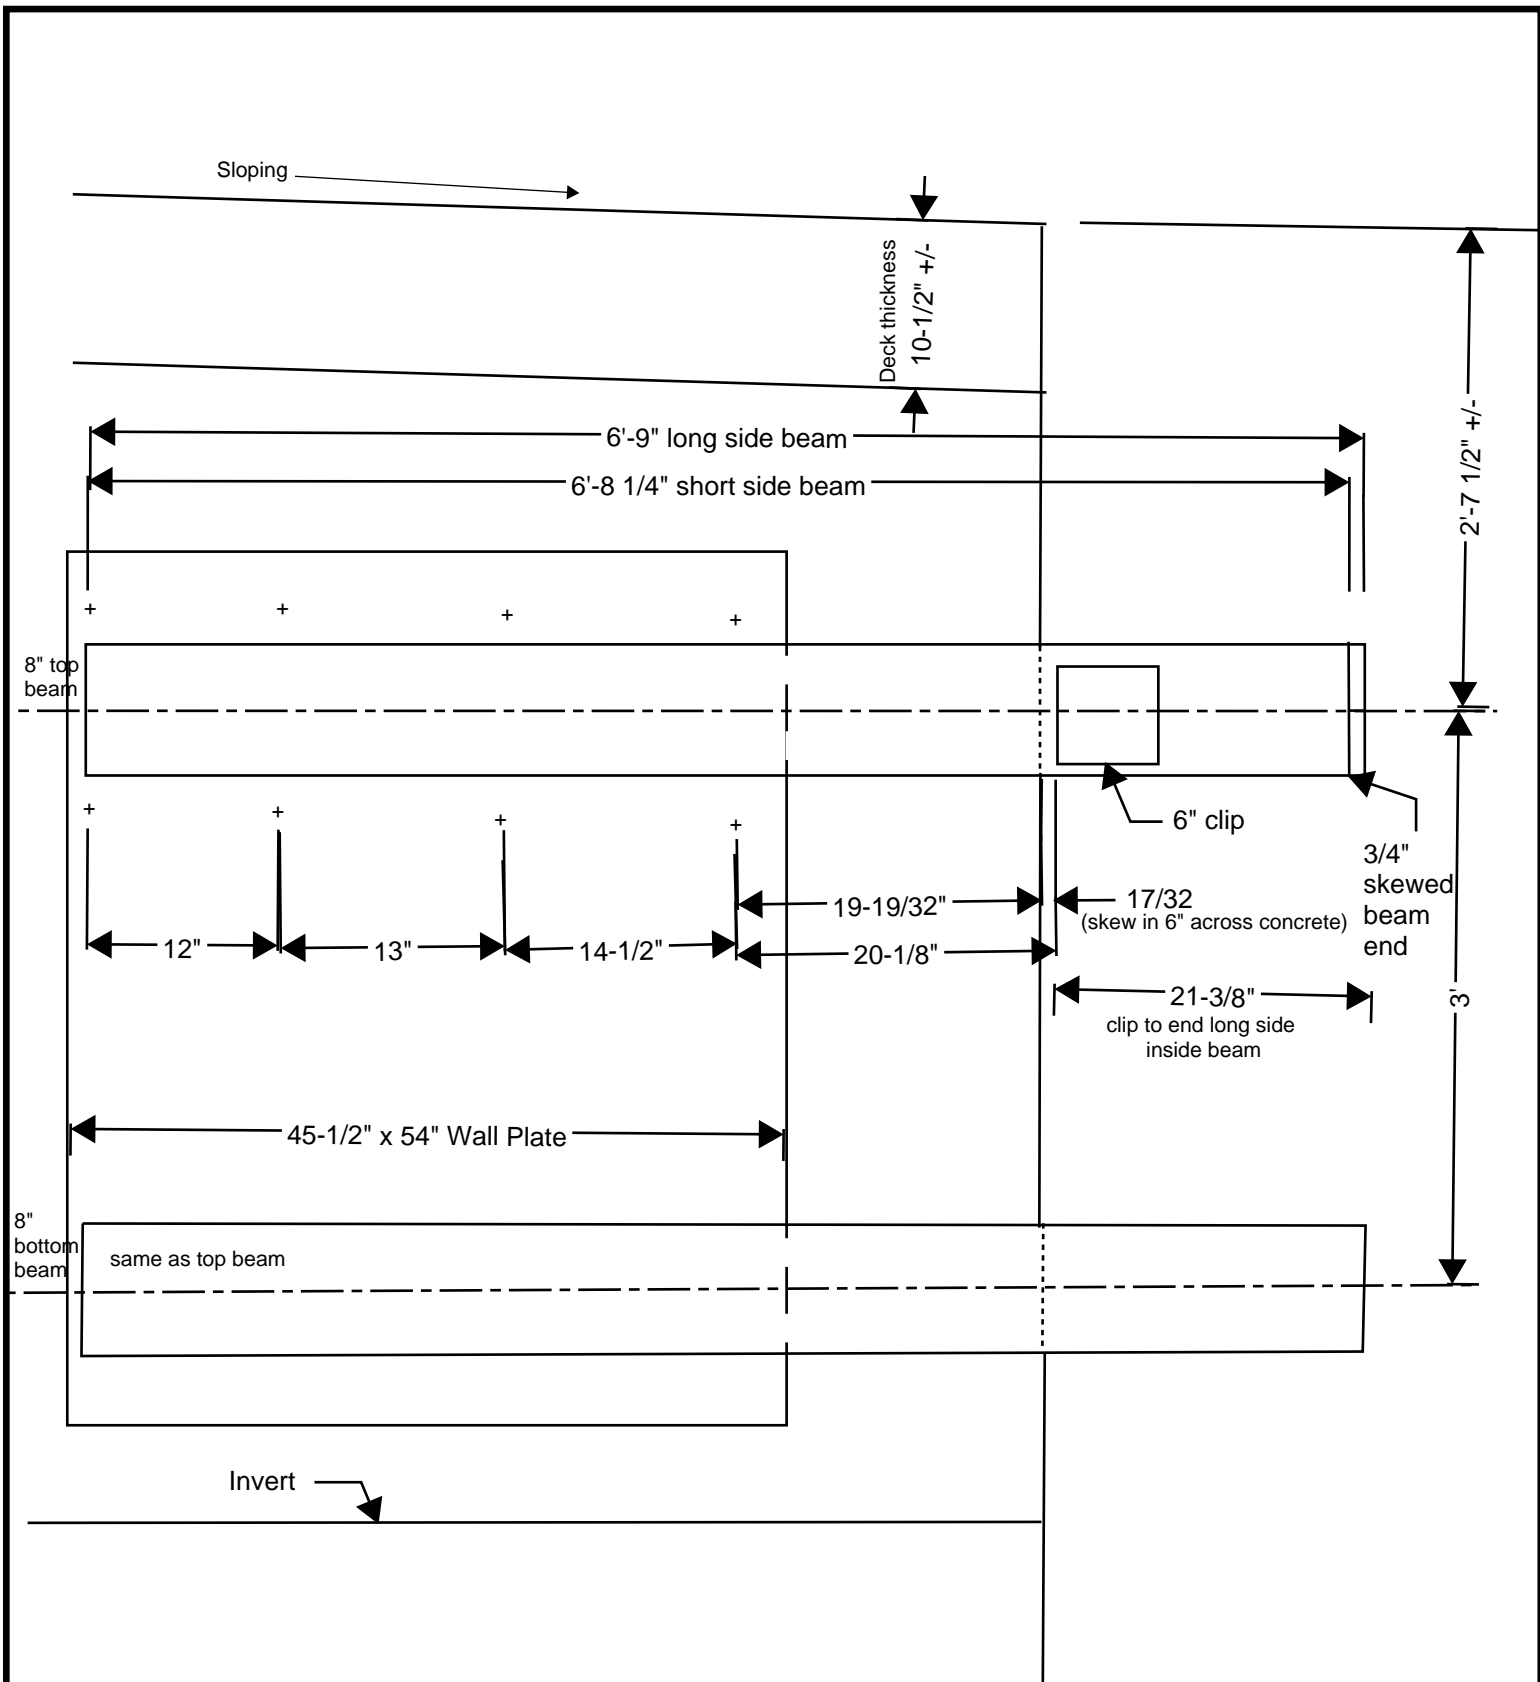

DESCRIPTION <b>Wave Barrier Beam Support at North Outside Wall RCB</b>	DRAWING NO. <b>2003-05</b>
	SCALE <b>1" = 1'</b>



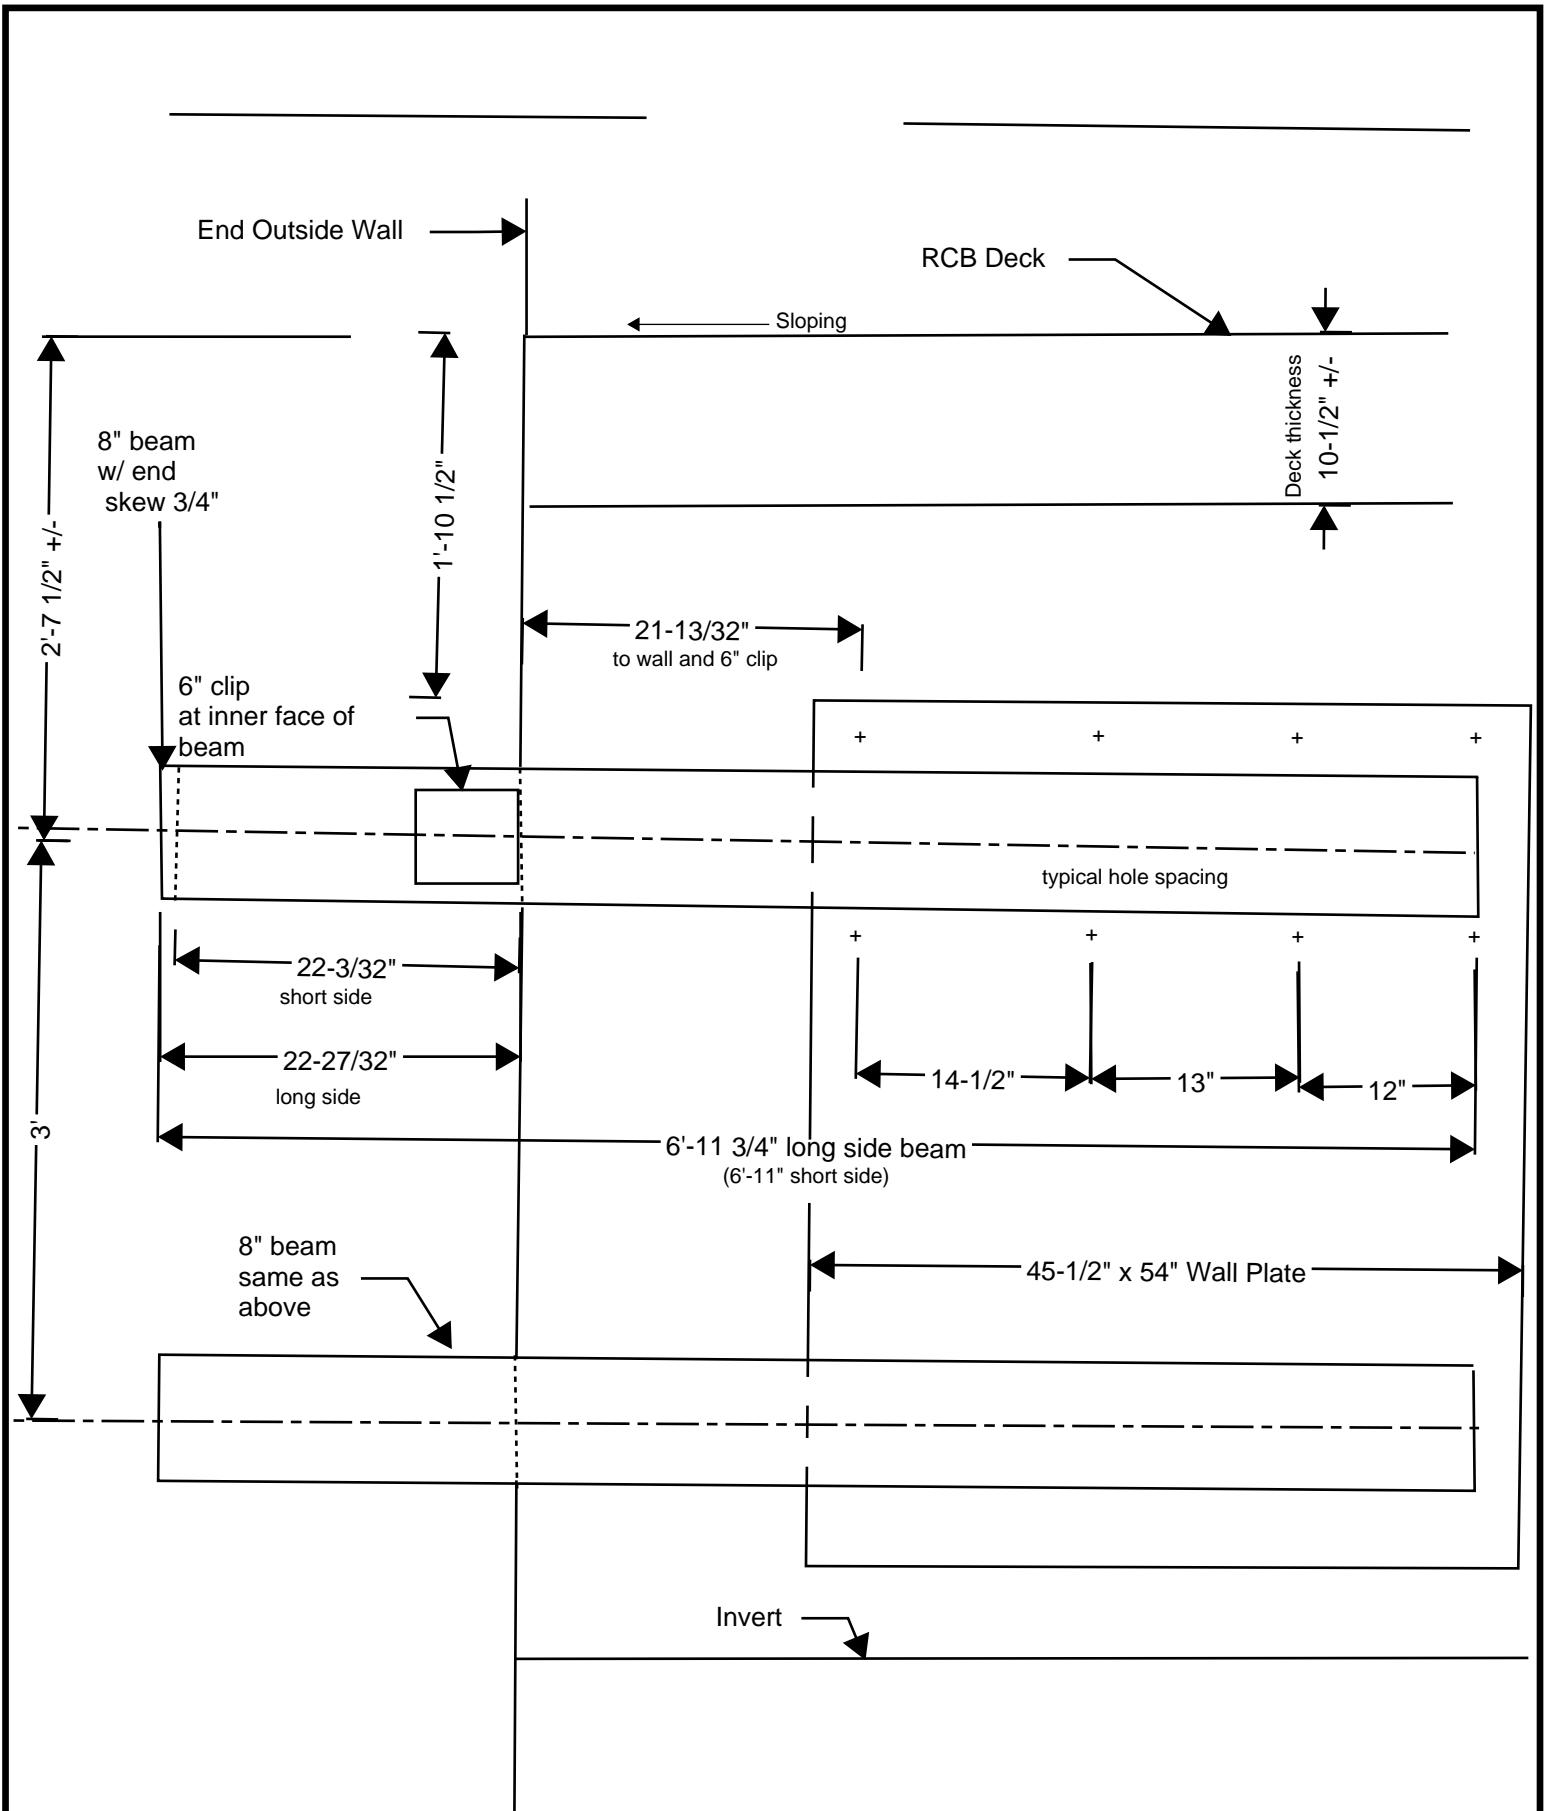

DESCRIPTION	DRAWING NO.
<b>Wave Barrier Beam Support at South Outside Wall RCB</b>	<b>2003-06</b>
SCALE	<b>1" = 1'</b>