


LOS ANGELES COUNTY PUBLIC WORKS

EAST LOS ANGELES


SUSTAINABLE MEDIAN

STORMWATER CAPTURE PROJECT

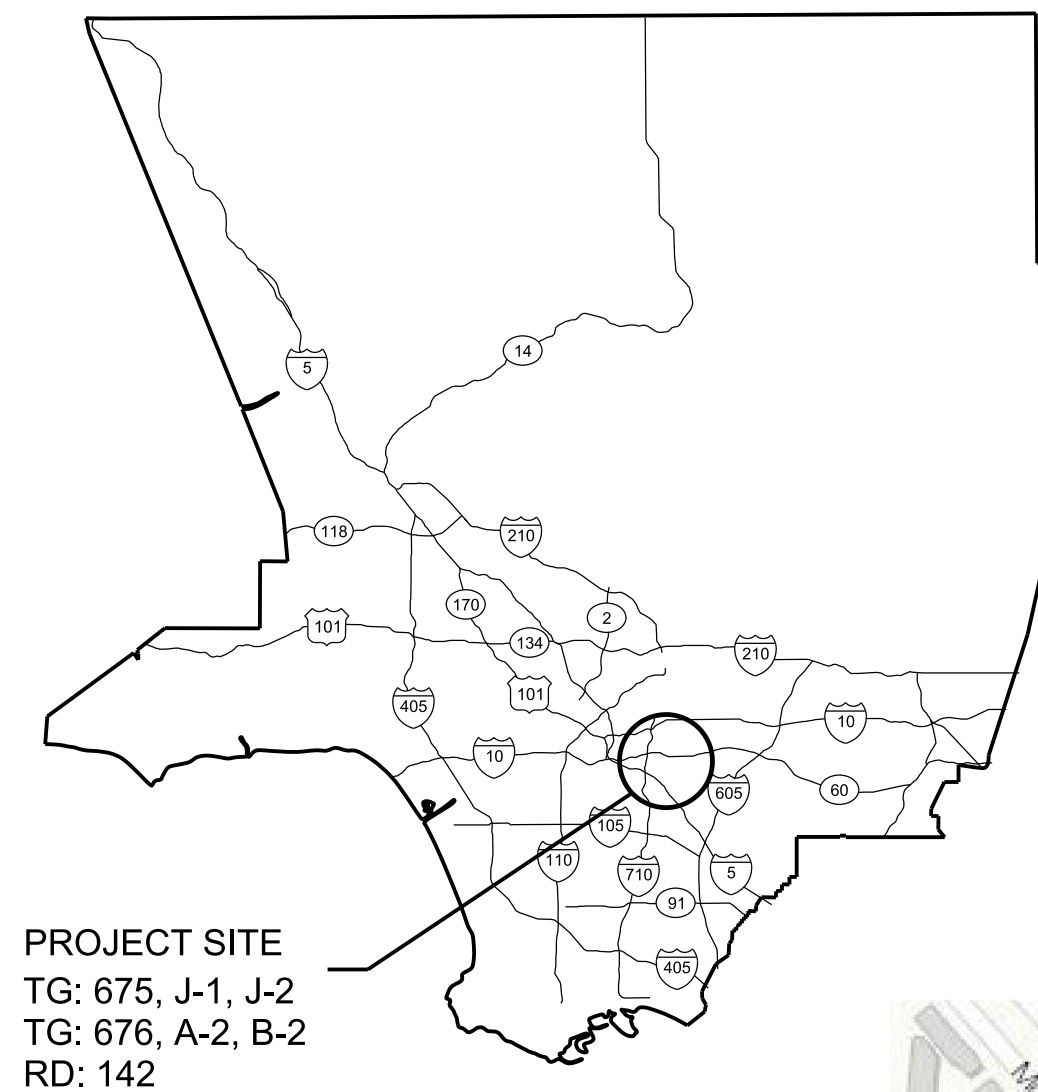

PROJECT SITE
TG: 675, J-1, J-2
TG: 676, A-2, B-2
RD: 142

VICINITY MAP

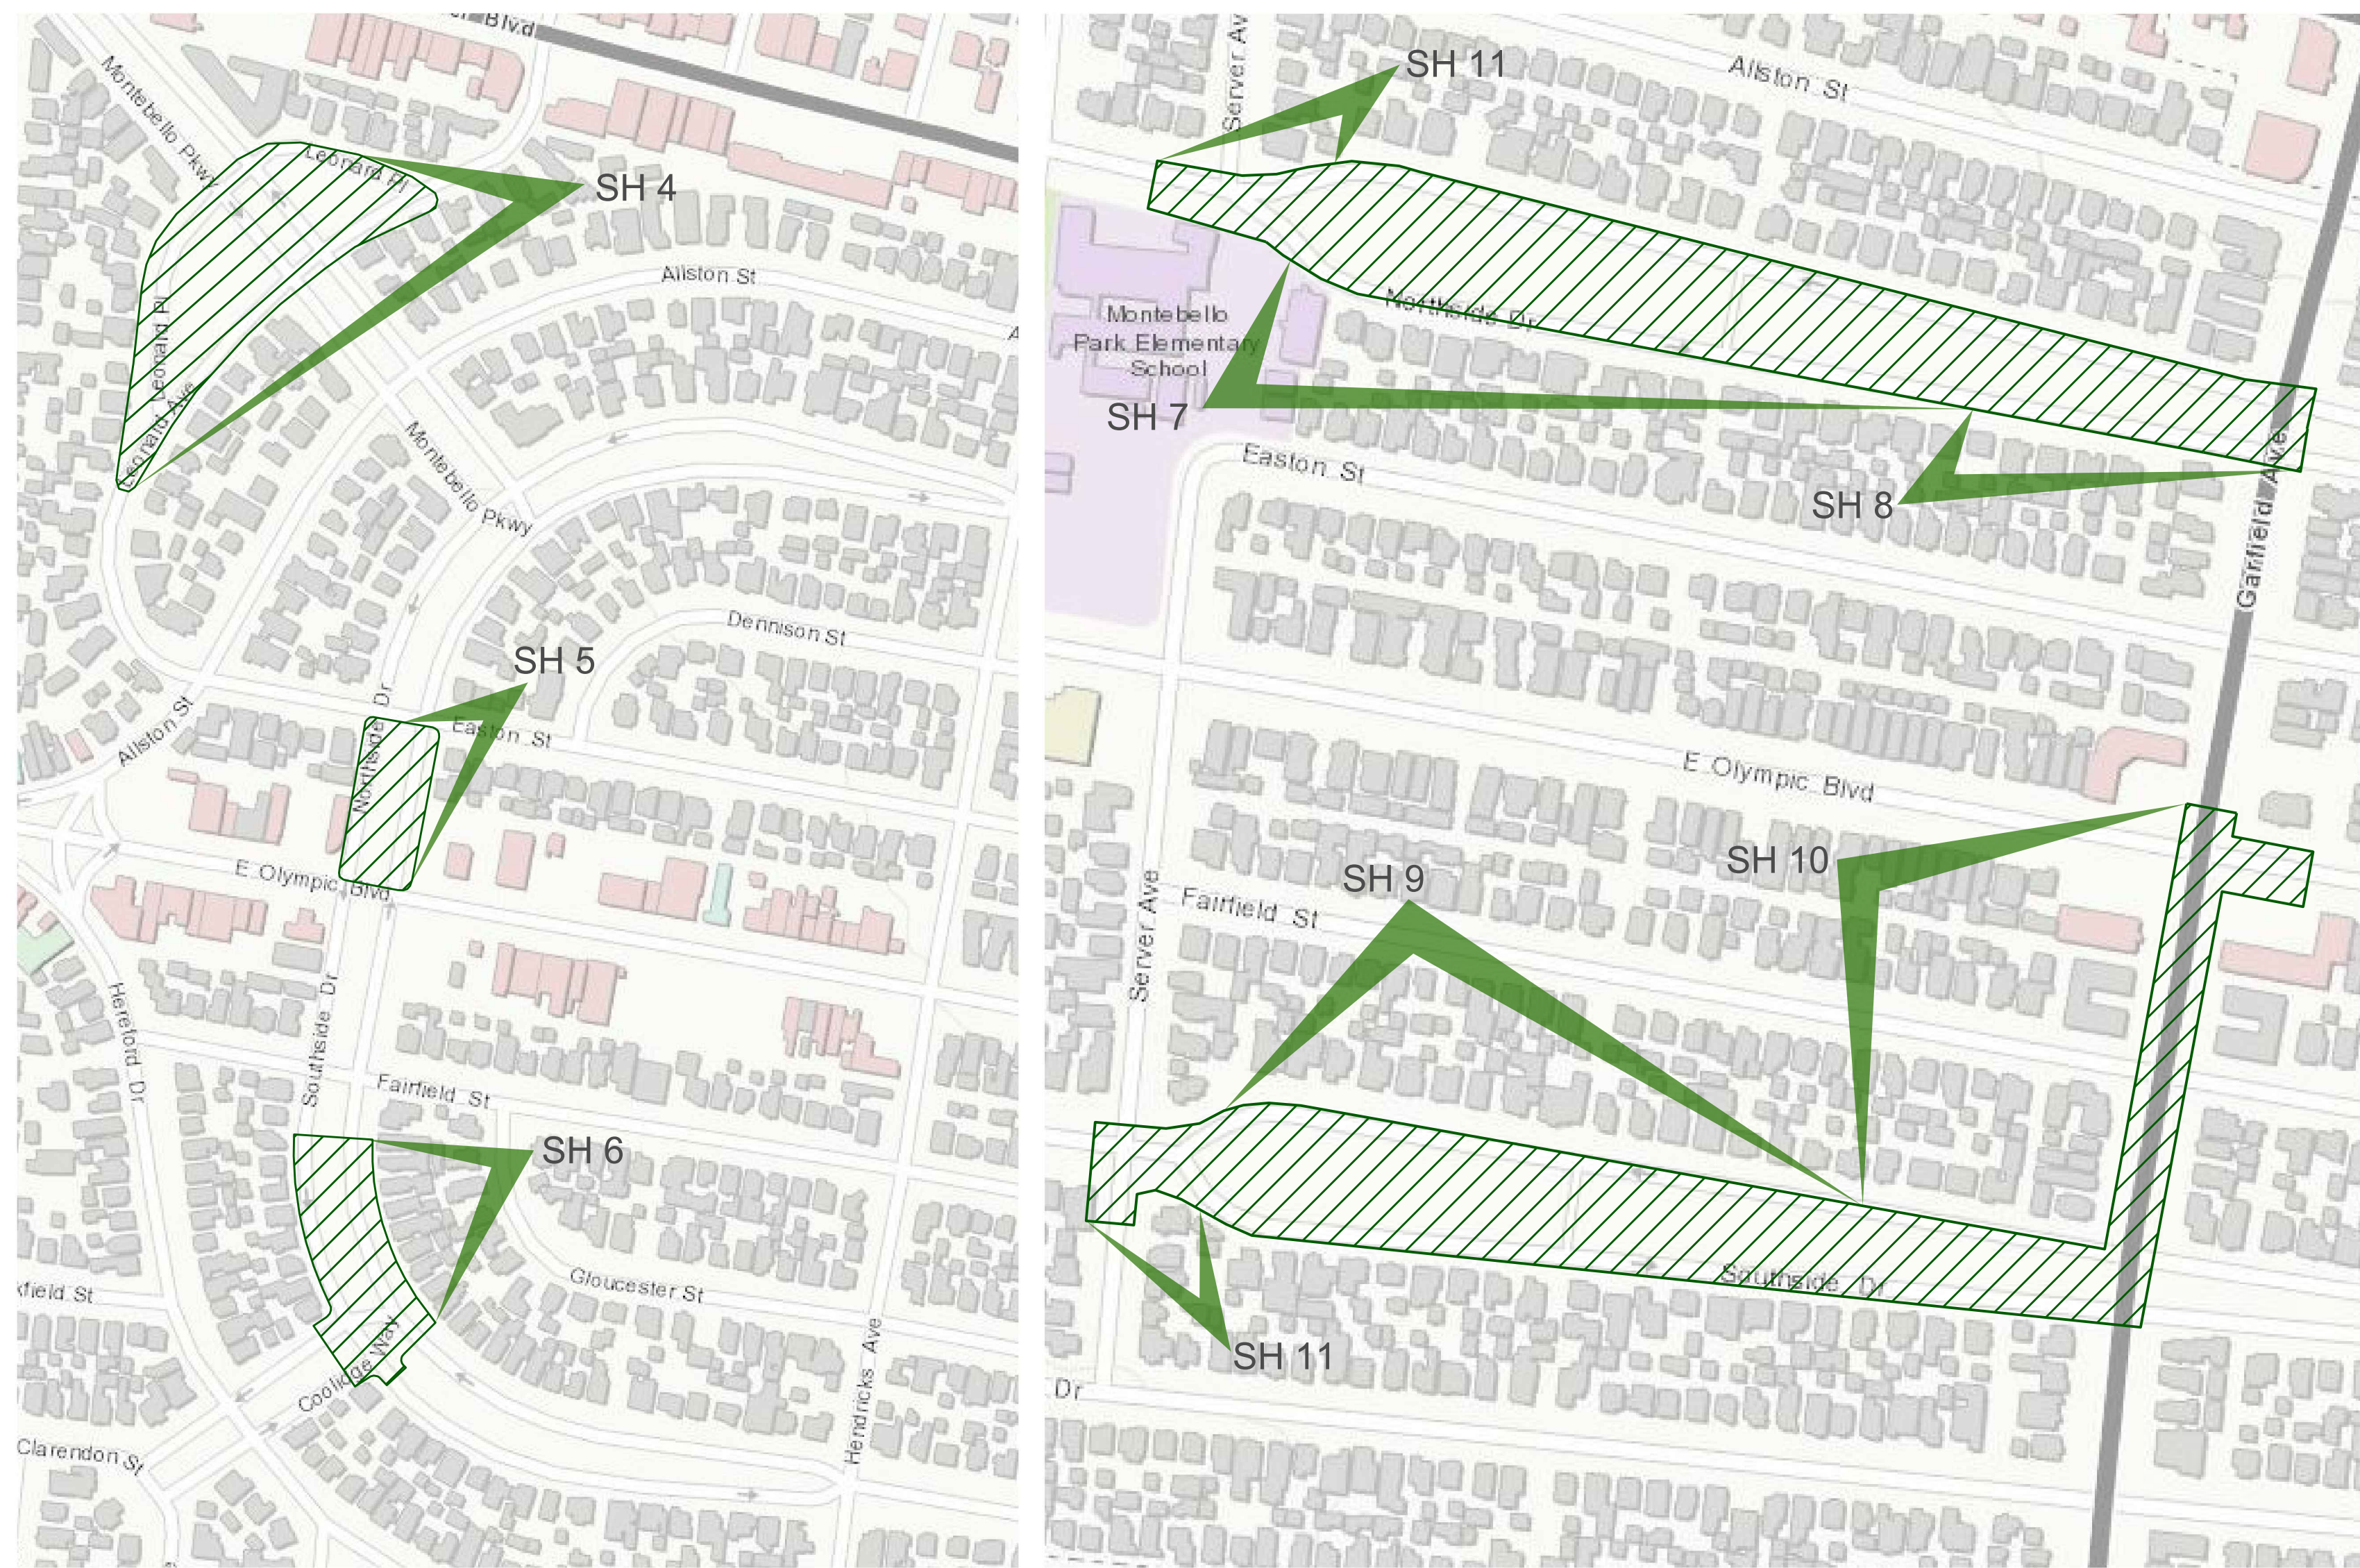

INDEX TO PROJECT PLANS

SHEET NO.	DESCRIPTION
1	TITLE SHEET
2	CONSTRUCTION NOTES AND LEGENDS
3	LID DETAILS
4	PLAN AND PROFILE - MONTEBELLO PKWY DRY WELLS, LINES A-1 AND A-2
5	PLAN AND PROFILE - NORTHSIDE DR STRUCTURAL CELL MODULES AND DRY WELLS, LINES A-3, A-4, A-5, AND A-6
6	PLAN AND PROFILE - SOUTHSIDE DR DRY WELLS AND DIVERSION LINE, LINE B-1
7	PLAN AND PROFILE - NORTHSIDE DR DRY WELLS, LINE C-1
8	PLAN AND PROFILE - NORTHSIDE DR DRY WELLS AND DIVERSION LINE, LINE C-1
9	PLAN AND PROFILE - SOUTHSIDE DR DRY WELLS, LINE D-1
10	PLAN AND PROFILE - SOUTHSIDE DR DRY WELLS AND DIVERSION LINE, LINE D-1
11	PLAN AND PROFILE - LINES E-1 AND F-1
12	PLAN - MEDIAN EXTENSION DETAILS
13	CONSTRUCTION DETAILS AND DRY WELL TABLE
14	WATER MONITORING PLAN
15-16	FILTRATION UNIT DETAILS
17-18	STRUCTURAL DETAILS AND SECTIONS
19-26	LOGS OF BORINGS
27	FILTRATION UNIT DETAILS
PLAN EE	ELECTRICAL PLANS
PLAN LS	LANDSCAPE PLANS
PLAN ME	MECHANICAL PLANS
PLAN SP	SIGNING, STRIPING, AND PEDESTRIAN SIGNAL PLANS
PLAN TC	TRAFFIC CONTROL PLANS
■ SCE	UTILITY RELOCATION PLAN

UTILITIES

GAS:	SOUTHERN CALIFORNIA GAS COMPANY
POWER:	SOUTHERN CALIFORNIA EDISON
SEWER:	SANITATION DISTRICT OF LOS ANGELES COUNTY
TELEPHONE:	AT&T
WATER:	CALIFORNIA WATER SERVICE COMPANY

REFERENCES

MONTEBELLO LMD - PHASE II INFILTRATION FEASIBILITY INVESTIGATION (DATED 12/04/17)
SURVEY FIELD NOTES: PWFB 1124 PAGES 2921-2962, 2969-2977

LOCATION	85TH PERCENTILE 24-HR CAPTURE VOLUME [AC-FT]	DRAINAGE AREA [AC]	85TH PERCENTILE DESIGN FLOW [CFS]	85TH PERCENTILE PEAK FLOW (DRAINAGE AREA) [CFS]	NUMBER OF 52"-INNER DIAMETER DRY WELLS
MONTEBELLO PKWY DRY WELLS, LINE A-1	3.30	87.4	3.19	5.95	14
MONTEBELLO PKWY DRY WELLS, LINE A-2	0.25	8	0.23	0.77	1
STRUCTURAL CELL MODULES AND DRY WELLS, LINES A-3, A-4, A-5, AND A-6	0.57	17.3	0.29	0.57	4
SOUTHSIDE DR DRY WELLS, LINE B-1	0.66	18.3	2.1	2.1	6
NORTHSIDE DR DRY WELLS, LINE C-1	8.46	2900	8.09	288	37
SOUTHSIDE DR DRY WELLS, LINE D-1	8.36	2900	7.73	288	38
NORTHSIDE DR AT SERVER AVE, LINE E-1	0.15	17.3	0.18	1.65	1
SOUTHSIDE DR AT SERVER AVE, LINE F-1	0.38	32.5	0.61	3.38	2
TOTAL	22.13	-	-	-	103

VOLUME OF STRUCTURAL CELL MODULES [CY]
108

CADD PROJECT FILE NAME
EAST LA MEDIANS.DGN

CHECKER
D. RADLE

DESIGNER
C. RAVE

DRAFTER
S. LU / L. CHAVEZ



KEY MAP
NOT TO SCALE

APPROVED BY MARK PESTRELLA DEPUTY DIRECTOR 7/10/2018	DATE	7/10/2018
RECOMMENDED BY Hector J. Bortas ASSISTANT DEPUTY DIRECTOR 7/10/2018	DATE	7/10/2018
SUBMITTED BY L. Chavez DESIGN TEAM 1 7/10/2018	DATE	7/10/2018
DATE	04/28/22	AS BUILT REVISIONS
DATE	08/27/19	ADDED SCE UTILITY RELOCATION PLAN TO PLAN SET AND INDEX
DATE	07/10/18	PROJECT ENGINEER



LOS ANGELES COUNTY PUBLIC WORKS
EAST LOS ANGELES SUSTAINABLE MEDIAN STORMWATER CAPTURE PROJECT
TITLE SHEET PROJECT ID NO. WMU0000010
LACFCD INDEX NO. 116-D27
PD053092
SHEET 1 OF 26-27

GENERAL NOTES

1.

PRIME CONTRACTOR LICENSE REQUIRED: CLASS A
2.

STANDARD PLANS REFERENCED ARE PER THE STANDARD PLANS FOR PUBLIC WORKS CONSTRUCTION (SPPWC) UNLESS OTHERWISE NOTED.
3.

ALL FIELD BOOK REFERENCES PERTAIN TO LOS ANGELES COUNTY PUBLIC WORKS FIELD BOOKS, UNLESS OTHERWISE NOTED.
4.

ELEVATIONS SHOWN ARE IN FEET BASED ON LOS ANGELES COUNTY RIVERA QUAD, 2005 ADJUSTMENT, NAVD 1988 DATUM. COORDINATES SHOWN ARE NAD 83, CA, ZONE 5, EPOCH 2007.
5.

ALL DISTURBED MONUMENTS AND BENCHMARK MARKERS WITHIN THE PROJECT LIMITS SHALL BE REPLACED AT THEIR PRE-CONSTRUCTION LOCATION AND ELEVATION UNLESS OTHERWISE DIRECTED BY THE AGENCY.
6.

STATIONS SHOWN ON THE PLANS ARE ALONG CENTERLINE OF CONDUIT OR ON A LINE NORMAL TO CENTERLINE OF CONDUIT.
7.

STATIONS AND INVERT ELEVATIONS OF PIPE INLETS SHOWN ON THE PROFILES ARE AT THE INSIDE FACE OF THE CONDUIT, UNLESS OTHERWISE SHOWN.
8.

REFER TO THIS SHEET FOR TYPICAL CATCH BASIN CONNECTOR PIPE PROFILE.
9.

PIPE CONNECTIONS TO STORM DRAIN SHALL CONFORM TO SPPWC STANDARD PLAN NO. 335, UNLESS OTHERWISE NOTED.
10.

ALL PIPE IN OPEN TRENCH SHALL BE BEDDED ACCORDING TO LACPW STANDARD PLAN 3080, CASE 3, UNLESS OTHERWISE NOTED. "W" VALUES SHALL BE AS SPECIFIED ON STANDARD PLAN 3080 FOR CASE 3 BEDDING, NOTES (a) AND (b). IF THE "W" VALUE AT THE TOP OF THE PIPE IS EXCEEDED, THE BEDDING SHALL BE MODIFIED AND/OR PIPE OF ADDITIONAL STRENGTH SHALL BE PROVIDED. THE PROPOSED MODIFICATION SHALL BE APPROVED BY THE AGENCY.
11.

CONCRETE BACKFILL SHALL BE PROVIDED AROUND PIPE 21 INCHES IN DIAMETER OR LESS WHERE THE COVER IS EQUAL TO OR LESS THAN 2'-0", AROUND PIPE GREATER THAN 21 INCHES IN DIAMETER BUT LESS THAN 39 INCHES WHERE THE COVER IS LESS THAN 1'-3", AND FOR PIPE 39 INCHES OR GREATER WHERE THE COVER IS LESS THAN 1'-0". THE CONCRETE BACKFILL SHALL BE AS SPECIFIED ON LACPW STANDARD PLAN 3080, NOTE 4.
12.

ALL NEW AND EXISTING CATCH BASINS SHALL INCLUDE A CONNECTOR PIPE SCREEN (CPS) AT EACH OUTLET.
13.

CATCH BASIN MANHOLE SHALL BE LOCATED ON THE OPPOSITE SIDE OF THE CONNECTOR PIPE OUTLET.
14.

MANHOLES SHALL USE SPPWC STANDARD PLAN NO. 630 OR 633 FOR THE "FRAME AND COVER," WHICHEVER APPLIES, AND 635 FOR THE "STANDARD DROP STEP". STORM DRAIN MANHOLE COVERS SHALL BE CAST WITH THE LETTER "D" AT THE CENTER OF THE COVER AND THE LETTERS "L.A.C.F.C.D." SHALL BE CAST BELOW THE LETTER "D". IF OWNED BY LACFCD, CATCH BASIN MANHOLE COVERS SHALL BE CAST WITH THE LETTERS "L.A.C.F.C.D." AT THE CENTER OF THE COVER IF OWNED BY LACFCD. THE LETTER SIZE SHALL BE 1-INCH HIGH.
15.

ALL MANHOLE COVERS SHALL BE FURNISHED WITH PICK HOLE PLUGS. PICK HOLE PLUG SHALL BE MOLDED, CUT, OR EXTRUDED FROM A HIGH QUALITY RUBBER. IF THE PLUG IS CUT, IT SHALL HAVE A MINIMUM TENSILE STRENGTH OF 800 PSI. IF THE PLUG IS EXTRUDED, IT SHALL HAVE A MINIMUM TENSILE STRENGTH OF 1200 PSI AND SHALL HAVE A HARDNESS BETWEEN 55 AND 65. THE PICK HOLE PLUG SHALL BE APPROPRIATELY SIZED FOR THE SIZE OF THE PICK HOLE.
16.

LOCATIONS OF CATCH BASIN CONNECTOR PIPE JUNCTIONS WITH CATCH BASINS, AS SHOWN ON THE PLANS, ARE SCHEMATIC. IT IS INTENDED THAT SUCH JUNCTIONS BE LOCATED AT THE DOWNSTREAM ENDS OF THE CATCH BASINS, UNLESS INDICATED OTHERWISE.
17.

MONOLITHIC CATCH BASIN CONNECTIONS, IF APPLICABLE, SHALL BE CONSTRUCTED PER SPPWC STANDARD PLAN NO. 308.
18.

FOR LOCAL DEPRESSION, SPPWC STANDARD PLAN NO. 313 SHALL BE USED, UNLESS OTHERWISE NOTED, H SHALL EQUAL 4 INCHES FOR CASES A, B, C, AND D; AND 2 INCHES FOR CASES E, F, AND G.
19.

CURB FACE SHALL BE 8 INCHES AT THE ENDS OF LOCAL DEPRESSIONS WHERE THERE IS NO EXISTING CURB.
20.

THE EXISTING PAVEMENT ADJACENT TO LOCAL DEPRESSIONS OR OTHER IMPROVEMENTS SHALL BE REMOVED AND REPLACED TO A MINIMUM OF 2 FEET FROM THE STRUCTURE.
21.

ALL RESURFACING, CURBS, GUTTERS, SIDEWALKS, DRIVEWAYS AND OTHER EXISTING IMPROVEMENTS TO BE RECONSTRUCTED SHALL BE CONSTRUCTED AT THE SAME ELEVATION AND LOCATION AS THE EXISTING IMPROVEMENTS, UNLESS OTHERWISE NOTED.
22.

COMPACTION EQUIPMENT USED TO PLACE BACKFILL MUST NOT EXCEED 35,000 LBS.
23.

ALL GALVANIZED STEEL SHALL BE HOT DIPPED.
24.

ALL ANCHOR BOLTS SHALL BE GALVANIZED AND HOT DIPPED.
25.

ALL EXISTING UTILITIES SHOWN ON THE PLANS ARE THE PROPERTY OF THE OWNERS LISTED ON SHEET 1, UNLESS OTHERWISE NOTED.
26.

EXISTING UTILITIES SHALL BE MAINTAINED IN PLACE BY THE CONTRACTOR, UNLESS OTHERWISE NOTED, AND ALL UTILITIES CROSSING THE TRENCH SHALL BE TEMPORARILY SUPPORTED TO THE SATISFACTION OF THE OWNER.
27.

WHERE THE UTILITIES ARE INDICATED ON THE PLANS TO BE SUPPORTED, SAID SUPPORTS SHALL BE IN ACCORDANCE WITH SPPWC STANDARD PLAN NO. 224, UNLESS OTHERWISE INDICATED.
28.

OVERHEAD UTILITY LINES ARE NOT SHOWN ON THE PROJECT PLANS, WHICH MAY IMPACT THE CONTRACTOR'S OPERATIONS.
29.

WITHIN THE PROJECT LIMITS, THE CONTRACTOR SHALL INSTALL A BLUE RAISED RETROREFLECTIVE PAVEMENT MARKER (RPM) ON THE FINISHED SURFACE AT EACH FIRE HYDRANT LOCATION PER CALIFORNIA 2014 MUTCD PART 3, FIGURE 3B-102 (CA), AS DESCRIBED IN THE SPECIAL PROVISIONS.
30.

EXISTING TREES SHALL BE REMOVED ONLY IF DESIGNATED BY SYMBOL "R." THOSE TREES NOT INTERFERING WITH CONSTRUCTION SHALL BE PROTECTED IN PLACE.
31.

STEEL STEPS PLACED IN MANHOLES WITH 24" DIAMETER SHAFTS SHALL HAVE A WIDTH OF 16", DEPTH OF 5", AND VERTICAL SPACING OF 12". STEEL STEPS PLACED ELSEWHERE SHALL HAVE A WIDTH OF 16", DEPTH OF 7", AND VERTICAL SPACING OF 12".

NON-STANDARD ABBREVIATIONS

ABBREVIATION	WORD OR WORDS
ADJ	ADJUST, ADJUSTMENT
AP	ANGLE POINT
AVE	AVENUE
BLVD	BOULEVARD
BM	BENCH MARK
BW	BACK OF WALK
C&G	CURB AND GUTTER
CA	CALIFORNIA
CALTRANS	STATE OF CALIFORNIA
	DEPARTMENT OF TRANSPORTATION
CF	CUBIC FEET
CFS	CUBIC FEET PER SECOND
CLR	CLEARANCE
CMP	CORRUGATED METAL PIPE
CONN	CONNECTOR
CP	CONNECTOR PIPE
CPS	CONNECTOR PIPE SCREEN
CY	CUBIC YARD
D/S	DOWNSTREAM
DR	DRIVE
DWG	DRAWING
E/O	EAST OF
E	EAST, ELECTRIC
EFL	EFFLUENT
ELEC	ELECTRIC, ELECTRICAL
ELEV	ELEVATION
EX	EXISTING
FG	FINISHED GRADE
FH	FIRE HYDRANT
FS	FINISHED SURFACE
G	GAS
GC	GRADE CHANGE
GR	GRADE
GV	GAS VALVE
GW	GUY WIRE
H	HIGH
HORIZ	HORIZONTAL
HW	HOUSEWALK
INCL	INCLUDING
INF	INFLUENT
INT	INTERSECTION
INV	INVERT
JS	JUNCTION STRUCTURE
L	LENGTH
LACPW	LOS ANGELES COUNTY PUBLIC WORKS
LACFCD	LOS ANGELES COUNTY FLOOD CONTROL DISTRICT
	LOCAL DEPRESSION
LD	LINEAR FEET
LF	LONG
LG	MECHANICAL
MECH	MODIFIED
MOD	MONITORING
MON	MATERIAL
MTL	NORTH
N	NORTH OF
N/O	NORTH AMERICA DATUM
NAD	NORTH AMERICA VERTICAL DATUM
NAVD	NORTHEAST
NE	NORTHWEST
NW	PULL BOX
PB	PERFORATED
PERF	PAGE
PG	POINT OF INTERSECTION
PI	PARKWAY
PKWY	PLACE
PL	POWER POLE
PP	PROPOSED
PROP	PUBLIC WORKS FIELD BOOK
PWFB	ROAD DIVISION
RD	RECONSTRUCT
RECONST	RELOCATE
RELOC	RESURFACE, RESURFACING
RESURF	REVISED STANDARD PLAN
RSP	UTILITY TO BE RELOCATED BY OWNER
RU	SLOPE, SOUTH
S	SOUTH OF
S/O	SCHEDULE
SCH	STORM DRAIN
SD	SOUTHEAST
SE	SHEET
SH	SQUARE FEET
SF	STREET LIGHT
SL	SPECIFICATIONS
SPECS	STAINLESS STEEL
SS	STREET
ST	STATION
STA	SOUTHWEST
SW	SANITARY SEWER
SWR	SANITARY SEWER MANHOLE
TC	TOP OF CURB
TG	THOMAS GUIDE
TL	TRANSIT LINE
TOT	TOTAL

NON-STANDARD ABBREVIATIONS (CONTINUED)

ABBREVIATION	WORD OR WORDS
TS	TRAFFIC SIGNAL, TRANSITION STRUCTURE
U/S	UPSTREAM
V _i	INLET V-DEPTH
V _{od}	OUTLET V-DEPTH TO DRYWELL
V _{om}	OUTLET V-DEPTH TO MAINLINE
VAR	VARIABLE, VARIES
VERT	VERTICAL
W	WATER, WEST, WIDE
W/O	WEST OF
WM	WATER METER
WV	WATER VALVE
WY	WAY
Ø	DIAMETER

STANDARD PLANS

SPPWC, 2012 EDITION	
100-2	TOPOGRAPHY SYMBOLS AND STANDARD ABBREVIATIONS
101-2	ABOVEGROUND UTILITIES LOCATION IN PARKWAY
112-2	CURB AND SIDEWALK JOINTS
120-2	CURB AND GUTTER - BARRIER
121-2	CURB AND GUTTER - MOUNTABLE
122-2	CROSS AND LONGITUDINAL GUTTERS
132-3	CONCRETE PAVEMENT REPLACEMENT
133-3	ASPHALT CONCRETE PAVEMENT REPLACEMENT
134-2	CONCRETE PAVEMENT JOINT DETAILS
224-2	SUPPORTS FOR CONDUITS ACROSS TRENCHES
300-3	CURB OPENING CATCH BASIN
302-3	CURB OPENING CATCH BASIN WITH GRATING(S)
308-2	MONOLITHIC CATCH BASIN CONNECTION
309-2	CATCH BASIN REINFORCEMENT
310-3	CATCH BASIN FACE PLATE ASSEMBLY AND PROTECTION BAR
312-4	CATCH BASIN MANHOLE FRAME AND COVER
313-3	LOCAL DEPRESSIONS AT CATCH BASINS
320-2	MANHOLE PIPE-TO-PIPE [MAIN LINE ID = 36" OR LARGER]
321-2	MANHOLE PIPE-TO-PIPE [ONE OR BOTH MAIN LINE IDS = 33" OR SMALLER]
326-2	MANHOLE SHAFT - 36" WITHOUT REDUCER
327-2	MANHOLE FOR EXISTING RCB
331-3	JUNCTION STRUCTURE - PIPE TO PIPE INLET ID > 24" OR OD >1/2" MAIN LINE ID
332-2	JUNCTION STRUCTURE - PIPE TO PIPE ID < 24"
333-2	JUNCTION STRUCTURE - PIPE TO RCB
335-2	PIPE CONNECTIONS TO EXISTING STORM DRAINS
342-2	TRANSITION STRUCTURE RCB TO PIPE
390-4	CONCRETE COLLAR FOR RCP 12" THROUGH 72"
523-2	ROOT PRUNING
630-4	24" MANHOLE FRAME AND COVER
633-4	36" MANHOLE FRAME AND COVER
635-3	STEEL STEP

LACDPW, 2000 EDITION	
3080-3	PIPE BEDDING IN TRENCHES
3090-1	CRITERIA FOR THE DESIGN OF SHORING FOR EXCAVATIONS
3091-1	SAMPLE SHEET FOR USE AS A GUIDE IN PREPARING CALCULATIONS FOR SHORING OF EXCAVATIONS
3093-1	UNIFIED SOIL CLASSIFICATION SYSTEM
6002-1	PORTABLE SECURITY FENCE FOR OPEN TRENCHES
6008-1	MINIMUM PUBLIC SAFETY REQUIREMENTS FOR OPEN EXCAVATIONS

CITY OF LOS ANGELES BUREAU OF ENGINEERING	
S-342-4	FRAME AND GRATING FOR CATCH BASINS (BICYCLE SAFE)
CALTRANS, 2015 EDITION	
RSP A88A	CURB RAMP DETAILS (DATED 7/21/2017)
RSP A88B	CURB RAMP AND ISLAND PASSAGEWAY DETAILS (DATED 7/21/2017)

14.

MANHOLES SHALL USE SPPWC STANDARD PLAN NO. 630 OR 633 FOR THE "FRAME AND COVER," WHICHEVER APPLIES. STORM DRAIN MANHOLE COVERS SHALL BE CAST WITH THE LETTER "D" AT THE CENTER OF THE COVER WITH A 2.5-INCH LETTER HEIGHT. AGENCY NAME SHALL BE CAST ABOVE THE LETTER "D" FOR STORM DRAIN MANHOLE COVERS AND CAST AT THE CENTER OF THE COVER FOR CATCH BASIN MANHOLE COVERS. AGENCY NAME SHALL INCLUDE THE LETTERS "LACFCD" IF OWNED BY LACFCD, AND SHALL INCLUDE "LACPW" IF NOT OWNED BY LACFCD. THE LETTER SIZE FOR THE AGENCY NAME SHALL BE 1-INCH HIGH.

CONSTRUCTION SYMBOLS

	ABOVE LINE: NAME OF SECTION OR DETAIL BELOW LINE: SHEET NUMBER OF THE REFERENCED SECTION OR DETAIL IF THE SECTION OR DETAIL IS NOT ON THE SAME SHEET
--	--

CONSTRUCTION NOTES

1.

THICKNESS OF PAVEMENTS ARE INDICATED ON PLAN IN THE RESURFACING SCHEDULE TABLE AND APPLY ONLY WITHIN THE LIMITS OF EXCAVATION.
2.

ALL PAVEMENT REMOVALS SHALL USE STRAIGHT LINE SAW CUTS A MINIMUM OF 1.5" DEEP.
3.

AC PAVEMENT CONSTRUCTION FOR ANY TRENCH RESURFACING SHALL EXTEND A MINIMUM OF 12" BEYOND ANY TRENCH WALL (SEE TYPICAL PIPE TRENCH DETAIL FOR AC PAVEMENT ON SHEET 8). IF REMAINING AC PAVEMENT BETWEEN EDGE OF TRENCH RESURFACING AND EXISTING GUTTER, CURB, CROSS GUTTER, OR CUT LINE IS LESS THAN 12 INCHES IN WIDTH, THE REMAINING AC PAVEMENT SHALL BE COLD MILLED 2" AND REPLACED.
4.

PCC PAVEMENT AND BASE CONSTRUCTION FOR ANY TRENCH RESURFACING SHALL EXTEND A MINIMUM OF 12" BEYOND ANY TRENCH WALL (SEE TYPICAL PIPE TRENCH DETAIL FOR PCC PAVEMENT ON SHEET 8). IF REMAINING CONCRETE PAVEMENT BETWEEN EDGE OF TRENCH RESURFACING AND EXISTING CONCRETE JOINT IS LESS THAN 3 FEET IN WIDTH, THE REMAINING CONCRETE PAVEMENT SHALL BE REPLACED WITH PCC ON BASE PER RESURFACING SCHEDULE.
5.

PCC PAVEMENT SHALL JOIN EDGE OF ALL EXISTING VAULTS.
6.

ALL AFFECTED TRAFFIC STRIPING, CURB MARKINGS, PAVEMENT MARKERS, AND LOOP DETECTORS SHALL BE REPLACED TO MATCH EXISTING UNLESS OTHERWISE NOTED.
7.

ANY MAIN LINE SEWERS, MANHOLES, OR HOUSE CONNECTIONS DAMAGED DURING CONSTRUCTION SHALL BE REPAIRED OR REPLACED BY THE CONTRACTOR AT THEIR EXPENSE TO THE SATISFACTION OF THE COUNTY ENGINEER.
8.

THE PCC THICKNESS "T" FOR ALL CURB RAMPS SHALL BE 4" UNLESS OTHERWISE NOTED.

NOTES

1.


THE CHANGE IN GRADE OF THE CONNECTOR PIPE SHALL OCCUR EITHER OVER OR UNDER EXISTING UTILITY. THE PARTICULAR UTILITY, AT WHICH THE CHANGE IN GRADE OCCURS, IS NOTED ON THE PROJECT PLANS. AT LOCATIONS WHERE UTILITY CROSSINGS ARE MARKED , THE CONNECTOR PIPE GRADE SHALL BREAK OVER THE UTILITY. AT LOCATIONS WHERE UTILITY CROSSINGS ARE MARKED , THE CONNECTOR PIPE GRADE SHALL BREAK UNDER THE UTILITY.
2.

ON THOSE CONNECTOR PIPES WHERE CHANGE IN GRADE IS NOT INDICATED, IT IS ASSUMED THAT THE CONNECTOR PIPE SHALL BE LAID ON A STRAIGHT GRADE FROM THE CATCH BASIN TO THE STORM DRAIN WITHOUT INTERFERENCE WITH UTILITIES.
3.

THE CONTRACTOR SHALL MAKE EXPLORATORY EXCAVATIONS TO DETERMINE THE EXACT LOCATION AND DEPTH OF UTILITIES THAT ARE MARKED OR , EXCEPT SANITARY SEWER UTILITIES. AFTER THE EXACT LOCATION A UTILITY HAS BEEN DETERMINED, THE GRADE AND ALIGNMENT OF THE CONNECTOR PIPE SHALL BE STAKED SO AS TO CLEAR THE UTILITY.
4.


WHERE CONNECTOR PIPE HAS A GRADE CHANGE EXCEEDING 0.10 FEET PER FEET, OR DIFFERS IN DIAMETER FROM THAT OF EXISTING PIPE, USE CONCRETE COLLAR PER STANDARD PLAN 380.
5.

LOCATIONS OF TEST WELLS FOR THE BORING LOGS ARE SHOWN AND MARKED ON PLANS WITH THE SYMBOL .

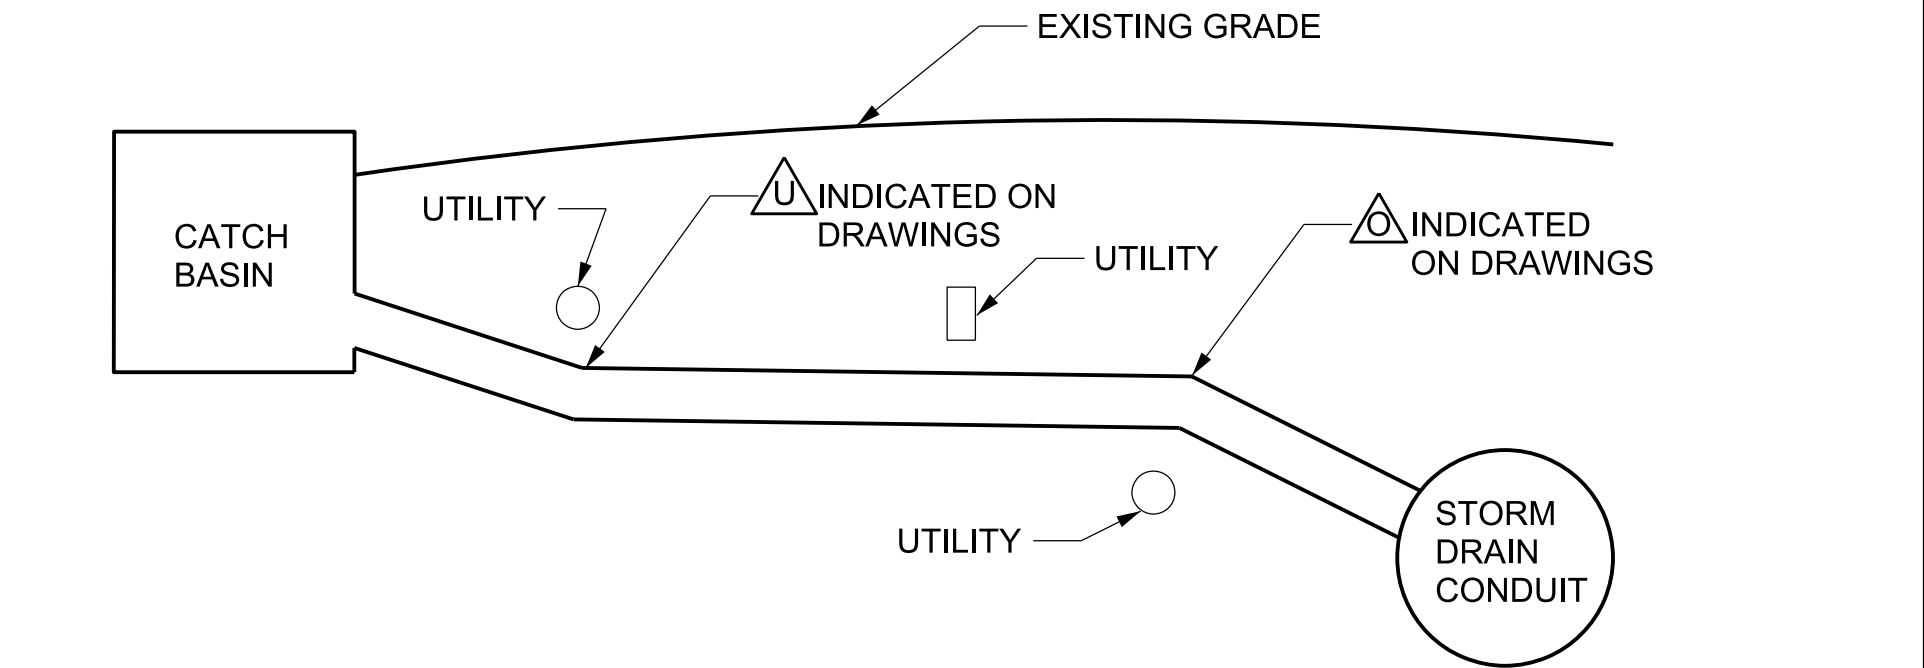



TYPICAL CONNECTOR PIPE PROFILE
NOT TO SCALE

						LOS ANGELES COUNTY PUBLIC WORKS						
						EAST LOS ANGELES SUSTAINABLE MEDIAN STORMWATER CAPTURE PROJECT CONSTRUCTION NOTES AND LEGENDS						
						PROJECT ID NO. WMU0000010						
						LACFCD INDEX NO. 116-D27		PD053092	SHEET	2	OF	26-27
04/28/22					AS BUILT REVISIONS							

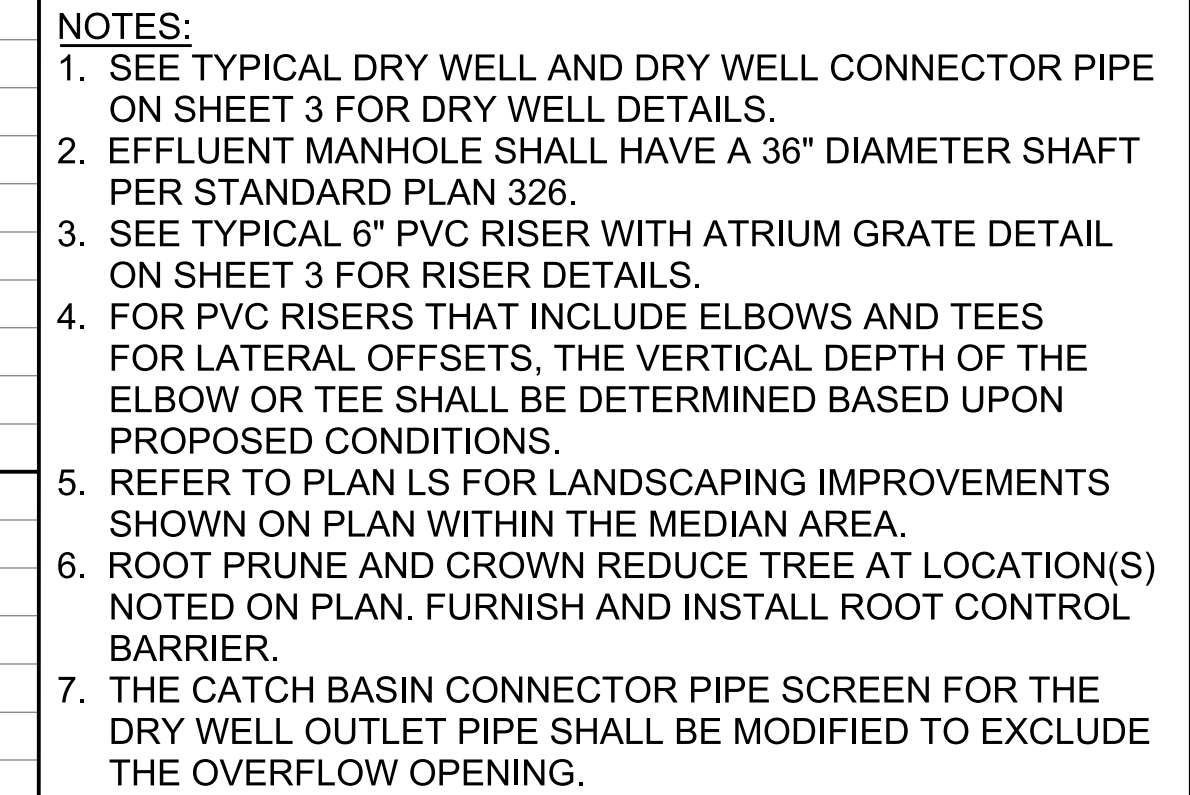

							CONNECTOR PIPE		
DRY WELL	NORTHING	EASTING	CASE	H	D	ELEV T	ELEV A	S	L
A1	1,828,236.30	6,517,670.92	1	30'	70'	176.7	-	-	-
A2	1,828,313.80	6,517,669.57	2	30'	70'	177.3	-	-	-
A3-A	1,828,370.01	6,517,668.43	3	30'	70'	178.2	170.10	0.01	40'
A3-B	1,828,336.14	6,517,696.52	2	30'	70'	178.0	-	-	-
A3-C	1,828,284.95	6,517,738.96	2	30'	70'	177.3	169.87	0.01	63'
A4-A	1,828,401.47	6,517,681.31	3	30'	70'	178.4	170.20	0.01	56'
A4-B	1,828,355.29	6,517,719.61	2	30'	70'	178.6	-	-	-
A4-C	1,828,329.88	6,517,740.66	3	30'	70'	177.8	170.47	0.01	29'
A4-D	1,828,306.33	6,517,760.20	2	30'	70'	178.2	170.20	0.01	27'
A5-A	1,828,423.01	6,517,710.71	2	30'	70'	180.2	170.53	0.01	26'
A5-B	1,828,395.06	6,517,720.58	2	30'	70'	179.5	170.79	0.01	28'
A5-C	1,828,377.63	6,517,746.55	1	30'	70'	179.5	-	-	-
A5-D	1,828,348.24	6,517,758.11	2	30'	70'	178.6	170.79	0.01	28'
A5-E	1,828,325.14	6,517,777.26	1	30'	70'	179.2	170.53	0.01	26'
A6	1,828,494.65	6,517,927.45	2	30'	70'	178.0	-	-	-

PLAN DR

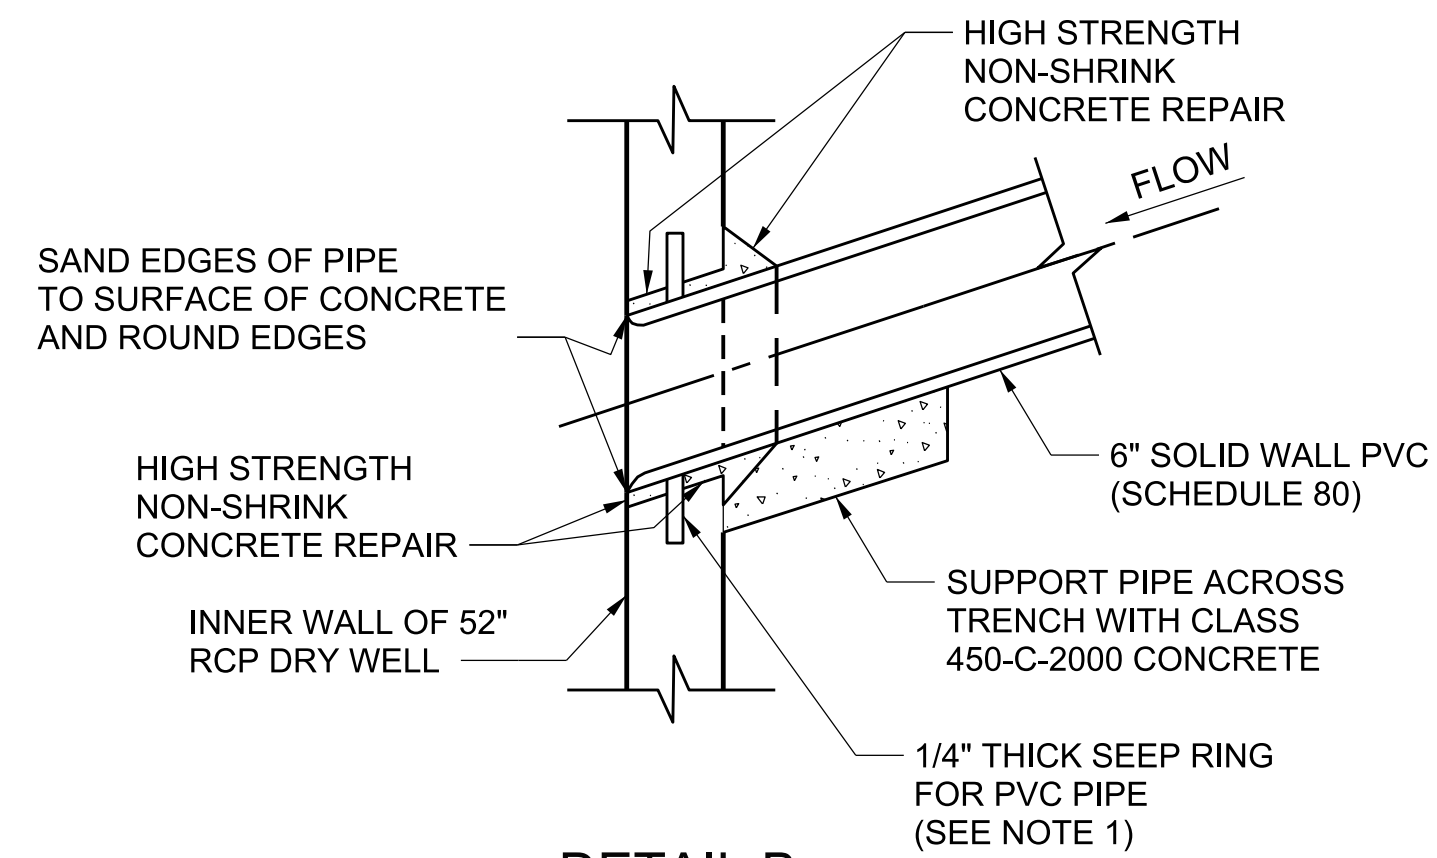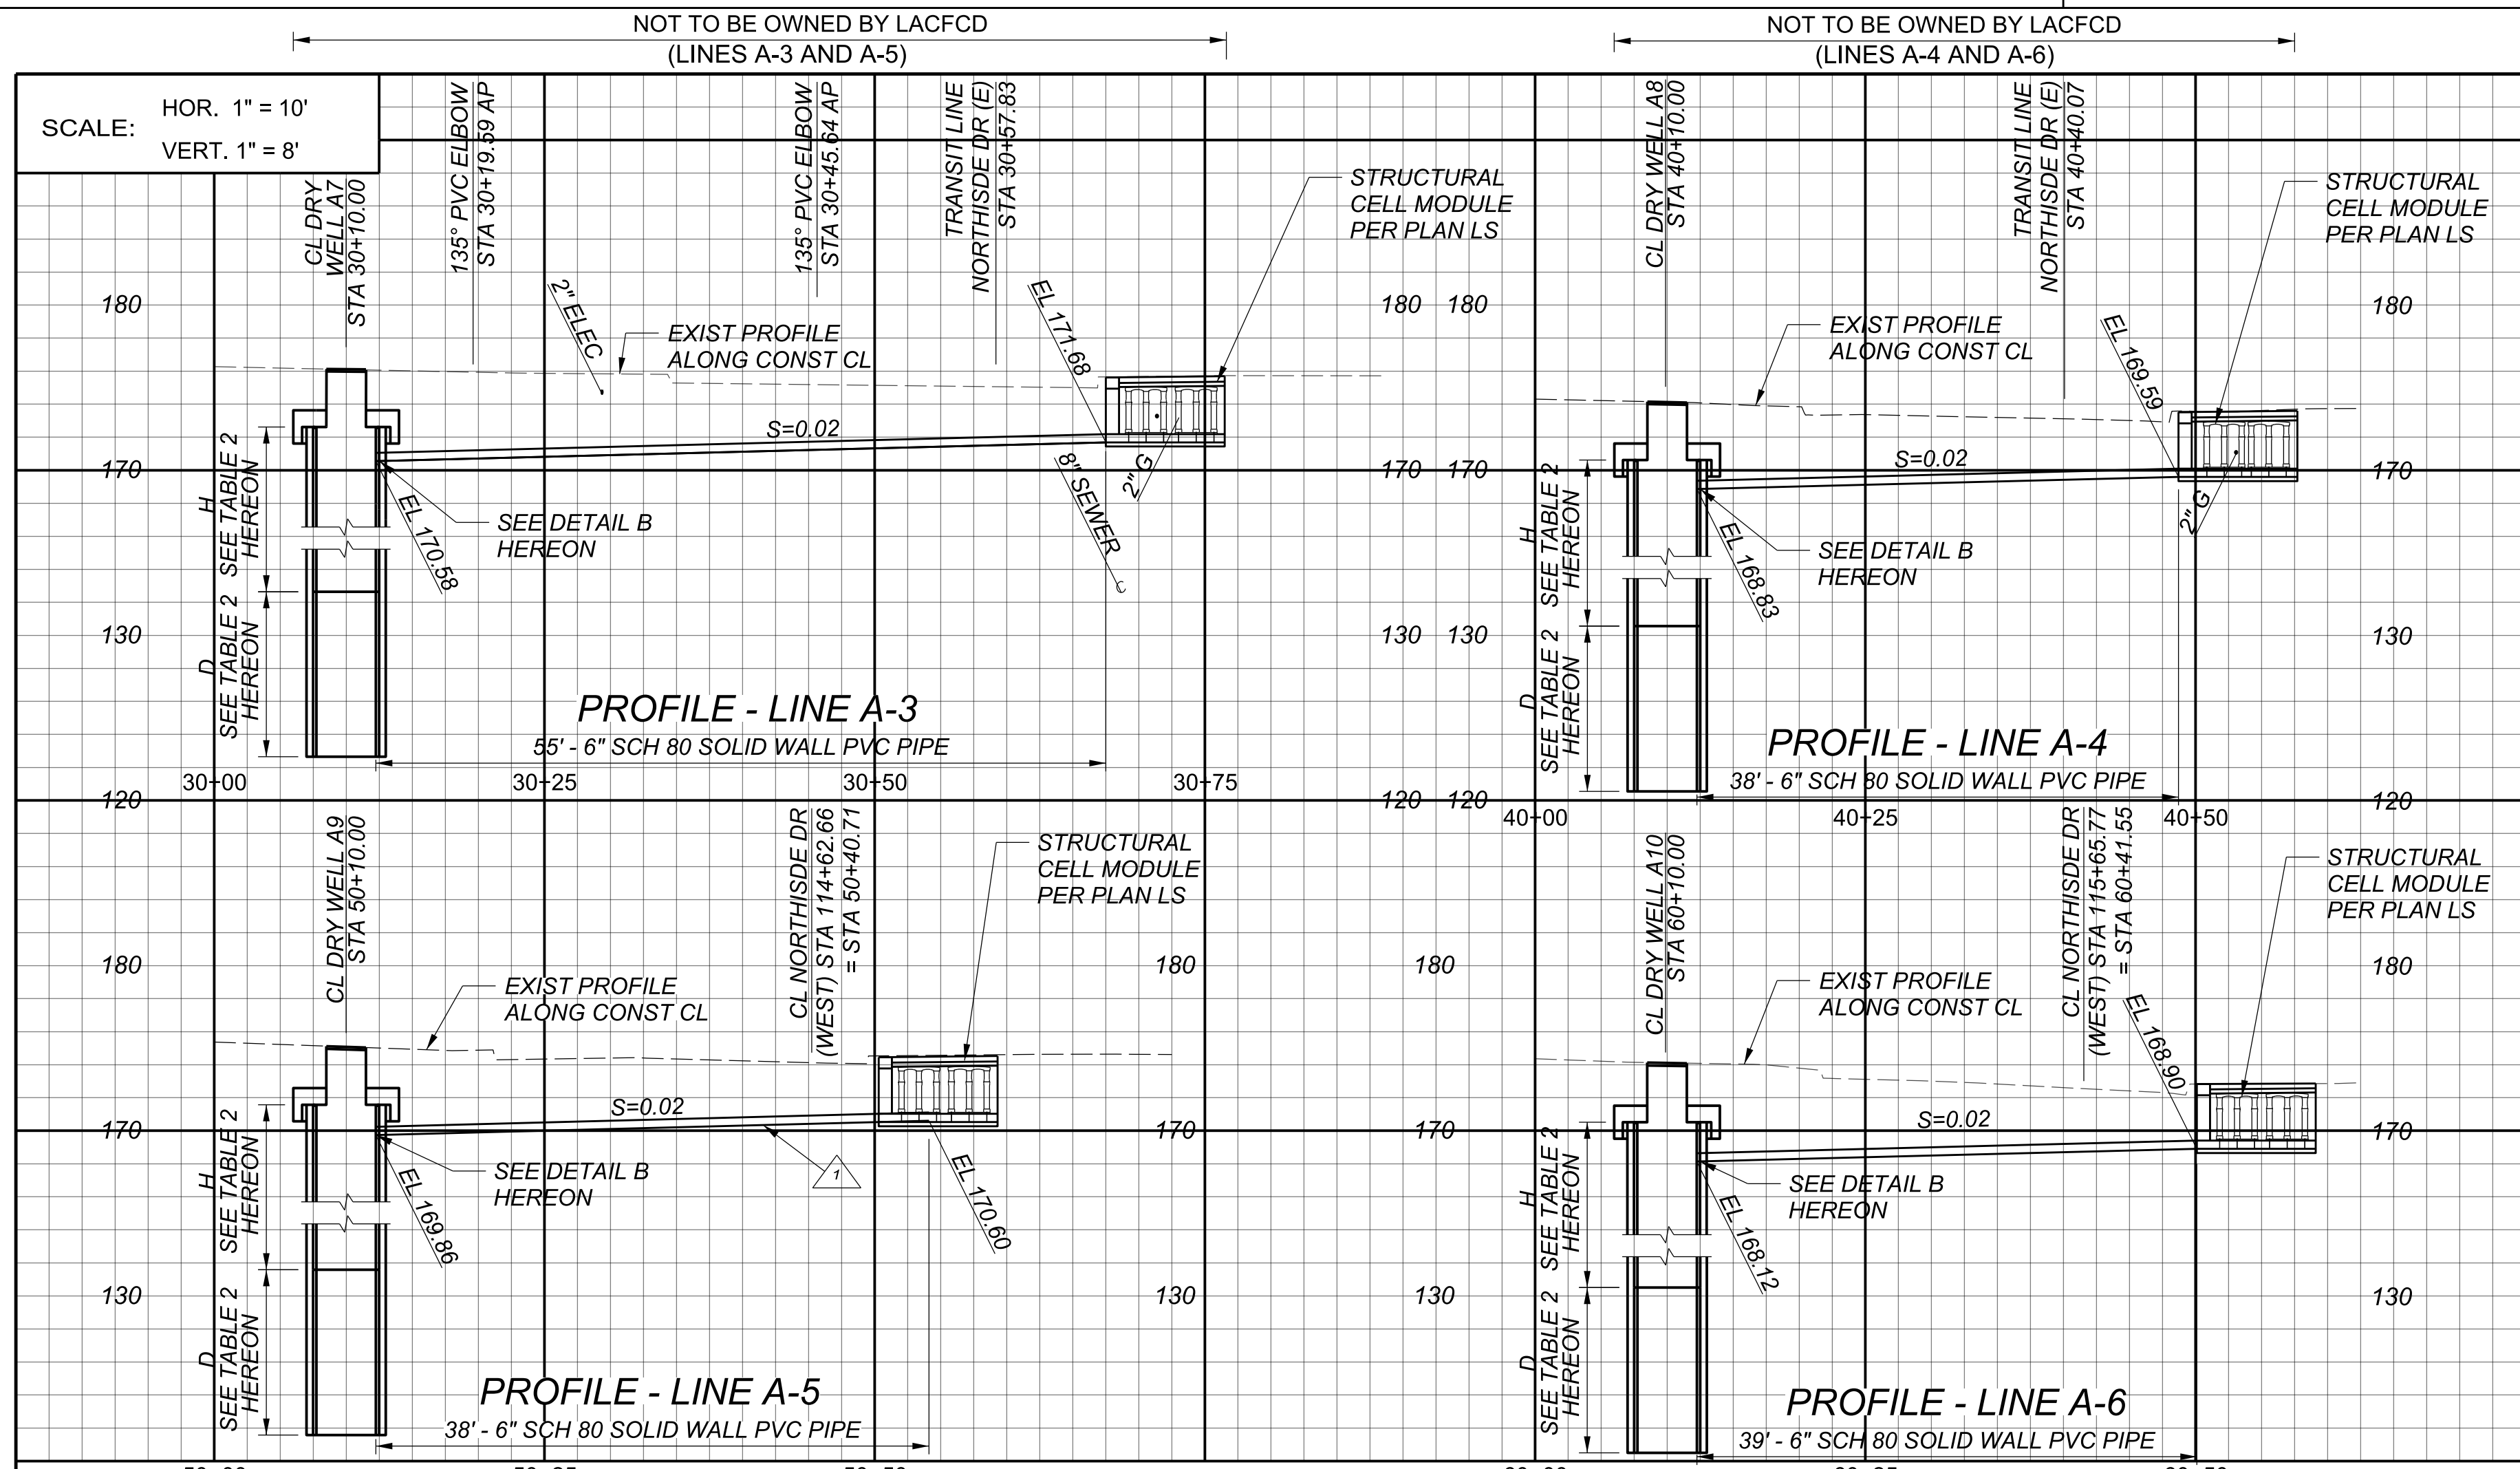

DETAIL B
PVC PIPE CONNECTION
NO SCALE


DRY WELL	NORTHING	EASTING	CASE	H	D	ELEV T
A7	1,827,560.61	6,518,040.65	1	40'	10'	173.6
A8	1,827,397.93	6,518,011.75	1	40'	10'	171.6
A9	1,827,503.67	6,518,011.42	1	40'	10'	172.6
A10	1,827,403.78	6,517,984.35	1	40'	10'	171.5

TABLE 2
DRY WELLS LINES A-3, A-4, A-5, AND A-6
ELEV "T" = FS FOR THE TOP OF THE DRY WELL COVER


RESURFACING SCHEDULE		
LOCATION	EXIST PVMT	RESURF PVMT
STA 30+36 TO STA 30+62	4" AC ON 10" CMB	5" AC ON 10" CMB
STA 40+21 TO STA 40+44	4" AC ON 10" CMB	5" AC ON 10" CMB
STA 50+23 TO STA 50+49	4" AC ON 10" CMB	5" AC ON 10" CMB
STA 60+23 TO STA 60+46	4" AC ON 10" CMB	5" AC ON 10" CMB

AC SHALL BE 2" OF C2-PG 64-10 ON 3" OF B-PG 64-10.

- NOTES:
- FOR PVC PIPE CONNECTIONS SHOWN ON DETAIL B, HOT AIR WELD THE SEEP RING TO THE PVC PIPE ALL AROUND THE PIPE.
 - SEE TYPICAL DRY WELL AND DRY WELL CONNECTOR PIPE ON SHEET 3 FOR DRY WELL DETAILS.
 - REFER TO PLAN LS FOR LANDSCAPING IMPROVEMENTS SHOWN ON PLAN WITHIN THE PARKWAY AREA.

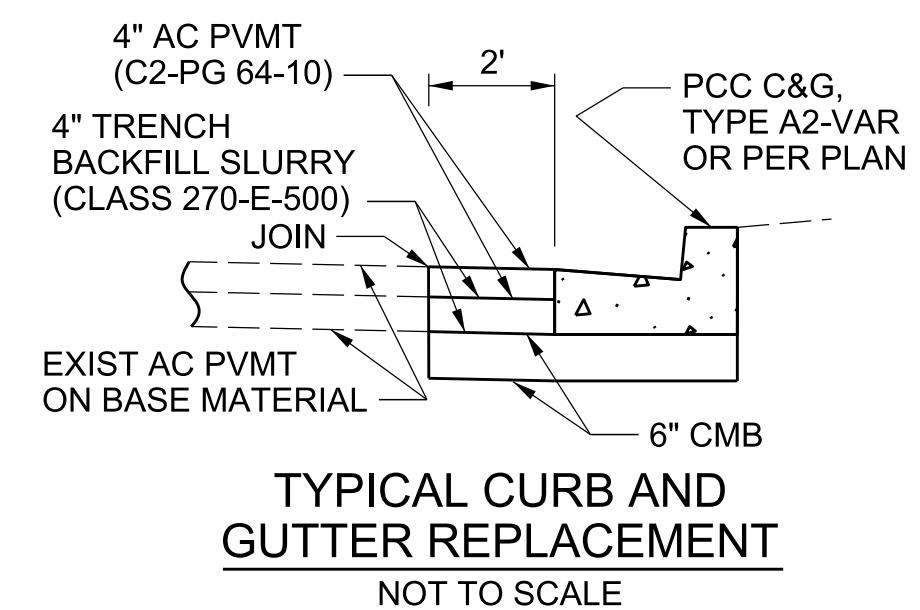

PT #107 STA 116+51.15

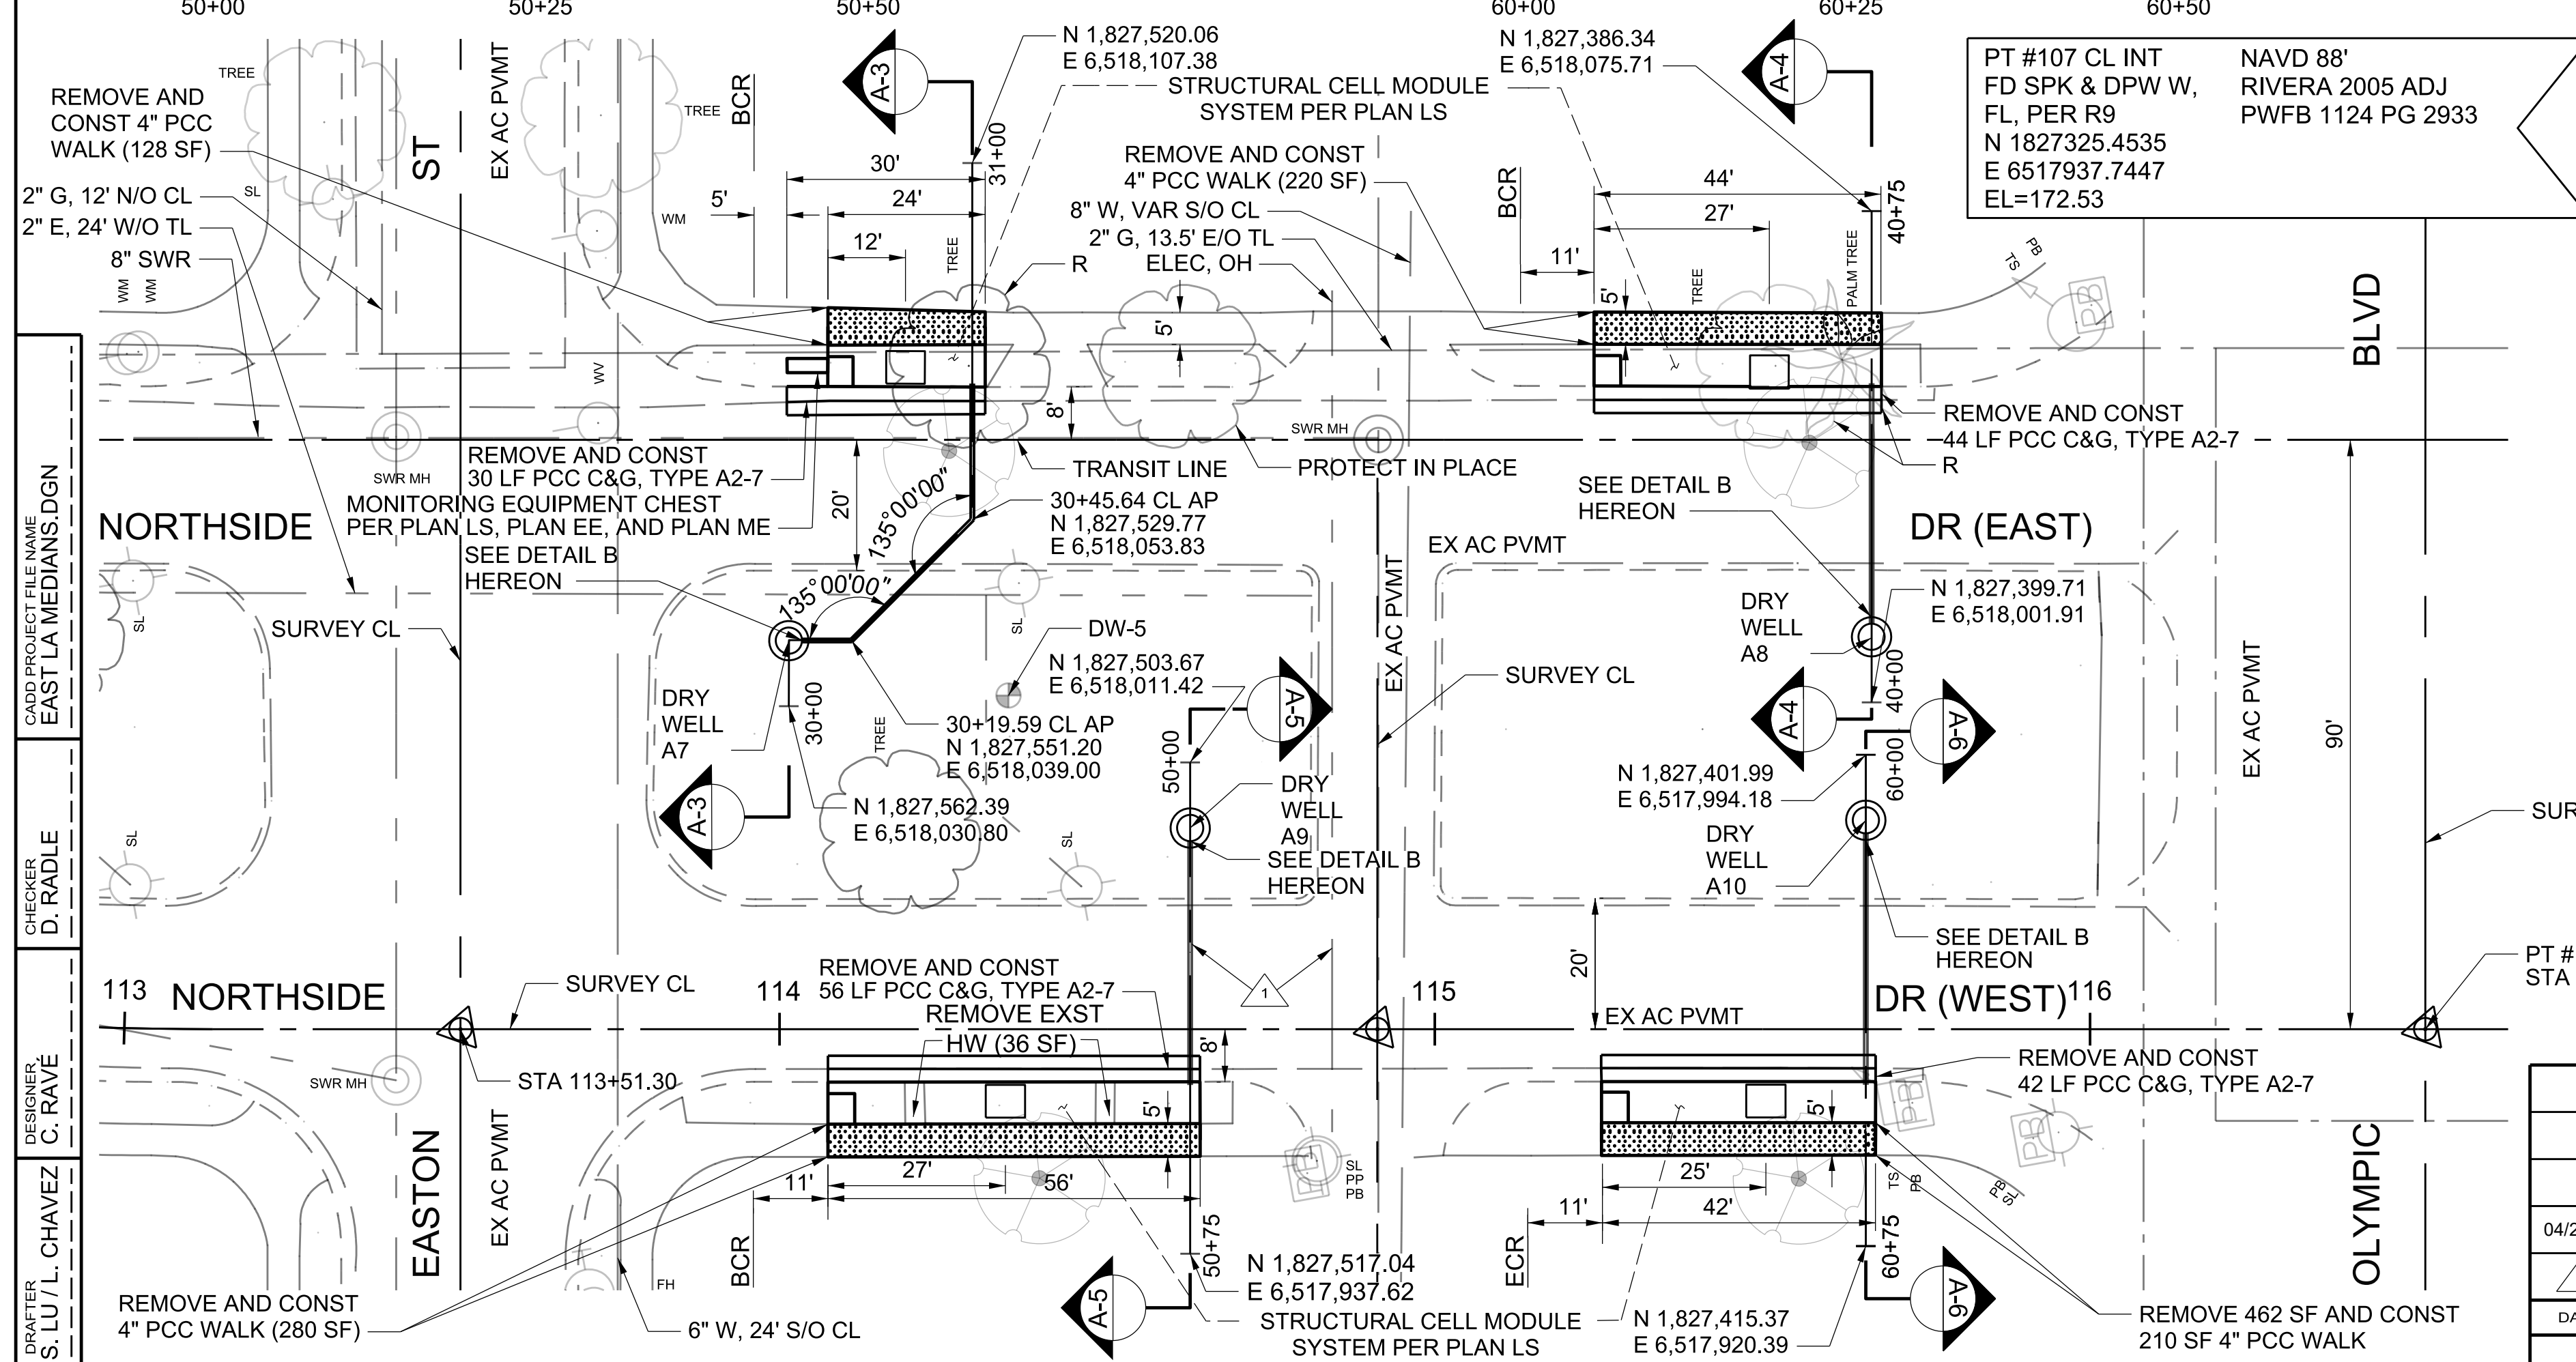

AS BUILT DRAWINGS

PLAN DR

[illegible]

The main plan view shows the alignment of Southside Drive from station 70+00 to 73+00. It includes several dry wells labeled B1 through B6, connected by pipes. Key features include:

- Dry Well Details:** DRY WELL B1 has a 6" PVC RISER WITH ATRIUM GRATE. Other wells have various pipe sizes like 8" SWR VAR or 6" W, 5' W/O CL.
- Pipes and Connections:** Includes notes about removing existing concrete boxes (CB) and laying new 12-inch RCP bypasses.
- Structural Notes:** References to structural drawings SH 13, SH 14, and SH 18 are included.
- Elevations:** Specific elevations are provided for manhole tops and invert levels at various stations.

NORTH
PLAN

SCALE: 1" = 20'

NOTES:

- SEE TYPICAL DRY WELL AND DRY WELL CONNECTOR PIPE ON SHEET 3 FOR DRY WELL DETAILS.
- SEE TYPICAL 6" PVC RISER WITH ATRIUM GRATE DETAIL ON SHEET 3 FOR RISER DETAILS.
- THE CAPS FOR 6" PVC RISERS AND THE CASE 2 DRY WELL MH COVER SHALL BE 2' BELOW SURFACE TO ACCOMMODATE FUTURE LANDSCAPING IMPROVEMENTS.
- EFFLUENT MONITORING MANHOLE SHALL HAVE A 36" DIAMETER SHAFT PER STANDARD PLAN 326.

* 4" AC PVMT (C2-PG 64-10, B-PG 64-10) ON 10" CMB

** MONITORING WELL AFFECTED BY TRENCH WORK WILL BE REMOVED, INCLUDING THE PVC PIPE AND CONCRETE CAP.

REMOVE EXIST CB AND 2 LF OF EX 12" CP

CONSTRUCT CB 300, W=3.5', V=3'-5", V_m=3'-3", 64" - 18" RCP, 2000 D, LD 313, CASE E, 170.29 TC, MONOLITHIC CB CONNECTION LACFCD

PT #121 P.O.L.
FD RR SPK & DPW FL., PER R3
N 1826576.0762c
E 6517958.6144c
EL=170.5050 (R2 PG.2)

NAVD '88
RIVERA 2005 ADJ
PWFB 1124 PG 2934

RESURFACING SCHEDULE		
LOCATION	EXIST PVMT	RESURF PVMT
STA 72+44 TO STA 72+76	4" AC ON 10" CMB	5" AC ON 10" CMB
NW CB CP AT STA 123+64	4" AC ON 10" CMB	5" AC ON 10" CMB
SW CB CP AT STA 124+96	4" AC ON 10" CMB	5" AC ON 10" CMB

AC SHALL BE 2" OF C2-PG 64-10 ON 3" OF B-PG 64-10.

JS 333				
LOCATION	STATION	A	B	C
18" RCP INLET (WEST)	72+69.43	56° 31' 41"	18"	3'
15" RCP INLET (EAST)	72+71.07	64° 50' 33"	15"	3'
24" RCP OUTLET (WEST)	72+72.10	83° 14' 11"	24"	2'

SEE UPDATED ELEV T VALUES ON TABLE 3.1 (SH 26)

DRY WELL	NORTHING	EASTING	CASE	H	D	ELEV T
B1	1,826,848.79	6,517,910.51	2	40"	20"	165.9'
B2	1,826,829.17	6,517,933.21	3	40"	20"	167.8'
B3	1,826,799.47	6,517,937.42	3	40"	20"	167.6'
B4	1,826,761.90	6,517,931.69	1	40"	20"	168.7'
B5	1,826,732.24	6,517,927.17	3	40"	20"	166.9'
B6	1,826,702.28	6,517,938.40	1	40"	20"	168.3'

TABLE 3
DRY WELLS LINE B-1
ELEV "T" = FS FOR THE TOP OF THE DRY WELL COVER

DATE	MK	DESCRIPTION
REVISIONS		
AS BUILT REVISIONS		

Chris Rate 07/10/18
PROJECT ENGINEER DATE

LOS ANGELES COUNTY PUBLIC WORKS	
EAST LOS ANGELES SUSTAINABLE MEDIAN STORMWATER CAPTURE PROJECT PLAN AND PROFILE SOUTHSIDE DR DRY WELLS AND DIVERSION LINE LINE B-1 PROJECT ID NO. WMU000010	
LACFCD INDEX NO. 116-D27	PD053092
SHEET	6 OF 26

JS 333				
LOCATION	STATION	A	B	C
18" RCP INLET (WEST)	72+69.43	56° 31' 41"	18"	3'
15" RCP INLET (EAST)	72+71.07	64° 50' 33"	15"	3'
24" RCP OUTLET (WEST)	72+72.10	83° 14' 11"	24"	2'

SEE UPDATED ELEV T VALUES ON TABLE 3.1 (SH 26)						
DRY WELL	NORTHING	EASTING	CASE	H	D	ELEV T
B1	1,826,848.79	6,517,910.51	2	40'	20'	165.9
B2	1,826,829.17	6,517,933.21	3	40'	20'	167.8
B3	1,826,799.47	6,517,937.42	3	40'	20'	167.6
B4	1,826,761.90	6,517,931.69	1	40'	20'	168.7
B5	1,826,732.24	6,517,927.17	3	40'	20'	166.9
B6	1,826,702.28	6,517,938.40	1	40'	20'	168.3

TABLE 3
DRY WELLS LINE B-1
 ELEV "T" = FS FOR THE TOP OF THE DRY WELL COVER

LOS ANGELES COUNTY PUBLIC WORKS

EAST LOS ANGELES
SUSTAINABLE MEDIAN
STORMWATER CAPTURE PROJECT
PLAN AND PROFILE
SOUTHSIDE DR DRY WELLS AND DIVERSION LINE
LINE B-1
PROJECT ID NO. WMU0000010

PLAN DR

NOT TO BE OWNED BY LACFCD
Q_{85TH} = 8.09 CFS

DRY WELL	NORTHING	EASTING	CASE	H	D	ELEV T
C2-A	1,827,489.84	6,520,929.98	1	40'	60'	-191.4
C3-A	1,827,482.44	6,520,959.05	3	40'	60'	-190.0
C4-A	1,827,472.57	6,520,997.81	3	40'	60'	-190.2
C5-A	1,827,465.17	6,521,026.88	3	40'	60'	-190.3
C6-A	1,827,450.36	6,521,085.03	3	40'	60'	-190.6
C7-A	1,827,441.73	6,521,118.95	3	40'	60'	-190.7
C8-A	1,827,397.31	6,521,293.38	3	40'	60'	-191.3
C9-A	1,827,420.75	6,521,201.32	3	40'	60'	-190.7
C10-A	1,827,413.35	6,521,230.39	1	40'	60'	-193.0
C11-A	1,827,389.91	6,521,322.45	3	40'	60'	-191.4
C12-A	1,827,355.37	6,521,458.13	3	40'	60'	-192.3
C13-A	1,827,333.16	6,521,545.34	3	40'	60'	-191.3
C14-A	1,827,318.36	6,521,603.49	2	40'	60'	-192.6
C15-A	1,827,296.15	6,521,690.71	3	40'	60'	-193.3
C16-A	1,827,283.82	6,521,739.16	3	40'	60'	-193.5

TABLE 4
DRY WELLS LINE C-1

SEE UPDATED
ELEV T VALUES ON
TABLE 4.1 (SH 26)

ELEV "T" = FS FOR THE TOP OF THE DRY WELL COVER

NOTES:

- * CONTRACTOR SHALL REMOVE INTERFERING WALL FOOTING AND JOIN RAMP TO EXISTING BRICK WALL
- ** PROPOSED PEDESTRIAN SIGNAL PER PLAN SP
- *** FOR SCE ELECTRICAL CONDUIT RELOCATION, THE CONTRACTOR SHALL CONTACT THE SCE PLANNER (NOELLE PETERSON) AT (310) 608-5162 TO COORDINATE THE WORK THAT NEEDS TO BE PERFORMED.
- DRY WELL C2-A DRILLED TO GROUNDWATER AND BACKFILLED WITH SAND TO EL 103.10. DRY WELL C3-A DRILLED TO GROUNDWATER AND BACKFILLED WITH SAND TO EL 103.60.

SEE UPDATED DETAIL FOR
PEDESTRIAN RAMP
RELOCATION (SH 26)

SERVER
AVENUE

4" PCC CURB RAMP PER
CALTRANS STD PLAN RSP
A88A (CASE F MOD), 6" CMB *

RU, **

6" W, VAR
2" G, 8' S/O BW
8" SWR, VAR

EXIST BRICK WALL

6" W, VAR
2" G, 8' S/O BW
8" SWR, VAR

6" W, VAR
2" G, 8' S/O BW
8" SWR, VAR

SCALE: HOR. 1" = 40'
VERT. 1" = 8'

SCALE: HOR. 1" = 40'
VERT. 1" = 8'


SCALE: HOR. 1" = 40'
VERT. 1" = 8'

SCALE: HOR. 1" = 40'
VERT. 1" = 8'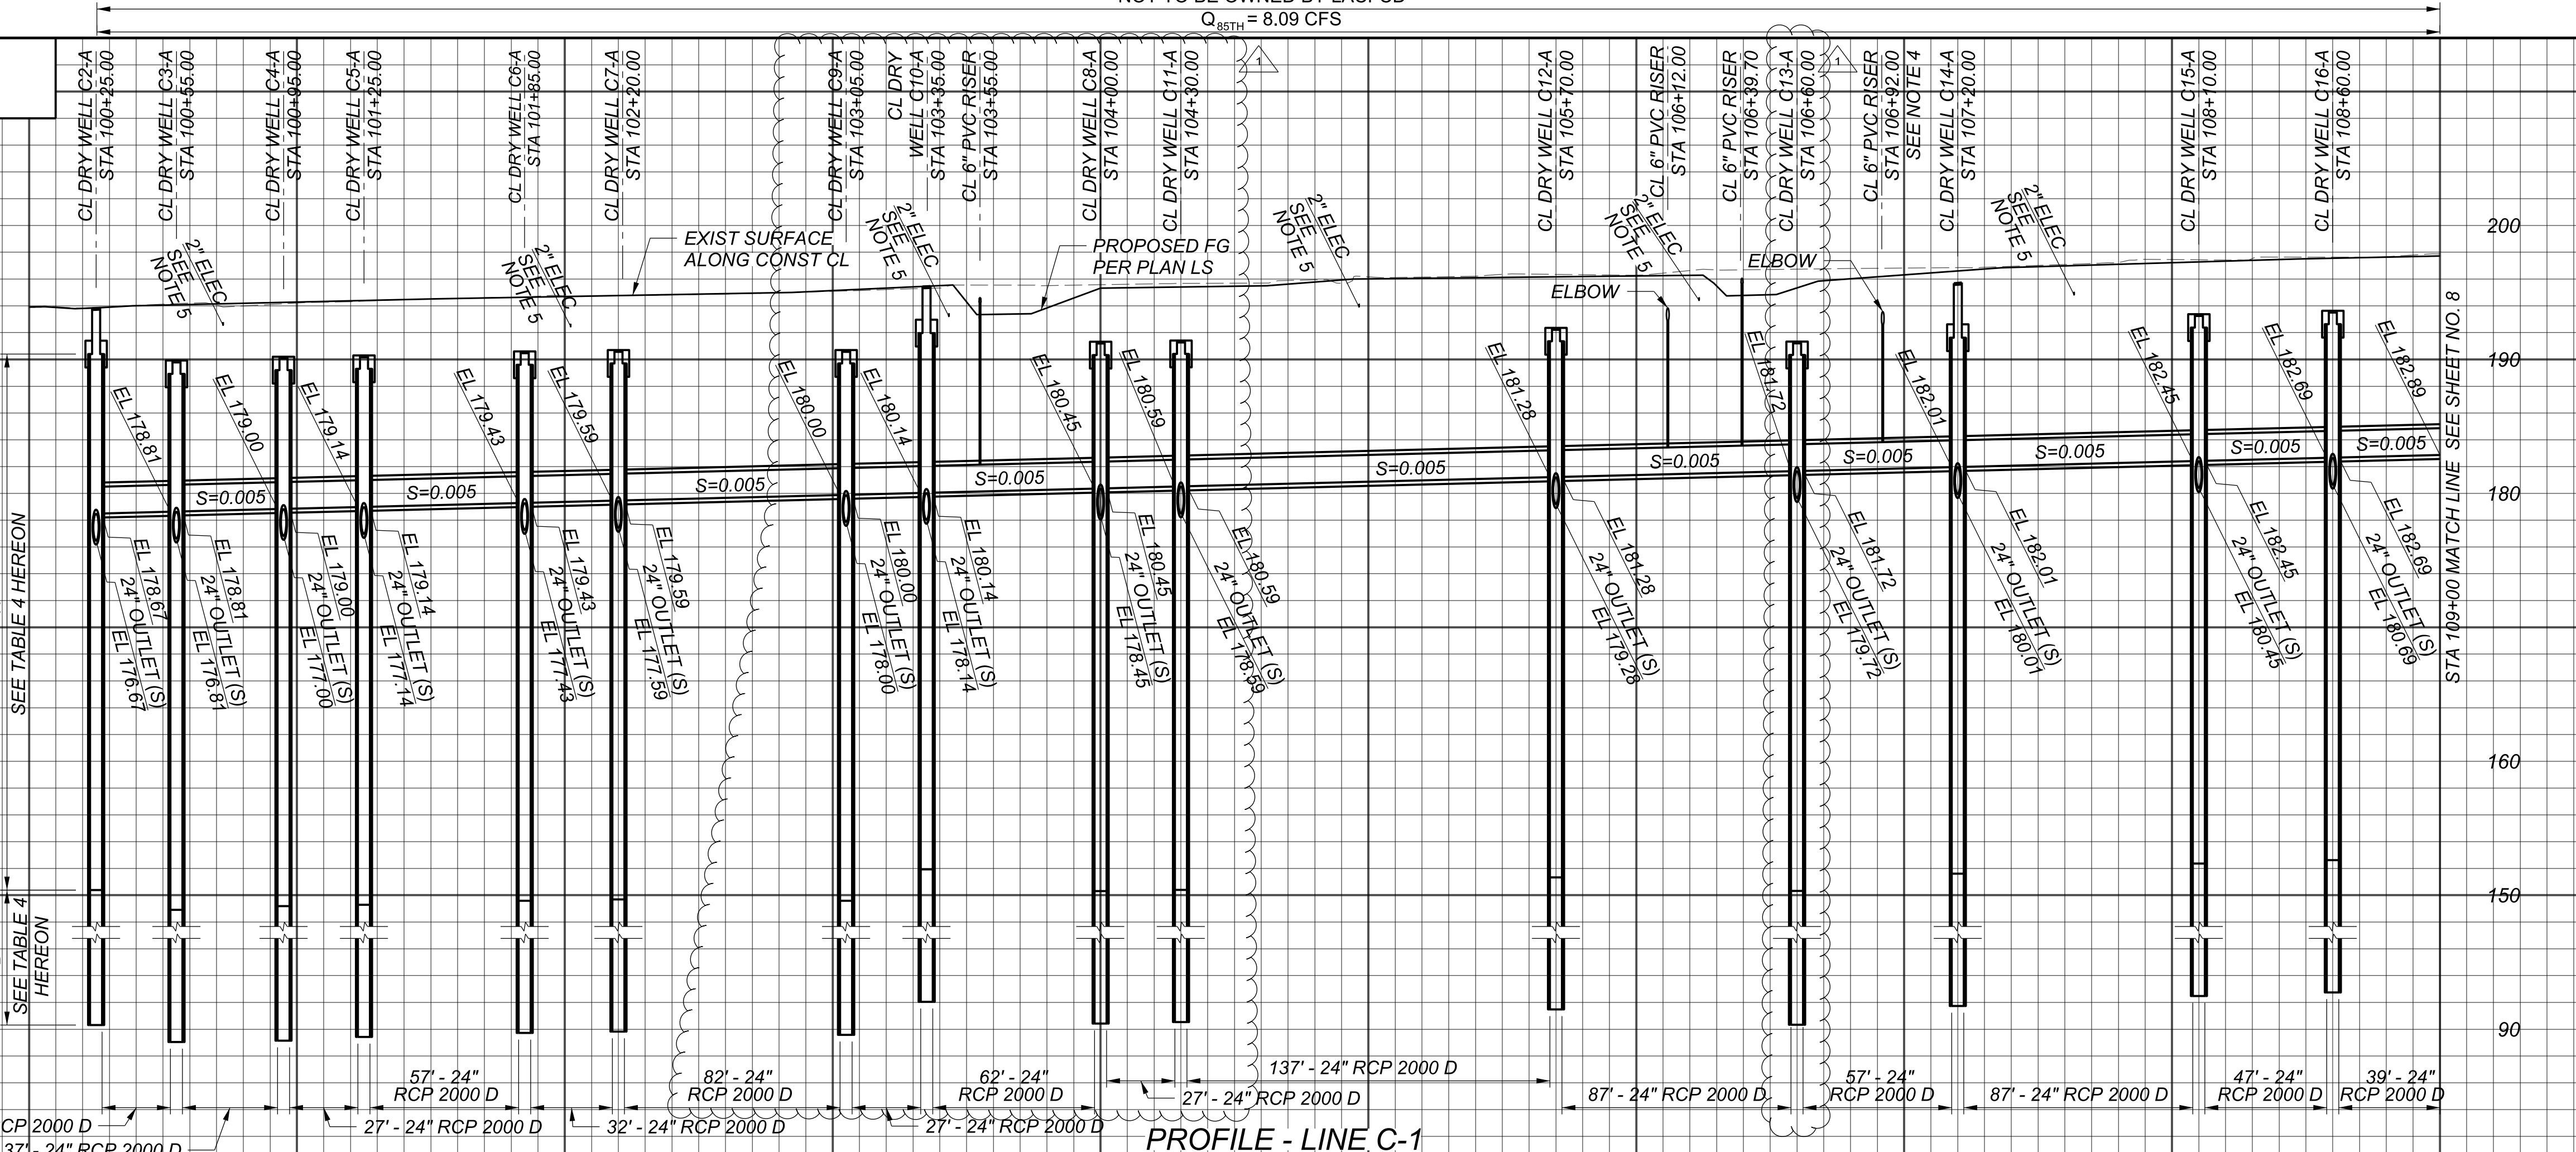


PROFILE - LINE C-1

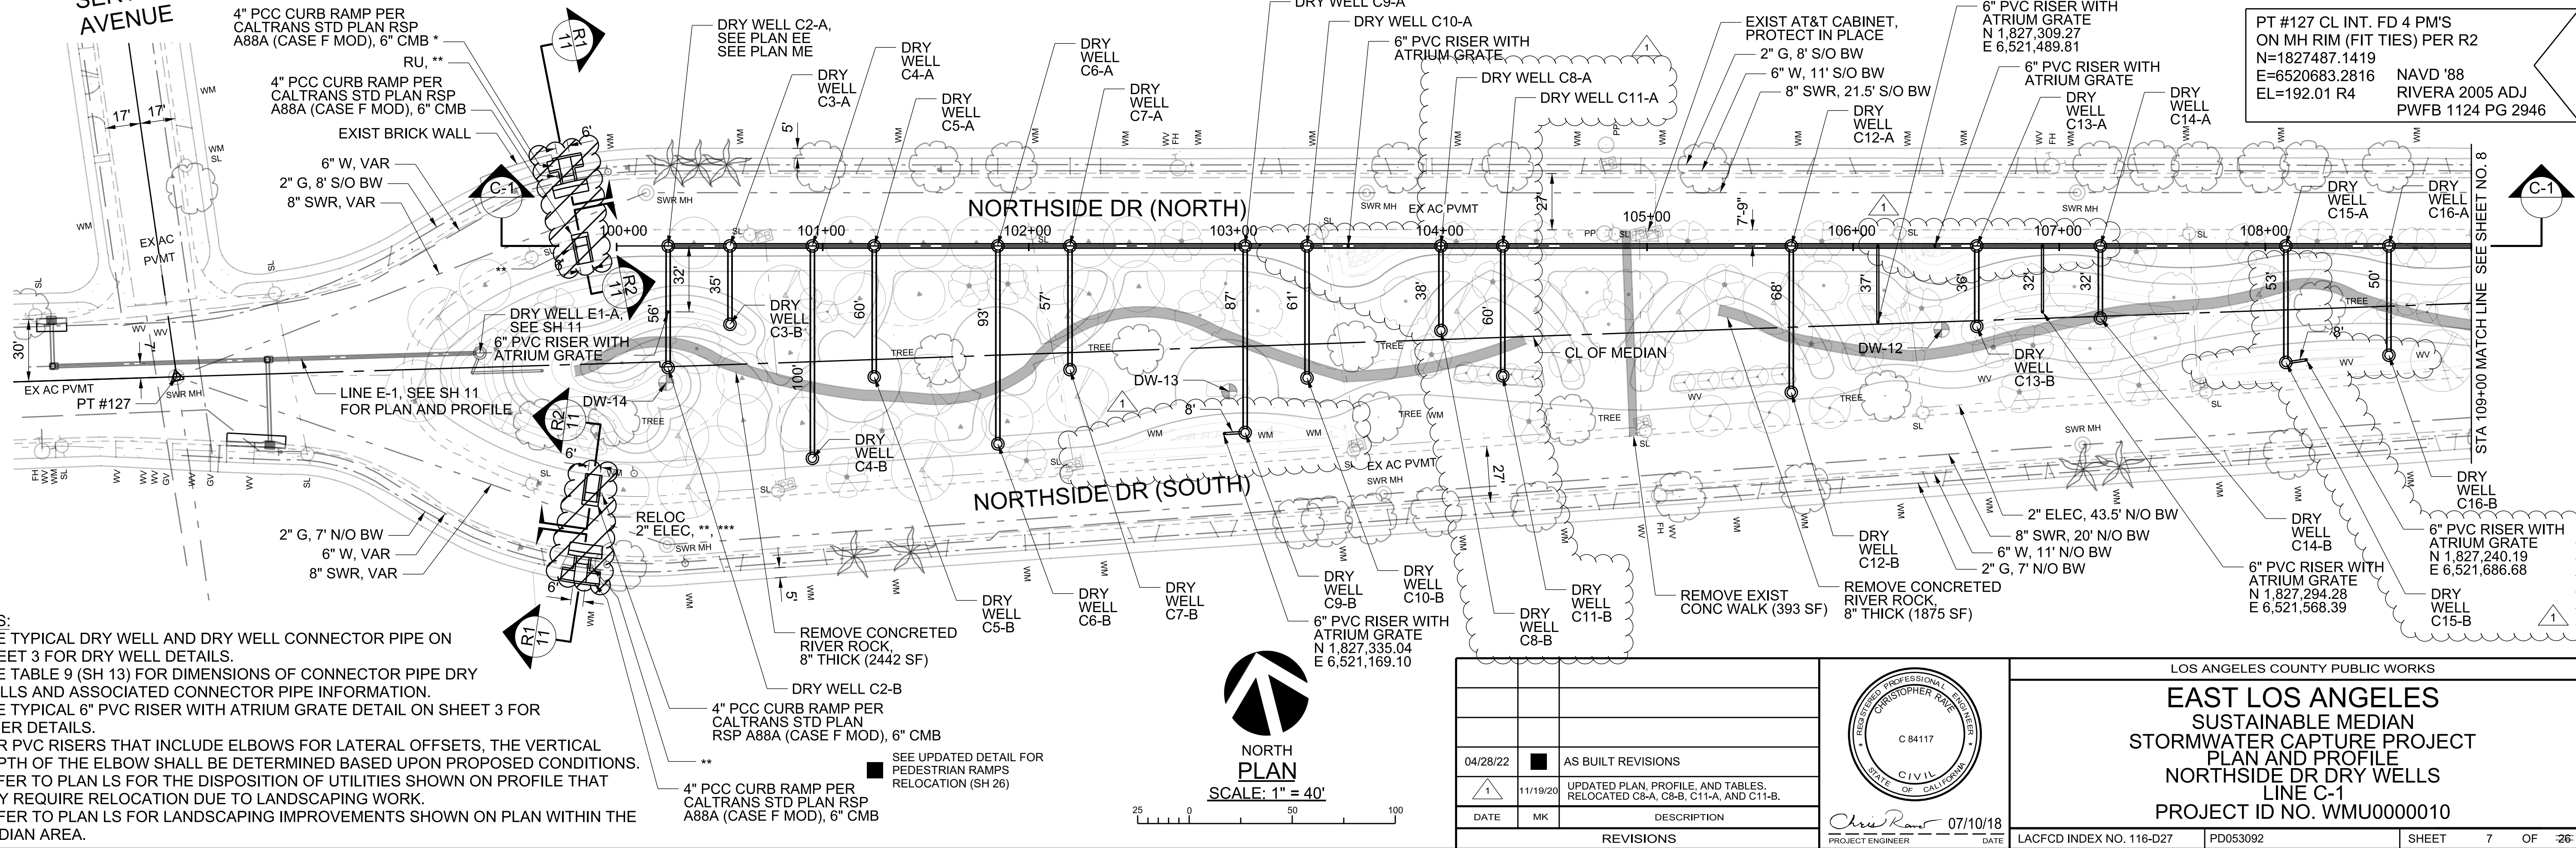

NORTH
PLAN
SCALE: 1" = 40'

DATE	REVISIONS
04/28/22	AS BUILT REVISIONS
11/19/20	UPDATED PLAN, PROFILE, AND TABLES, RELOCATED C8-A, C8-B, C11-A, AND C11-B.

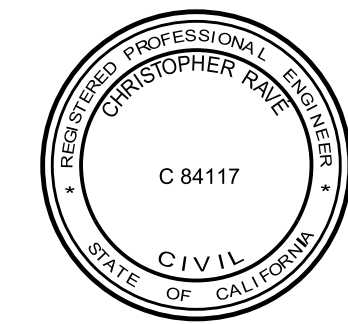

PROJECT ENGINEER
07/10/18

LOS ANGELES COUNTY PUBLIC WORKS
EAST LOS ANGELES
SUSTAINABLE MEDIAN
STORMWATER CAPTURE PROJECT
PLAN AND PROFILE
NORTHSIDE DR DRY WELLS
LINE C-1
PROJECT ID NO. WMU0000010

LACFCD INDEX NO. 116-D27 PD053092 SHEET 7 OF 26-27

AS BUILT DRAWINGS

PLAN DR

SCALE: HOR. 1" = 40'
VERT. 1" = 8'

SEE TABLE 5 HEREON
STA 109+00 MATCHLINE SEE SHEET NO. 7

SEE TABLE 5 HEREON
STA 109+00

CL DRY WELL C18-A
STA 109+40.00

CL DRY WELL C19-A
STA 110+10.00

CL DRY WELL C20-A
STA 110+45.00

CL EEL MON MH 321
STA 111+17.09

CL FILTRATION UNIT
STA 111+49.34

CL 72" RCP INF MON MH STA 111+42.84

CL VALVE STA 111+51.78

CL TRASH SLIDE GATE MH STA 111+88.76

EXIST SURFACE ALONG CONST CL

CL GARFIELD AV STA 112+66.12

CL DD1/23 EXIST STA 112+85.68

12" O.W. X 8'-6" RCB STA 98+61.65 DD1/23 EL-187.02, LA CFCD

CL DD1/23 EXIST STA 112+85.68

TOP OF 6" HIGH BERM EL 187.60 FL EL 187.81

EL 187.42

EL 187.31

EL 187.11

EL 186.99

EL 186.97

EL 186.93

EL 186.90

EL 186.86

EL 186.82

EL 177.18

EL 1

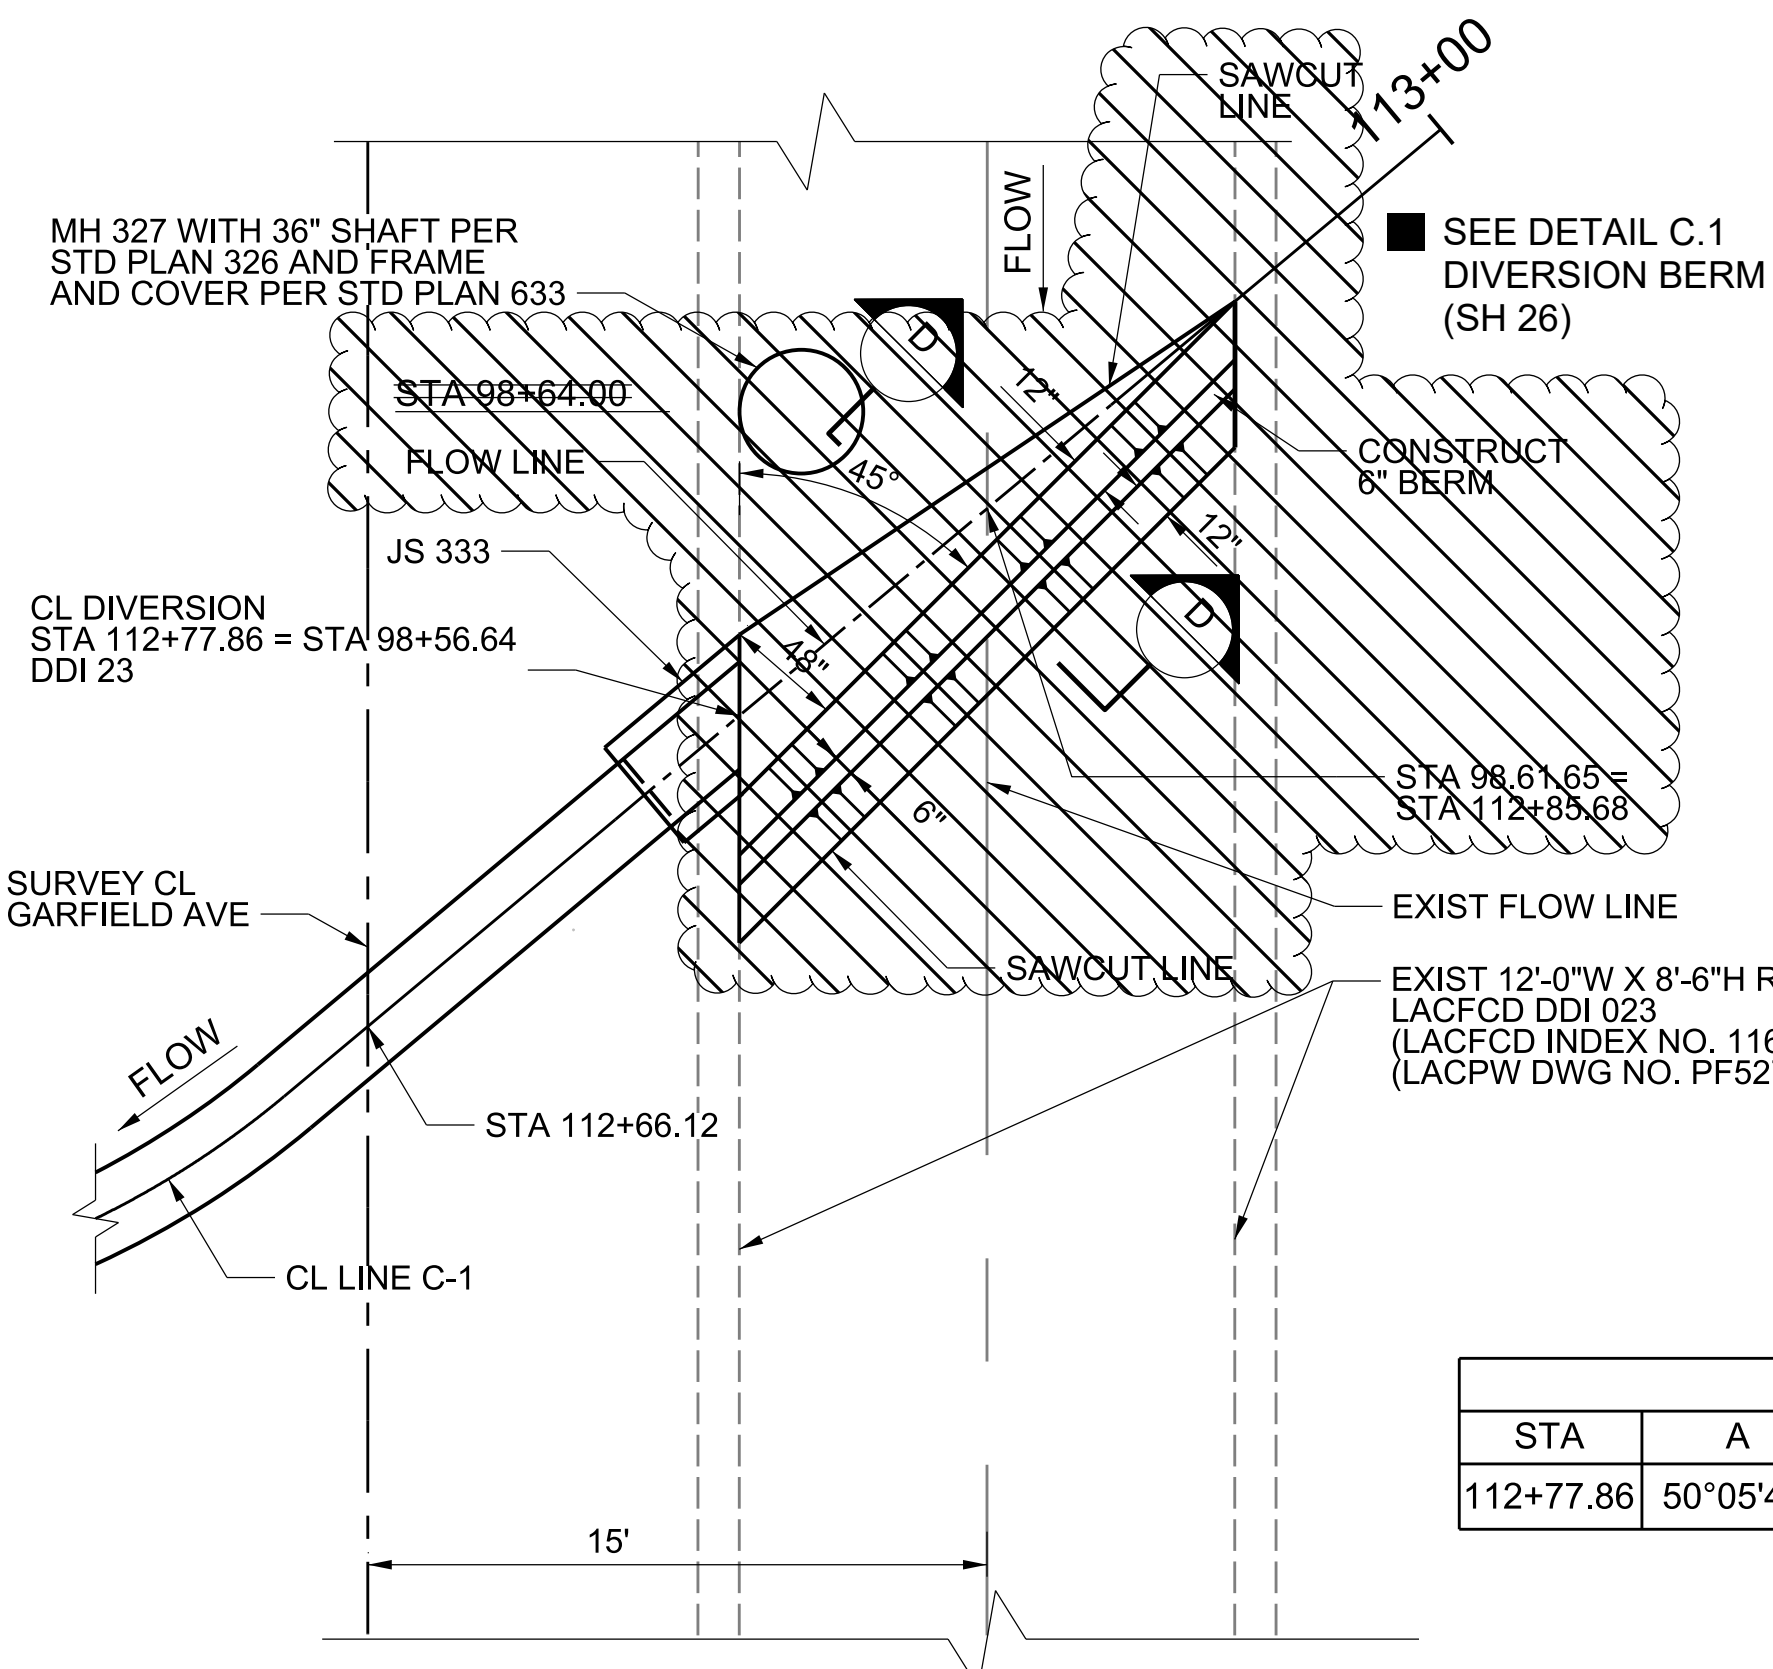


DRY WELL	NORTHING	EASTING	CASE	H	D	ELEV T	
C17-A	1,827,271.48	6,521,787.61	3	40'	60'	193.7	193.39
C18-A	1,827,259.14	6,521,836.07	3	40'	60'	193.9	193.97
C19-A	1,827,246.81	6,521,884.52	3	40'	60'	194.2	194.11
C20-A	1,827,230.77	6,521,947.51	1	40'	60'	196.1	195.78


TABLE 5
DRY WELLS LINE C-1
 ELEV "T" = FS FOR THE TOP OF THE DRY WELL COVER

RESURFACING SCHEDULE		
LOCATION	EXIST PVMT	RESURF PVMT
STA 110+86 TO STA 111+98	4" AC ON 4" CMB	5" AC ON 4" CMB
STA 112+30 TO STA 112+78	8" CONC ON 5" CMB	8" PCC ON 5" CMB


AC SHALL BE 2" OF C2-PG 64-10 ON 3" OF B-PG 64-10.

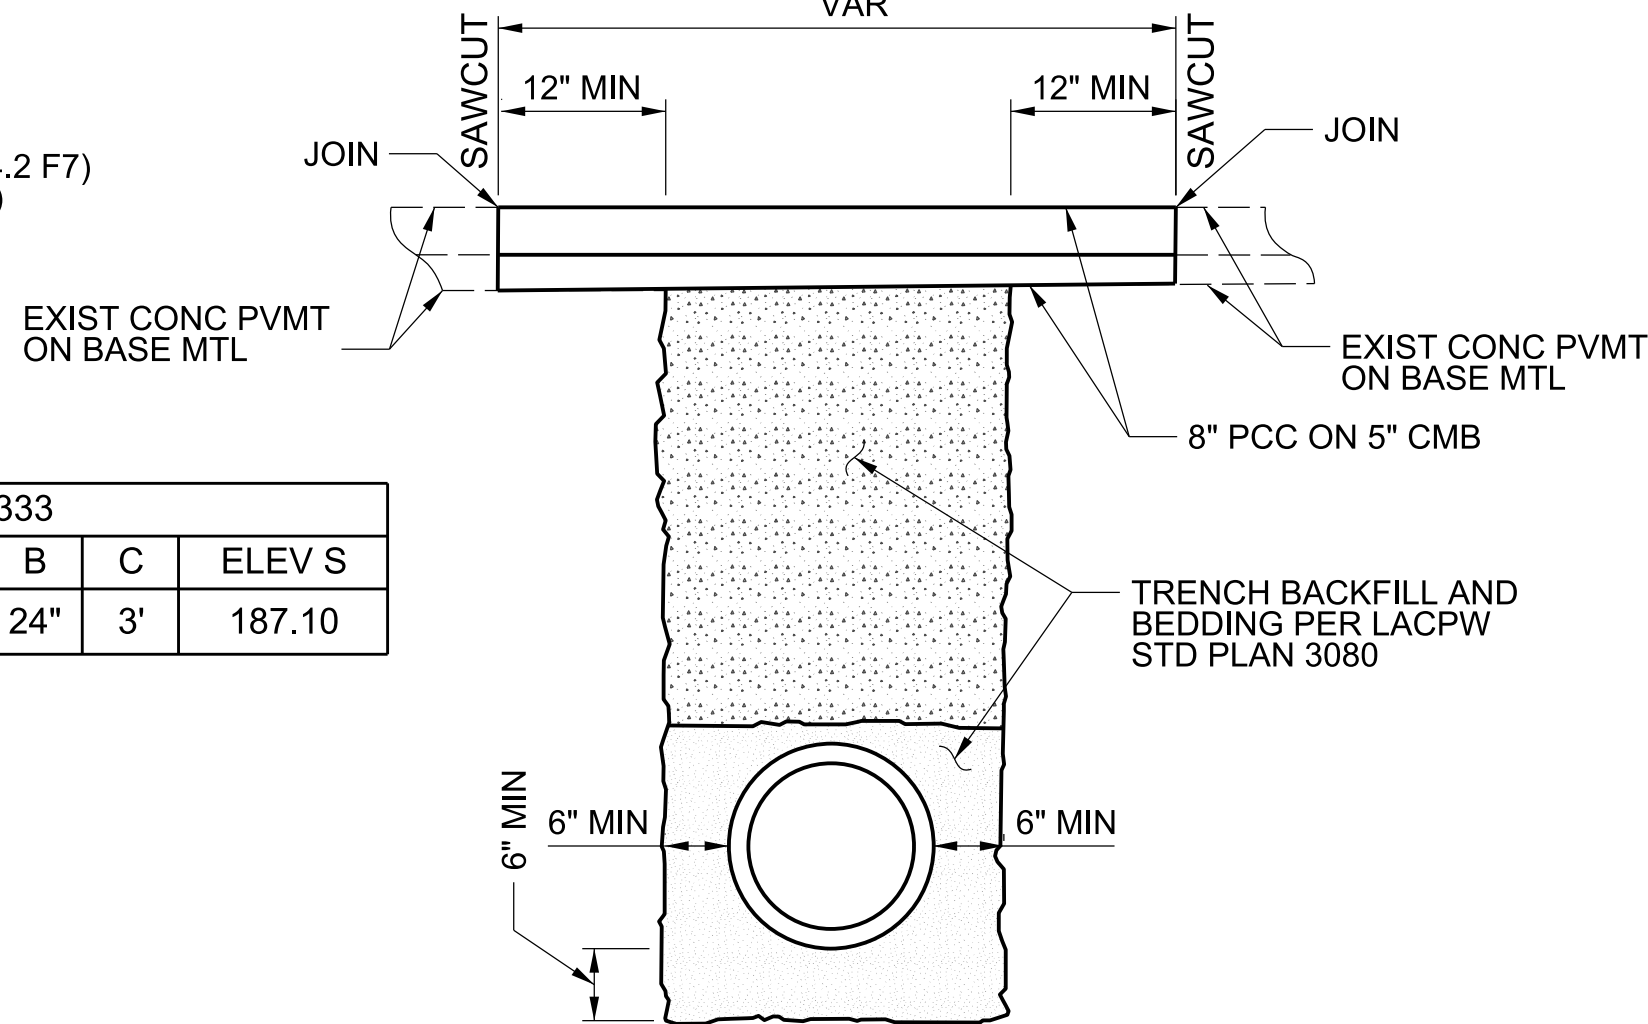

TYPICAL PIPE TRENCH DETAIL
FOR PCC PAVEMENT
NO SCALE

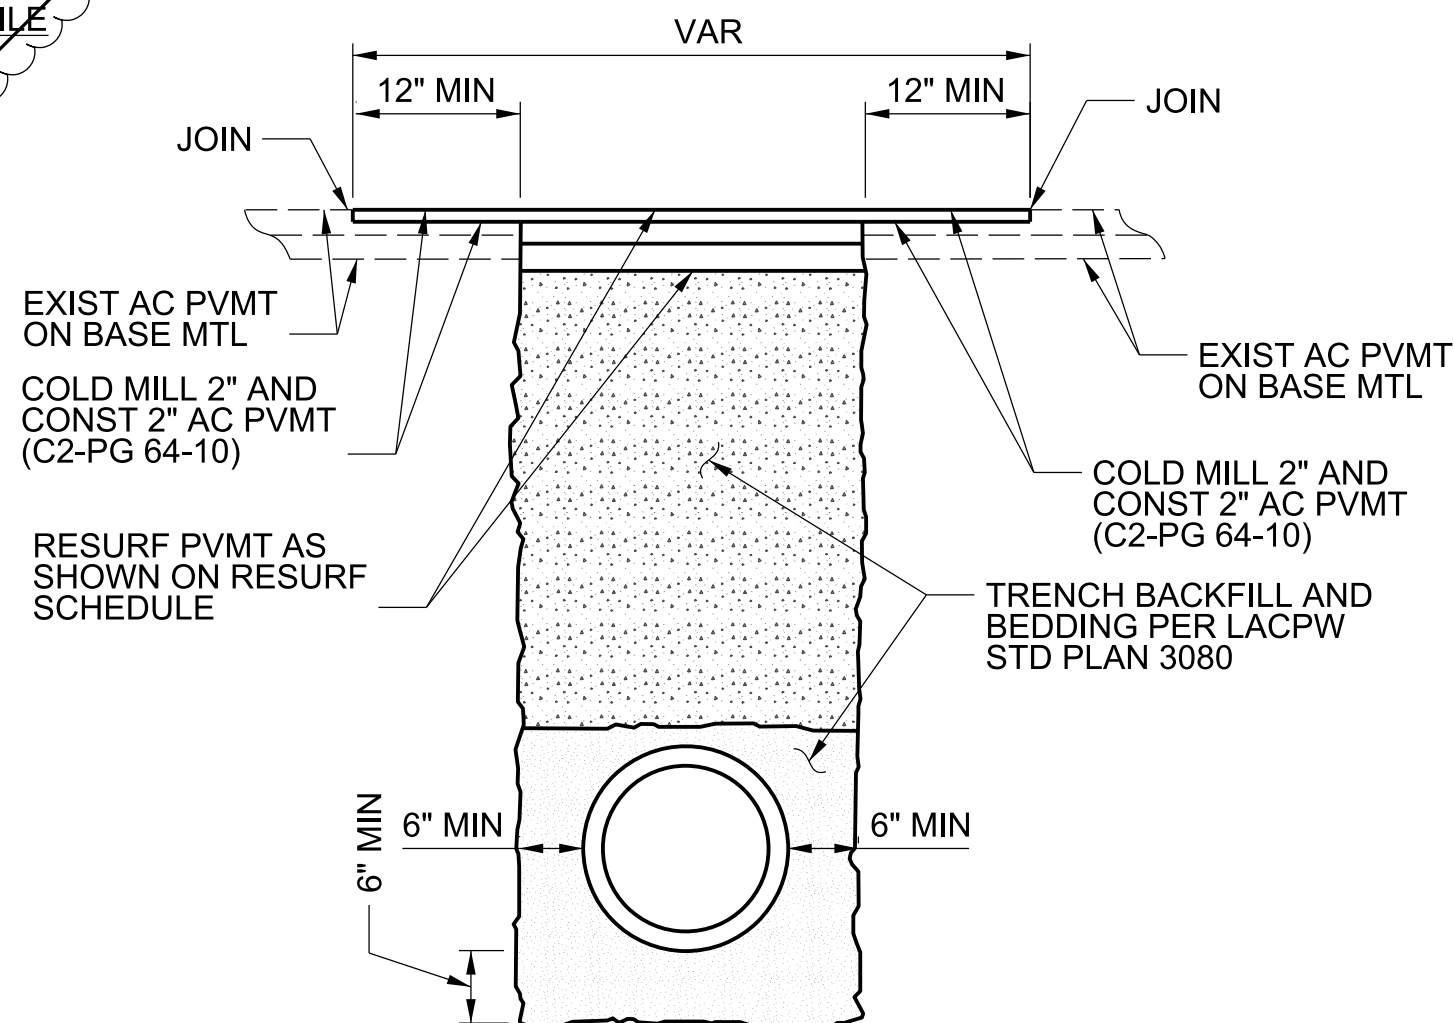


TYPICAL PIPE TRENCH DETAIL
FOR AC PAVEMENT
NO SCALE

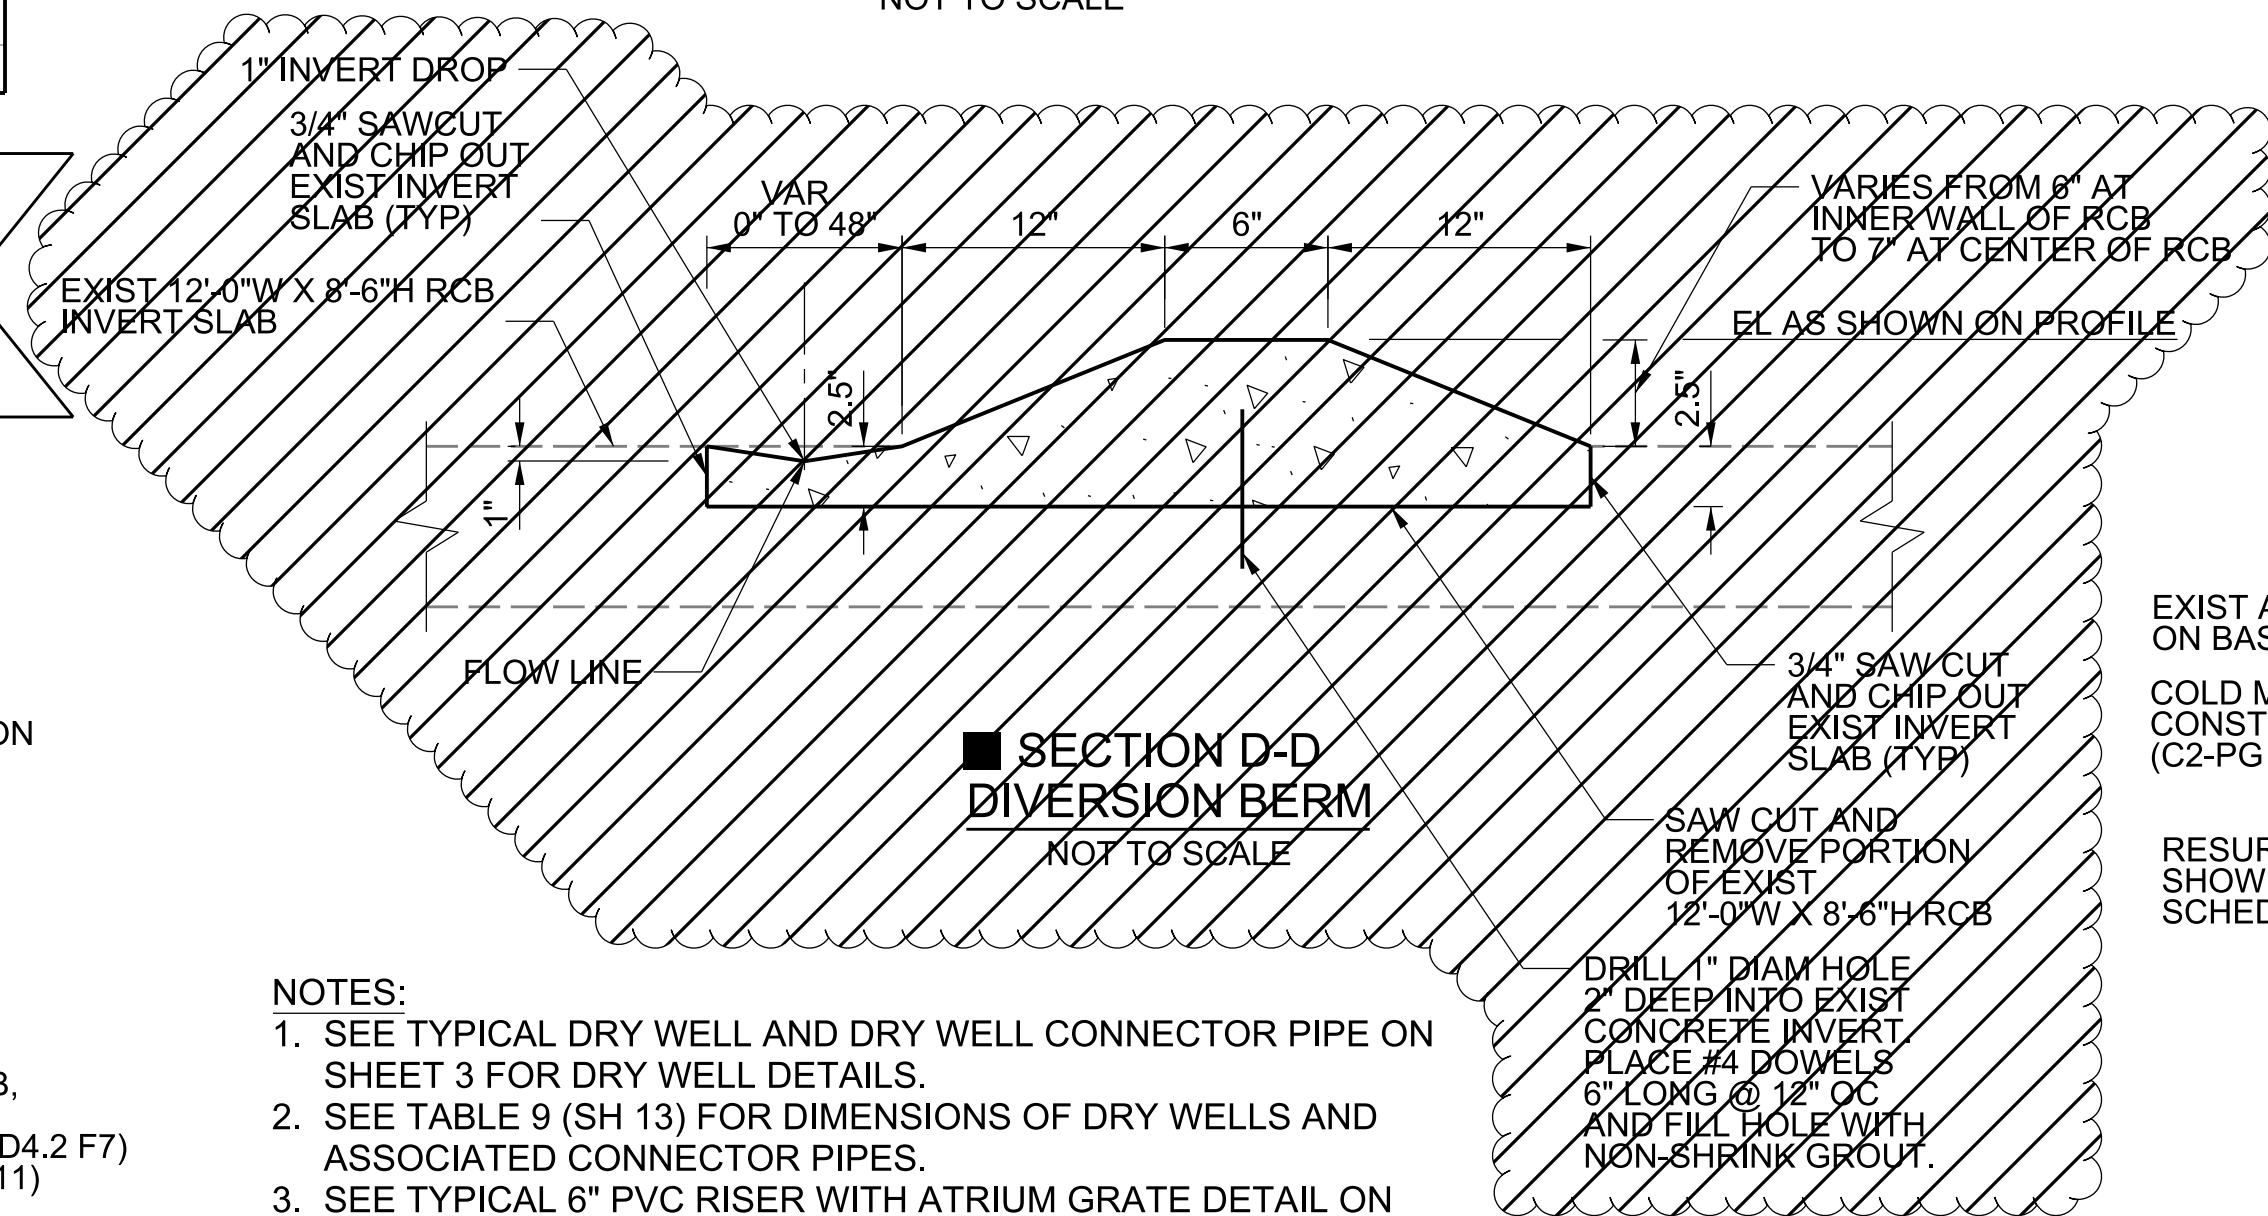

SECTION D-D
DIVERSION BERM
NOT TO SCALE

- NOTES:**
1. SEE TYPICAL DRY WELL AND DRY WELL CONNECTOR PIPE ON SHEET 3 FOR DRY WELL DETAILS.
 2. SEE TABLE 9 (SH 13) FOR DIMENSIONS OF DRY WELLS AND ASSOCIATED CONNECTOR PIPES.
 3. SEE TYPICAL 6" PVC RISER WITH ATRIUM GRATE DETAIL ON SHEET 3 FOR RISER DETAILS.
 4. FOR PVC RISERS THAT INCLUDE ELBOWS FOR LATERAL OFFSETS, THE VERTICAL DEPTH OF THE ELBOW SHALL BE DETERMINED BASED UPON PROPOSED CONDITIONS.
 5. REFER TO PLAN LS FOR THE DISPOSITION OF UTILITIES SHOWN ON PROFILE THAT MAY REQUIRE RELOCATION DUE TO LANDSCAPING WORK.
 6. REFER TO PLAN LS FOR LANDSCAPING IMPROVEMENTS SHOWN ON PLAN WITHIN THE MEDIAN AREA.

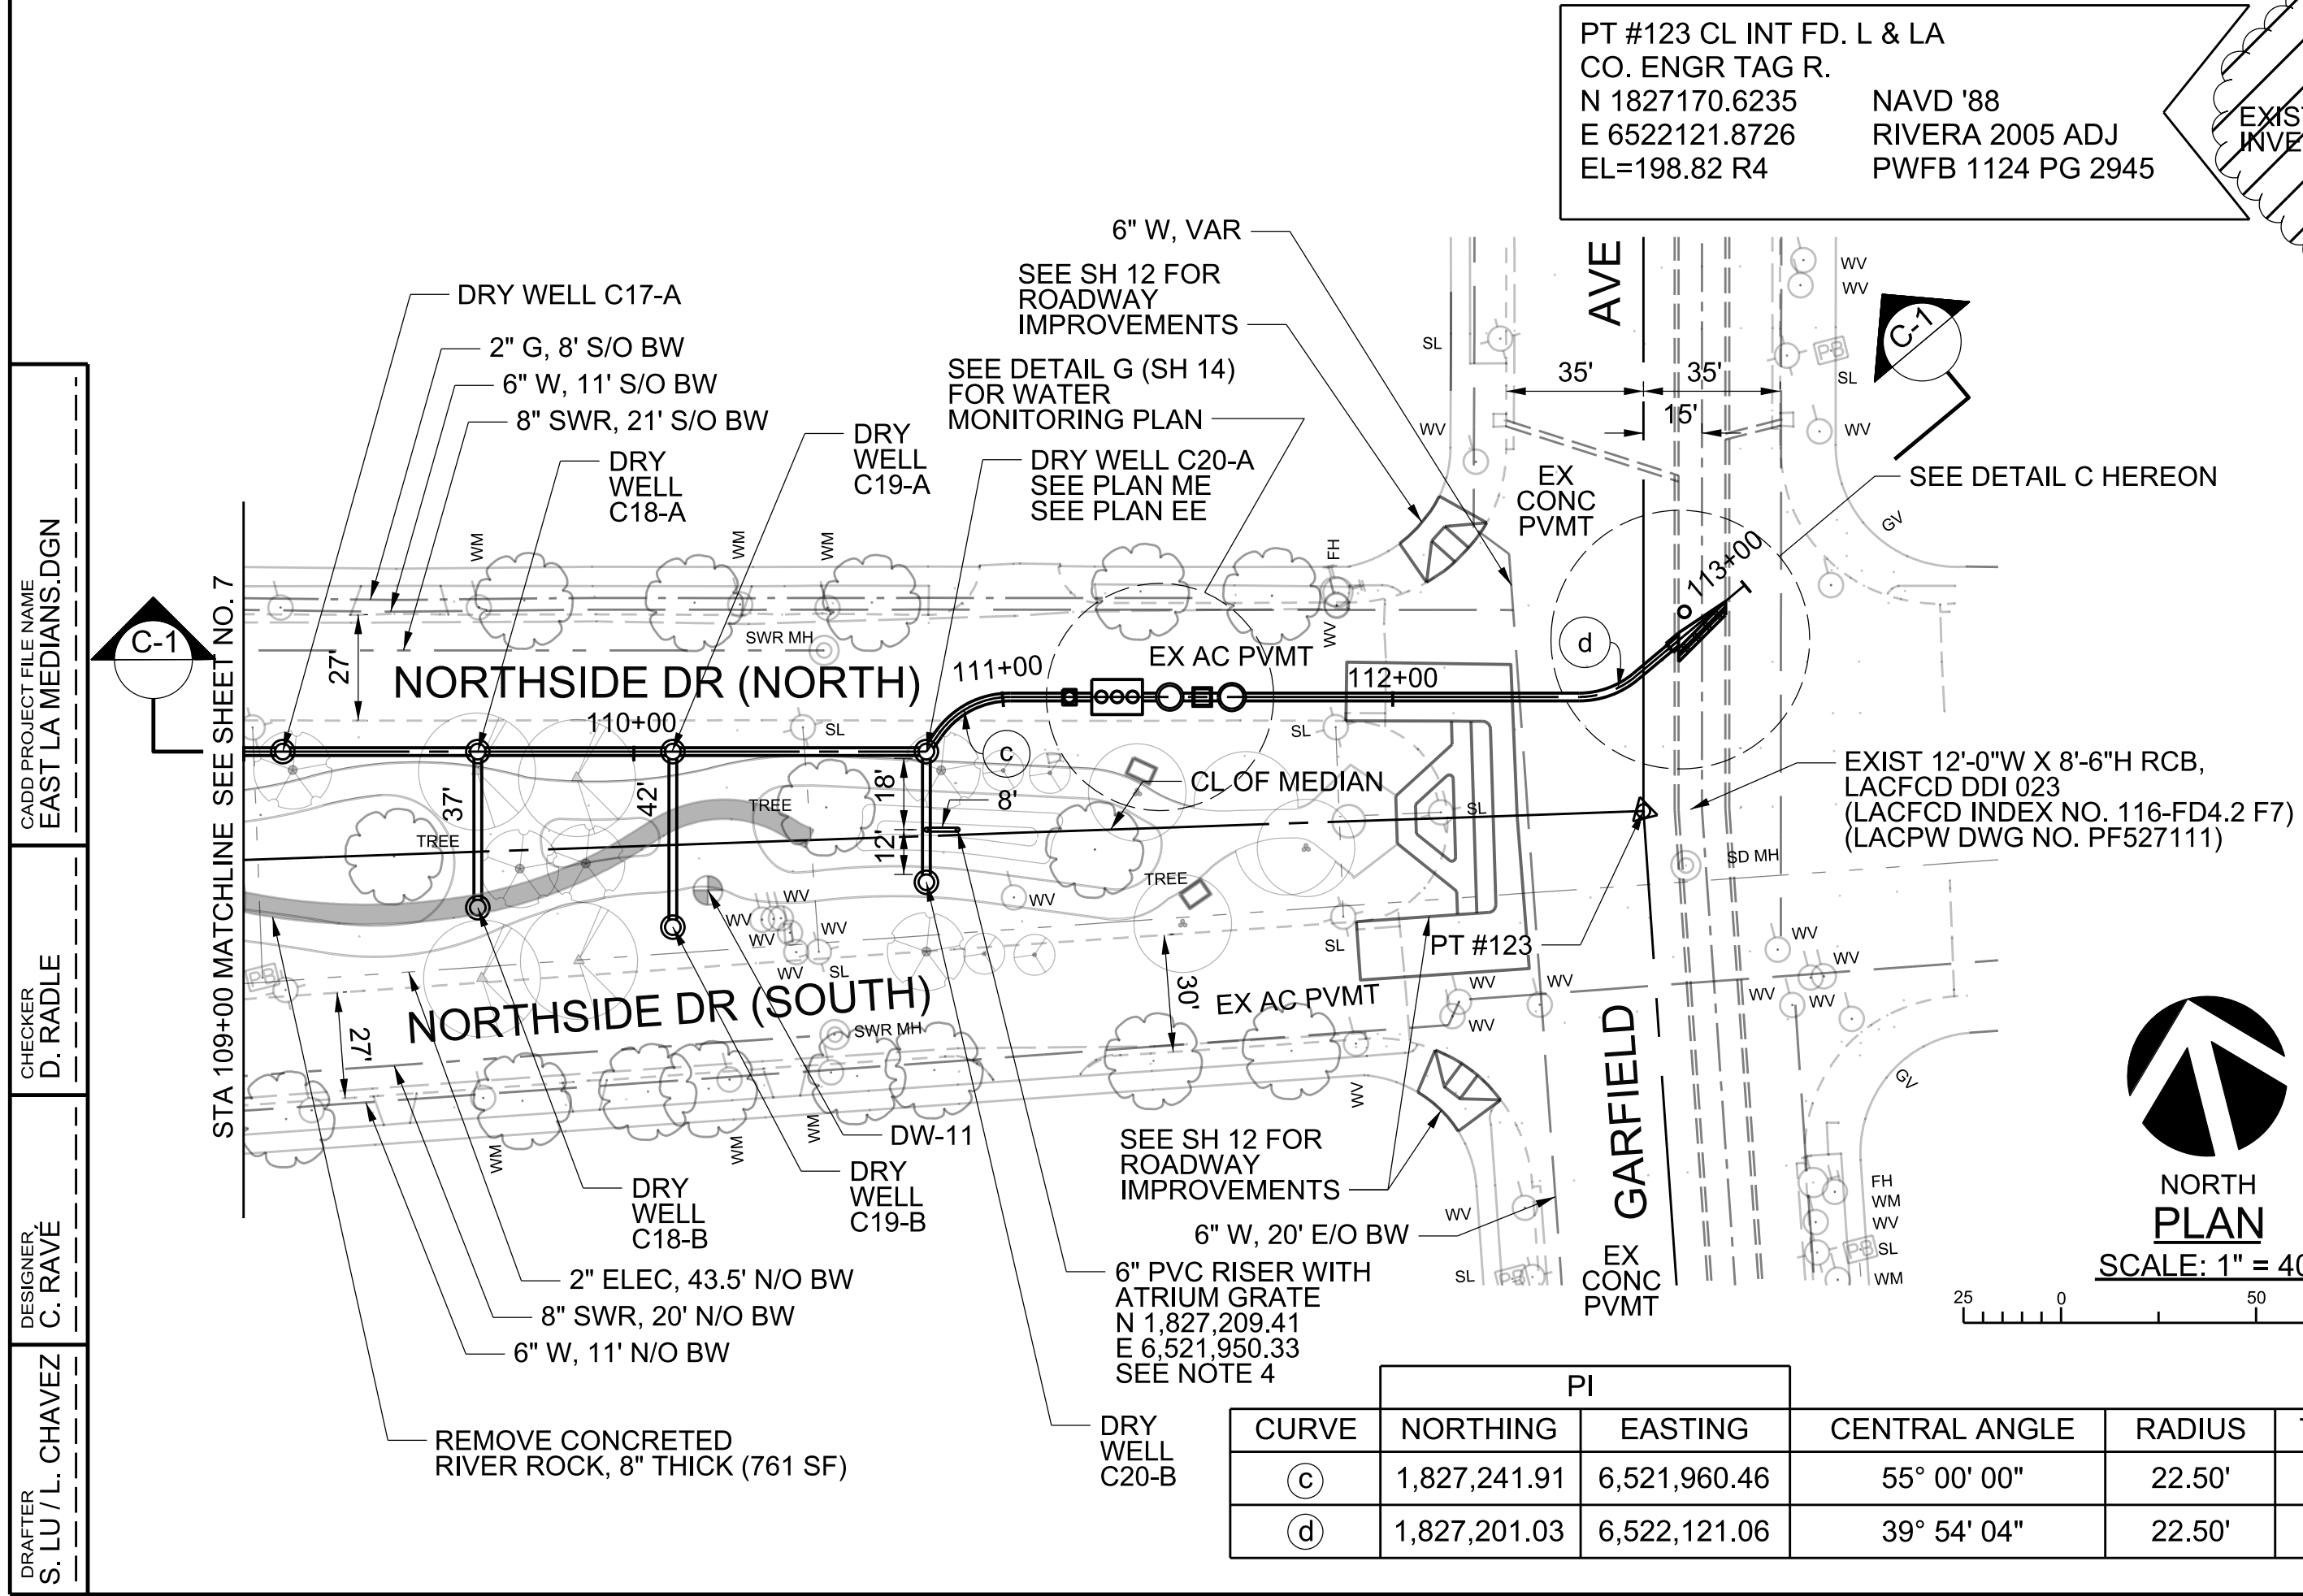

PI								
CURVE	NORTHING	EASTING	CENTRAL ANGLE	RADIUS	TANGENT	LENGTH	BC	EC
Ⓒ	1,827,241.91	6,521,960.46	55° 00' 00"	22.50'	11.71'	21.60'	110+80.38	111+01.98
Ⓓ	1,827,201.03	6,522,121.06	39° 54' 04"	22.50'	8.17'	15.67'	112+47.81	112+63.48

AS BUILT DRAWINGS

PLAN DR

NOT TO BE OWNED BY LACFCD
Q_{85TH} = 7.73 CFS

DRY WELL	NORTHING	EASTING	CASE	H	D	ELEV T
D2-A	1,826,204.45	6,520,743.25	2	40'	60'	181.2
D3-A	1,826,198.57	6,520,775.72	3	40'	60'	182.5
D4-A	1,826,193.22	6,520,805.24	3	40'	60'	182.8
D5-A	1,826,186.09	6,520,844.60	3	40'	60'	183.0
D6-A	1,826,177.18	6,520,893.80	3	40'	60'	183.2
D7-A	1,826,171.84	6,520,923.32	3	40'	60'	183.6
D8-A	1,826,166.49	6,520,952.84	3	40'	60'	183.9
D9-A	1,826,149.91	6,521,044.34	3	40'	60'	185.3
D10-A	1,826,126.56	6,521,173.25	1	40'	60'	187.5
D11-A	1,826,141.29	6,521,237.80	3	40'	60'	186.4
D12-A	1,826,130.60	6,521,296.84	1	40'	60'	187.6
D13-A	1,826,125.25	6,521,326.36	3	40'	60'	186.0
D14-A	1,826,117.23	6,521,370.63	3	40'	60'	185.1
D15-A	1,826,106.54	6,521,429.68	3	40'	60'	185.2
D16-A	1,826,100.30	6,521,464.12	3	40'	60'	185.2
D17-A	1,826,087.82	6,521,533.00	1	40'	60'	188.8

TABLE 6
DRY WELLS LINE D-1


SEE UPDATED
ELEV T VALUES ON
TABLE 6.1 (SH 26)

ELEV "T" = FS FOR THE TOP OF THE DRY WELL COVER

NOTES:



- SEE TYPICAL DRY WELL AND DRY WELL CONNECTOR PIPE ON SHEET 3 FOR DRY WELL DETAILS.
 - SEE TABLE 9 (SH 13) FOR DIMENSIONS OF CONNECTOR PIPE DRY WELLS AND ASSOCIATED CONNECTOR PIPE INFORMATION.
 - SEE TYPICAL 6" PVC RISER WITH ATRIUM GRATE DETAIL ON SHEET 3 FOR RISER DETAILS.
 - FOR PVC RISERS THAT INCLUDE ELBOWS FOR LATERAL OFFSETS, THE VERTICAL DEPTH OF THE ELBOW SHALL BE DETERMINED BASED UPON PROPOSED CONDITIONS.
 - REFER TO PLAN LS FOR THE DISPOSITION OF UTILITIES SHOWN ON PROFILE THAT MAY REQUIRE RELOCATION DUE TO LANDSCAPING WORK.
 - REFER TO PLAN LS FOR LANDSCAPING IMPROVEMENTS SHOWN ON PLAN WITHIN THE MEDIAN AREA.
- * CONTRACTOR SHALL REMOVE INTERFERING WALL FOOTING AND JOIN RAMP TO EXISTING BRICK WALL PROPOSED PEDESTRIAN SIGNAL PER PLAN SP
- ** FOR SCE ELECTRICAL CONDUIT RELOCATION, THE CONTRACTOR SHALL CONTACT THE SCE PLANNER (NOELLE PETERSON) AT (310) 608-5162 TO COORDINATE THE WORK THAT NEEDS TO BE PERFORMED.

SCALE: HOR. 1" = 40'
VERT. 1" = 8'

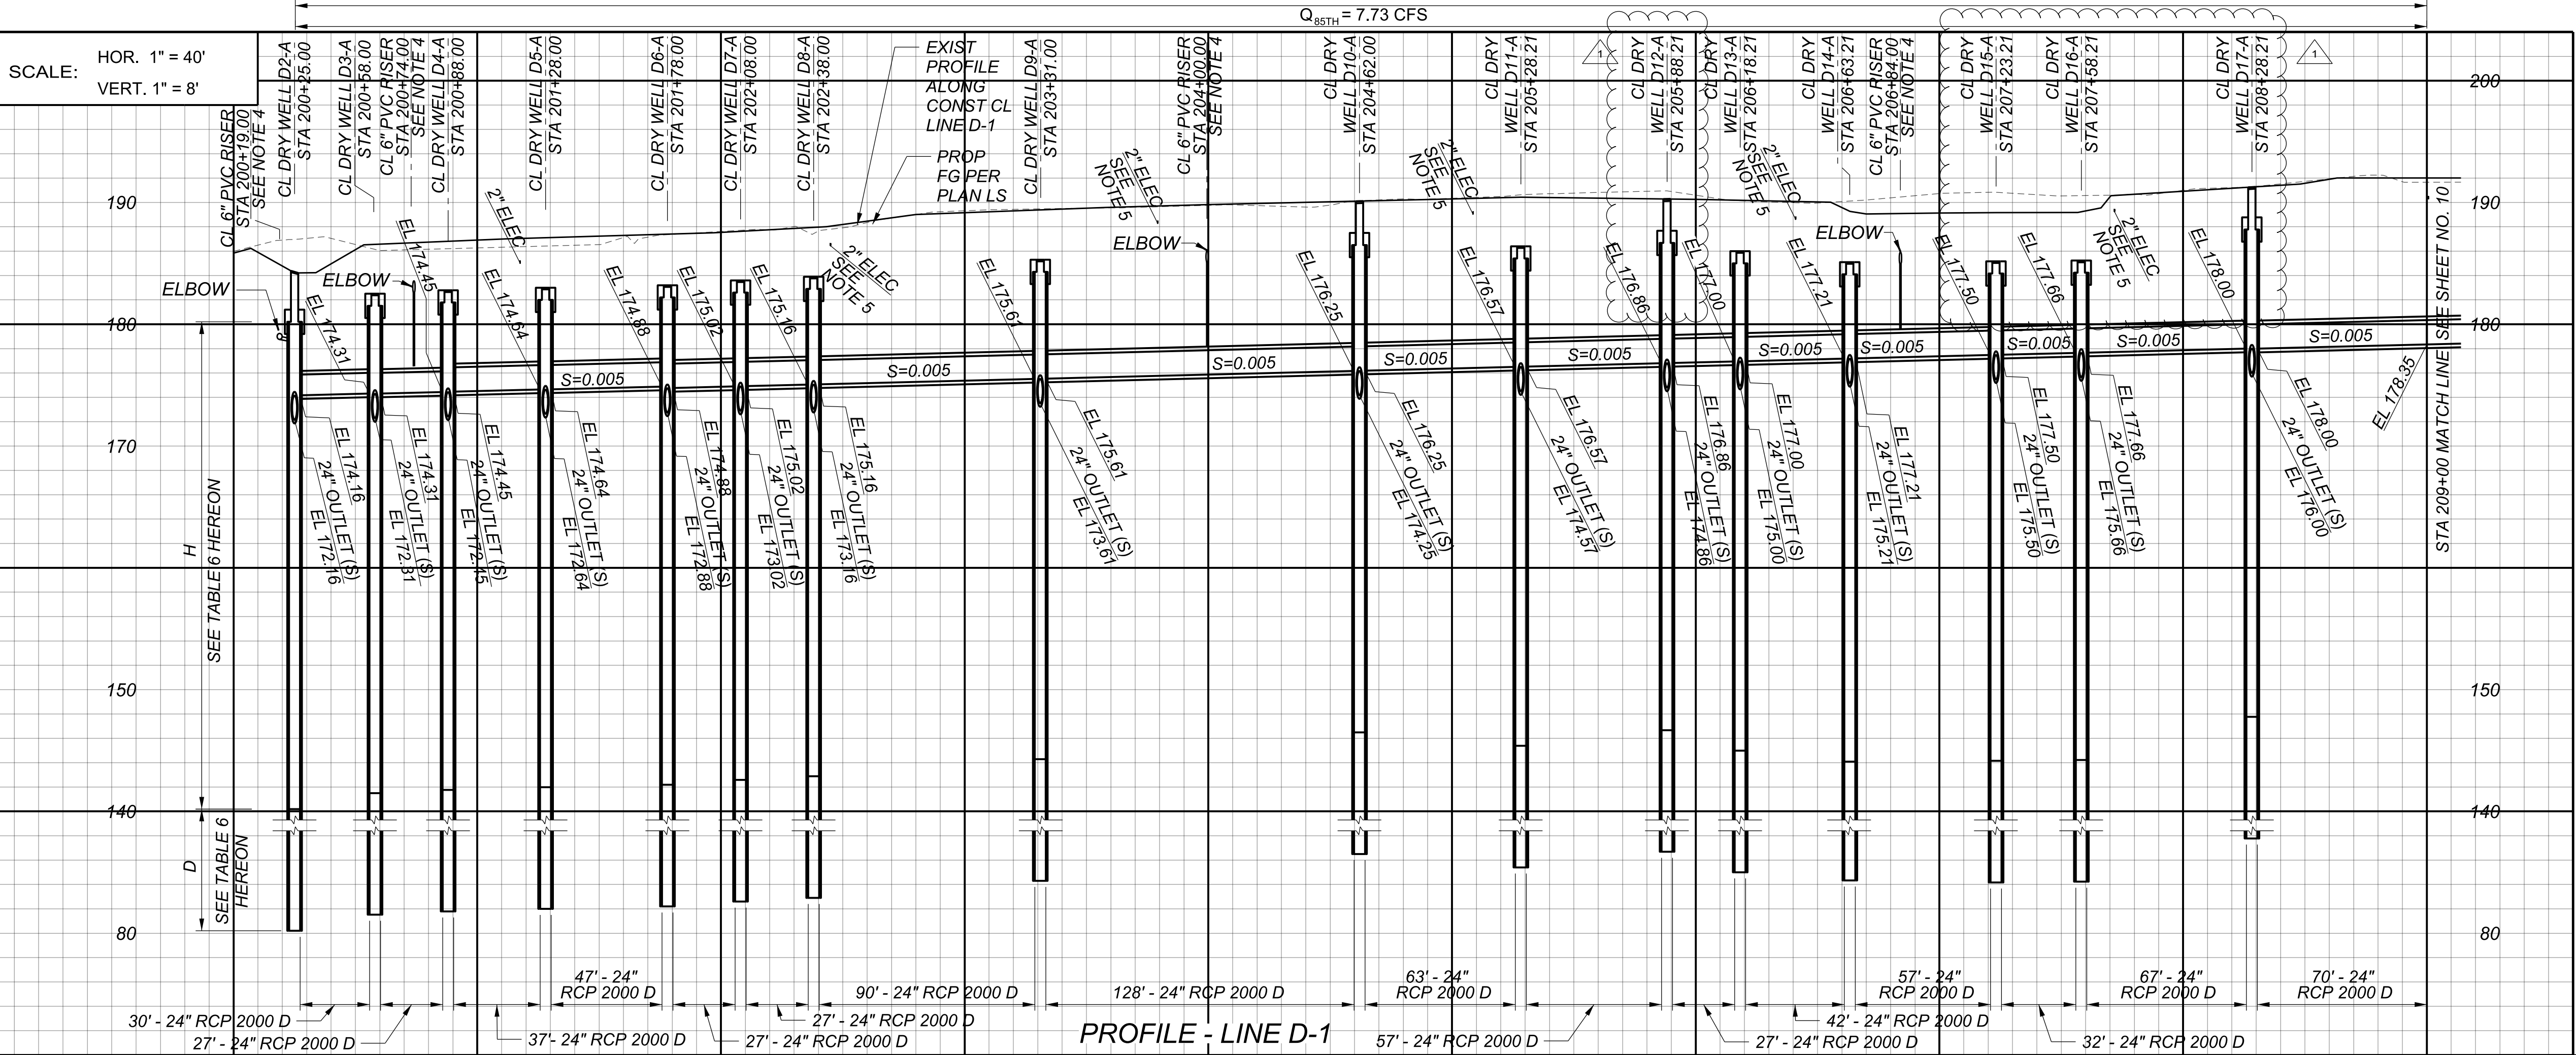


PROFILE - LINE D-1

SERVER AVE

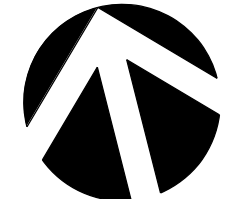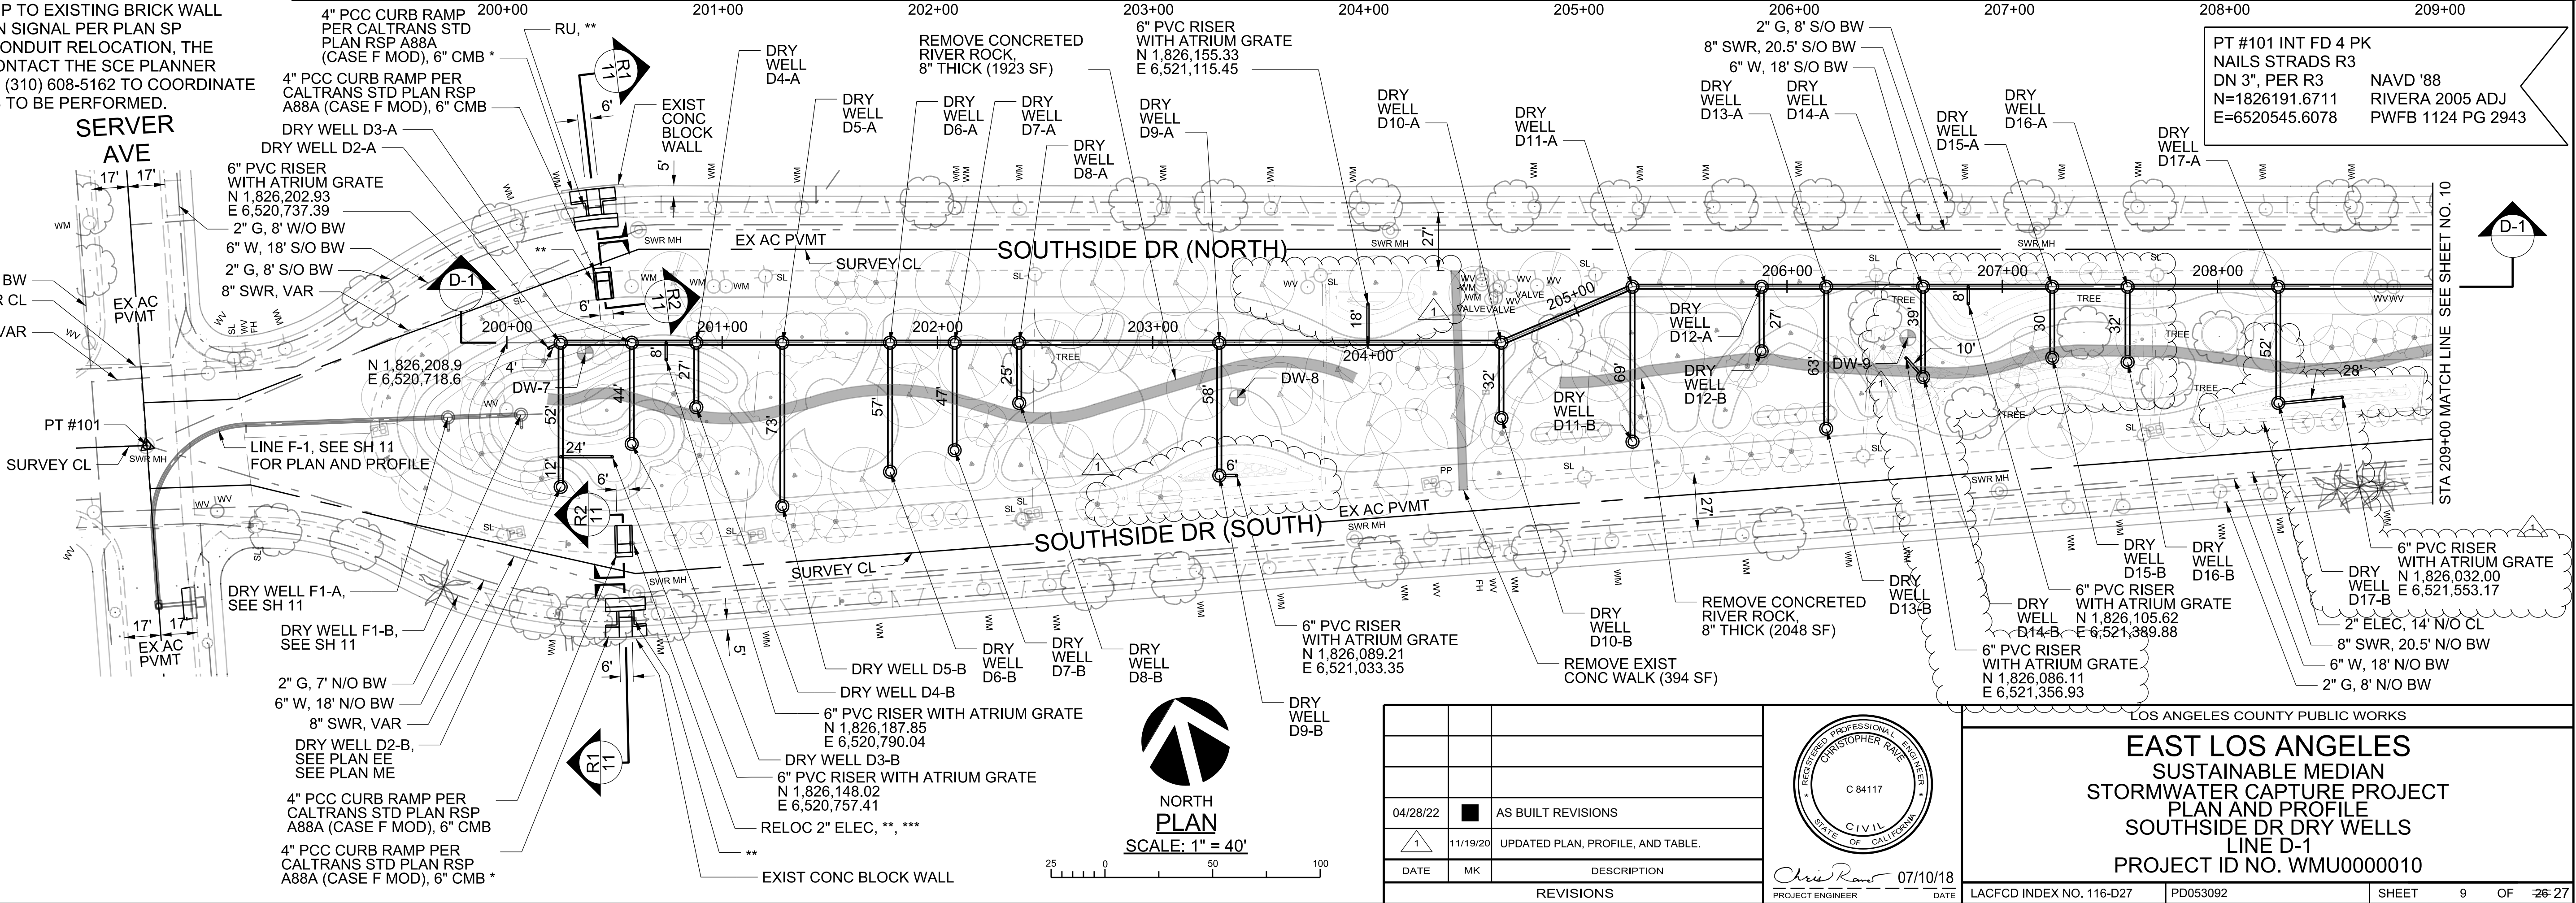

NORTH
PLAN
SCALE: 1" = 40'

DATE	REVISIONS
04/28/22	AS BUILT REVISIONS
11/19/20	UPDATED PLAN, PROFILE, AND TABLE.

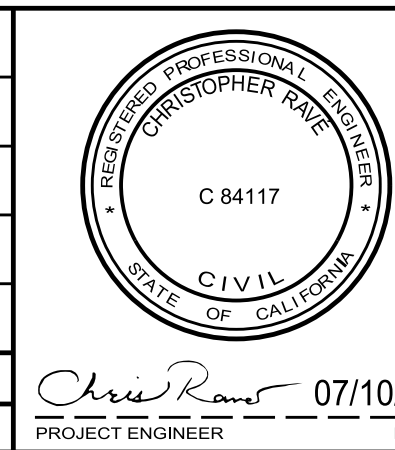


LOS ANGELES COUNTY PUBLIC WORKS
EAST LOS ANGELES
SUSTAINABLE MEDIAN
STORMWATER CAPTURE PROJECT
PLAN AND PROFILE
SOUTHSIDE DR DRY WELLS
LINE D-1
PROJECT ID NO. WMU0000010
LACFCD INDEX NO. 116-D27 PD053092 SHEET 9 OF 26-27

AS BUILT DRAWINGS

PLAN DR


$$Q_{85TH} = 7.73 \text{ CFS}$$

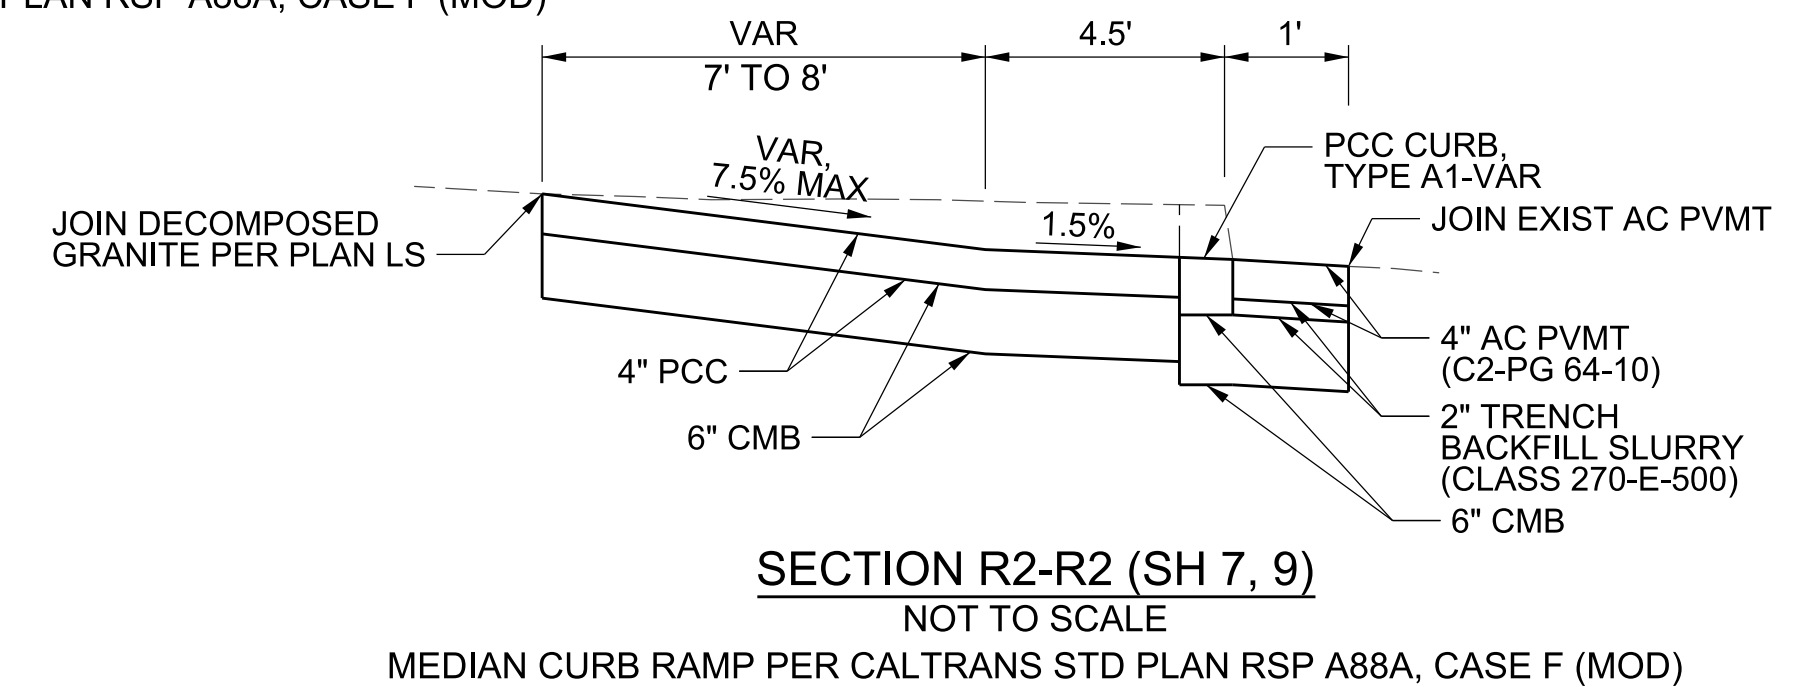- NOTES:
1. SEE TYPICAL DRY WELL AND DRY WELL CONNECTOR PIPE ON SHEET 3 FOR DRY WELL DETAILS.
 2. SEE TYPICAL 6" PVC RISER WITH ATRIUM GRATE DETAIL ON SHEET 3 FOR RISER DETAILS.
 3. FOR PVC RISERS THAT INCLUDE ELBOWS FOR LATERAL OFFSETS, THE VERTICAL DEPTH OF THE ELBOW SHALL BE DETERMINED BASED UPON PROPOSED CONDITIONS.
 4. REFER TO PLAN LS FOR THE DISPOSITION OF UTILITIES SHOWN ON PROFILE THAT MAY REQUIRE RELOCATION DUE TO LANDSCAPING WORK.
 5. MANHOLE 321 SHALL HAVE A SHAFT PER STD PLAN 326.
 6. REFER TO PLAN LS FOR LANDSCAPING IMPROVEMENTS SHOWN ON PLAN WITHIN THE MEDIAN AREA.
 7. EACH GRATING CATCH BASIN SHALL INCLUDE GRATE(S) PER CITY OF LOS ANGELES BUREAU OF ENGINEERING STD PLAN S-342-4.
 8. THE CATCH BASIN CONNECTOR PIPE SCREEN SHALL BE MODIFIED TO EXCLUDE THE OVERFLOW OPENING.
- * 4" AC PVMT (C2-PG 64-10, B-PG 64-10) ON 10" CMB

	PI							
CURVE	NORTHING	EASTING	CENTRAL ANGLE	RADIUS	TANGENT	LENGTH	BC	EC
(h)	1,826,199.61	6,520,546.45	92° 05' 38"	45.00'	46.68'	72.33'	91+37.83	92+10.16


04/28/22	<input checked="" type="checkbox"/>	AS BUILT REVISIONS	
DATE	MK	DESCRIPTION	
REVISIONS			



Chris Rowe 07/10/18

PROJECT ENGINEER DATE

LOS ANGELES COUNTY PUBLIC WORKS			
<p align="center">EAST LOS ANGELES SUSTAINABLE MEDIAN STORMWATER CAPTURE PROJECT PLAN AND PROFILE LINES E-1 AND F-1 PROJECT ID NO. WMU0000010</p>			
LACFCD INDEX NO. 116-D27	PD053092	SHEET	11 OF 26-27

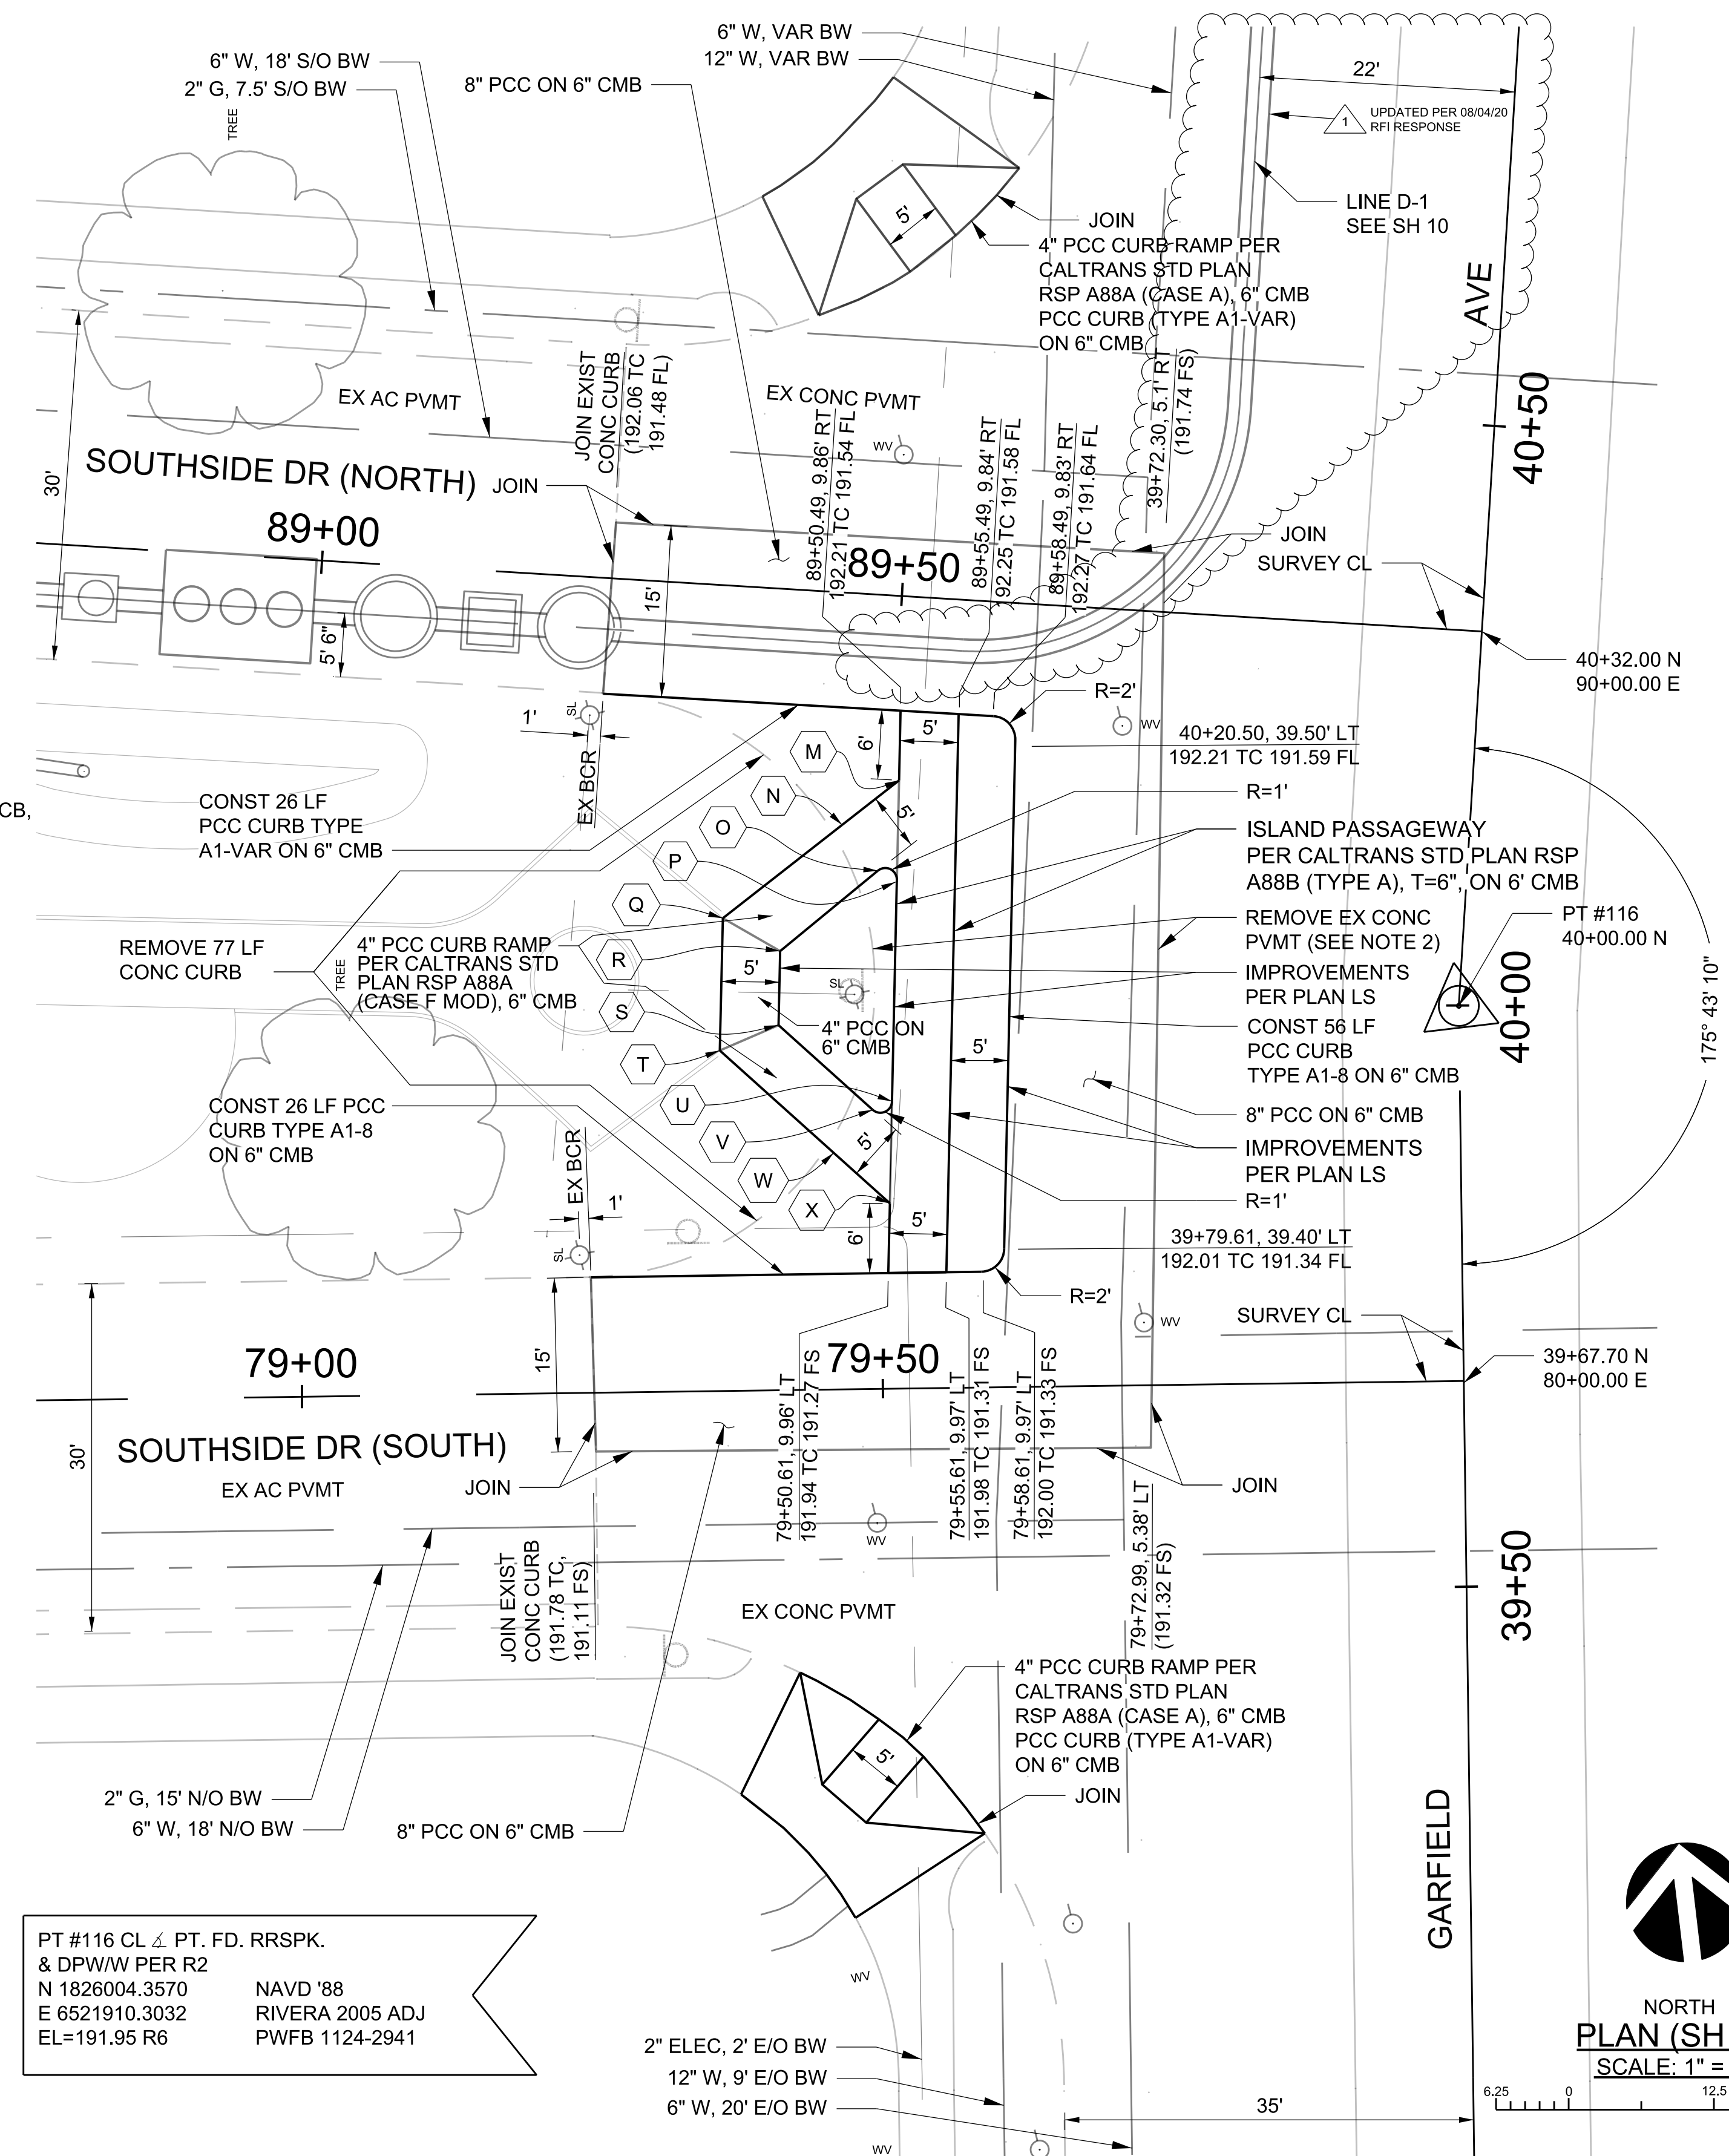


PT #116 CL 4 PT. FD. RRSPK.
& DPW/W PER R2
N 1826004.3570
E 6521910.3032
EL=191.95 R6

NAVD '88
RIVERA 2005 ADJ
PWFB 1124-2941


LOS ANGELES COUNTY PUBLIC WORKS			
<p align="center">EAST LOS ANGELES SUSTAINABLE MEDIAN STORMWATER CAPTURE PROJECT PLAN - MEDIAN EXTENSION DETAILS PROJECT ID NO. WМУ0000010</p>			
LACFD INDEX NO. 116-D27	PD053092	SHEET	12 OF 26

JS 333			
STATION	A	B	C
218+56.84	50° 05' 41"	24"	4'

- NOTES:
- SAWCUT 1" DEEP ALONG PERIMETER OF CONCRETE REMOVAL LIMITS TO PREVENT FEATHER EDGING.
 - REMOVE CONCRETE AND CHIP OUT 1/2" BEHIND SURFACE OF THE INVERT AT THE CENTER OF THE BOX.
 - ROUGHEN THE EXPOSED SURFACE OF REMOVED INVERT TO OBTAIN A 1/4" AMPLITUDE.
 - APPLY PATCHING MORTAR (SIKA REPAIR 224 OR AGENCY-APPROVED EQUAL) ON THE ROUGHED SURFACE TO SMOOTHEN THE FINISHED SURFACE.

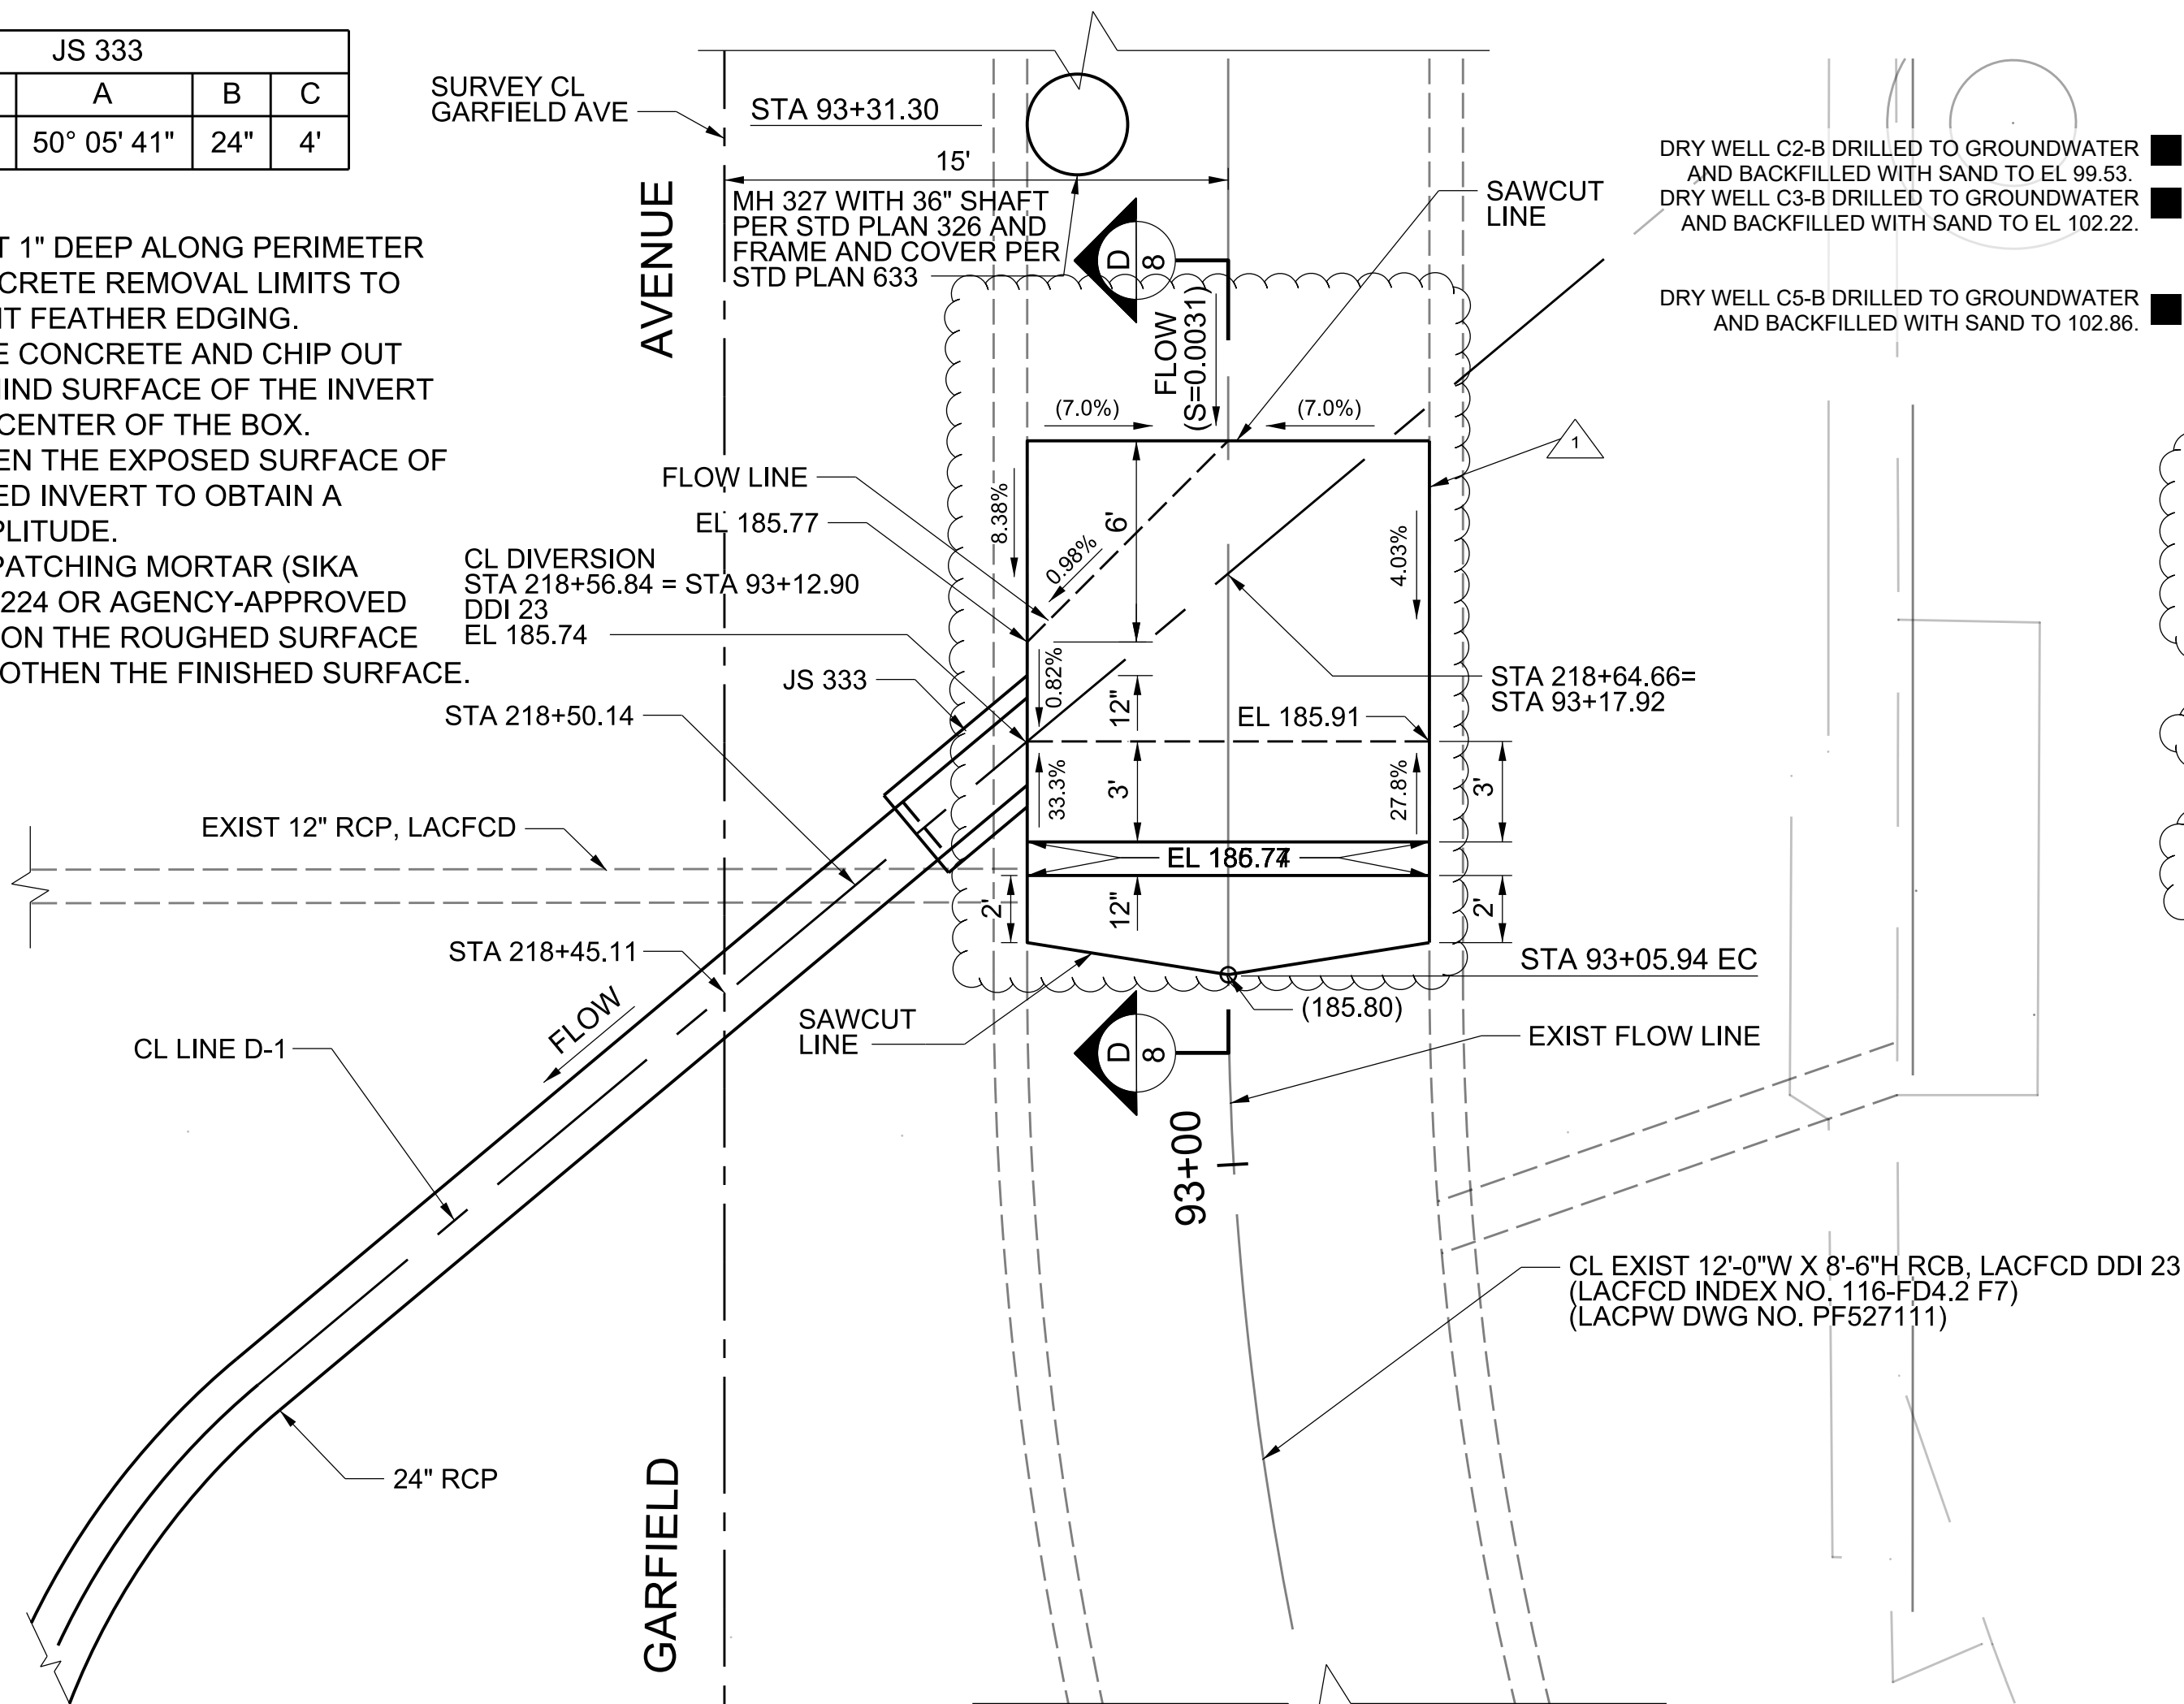


DETAIL D
DIVERSION BERM (SH 10)
NOT TO SCALE

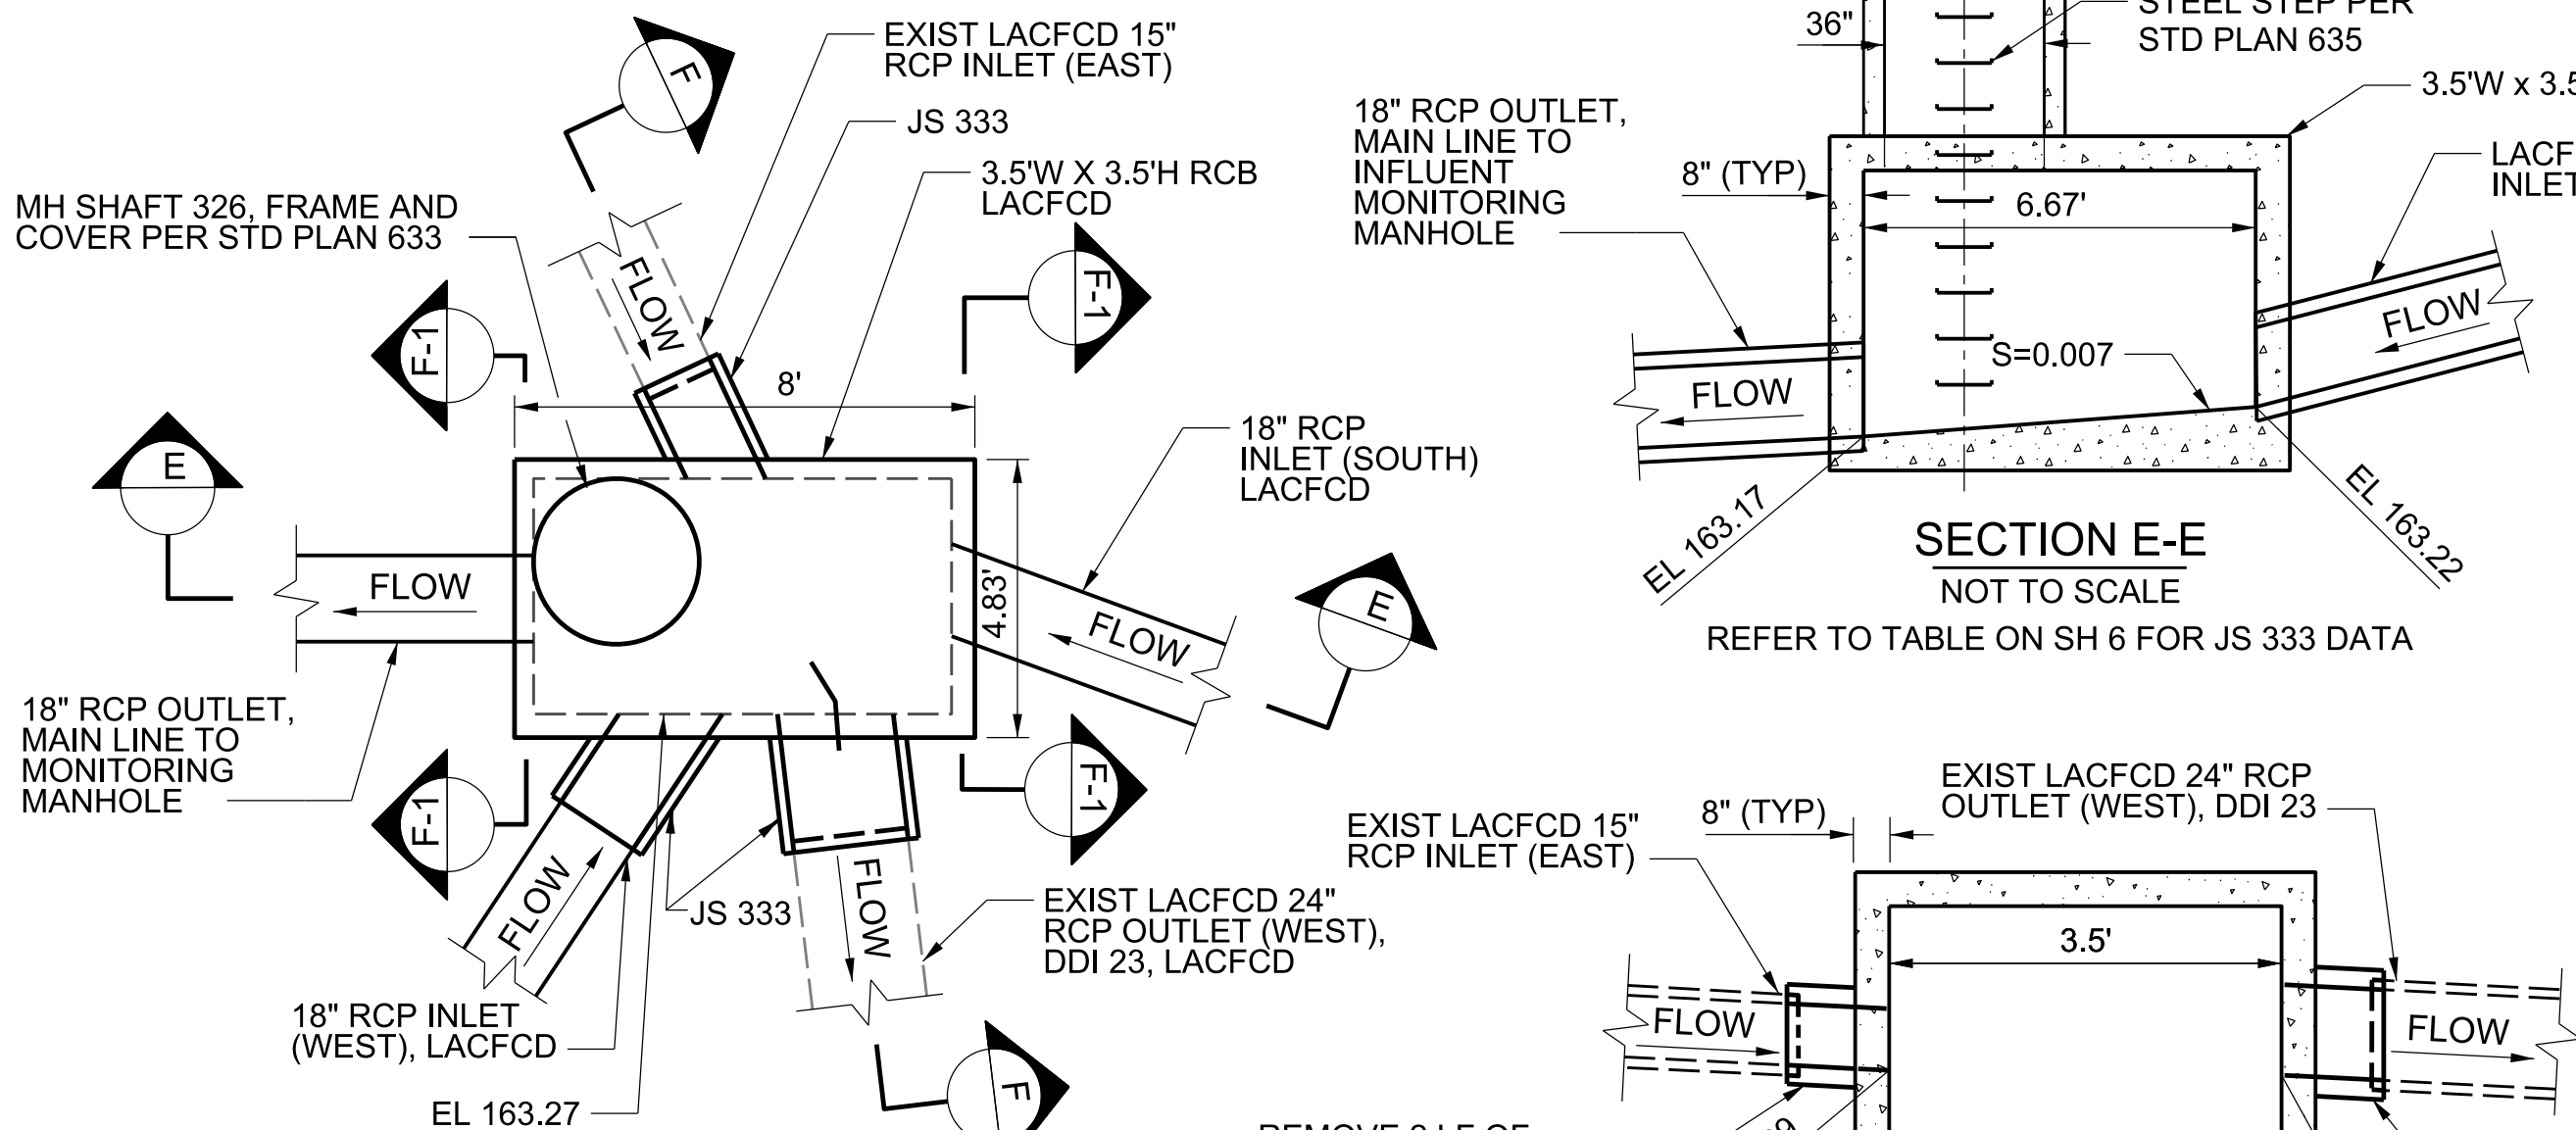


DIVERSION STRUCTURE
DETAIL E (SH 6)
NOT TO SCALE


NOTE: SEE SH 17 FOR STRUCTURAL DETAILS
REFER TO TABLE ON SH 6 FOR JS 333 DATA

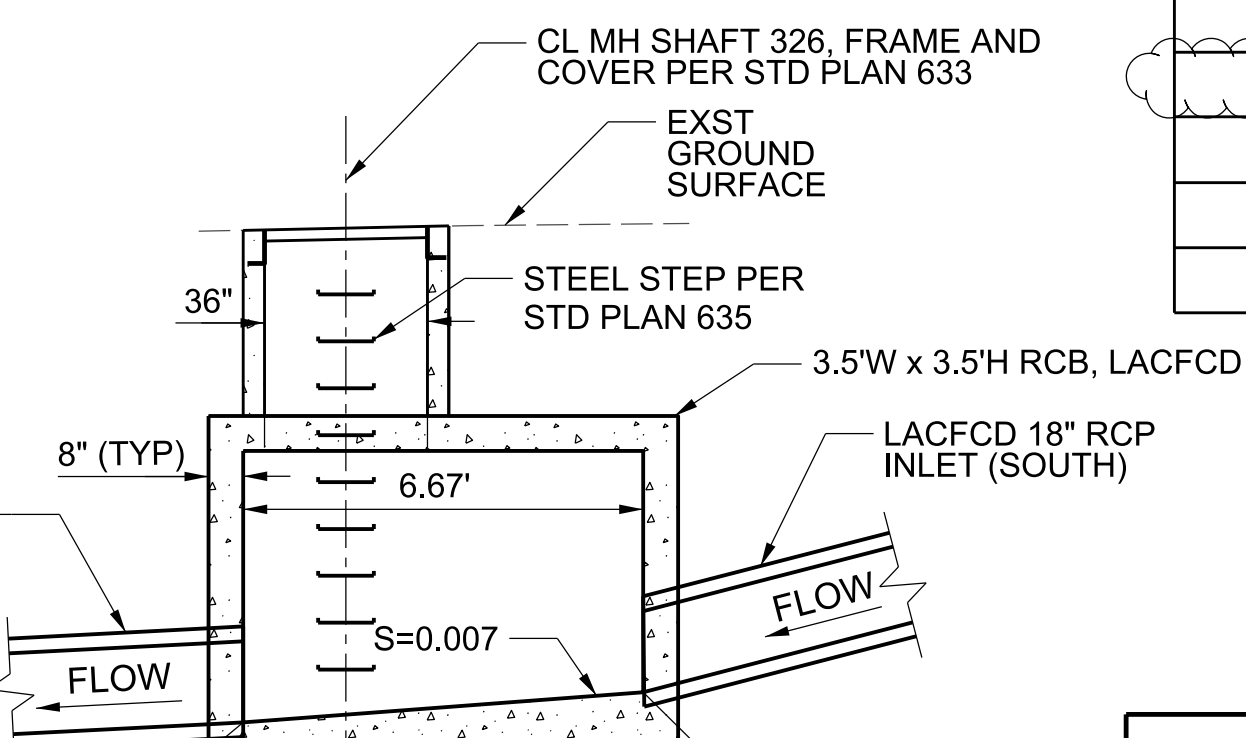

SECTION E-E
NOT TO SCALE
REFER TO TABLE ON SH 6 FOR JS 333 DATA

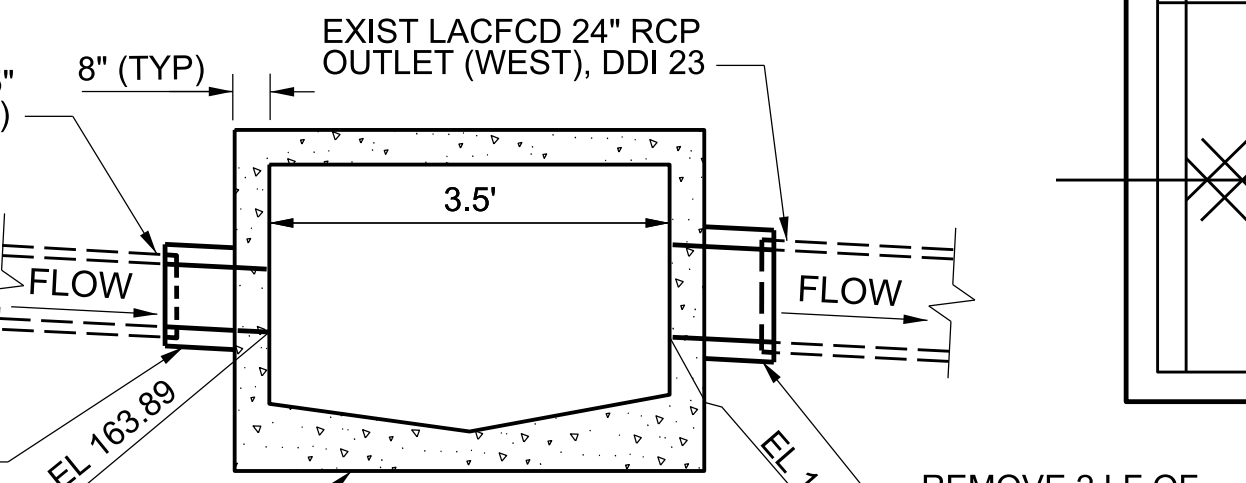

SECTION F-F
NOT TO SCALE
REFER TO TABLE ON SH 6 FOR JS 333 DATA

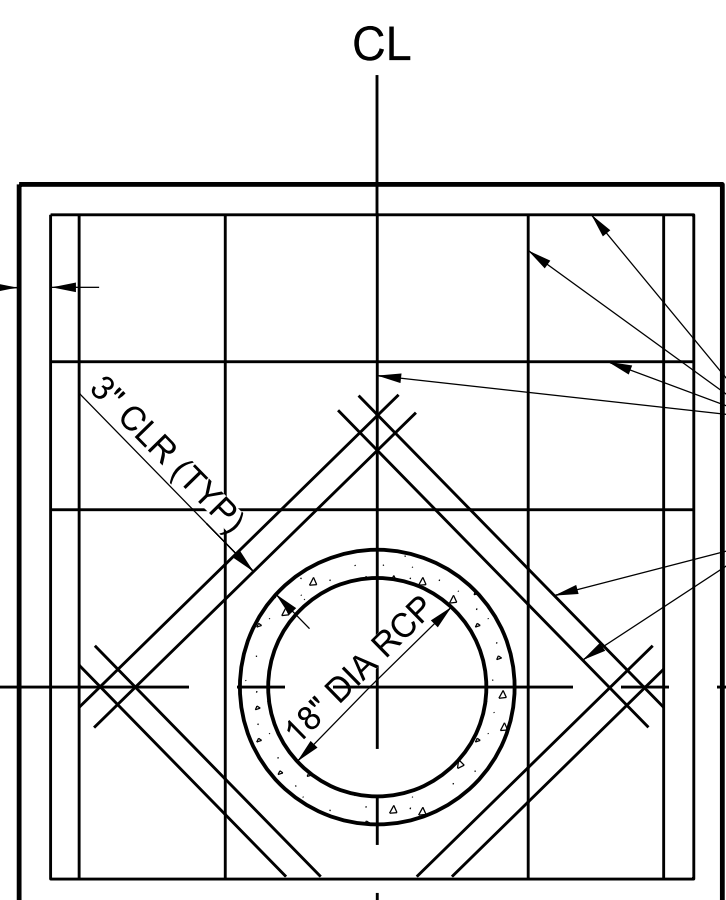


SECTION F1-F1
NOT TO SCALE


DRY WELL	CONNECTOR PIPE			H	D	ELEV T	EL A			L
	NORTHING	EASTING	CASE				EL A	S	L	
C2-B	1,827,432.66	6,520,915.42	3	40'	60'	188.7	176.11	0.01	56'	
C3-B	1,827,445.61	6,520,949.67	2	40'	60'	188.8	176.46	0.01	35'	
C4-B	1,827,372.75	6,520,972.40	2	40'	60'	190.2	176.00	0.01	100'	
C5-B	1,827,403.62	6,521,011.21	2	40'	60'	190.5	176.54	0.01	60'	
C6-B	1,827,357.33	6,521,061.34	2	40'	60'	190.7	176.50	0.01	93'	
C7-B	1,827,383.58	6,521,104.14	3	40'	60'	190.7	177.02	0.01	57'	
C8-B	1,827,357.58	6,521,283.27	3	40'	60'	190.7	178.07	0.01	38'	
C9-B	1,827,333.05	6,521,178.99	2	40'	60'	190.0	177.13	0.01	87'	
C10-B	1,827,351.33	6,521,214.60	1	40'	60'	192.5	177.53	0.01	61'	
C11-B	1,827,328.86	6,521,306.91	2	40'	60'	192.2	177.99	0.01	60'	
C12-B	1,827,286.57	6,521,440.61	2	40'	60'	192.4	178.60	0.01	68'	
C13-B	1,827,295.37	6,521,535.72	3	40'	60'	192.9	179.36	0.01	36'	
C14-B	1,827,284.44	6,521,594.85	2	40'	60'	191.8	179.69	0.01	32'	
C15-B	1,827,241.40	6,521,676.77	2	40'	60'	191.8	179.92	0.01	53'	
C16-B	1,827,232.46	6,521,726.08	2	40'	60'	192.4	180.19	0.01	50'	
C18-B	1,827,220.38	6,521,826.20	2	40'	60'	194.4	180.80	0.01	37'	
C19-B	1,827,203.20	6,521,873.41	3	40'	60'	194.0	180.99	0.01	42'	
C20-B	1,827,198.31	6,521,939.25	2	40'	60'	194.7	181.42	0.01	30'	
D2-B	1,826,138.53	6,520,731.31	1	40'	60'	181.8	171.52	0.01	64'	
D3-B	1,826,152.32	6,520,767.34	2	40'	60'	181.3	171.87	0.01	44'	
D4-B	1,826,163.70	6,520,799.89	3	40'	60'	182.7	172.18	0.01	27'	
D5-B	1,826,111.31	6,520,831.05	2	40'	60'	182.2	171.91	0.01	73'	
D6-B	1,826,118.14	6,520,883.11	3	40'	60'	183.1	172.31	0.01	57'	
D7-B	1,826,122.64	6,520,914.41	1	40'	60'	185.2	172.55	0.01	47'	
D8-B	1,826,138.93	6,520,947.85	3	40'	60'	184.0	172.91	0.01	25'	
D9-B	1,826,089.22	6,521,033.35	2	40'	60'	183.4	173.03	0.01	58'	
D10-B	1,826,092.12	6,521,167.01	3	40'	60'	185.5	173.93	0.01	32'	
D11-B	1,826,070.45	6,521,224.97	2	40'	60'	186.0	173.88	0.01	69'	
D12-B	1,826,101.08	6,521,291.50	3	40'	60'	186.4	174.59	0.01	27'	
D13-B	1,826,060.33	6,521,314.60	2	40'	60'	186.4	174.37	0.01	63'	
D14-B	1,826,075.89	6,521,363.20	2	40'	60'	185.7	174.82	0.01	39'	
D15-B	1,826,074.07	6,521,423.80	2	40'	60'	186.1	175.20	0.01	30'	
D16-B	1,826,065.86	6,521,457.88	2	40'	60'	186.2	175.34	0.01	32'	
D17-B	1,826,034.69	6,521,523.38	2	40'	60'	186.2	175.48	0.01	52'	
D18-B	1,826,026.47	6,521,643.84	2	40'	60'	188.4	176.25	0.01	39'	
D19-B	1,826,020.32	6,521,703.70	2	40'	60'	188.7	176.55	0.01	33'	
D20-B	1,826,008.64	6,521,762.56	3	40'	60'	188.5	178.83	0.01	34'	

TABLE 9 (SH 7 - 10)
DRY WELLS AND LATERAL
CONNECTOR PIPES, LINES C-1 AND D-1
ELEV "T" = FS FOR THE TOP OF THE DRY WELL COVER

SEE UPDATED
ELEV T VALUES ON
TABLE 9.1 (SH 26)

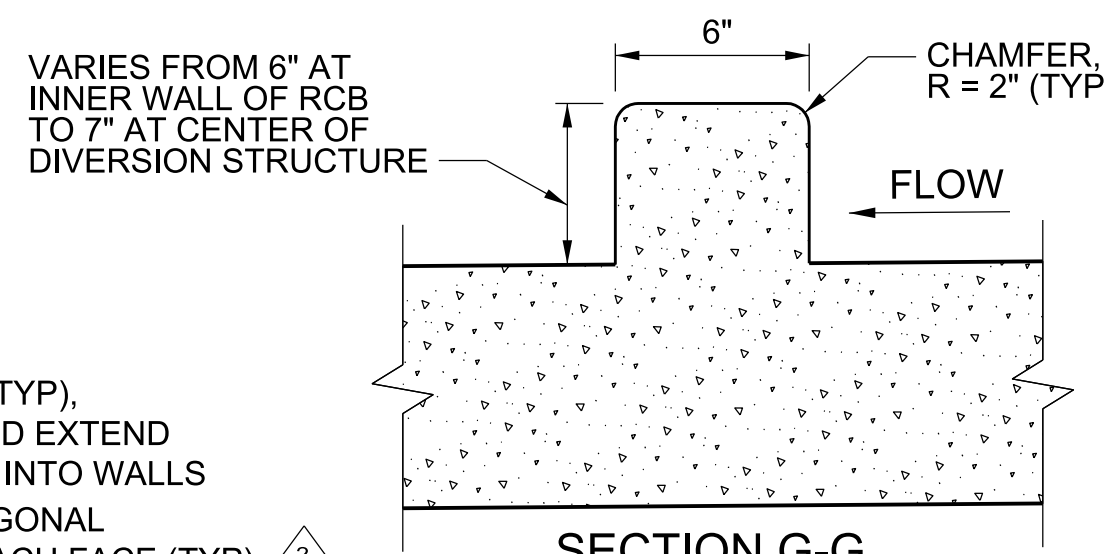


SECTION G-G
CONCRETE BERM
NOT TO SCALE

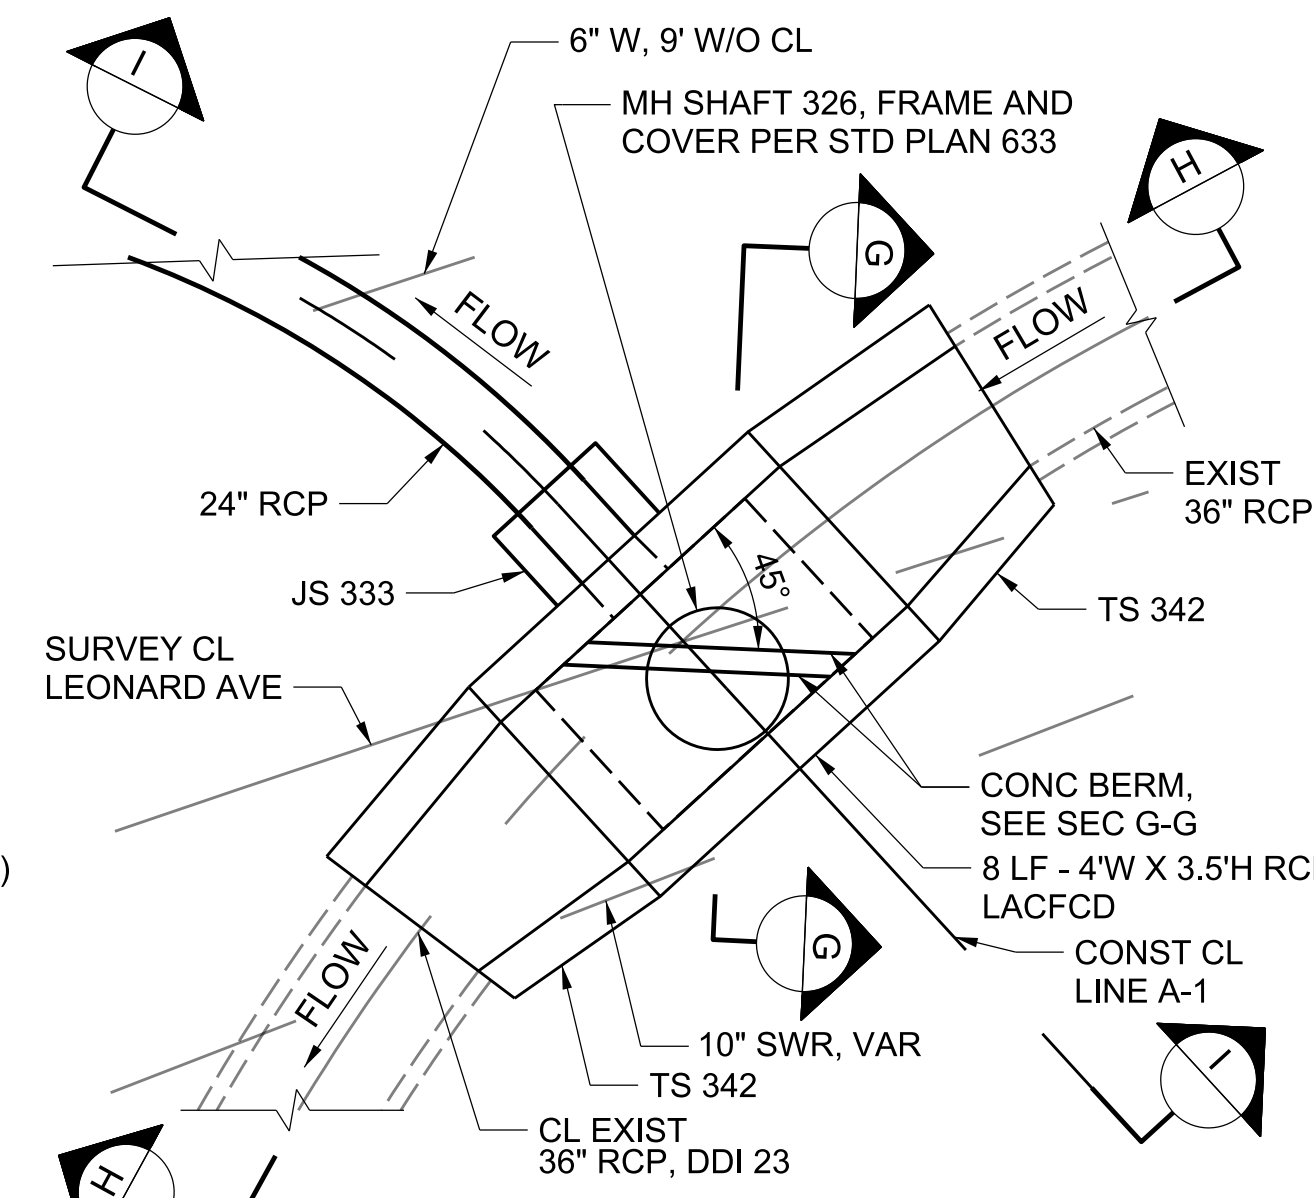


DETAIL F (SH 4)
DIVERSION STRUCTURE
NOT TO SCALE

NOTE: SEE SH 17 FOR STRUCTURAL DETAILS
REFER TO TABLE ON SH 4 FOR JS 333 DATA

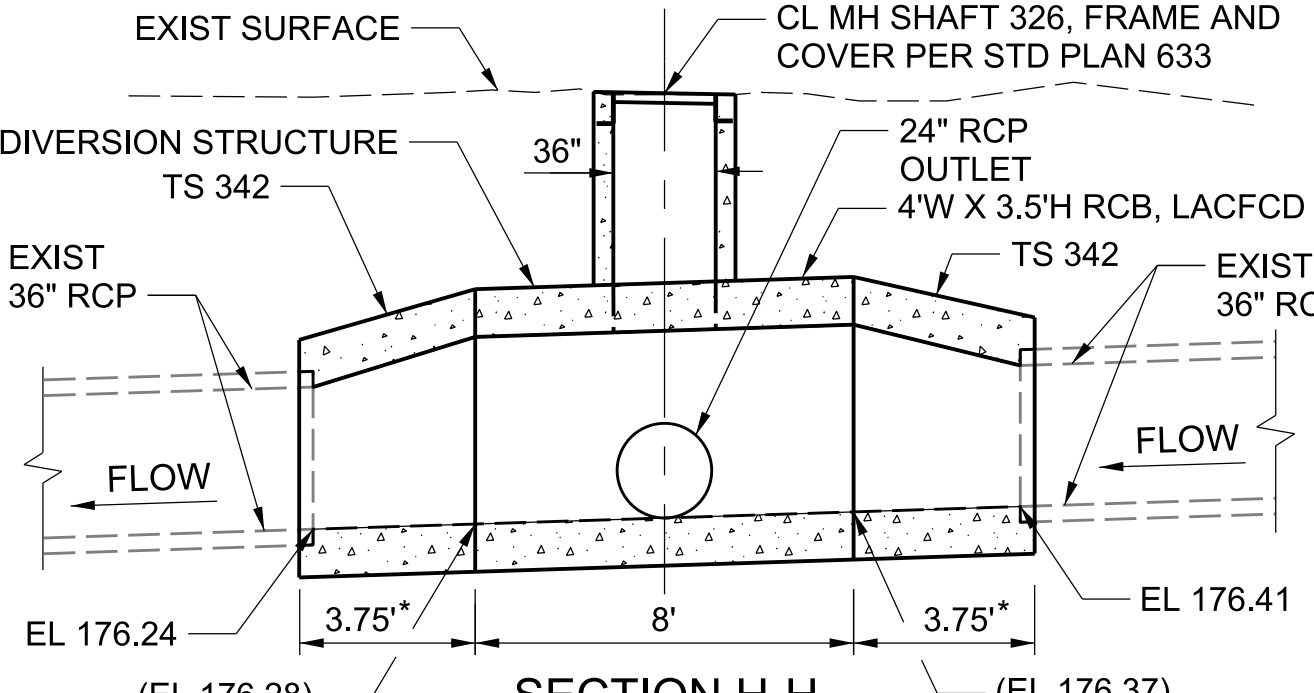

SECTION H-H
DIVERSION STRUCTURE
NOT TO SCALE


* DIMENSION TO BE VERIFIED AND/OR ADJUSTED
BASED UPON PROXIMITY OF EXISTING PIPE JOINTS.

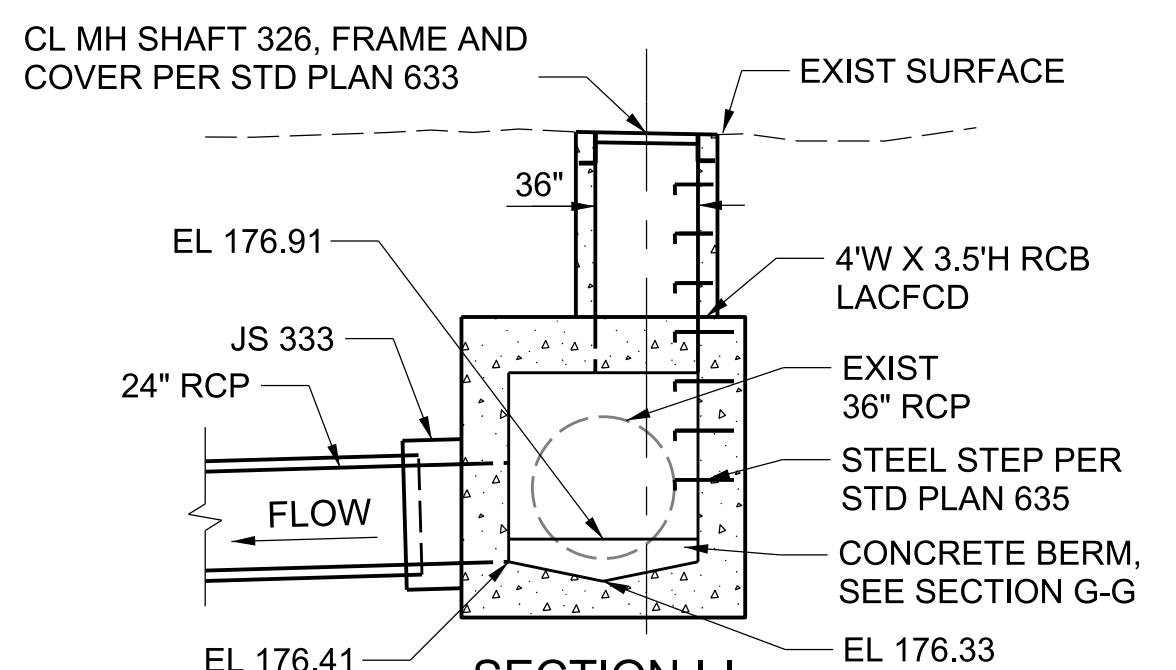




SECTION I-I
DIVERSION STRUCTURE
NOT TO SCALE

REFER TO TABLE ON SH 4 FOR JS 333 DATA

DATE	REVISIONS
04/28/22	AS BUILT REVISIONS
11/19/20	TABLE UPDATED.
10/27/20	UPDATED STRUCTURAL DETAILS.
08/24/20	DIVERSION BERM DETAILS REVISED.

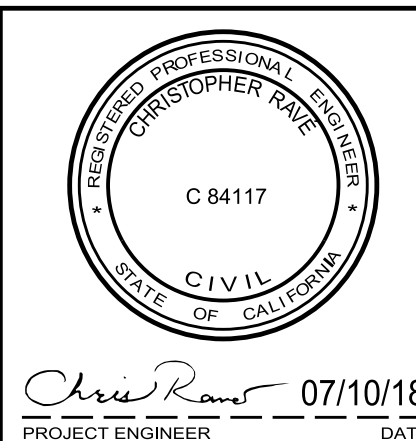

LOS ANGELES COUNTY PUBLIC WORKS			
EAST LOS ANGELES SUSTAINABLE MEDIAN STORMWATER CAPTURE PROJECT CONSTRUCTION DETAILS AND DRY WELL TABLE			
PROJECT ID NO. WMU0000010			
LACFCD INDEX NO. 116-D27	PD053092	SHEET 13	OF 26-27

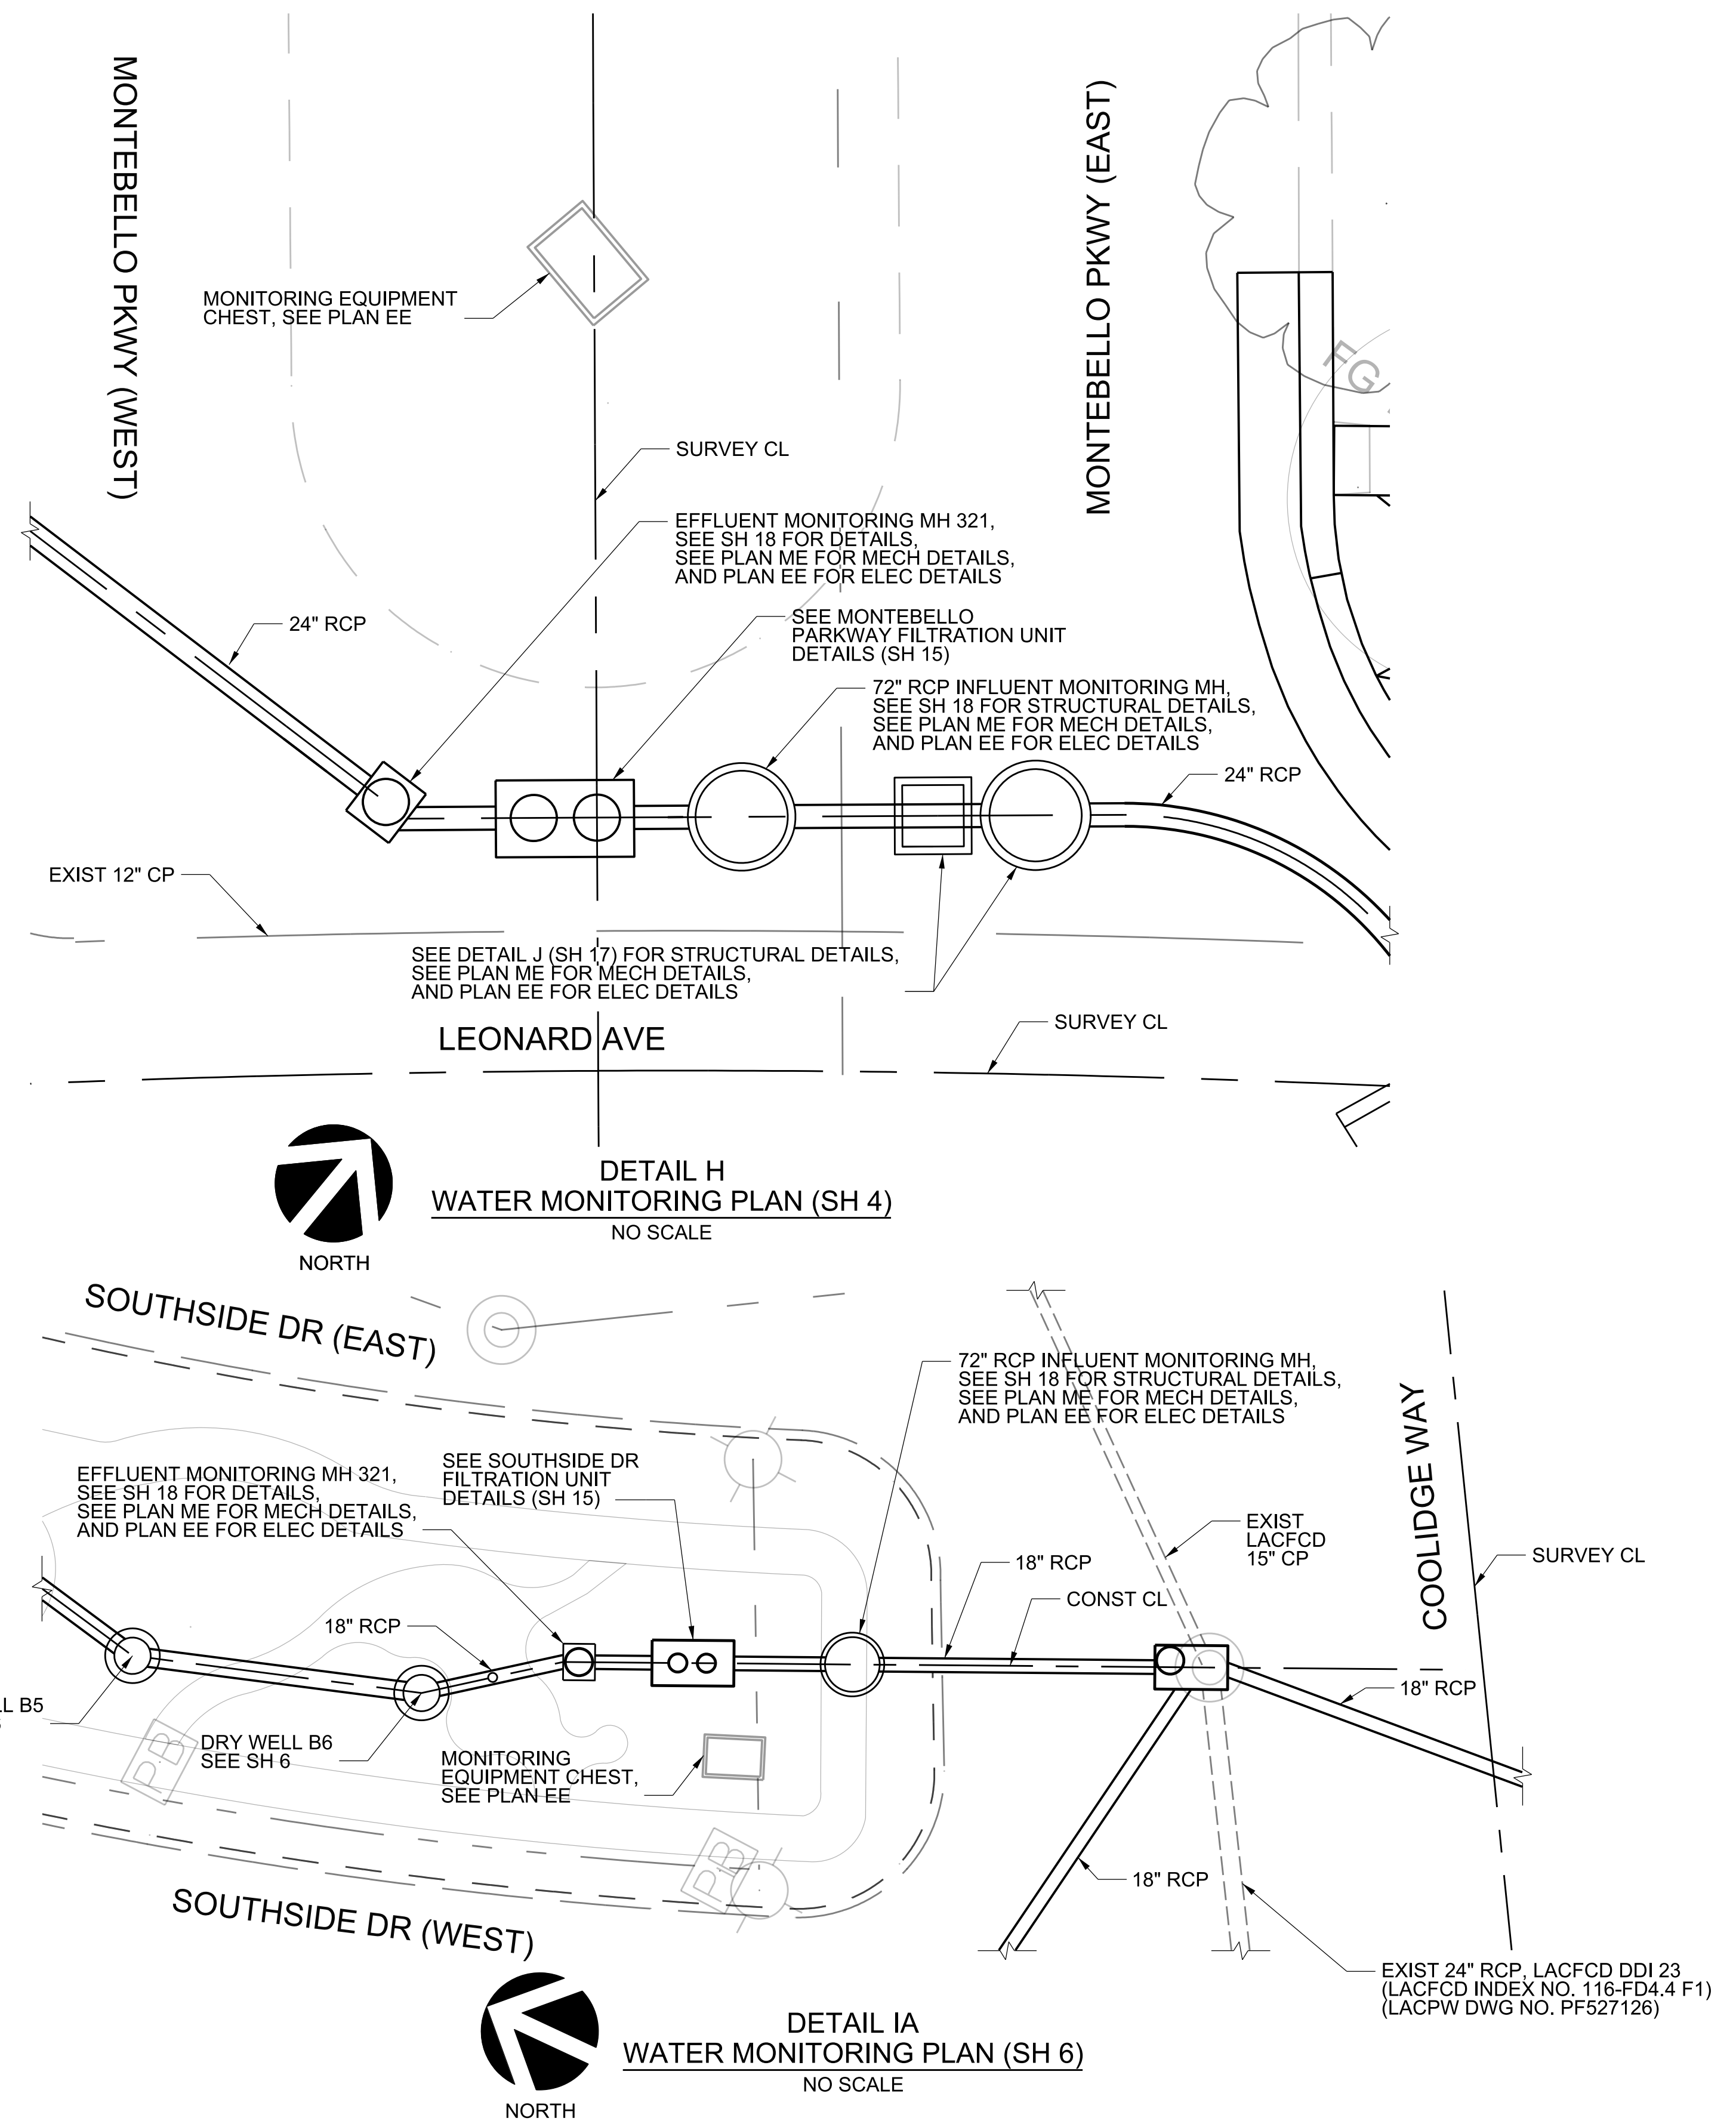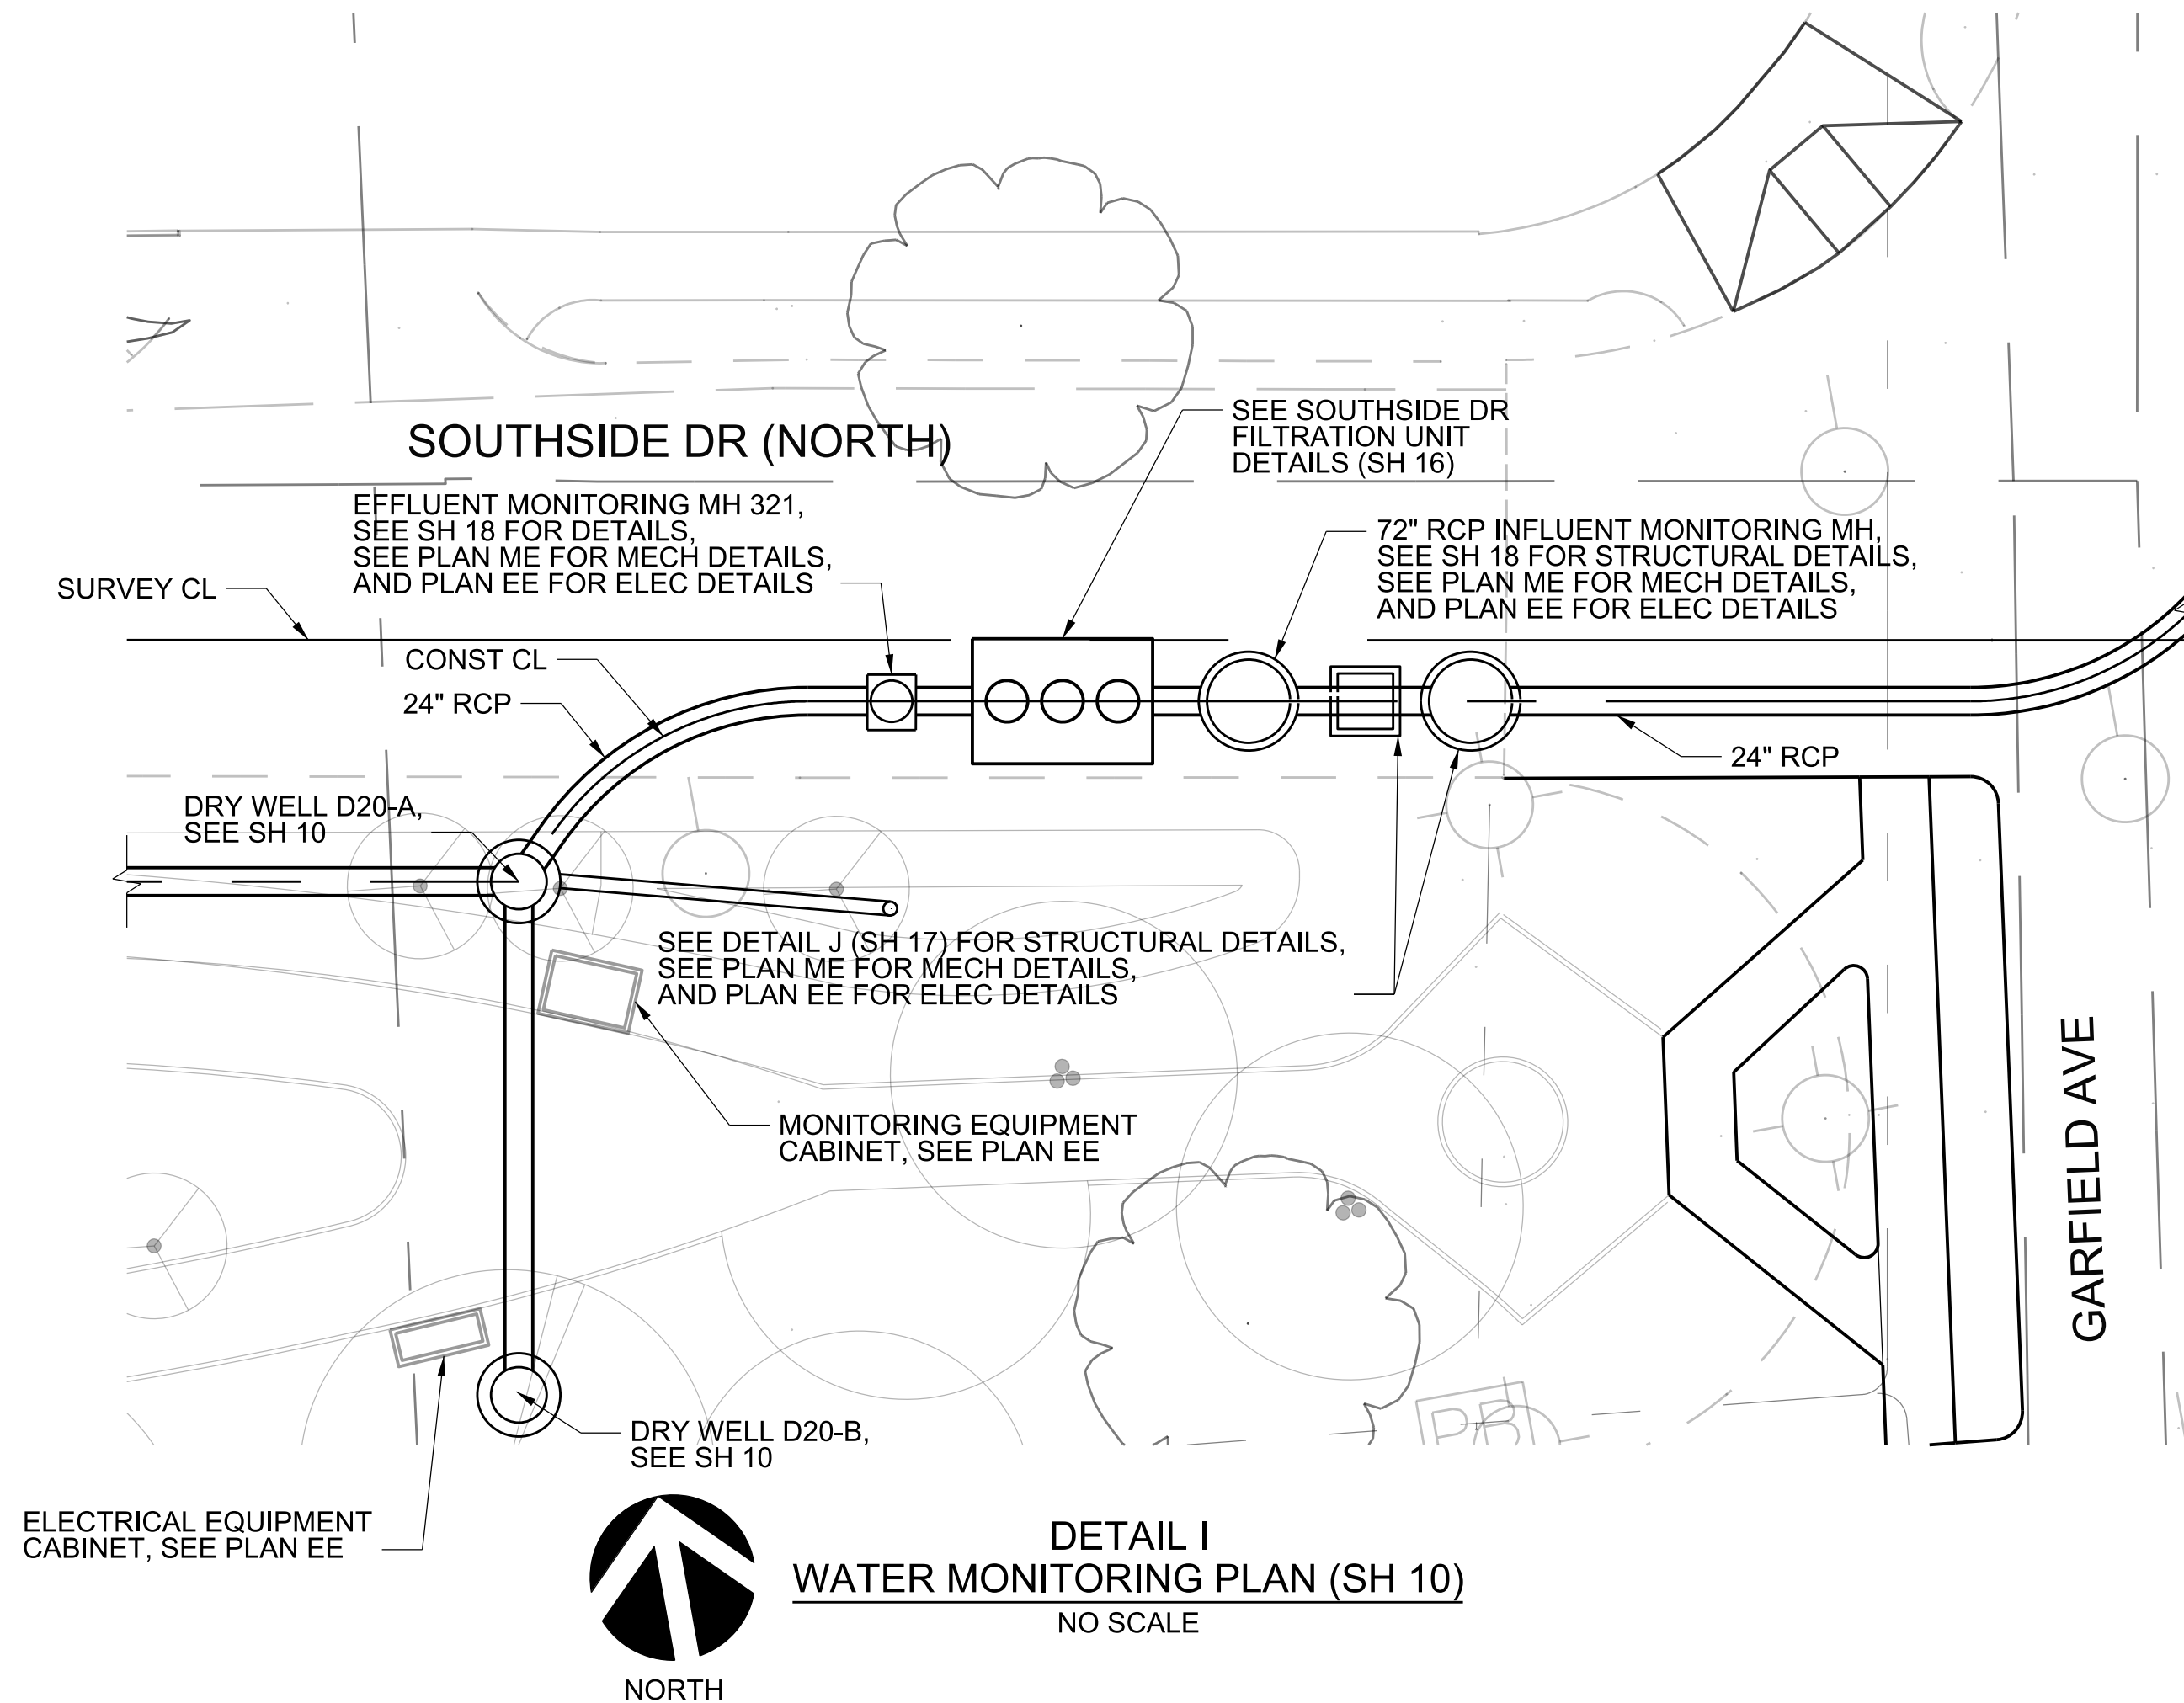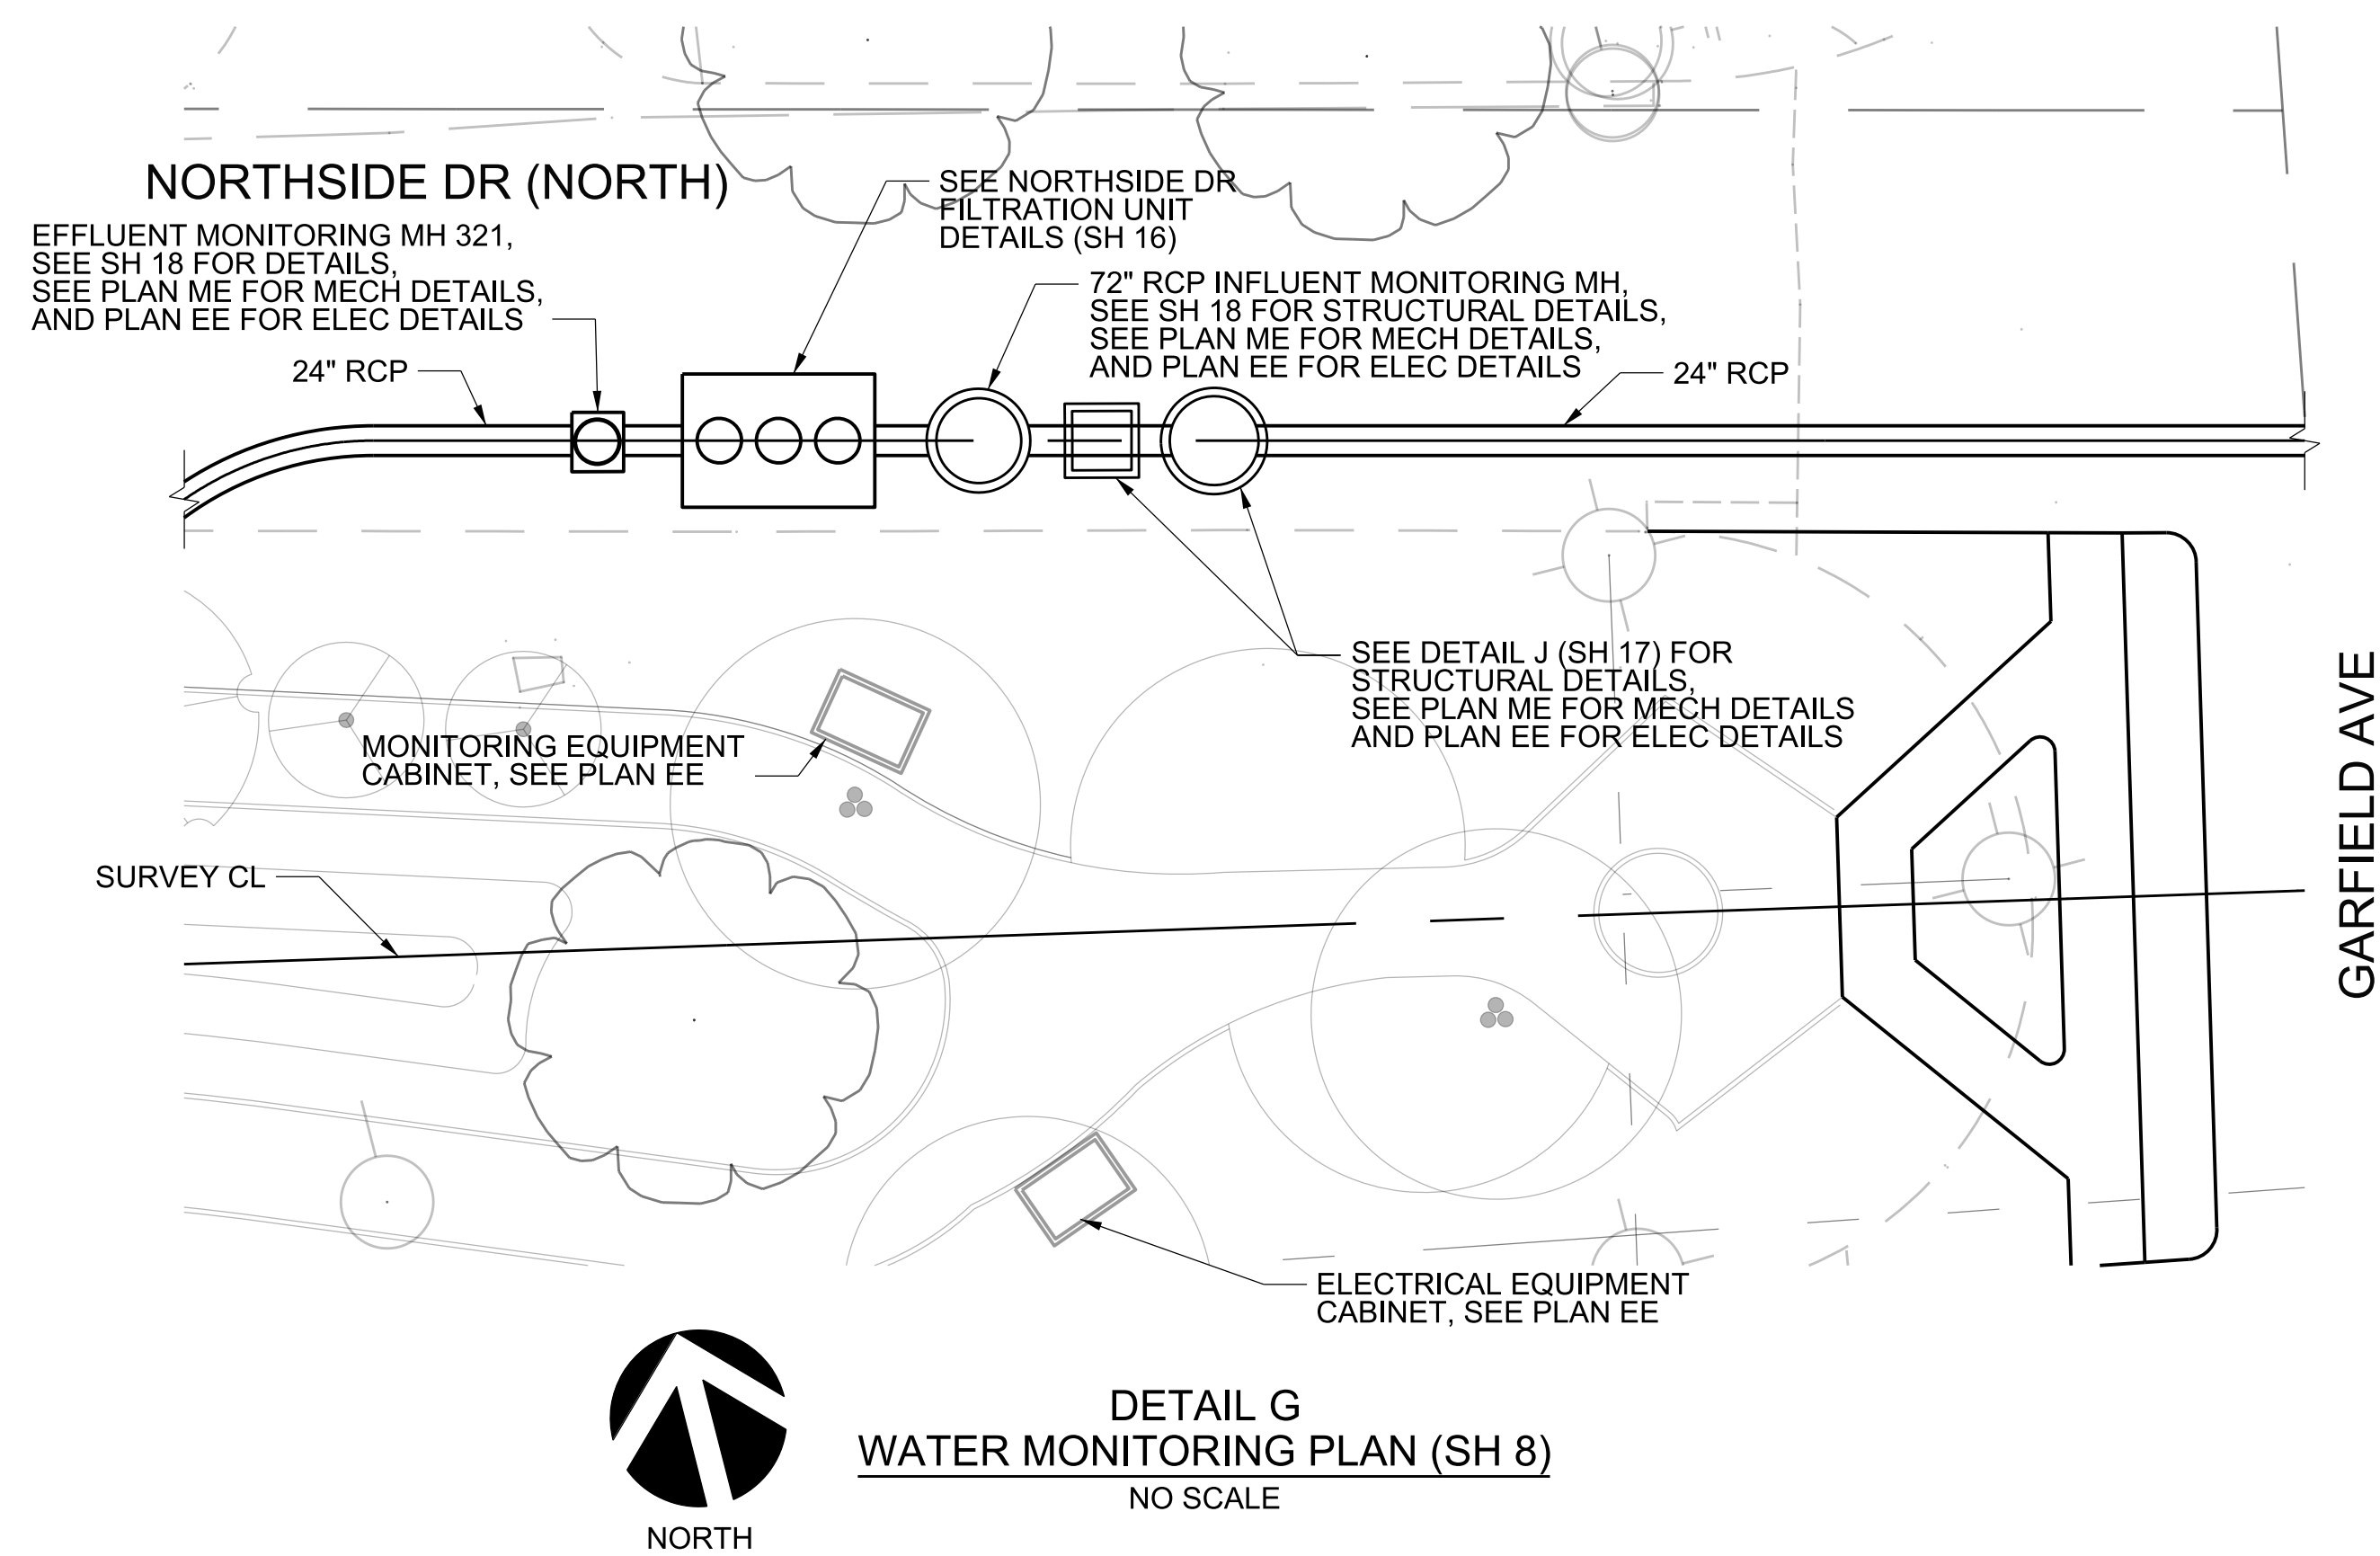

CADD PROJECT FILE NAME
EAST LA MEDIANS.DGN

CHECKER
D. RADLE

DESIGNER
C. RAVE

DRAFTER
S. LU / L. CHAVEZ

DATE	MK	DESCRIPTION
04/28/22	AS BUILT REVISIONS	
REVISIONS		



Chris Rave 07/10/18
PROJECT ENGINEER DATE

LOS ANGELES COUNTY PUBLIC WORKS

EAST LOS ANGELES
SUSTAINABLE MEDIAN
STORMWATER CAPTURE PROJECT

WATER MONITORING PLAN


PROJECT ID NO. WMU0000010

LACFCD INDEX NO. 116-D27 PD053092 SHEET 14 OF 26-27

AS BUILT DRAWINGS



PLAN DR

SEE SHEET 27 FOR UPDATED FILTRATION UNIT DETAILS

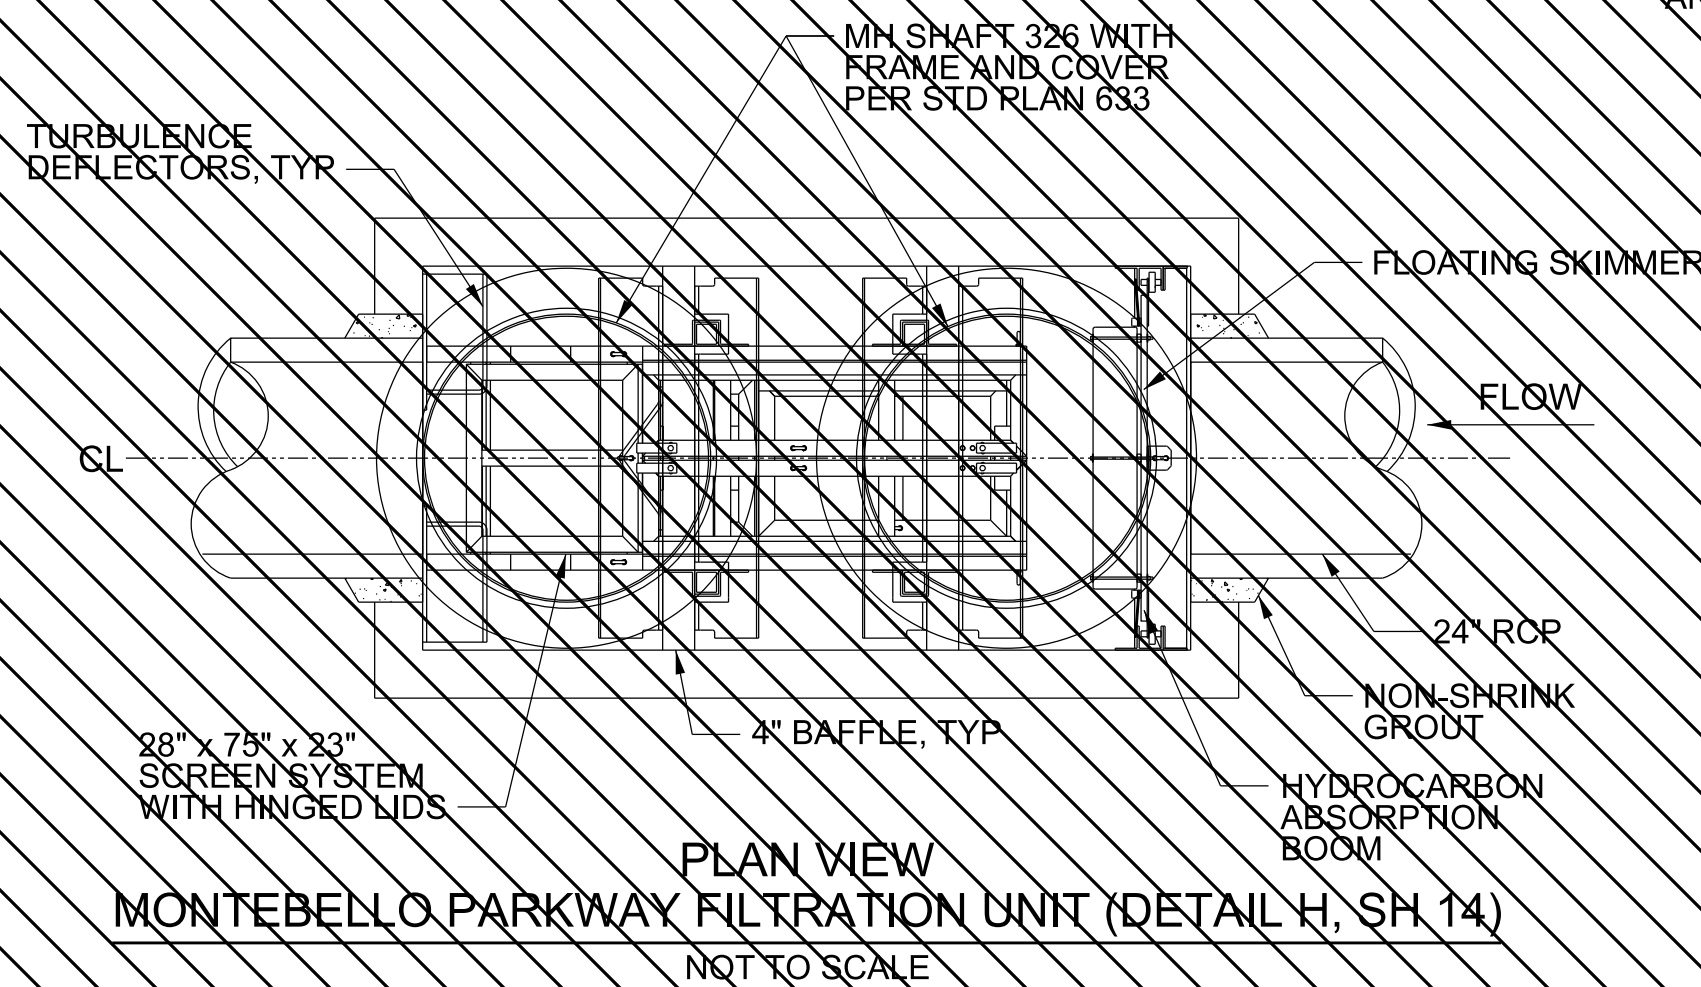

TREATMENT SPECIFICATIONS

- | | |
|---|----------|
| 1. INFLOW PIPE AREA (DRAWN AS 24\" RCP) | 3.14 SF |
| 2. PEAK TREATMENT FLOW | 16.0 CFS |
| 3. SCREEN SYSTEM STORAGE VOLUME (MIN) | 28.0 CF |
| 4. TOTAL SEDIMENT VOLUME (MIN) | 88.0 CF |

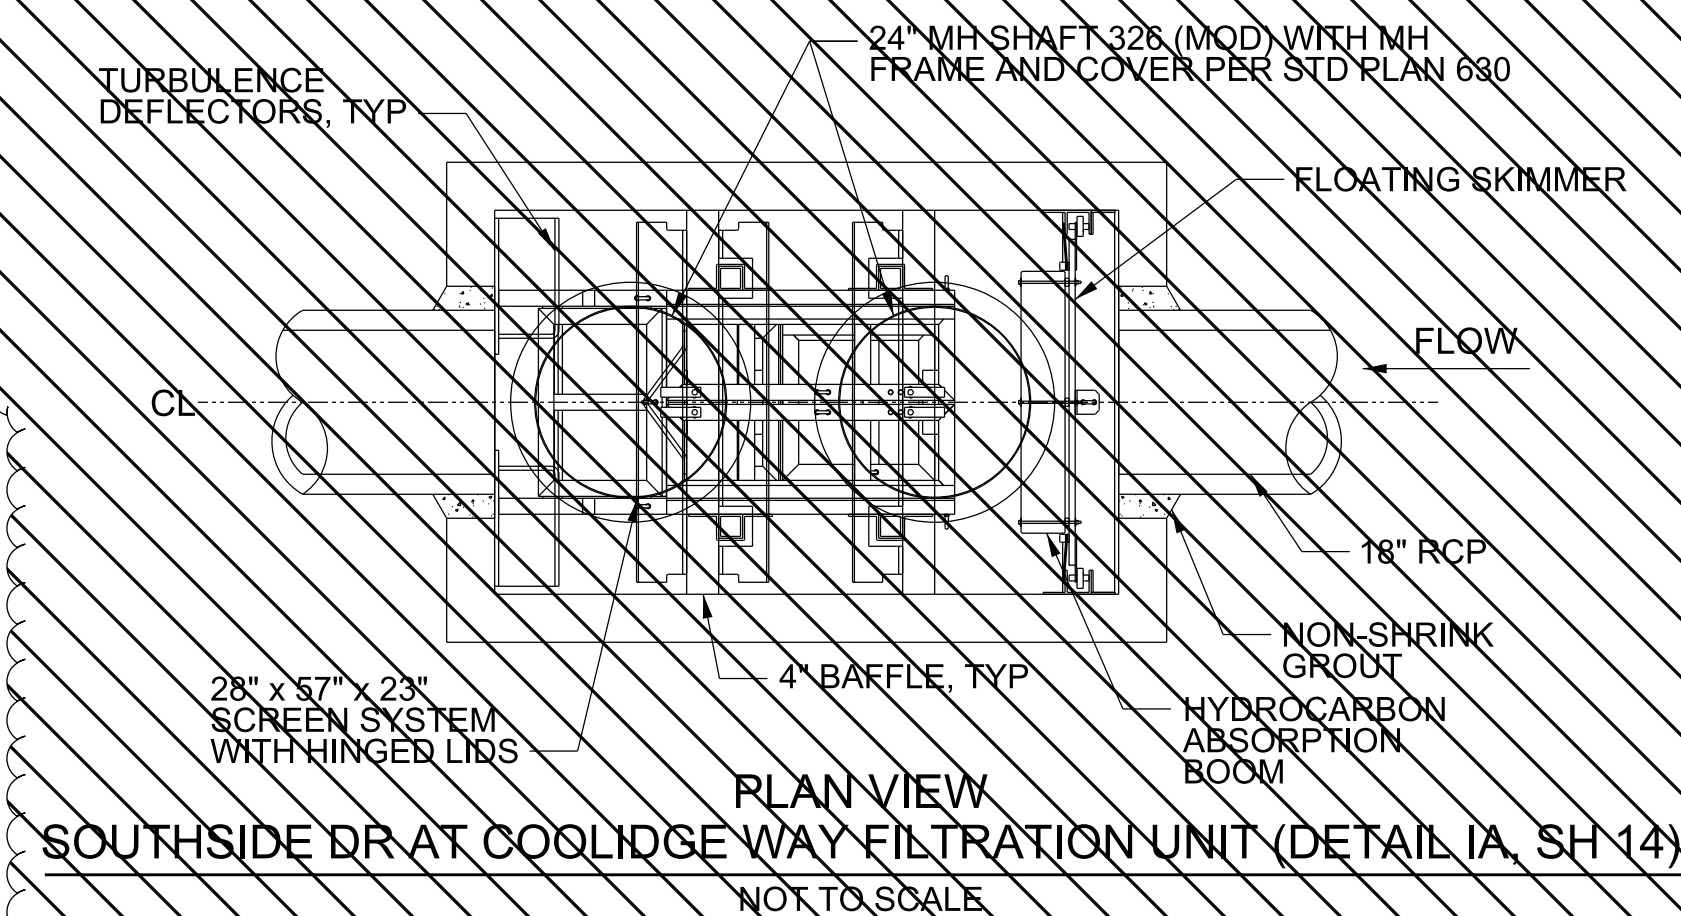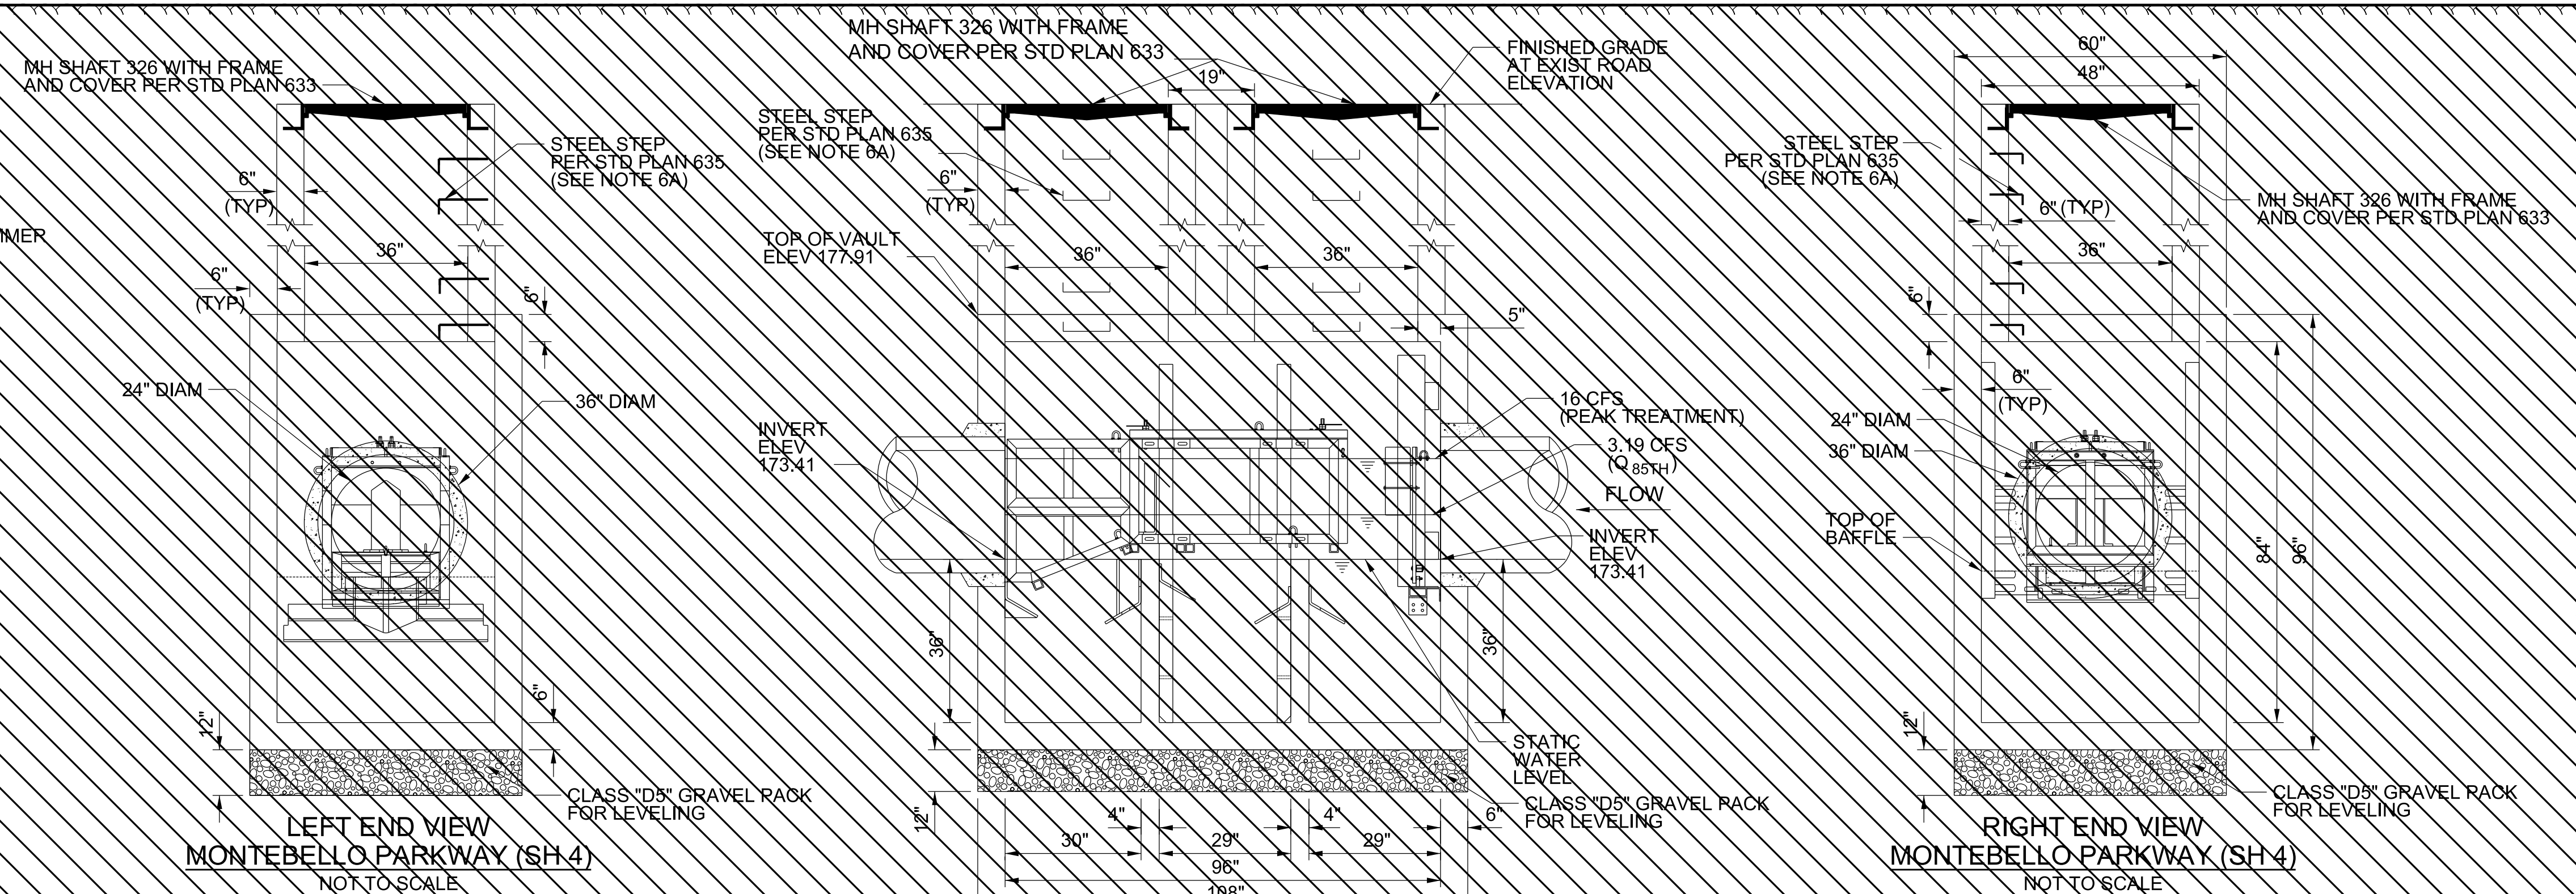


TREATMENT SPECIFICATIONS

- | | |
|---|----------|
| 1. INFLOW PIPE AREA (DRAWN AS 18\" RCP) | 1.77 SF |
| 2. PEAK TREATMENT FLOW | 7.40 CFS |
| 3. SCREEN SYSTEM STORAGE VOLUME (MIN) | 21.2 CF |
| 4. TOTAL SEDIMENT VOLUME (MIN) | 70.0 CF |

CONSTRUCTION NOTES

1. CONCRETE 28-DAYS COMPRESSIVE STRENGTH, $f'_c = 5,000$ PSI
2. REINFORCING: ASTM A-615 GRADE 60
3. SUPPORTS AN H2O4 LOADING AS INDICATED BY AASHTO
4. JOINT SEALANT: BUTYL RUBBER SS-S-00210
5. ALL WALLS (TOP, BOTTOM, EXTERIOR SIDE) TO BE 6\" THICK CONCRETE.

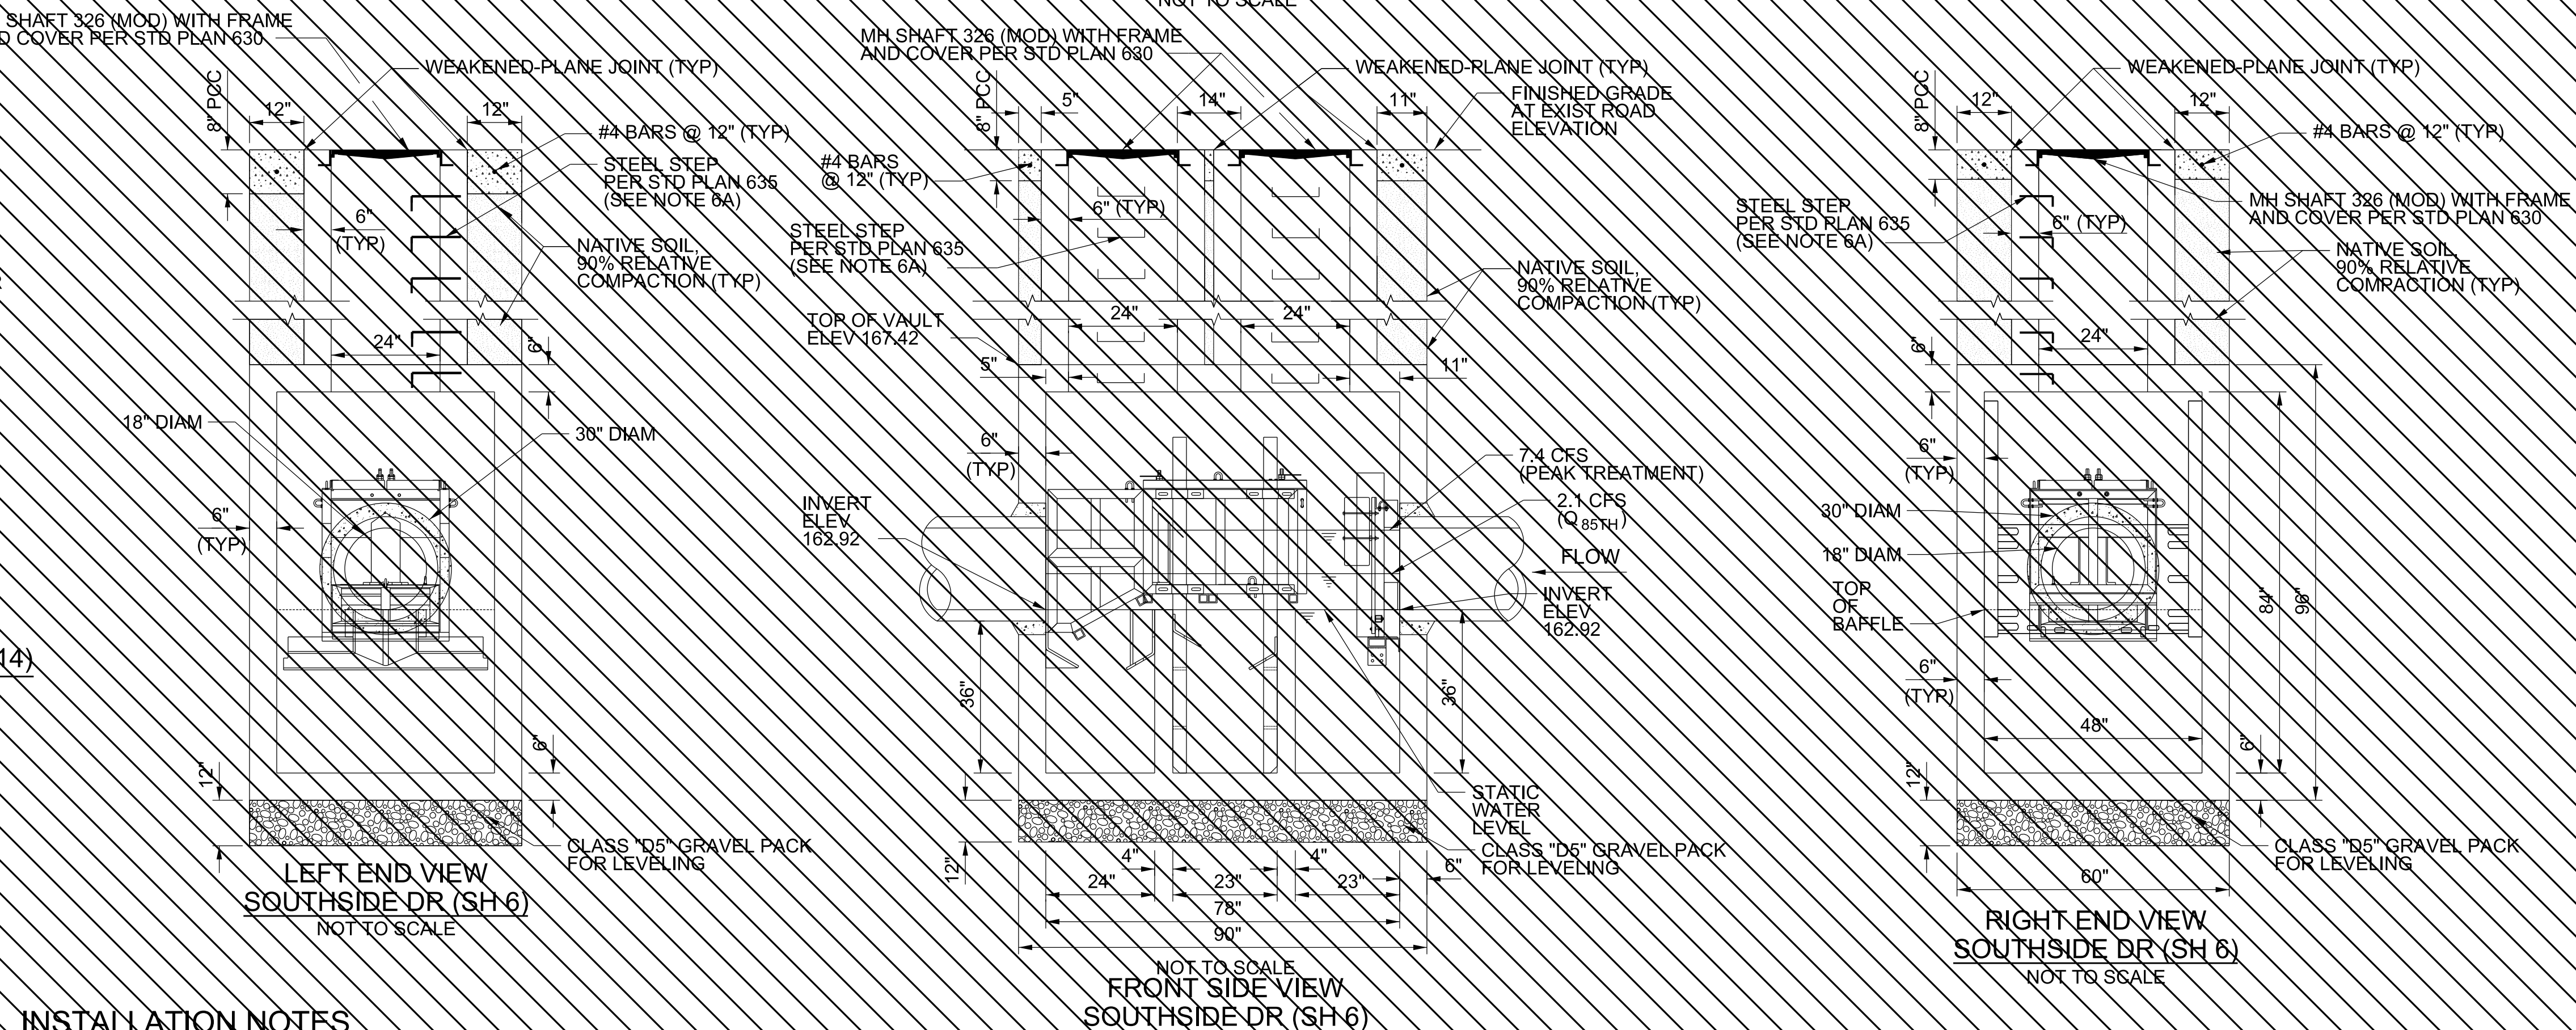

INSTALLATION NOTES

- 1A. INFLOW AND OUTFLOW PIPES ARE TO BE FLUSH WITH THE INSIDE SURFACE OF THE CONCRETE STRUCTURE. CANNOT INTRUDE BEYOND FLUSH.
- 2A. BAFFLES WILL BE SEALED TO THE WALLS AND FLOOR WITH GROUT.
- 3A. INVERT OF OUTFLOW PIPE SHALL BE EVEN WITH THE TOP OF THE BAFFLES.
- 4A. THE BOTTOM OF THE SKIMMER SHALL BE 8\" BELOW THE INVERT OF THE OUTFLOW PIPE.
- 5A. INVERT OF THE INFLOW PIPE SHALL NOT BE BELOW THE INVERT OF THE OUTFLOW PIPE.
- 6A. THE ENGINEER SHALL DETERMINE THE SIDE OF THE MANHOLE SHAFT WHERE STEPS SHALL BE INSTALLED.

CADD PROJECT FILE NAME
EAST LA MEDIANS.DGN

CHECKER
D. RADLE

DESIGNER
C. RAVE

DRAWN
S. LU / L. CHAVEZ

04/28/22		AS BUILT REVISIONS
DATE	MK	DESCRIPTION
REVISIONS		
PROJECT ENGINEER		DATE




LOS ANGELES COUNTY PUBLIC WORKS		
EAST LOS ANGELES SUSTAINABLE MEDIAN STORMWATER CAPTURE PROJECT		
FILTRATION UNIT DETAILS		
PROJECT ID NO. WMU0000010		
LACFD INDEX NO. 116-D27	PD053092	SHEET 15 OF 26-27

AS BUILT DRAWINGS

PLAN DR


SEE SHEET 27 FOR UPDATED FILTRATION UNIT DETAILS

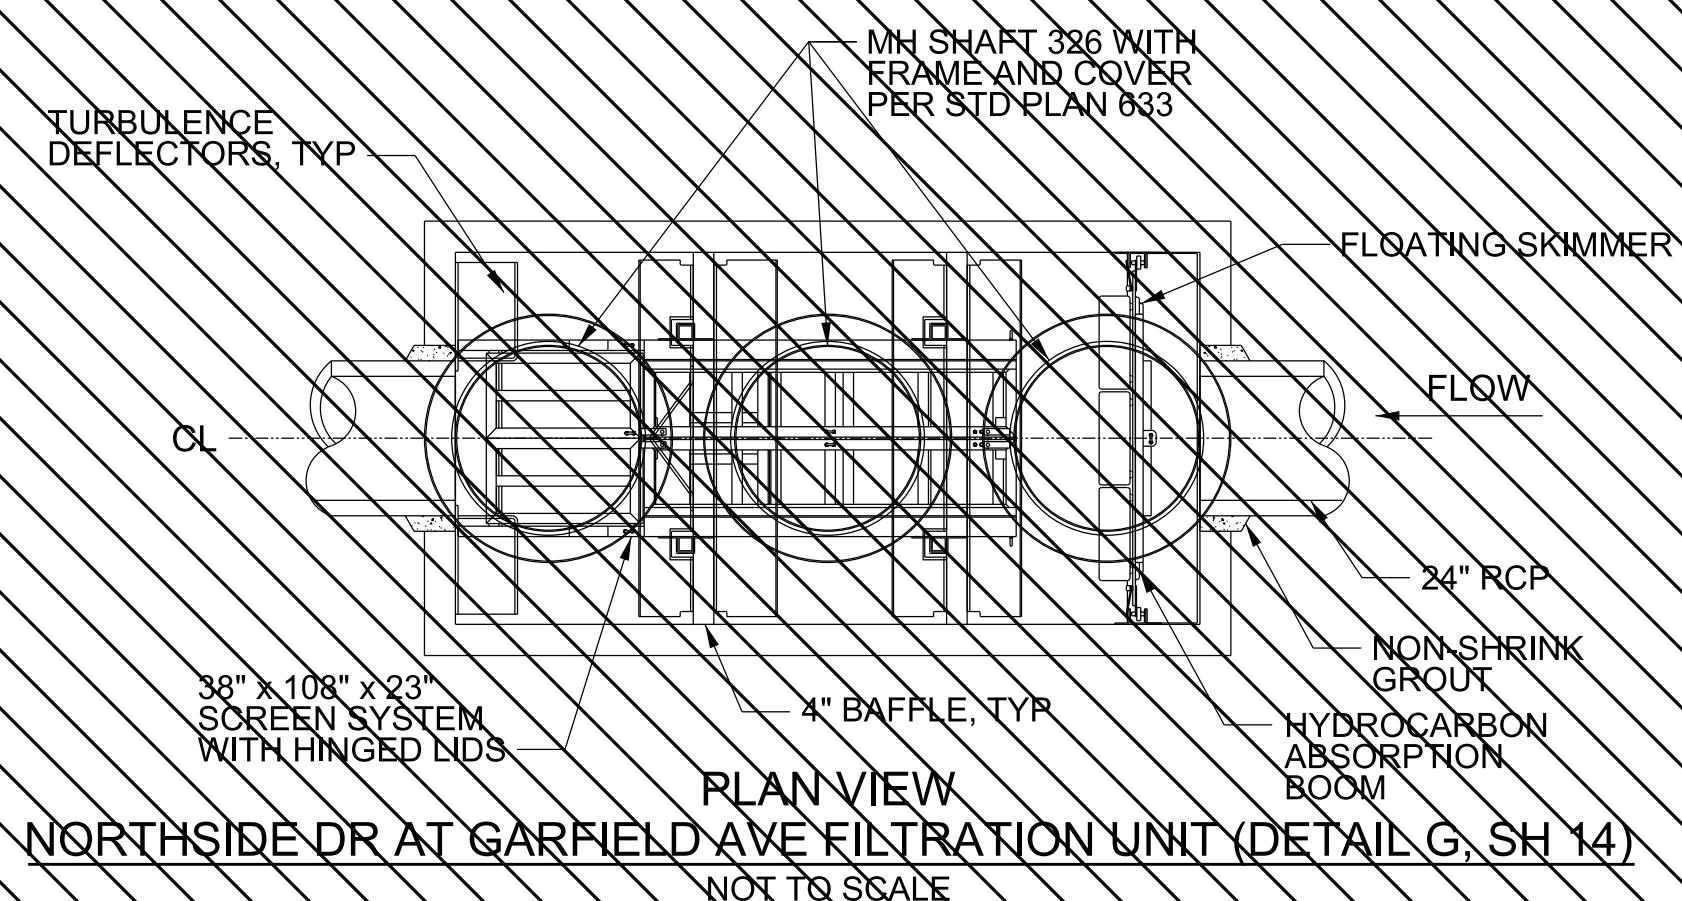


TREATMENT SPECIFICATIONS

1. INFLOW PIPE AREA (DRAWN AS 24" RCP) 3.14 SF
2. PEAK TREATMENT FLOW 16.0 CFS
3. SCREEN SYSTEM STORAGE VOLUME (MIN) 54.6 CF
4. TOTAL SEDIMENT VOLUME (MIN) 329 CF


MH SHAFT 326 WITH FRAME AND COVER PER STD PLAN 633

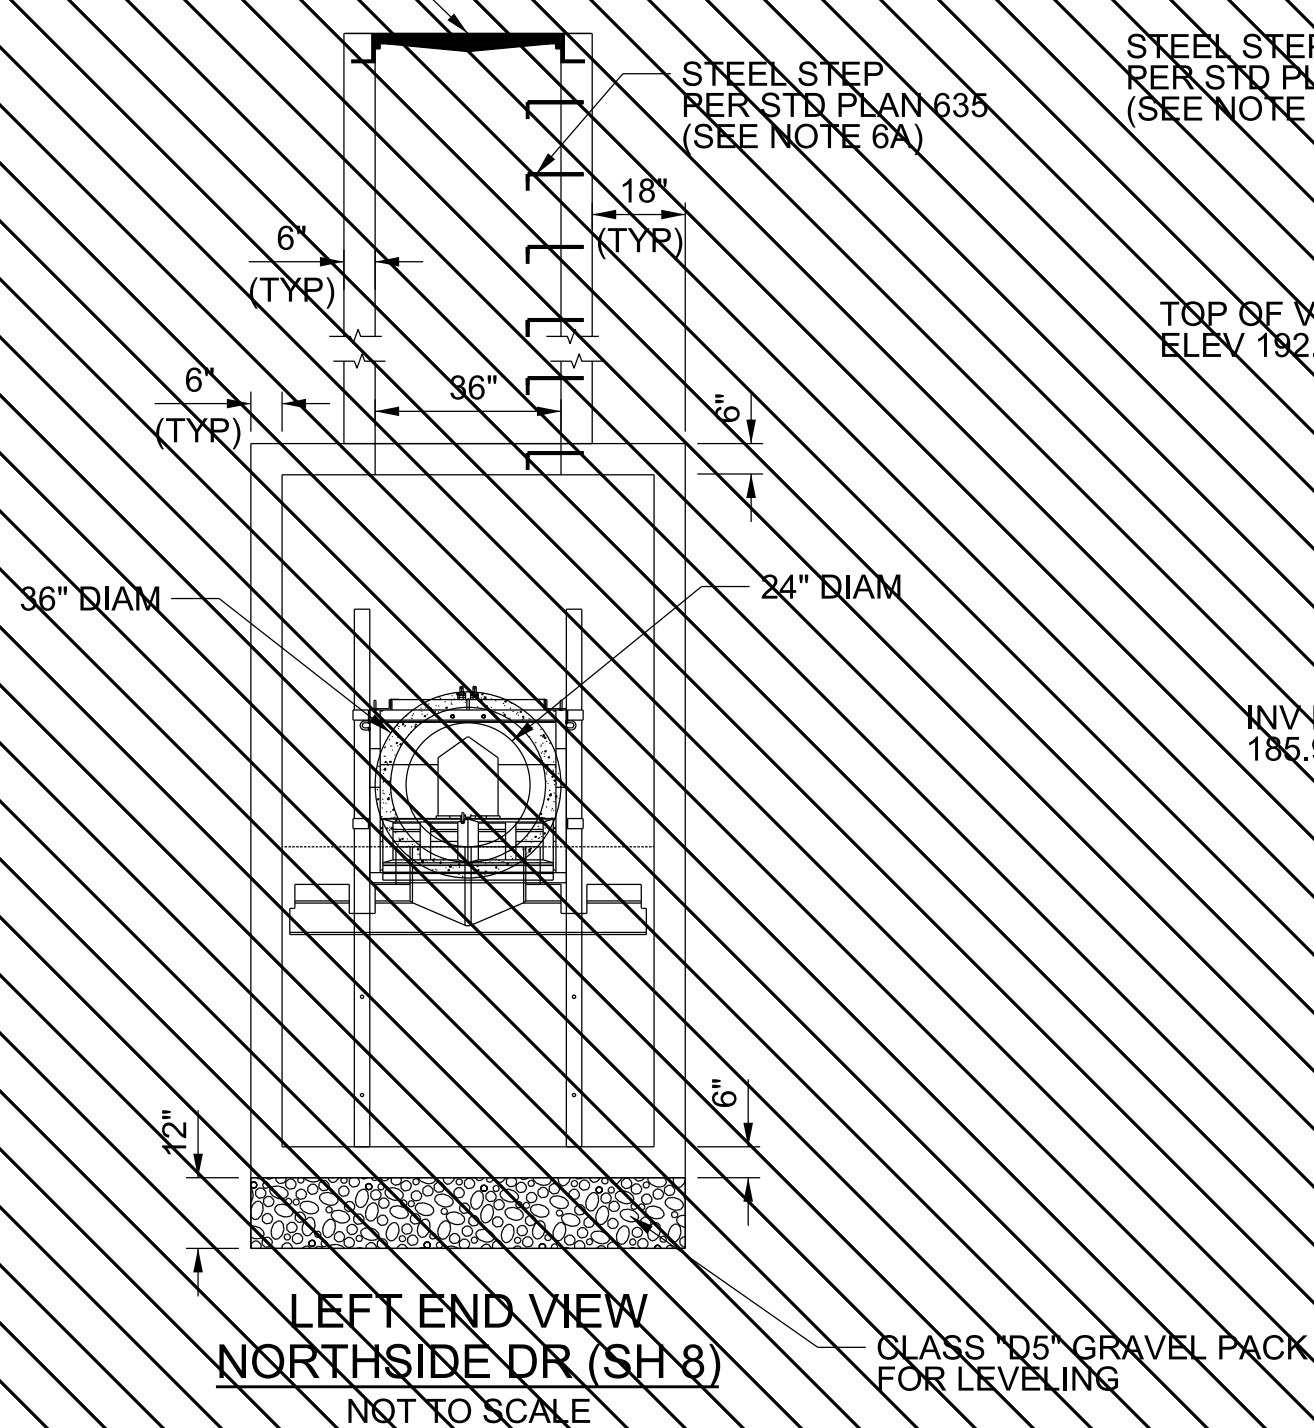


MH SHAFT 326 WITH FRAME AND COVER PER STD PLAN 633

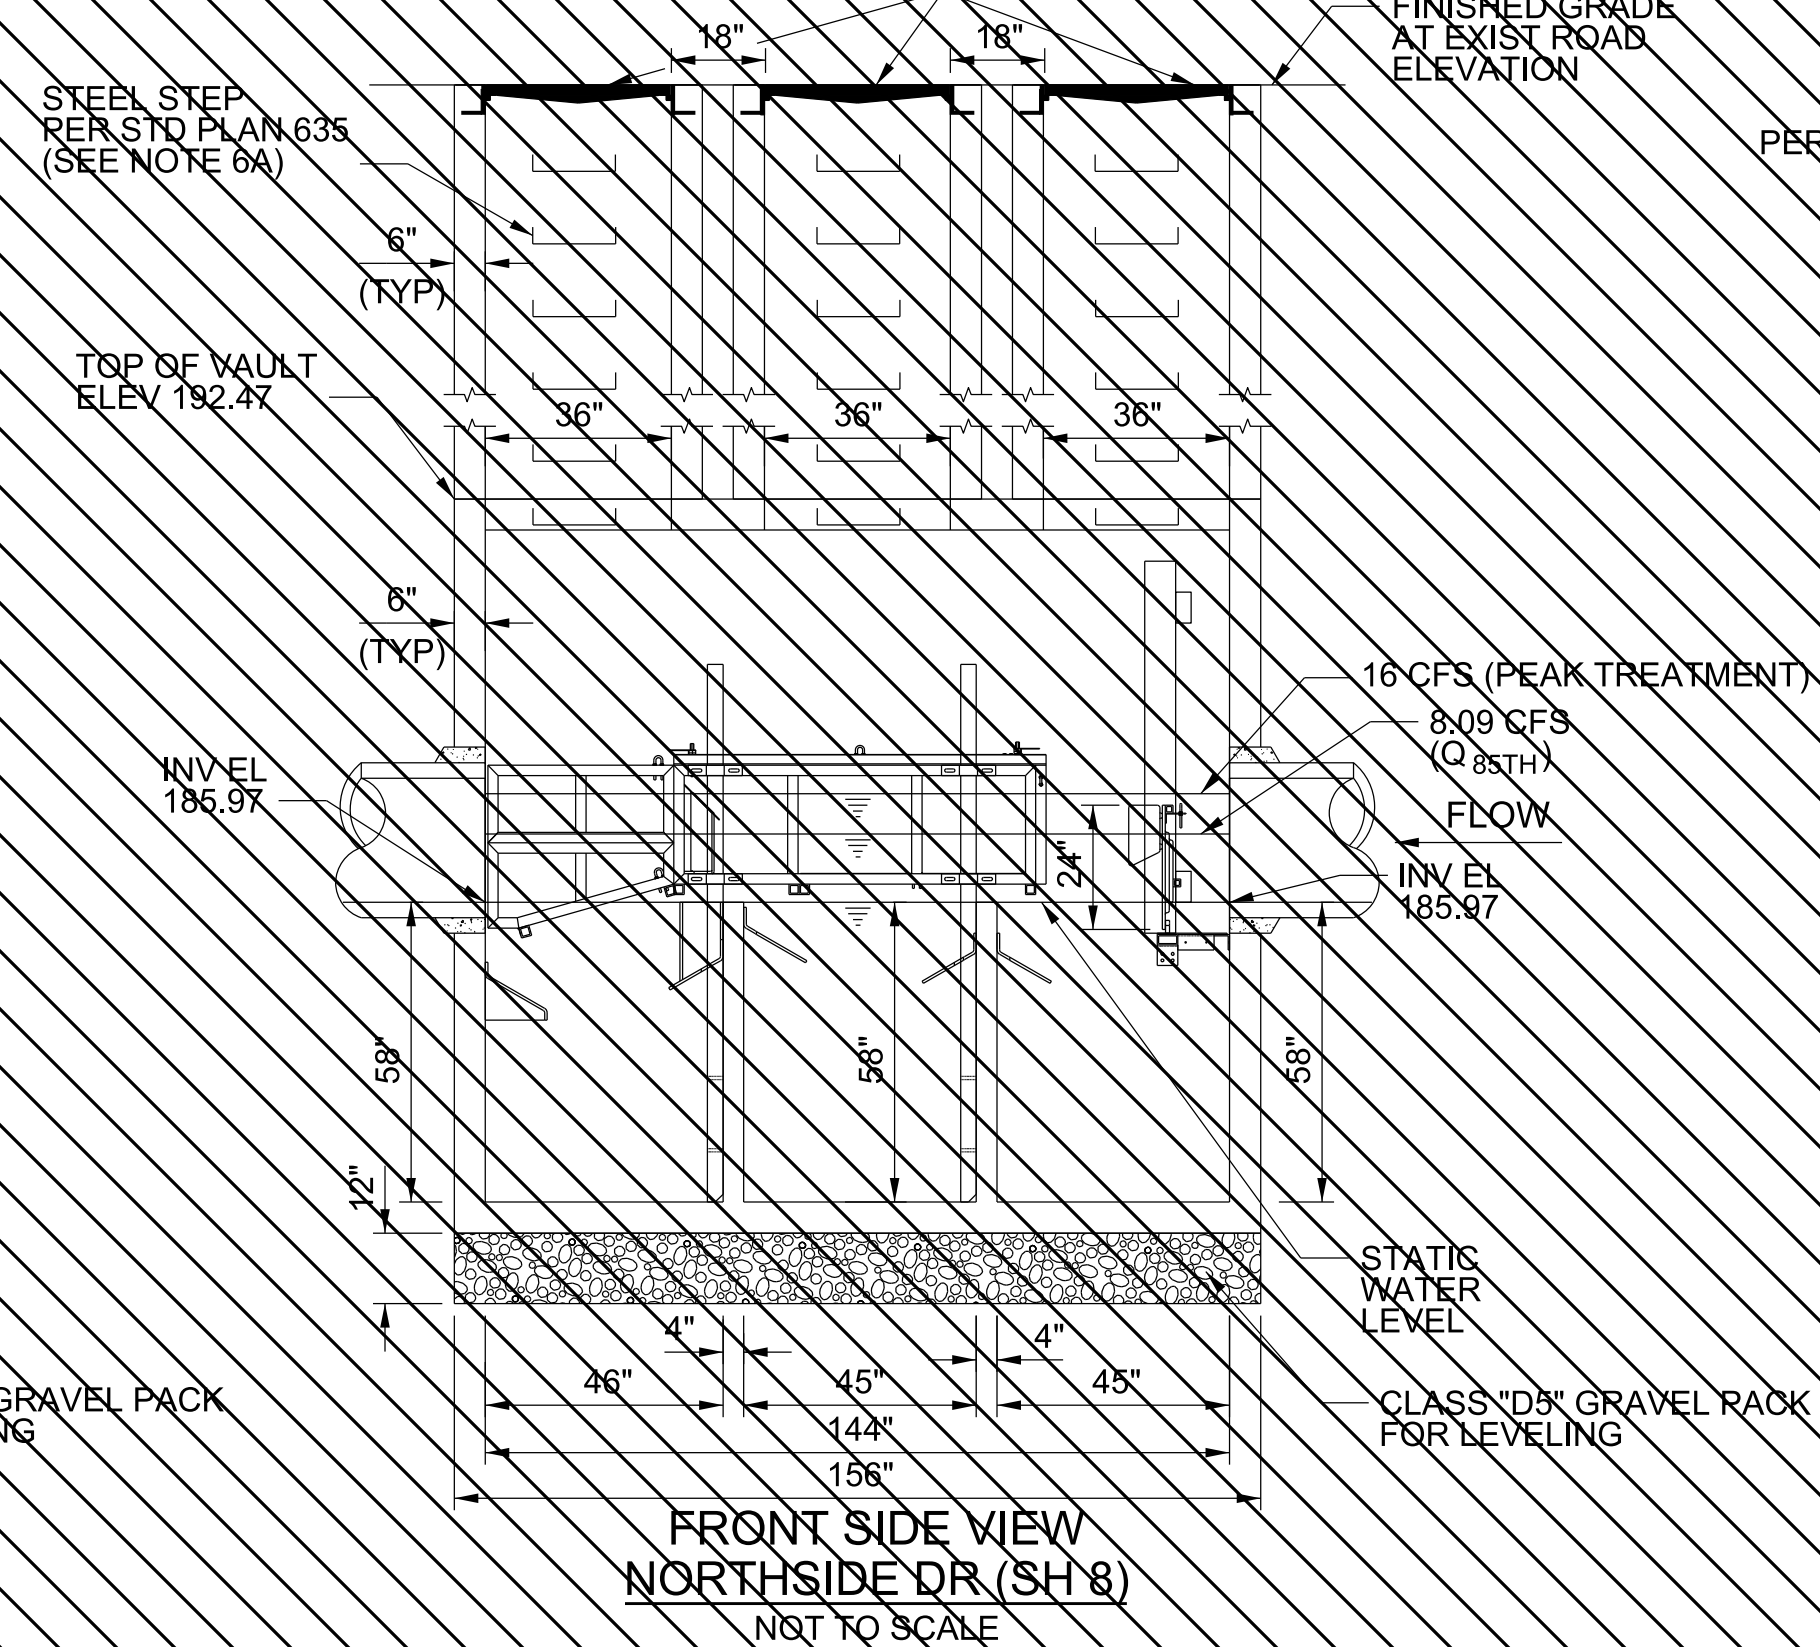


STEEL STEP PER STD PLAN 635 (SEE NOTE 6A)

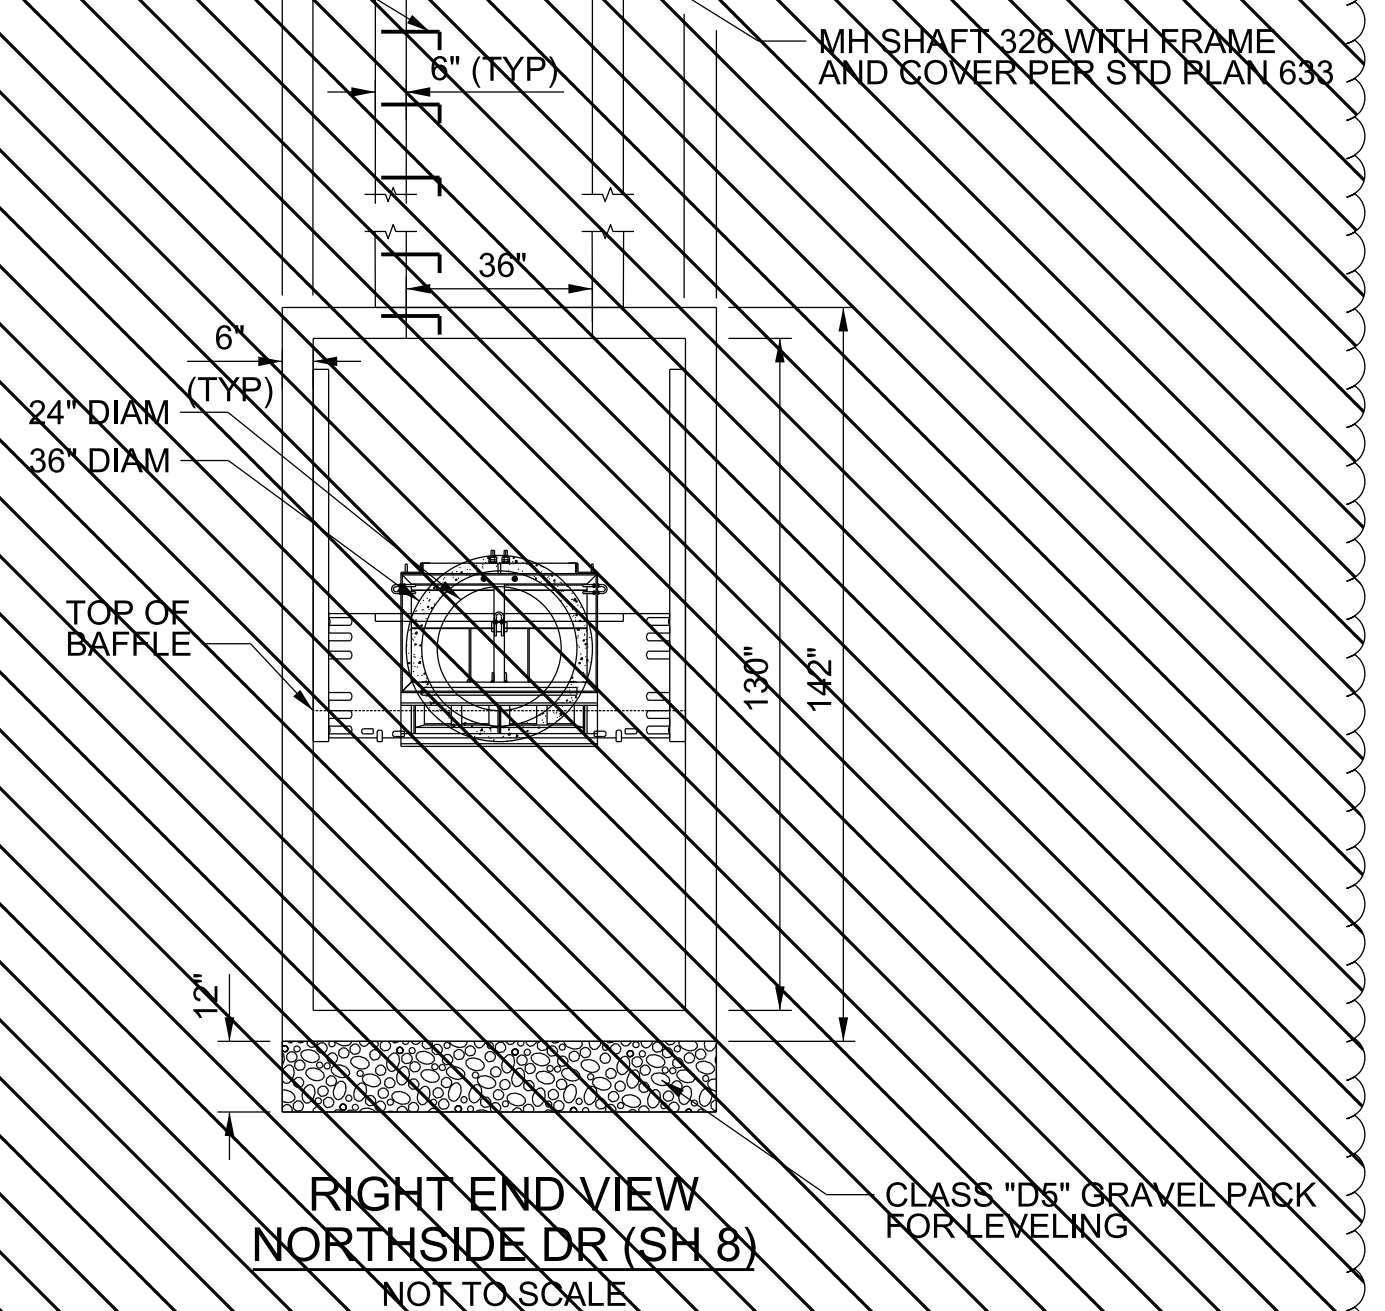



MH SHAFT 326 WITH FRAME AND COVER PER STD PLAN 633

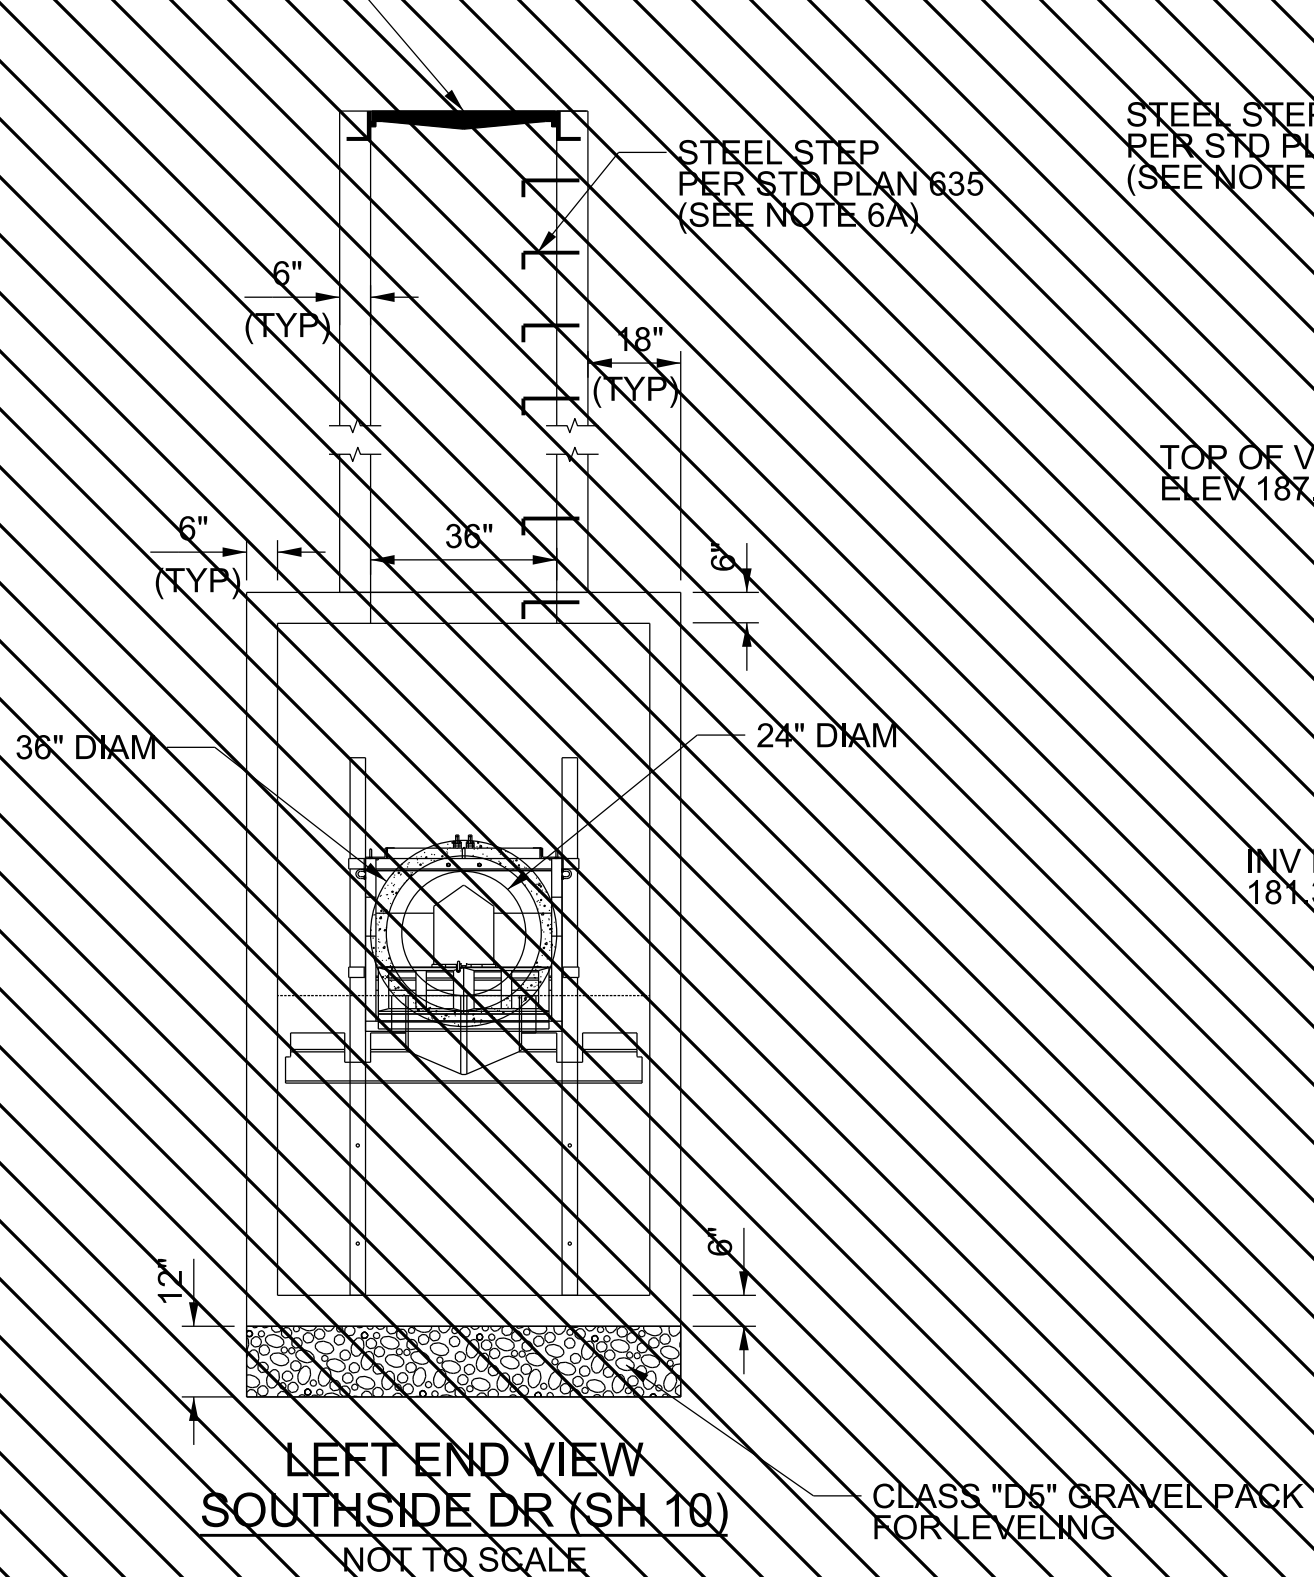

MH SHAFT 326 WITH FRAME AND COVER PER STD PLAN 633

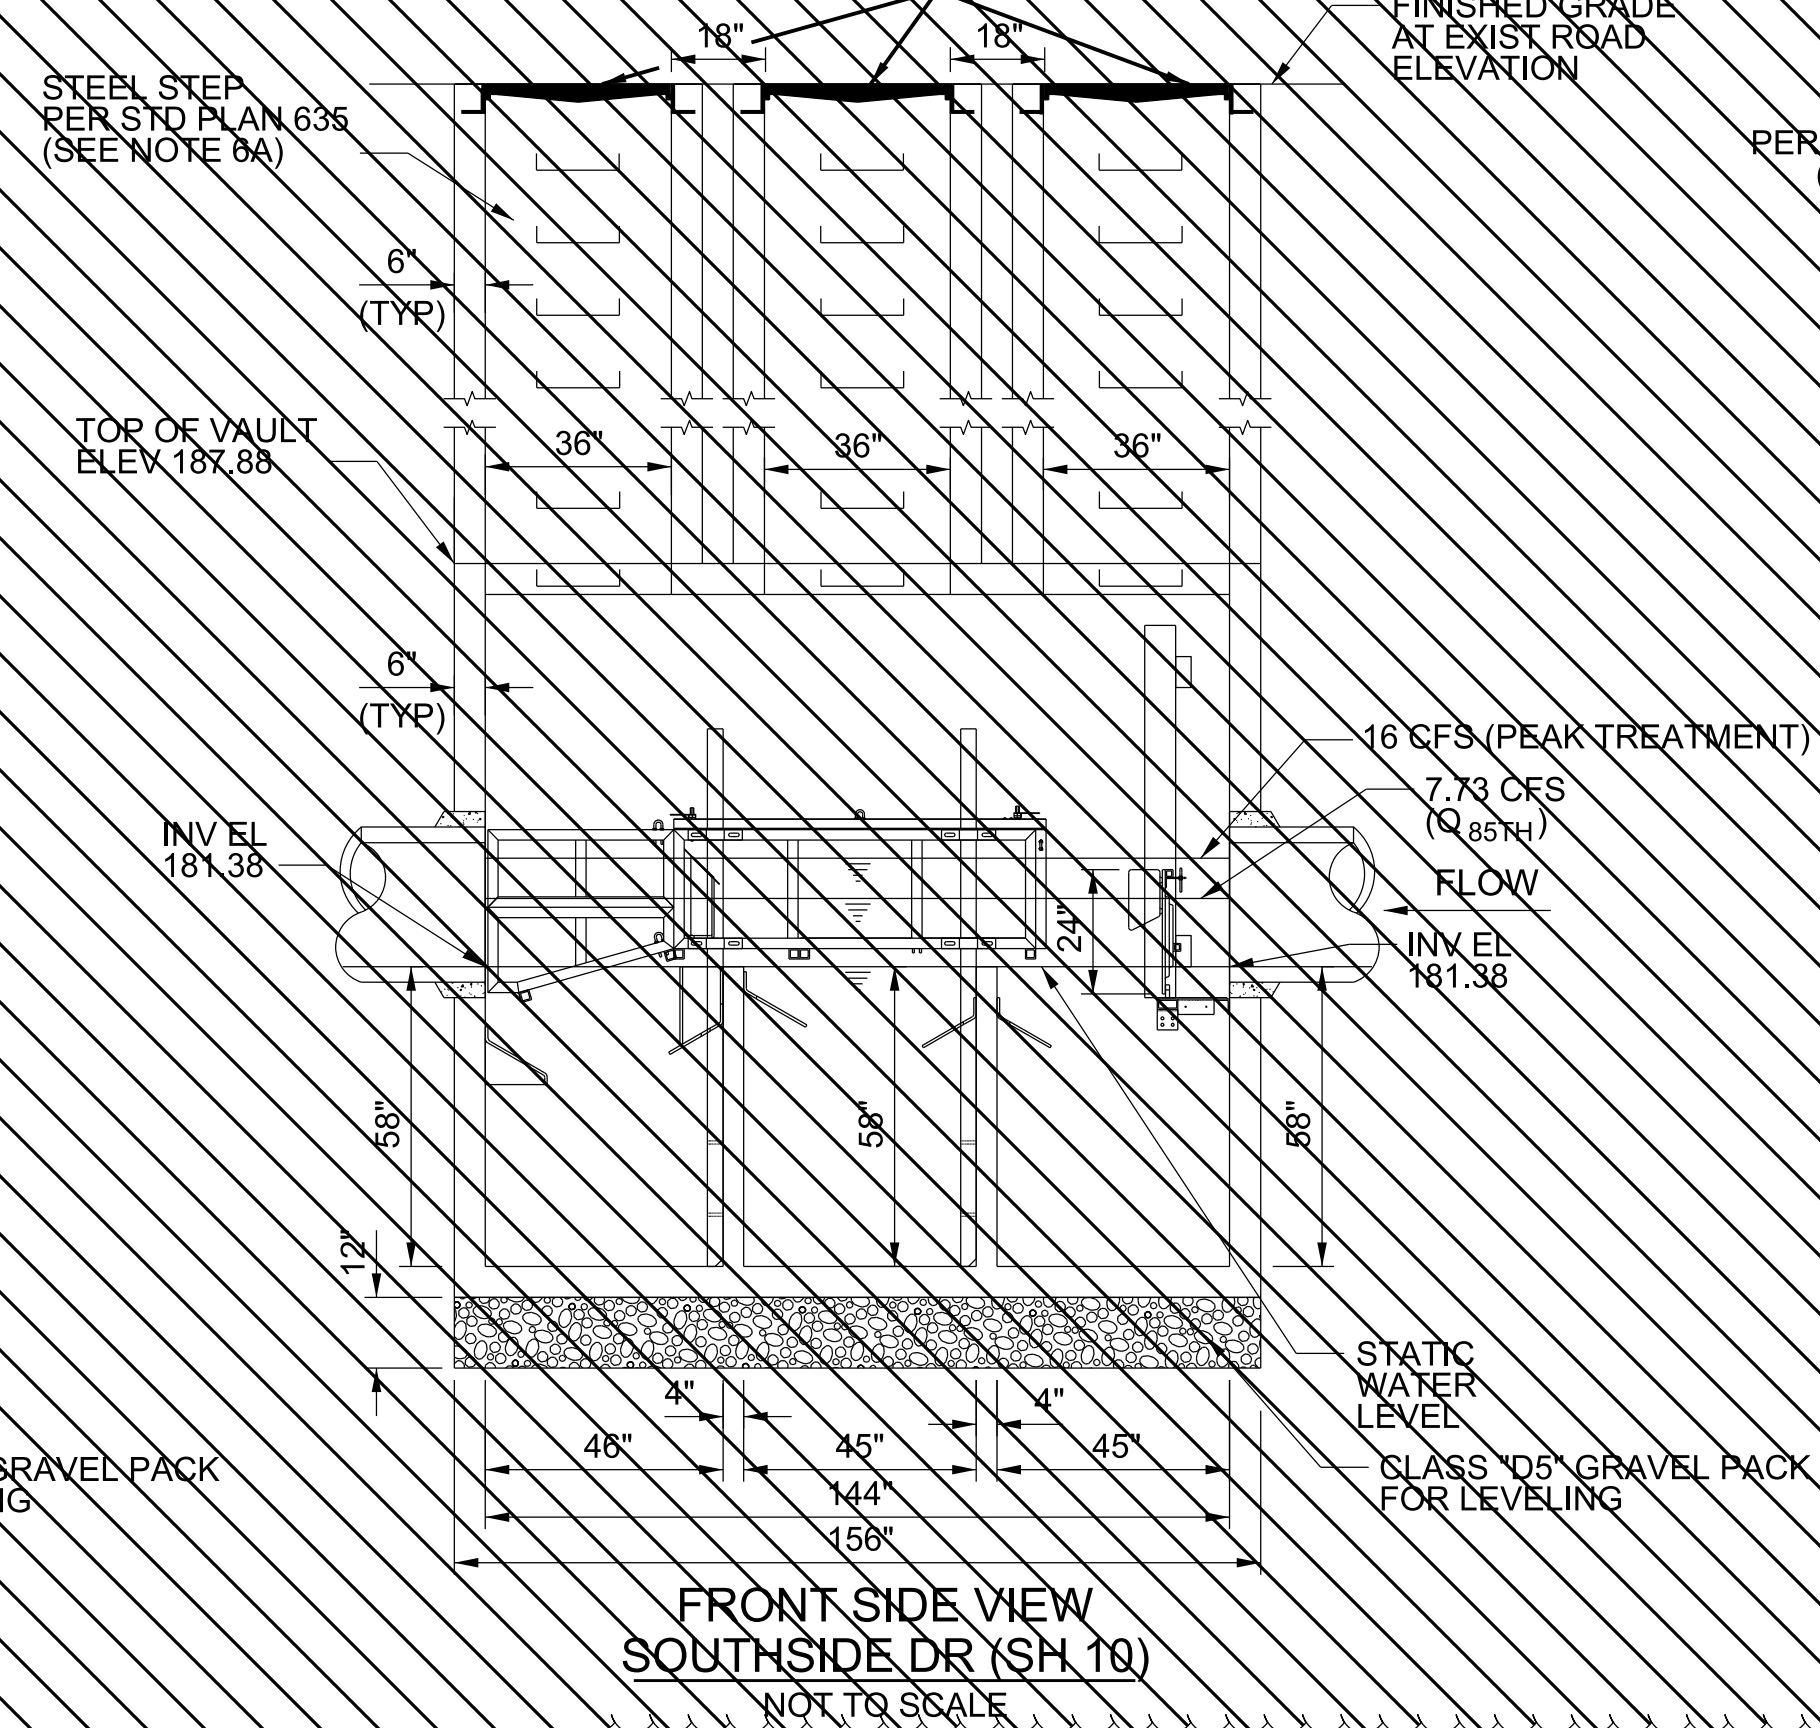

STEEL STEP PER STD PLAN 635 (SEE NOTE 6A)

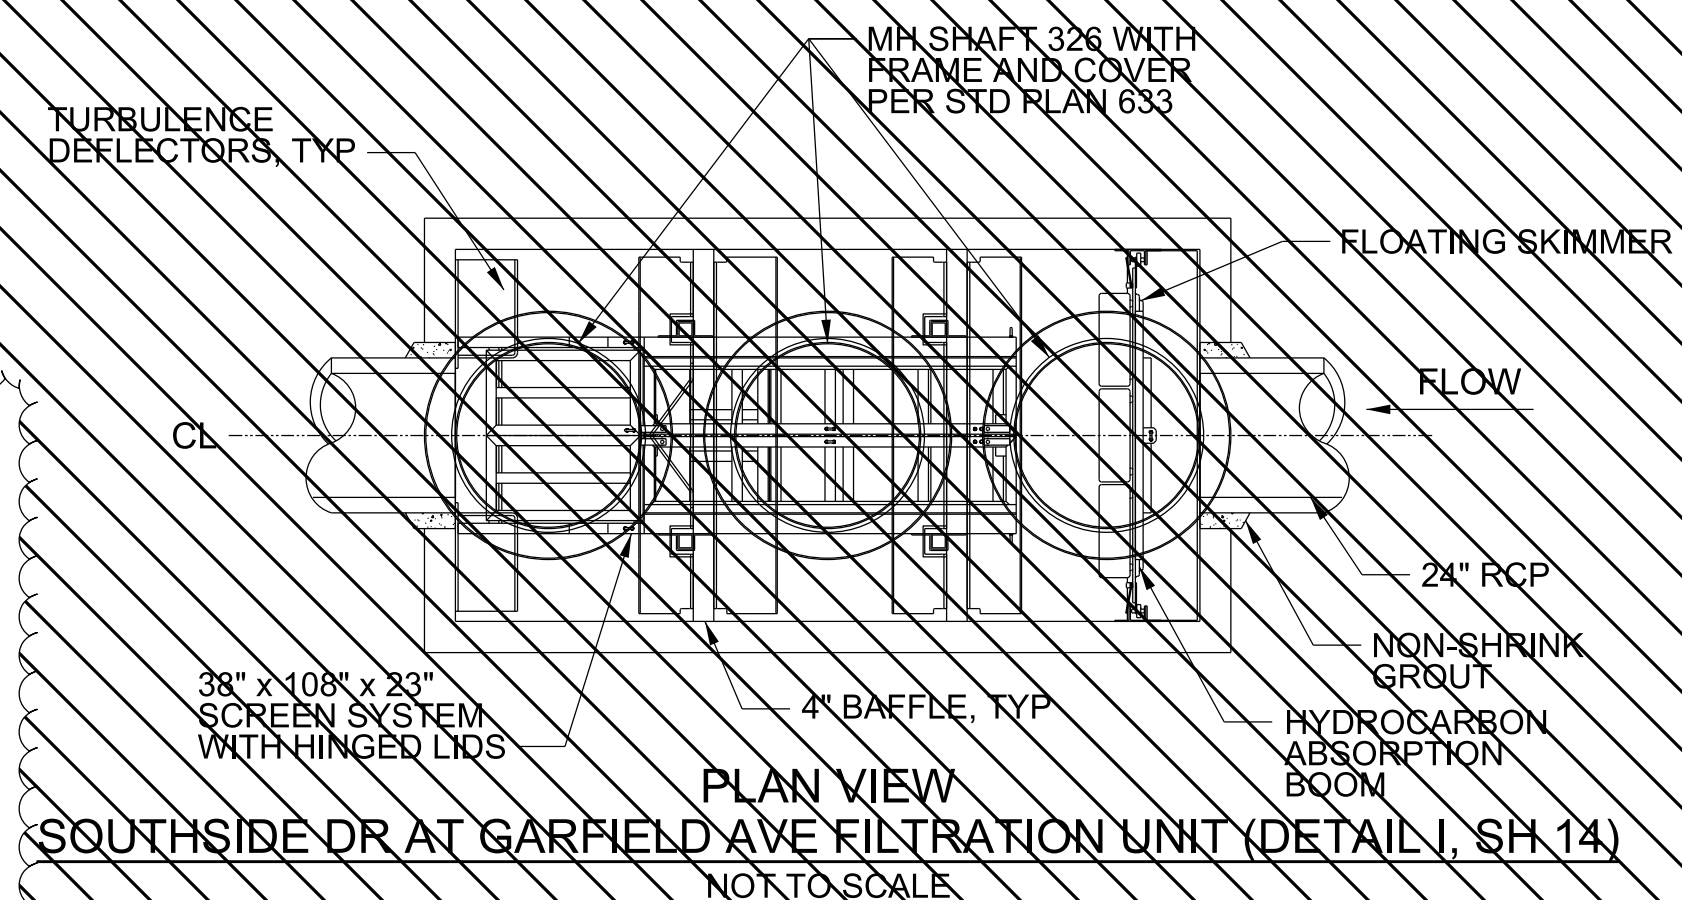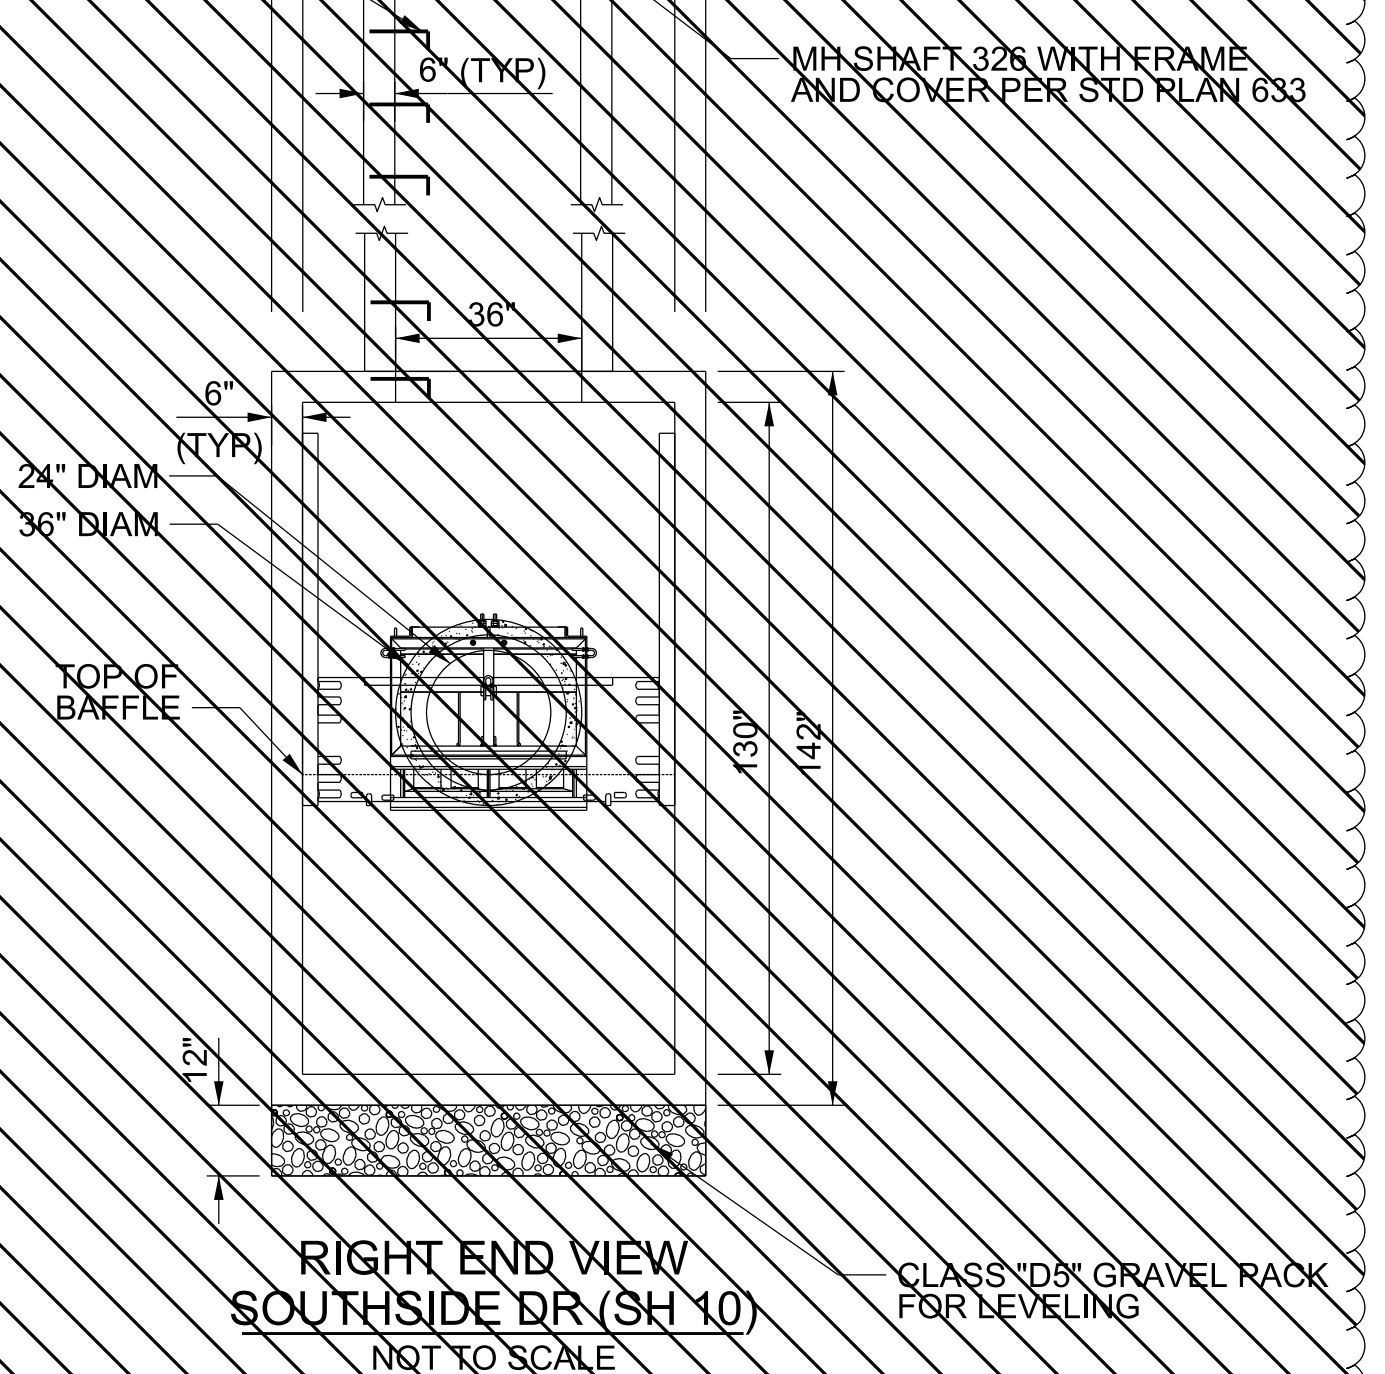

TREATMENT SPECIFICATIONS

1. INFLOW PIPE AREA (DRAWN AS 24" RCP) 3.14 SF
2. PEAK TREATMENT FLOW 16.0 CFS
3. SCREEN SYSTEM STORAGE VOLUME (MIN) 54.6 CF
4. TOTAL SEDIMENT VOLUME (MIN) 329 CF

CONSTRUCTION NOTES

1. CONCRETE 28 DAYS COMPRESSIVE STRENGTH, $F_c = 5,000$ PSI
2. REINFORCING: ASTM A-616 GRADE 60
3. SUPPORTS AN H2O LOADING AS INDICATED BY AASHTO
4. JOINT SEALANT: BUTYL RUBBER SS-S-08218
5. ALL WALLS (TOP, BOTTOM, EXTERIOR SIDE) TO BE 6" THICK CONCRETE.

INSTALLATION NOTES

- 1A. INFLOW AND OUTFLOW PIPES ARE TO BE FLUSH WITH THE INSIDE SURFACE OF THE CONCRETE STRUCTURE. CANNOT INTRUDE BEYOND FLUSH.
- 2A. BAFFLES WILL BE SEALED TO THE WALLS AND FLOOR WITH GROUT.
- 3A. INVERT OF OUTFLOW PIPE SHALL BE EVEN WITH THE TOP OF THE BAFFLES.
- 4A. THE BOTTOM OF THE SKIMMER SHALL BE 6" BELOW THE INVERT OF THE OUTFLOW PIPE.
- 5A. INVERT OF THE INFLOW PIPE SHALL NOT BE BELOW THE INVERT OF THE OUTFLOW PIPE.
- 6A. THE ENGINEER SHALL DETERMINE THE SIDE OF THE MANHOLE SHAFT WHERE STEPS SHALL BE INSTALLED.


CADD PROJECT FILE NAME
EAST LA MEDIANS.DGN

CHECKER
D. RADLE

DESIGNER
C. RAVE

DRAFTER
S. LU / L. CHAVEZ

DATE	REVISIONS
04/28/22	AS BUILT REVISIONS
DATE	DESCRIPTION

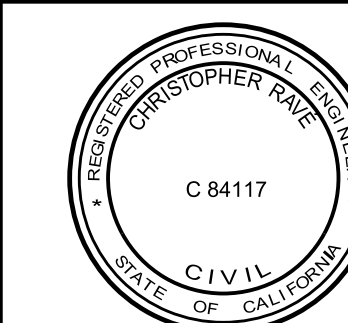

PROJECT ENGINEER
07/10/18


LOS ANGELES COUNTY PUBLIC WORKS

EAST LOS ANGELES
SUSTAINABLE MEDIAN
STORMWATER CAPTURE PROJECT
FILTRATION UNIT DETAILS
PROJECT ID NO. WMU0000010





LACFCD INDEX NO. 116-D27 PD053092 SHEET 16 OF 26-27

AS BUILT DRAWINGS

PLAN DR

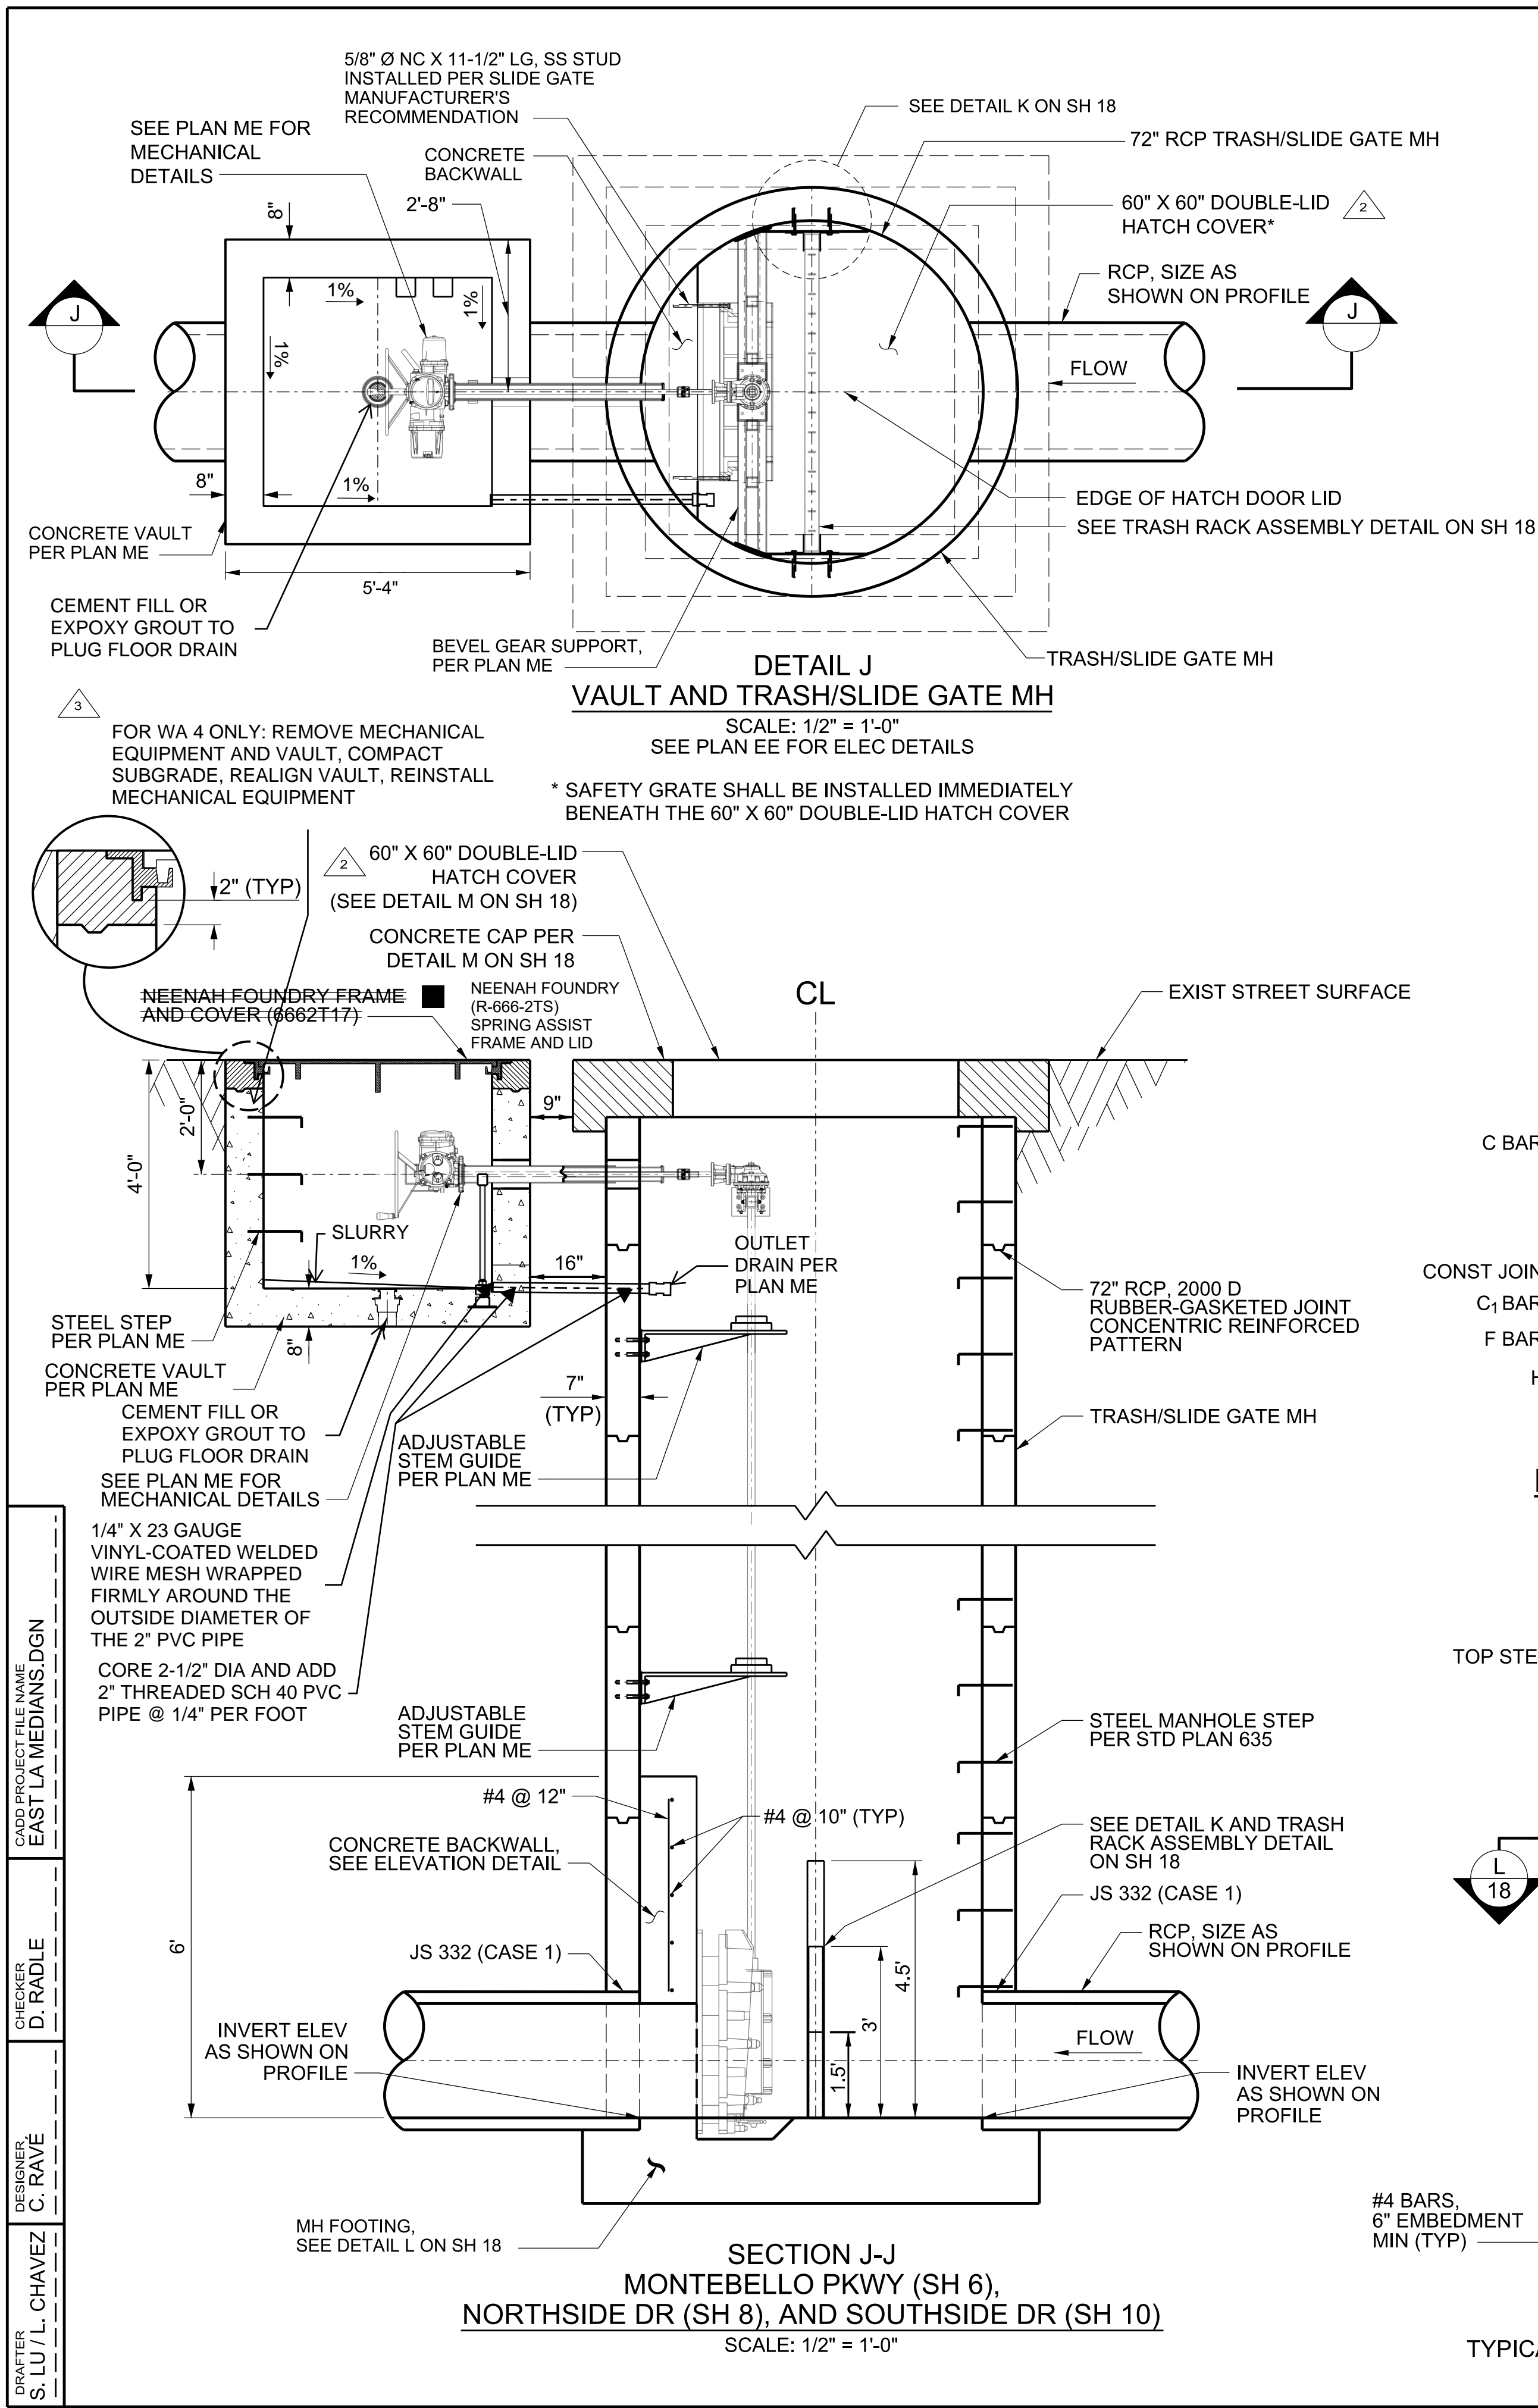

STRUCTURAL VALUES		
LOCATION	MONTEBELLO PKWY/LEONARD AVE	SOUTHSIDE DR/COOLIDGE WY
DESIGN COVER	2'	3'-4"
WIDTH	W	4'
HEIGHT	H ₁	3.5'
TOP SLAB THICKNESS	T ₁	8"
SIDE WALL THICKNESS	T ₂	8"
BOTTOM SLAB THICKNESS	T ₃	12"
CONCRETE COVER (3" MIN)	Y	3"
B BARS	BAR NO. & SPACING	5 @ 6"
B ₁ BARS	BAR NO. & SPACING	5 @ 6"
C BARS	BAR NO. & SPACING	5 @ 9"
C ₁ BARS	BAR NO. & SPACING	5 @ 9"
D BARS	BAR NO. & SPACING	5 @ 9"
F BARS	BAR NO. & SPACING	5 @ 9"
F ₁ BARS	BAR NO. & SPACING	5 @ 9"
G BARS	BAR NO. & SPACING	5 @ 6"
H BARS	BAR NO. & SPACING	5 @ 9"

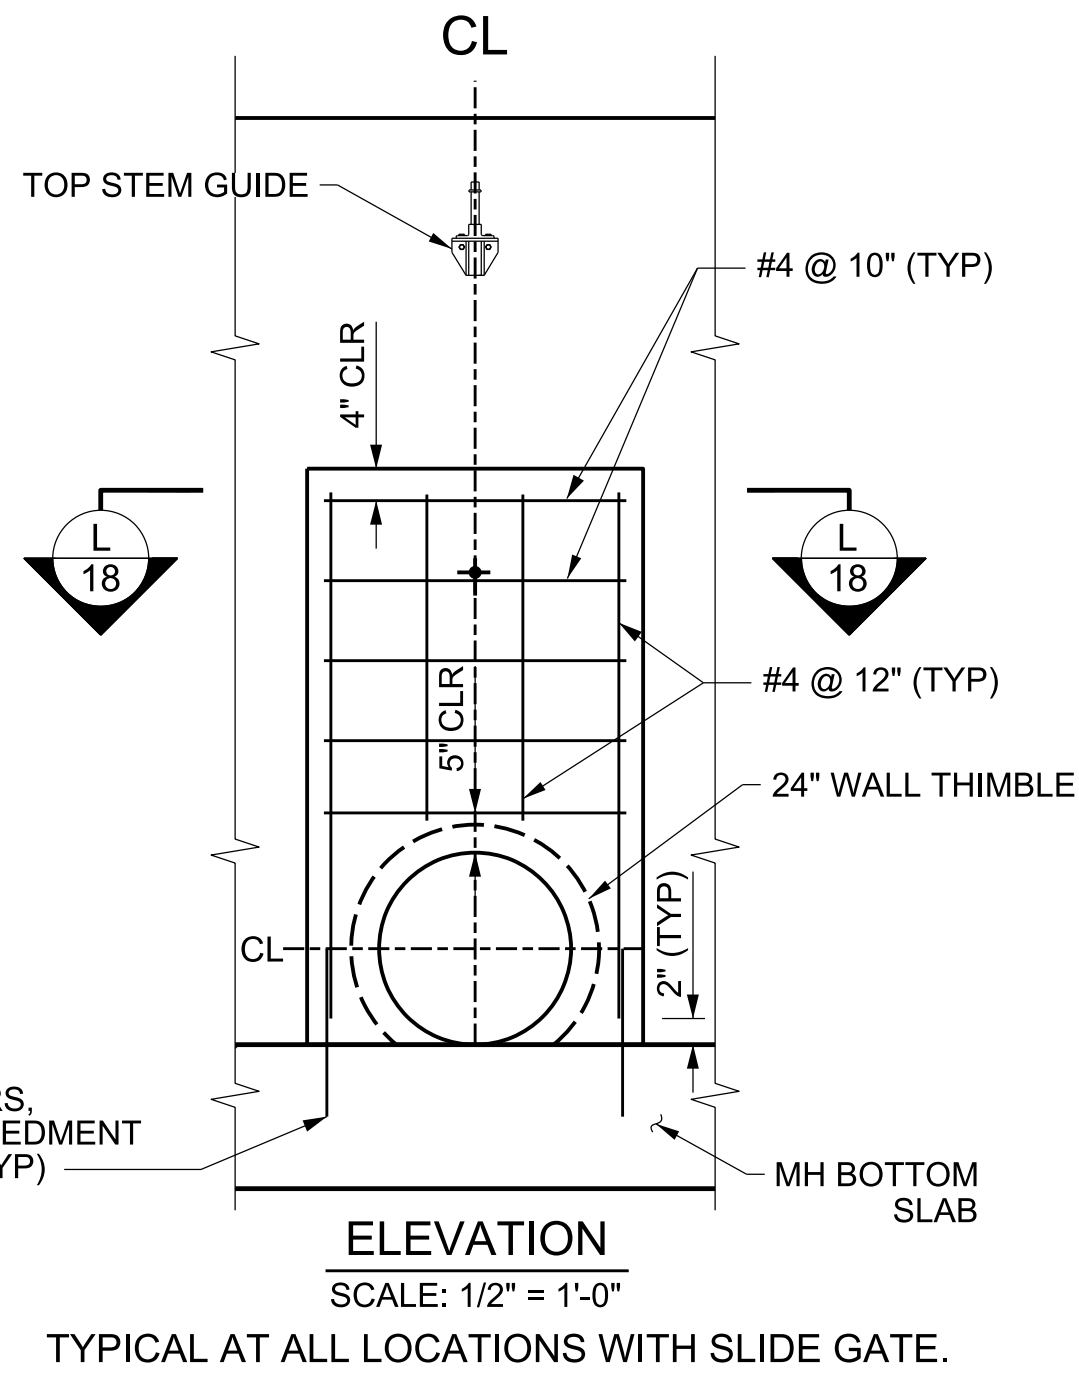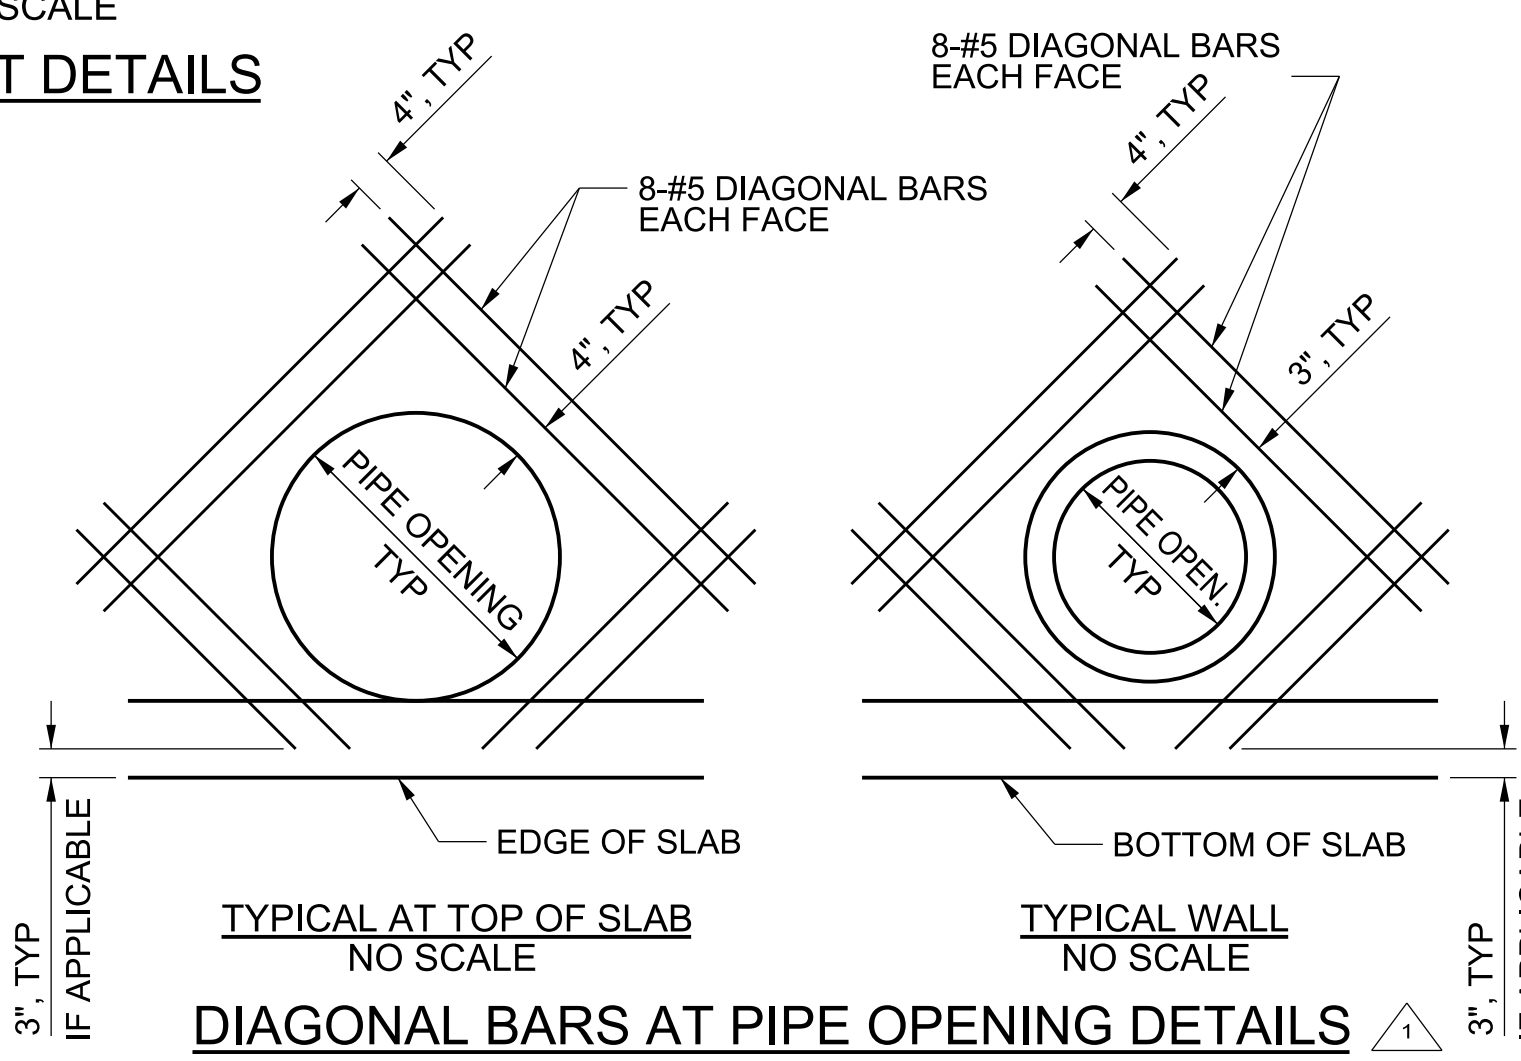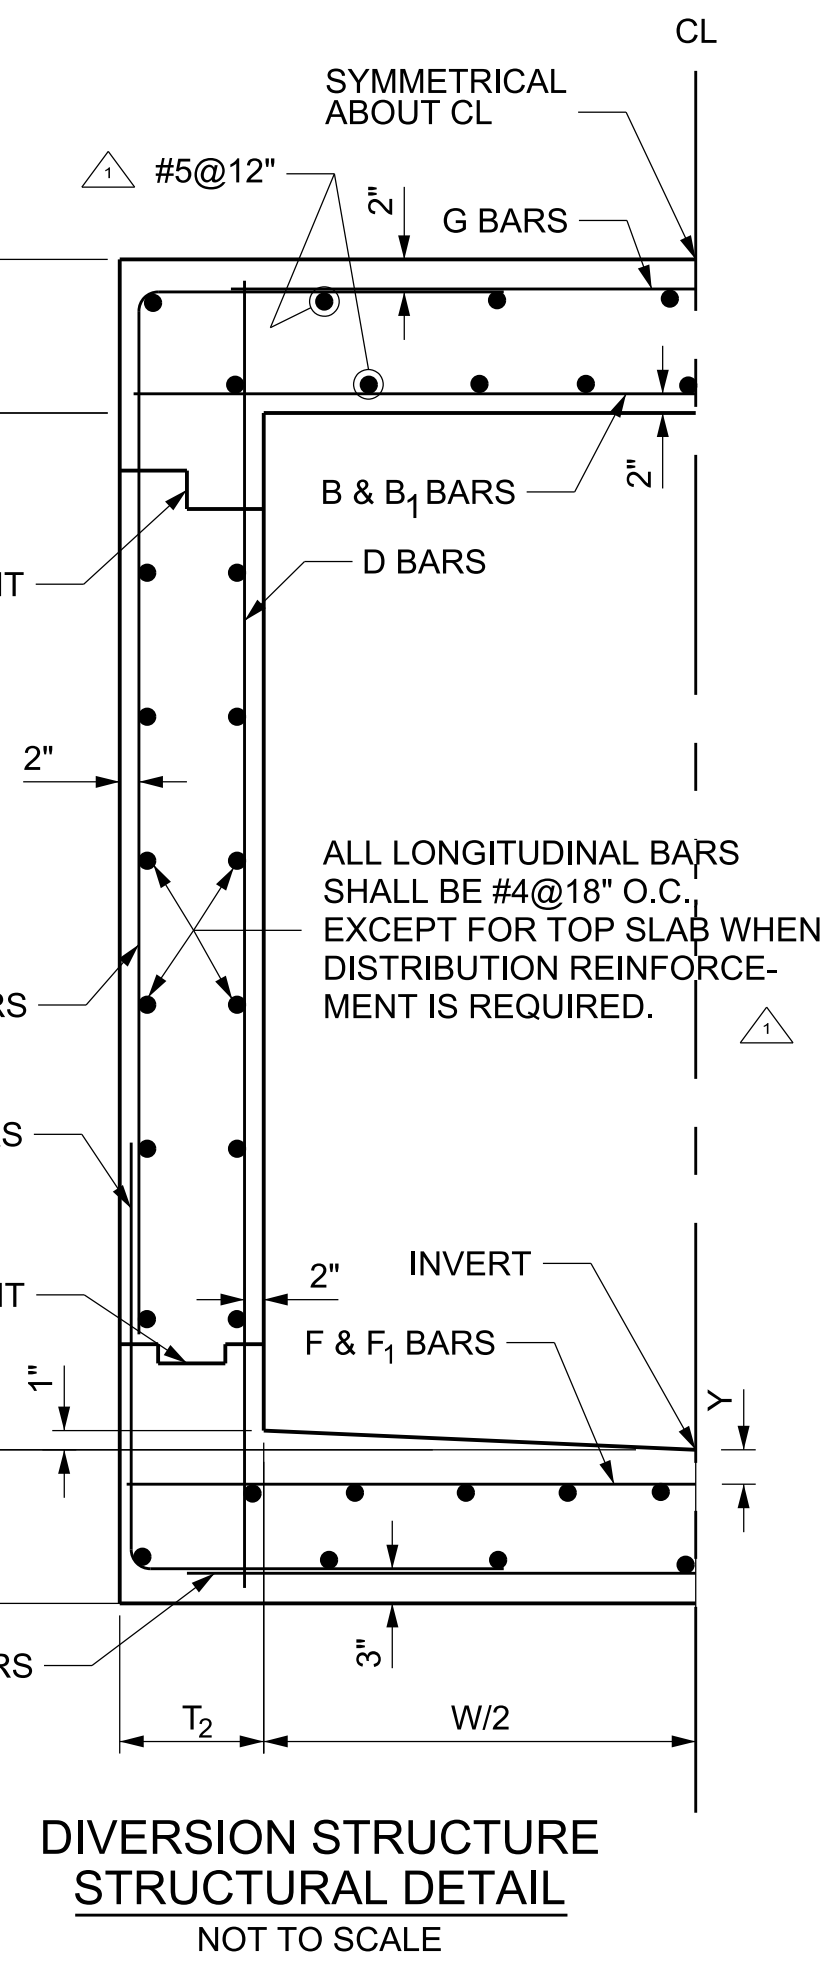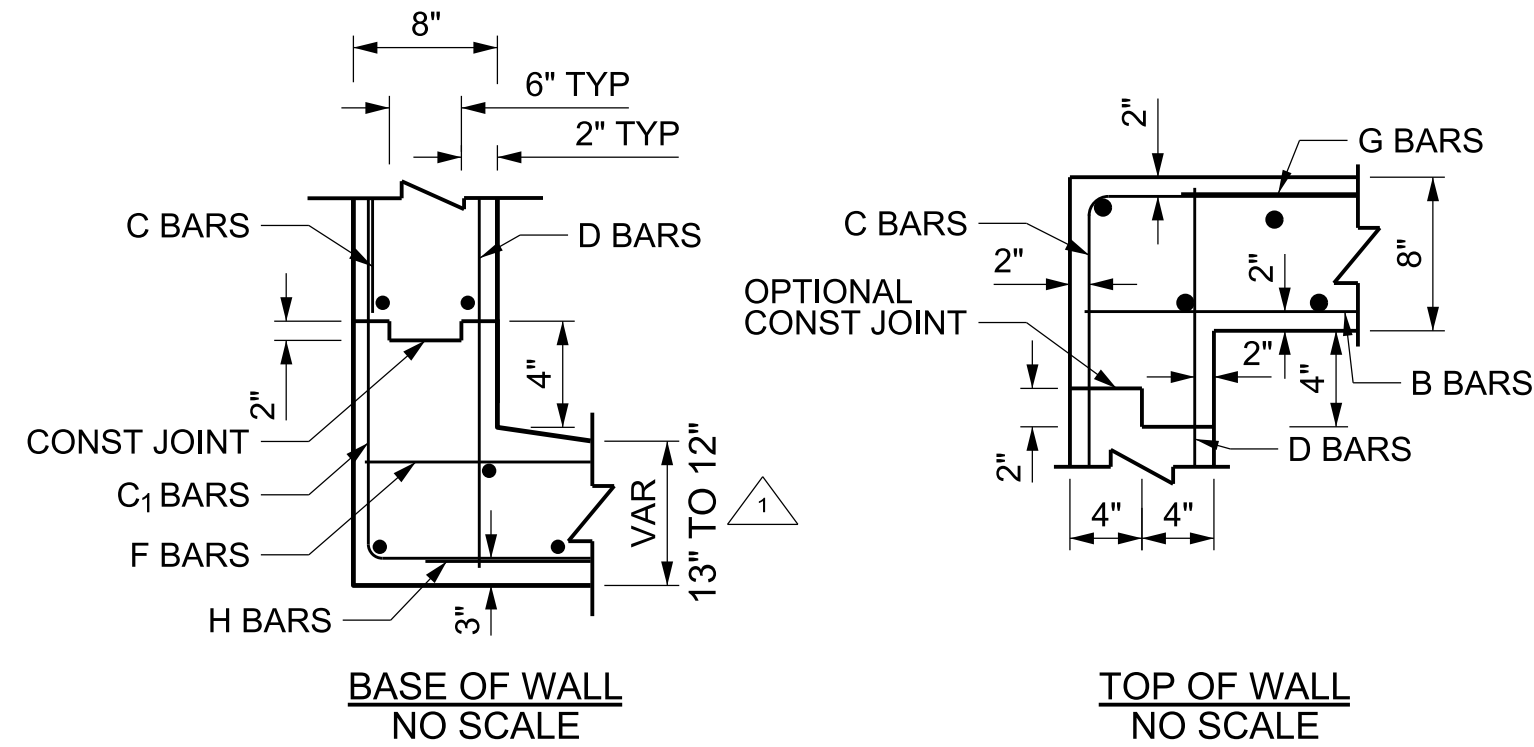

STRUCTURAL NOTES

- DIMENSIONS FROM FACE OF CONCRETE TO STEEL ARE CLEAR DISTANCE BETWEEN FACE OF CONCRETE AND FACE OF REINFORCEMENT.
- CONCRETE DIMENSIONS SHALL BE MEASURED HORIZONTALLY OR VERTICALLY ON THE PROFILE, AND PARALLEL TO OR AT RIGHT ANGLES (OR RADIALLY) TO CENTERLINE OF CONDUIT ON THE PLAN EXCEPT AS OTHERWISE SHOWN.
- ALL BAR BENDS AND HOOKS SHALL CONFORM TO THE AMERICAN CONCRETE INSTITUTE'S "BUILDING CODE REQUIREMENTS FOR STRUCTURAL CONCRETE (ACI 318)," LATEST EDITION, SECTION 7.2.
- TRANSVERSE CONSTRUCTION JOINTS IN WALLS AND SLABS SHALL BE IN THE SAME PLANE, NO STAGGERING OF JOINTS WILL BE PERMITTED. TRANSVERSE CONSTRUCTION JOINTS SHALL BE NORMAL OR RADIAL TO THE CENTERLINE OF CONSTRUCTION.
- THE TRANSVERSE REINFORCING BARS SHALL TERMINATE ONE AND ONE-HALF INCHES FROM THE CONCRETE SURFACES UNLESS OTHERWISE SHOWN ON THE STRUCTURAL DETAILS.
- EXPOSED SURFACES OF CONCRETE MEMBERS SHALL BE ROUNDED OR BEVELED.
- NO SPLICES IN TRANSVERSE BARS REINFORCEMENT WILL BE PERMITTED OTHER THAN SHOWN ON THE PLAN WITHOUT APPROVAL OF THE ENGINEER. NO MORE THAN TWO SPLICES WILL BE PERMITTED IN ANY LONGITUDINAL BAR BETWEEN TRANSVERSE JOINTS. SPLICES SHALL BE STAGGERED.
- LONGITUDINAL BARS SHALL BE LAPPED 20 BAR DIAMETERS AT SPLICES. TRANSVERSE BARS SHALL BE LAPPED 30 BAR DIAMETERS AT SPLICES.
- LONGITUDINAL BARS SHALL BE CONTINUOUS AND EXTEND THROUGH ALL CONSTRUCTION JOINTS.
- UNLESS OTHERWISE SHOWN ON THE PLANS, TRANSVERSE CONSTRUCTION JOINTS (IN BOTH SLABS AND WALLS) SHALL BE PLACED AT THE END OF EACH POUR, BUT THE SPACING THEREOF SHALL NOT BE LESS THAN 10 FEET.
- AT THE BEGINNING AND ENDING OF ALL POURS, A CURTAIN OF REINFORCEMENT COMPOSED OF B, C, C₁, D, F, F₁, G, AND H BARS SHALL BE PLACED THREE INCHES FROM THE TRANSVERSE CONSTRUCTION JOINT.
- D BARS MAY BE SPLICED 20 BAR DIAMETERS AT THE LOWER LONGITUDINAL CONSTRUCTION JOINT, AT CONTRACTOR'S OPTION.
- IN ALL SECTIONS LAP C AND C₁ BARS, THE VERTICAL LENGTH OF C AND C₁ HAS BEEN CALCULATED FOR A FOUR-INCH STARTER WALL. IF THE HEIGHT OF THE STARTER WALL IS VARIED, THE VERTICAL LENGTH OF THE C AND C₁ BARS SHALL BE VARIED CORRESPONDINGLY SO AS TO MAINTAIN A 30 DIAMETER LAP BETWEEN THE TWO BARS. THE LAPS SHALL BE BASED ON THE SMALLER BARS.
- CONCRETE QUANTITIES ARE BASED ON A SIX-BY-SIX INCH FILLET AND STEEL QUANTITIES DO NOT INCLUDE ANY OPTIONAL SPLICES.
- GROUT BETWEEN ANY CUT SURFACES WITHIN THE STORM DRAIN TO PREVENT WATER FROM SEEPING IN-BETWEEN THE CONNECTIONS.

STRUCTURAL DESIGN CRITERIA

LACFCD STRUCTURAL DESIGN MANUAL
DATED APRIL 1982 + 2000 UPDATES

LIVE LOAD

HS 20-44 UNLESS OTHERWISE NOTED

DEAD LOAD

EARTH LOAD: w = 120 PCF
K_u = K_u = 0.150
B_d = OUTSIDE WIDTH OF BOX PLUS 3 FEET
SIDE EARTH ACTIVE = 37 PCF
INTERNAL WATER PRESSURE: 62.4 PSF PER FOOT OF DEPTH
WEIGHT OF CONCRETE: 150 PCF

ALLOWABLE STRESSES


F_c = 4000 PSI AT 28 DAYS

F_y = 60,000 PSI

SHEAR AND BOND STRESSES PER THE LATEST EDITION OF ACI 318

CADD PROJECT FILE NAME: EAST LA MEDIANS.DGN
CHECKER: D. RADLE
DESIGNER: C. RAVE
DRAFTER: S. LU / L. CHAVEZ







DATE	REVISIONS
04/28/22	AS BUILT REVISIONS
01/28/21	UPDATED ACTUATOR VAULT DETAILS.
12/02/20	UPDATED TRASH/SLIDE GATE MH COVER AND ADDED SAFETY GRATE.
10/27/20	UPDATED STRUCTURAL DETAILS

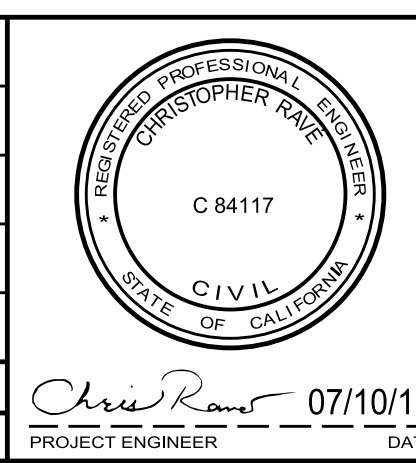




LOS ANGELES COUNTY PUBLIC WORKS
EAST LOS ANGELES SUSTAINABLE MEDIAN STORMWATER CAPTURE PROJECT
STRUCTURAL DETAILS AND SECTIONS
PROJECT ID NO. WMU0000010
LACFCD INDEX NO. 116-D27 PD053092 SHEET 17 OF 26-27

AS BUILT DRAWINGS




PLAN DR

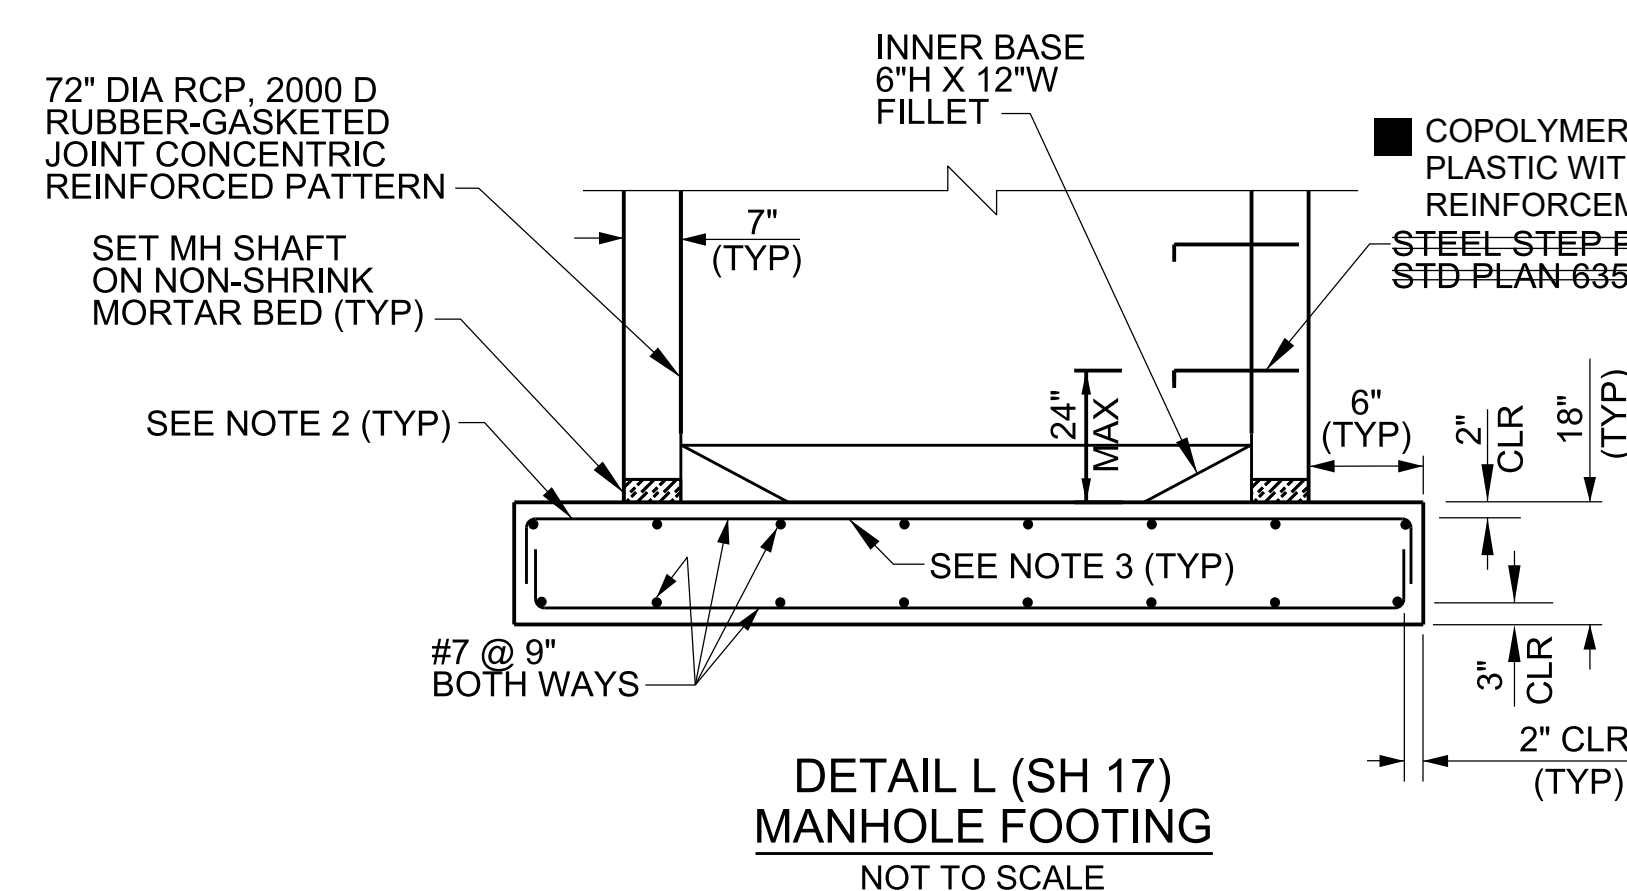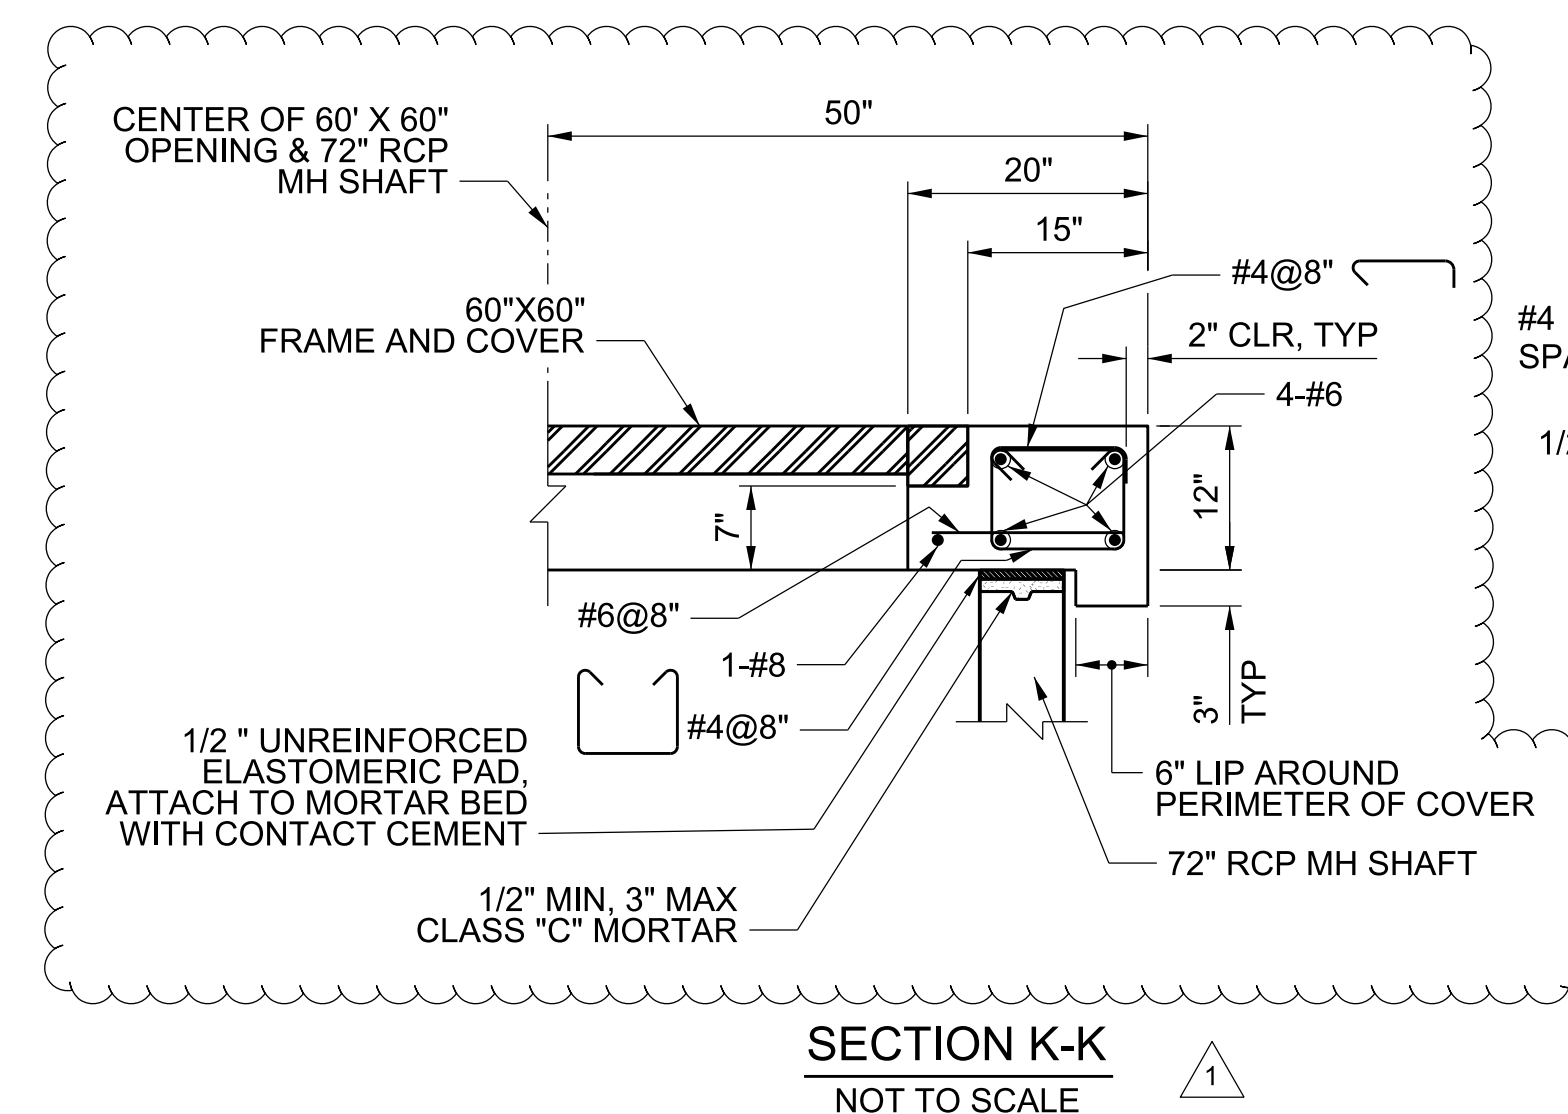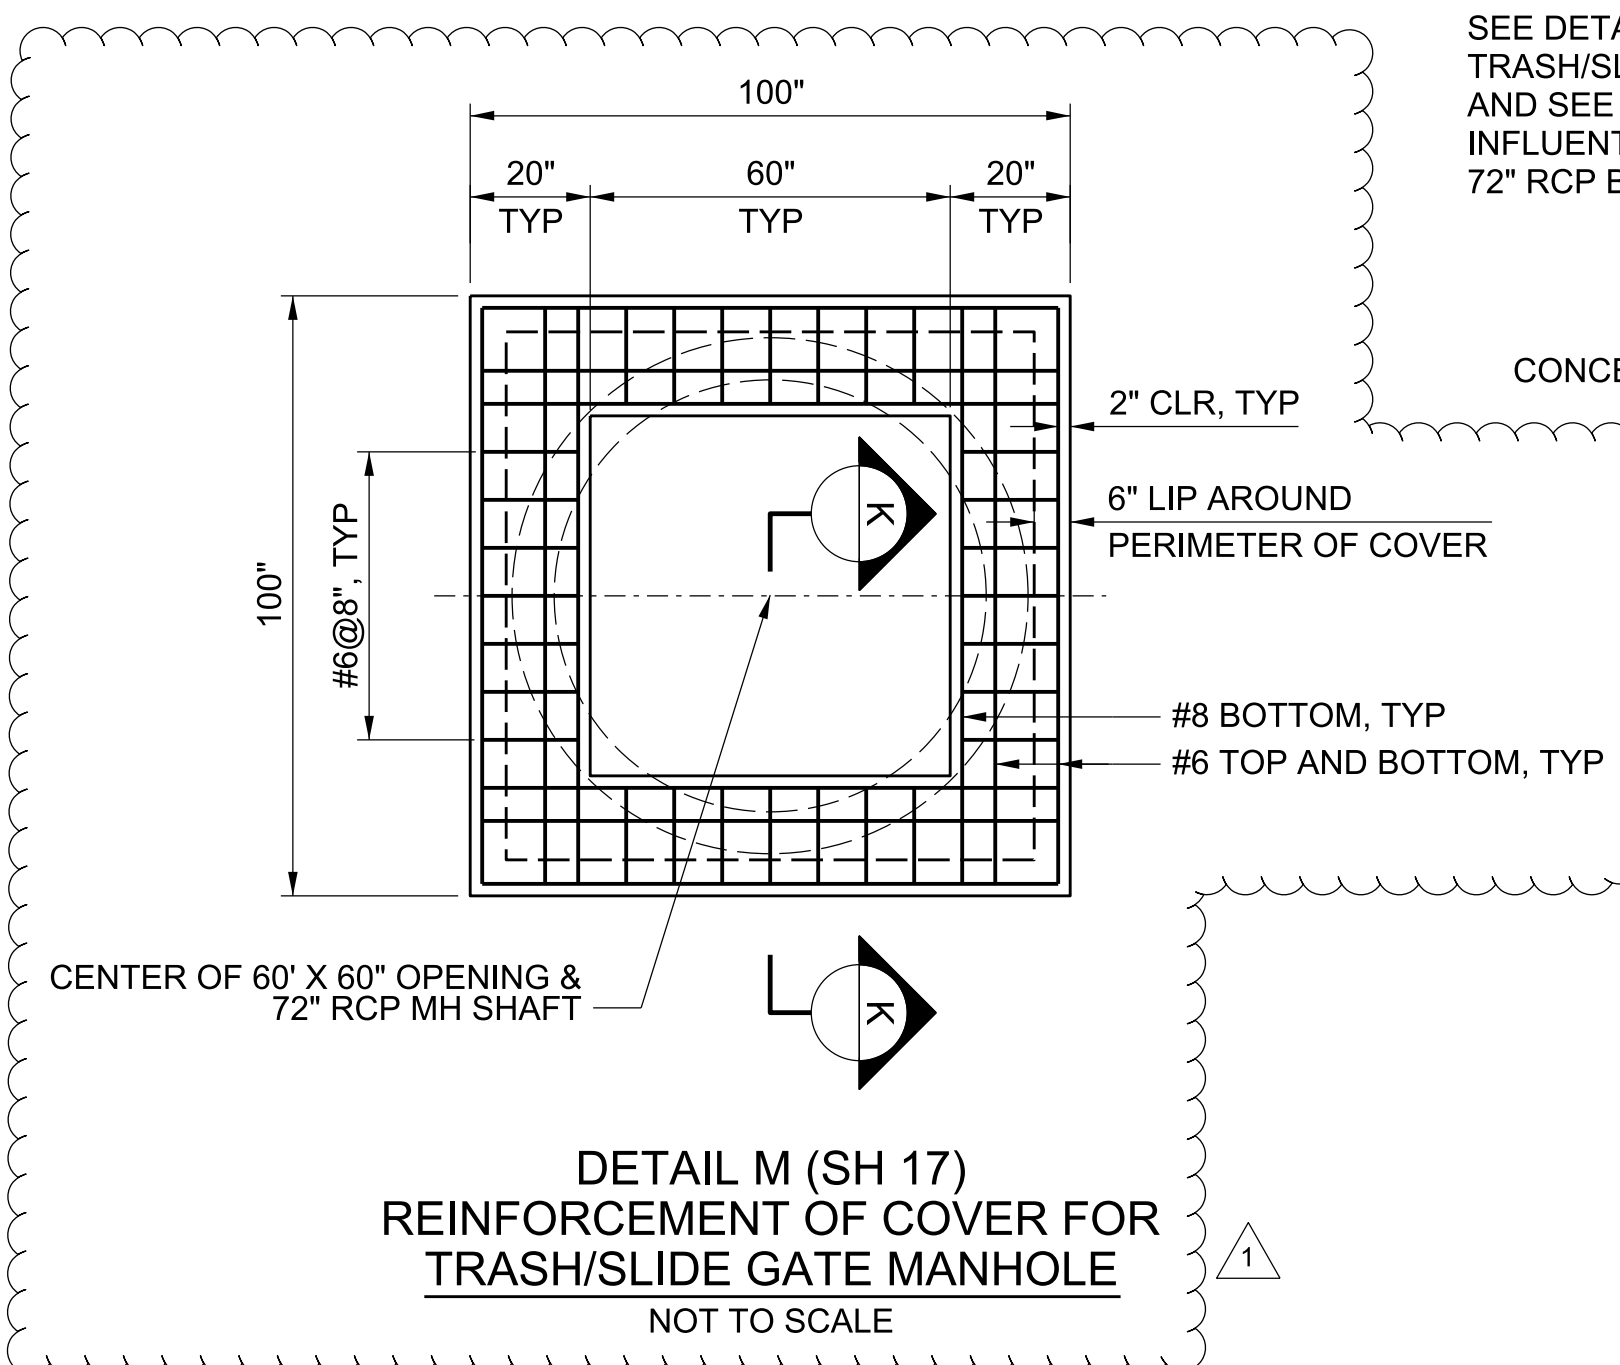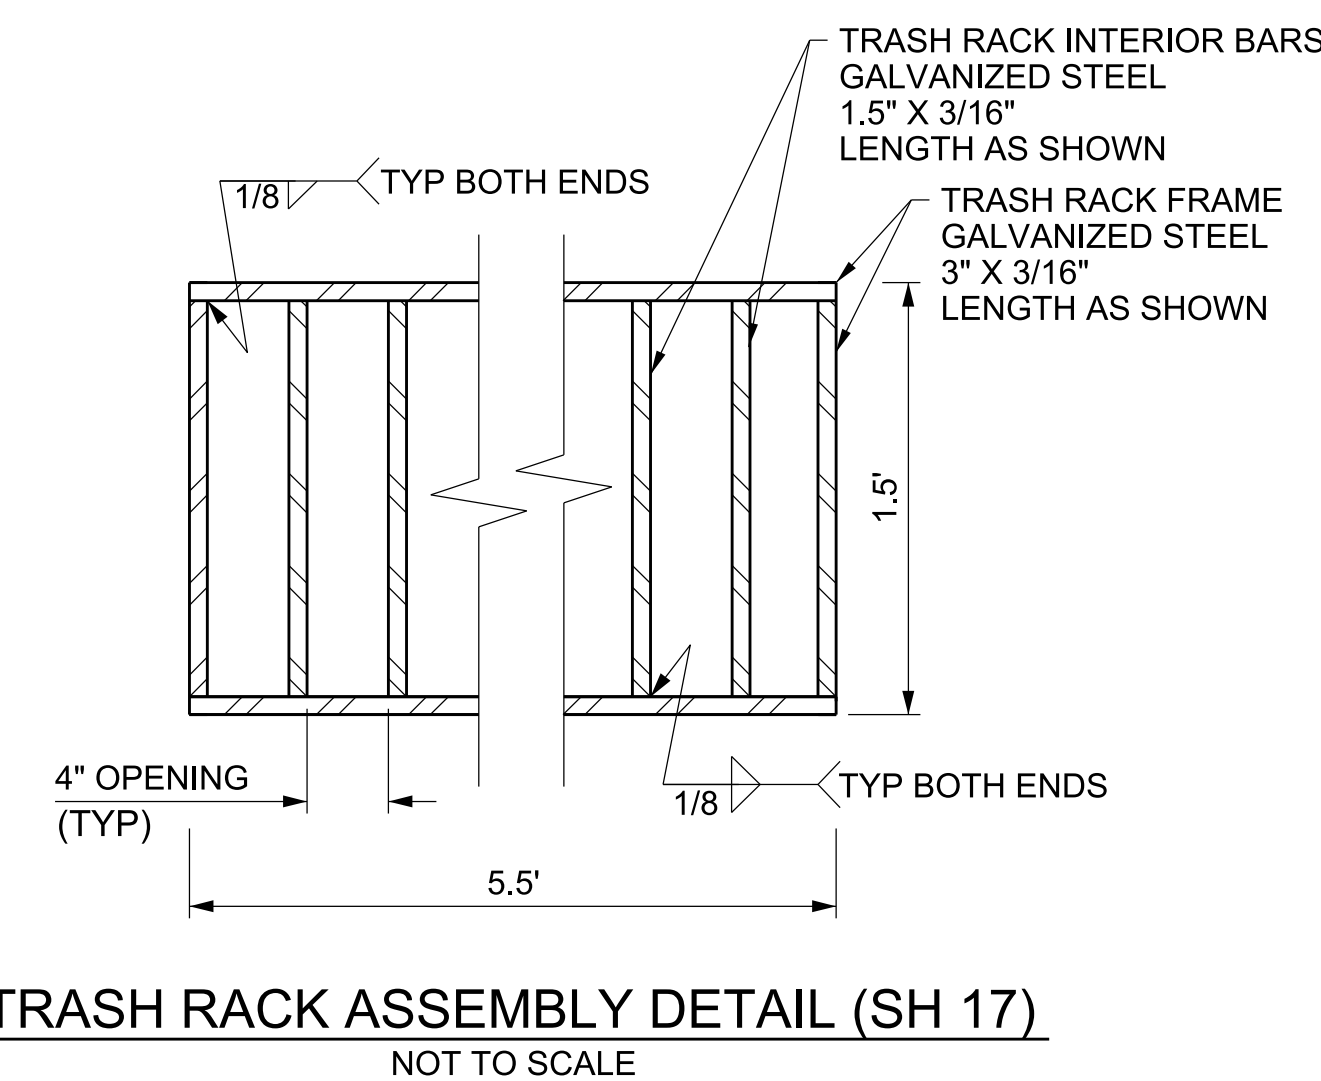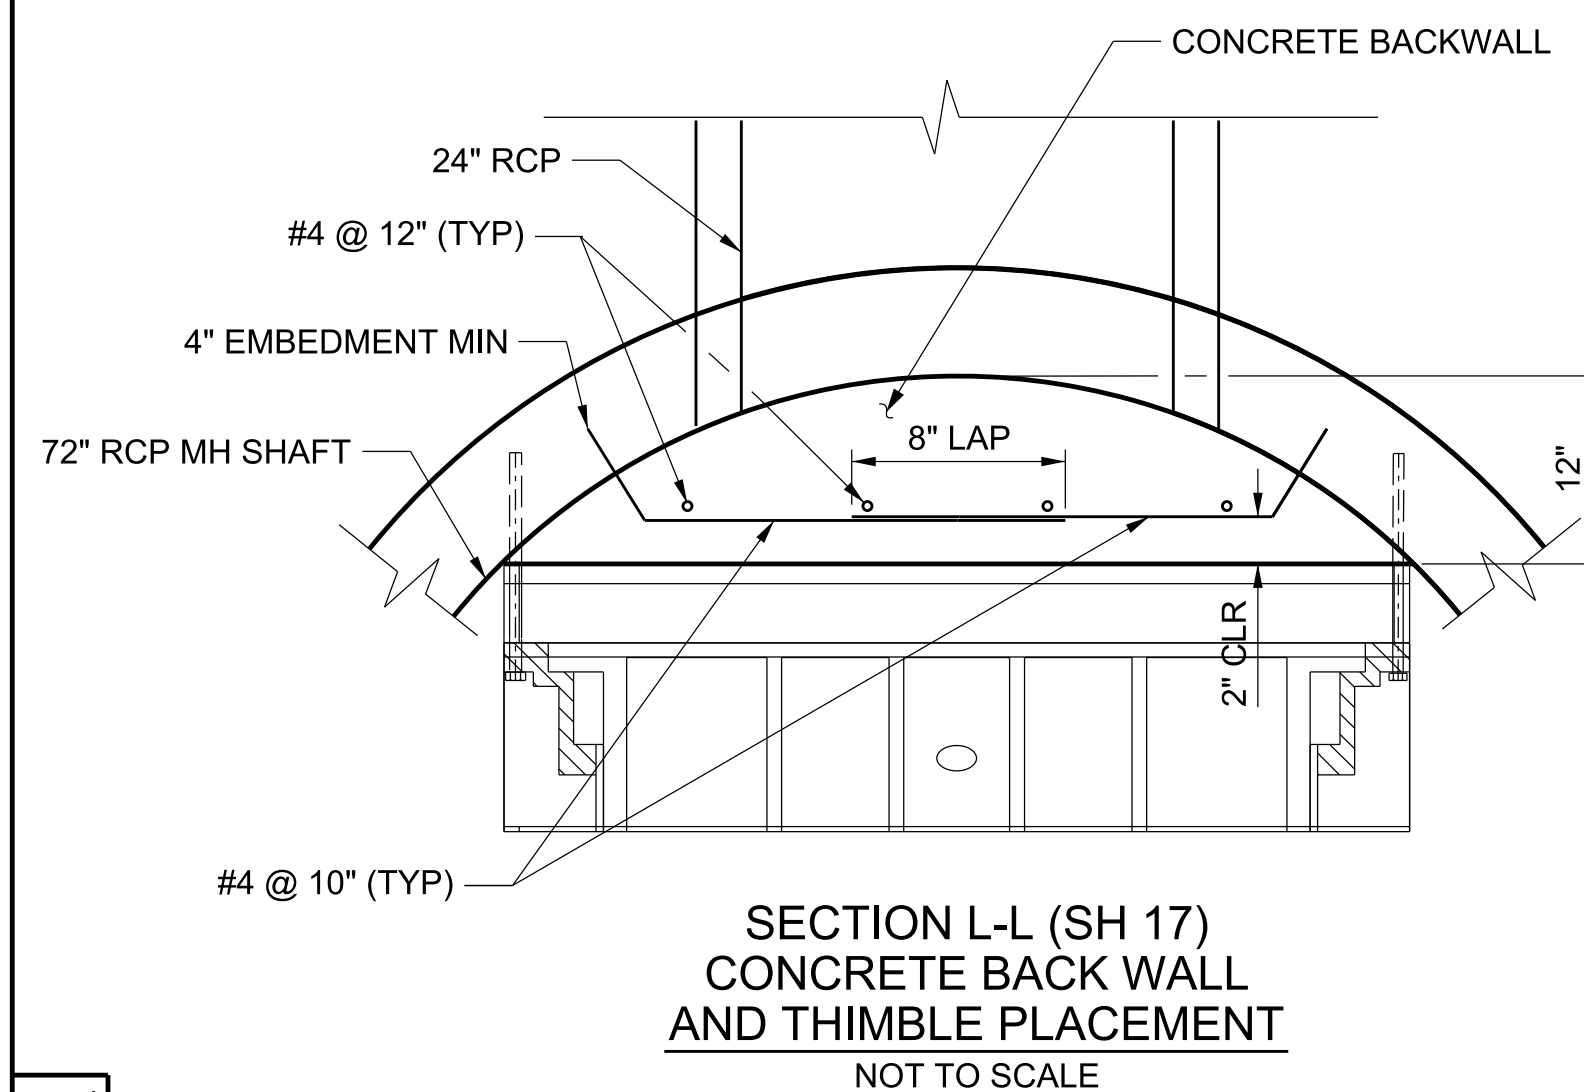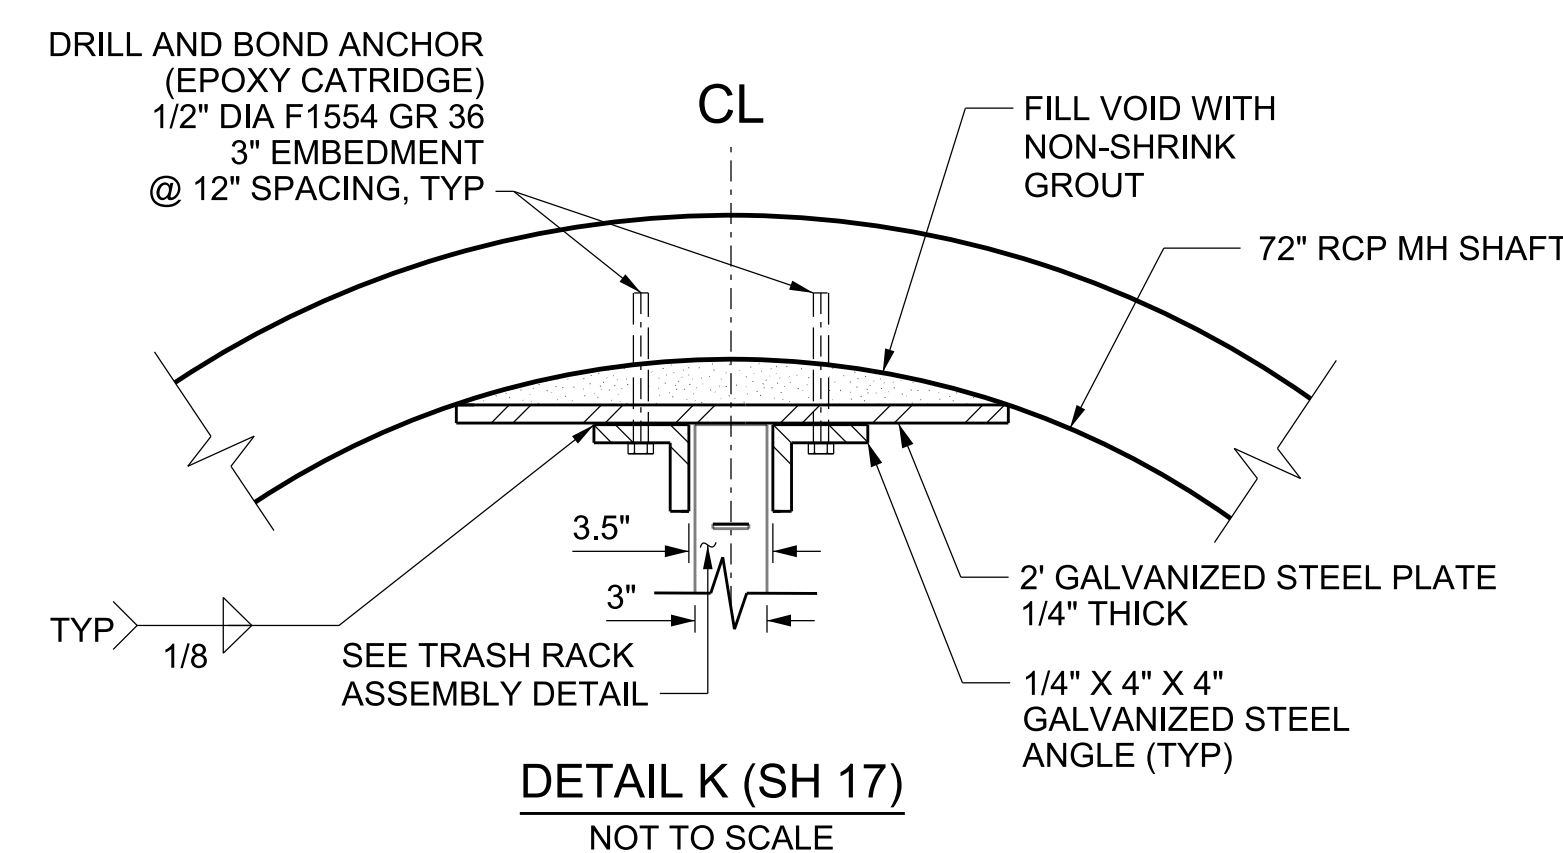

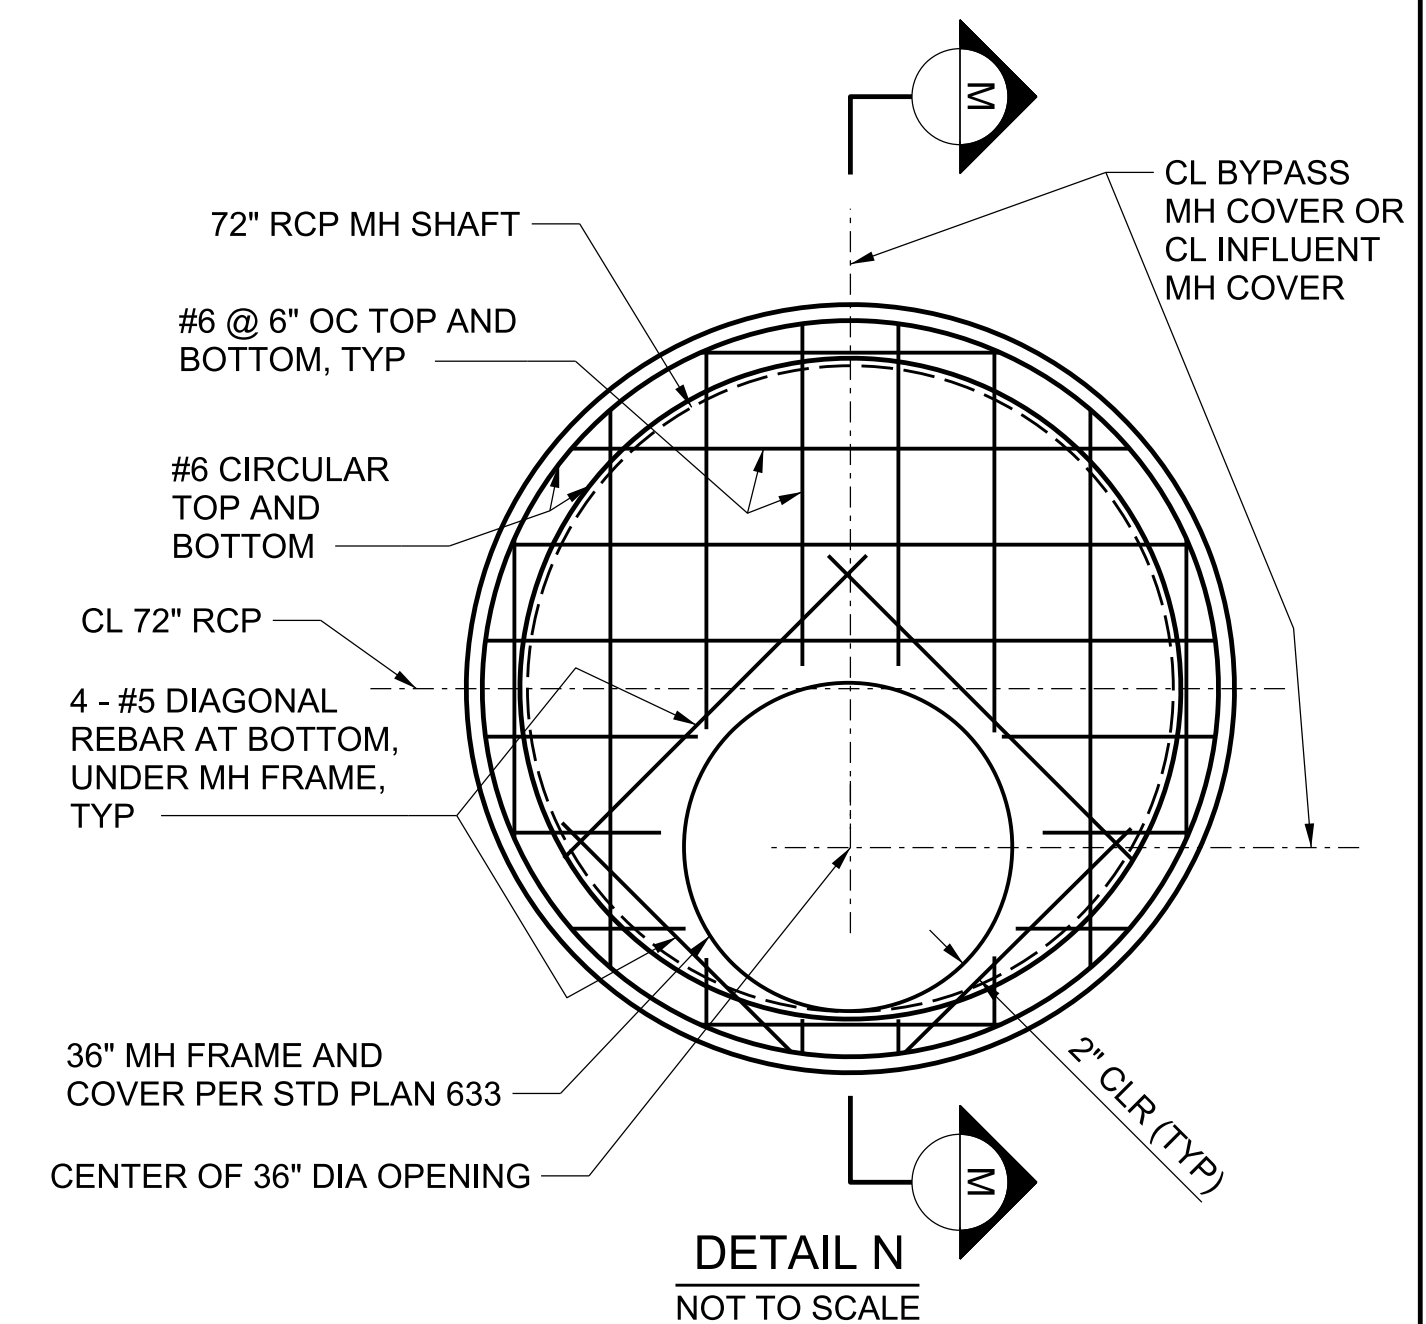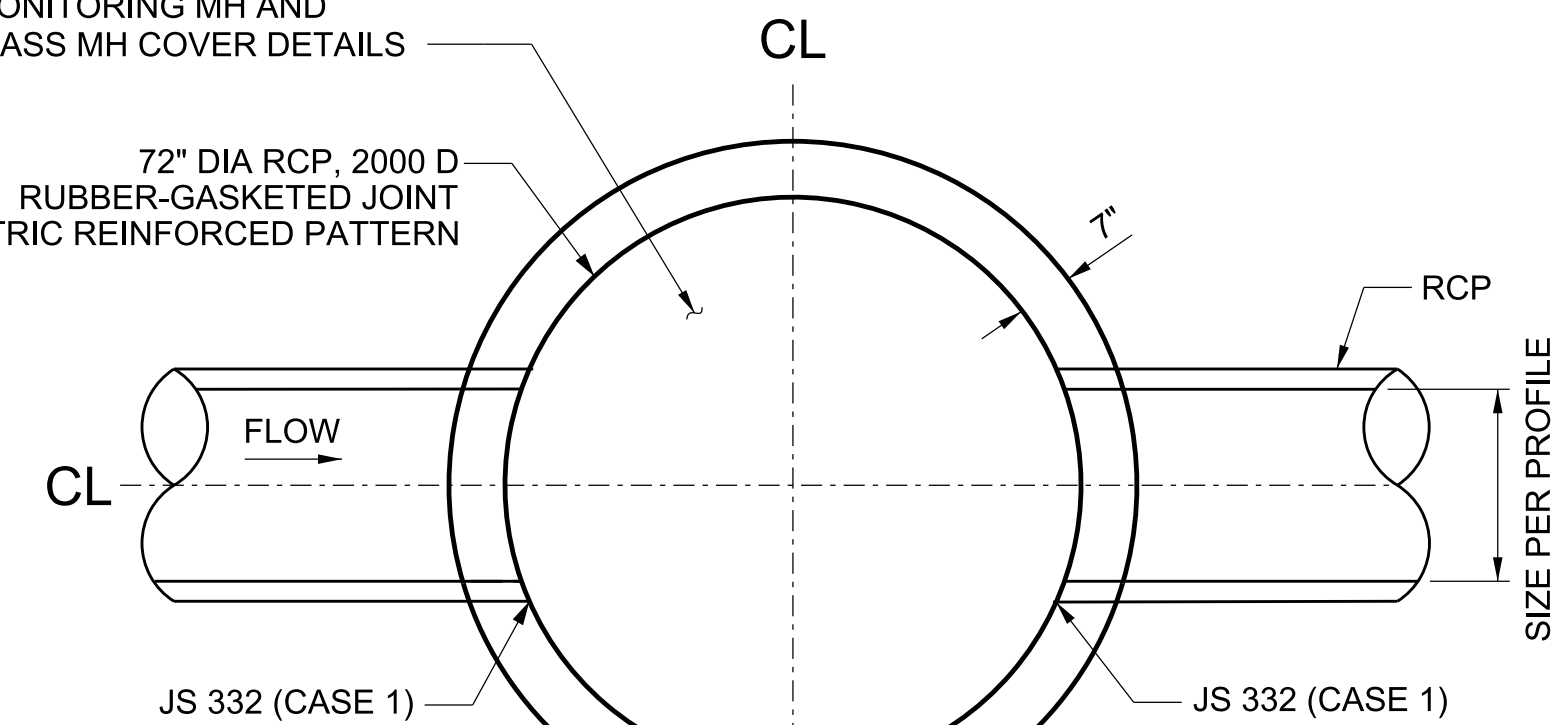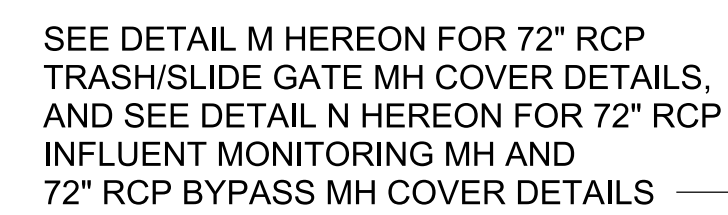

1. APPLICABLE FOR ALL MANHOLES THAT INCLUDE 72" RCP VERTICAL CASING.
2. MODIFY REBAR LAYOUT TO ACCOMMODATE PIPE CONNECTIONS.
3. MODIFY REBAR LAYOUT TO ACCOMMODATE BOX-OUTS FOR TRASH/SLIDE GATE MANHOLES.

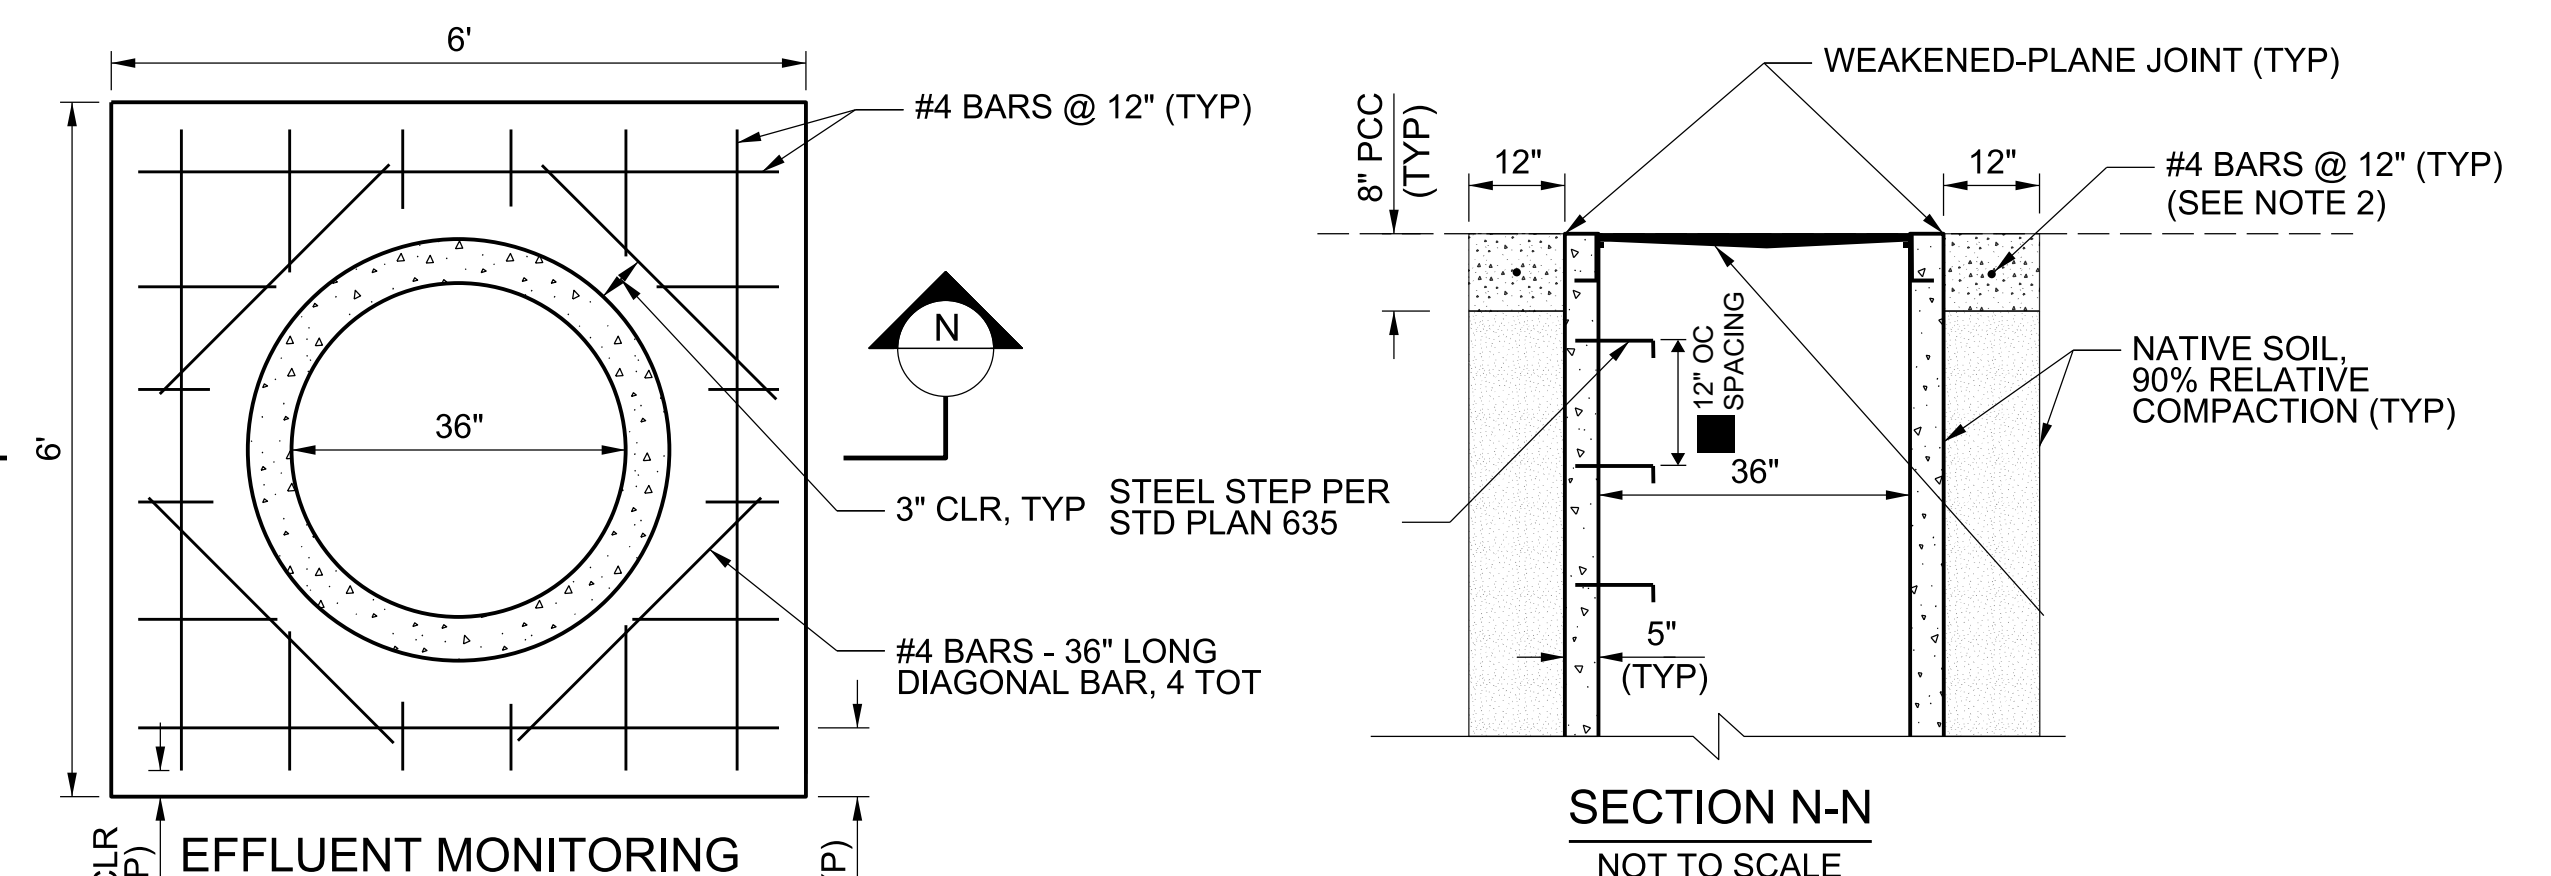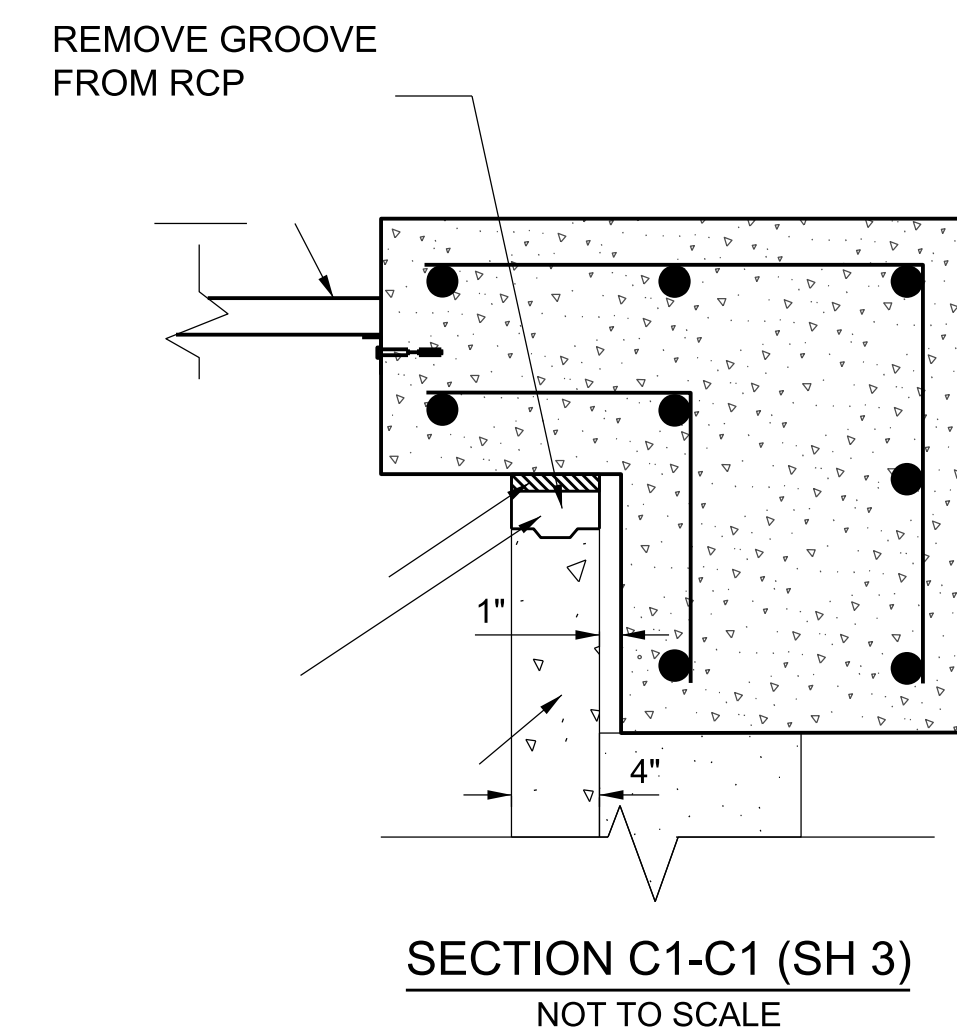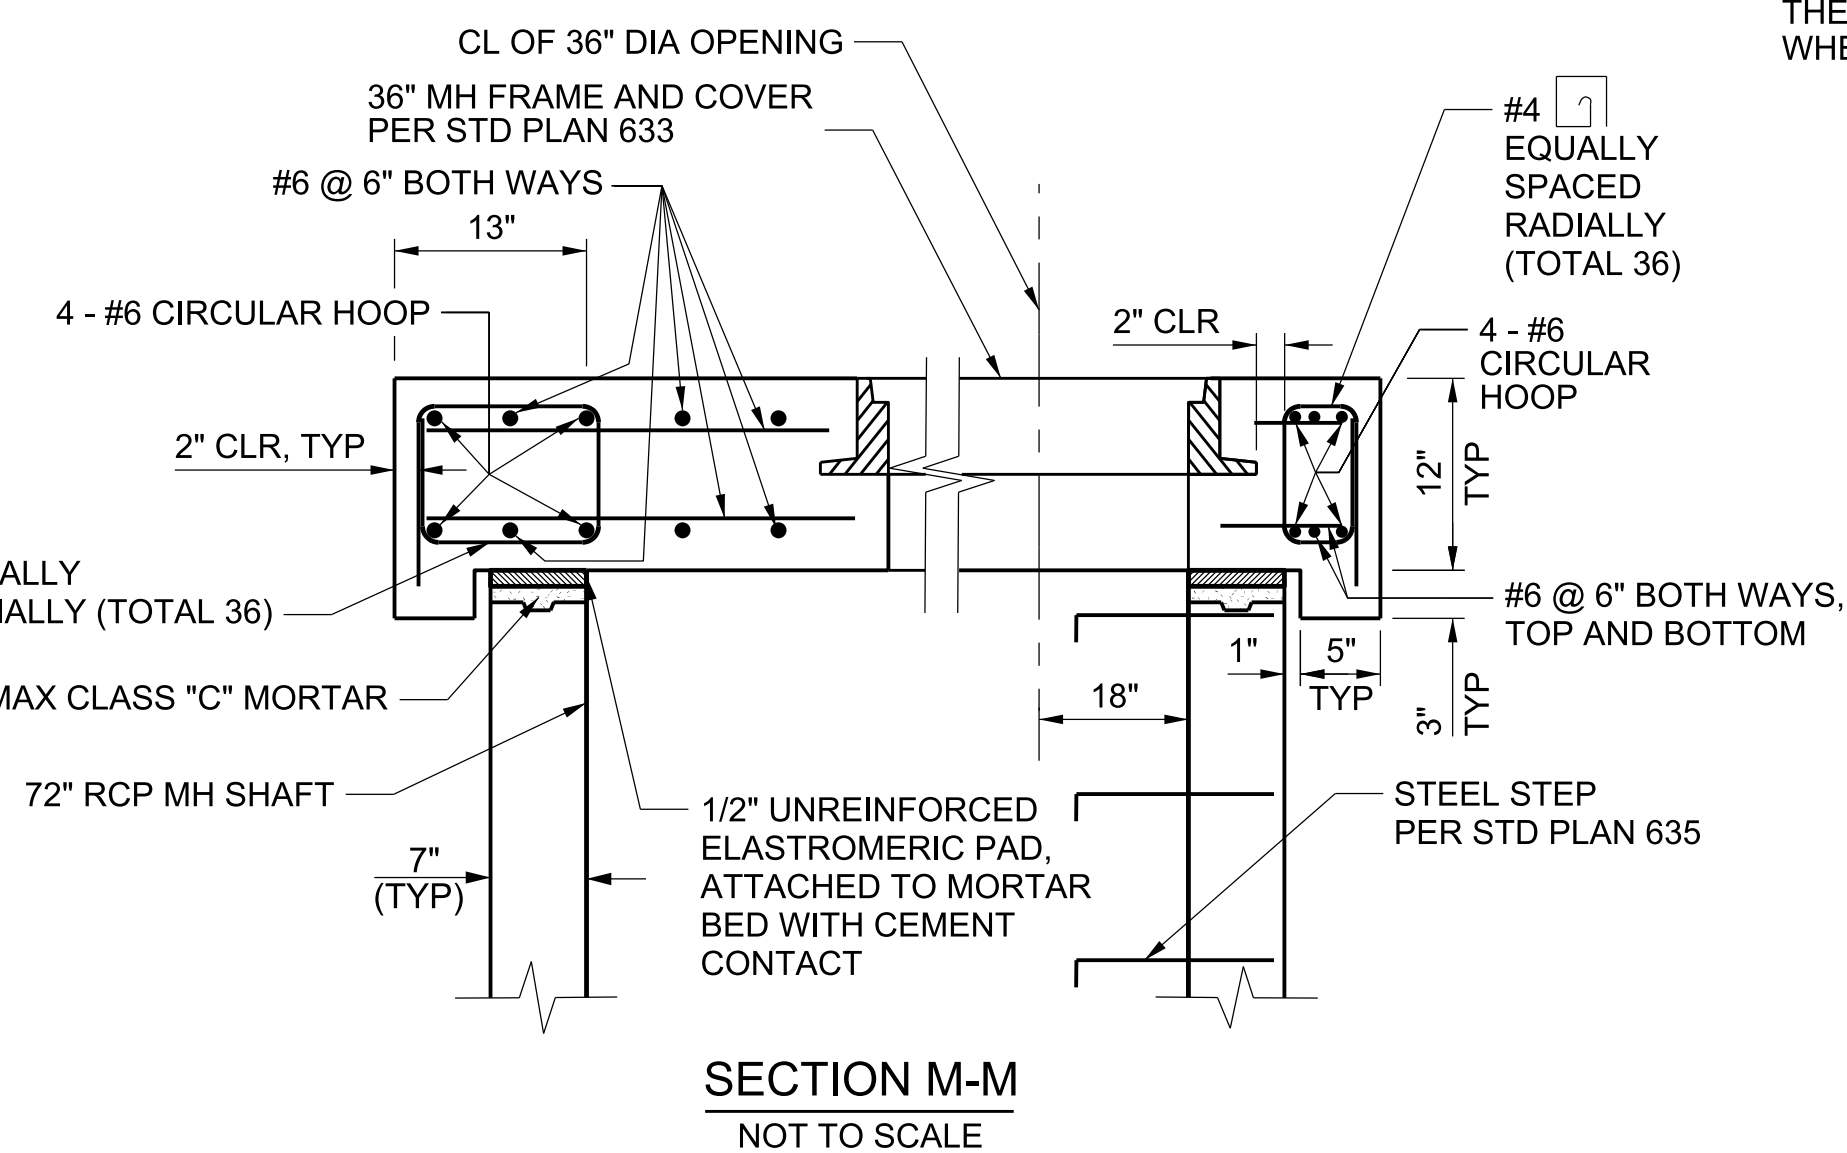


THE ENGINEER SHALL DETERMINE THE SIDE OF THE MANHOLE WHERE THE 36" DIAMETER OPENING IS TO BE LOCATED.



1. LOCATION OF THE STEEL STEP PER STD PLAN 635 SHALL BE DETERMINED BY THE ENGINEER.
2. CONCRETE CAP IS ONLY APPLICABLE FOR THE LOCATION SHOWN ON SHEET 6.

04/28/22		AS BUILT REVISIONS
11/04/20		UPDATED STEEL FRAME AND COVER DIMENSIONS.
DATE	MK	DESCRIPTION
REVISIONS		

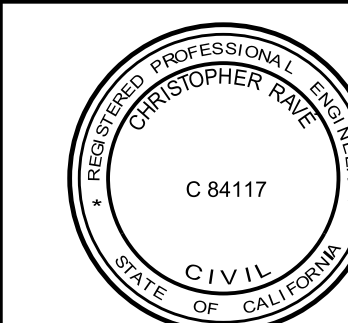

Chris Rane 07/10/18
PROJECT ENGINEER DATE

LOS ANGELES COUNTY PUBLIC WORKS			
<p align="center">EAST LOS ANGELES SUSTAINABLE MEDIAN STRUCTURAL CAPTURE PROJECT STRUCTURAL DETAILS AND SECTIONS</p> <p align="center">PROJECT ID NO. WMU0000010</p>			
8	LACFCD INDEX NO. 116-D27	PD0503092	SHEET 18 OF 26/27

Project: Montebello LMD Project Location: Unincorporated East Los Angeles PCA: F2181510			GEOTECHNICAL LOG OF BORING AND SAMPLING Los Angeles County Department of Public Works Geotechnical and Materials Engineering Division							
Boring No.: DW-1	Date(s) Drilled: 5/22/17	Logged by: JUJ, YG	Boring Diameter: 8 1/8 in.	Ground Elevation: ~184'	Page 1 of 4					
Boring Location: Intersection of Montebello Pkwy and Leonard Pl.			Drilled by: Gregg Drilling	Hammer Weight: 140 lbs.	Total Depth: 101'	Depth to Invert: 100 ft.				
Latitude & Longitude: 34.01671, -118.14447			Drilling Method: Hollow Stem Auger Equipment: CME-95	Drop Height: 30 in.	Depth to Groundwater: N/A	Depth to Bedrock: N/A				
DEPTH (FEET)	FIELD DATA		USCS	DESCRIPTION	LABORATORY TESTING					
	Sample No. (California Ring) Bulk Blow (ft)	Graphic Log			In-situ γ _d (pcf)	Sieve % Passing No. 200	LL	PI	Type of Test	
0				SILT medium stiff, reddish brown, slightly moist; no plasticity; dry turf grass at the surface.						
6	1R 2B	21/1522	ML	very stiff traces of medium to coarse grained SAND.						CR DS SE
10	3R	62/152		hard, dry.						DS
15	4R	28/50 per ft		some medium to coarse grained SAND.						
20	5R E20	19/3650 per ft	SM	SILTY SAND with GRAVEL very dense, reddish brown, dry; medium to coarse grained SAND; some fine to coarse GRAVEL.						CO
25	6R	26/762 per ft	SP	POORLY-GRADED SAND with GRAVEL very dense, orange brown, dry; fine to medium grained SAND; some fine to coarse GRAVEL; fragments of cobbles (~3" to 4" diameter); moderate cementation.						
30	7R	26/560 per ft	SW	WELL-GRADED SAND with GRAVEL very dense, orange brown, moist; fine to coarse grained SAND; some fine to coarse GRAVEL; fragments of cobbles (~3" to 4" diameter); moderate cementation.						
<div>LEGEND</div> <div><div><div>California Ring (2.5 in. OD) Sample</div><div>California Ring (3 in. OD) Sample</div><div>Bulk Sample</div></div><div><div>SPT (2 in. OD) Sample</div><div>Depth Encountered</div><div>Drilling Encountered</div><div>Coring Depth</div></div><div><div>Disturb Contact</div><div>Disturbation or Disturbance Contact</div><div>Dry Density</div><div>Moisture Content</div></div></div> <div>Types of Tests</div> <div><div>CO - Consolidation</div><div>CR - Corrosion</div><div>DS - Direct Shear</div><div>EI - Expansion Index</div><div>HY - Hydrometer</div><div>MD - Maximum Density</div><div>PE - Permeability</div><div>SA - Shear Analysis</div><div>SE - Sand Equivalence</div><div>TR - Triaxial</div></div>										
Note: This log contains observations and interpretations that are valid only for the specific date and location of the boring. Subsurface conditions vary between borings and with time. Material descriptions are derived using visual methods and may not agree with test results. Identifications based on laboratory testing.										

Project: Montebello LMD Project Location: Unincorporated East Los Angeles PCA: F2181510			GEOTECHNICAL LOG OF BORING AND SAMPLING Los Angeles County Department of Public Works Geotechnical and Materials Engineering Division							
Boring No.: DW-1	Date(s) Drilled: 5/22/17	Logged by: JUJ, YG	Boring Diameter: 8 1/8 in.	Ground Elevation: ~184'	Page 2 of 4					
Boring Location Intersection of Montebello Pkwy and Leonard Pl.		Drilled by: Gregg Drilling	Hammer Weight: 140 lbs.	Total Depth: 101'	Depth to Invert: 100 ft.					
Latitude & Longitude: 34.01671, -118.14447		Drilling Method: Hollow Stem Auger Equipment: CME-95	Drop Height: 30 in.	Depth to Groundwater: N/A	Depth to Bedrock: N/A					
DEPTH (FEET)	FIELD DATA		USCS	DESCRIPTION	LABORATORY TESTING					Type of Tests
	Standard Penetration Test Blow Count (SPT)	Graphic Log			In-situ γ _d (pcf)	Sieve % Passing MC (%)	No. 4 No. 200	LL	PI	
30	FR	20.38/50 per ft	SW							
35	BR	33/50 per ft		very dense, grey with brown and orange, dry.						
40	SL	40/50 per ft	SM	SILTY SAND with GRAVEL, very dense, tan with gray, dry, fine to coarse grained SAND, some angular fine to coarse GRAVEL, moderate cementation.						
45	ML	12/16/24	ML	SILT, hard, reddish brown, moist, no plasticity.						
50	SP	17/20/20	SP	POORLY-GRADED SAND, very dense, reddish brown, moist, fine to medium grained SAND, traces of fine GRAVEL.						
55	SM	15/19/21	SM	SILTY SAND, very dense, reddish brown, moist, fine to medium grained SAND, traces of fine to coarse GRAVEL.						
60	SW	22/30/36	SW	WELL-GRADED SAND with GRAVEL, very dense, reddish brown, moist, fine to medium grained SAND, little fine to coarse GRAVEL.						
<div>LEGEND</div> <div><div><div><div>California Ring (2.5 in. OD) Sample</div><div>California Ring (3 in. OD) Sample</div><div>Sample</div></div><div><div>SPT (2 in. OD) Sample</div><div>Sample</div><div>Sample</div></div></div><div><div>Depth to Invert</div><div>Seepage Encountered</div><div>Drilling Encountered</div><div>Grouting Encountered</div></div><div><div>District Contact</div><div>Unsaturation / Unsaturation Contact</div><div>Dry Density</div><div>Moisture Content</div></div><div><div>CO - Consolidation</div><div>CR - Corrosion</div><div>DS - Direct Shear</div><div>EI - Expansion Index</div></div><div><div>MD - Maximum Density</div><div>PE - Permeability</div><div>SA - Shear Analysis</div><div>SE - Sand Equivalence</div><div>TR - Triaxial</div></div></div> <div>Note: This log contains observations and interpretations that are valid only for the specific date and location of the boring. Subsurface conditions vary between borings and with time. Material descriptions are derived using visual classification methods and may vary from descriptions/notations based on laboratory testing.</div>										

Project: Montebello LMD Project Location: Unincorporated East Los Angeles PCA: F2181510			GEOTECHNICAL LOG OF BORING AND SAMPLING Los Angeles County Department of Public Works Geotechnical and Materials Engineering Division							
Boring No.: DW-1	Date(s) Drilled: 5/22/17	Logged by: JUJ, YG	Boring Diameter: 8 1/8 in.	Ground Elevation: ~184'	Page 3 of 4					
Boring Location: Intersection of Montebello Pkwy and Leonard Pl.	Drilled by: GREGG Drilling	Hammer Weight: 140 lbs.	Total Depth: 101'	Depth to Invert: 100 ft.						
Latitude & Longitude: 34.01671, -118.14447	Drilling Method: Hollow Stem Auger Equipment: CME-95	Drop Height: 30 in.	Depth to Groundwater: N/A	Depth to Bedrock: N/A						
DEPTH (FEET)	FIELD DATA	USCS	DESCRIPTION	LABORATORY TESTING					Type of Test	
				In-situ γ _d (pcf)	Sieve % Passing MC (%)	No. 4 No. 200	LL	PI		
60	2238/8 Bore log F	SW	orange brown, fine to medium grained SAND; some fine to coarse GRAVEL							
65	18/43/0									
70	2254/3	ML	SANDY SILT with GRAVEL, hard, orange brown, fine to medium grained SAND; little of fine GRAVEL; no plasticity							
75	4252 pw F	SW	WELL-GRADED SAND with GRAVEL, very dense, brown and tan, dry; fine to coarse grained SAND; some fine to coarse GRAVEL							
80	1465 pw F	SM	SILTY SAND; very dense, reddish brown, moist; fine to medium grained SAND							
85	13/4/28	SW	WELL-GRADED SAND with GRAVEL, very dense, brown and tan, dry; fine to coarse grained SAND; little fine to coarse GRAVEL							
90	18/18/3	ML	SANDY SILT, hard, orange brown, moist, fine grained SAND; no plasticity							
95		SW	WELL-GRADED SAND with GRAVEL, very dense, brown and tan, dry; fine to coarse grained SAND; little fine to coarse GRAVEL							
100		ML								
<div>LEGEND</div> <div><div><div>California Ring (2.5 in. OD) Sample</div><div>California Ring (3 in. OD) Sample</div><div>SPT (2 in. OD) Sample</div><div>Sample</div><div>Sample</div></div><div><div>Depth to Invert</div><div>Seepage Encountered</div><div>Drilling Encountered</div><div>Groundwater Encountered</div></div><div><div>District Contact</div><div>Ordination or Unofficial Contact</div><div>Y_d Density</div><div>MC Moisture Content</div></div><div><div>Types of Tests</div><div>CO - Consolidation</div><div>CR - Corrosion</div><div>DS - Direct Shear</div><div>EI - Expansion Index</div><div>MD - Maximum Density</div><div>PE - Permeability</div><div>SA - Shear Analysis</div><div>SE - Sand Equivalence</div><div>TR - Triaxial</div></div></div> <div>Note: This log contains observations and interpretations that are valid only for the specific date and location of the boring. Subsurface conditions may vary between borings and with time. Detailed description of test methods and test results from test results/observations based on laboratory testing.</div>										

Project: Montebello LMD Project Location: Unincorporated East Los Angeles PCA: F2181510				GEOTECHNICAL LOG OF BORING AND SAMPLING Los Angeles County Department of Public Works Geotechnical and Materials Engineering Division					
Boring No.: DW-1		Date(s) Drilled: 5/22/17	Logged by: JJJ, YG	Boring Diameter: 8 1/8 in.		Ground Elevation: ~184'	Page 4 of 4		
Boring Location: Intersection of Montebello Pkwy and Leonard Pl.		Drilled by: Gregg Drilling		Hammer Weight: 140 lbs.		Total Depth: 101'	Depth to Invert: 100 ft.		
Latitude & Longitude: 34.01671, -118.14447		Drilling Method: Hollow Stem Auger Equipment: CME-95		Drop Height: 30 in.		Depth to Groundwater: N/A	Depth to Bedrock: N/A		
DEPTH (FEET)	FIELD DATA		USCS	DESCRIPTION	LABORATORY TESTING				
	Sample No.	Graphic Log			In-situ <i>(γ_d)</i>	Sieve % Passing No. 200	LL	PI	Type of Test
90	108	11/3/31	ML	SANDY SILT; hard, orange brown, moist; fine to medium grained SAND; no plasticity.					
95		11/3/40	SP	POORLY-GRADED SAND; very dense, tan, moist; fine to medium grained SAND; traces of fine to coarse GRAVEL.					
100	108	2650 per ft	SW	WELL-GRADED SAND with GRAVEL; very dense, tan, dry; fine to coarse grained SAND; some fine to coarse GRAVEL.					
105				End of boring at 101'; boring terminated at planned depth, no groundwater was encountered.					
110									
115									
120									
<div>LEGEND</div> <div><div><div>California Ring (2.5 in. OD) Sample</div><div>California Ring (3 in. OD) Sample</div><div>Bulk Sample</div></div><div><div>SPT (2 in. OD) Sample</div><div>Drilling Encountered</div><div>Groundwater Encountered</div></div><div><div>Depth to Invert</div><div>Seepage Encountered</div><div>Drilling Method</div></div><div><div>District Contact</div><div>Disturbance or Discontinuity Contact</div><div>Y_r Dry Density</div><div>M_c Moisture Content</div></div></div> <div>Types of Tests</div> <div><div>CO - Consolidation</div><div>CR - Corrosion</div><div>DS - Direct Shear</div><div>EI - Expansion Index</div></div> <div><div>MD - Maximum Density</div><div>PE - Permeability</div><div>SA - Shear Analysis</div><div>SE - Sand Equivalence</div><div>TR - Triaxial</div></div>									
Note: This log contains observations and interpretations that are valid only for the specific date and location of the boring. Subsequent conditions may vary between borings and with time. Material descriptions are derived using visual classification methods and may vary from spectroscopic classifications based on laboratory testing.									

Project: Montebello LMD Project Location: Unincorporated East Los Angeles PCA: F2181510				GEOTECHNICAL LOG OF BORING AND SAMPLING Los Angeles County Department of Public Works Geotechnical and Materials Engineering Division					
Boring No.: DW-2	Date(s) Drilled: 5/23/17	Logged by: JUJ, YG	Boring Diameter: 8 1/8 in.	Ground Elevation: ~182'	Page 1 of 4				
Boring Location: Intersection of Montebello Pkwy and Leonard Pl. (North-South)		Drilled by: Gregg Drilling	Hammer Weight: 140 lbs.	Total Depth: 101'	Depth to Invert: 100 ft.				
Latitude & Longitude: 34.01621, -118.14912		Drilling Method: Hollow Stem Auger Equipment: CME-95	Drop Height: 30 in.	Depth to Groundwater: N/A	Depth to Bedrock: N/A				
DEPTH (FEET)	FIELD DATA	USCS	DESCRIPTION	LABORATORY TESTING					Type of Test
				In-situ γ _d (pcf)	Sieve % Passing M ₅₀ (%)	LL No. 200	PI		
0			SILT, soft, brown, dry, no plasticity, dry turf grass at the surface.						
5	1R 2B		reddish brown.						CR DS SE
10	3R		hard, slightly moist; traces of fine to medium grained SAND.						
15	4R	SP	POORLY-GRADED SAND, very dense, light brown, dry, fine to medium grained SAND; traces of fine GRAVEL.						
20	5R E20	SM	SILTY SAND, very dense, reddish brown and tan, dry, fine to medium grained SAND.						CO
25	6R	ML	SANDY SILT, hard, reddish brown and tan, dry, fine grained SAND; traces of fine GRAVEL; no plasticity.						
30	7R	SW	WELL-GRADED SAND with GRAVEL, very dense, brown and tan, dry, fine to coarse grained SAND, little fine to coarse GRAVEL.						
intervals of GRAVEL between 25' to 55'.									
<div>LEGEND</div> <div><div><div><div>California Ring (2.5 in. OD) Sample</div><div>California Ring (3 in. OD) Sample</div></div><div><div>SPT (2 in. OD) Sample</div><div>γ_d Bulk Sample</div></div></div><div><div>Depth to Invert</div><div>Seepage Encountered</div><div>Coring Difficulty</div><div>Drilling Encountered</div></div><div><div>District Contact</div><div>Overburden Contact</div><div>γ_d Dry Density</div><div>M₅₀ Moisture Content</div></div></div> <div>Types of Tests</div> <div><div>CO - Consolidation</div><div>CR - Corrosion</div><div>DS - Direct Shear</div><div>EI - Expansion Index</div><div>HY - Hydrometer</div><div>MD - Maximum Density</div><div>PE - Permeability</div><div>SA - Shear Analysis</div><div>SE - Sand Equivalence</div><div>TR - Triaxial</div></div> <div>Note: This log contains observations and interpretations that are valid only for the specific date and location of the boring. Subsequent observations only between borings and with time.</div> <div>General descriptions are derived using visual classification methods and may vary from descriptions classifications based on laboratory testing.</div>									

Project: Montebello LMD Project Location: Unincorporated East Los Angeles PCA: F2181510				GEOTECHNICAL LOG OF BORING AND SAMPLING Los Angeles County Department of Public Works Geotechnical and Materials Engineering Division							
Boring No.: DW-2	Date(s) Drilled: 5/23/17	Logged by: JUJ, YG	Boring Diameter: 8 1/8 in.	Ground Elevation: ~182'	Page 2 of 4						
Boring Location: Intersection of Montebello Pkwy and Leonard Pl. (North-South)			Drilled by: Gregg Drilling	Hammer Weight: 140 lbs.	Total Depth: 101'	Depth to Invert: 100 ft.					
Latitude & Longitude: 34.01621, -118.14912			Drilling Method: Hollow Stem Auger Equipment: CME-95	Drop Height: 30 in.	Depth to Groundwater: N/A	Depth to Bedrock: N/A					
DEPTH (FEET)	FIELD DATA		USCS	DESCRIPTION	LABORATORY TESTING					Type of Test	
	Sample No. (Soils)	Soils (Soils)			In-situ (Yd)	MC (%)	Sieve % Passing (No.)	LL	PI		
30	7R	13/2850	SW	WELL-GRADED SAND with GRAVEL, very dense, brown and tan, dry, fine to coarse grained SAND; little fine to coarse GRAVEL.							
35	8R	13/1421	SP	POORLY-GRADED SAND, dense, reddish brown and tan, dry, fine to medium grained SAND; traces of fine to coarse GRAVEL.						CO	
40	9R	27/6198	SM	SILTY SAND with GRAVEL, dense, reddish brown and tan, slightly moist, fine to coarse grained SAND; some fine to coarse GRAVEL; fragments of cobbles (~3" diameter).							
45	10R	23/5050	SW	WELL-GRADED SAND with GRAVEL, very dense, brown and gray, dry, fine to coarse grained SAND; little fine to coarse GRAVEL.							
50	11R	14/2847		brown and tan; traces of fine to coarse GRAVEL.							
55	12R	11/2428	ML	SANDY SILT, hard, reddish brown and tan, dry, fine to coarse grained SAND; traces of fine to coarse GRAVEL.							
60	13R	10/2250	SM	SILTY SAND, very dense, reddish brown, moist, fine to coarse grained SAND.							
LEGEND											
California Ring (2.5 in. OD) Sample				SPT (2 in. OD) Sample		Depth to Invert		District Contact		Types of Tests	
California Ring (3 in. OD) Sample				Bulk Sample		Seepage Encountered		Crustal or Unconformity Contact		CO - Consolidation	
						Dry Density		Dry Density		MD - Maximum Density	
						Moisture Encountered		Moisture Content		CR - Corrosion	
										PE - Permeability	
										DS - Direct Shear	
										EI - Expansion Index	
										SA - Shear Analysis	
										SE - Sand Equivalence	
										HY - Hydrometer	
										TR - Triaxial	
Note: This log contains observations and interpretations that are valid only for the specific date and location of the boring. Subsurface conditions vary between borings and with time. General descriptions are derived using visually-determined methods and may vary from descriptions/classifications based on laboratory testing.											

Project: Montebello LMD Project Location: Unincorporated East Los Angeles PCA: F2181510				GEOTECHNICAL LOG OF BORING AND SAMPLING Los Angeles County Department of Public Works Geotechnical and Materials Engineering Division								
Boring No.: DW-2		Date(s) Drilled: 5/23/17		Logged by: JUJ, YG		Boring Diameter: 8 in.		Ground Elevation: ~182'		Page 3 of 4		
Boring Location: Intersection of Montebello Pkwy and Leonard Pl. (North-South)				Drilled by: Gregg Drilling		Hammer Weight: 140 lbs.		Total Depth: 101'		Depth to Invert: 100 ft.		
Latitude & Longitude: 34.01621, -118.14912				Drilling Method: Hollow Stem Auger Equipment: CME-95		Drop Height: 30 in.		Depth to Groundwater: N/A		Depth to Bedrock: N/A		
DEPTH (FEET)	FIELD DATA		USCS	DESCRIPTION	LABORATORY TESTING						Type of Test	
	Sample No.	Soils Test Per 5' (in) B.A.R.			Y _c / pcf	MC % #	In-situ ft Passing No.	LL %	PI %			
60	14R	140123 per 5'	SM	SILTY SAND; very dense, reddish brown, moist, fine to coarse grained SAND.								
65	15R	140123 5/23/17	SW	WELL-GRADED SAND; very dense, reddish brown and tan, dry, fine to coarse grained SAND.								
70	16R	69917	ML	SILT; medium stiff, reddish brown, dry; traces of medium to coarse grained SAND; little to no plasticity.								
				Intervals of GRAVEL between 70' to 80'.								
75	17R	91925	SM	SILTY SAND; dense, reddish brown, moist, medium to coarse grained SAND; traces of fine to coarse GRAVEL; moderate cementation.								
80	18R	2150 per 5'	SW	WELL-GRADED SAND with GRAVEL; very dense, reddish brown, dry, fine to coarse grained SAND; some fine to coarse GRAVEL; moderate cementation.								
85	19R	21202	SP	POORLY-GRADED SAND; very dense, reddish brown, moist, fine to medium grained SAND; moderate cementation.								
90	20R	152330		light brown, dry; traces of fine GRAVEL; weak cementation.								
LEGEND												
California Ring (2.5 in. OD) Sample				SPT (2 in. OD) Sample				Types of Tests				
California Ring (3 in. OD) Sample				Bulk Sample				CO - Consolidation				
California Ring (4 in. OD) Sample				Drilling Encountered				CR - Corrosion				
				Dry Density				DS - Direct Shear				
				Moisture Content				EI - Expansion Index				
								SE - Sand Equivalence				
								HY - Hydrometer				
								MD - Maximum Density				
								PE - Permeability				
								SA - Shear Analysis				
								TR - Triaxial				
Note: This log contains observations and interpretations that are valid only for the specific date and location of the boring. Subsurface conditions may vary between borings and with time. Detailed interpretations are developed using visual classification methods and may vary from descriptions/classifications based on laboratory testing.												

Project: Montebello LMD Project Location: Unincorporated East Los Angeles PCA: F2181510			GEOTECHNICAL LOG OF BORING AND SAMPLING Los Angeles County Department of Public Works Geotechnical and Materials Engineering Division						
Boring No.: DW-2	Date(s) Drilled: 5/23/17	Logged by: JUJ, YG	Boring Diameter: 8 / 18 in.	Ground Elevation: ~182'	Page 4 of 4				
Boring Location: Intersection of Montebello Pkwy and Leonard Pl. (North-South)	Drilled by: Gregg Drilling	Hammer Weight: 140 lbs.	Total Depth: 101'	Depth to Invert: 100 ft.					
Latitude & Longitude: 34.01621, -118.14912	Drilling Method: Hollow Stem Auger Equipment: CME-95	Drop Height: 30 in.	Depth to Groundwater: N/A	Depth to Bedrock: N/A					
DEPTH (FEET)	FIELD DATA	USCS	DESCRIPTION	LABORATORY TESTING					Type of Test
				γ_d (pcf)	MC (%)	LL (%)	PI		
90	21R 15/23/30	SP	SILT, stiff, reddish brown, moist, low plasticity.						
95	16R 14/13/14	ML							
100	17R 15/20/31	SP	POORLY GRADED SAND; very dense, brown and tan, dry, fine to medium grained SAND.						
		ML	SANDY SILT, hard, reddish brown, dry, fine grained SAND; no plasticity.						
105			End of boring at 101'; boring terminated at planned depth, no groundwater was encountered.						
110									
115									
<div>LEGEND</div> <div>California Ring (2.5 in. OD) Sample SPT (2 in. OD) Sample Depth to Invert District Contact Types of Tests: CO - Consolidation, MD - Maximum Density, CR - Corrosion, PE - Permeability, DS - Direct Shear, SA - Shear Analysis, EI - Expansion Index, SE - Sand Equivalence, HY - Hydrometer, TR - Triaxial</div> <div>California Ring (3 in. OD) Sample Bulk Sample Drilling Encountered Dry Density Moisture Content </div>									
Note: This log contains observations and interpretations that are valid only for the specific date and location of the boring. Subsequent conditions vary between borings and with time. Material descriptions are derived using visual classification methods and may vary from descriptions/classifications based on laboratory testing.									








 



CADD PROJECT FILE NAME

CHECKER

DESIGNER
C. RAVE

DRAFTER
C. RAVE

04/28/22	AS BUILT REVISIONS
DATE	DESCRIPTION
	REVISIONS


Project: Montebello LMD				GEOTECHNICAL LOG OF BORING AND SAMPLING								
Project Location: Unincorporated East Los Angeles				Los Angeles County Department of Public Works								
PCA: F21851510				Geotechnical and Materials Engineering Division								
Boring No.: DW-4		Date(s) Drilled: 5/30/17		Logged by: JUJ, YG		Boring Diameter: 8 / 18 in.						
Boring Location: at West of 90th, Northside Dr.		Drilled by: Gregg Drilling		Hammer Weight: 140 lbs		Ground Elevation: ~101'						
Latitude & Longitude: 34.01488, -118.142377		Drilling Method: Hollow Stem Auger Equipment: CME-85		Total Depth: 101'		Depth to Invert: 100'						
				Drop Height: 30 in.		Depth to Groundwater: N/A						
						Depth to Bedrock: N/A						
FIELD DATA				LABORATORY TESTING								
DEPTH (FEET)	Sample No.	Soil Bank	Graphic Log	USCS	DESCRIPTION	In-situ				Sieve % Passing		Type of Test
						γ_d (pcf)	MC (%)	NC (%)	LL	PI		
0				ML	SILT; medium stiff, reddish brown, dry, no plasticity, turf grass on the surface.							
5	1R	8/13/18			stiff; traces of medium to coarse grained SAND; traces of fine GRAVEL							
10	3R	8/13/20			traces of fine to medium grained SAND.							
15	4R	17/25/32		SM	SILTY SAND; very dense, brown, dry; fine to medium grained SAND; traces of fine GRAVEL							
20	5R	15/30/37		ML	SILT; hard, reddish brown, dry; traces of medium to coarse grained SAND; traces of fine GRAVEL, no plasticity.							
25	6R	19/36/37			low plasticity							
30		25/50 for 6"		SM	SILTY SAND with GRAVEL; very dense, tan and reddish brown, dry; fine to coarse grained SAND, little of fine GRAVEL; moderate cementation.							
intervals of GRAVEL from 25' to 35'												
LEGEND												
 Sample  Sample  Sample  Seepage Encountered  Coring Filling  Gravelly Encountered  Caving Drilling						 District Contact  Crustal or Unsaturation Contact  City Boundary  MC - Moisture Control						
						Types of Tests CO - Consolidation MD - Maximum Density CR - Compression FE - Permeability EC - Direct Shear SA - Stress Analysis E - Expansion Index SE - Sand Equivalence IS - Triaxial TS - Triaxial						


Note: This log contains observations and interpretations that are valid only for the specific date and location of the boring. Subsurface conditions vary between borings and with time. Material descriptions are derived using visual classification methods and may vary from description classifications based on laboratory testing.









Project: Montebello LMD				GEOTECHNICAL LOG OF BORING AND SAMPLING					
Project Location: Unincorporated East Los Angeles				Los Angeles County Department of Public Works					
PCA: F2181510				Geotechnical Materials Engineering Division					
Boring No. DW-4		Dates: Drilled 5/30/17	Logged by JUJ, YG	Boring Diameter 8' 18 in.	Ground Elevation ~179'	Page 2	of 4		
Boring Location in front of 3001 Normandie Dr.		Drilled by Gregg Drilling	Hammer Weight 140 lbs	Total Depth 101'	Depth to Invert 100'	100'			
Latitude & Longitude 34.01488, -118.14257		Drilling Method: Hollow Stem Auger Equipment: CME-95	Drop Height 30 in.	Depth to Groundwater: N/A	Depth to Bedrock: N/A				
FIELD DATA				LABORATORY TESTING					
DEPTH (FEET)	Sample No.	Soil Description (See Log P. 1)	USGS Graphic Log	In-situ					Type of Test
				γ_e (pcf)	MC (%)	NC (%)	LL	PI	
30	7R	POORLY-GRADED SAND with GRAVEL, very dense, tan, dry, fine to medium grained SAND, little fine to coarse GRAVEL, moderate cementation.	SP						
35	8R	WELL-GRAINED SAND with GRAVEL, very dense, brown and tan, dry, fine to coarse GRAINED SAND, some fine to coarse GRAVEL.	DW						
40	9R	SILT, hard, brown, dry, traces of fine to medium grained SAND, no plasticity.	ML						
45	10R	traces of medium to coarse grained SAND.							
45	10B	medium stiff, moist.							
50		WELL-GRAINED SAND with GRAVEL, very dense, brown and tan, dry, fine to coarse GRAINED SAND, little fine to coarse angular GRAVEL.	DW						
55		SILT, hard, reddish brown, slightly moist; traces of fine grained SAND, no plasticity.	ML						
60		moist, low plasticity.							
LEGEND									
Distinct Contact				Gradational or Diffuse Contact					
Dry (clayey) or Moist (clayey)				MC - Moisture Content					
SPT (2 in. OD) Sample				SPT (2 in. OD) Sample					
SPT (2 in. OD) Sample				SPT (2 in. OD) Sample					
SPT (2 in. OD) Sample									

Project: Montebello LMD					GEOTECHNICAL LOG OF BORING AND PUBLISHING WORKS											
Project Location: Unincorporated East Los Angeles					Los Angeles County Department of Public Works Geotechnical and Materials Engineering Division											
PCA: F2181510		Monitoring Well Installed (Yes) No														
Boring No.: DW-4		Dates Drilled: 5/30/17		Logged by: JUJ, YG		Boring Diameter: 8 / 18 in.		Ground Elevation: ~179'		Page 3 of 4						
Boring Location: in front of 2101 Normandie Dr.				Drilled by: Gregg Drilling		Hammer Weight: 140 lb		Total Depth: 101'		Depth to Invert: 100'						
Latitude & Longitude: 34.5488, -118.1437				Drilling Method: Hollow Stem Auger Equipment: CME-95		Drop Height: 30 in.		Depth to Groundwater: N/A		Depth to Bedrock: N/A						
DEPTH (FEET)		FIELD DATA		LABORATORY TESTING												
Sample No.	Soil Type	Blow Count (blows ft.)	Graphic Log	USCS	DESCRIPTION	In-situ				Swave		LL	PI	Type of Test		
						γ_d (pcf)	MC (%)	C _u (No)	% Passing							
60	11E	5/1423		ML	SANDY SILT; very stiff, reddish brown, dry, fine to medium grained SAND; no plasticity											
65	E60	6/1628		GP	POORLY-GRADED SAND; dense, orange brown, dry, fine to medium grained SAND.											
70		32/1675		(WELL WITH WELL-GRADED SAND lens (~6" thick); hard gray brown moist. SILT-WITH GRADED SAND WITH GRAVEL; tan, dry; fine to coarse grained SAND, some coarse angular GRAVEL), no plasticity												
75		9/1116		very stiff, reddish brown, dry; traces of medium to coarse grained SAND; traces of fine GRAVEL												
80	12B	28/50 #4"		SM	SILTY SAND; very dense, reddish brown and tan, moist; fine to medium grained SAND; traces of fine to coarse GRAVEL; moderate cementation.											
85	E90	173/395 #4"		SILT (~1") thick lens at 85'; hard, brown, slightly moist no plasticity.												
90		22/1847	GP	POORLY-GRADED SAND; very dense, tan and orange, dry; medium to coarse grained SAND.												
<div style="text-align: center;">LEGEND</div> <div style="display: flex; justify-content: space-between;"><div><p>California Ring (2.5 in OD) Sample</p><p>SPT (ft. in 0.0) Sample</p><p>Cast-in-place Ring (3 in OD) Sample</p></div><div><p>Depth to Invert</p><p>Seepage Encountered</p><p>Gauging Encountered</p><p>Drying Device</p></div><div><p>Distorted Contact</p><p>Gravelly or Grout-filled Contact</p><p>Dry Density</p><p>M₂- Moisture Content</p></div><div><p>Types of Tests</p><p>CO - Consolidation</p><p>CR - Compression</p><p>DS - Direct Shear</p><p>EV - Expansion Index</p><p>HY - Hydrocarbon</p><p>MO - Maximum Density</p><p>PE - Permeability</p><p>SA - Stress Analysis</p><p>TS - Triaxial</p></div></div>																
Note: This log contains observations and interpretations that are valid only for the specific date and location of the boring. Subsurface conditions vary among borings and over time. Material descriptions are derived using classification methods and may vary from descriptive classifications based on laboratory testing.																

Project: Montebello LMD Project Location: Unincorporated East Los Angeles PCA: F2181510				GEOTECHNICAL LOG OF BORING AND PUBLIC WORKS Los Angeles County Department of Public Works Geotechnical and Materials Engineering Division					
Boring No.: DW-4		(Date) Drilled 5/25/17	Logged by JUJ_YG	Boring Diameter 8 / 18 in.	Ground Elevation ~179'	Page 4 of 4	100'		
Boring Location In front of 2811 Normandie Dr.		Drilled by Gregg Drilling		Hammer Weight 140 lbs	Total Depth 101'	Depth to Invert 100'	100'		
Latitude & Longitude 34.01488, -118.14377		Drilling Method: Hollow Stem Auger Equipment: CME-95		Drop Height 30 in.	Depth to Groundwater N/A	Depth to Bedrock N/A	N/A		
DEPTH (FEET)	FIELD DATA			DESCRIPTION	LABORATORY TESTING				
	Sample No.	Soil Bank Type & Size	Geoplot Log		UCS	In-situ			
						Y _p (psi)	MC (%)	SI (%)	LL (%)
90		223047		SP					
				CL					
95		618/03		SW					
100		750 per 5'		ML					
105									
110									
115									
120									
<div><div><div>California Ring (2.5 in. OD) Sample</div><div>California Ring (3 in. OD) Sample</div></div><div><div>SPT (2 in. OD) Sample</div><div>Soil Bank Sample</div></div><div><div>Depth to Invert</div><div>Seepage Encountered</div><div>Coring Intact</div><div>Disturbance Encountered</div></div><div><div>Distinct Contact</div><div>Gradational Contact</div><div>Discontinuity</div><div>Mudstone Contact</div></div><div><div>Types of Tests</div><div>CO - Consolidation</div><div>CR - Compression</div><div>CS - Direct Shear</div><div>EI - Expansion Index</div><div>SE - Seal Equivalency</div><div>TS - Triaxial</div><div>MD - Maximum Density</div><div>PE - Permeability</div><div>SA - Sieve Analysis</div><div>SE - Seal Equivalency</div><div>TS - Triaxial</div></div></div>									
Note: This log contains observations and interpretations that are valid only for the specific date and location of the boring. Subsurface conditions may vary between borings and with time. Material descriptions are defined using visual classification methods and may vary from descriptive classifications based on laboratory testing.									

04/28/22		AS BUILT REVISIONS
DATE	MK	DESCRIPTION
REVISIONS		

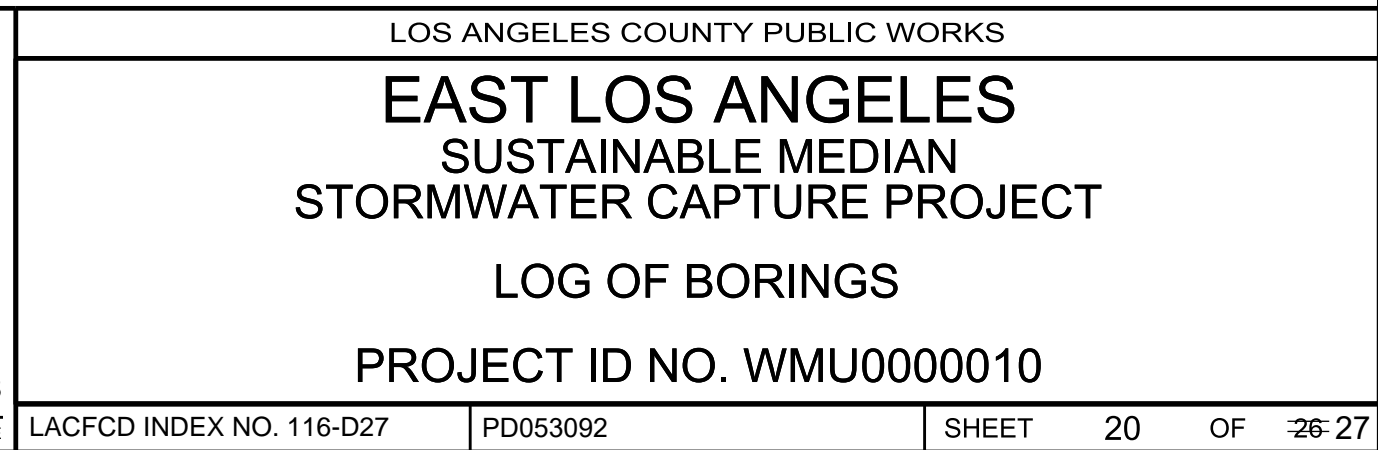

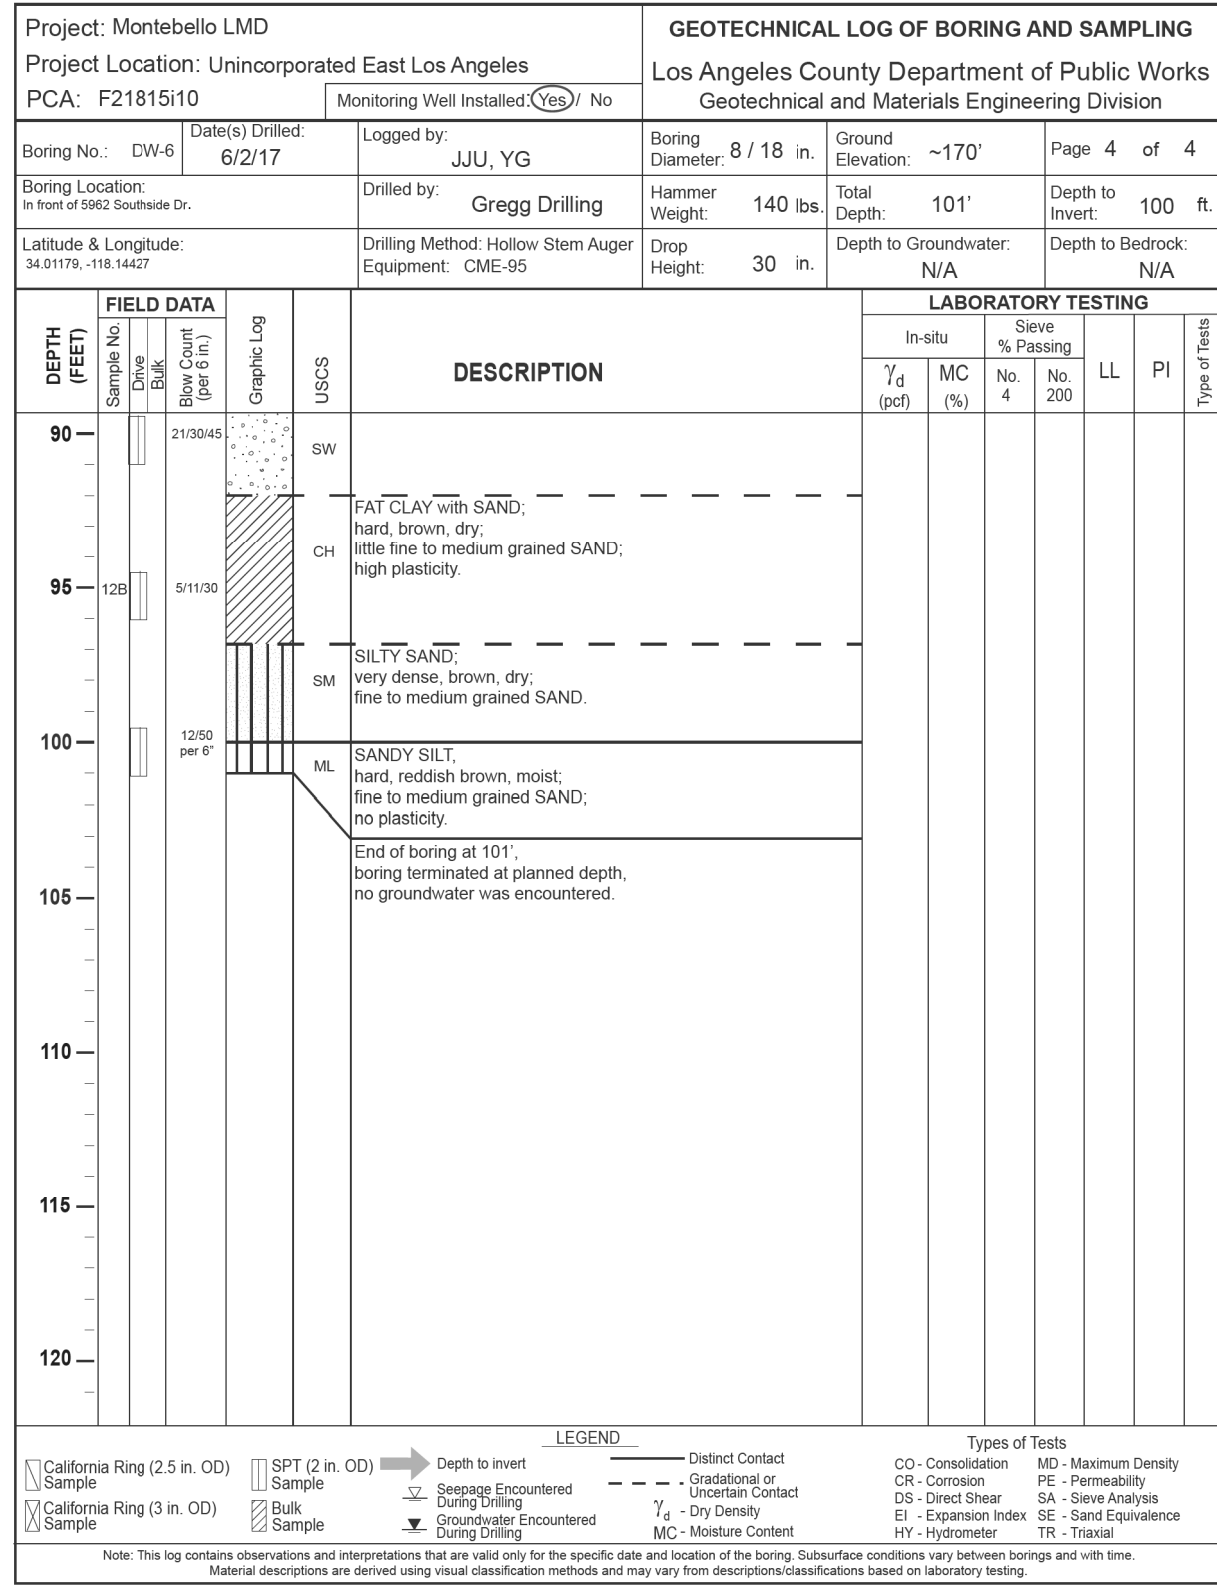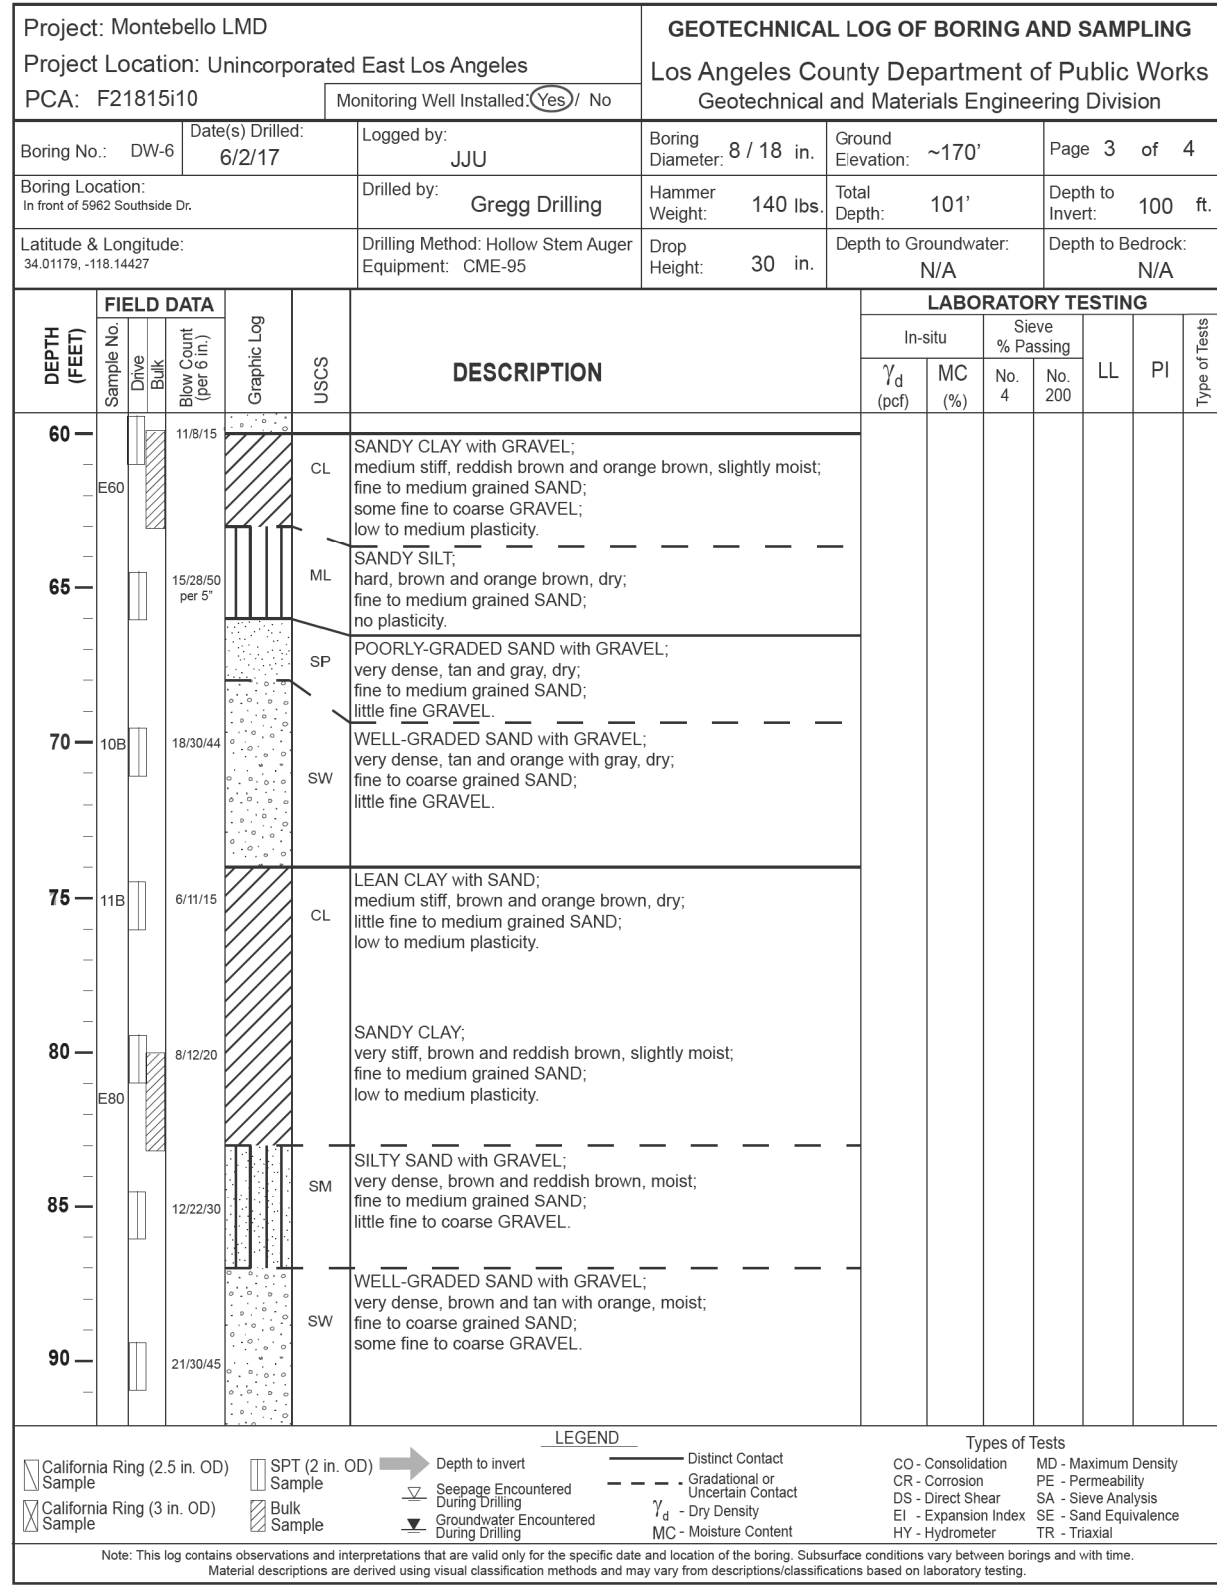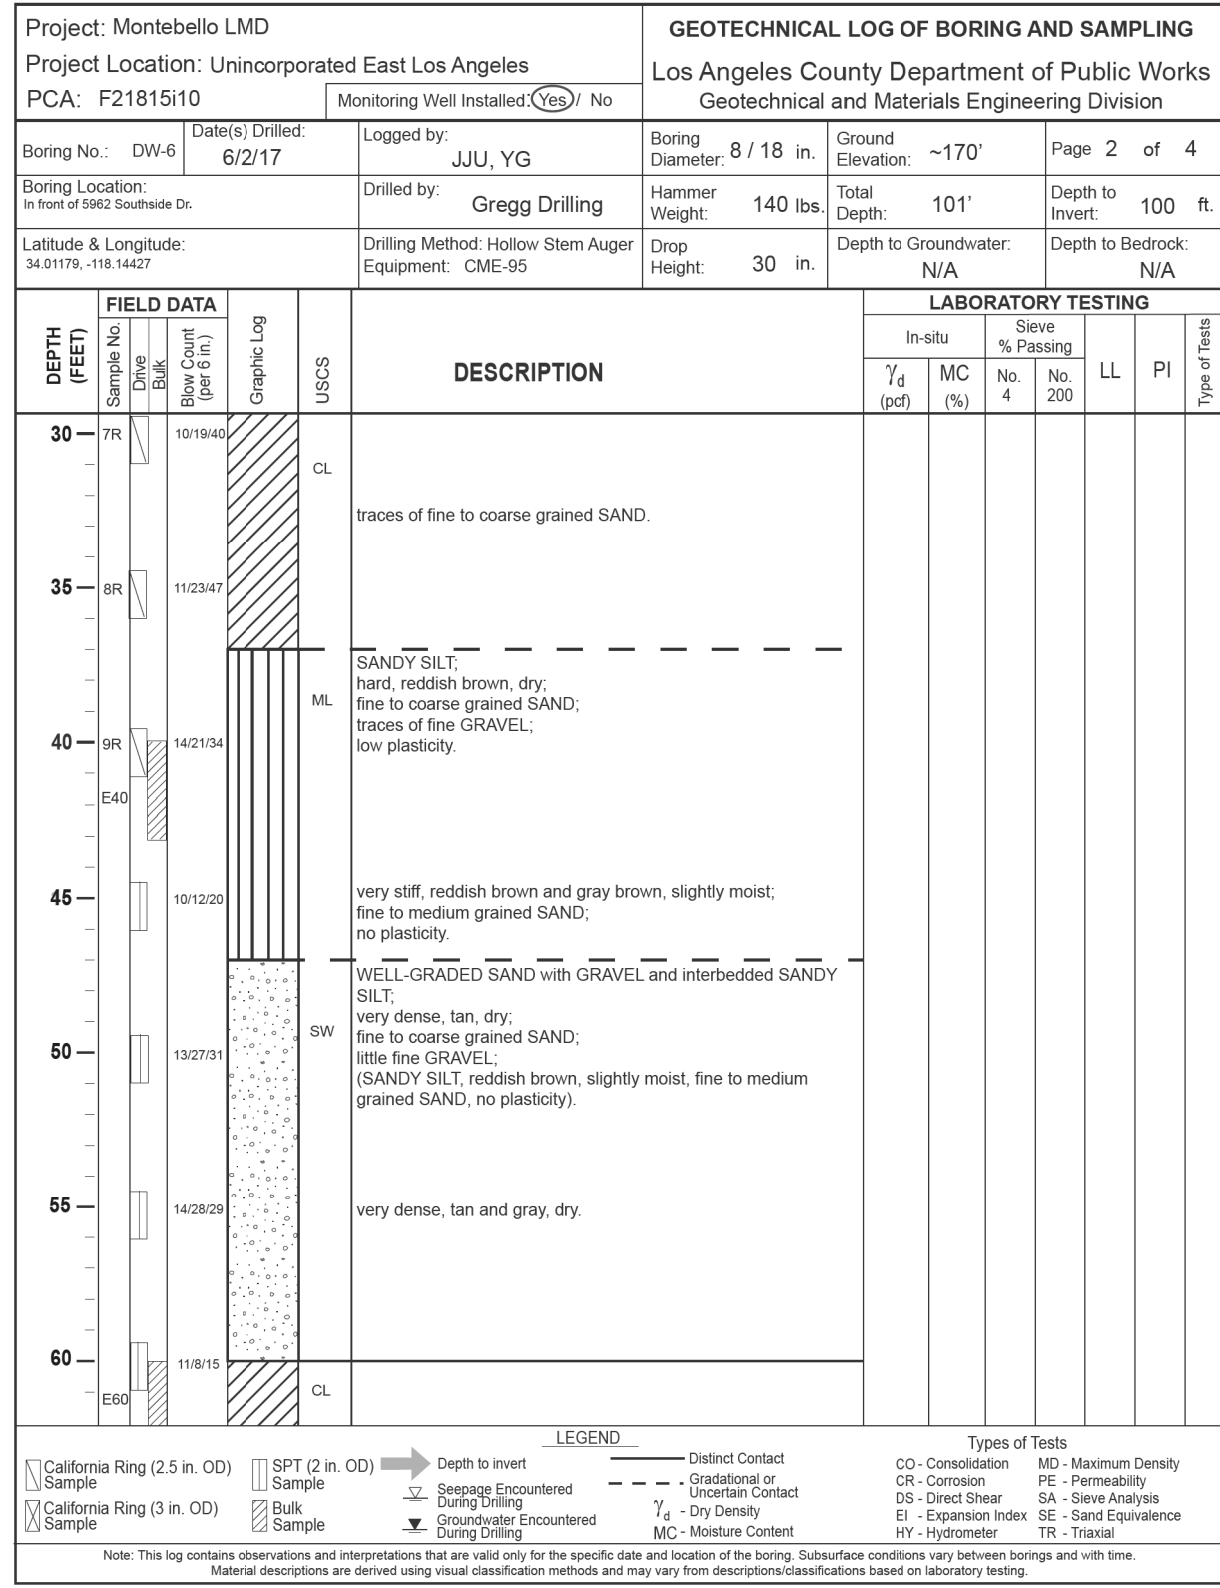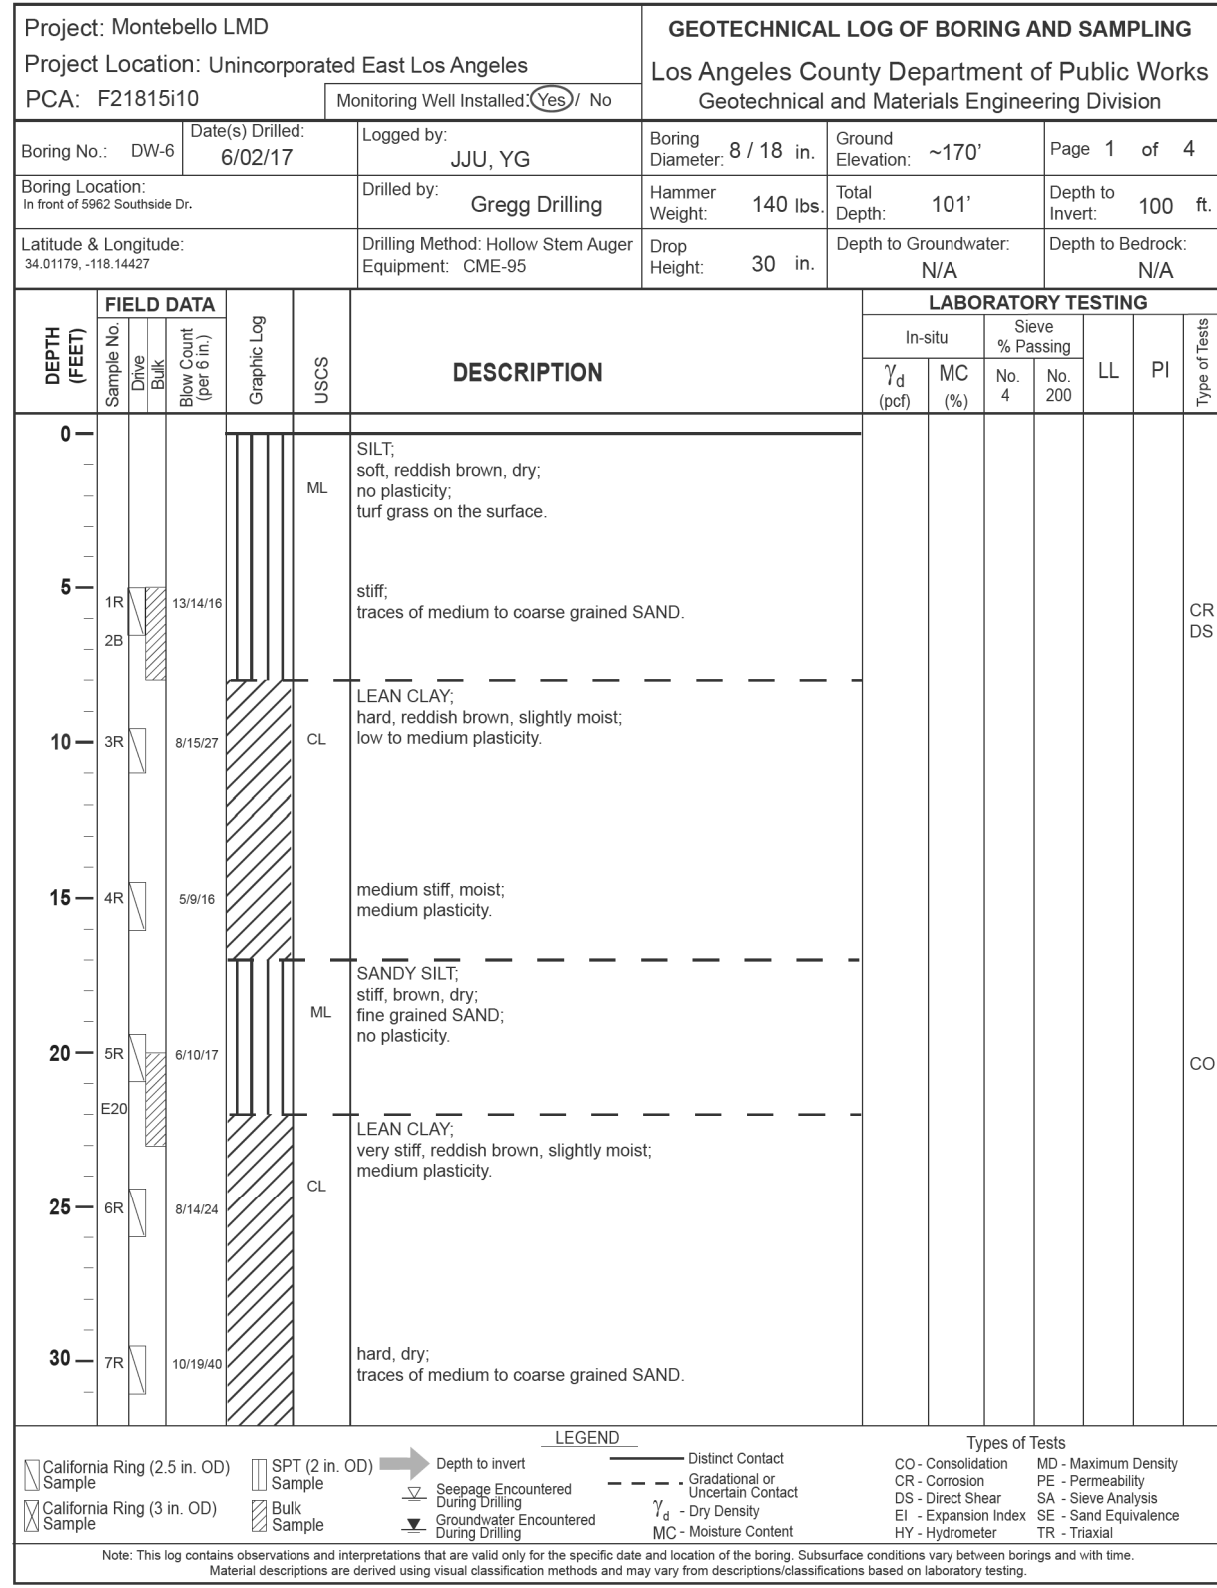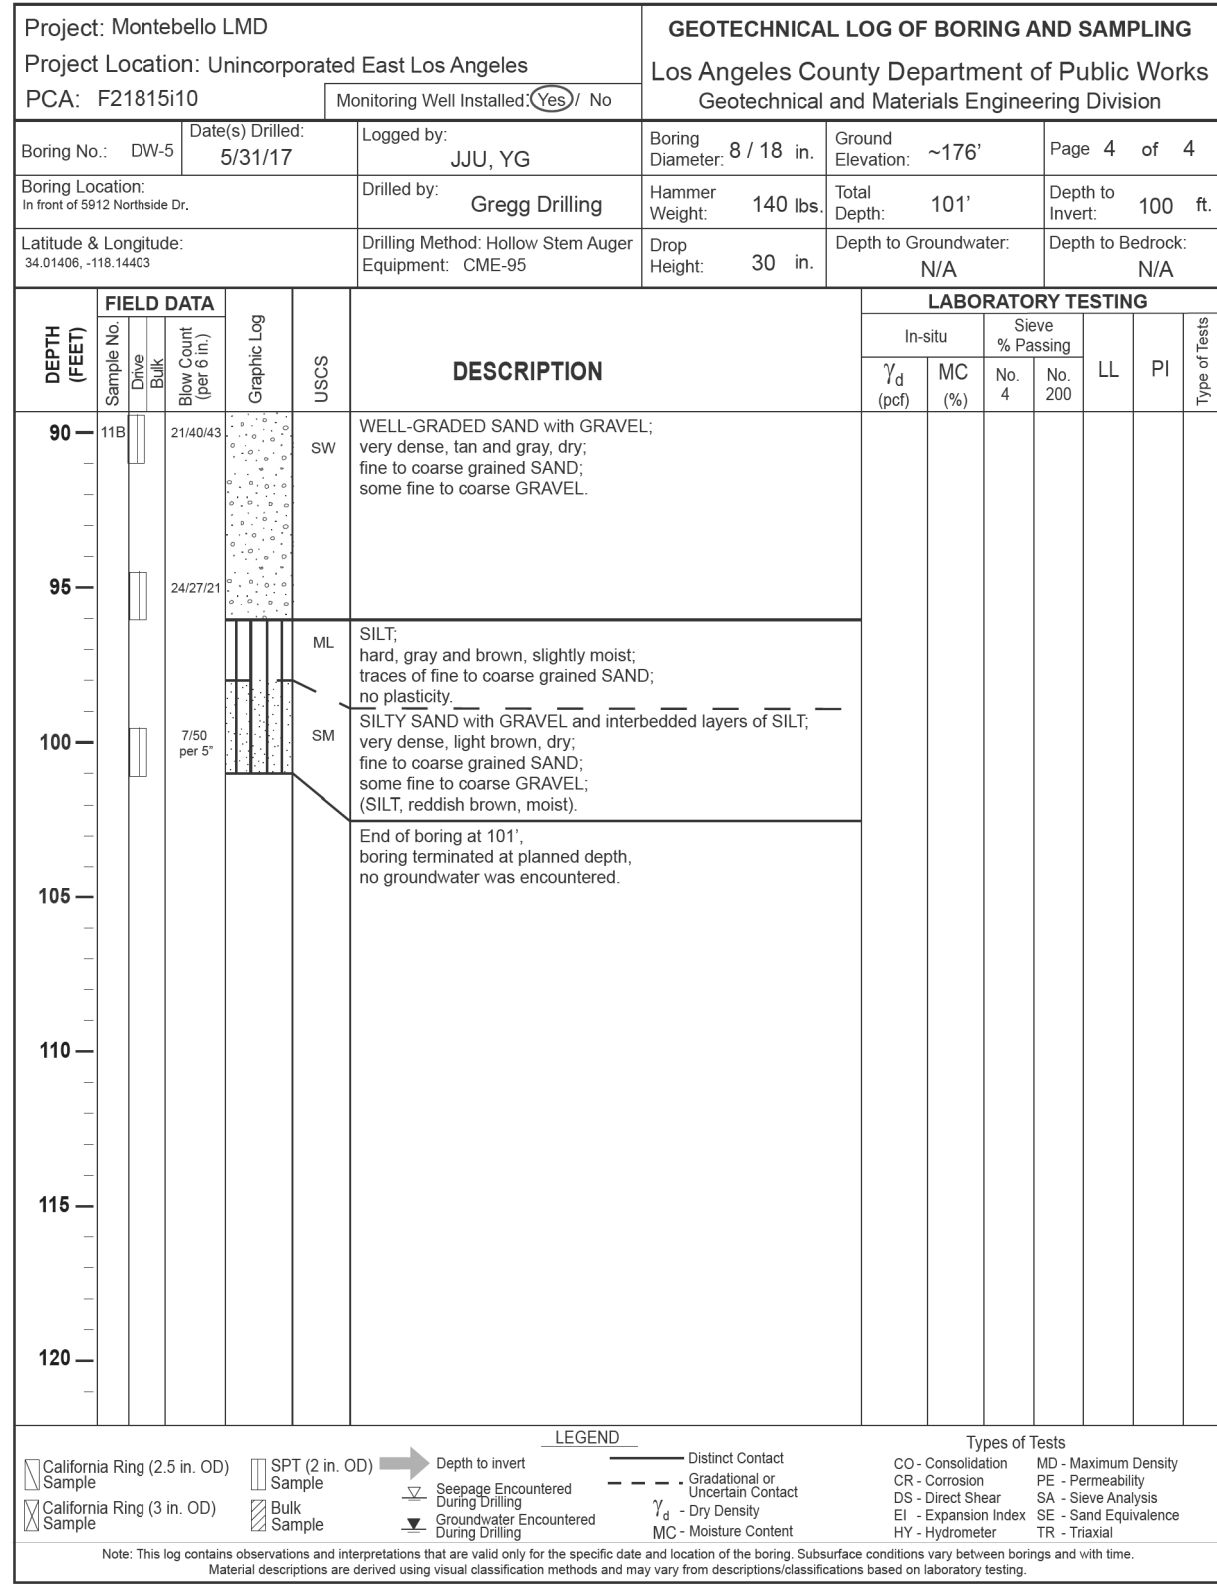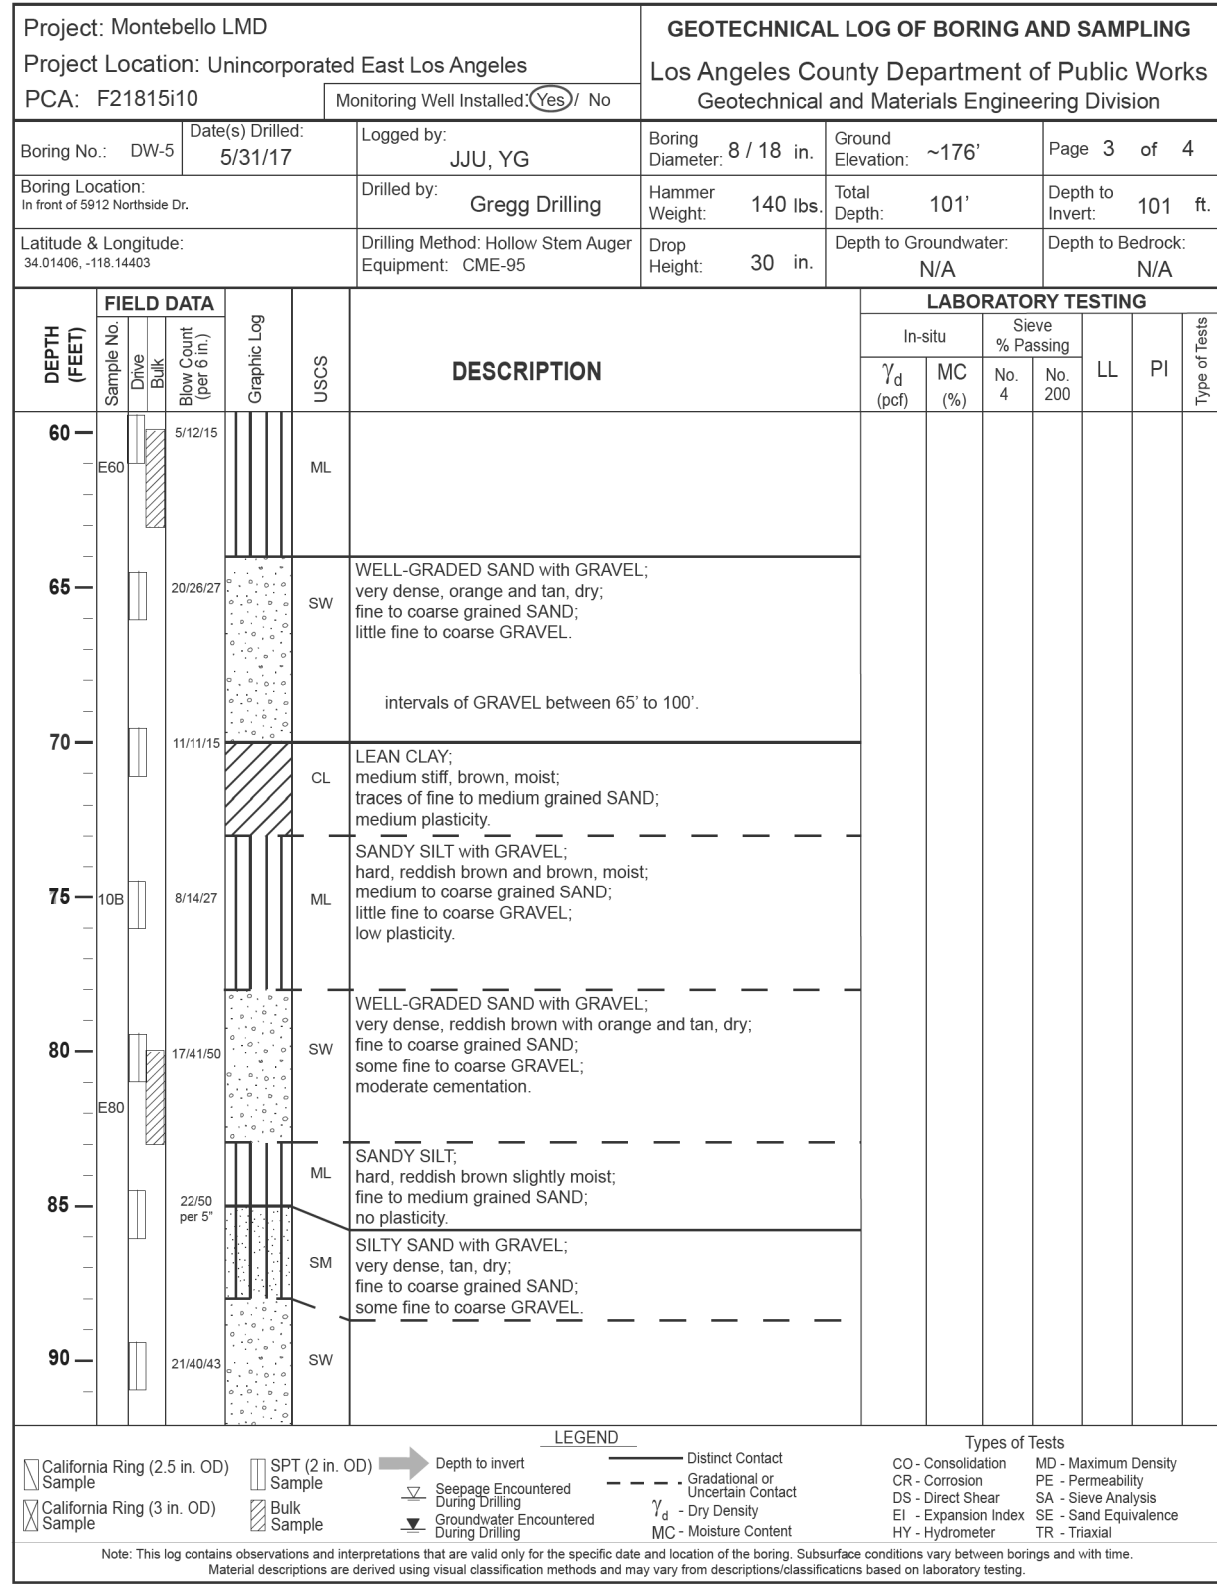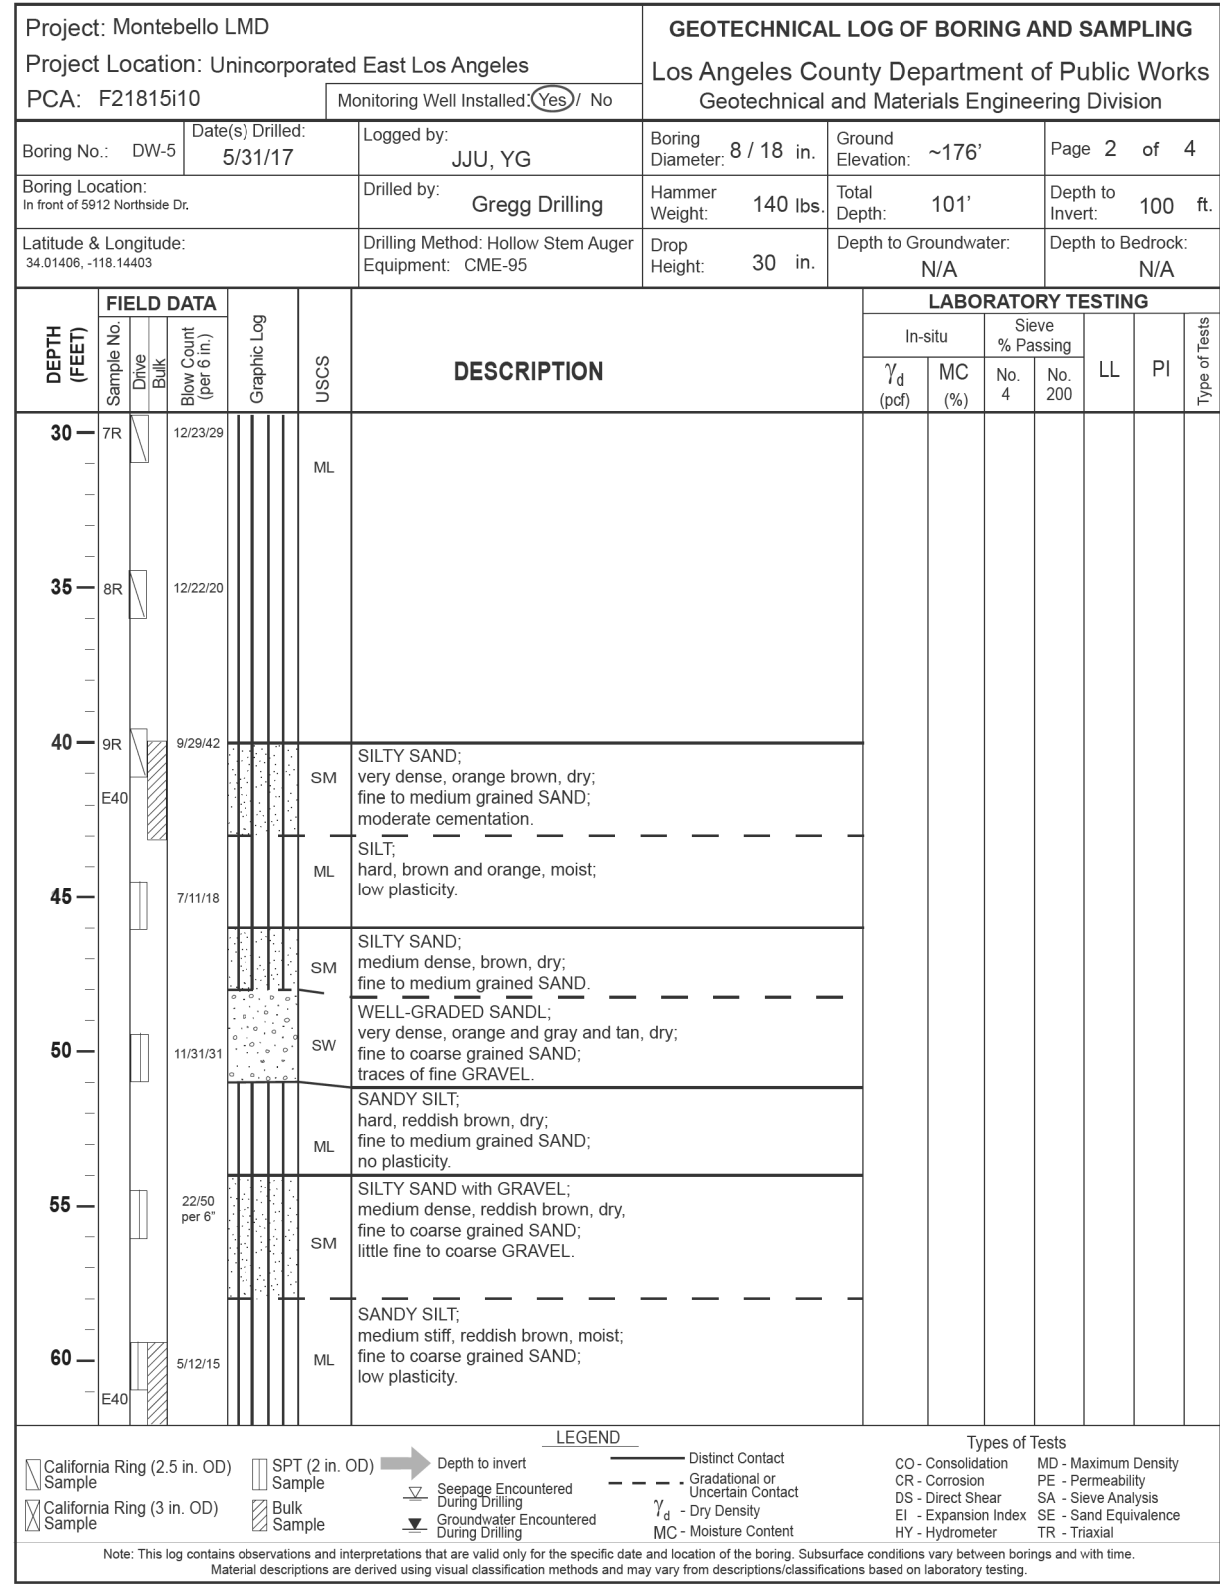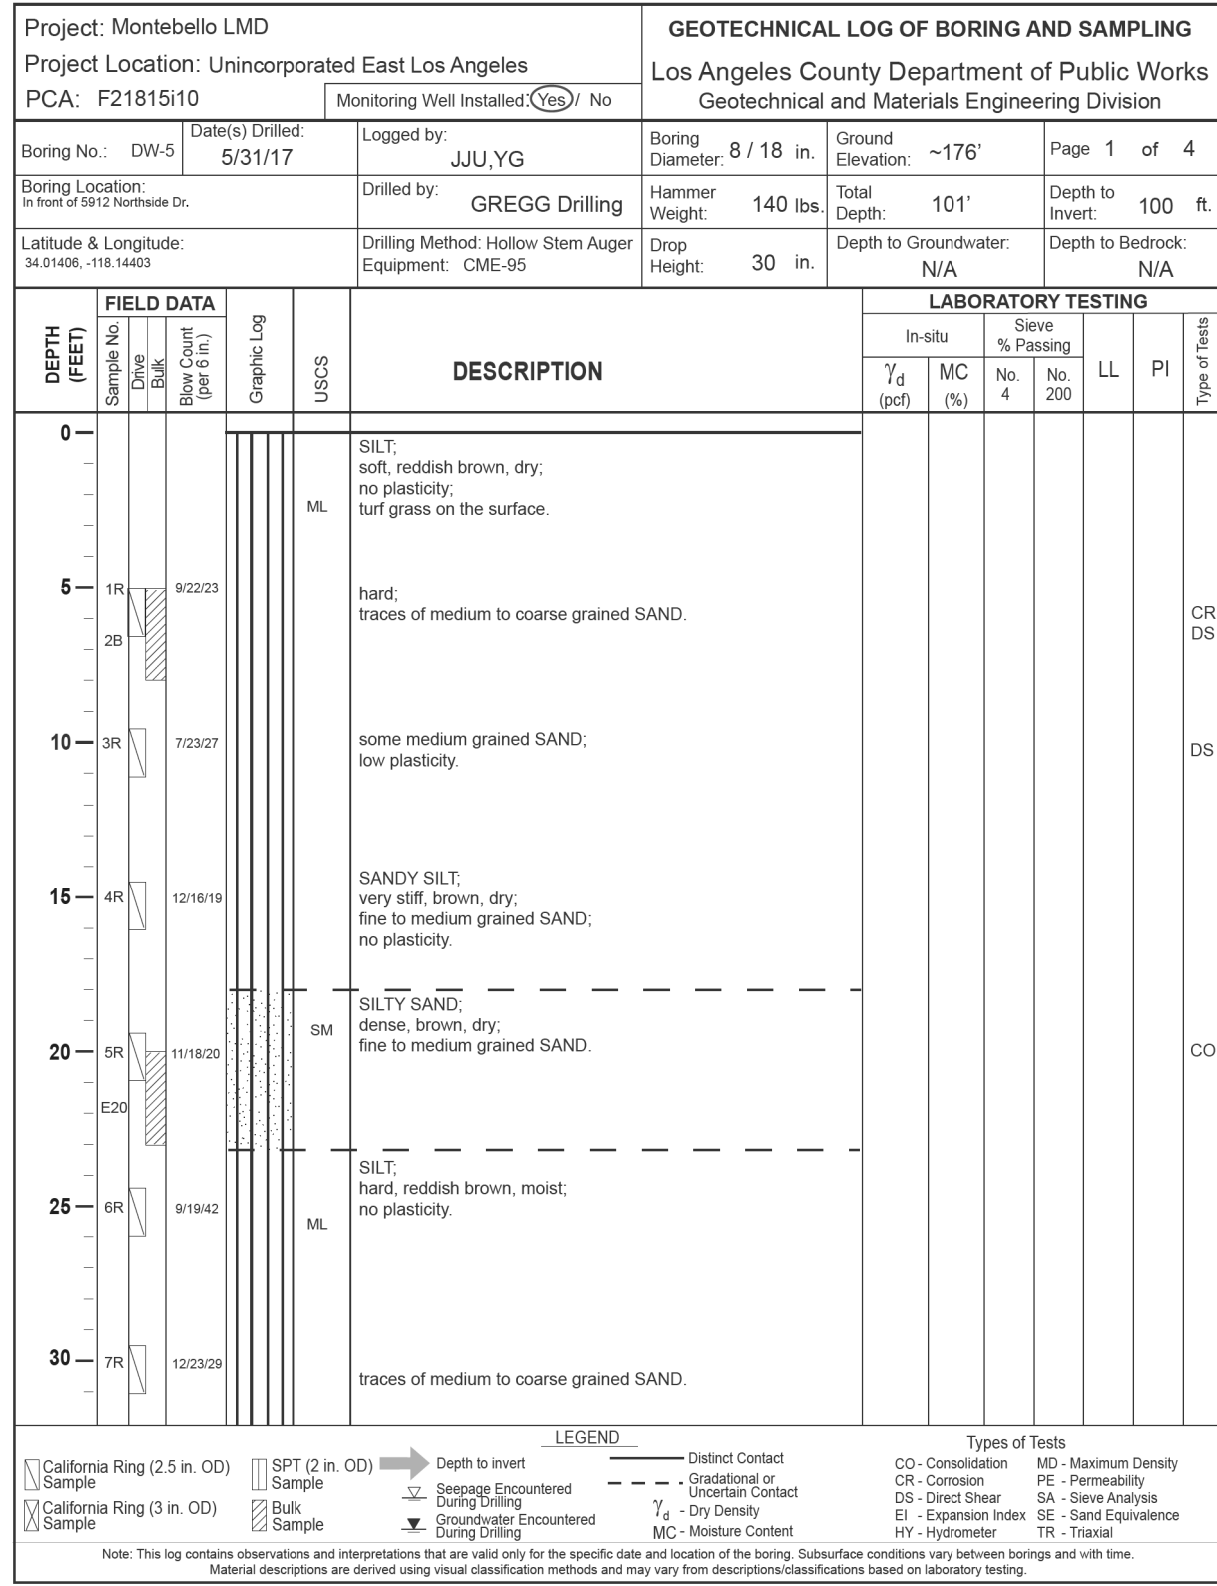

CADD PROJECT FILE NAME
CHECKER
DESIGNER
DRAFTER

04/28/22


AS BUILT REVISIONS

DATE

04/28/22

REVISIONS

DESCRIPTION



03/27/18

PROJECT ENGINEER

DATE

03/27/18

LOS ANGELES COUNTY PUBLIC WORKS

EAST LOS ANGELES SUSTAINABLE MEDIAN STORMWATER CAPTURE PROJECT

LOG OF BORINGS

PROJECT ID NO. WMU0000010

LACFCD INDEX NO. 116-027

PD053092

SHEET 21 OF 26-27

AS BUILT DRAWINGS

PLAN DR

Project: Montebello LMD

Project Location: Unincorporated East Los Angeles

PCA: R21515/0

Monitoring Well Installed (Yes/No)

Yes

Boring No. DW-8

Dates/Drilled

6/9/17

Logged by

JUJ, YG

Boring Diameter: 8" / 18 in.

Ground Elevation: ~186'

Page 1 of 4

Boring Location

in front of 4434 Southwest Dr.

Drilled by

Gregg Drilling

140 lbs

Total Depth: 101'

Depth to Invert: 100 ft

Latitude & Longitude

34.0121, -118.1363

Drilling Method: Hollow Stem Auger

Equipment: CME-95

Drop Height: 30 in.

Depth to Bedrock: N/A

Depth to Invert: N/A

DEPTH (FEET)	FIELD DATA Sample No. B.A.# Sieve # (ft)	Graphic Log	UCS	DESCRIPTION	LABORATORY TESTING						Time of Test
					In situ		Sieve No. Passing		LL	PI	
					γ_d (pcf)	MC (%)	No. 4	No. 200			
0			ML	SILT, soft, reddish brown, dry; traces of medium to coarse grained SAND; no plasticity; air grass on the surface. Intervals of fine to coarse grained SAND between 0' to 40'.							
5			CH	FAT CLAY with SAND; hard, brown, dry; some medium to coarse grained SAND; traces of fine to coarse GRAVEL; high plasticity.							
10			CL	SANDY LEAN CLAY with GRAVEL; hard, brown, moist; medium to coarse grained SAND; little fine GRAVEL; low to medium plasticity.							
15			CH	LEAN CLAY with SAND and interbedded SANDY SILT; stiff, brown, moist; some fine to medium grained SAND; SANDY SILT, reddish brown, moist; medium plasticity.							
20			CH	FAT CLAY with SAND; hard, reddish brown, moist; little fine to coarse grained SAND; high plasticity.							
25			CL	SANDY FAT CLAY with GRAVEL; hard, reddish brown, dry; medium to coarse grained SAND; little fine GRAVEL; high plasticity.							
30			CL	SANDY LEAN CLAY; very stiff, reddish brown, moist; low to medium grained SAND; low plasticity.							

California RPT (2.5 in. CO) Sample

California RPT (3 in. CO) Sample

Sample

Depth to Invert

Seepage Encountered

Grout Encountered

Grout Encountered

----- Distinct Contact

----- Gradational or Unsettled Contact

--- Dry Density

--- Moisture Content

CO - Consolidation

OR - Oedometer

DI - Direct Shear

E - Expansion Index

HY - Hydrometer

MC - Maximum Density

SA - Sieve Analysis

FE - Permeability

TS - Triaxial

SE - Sand Equivalence

Note: This log contains observations and interpretations that are valid only for the specific date and location of the boring. Subsurface conditions vary between borings and with time. Minor discrepancies are allowed using different classification methods and may vary from descriptions/classifications based on laboratory testing.

Project: Montebello LMD

Project Location: Unincorporated East Los Angeles

PCA: F2181510

Monitoring Well Installed (Yes/No) No

GEOTECHNICAL LOG OF BORING AND SAMPLING

Los Angeles County Department of Public Works

Geotechnical and Materials Engineering Division

Boring No. DW-8

Dates: Drilled 6/8/17

Logged by JUU, JYG

Boring Diameter: 8 / 18 in.

Ground Elevation: ~186'

Page 2 of 4

Boring Location in front of 401 Southwest St.

Drilled by GREGG Drilling

Hammer Weight: 140 lbs

Total Depth: 101'

Depth to Imaginary Bedrock: N/A

Depth to 100 ft

Latitude & Longitude: 34.0121, -118.1343

Drilling Method: Hollow Stem Auger

Equipment: CME-95

Drop Height: 30 in.

Depth to Bedrock: N/A

DEPTH (FEET)	FIELD DATA		Geologic Log	UCS	DESCRIPTION	LABORATORY TESTING						Type of Soil	
	Sample No.	Soil Type				In situ γ_d (pcf)	Moisture Content (%)	Swelling Potential (%)	LL	PI	Notes		
30	TR	71221	CH										
35	BR	81633		ML	SANDY SILT; hard, light brown and orange brown, moist; fine grained SAND; no plasticity.								
40	BR	122238		CL	SANDY LEAN CLAY with GRAVEL; hard, reddish brown and orange brown, moist; fine to medium grained SAND; little fine GRAVEL; low plasticity.								
45	BR	192727	SW	WELL-GRADED SAND with GRAVEL; very dense, tan and orange, dry; fine to coarse grained SAND; some fine to coarse GRAVEL.									
50	BR	213017	CL										
55	BR	51114		SANDY LEAN CLAY; hard, orange brown, moist; fine to medium grained SAND; low plasticity.									
60	BR	71614											
65	BR	71614											
70	BR	71614											
75	BR	71614											
80	BR	71614											
85	BR	71614											
90	BR	71614											
95	BR	71614											
100	BR	71614											

California Ring (2.5 in. OD) Sample

California Ring (3 in. OD) Sample

SPT (2 in. OD) Sample

Soil Sample

Depth to invert

Seepage Encountered

Corrosion Encountered

Downhole Drilling

Distinct Contact

Gradational or Abrupt Contact

Gravelly

Drainage

Medium Contact

Consolidation

Compression

Direct Shear

Expansion Index

Hydrometer

Maximum Density

Permeability

Sieve Analysis

Standard Equivalence

Triaxial

Note: This log contains observations and interpretations that are valid only for the specific date and location of the boring. Subsurface conditions vary between borings and with time. Material classifications are derived using the following charting criteria.

Project: Montebello LMD Project Location: Unincorporated East Los Angeles PCA: FZ181510					GEOTECHNICAL LOG OF BORING AND SAMPLING Los Angeles County Department of Public Works Geotechnical and Materials Engineering Division							
Boring No. DW-8		Date(s) Drilled 6/9/17	Logged by JJU_YG		Boring Diameter: 8 / 18 in.	Ground Elevation: -186'	Page 3 of 4					
Boring Location In front of 441 Southwest St.		Drilled by Gregg Drilling		Hammer Weight: 140 lbs.	Total Depth: 101'	Depth to Invert: 100'						
Latitude & Longitude: 34.01521 -118.13463		Drilling Method: Hollow Stem Auger Equipment: CME-95		Drop Height: 30 in.	Depth to Groundwater: N/A	Depth to Bedrock: N/A						
FIELD DATA				LABORATORY TESTING								
DEPTH (FEET)	Sample No. B/L# (Soil 6" Int.)	Graphic Log	UCS	DESCRIPTION	In situ					LL	PI	Type of Test
					γ_d (pcf)	MC (%)	No. 4	Sieve % Passing	No. 200			
60	E60	7/61/61	CL									
65	420123		ML	SILT with SAND; hard, orange brown, moist; little fine grained SAND; no plasticity								
70	171726		SW	WELL-GRAINED SAND with GRAVEL; very dense, gray and tan, dry; fine to coarse grained SAND, some fine to coarse GRAVEL								
75	162235			little fine GRAVEL								
80	E80	142934		very dense, tan and orange, dry; some fine to coarse angular GRAVEL								
85	1224248		SM	SILTY SAND; very dense, tan and brown, moist; fine to medium grained SAND								
90	235650 per S*		SW									

California Riem (2.5 in. OD)
X Sample

California Riem (3 in. OD)
X Sample

X Sample

SPT (2 in. OD)
Sample

Swage Encountered
Coring Trial

Swage Encountered
Coring Trial

Swage Encountered
Coring Trial

Distorted Contact

Distorted or Gravitational Contact

Gravitational Contact

Mod. Distorted Contact

Types of Tests

CO - Consolidation MD - Maximum Density

CR - Corrosion PE - Permeability

GS - Direct Shear SA - Sieve Analysis

EX - Expansion Index SE - Sand Equivalence

HT - Hydrometer TS - Triaxial

Note: This log contains observations and interpretations that are valid only for the specific date and location of the boring. Subsurface conditions may vary between borings and with time. Material descriptions are derived using soil classification methods and may vary from descriptions/classifications based on laboratory testing.

Project: Montebello LMD

Project Location: Unincorporated East Los Angeles

PCA: F2181510

Monitoring Well Installed (Yes) No

Boring No. DW-8

Date(s) Drilled: 6/5/17

Logged by: JUJ, JYJ

Boring Location:
in front of 4140 Southside Dr.

Latitude & Longitude:
34.0121 -118.1343

Boring Diameter: 8 / 18 in.

Ground Elevation: ~101'

Page 4 of 4

Hammer Weight: 140 lb.

Depth to Invert: 100 ft

Depth to Bedrock: N/A

Drilling Method: Hollow Stem Auger Equipment: CME-95

Drop Height: 30 in.

Groundwater: N/A

FIELD DATA

Sample No.

Remarks
(Soil Type, Moisture, etc.)

Grain Log

UCS

DESCRIPTION

LABORATORY TESTING

In situ
γ_d (pcf)

Sieve % Passing
MC (%)

No. 200
CL

PI

N/A

90

24000 per ft

SW

WELL-GRADED SAND WITH GRAVEL, very dense, tan with gray and orange, dry, fine to coarse grained SAND, some fine to coarse angular GRAVEL

95

4148350

SM

very dense, gray and tan, dry, some fine to coarse angular GRAVEL

~1' silt-tan, loose at 94'; no plasticity

100

448

1117720

CL

SILT SAND,
dense, light brown, moist,
fine to medium grained SAND

105

LEAN CLAY;
very stiff, orange brown, moist;
medium plasticity

110

End of boring at 101'
boring terminated at planned depth,
no groundwater was encountered.

115

120

California Rim (2.5 in. OD)

Sample

California Rim (3 in. OD)

Sample

SPT (2 in. OD)

Sample

Seepage Encountered

Gas Encountered

Distinct Contact

Gradation or Orientation Contact

γ_d Density

γ_e Expansion Index

Moisture Content

CO - Consolidation

CR - Corrosion

DS - Direct Shear

HT - Hydrometer

SI - Sand Equivalence

Trial

MO - Maximum Density


PE - Permeability


SA - Sieve Analysis









SE - Sand Equivalence

TC - Triaxial

Note: This log contains observations and interpretations that are valid only for the specific date and location of the boring. Subsurface conditions vary between borings and with time. Material descriptions are derived using visual classification methods and may vary from descriptions/classifications based on laboratory testing.

04/28/22		AS BUILT REVISIONS
DATE	MK	DESCRIPTION
REVISIONS		

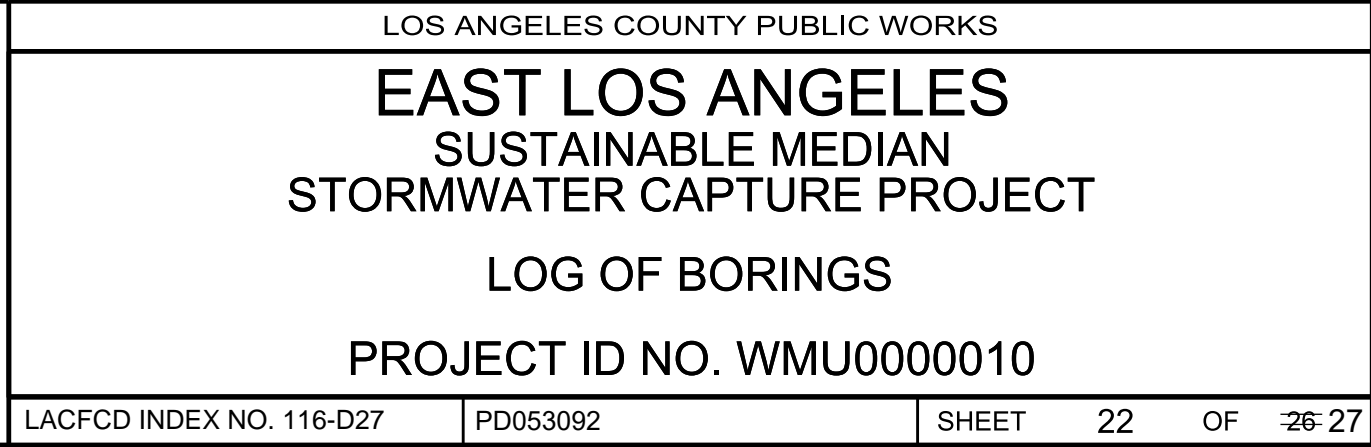

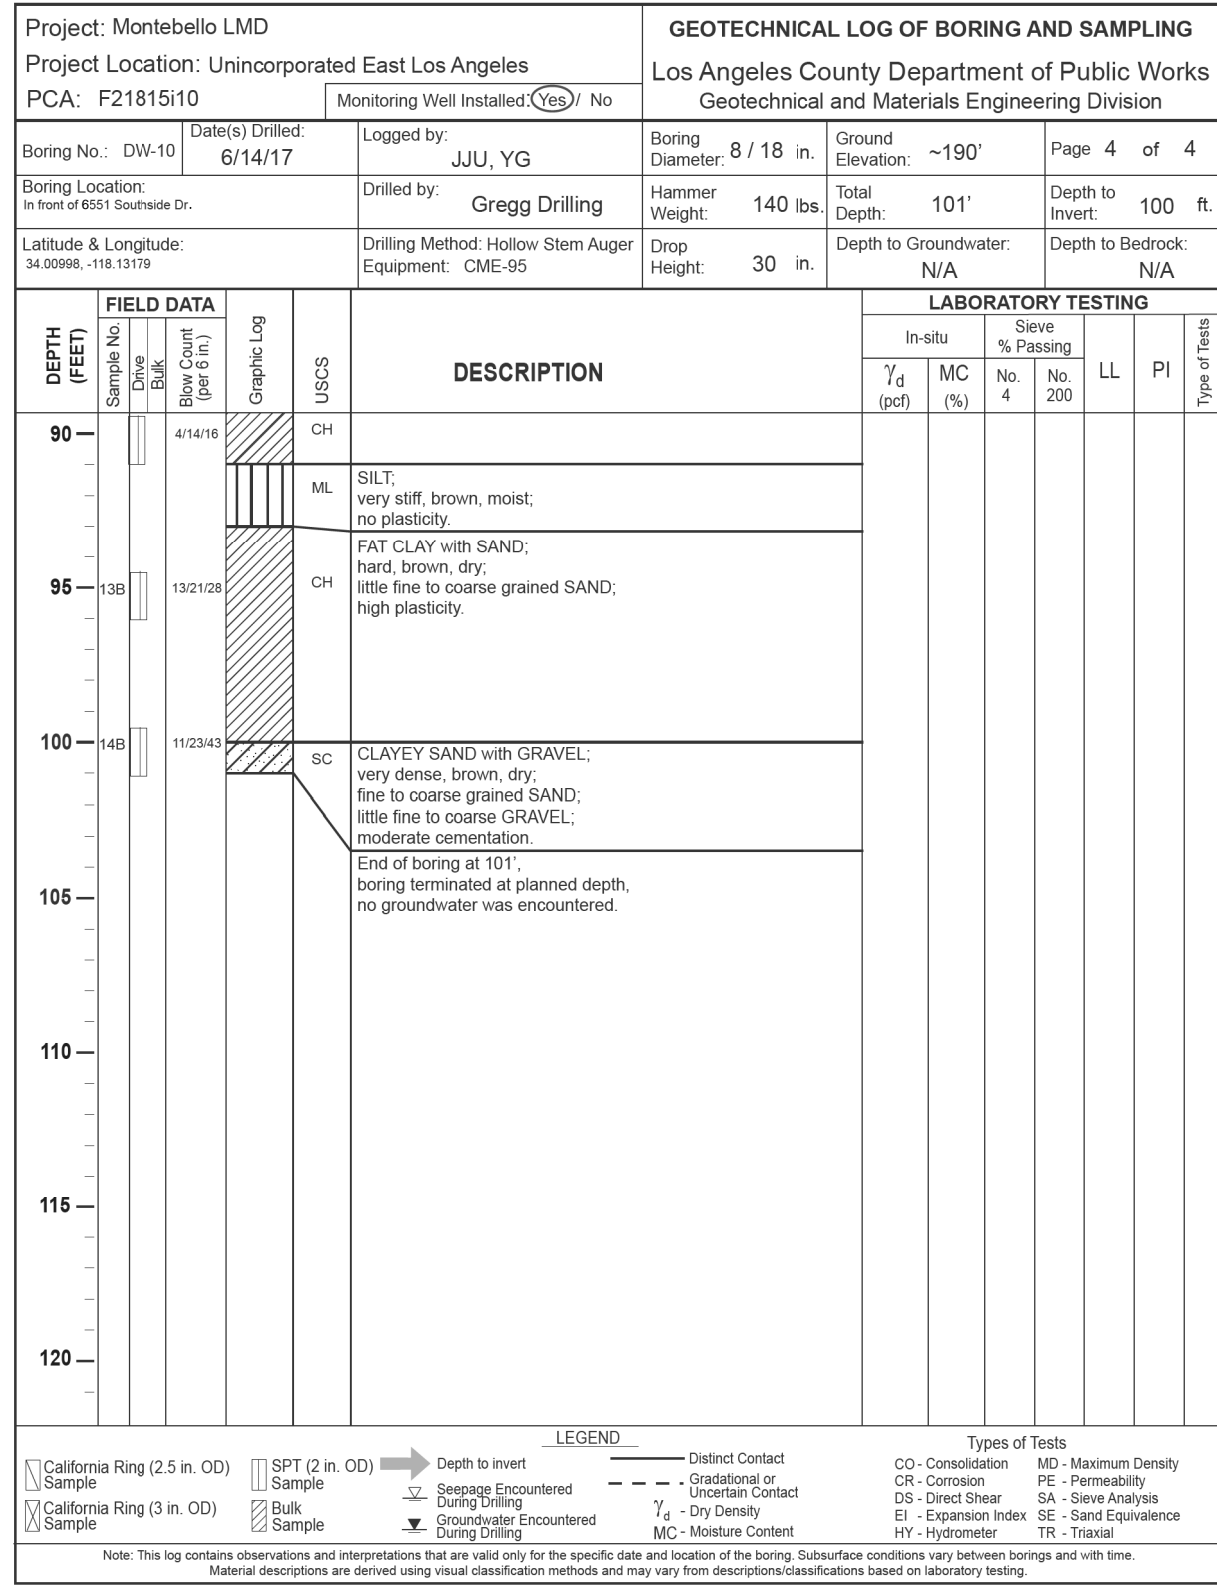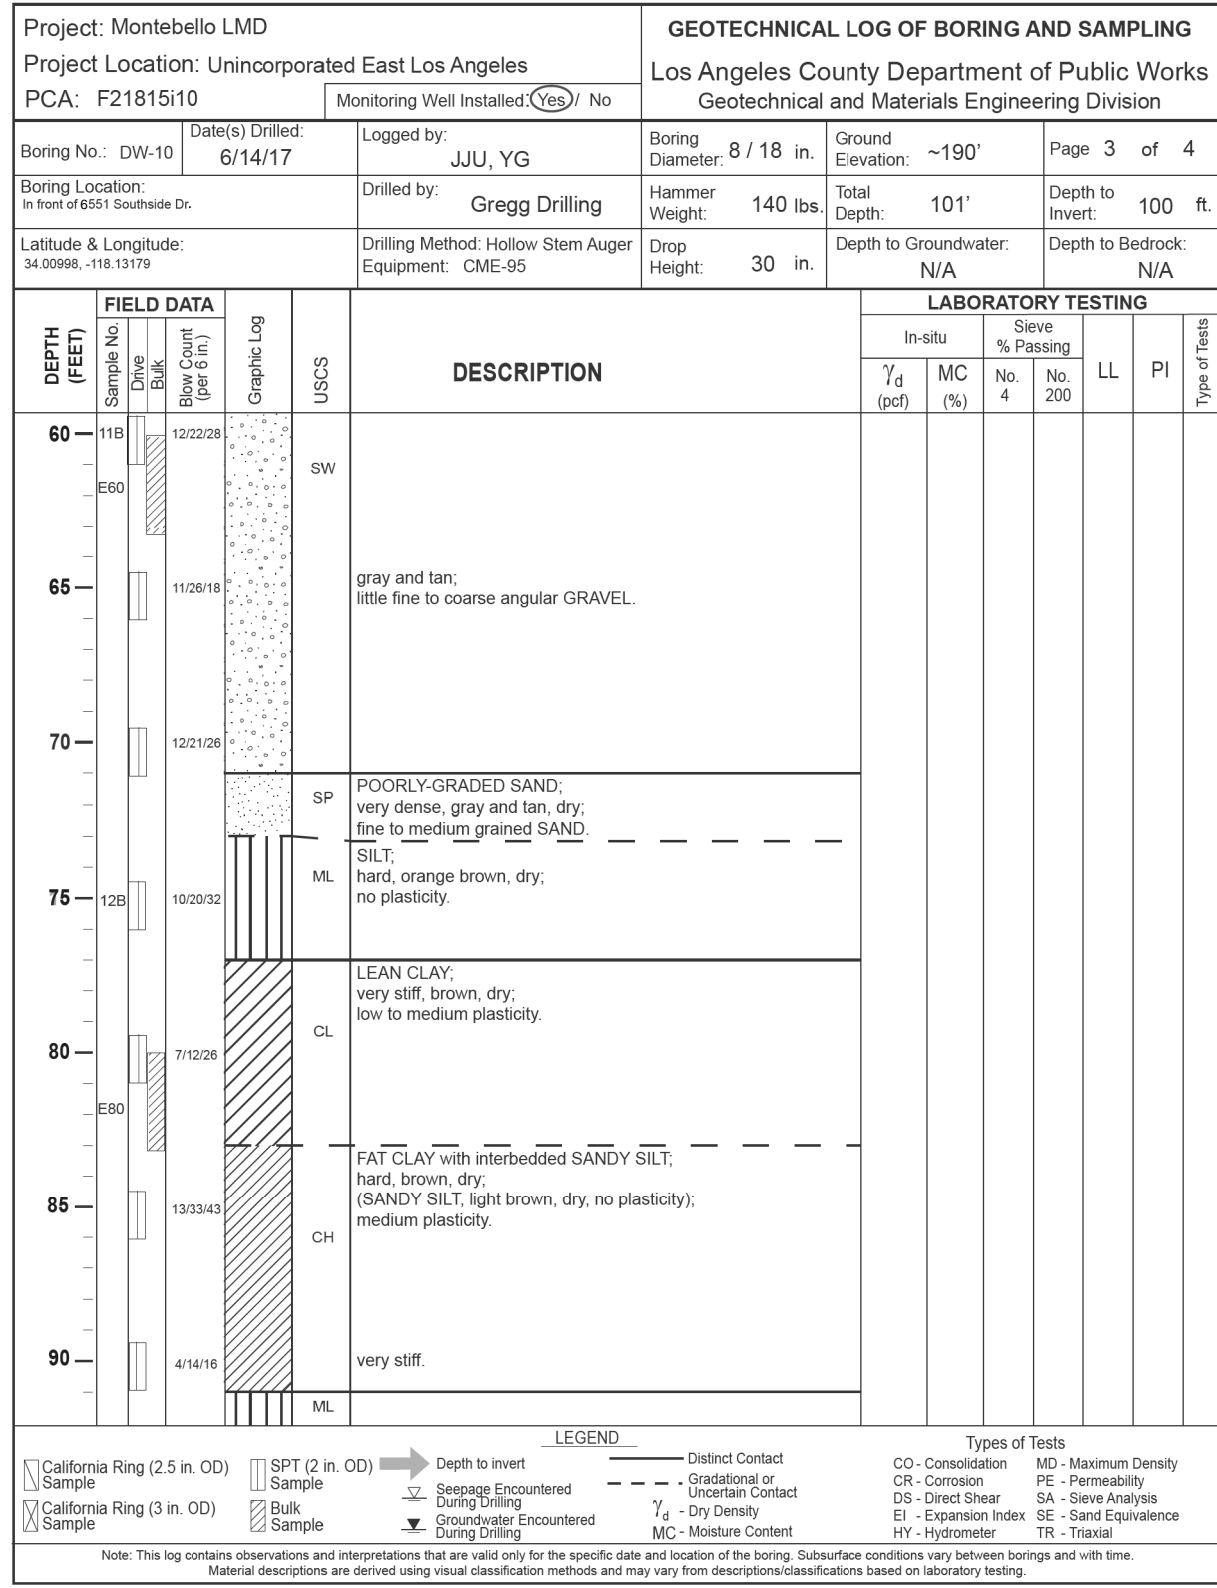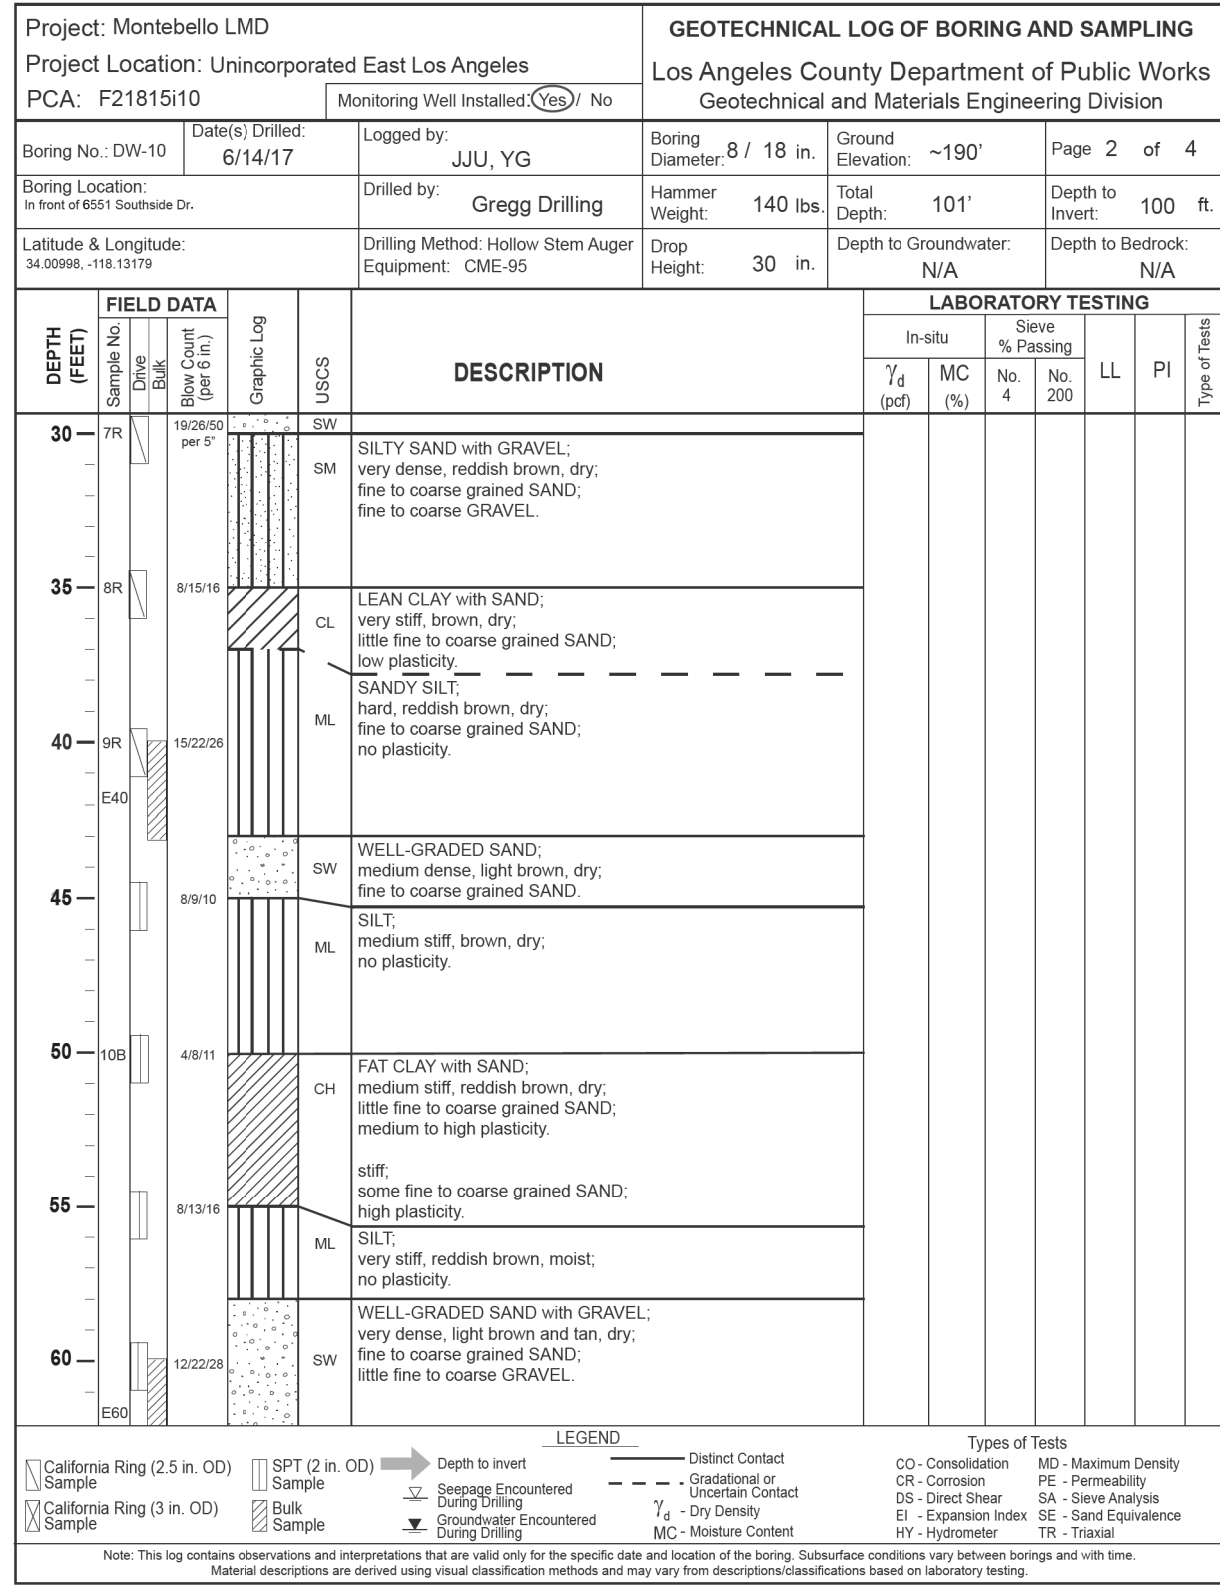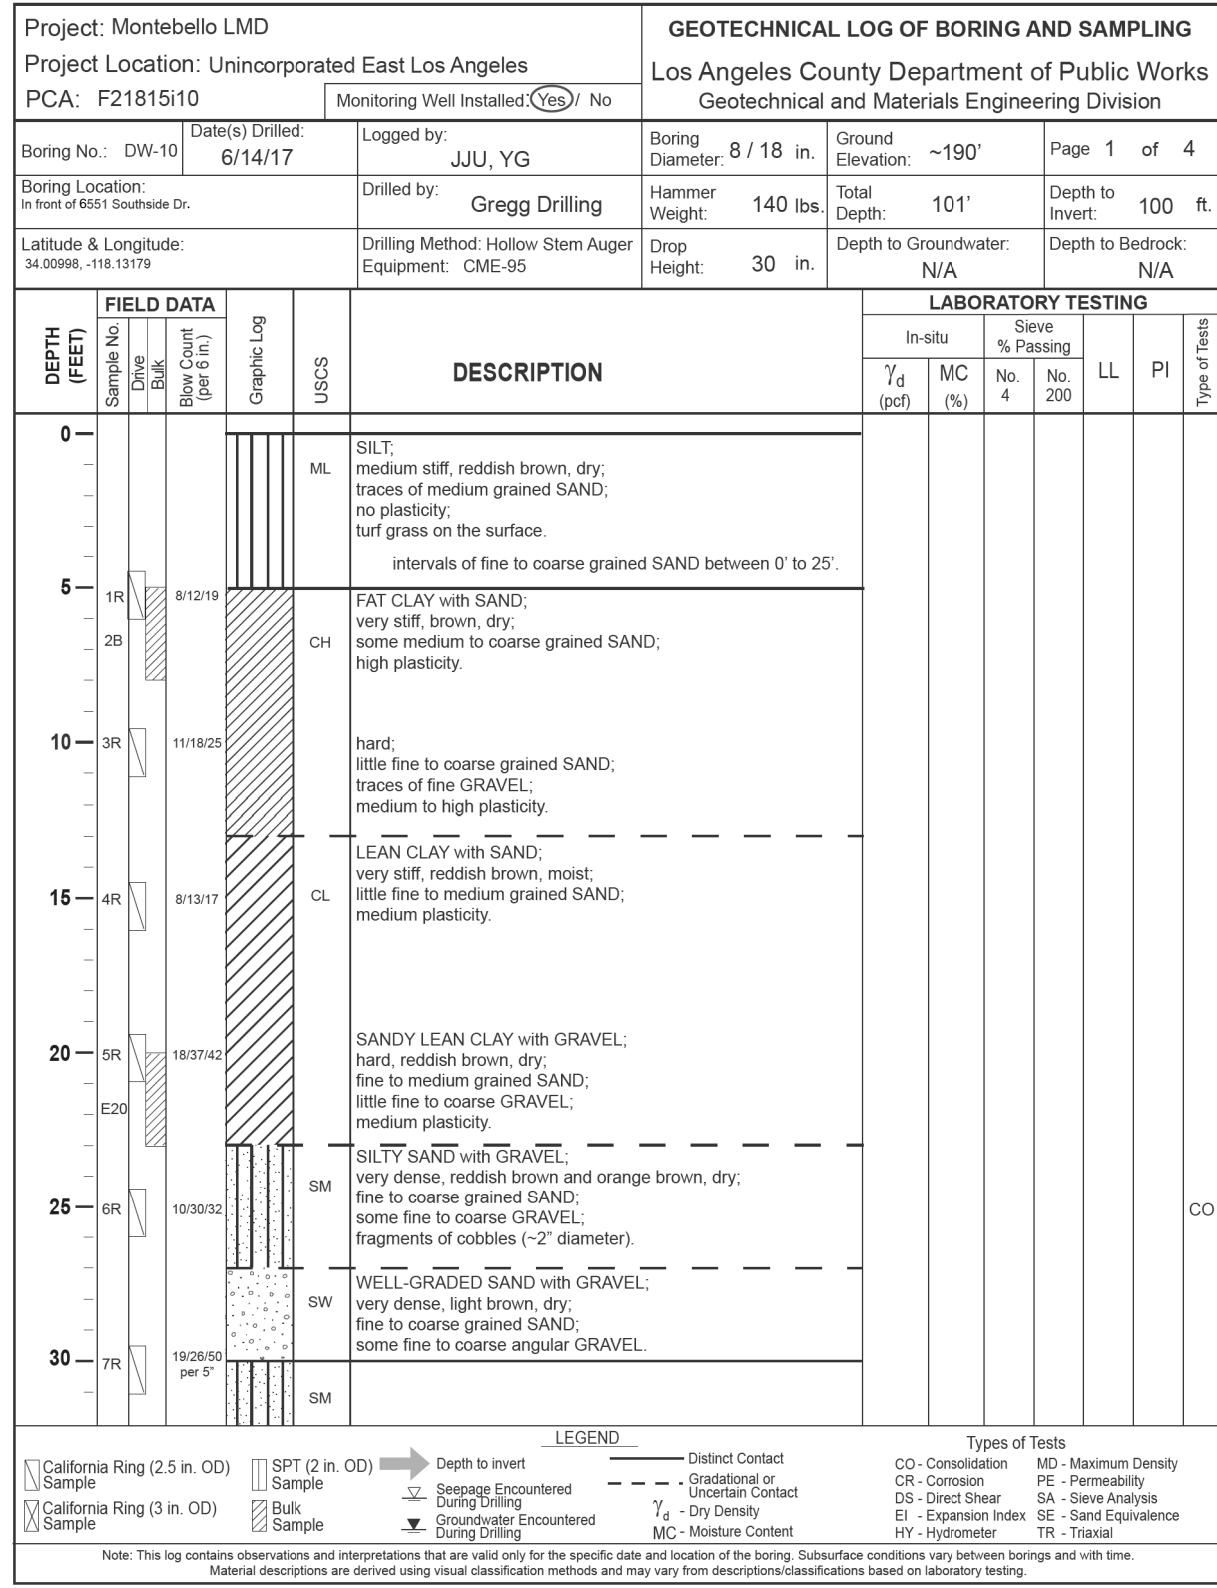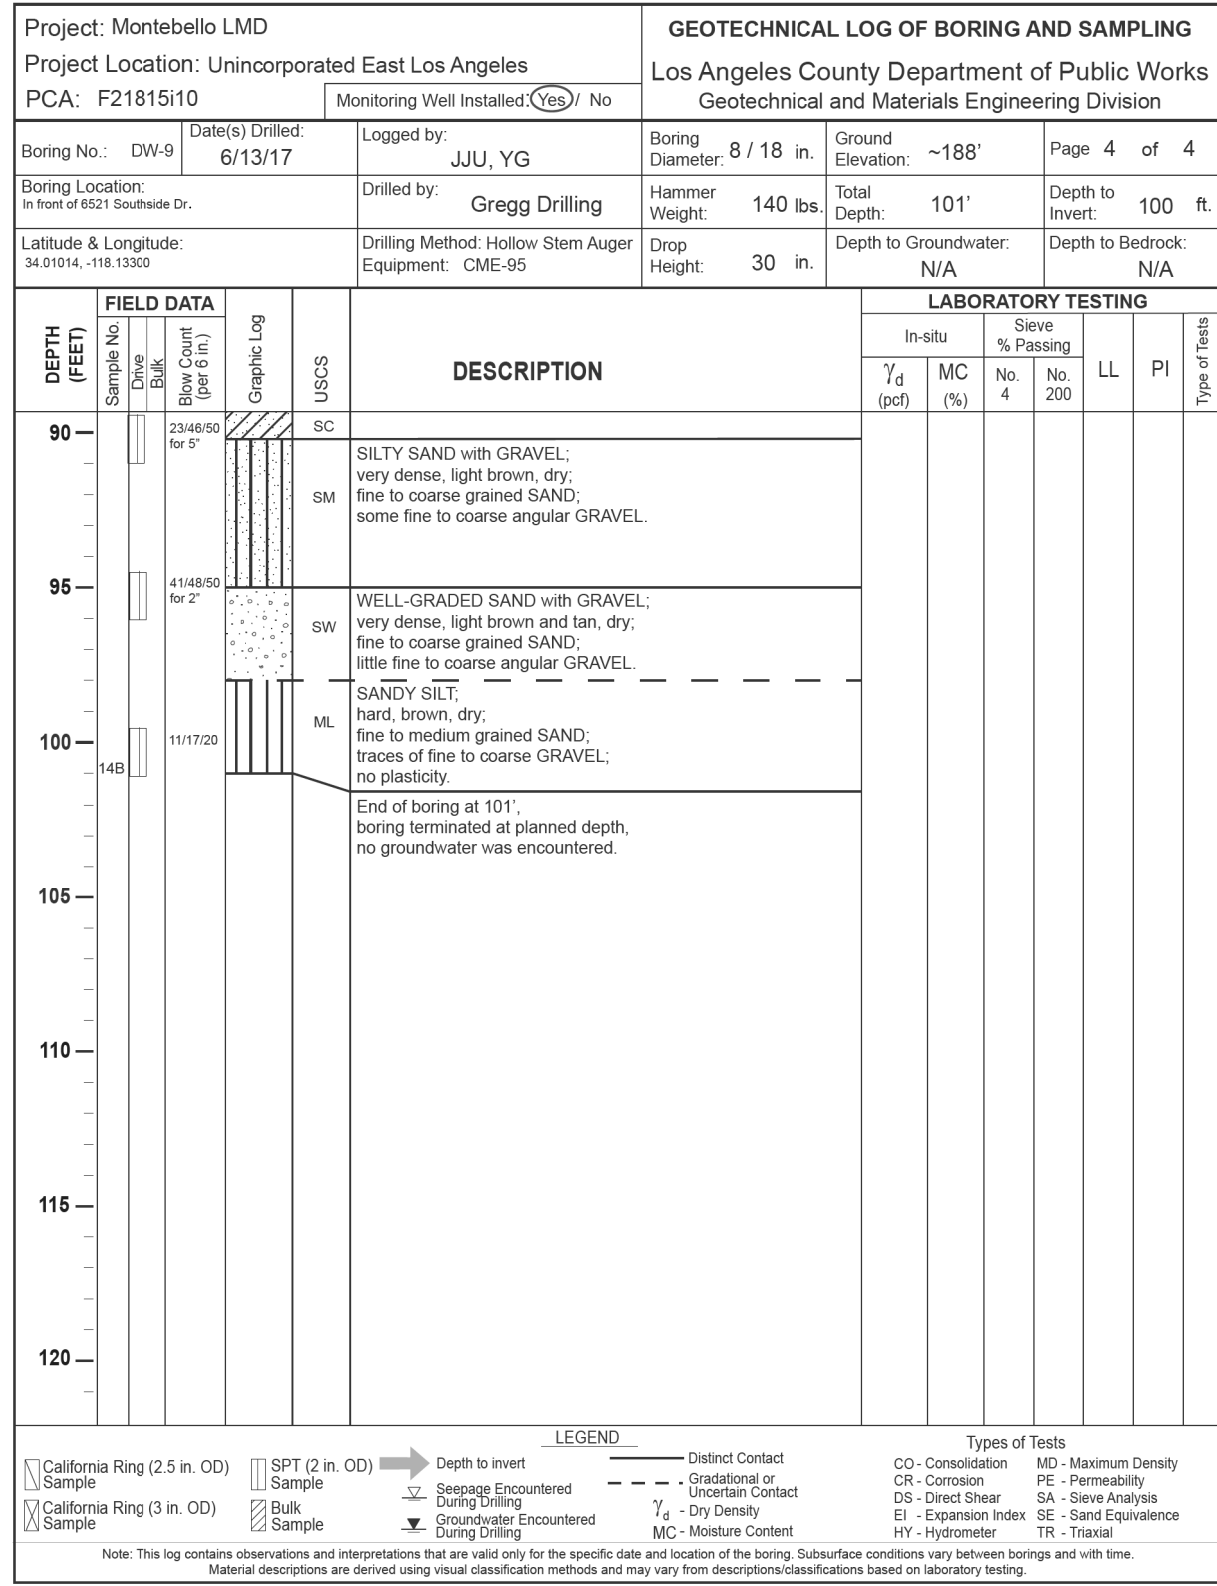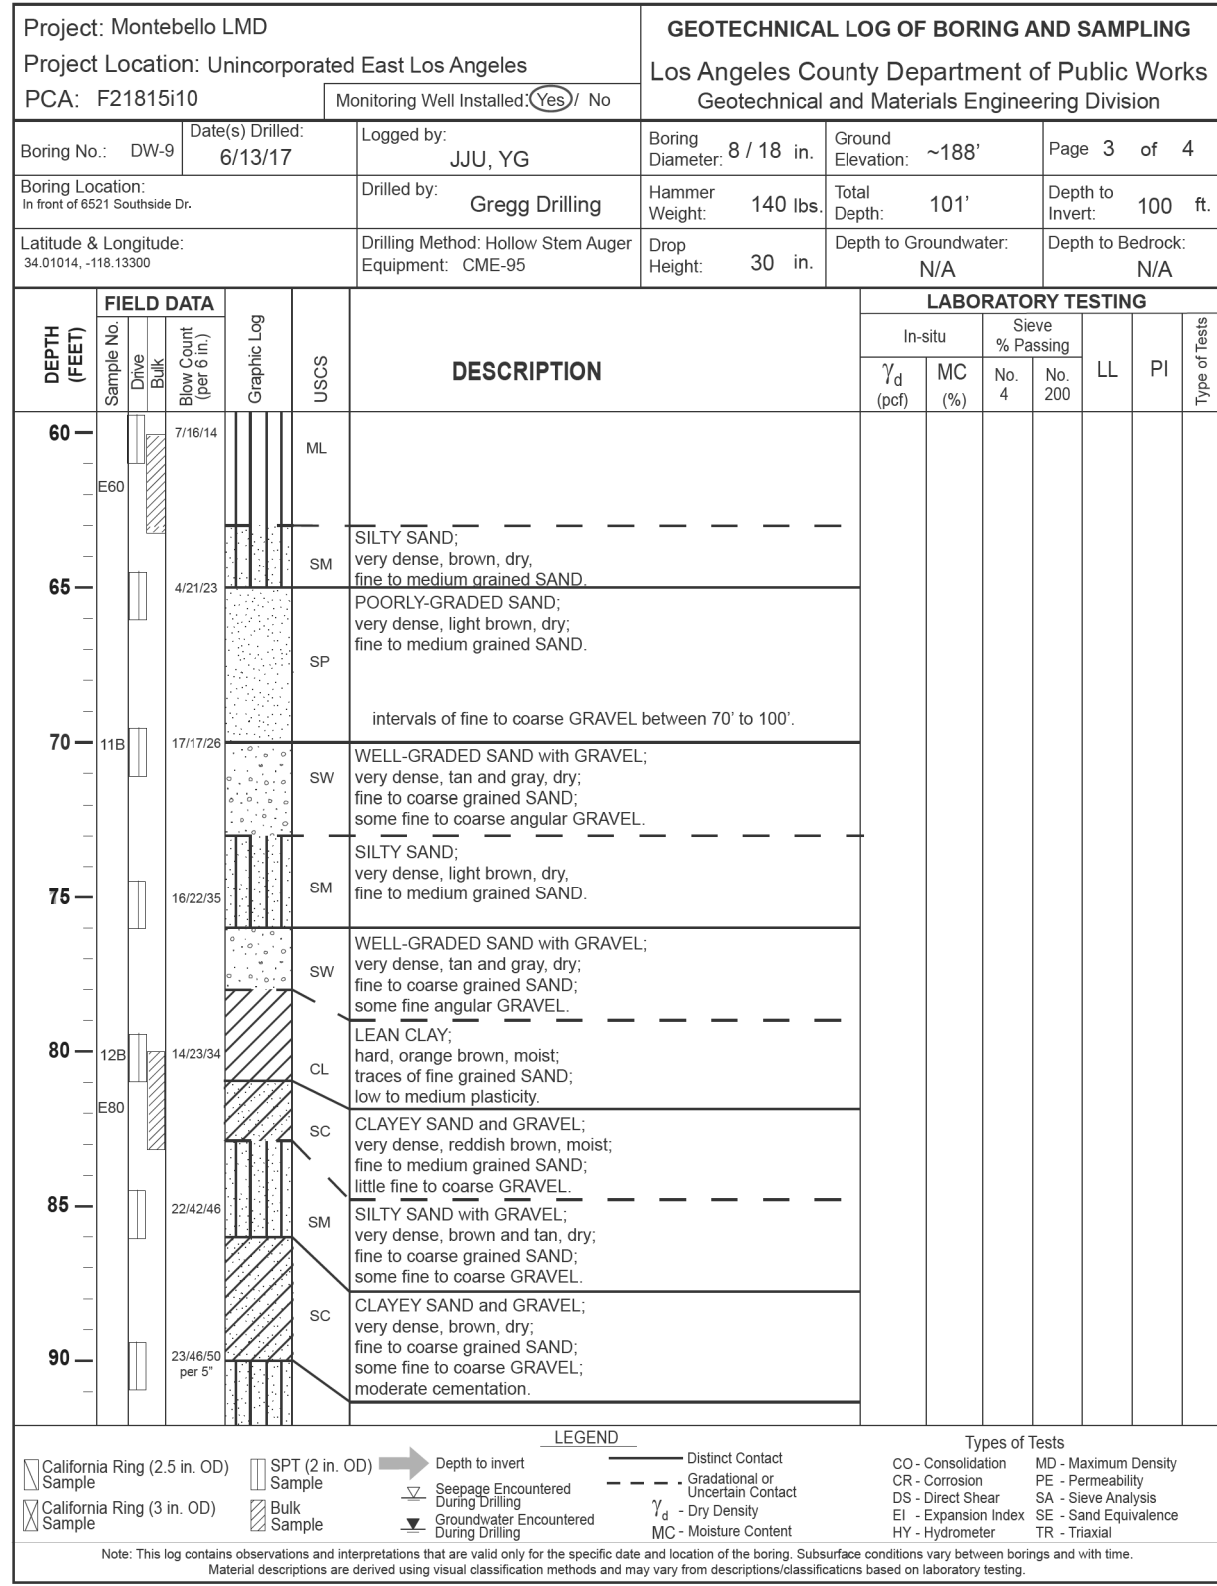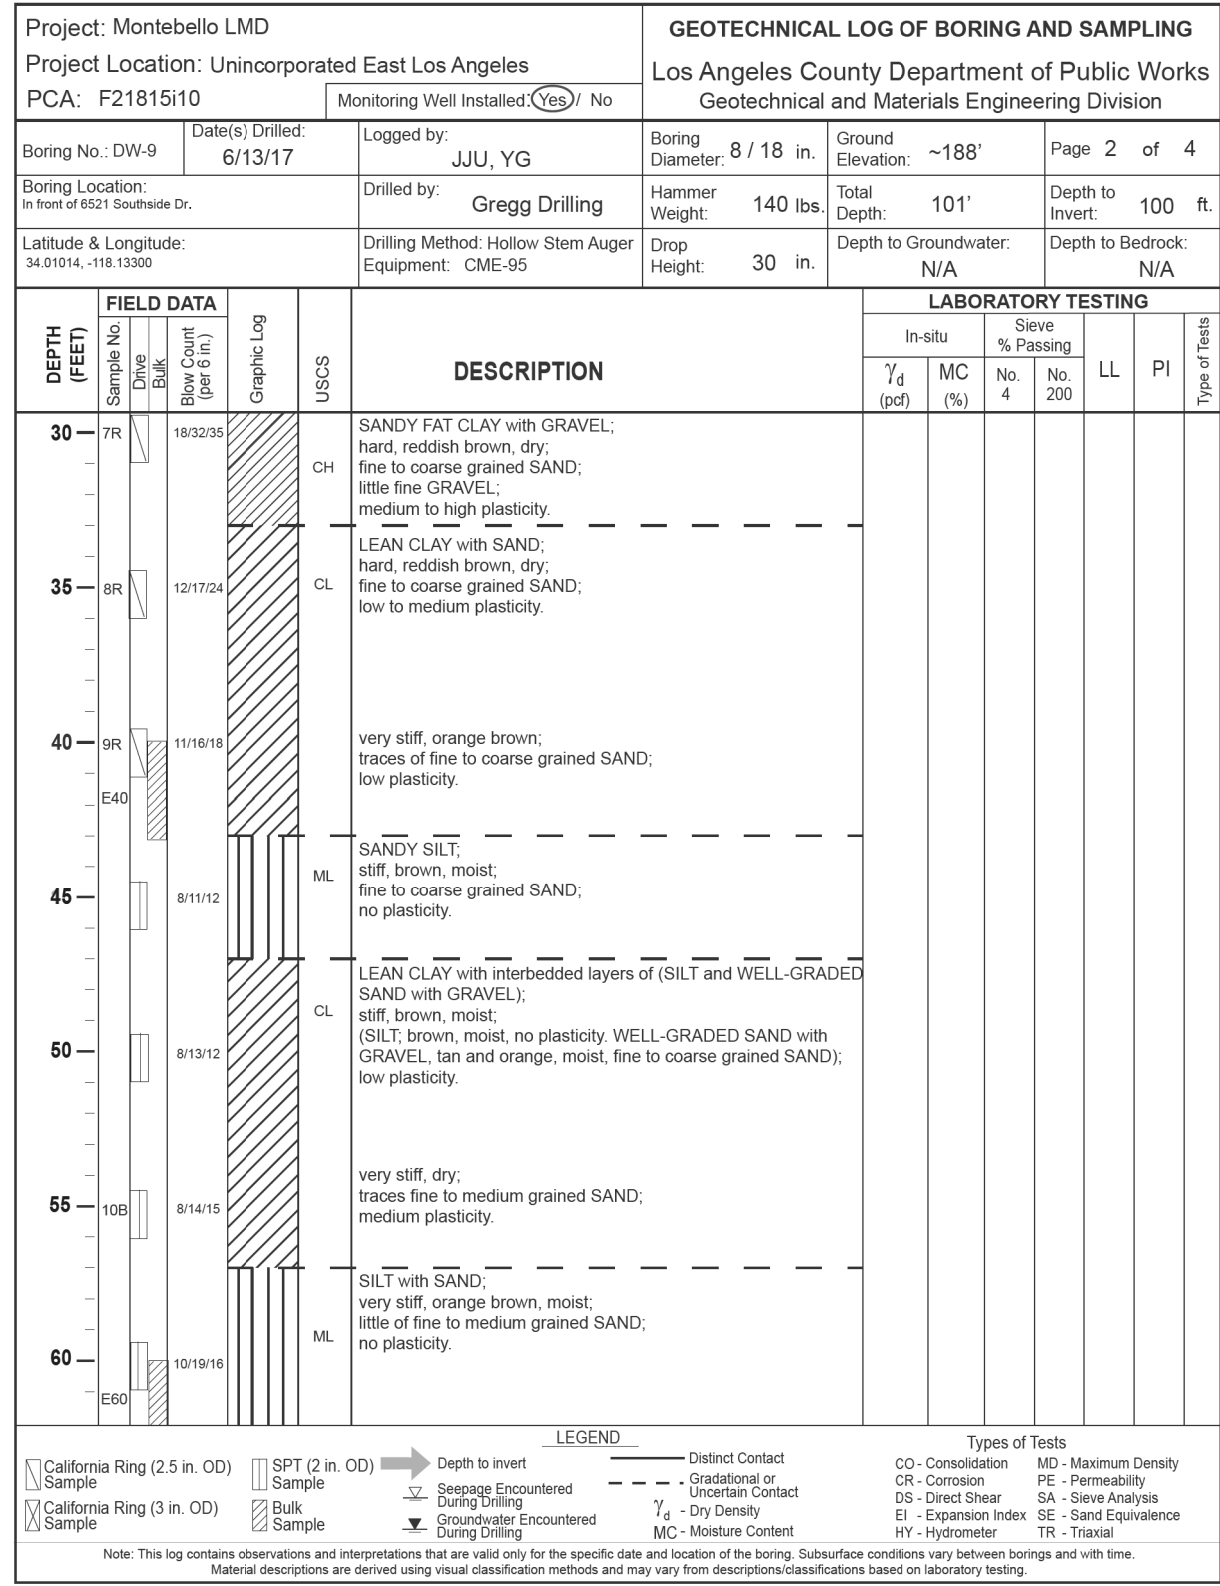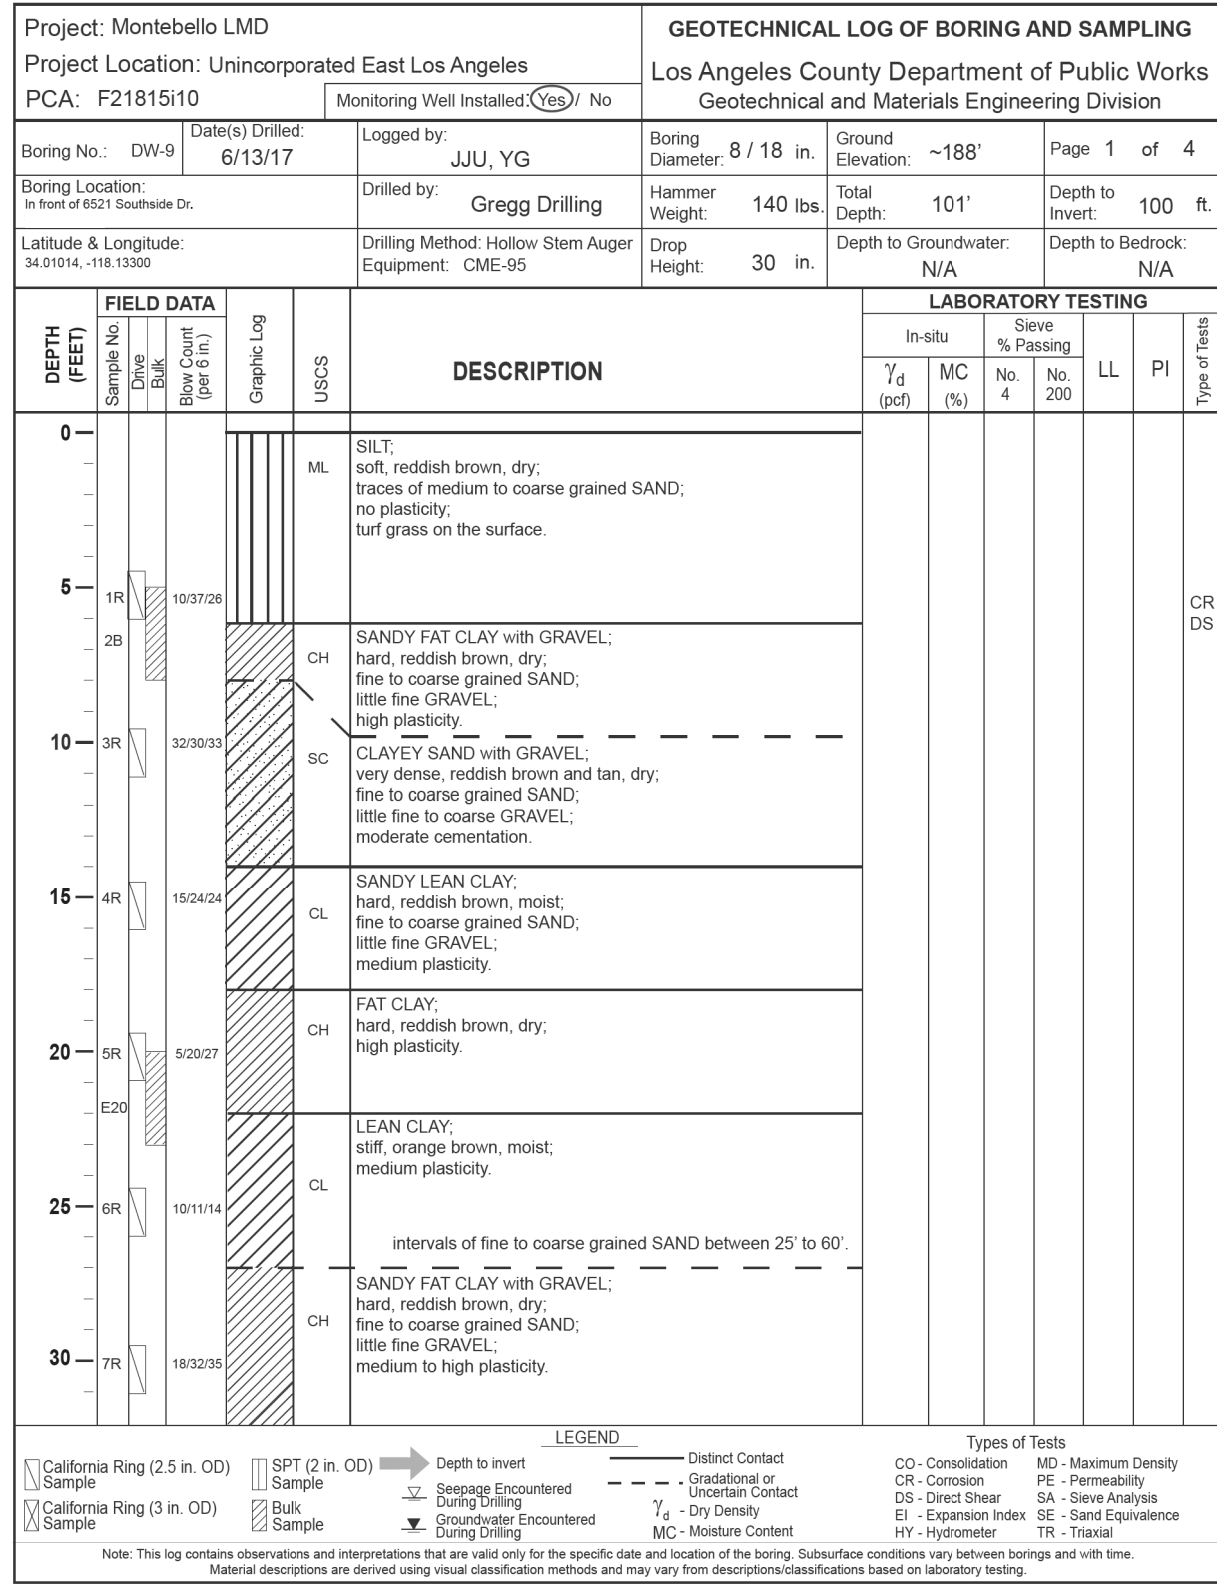

LOS ANGELES COUNTY PUBLIC WORKS

EAST LOS ANGELES
SUSTAINABLE MEDIAN
STORMWATER CAPTURE PROJECT

LOG OF BORINGS

PROJECT ID NO. WMU0000010

04/28/22

AS BUILT REVISIONS

DATE

REVISIONS

03/27/18

PROJECT ENGINEER

DATE

LACFD INDEX NO. 116-D27

P0053092

SHEET 23 OF 26-27

AS BUILT DRAWINGS

PLAN DR

Project: Montebello LMD					GEOTECHNICAL LOG OF BORING AND PUBLIC WORKS						
Project Location: Unincorporated East Los Angeles					Los Angeles County Department of Public Works						
PCA: F2181510					Geotechnical and Materials Engineering Division						
Boring No.: DW-12		Dates Drilled: 6/19/17		Logged by: JUI, YG		Boring Diameter: 8" / 18 in.		Ground Elevation: ~196'		Page 1 of 4	
Boring Location: at West of 61st Northeast Dr.		Drilled by: Gregg Drilling		Drilling Method: Hollow Stem Auger		Hammer Weight: 140 lbs.		Total Depth: 101'		Depth to Invert: 101'	
Latitude & Longitude: 34.01349, -118.15248		Drilling Method: Hollow Stem Auger		Drilling Method: CME-85		Drop Height: 30 in.		Depth to Groundwater: N/A		Depth to Bedrock: N/A	
DEPTH (FEET)		FIELD DATA		DESCRIPTION		LABORATORY TESTING					
Sample No.	Soil Bank	Time (min)	Graphic Log	USCS	DESCRIPTION	In-situ γ _d (pcf)	Sw %	Shrinkage % (No. 40)	LL %	PI %	Type of Test
0				ML	SILT with SAND; soft, reddish brown, dry; fine medium to coarse grained SAND; no plasticity; hard grass on the surface.						
5		6/11/20		CL	LEAN CLAY with SAND; soft, brown, dry; fine medium to coarse grained SAND; low plasticity.						
8		1B		CH	SANDY FAT CLAY with GRAVEL; very stiff, brown, dry; fine to coarse grained SAND; little fine GRAVEL; high plasticity.						
10		3R	6/14/20	SC	CLAYEY SAND with GRAVEL; very dense, brown, moist; fine to coarse grained SAND; moderate cementation.						
15		4R	6/11/22		dense, reddish brown; intervals of fine to coarse grained SAND and fine to coarse GRAVEL between 0' to 100'.						
20		5R	6/11/19	CL	LEAN CLAY; soft, reddish brown, moist; traces of fine to medium grained SAND; low to medium plasticity.						
25		6R	14/25/17		SANDY LEAN CLAY with GRAVEL; hard, brown and orange, moist; fine to coarse grained SAND; little fine GRAVEL; medium plasticity.						
30		7R	7/18/20		increase of fine to coarse grained SAND at 30'.						

California Ring (2.5 in. OD)
Sample

California Ring (3 in. OD)
Sample

SPT (2 in. OD)
Sample

Seepage Encountered
During Drilling

Gravelly Sand Encountered
During Drilling

Disturbed Contact

Undisturbed Contact

γ_d - Dry Density

MC - Moisture Content

Tests of Types

CO - Consolidation

CR - Compression

DS - Direct Shear

EP - Expansion Index

HY - Hygroscopic

FE - Permeability

SA - Stress Analysis

SE - Sand Equivalence

TS - Triaxial

Note: This log contains observations and interpretations that are valid only for the specific date and location of the boring. Subsurface conditions vary between borings and with time.
Detailed descriptions are derived using visual classification methods and may vary from descriptions/classifications based on laboratory findings.

Project: Montebello LMD

Project Location: Unincorporated East Los Angeles

PCA: F2181510

Monitoring Well Installed

Yes

No

Boring No.: DW-12

Dates: Drilled
6/19/17

Logged by
JUJ, YG

Boring Location:
at West of 61st Street Dr.

Drilling Method: Hollow Stem Auger
Equipment: CME-93

GEOTECHNICAL LOG OF BORING AND PUBLIC WORKS

Los Angeles County Department of Public Works

Geotechnical and Materials Engineering Division

Boring No.: DW-12

Dates: Drilled
6/19/17

Logged by
JUJ, YG

Boring Diameter:
8" / 18 in.

Ground Elevation:
~196'

Total Depth:
101'

Depth to Invert:
100 ft

Depth to Bedrock:
N/A

Page 2 of 4

Boring Location:
at West of 61st Street Dr.

Drilling Method: Hollow Stem Auger
Equipment: CME-93

Drop Height:
30 in.

Depth to Groundwater:
N/A

FIELD DATA

LABORATORY TESTING

DEPTH (FEET)	Sample No.	Field Chart (1/8" = 1')	Graphic Log	USGS	DESCRIPTION	LABORATORY TESTING						Type of Test
						In-situ Yd (%)	Sieve % Passing No.	MC (%)	No.	LL	PI	
30	7R	71625		CL	CLAYEY SAND with GRAVEL, very dense, brown, moist; fine to coarse grained SAND, little fine to coarse GRAVEL							
35	8R	82207		SC	CLAYEY SAND with GRAVEL, very dense, brown, moist; fine to coarse grained SAND, little fine to coarse GRAVEL							
40	9R	133034		SM	SILTY SAND with GRAVEL, very dense, orange brown, moist; fine to coarse grained SAND, little fine to coarse GRAVEL							
40	E40			SP	POORLY-GRADED SAND with GRAVEL, dense, tan and orange, dry; fine to medium grained SAND, traces of coarse GRAVEL							
45	10R	92121		SC	CLAYEY SAND with GRAVEL, medium dense, reddish brown, moist; fine to coarse grained SAND, some fine to coarse GRAVEL							
50	10B	61011		SW	WELL-GRADED SAND with GRAVEL, dense, orange brown, dry; fine to coarse grained SAND, little fine to coarse GRAVEL							
55	11R	122020		SM	SILTY SAND with GRAVEL, dense, brown, dry; fine to coarse grained SAND, little fine to coarse GRAVEL							
60	E60	91417		SM	SILTY SAND with GRAVEL, dense, brown, dry; fine to coarse grained SAND, little fine to coarse GRAVEL							

California Ring (2.5 in. OD)

Sample

SPT (2 in. OD)

Sample

Swage

Sample

Blank

Sample

Curf Drilling

Sample

Depth to Invert

Gratification or Unsettled Contact

T₂ - Dry Density

MC - Moisture Content

Distinct Contact

Types of Tests

CO - Consolidation

CR - Compression

DS - Direct Shear

E - Expansion Index

HY - Hydrometer

MD - Maximum Density

PE - Permeability

SA - Stress Analysis

SE - Sand Equivalence

TS - Triaxial

Note: This log contains observations and interpretations that are valid only for the specific date and location of the boring. Subsurface conditions vary between borings and with time.

Negative descriptions are derived using standard classification methods and may vary from description/classifications based on laboratory findings.

Project: Montebello LMD

Project Location: Unincorporated East Los Angeles

PCA: F2181510

Monitoring Well Installed?

☒ No

Boring No.: DW-12

Datums Drilled: 6/19/17

Logged by: JUJ, YG

Boring Diameter: 8 / 18 in.

Ground Elevation: ~196'

Page 3 of 4

Boring Location:
in front of 4514 Normandie Dr.

Drilled by: GREG Gilling

Hammer Weight: 140 lb.

Latitude & Longitude:
34.01549, -118.15248

Drilling Method: Hollow Stem Auger Equipment: CME-95

Drop Height: 30 in.

Total Depth: 101'

Depth to Invert:

Depth to Bedrock: N/A

DEPTH (FEET)	FIELD DATA		USCS	DESCRIPTION	LABORATORY TESTING					Type of Test	
	Sample No.	Bulk			Grain Size Log	In situ	Swave	No.	LL		PI
60				SM							
60											
65											
65				ML							
70											
70											
75				SW							
75				SM							
80											
80											
85				ML							
85											
90				SM							
90											

California Ring (2.5 in. OD) Sample

SPT (2 in. OD) Sample

Swave Logging During Driving

Gravel Encountered During Driving

Distorted Contact

Gravitational or Unsettled Contact

Dry Density

Moisture Content

CO - Consolidation

CR - Compression

DS - Direct Shear

EI - Expansion Index

HY - Hydrometer

MO - Maximum Density

FE - Permeability

SA - Sieve Analysis

SE - Sand Equivalence

TR - Triaxial

Note: This log contains observations and interpretations that are valid only up to the specific date and location of the boring. Subsequent conditions may vary from those described based on borings and soil time.

Natural descriptions are derived using standard methods and may vary from descriptive classifications based on laboratory tests.

Project: Montebello LMD

Project Location: Unincorporated East Los Angeles

PCA: F218510

Monitoring Well Installed?

Yes

No

Boring No.: DW-12

Boring Location:
on corner of 610 N. Normandie Dr.

Latitude & Longitude:
34.01349, -118.13248

Date(s) Drilled:
6/19/17

Logged by:
JUJ, YG

Drilled by:
Gregg Drilling

Drilling Method: Hollow Stem Auger Equipment: CME-95

Boring Diameter: 8 / 18 in.

Ground Elevation: ~196'

Total Depth: 101'

Depth to Groundwater: N/A

Page 4 of 4

Depth to Invert:

Depth to Bedrock: N/A

DEPTH (FEET)	FIELD DATA		USGS	DESCRIPTION	LABORATORY TESTING						Type of Test
	Sample No.	Blow Count (per ft.)			In-situ	Sieve % Passing	LL	PI	MC (%)		
										γ_d (pcf)	
90	126	172740	SM	CLAYEY SAND: very dense, reddish brown, moist; fine to coarse grained SAND; moderate cementation							
95	138	143234	SC								
100	140	216524									
105				dense, brown, dry; little fine to coarse GRAVEL							
110				End of boring at 101'; boring terminated at planned depth, no groundwater was encountered.							
115											
120											

California Ring (2.5 in. OD)
Sample

California Ring (3 in. OD)
Sample

SPT (2 in. OD)
Sample

Sample

Sample

Depth to Invert

Seepage Encountered

Caving/Drilling

Curving Encountered

Curving Drilling

Distinct Contact

Gradational or Unsettled Contact

γ_d - Density

MC - Moisture Content

Types of Tests

CO - Consolidation

CR - Compression

DS - Direct Shear

E - Expansion Index

IPI - Hydrometer

MD - Maximum Density

FE - Permeability

 
SA - Sieve Analysis


SE - Sand Equivalence









TS - Triaxial

Note: This log contains observations and interpretations that are valid only for the specific date and location of the boring. Subsurface conditions vary between borings and with time.

Material descriptions are derived using visual classification methods and may vary from descriptions/classifications based on laboratory testing.


04/28/22		AS BUILT REVISIONS
DATE	MK	DESCRIPTION
REVISIONS		

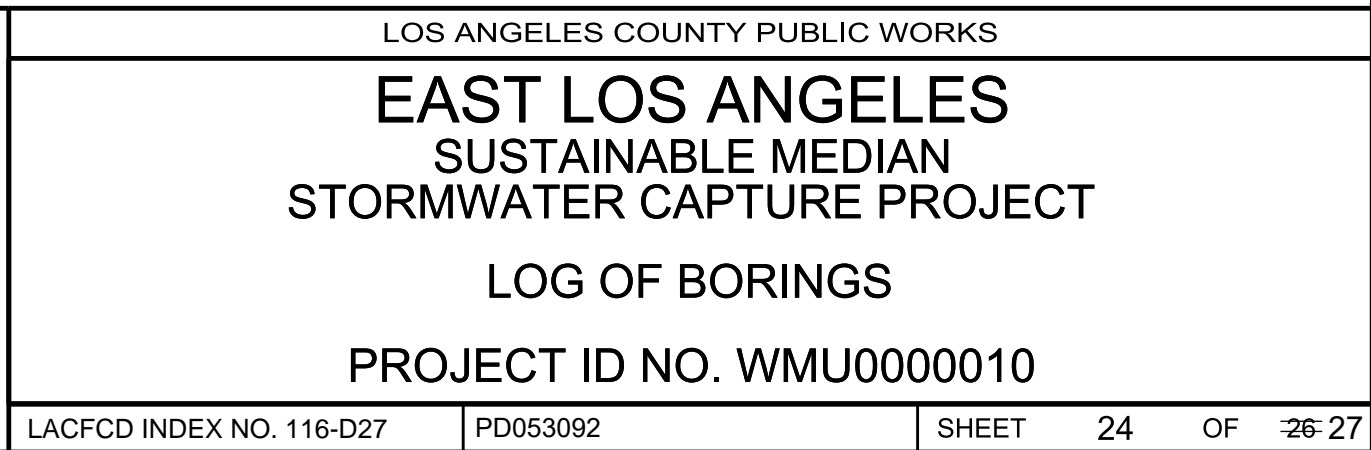

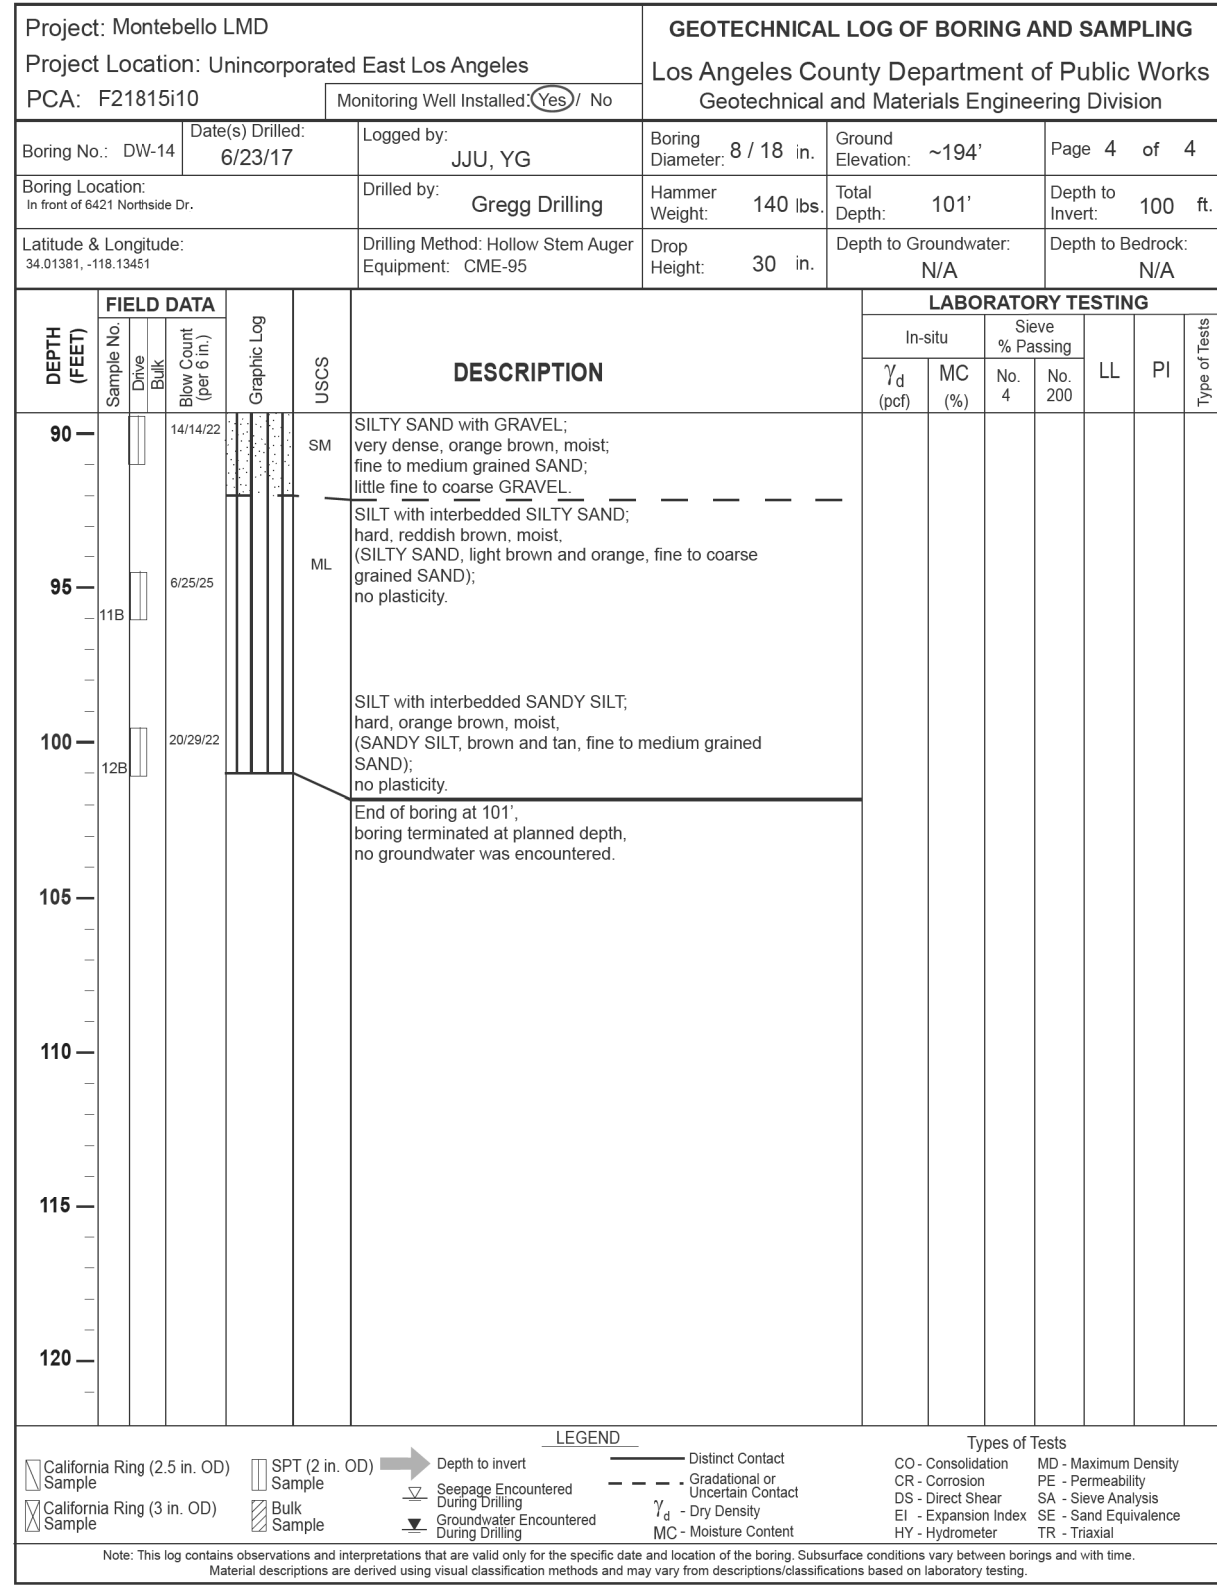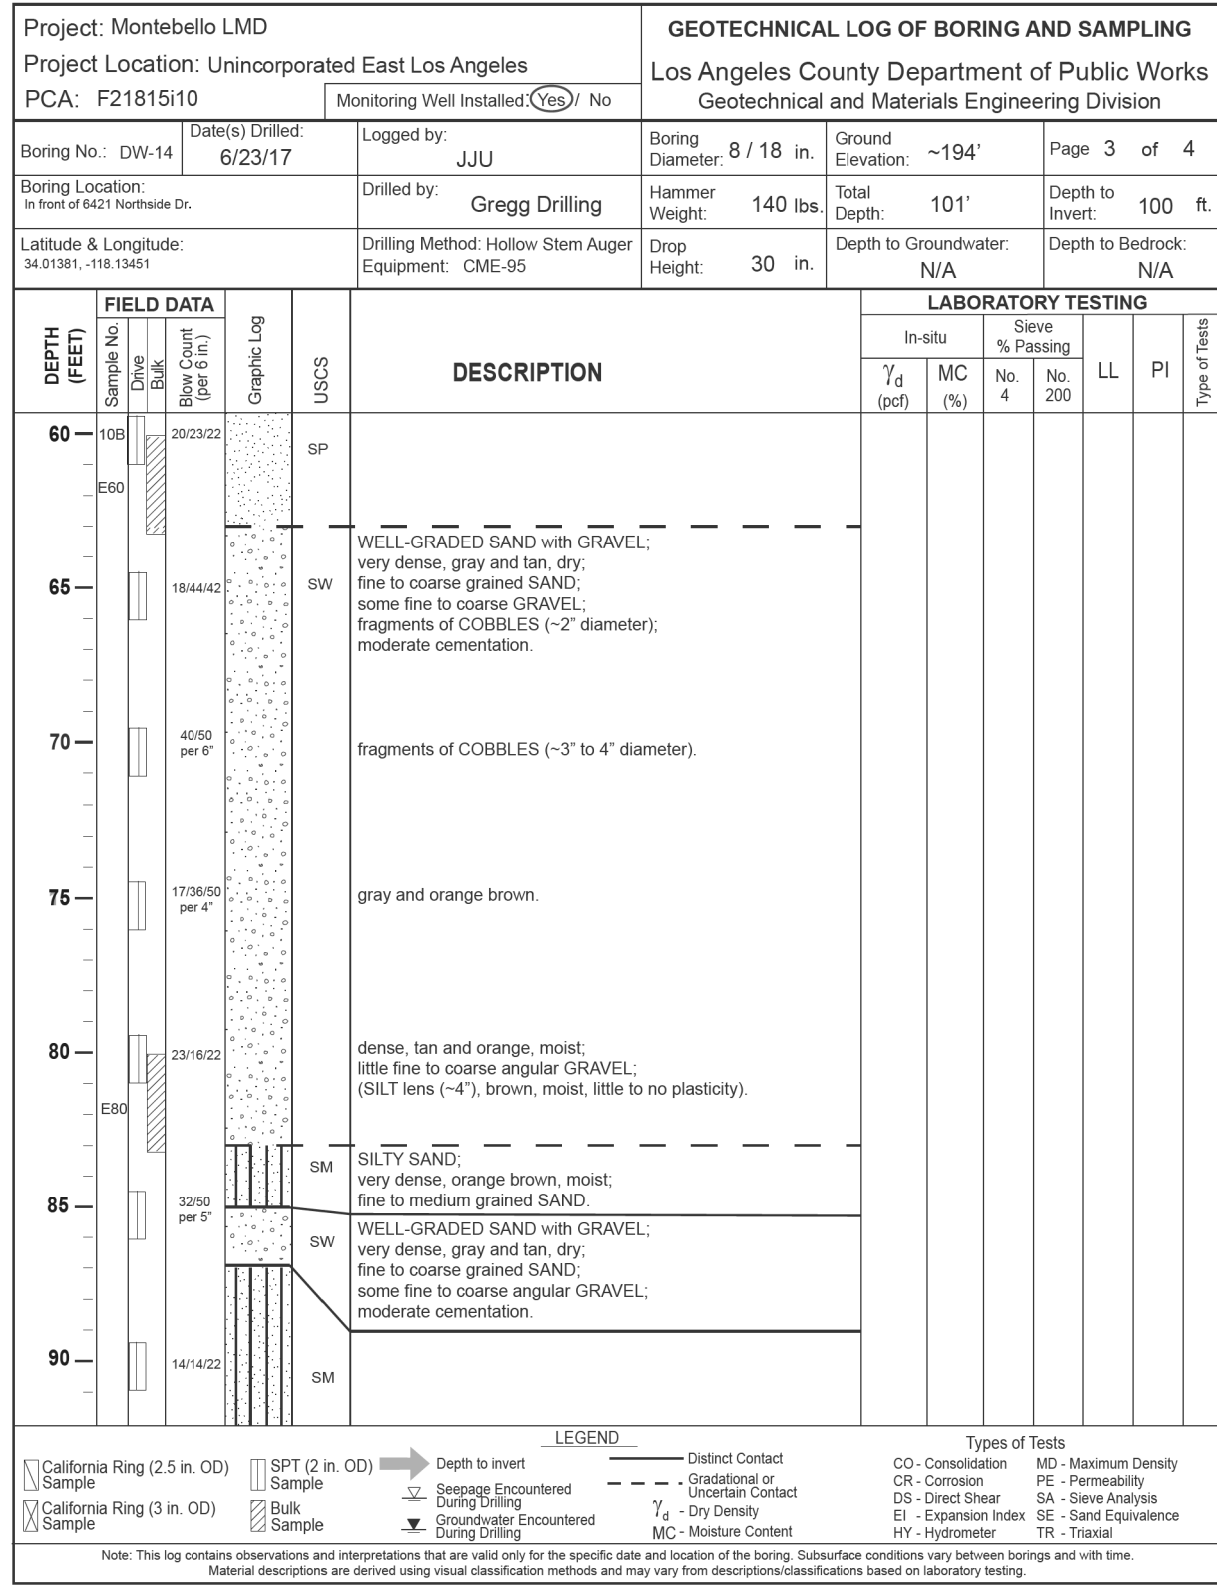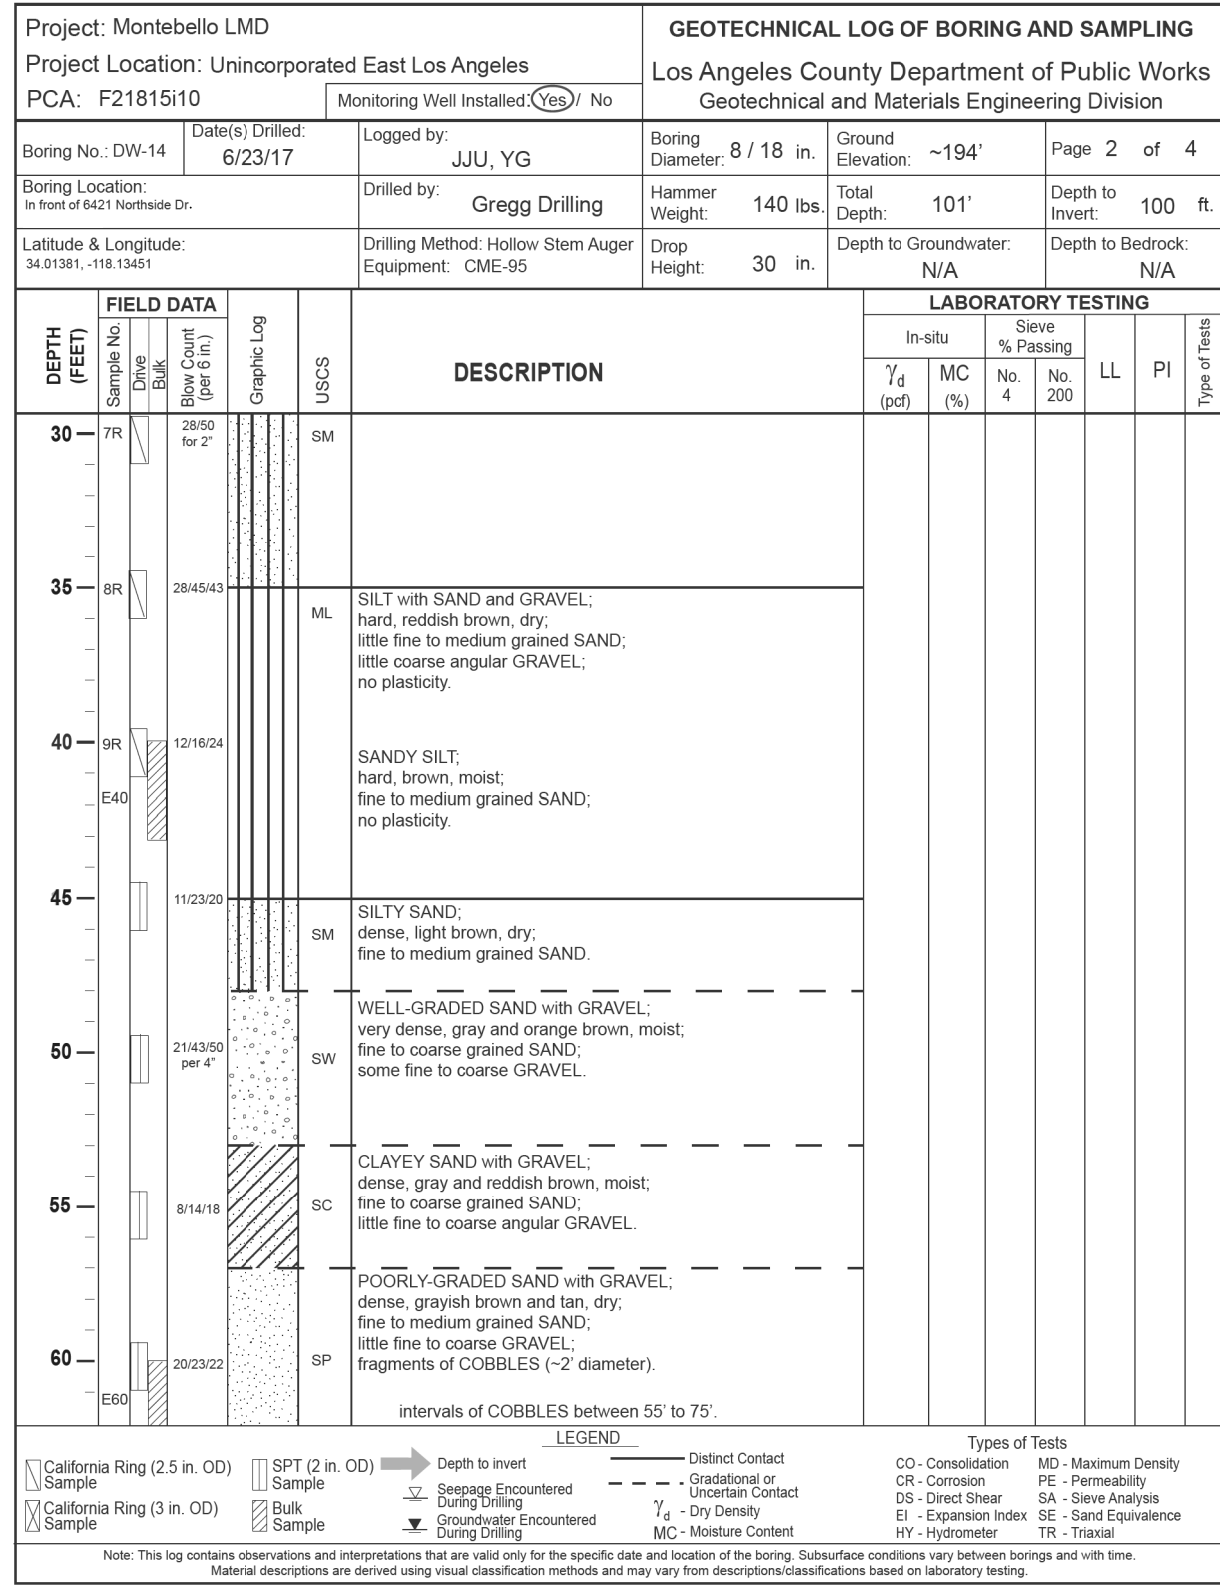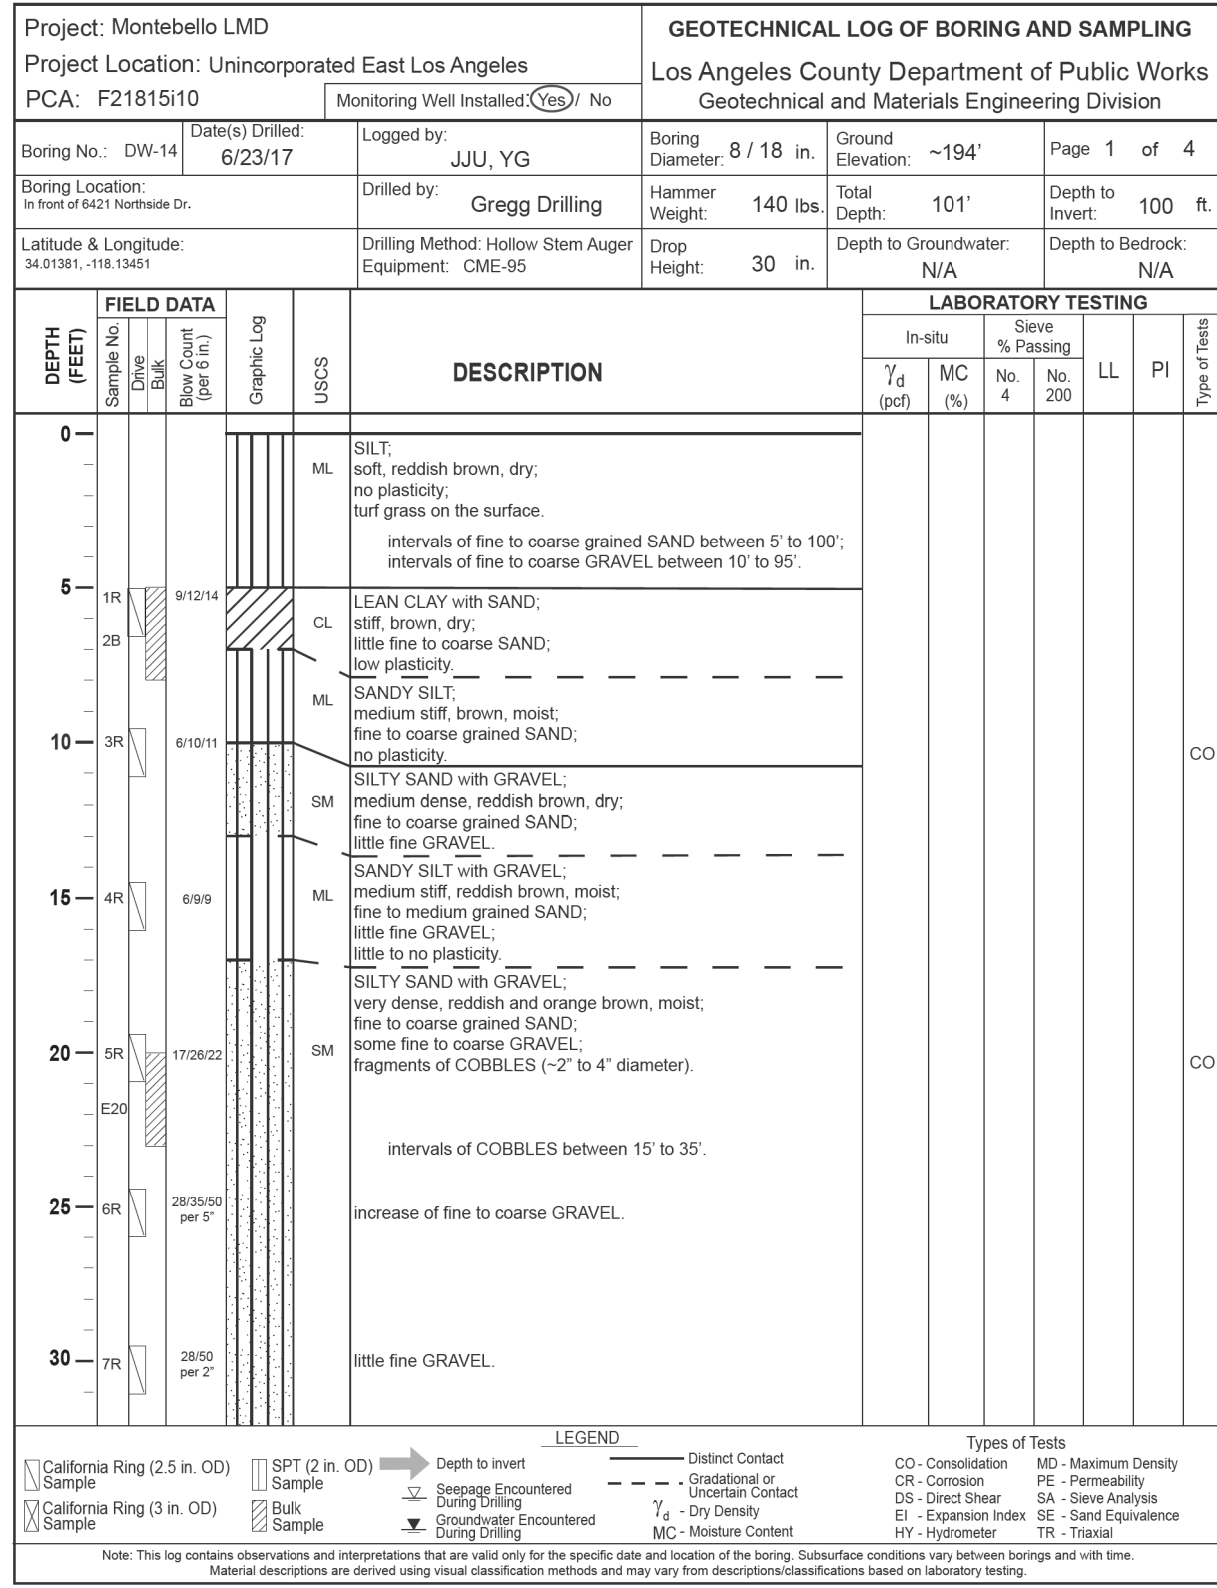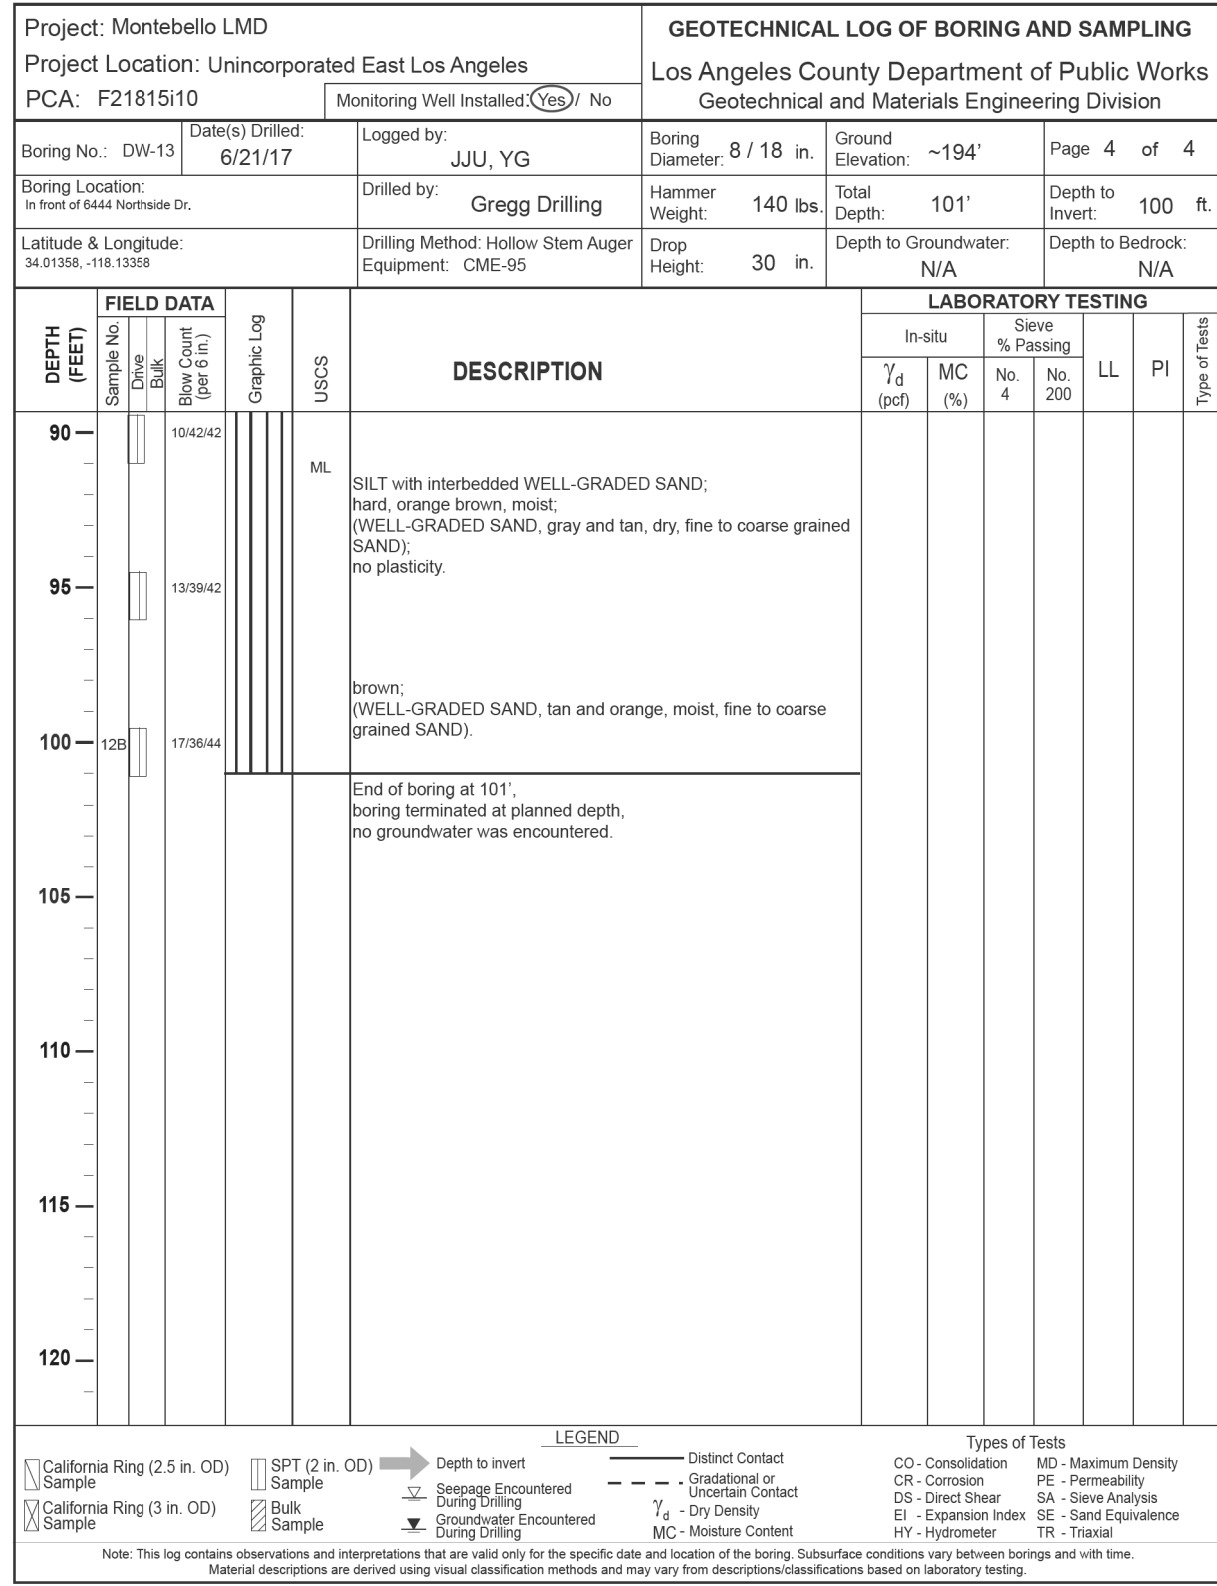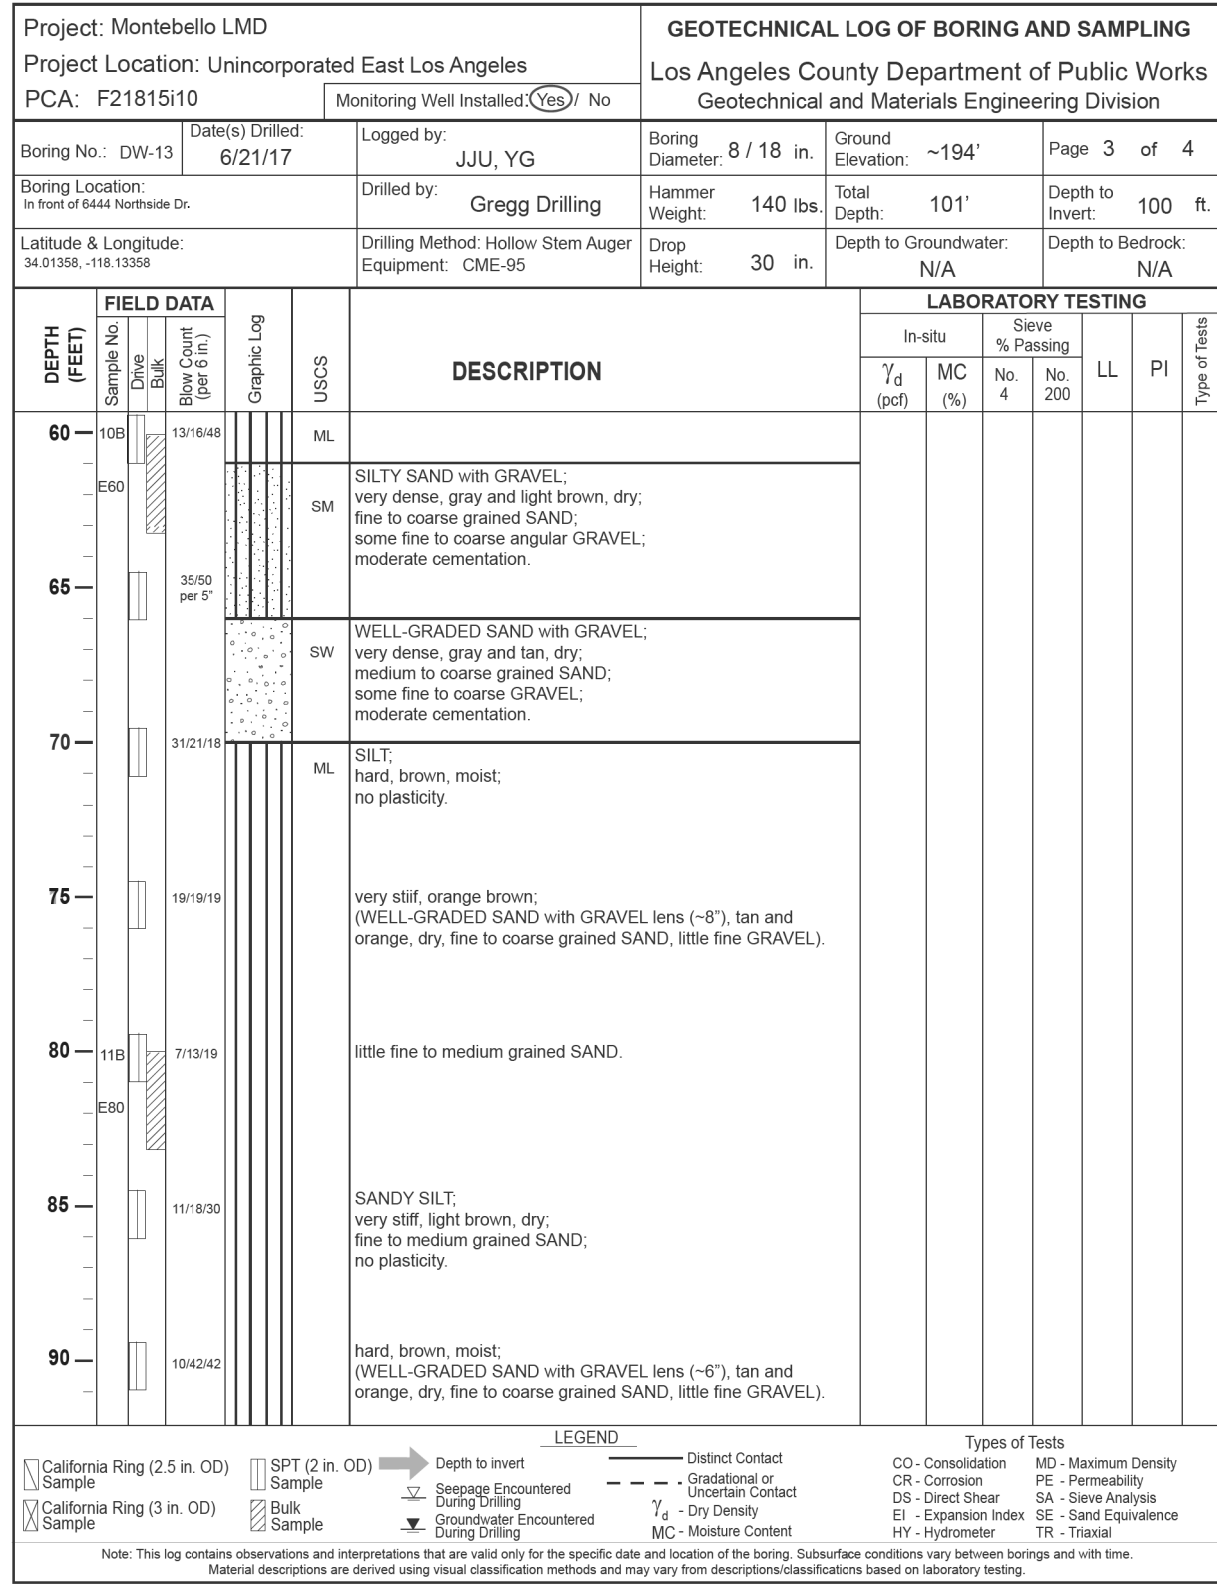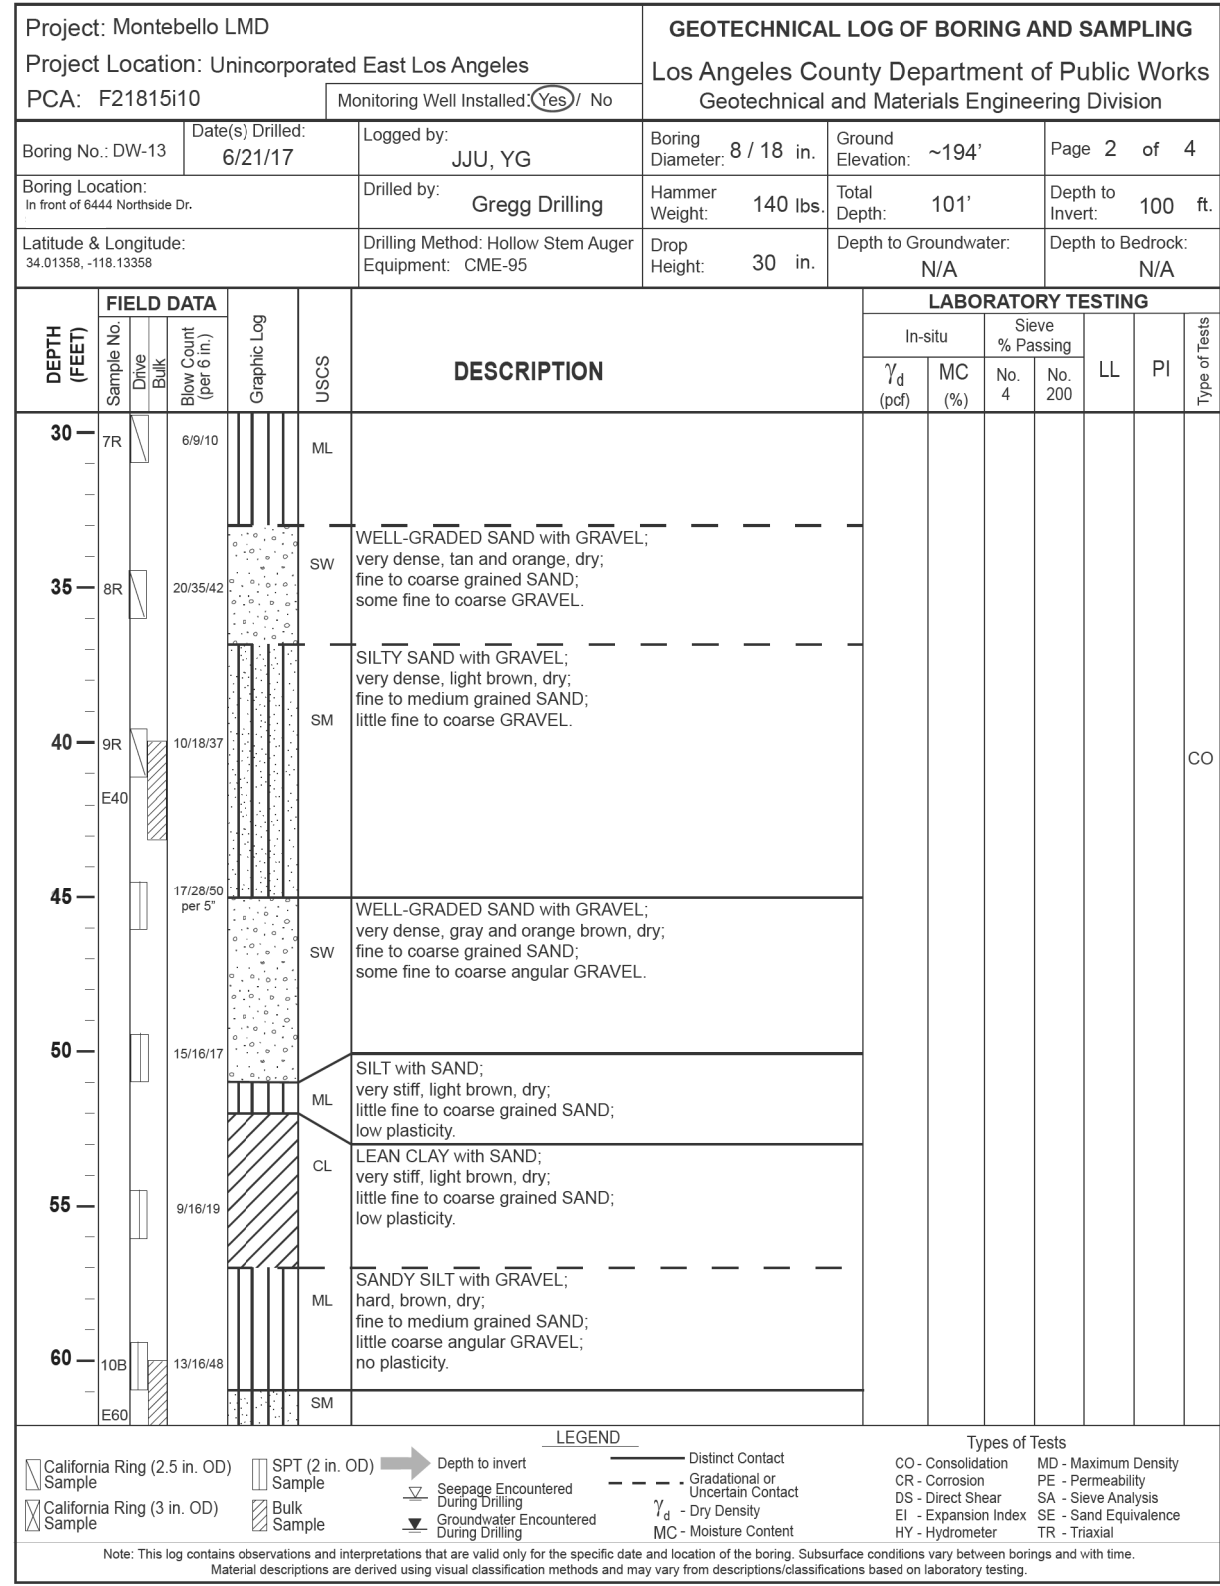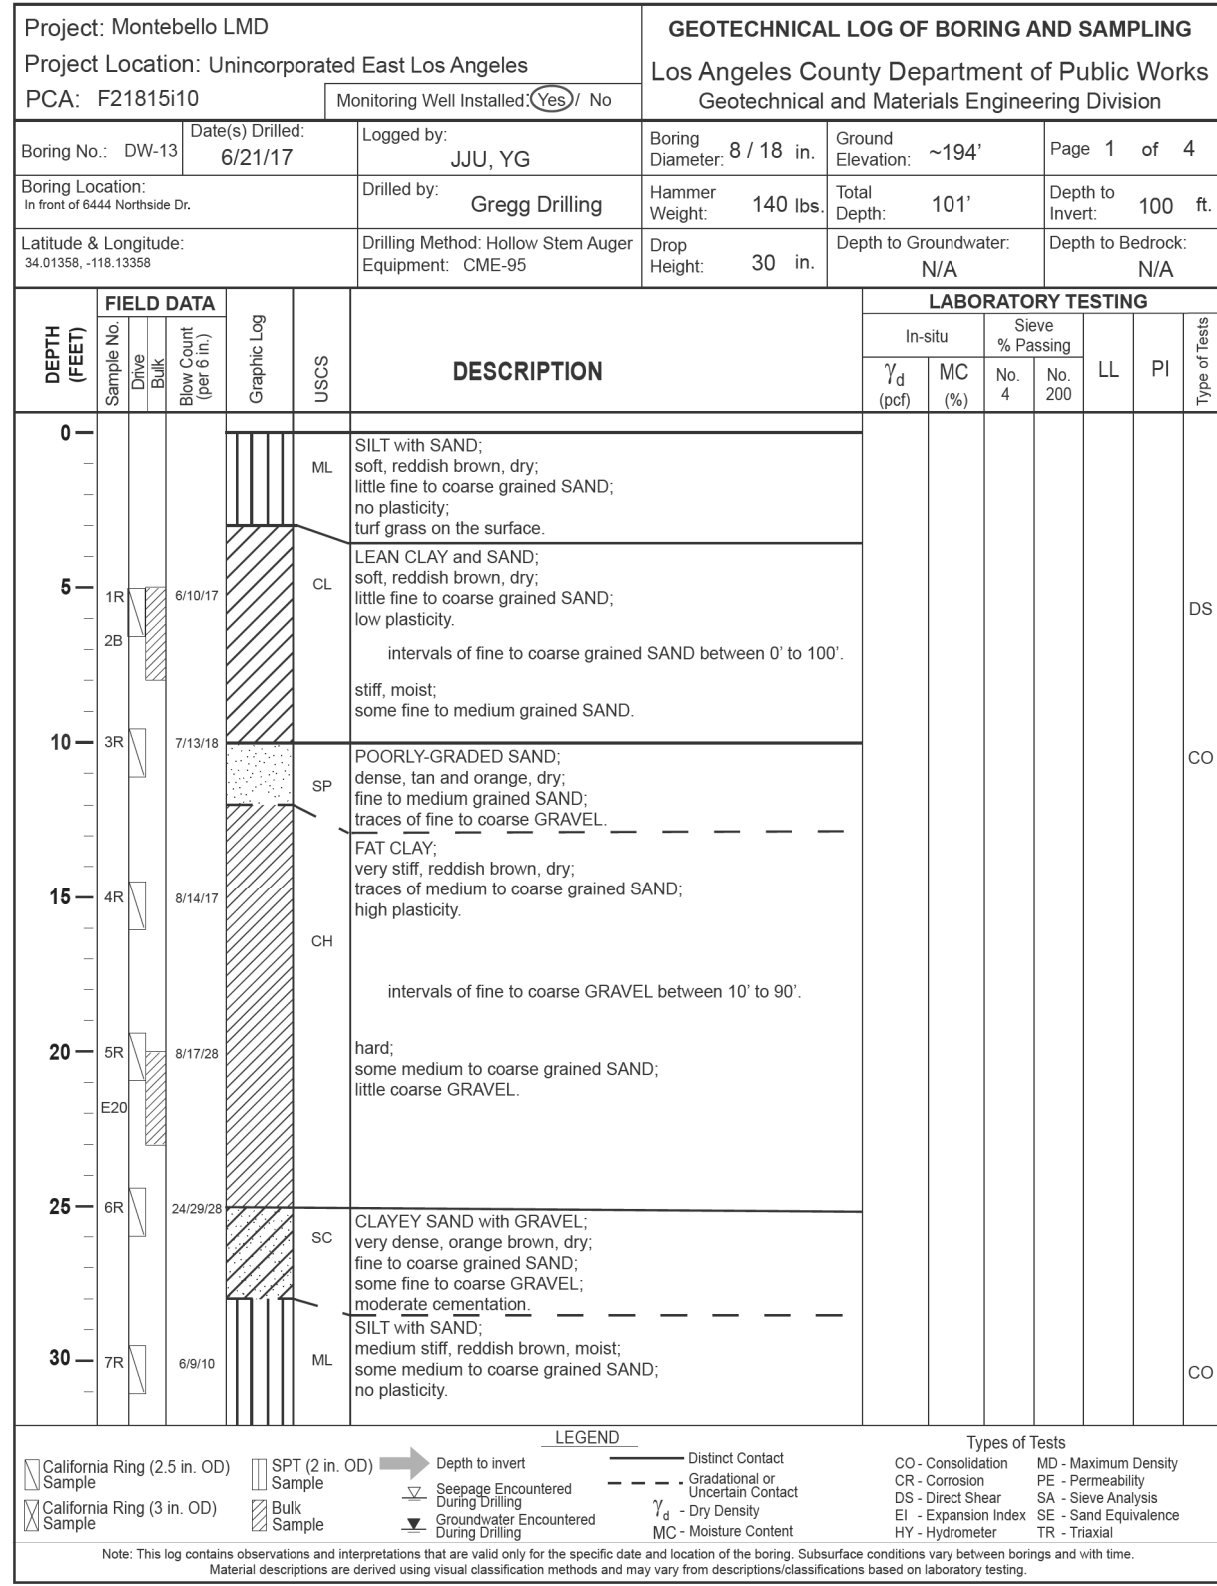

CADD PROJECT FILE NAME
CHECKER
DESIGNER
DRAFTER

04/28/22	AS BUILT REVISIONS
DATE	DESCRIPTION
REVISIONS	



PROJECT ENGINEER

03/27/18

DATE

LOS ANGELES COUNTY PUBLIC WORKS

EAST LOS ANGELES
SUSTAINABLE MEDIAN
STORMWATER CAPTURE PROJECT

LOG OF BORINGS

PROJECT ID NO. WMU0000010

LACFD INDEX NO. 116-D27

PD053092

SHEET 25 OF 26-27

AS BUILT DRAWINGS

PLAN DR

ELEV T
177.71
177.38
178.18
177.48
178.44
179.00
178.16
178.10
179.89
179.41
179.52
178.6
179.40
177.80

TABLE 1.1 (SH 4)
DRY WELLS
LINES A-1 AND A-2

ELEV T
166.26
167.85
167.64
168.23
166.03
168.02
















TABLE 3.1 (SH 6)
DRY WELLS LINE B-1

ELEV T
191.69
190.31
189.50
190.64
191.03
190.24
191.63
190.44
191.43
192.53
191.31
192.82
193.60
192.67

TABLE 4.1 (SH 7)
DRY WELLS LINE C-1

ELEV T
181.22
182.27
182.85
183.09
183.10
183.70
183.82
184.60
186.44
186.29
187.10
185.46
185.44
185.38
186.15

TABLE 6.1 (SH 9)
DRY WELLS
LINE D-1

Project: Montebello LMD			GEOTECHNICAL LOG OF BORING AND SAMPLING							
Project Location: Unincorporated East Los Angeles			Los Angeles County Department of Public Works							
PCA #: F2181510			Geotechnical and Materials Engineering Division							
Boring No.: B8	Date(s) Drilled: 1/19/16	Logged by: JJU	Boring Diameter: 10 in.	Ground Elevation: ~196'	Page 1 of 2					
Boring Location: In front of 6465 E. Northside Drive, center grass			Drilled by: FMD	Hammer Weight: 140 lbs.	Depth to Invert: 10 ft.					
Latitude & Longitude: 34.07359, -118.123144			Drilling Method: Hollow Stem Auger	Drop Height: 30 in.	Depth to Groundwater: N/A					
			Equipment: CME		Depth to Bedrock: N/A					
DEPTH (FEET)	FIELD DATA		DESCRIPTION	LABORATORY TESTING						
	Sample No. / Depth (ft.)	Graphic Log		In-situ γ_d (pcf)	Moisture Content (%)	Specific Gravity G_s	LL (%)	PI (%)	Type of Test	
0			ML SILT with SAND soft, reddish brown, dry; some medium to coarse grained SAND; organics at surface.							
5	IR 102221		Well-graded SAND with SILT and GRAVEL dense, red-brown, moist; some non-plastic SILT, little fine to coarse GRAVEL; moderate cementation.	115.6	8.7	100	26.7			DS SA
10	OR 715117		Well permeability testing performed at 5'-10'							CR SA
15	IR 102023		SILTY, CLAYEY SAND dense, red-brown, moist; fine to medium grained SAND; moderate cementation.	76.4	11.4	100	41.5			SA
20	OR 82426		traces of fine GRAVEL.	114.1	12.7	100	39.7			DS SA
25	IR 72748		CLAY with SAND very hard, red-brown, moist; traces of fine to medium grained SAND.	112.5	10.9	100	41.8	25	12	SA
30	OR 71338		little medium to coarse grained SAND.	121.8	12.4	100	70.0			
			some coarse GRAVEL.							
			little coarse GRAVEL.							
			LEGEND			Types of Tests				
California Ring (2.5 in. CO)  Depth to Invert  District Contact 			Swage Encountered  Drilling Encountered  Moisture Contact 			CO - Consolidation  PE - Permeability  LA - Stress Analysis  TH - Expansion Index  TC - Soil Equivalents 				
California Ring (2.5 in. CO)  SPT (2 in. CO)   										
Note: This log contains observations and interpretations that are valid only for the specific date and location of the boring. Subsurface conditions may vary between borings and with time. Material descriptions are derived using visual classification methods and may vary from descriptions due to fluctuations based on laboratory testing.										

Project: Montebello LMD			GEOTECHNICAL LOG OF BORING AND SAMPLING							
Project Location: Unincorporated East Los Angeles			Los Angeles County Department of Public Works							
PCA: F2181510			Geotechnical and Materials Engineering Division							
Boring No.: B10	Date(s) Drilled: 4/25/16	Logged by: JJU	Boring Diameter: 10 in.	Ground Elevation: ~195'	Page 1 of 2					
Boring Location: In front of 6465 E. Northside Drive, center grass median.			Drilled by: FMD	Hammer Weight: 140 lbs.	Depth to Invert: 10 ft.					
Latitude & Longitude: 34.07374, -118.13979			Drilling Method: Hollow Stem Auger	Drop Height: 30 in.	Depth to Bedrock: N/A					
			Equipment: CME							
DEPTH (FEET)	FIELD DATA	GRAPHIC LOG	DESCRIPTION	LABORATORY TESTING						
				In-situ γ _d (pcf)	Moisture MC (%)	Specific Gravity G _s	Unit Weight No. 4	LL (%)	PI (%)	
0			ML SILT with SAND soft, brown, lightly moist; traces of medium to coarse grained SAND; organics at surface.							
5	1R	711228								
			hard, red-brown, moist; little of fine to medium grained SAND.							
10	2R	3825								
			CLAYEY SILT with SAND hard, red-brown, moist; little fine to medium grained SAND.							
			traces of fine GRAVEL							
15	3R	211115								
			SC CLAYEY SAND with GRAVEL medium dense, red-brown, moist; medium to coarse grained SAND; some fine GRAVEL; moderate cementation.							
20		212233								
			CL-M CLAYEY SILTY CLAY very stiff, red-brown, moist; medium to coarse grained SAND.							
			SANDY CLAY hard, red-brown, moist; medium to coarse grained SAND.							
25	4R	2405 per F								
			Well permeability testing performed at 23'-28'.							
			SW WELL-GRADED SAND with CLAY and GRAVEL very dense, red-brown, moist; some medium plastic CLAY; some coarse GRAVEL; strong cementation.							
30	5R	511117								
			CL SANDY CLAY with GRAVEL very stiff, red-brown, moist; traces of fine to coarse GRAVEL.							

California R (2.5 in. O.D.)

Sample

California R (3 in. O.D.)

Sample

SPT (2 in. O.D.)

Sample

Split Barrel Sampling

Sample

Depth to Invert

Gravel Encountered

Gravel Encountered

Distinct Contact

Gradation or Unsettled Contact

T₂ Dry Density

Moisture Content

Distinct Contact

Gradation or Unsettled Contact

T₂ Dry Density

Moisture Content

Types of Tests

CO - Consolidation

CR - Corrosion

DS - Direct Shear

EP - Expansion Index

HY - Hydrometer

MC - Maximum Density

FE - Permeability

SA - Seepage Analysis

SE - Sand Equivalence

TR - Triaxial

Types of Tests

CO - Consolidation

CR - Corrosion

DS - Direct Shear

EP - Expansion Index

HY - Hydrometer

MC - Maximum Density

FE - Permeability

SA - Seepage Analysis

SE - Sand Equivalence

TR - Triaxial

Note: This log contains observations and interpretations that are valid only for the specific date and location of the boring. Subsurface conditions may be different and with time. Material descriptions are derived using visual inspection methods and may vary from descriptions and classifications based on laboratory testing.

ELEV T
188.63
180.20
179.40

TABLE 8.1 (SH 11)
DRY WELLS LINES
E-1 AND F-1

Project: Montebello LMD				GEO TECHNICAL LOG OF BORING AND SAMPLING							
Project Location: Unincorporated East Los Angeles				Los Angeles County Department of Public Works							
PCA: F2181510				Geotechnical and Materials Engineering Division							
Boring No.: B8		Date(s) Drilled: 1/19/16		Logged by: JJU		Boring Diameter: 10 in.		Ground Elevation: ~196'		Page 2 of 2	
Boring Location: In front of 6465 E. Northside Drive, center grass median				Drilled by: FMD		Hammer Weight: 140 lbs.		Total Depth: 50'		Depth to Invert: 10 ft.	
Latitude & Longitude: 34.07359, -118.123144				Drilling Method: Hollow Stem Auger		Drop Height: 30 in.		Depth to Groundwater: N/A		Depth to Bedrock: N/A	
FIELD DATA				LABORATORY TESTING							
DEPTH (FEET)	Soils No. / Bulk / Blow (ft)	Graphic Log	USCS	DESCRIPTION	TESTS						Type of Tests
					In-situ γ_d (pcf)	Moisture MC (%)	Specific Gravity G_s	Unit Weight γ (pcf)	LL (%)	PI (%)	
30				little coarse GRAVEL.							
35	11R 120	142734	SC-SM	SILTY, CLAYEY SAND with GRAVEL very dense, orange-red and brown, moist; fine to medium grained SAND; some coarse GRAVEL; moderate cementation.	116.8	4.4	100	18.4			
40	13R 140	152031		very dense, red-brown, moist; little of medium grained SAND; traces of fine to coarse GRAVEL.	111.7	5.5	100	18.4			
45	15R 160	152042		very dense, orange-brown, moist; some fine grained SAND.	107.6	10.3	100	33.0			
50	17R 180	12251 120 ft per ft		very dense, orange-red and brown, moist; some fine to coarse GRAVEL; strong cementation.	122.2	11.9	93.9	49.7			
55				Boring terminated at 50.5'. End of boring at planned depth. Groundwater or seepage not encountered. Backfilled with cuttings and bentonite.							
60											

California Rng (2.5 in. OD)

Sample

California Rng (3 in. OD)

Sample

SPT (2 in. OD)

Sample

Seepage Encountered

Sampling

Seepage Encountered

Sampling

Depth to invert

Seepage Encountered

Sampling

Seepage Encountered

Sampling

District Contact

Consolidation or Overconsolidation

City Boundary

MC: Contour

Types of Tests

CO - Consolidation

CR - Corrosion

SC - Direct Shear

EP - Expansion Index

MD - Maximum Density

PE - Permeability

SA - Stress Analysis

SE - Sand Equivalence

TR - Triaxial

Note: This log contains observations and interpretations that are valid only for the specific date and location of the boring. Subsurface conditions may vary between borings and over time. Material descriptions are derived using visual classification methods and may vary from descriptions classifications based on laboratory testing.

Project: Montebello LMD			GEOTECHNICAL LOG OF BORING AND SAMPLING						
Project Location: Unincorporated East Los Angeles			Los Angeles County Department of Public Works						
PCA: F2181510			Geotechnical and Materials Engineering Division						
Boring No.: B10	Date(s) Drilled: 4/25/16	Logged by: JJU	Boring Diameter: 10 in.	Ground Elevation: ~195'	Page 2 of 2				
Boring Location: In front of 6465 E. Northside Drive, center grass median.		Drilled by: FMD	Hammer Weight: 140 lbs.	Total Depth: 40'	Depth to Invert: 10 ft				
Latitude & Longitude: 34.07374, -118.13979		Drilling Method: Hollow Stem Auger	Drop Height: 30 in.	Depth to Groundwater: N/A	Depth to Bedrock: N/A				
Equipment: CME									
DEPTH (FEET)	FIELD DATA		LABORATORY TESTING						Type of Tests
	Sample No. (per SPT)	Graphic Log (Scale 6"=1')	USCS	DESCRIPTION	In situ (γ _d)	Sieve No. Passing (%)	Moisture Content (%)	LL	
30	BR	51117	CL	SANDY CLAY with GRAVEL very stiff, red-brown, moist; traces of fine to coarse GRAVEL.					
35	FR	81324	SC-SM	SILTY, CLAYEY SAND with GRAVEL dense, orange-red and brown, moist; medium to coarse grained SAND; some fine to coarse GRAVEL; moderate cementation.					
40	BR	92435	SW	Well-graded SAND with CLAY and GRAVEL very dense, orange-red and brown, moist; some fine to coarse GRAVEL; moderate cementation. Boring terminated at 41'. End of boring at planned depth. Groundwater or seepage not encountered. Backfilled with cuttings and bentonite.					
45									
50									
55									
60									

California Ring (2.5 in. OD)

Sample

California Ring (3 in. OD)

Sample

SPT (2 in. OD)

Sample

SPT (Sample)

Sample

Depth to Invert

Seepage Encountered

Groundwater Encountered

Disturbance

Gratification or Unconform Contact

γ_d Dry Density

Moisture Content

Types of Tests

CO - Consolidation

CR - Corrosion

GC - Direct Shear

EM - Expansion Index

MD - Maximum Density

PE - Permeability


SA - Seismic Analysis


SE - Sead Equivalence

TR - Triaxial


Note: This log contains observations and interpretations that are valid only for the specific date and location of the boring. Subsequent conditions vary between borings and with time. Material descriptions are given only for visual classification methods and may vary from descriptions/classifications based on laboratory testing.

Project: Montebello LMD			GEOTECHNICAL LOG OF BORING AND SAMPLING											
Project Location: Unincorporated East Los Angeles			Los Angeles County Department of Public Works											
PCA: F2181510			Geotechnical and Materials Engineering Division											
Boring No.: B9	Date(s) Drilled: 1/20/16	Logged by: JJU	Boring Diameter: 10 in.	Ground Elevation: ~188'	Page 1 of 2									
Boring Location: In front of 6502 E. Southside Drive, center grass			Drilled by: FMD	Hammer Weight: 140 lbs.	Depth to Invert: 10 ft.									
Latitude & Longitude: 34.07059, -118.13289			Drilling Method: Hollow Stem Auger	Drop Height: 30 in.	Depth to Groundwater: N/A									
			Equipment: CME		Depth to Bedrock: N/A									
FIELD DATA			LABORATORY TESTING											
DEPTH (FEET)	SAMPLE NO.	Soils / Bulk / Blow Data	Graphic Log	USCS	DESCRIPTION	In-situ				LL	PI	Type of Test		
						γ _d (pcf)	MC (%)	No. 4	% Passing No. 200					
0				ML	SILT with SAND soft, red-brown, dry; traces of medium to coarse grained SAND; organics at surface.									
5	IR	12/23/17		SC-SM	SILTY, CLAYEY SAND and GRAVEL very dense, brown, moist; fine to medium grained SAND; traces of coarse GRAVEL; moderate cementation.	124.2	10.2					DS		
10	BR	9/17/26			red-brown, moist; some coarse GRAVEL.	116.0	15.3			92.0	29.4	23	8	CR SA
15	AR	9/12/17		CL	Well permeability testing performed at 12'-16'.	102.7	10.7							DS
20	OR	6/17/26			CLAY with SAND very hard, red-brown, moist; little medium to coarse grained SAND.					99.5	72.9	35	19	SA
25	BR	13/4/20 (per L.P.)		SC-SM	SILTY, CLAYEY SAND with GRAVEL dense, red-brown, moist; fine to medium grained SAND; some coarse GRAVEL; moderately bedded with thin interbeds of FINE SAND, reddish-orange, dry.	124.2	7.4	81.6	27.5	100	91.2	32	16	SA
30	OR	9/15/27				110.0	11.6	100	55.8	100	68.6	35	19	SA
LEGEND														
California Rim (2.5 in. OD) Sample			SPT (2 in. OD) Sample			Depth to Invert			District Contact			Types of Tests		
Sample			Sample			Seepage Encountered			--- Gravel or Shorbon Contact			CO - Consolidation		
Sample			Sample			Gravel Encountered			Dry Density			CR - Corrosion		
Sample			Sample			Grouting Encountered			Moisture Content			SI - Direct Shear		
Sample			Sample			Grouting Encountered			Moisture Content			E - Expansion Index		
Sample			Sample			Grouting Encountered			Moisture Content			SI - Triaxial		
Sample			Sample			Grouting Encountered			Moisture Content			SI - Triaxial		
Note: This data contains observations and interpretations that are valid only for the specific date and location of the boring. Subsurface conditions vary between borings and with time. Material descriptions are derived using visual classification methods and may vary from descriptions/classifications based on laboratory testing.														

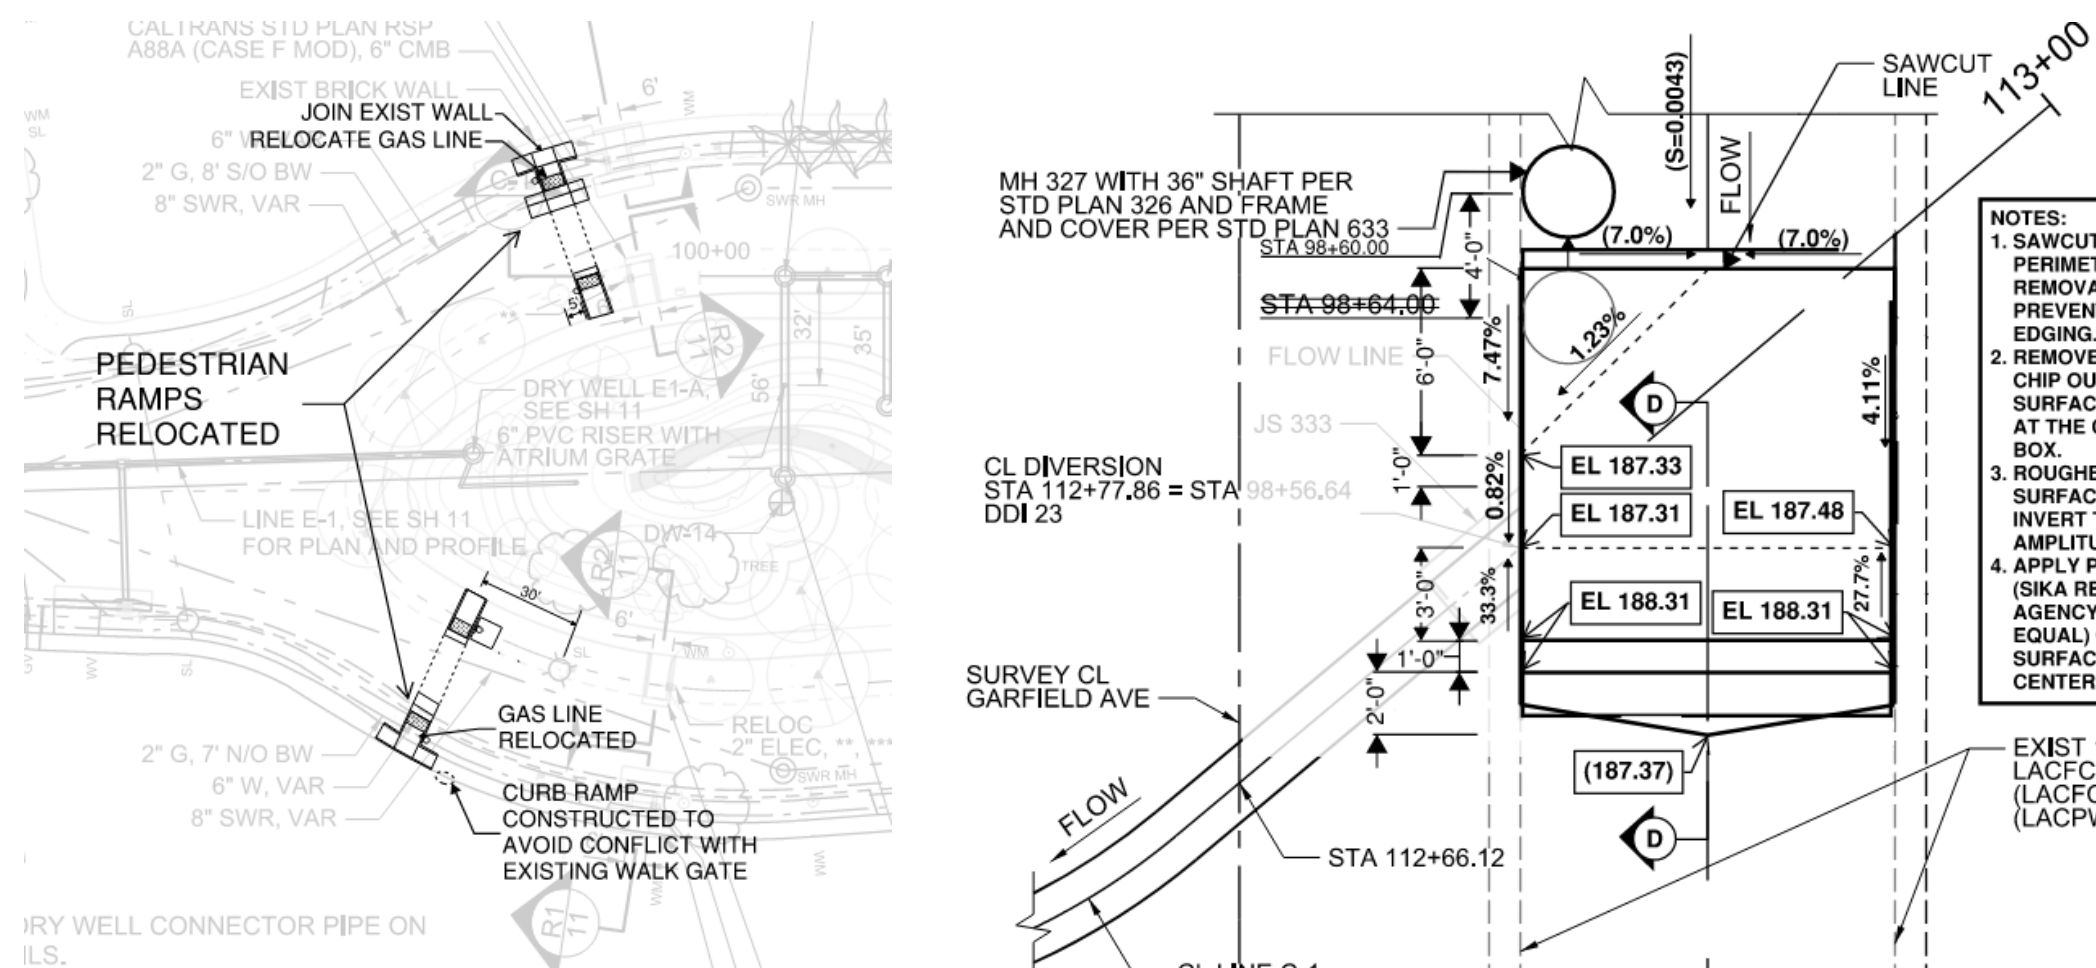


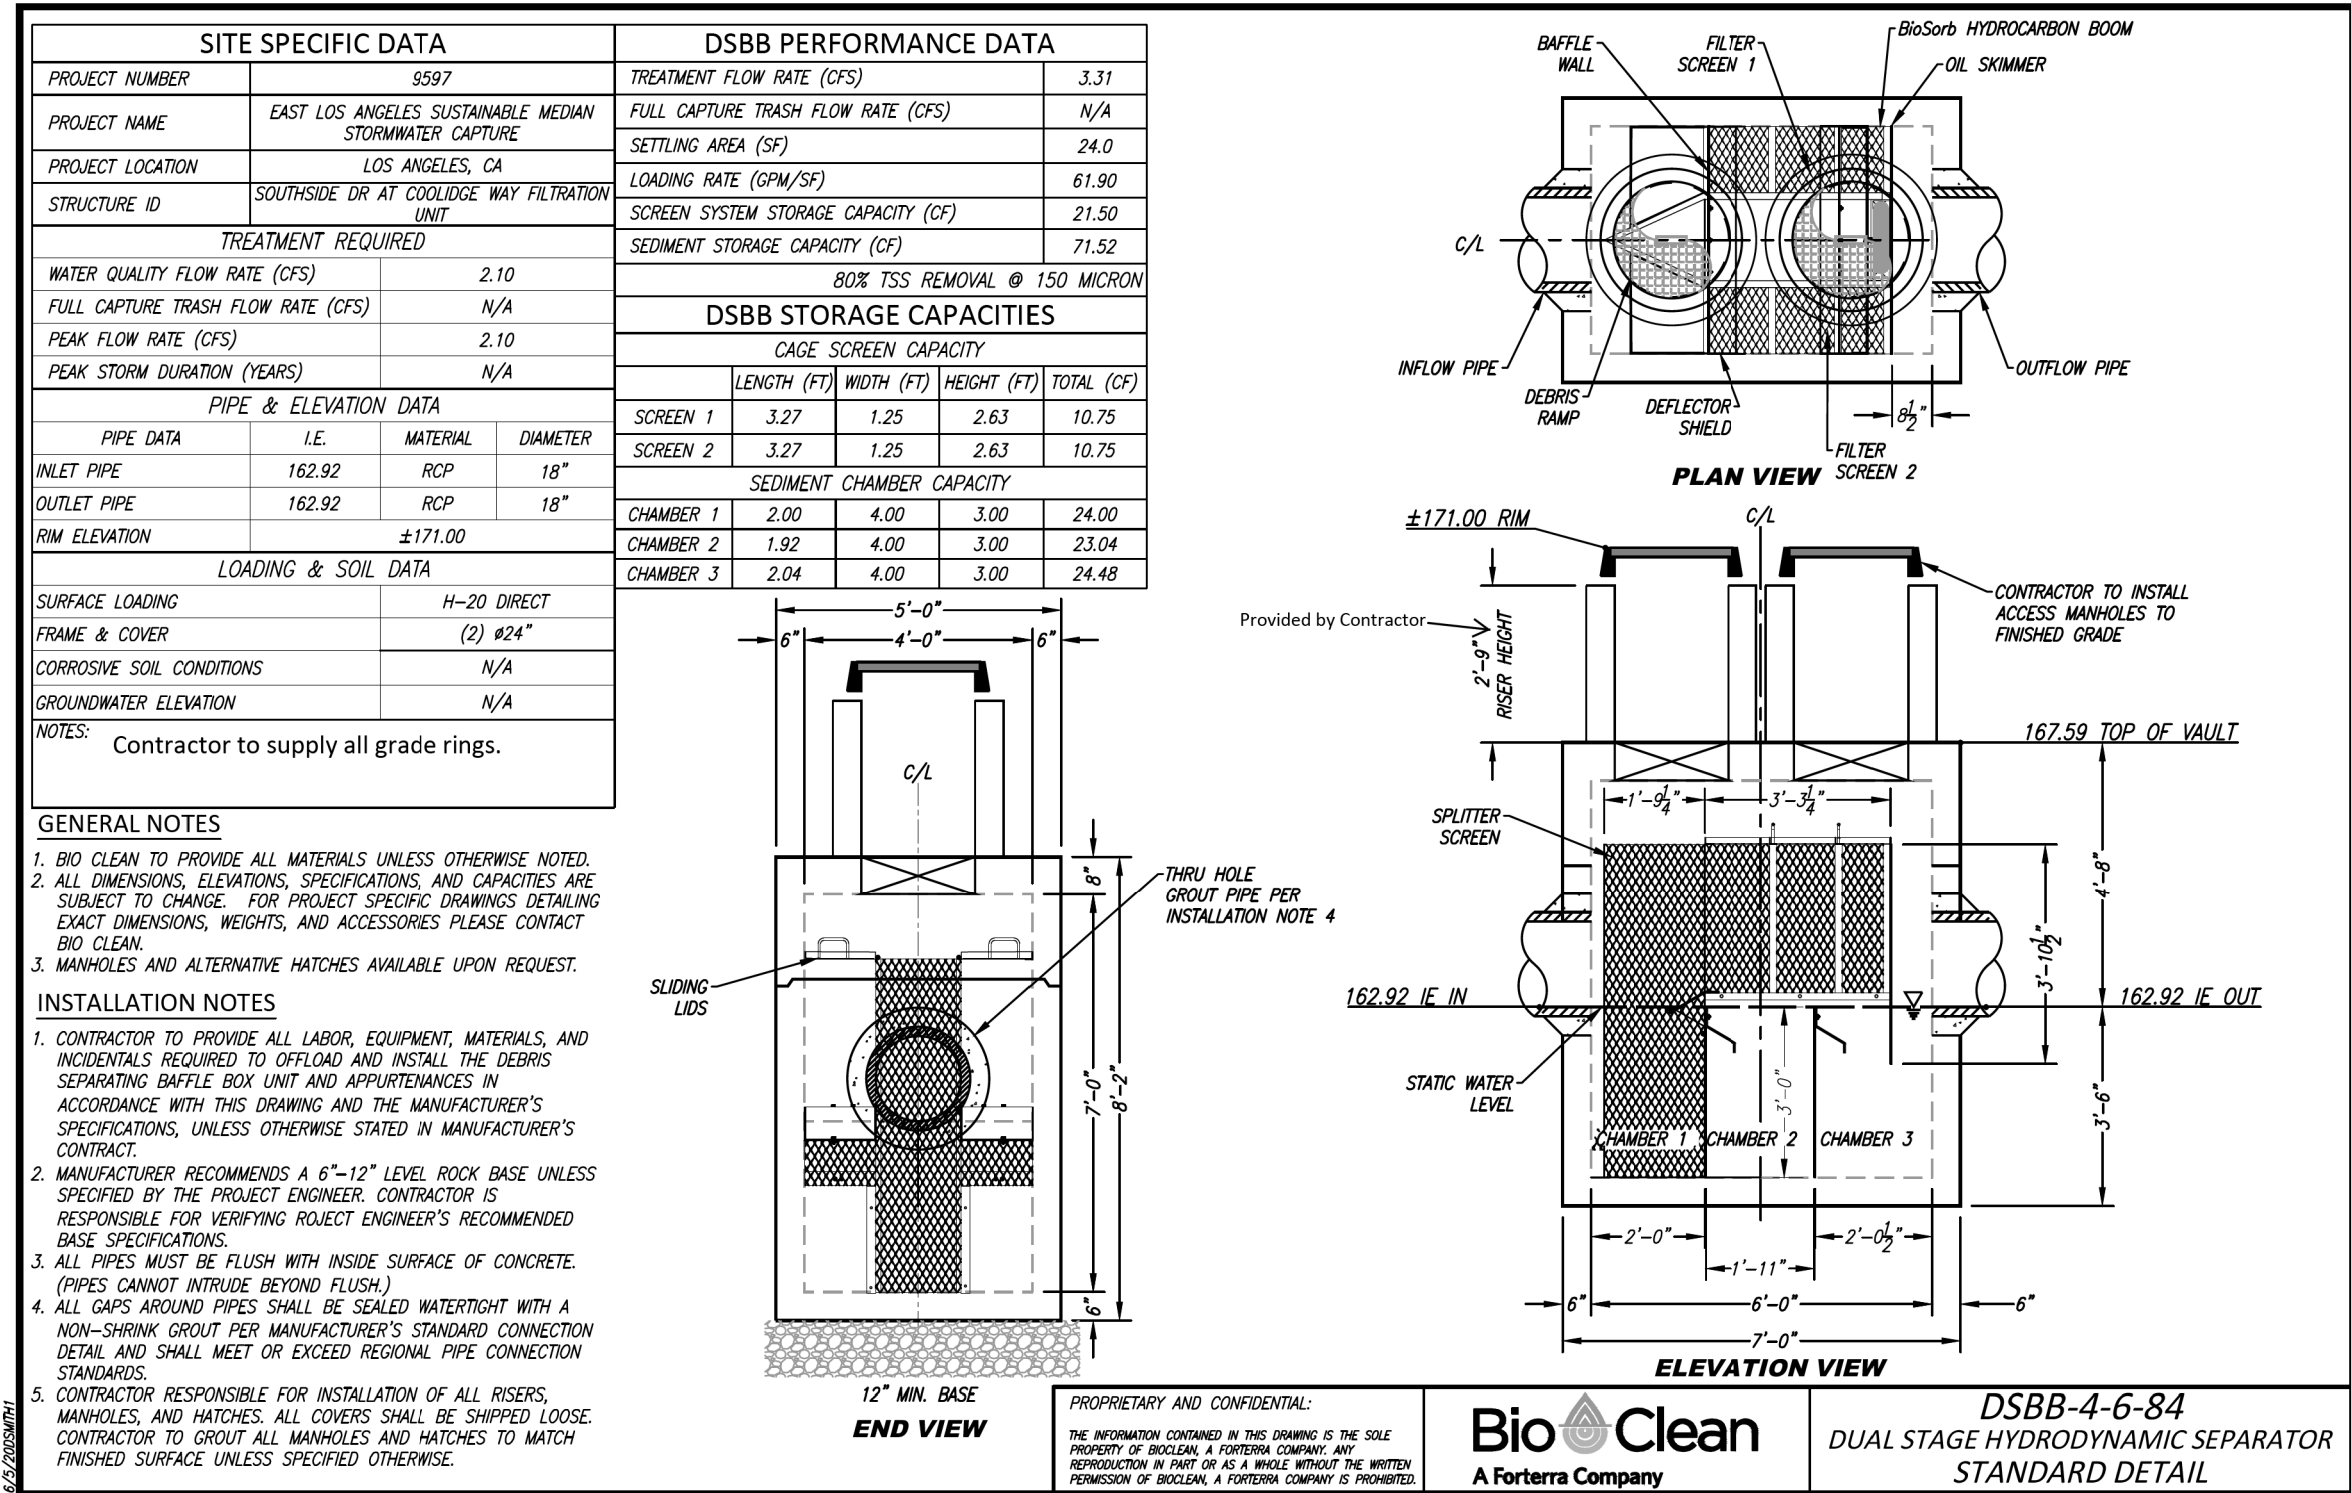


SOUTHSIDE DR AT COOLIDGE WAY FILTRATION UNIT (DET IA, SH 14)
NO SCALE

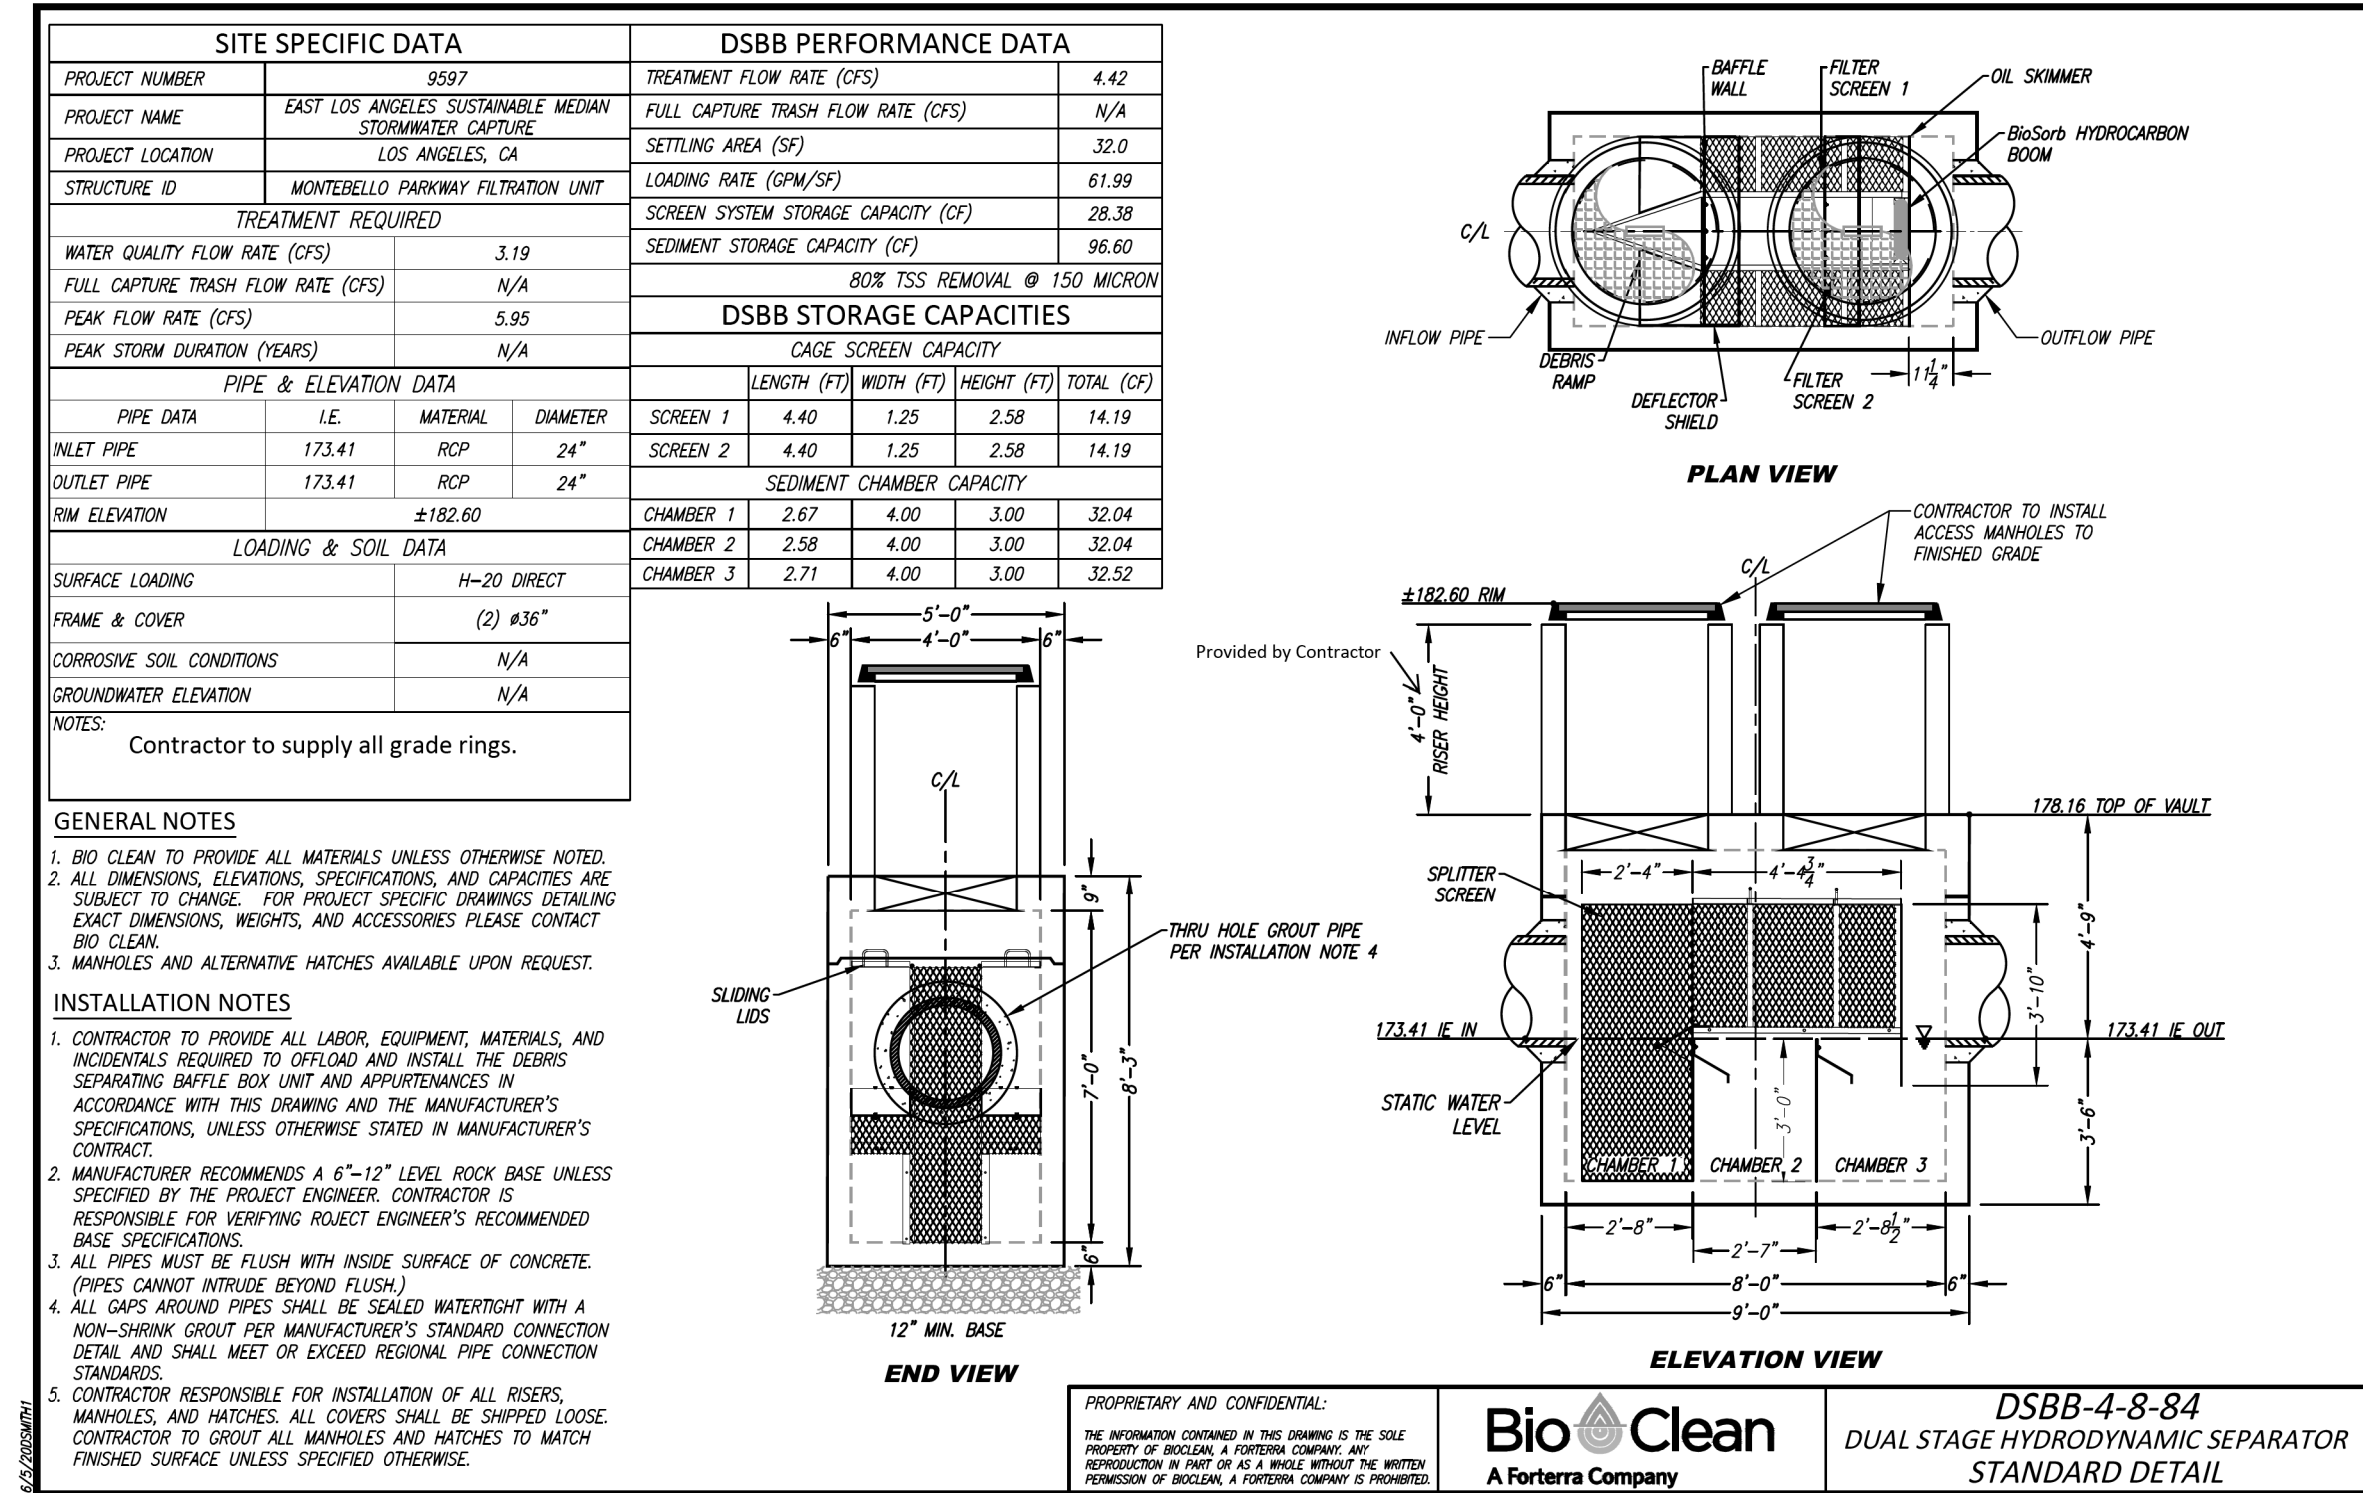

MONTEBELLO PARKWAY FILTRATION UNIT (DET H, SH 14)
NO SCALE

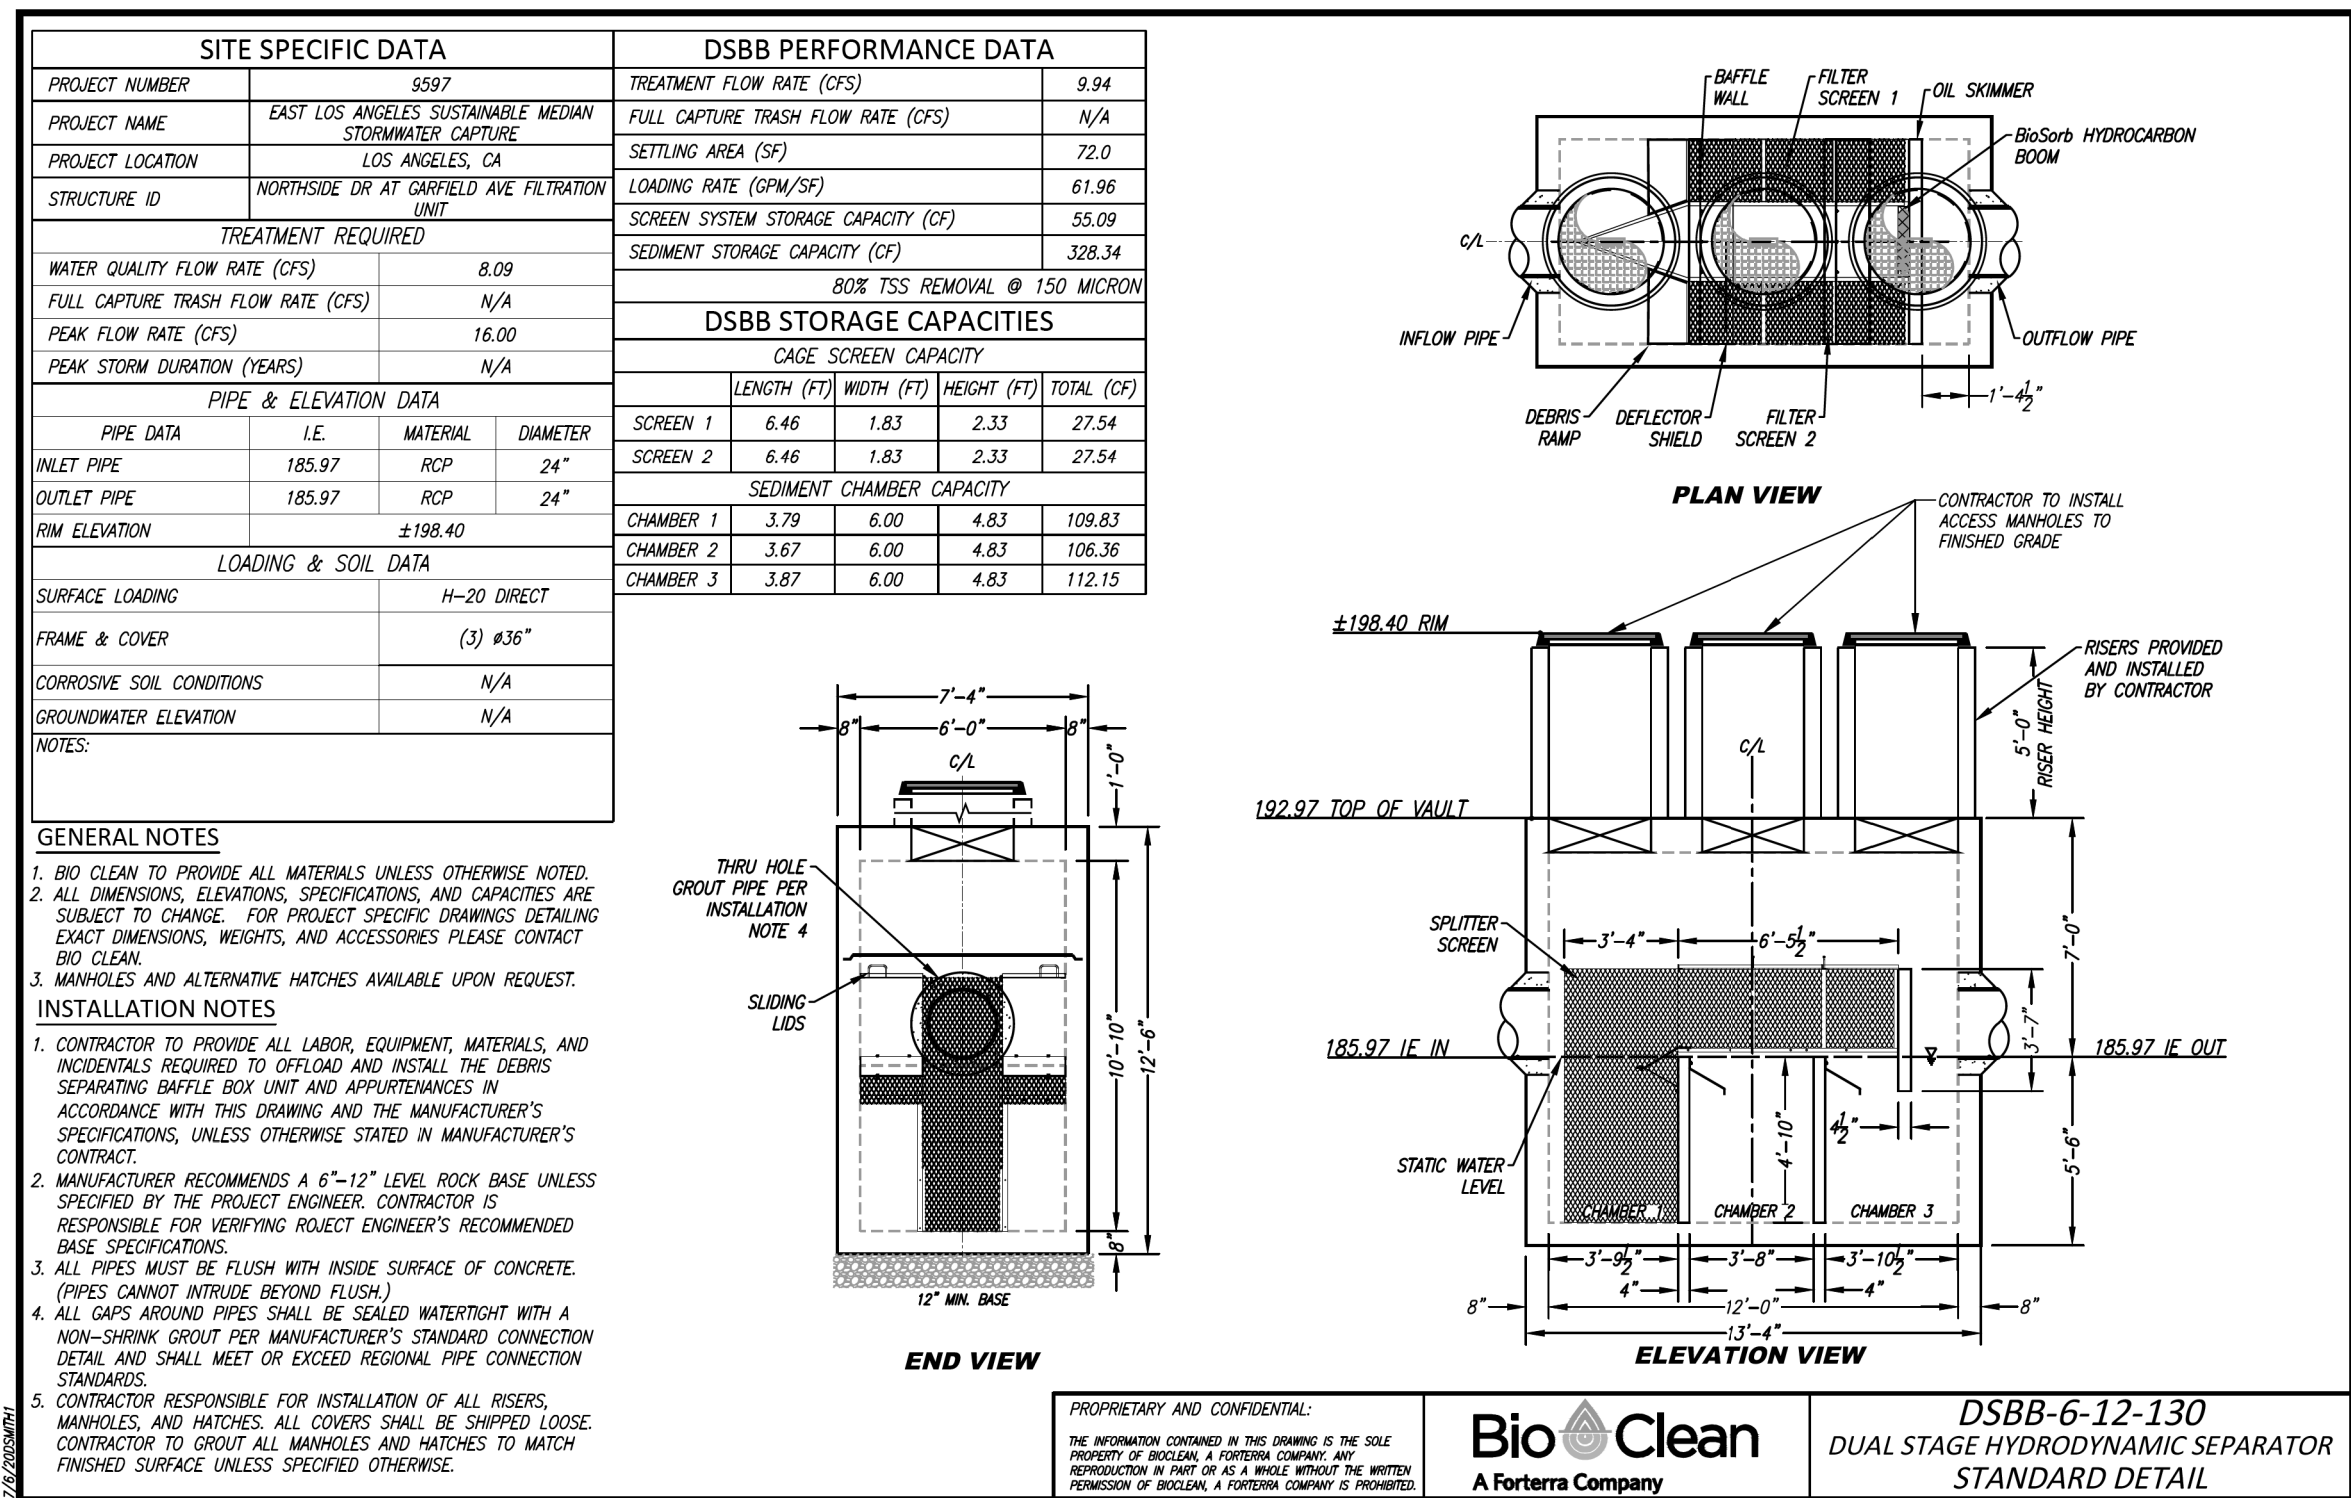

NORTHSIDE DR AT GARFIELD AVE FILTRATION UNIT (DET G, SH 14)
NO SCALE

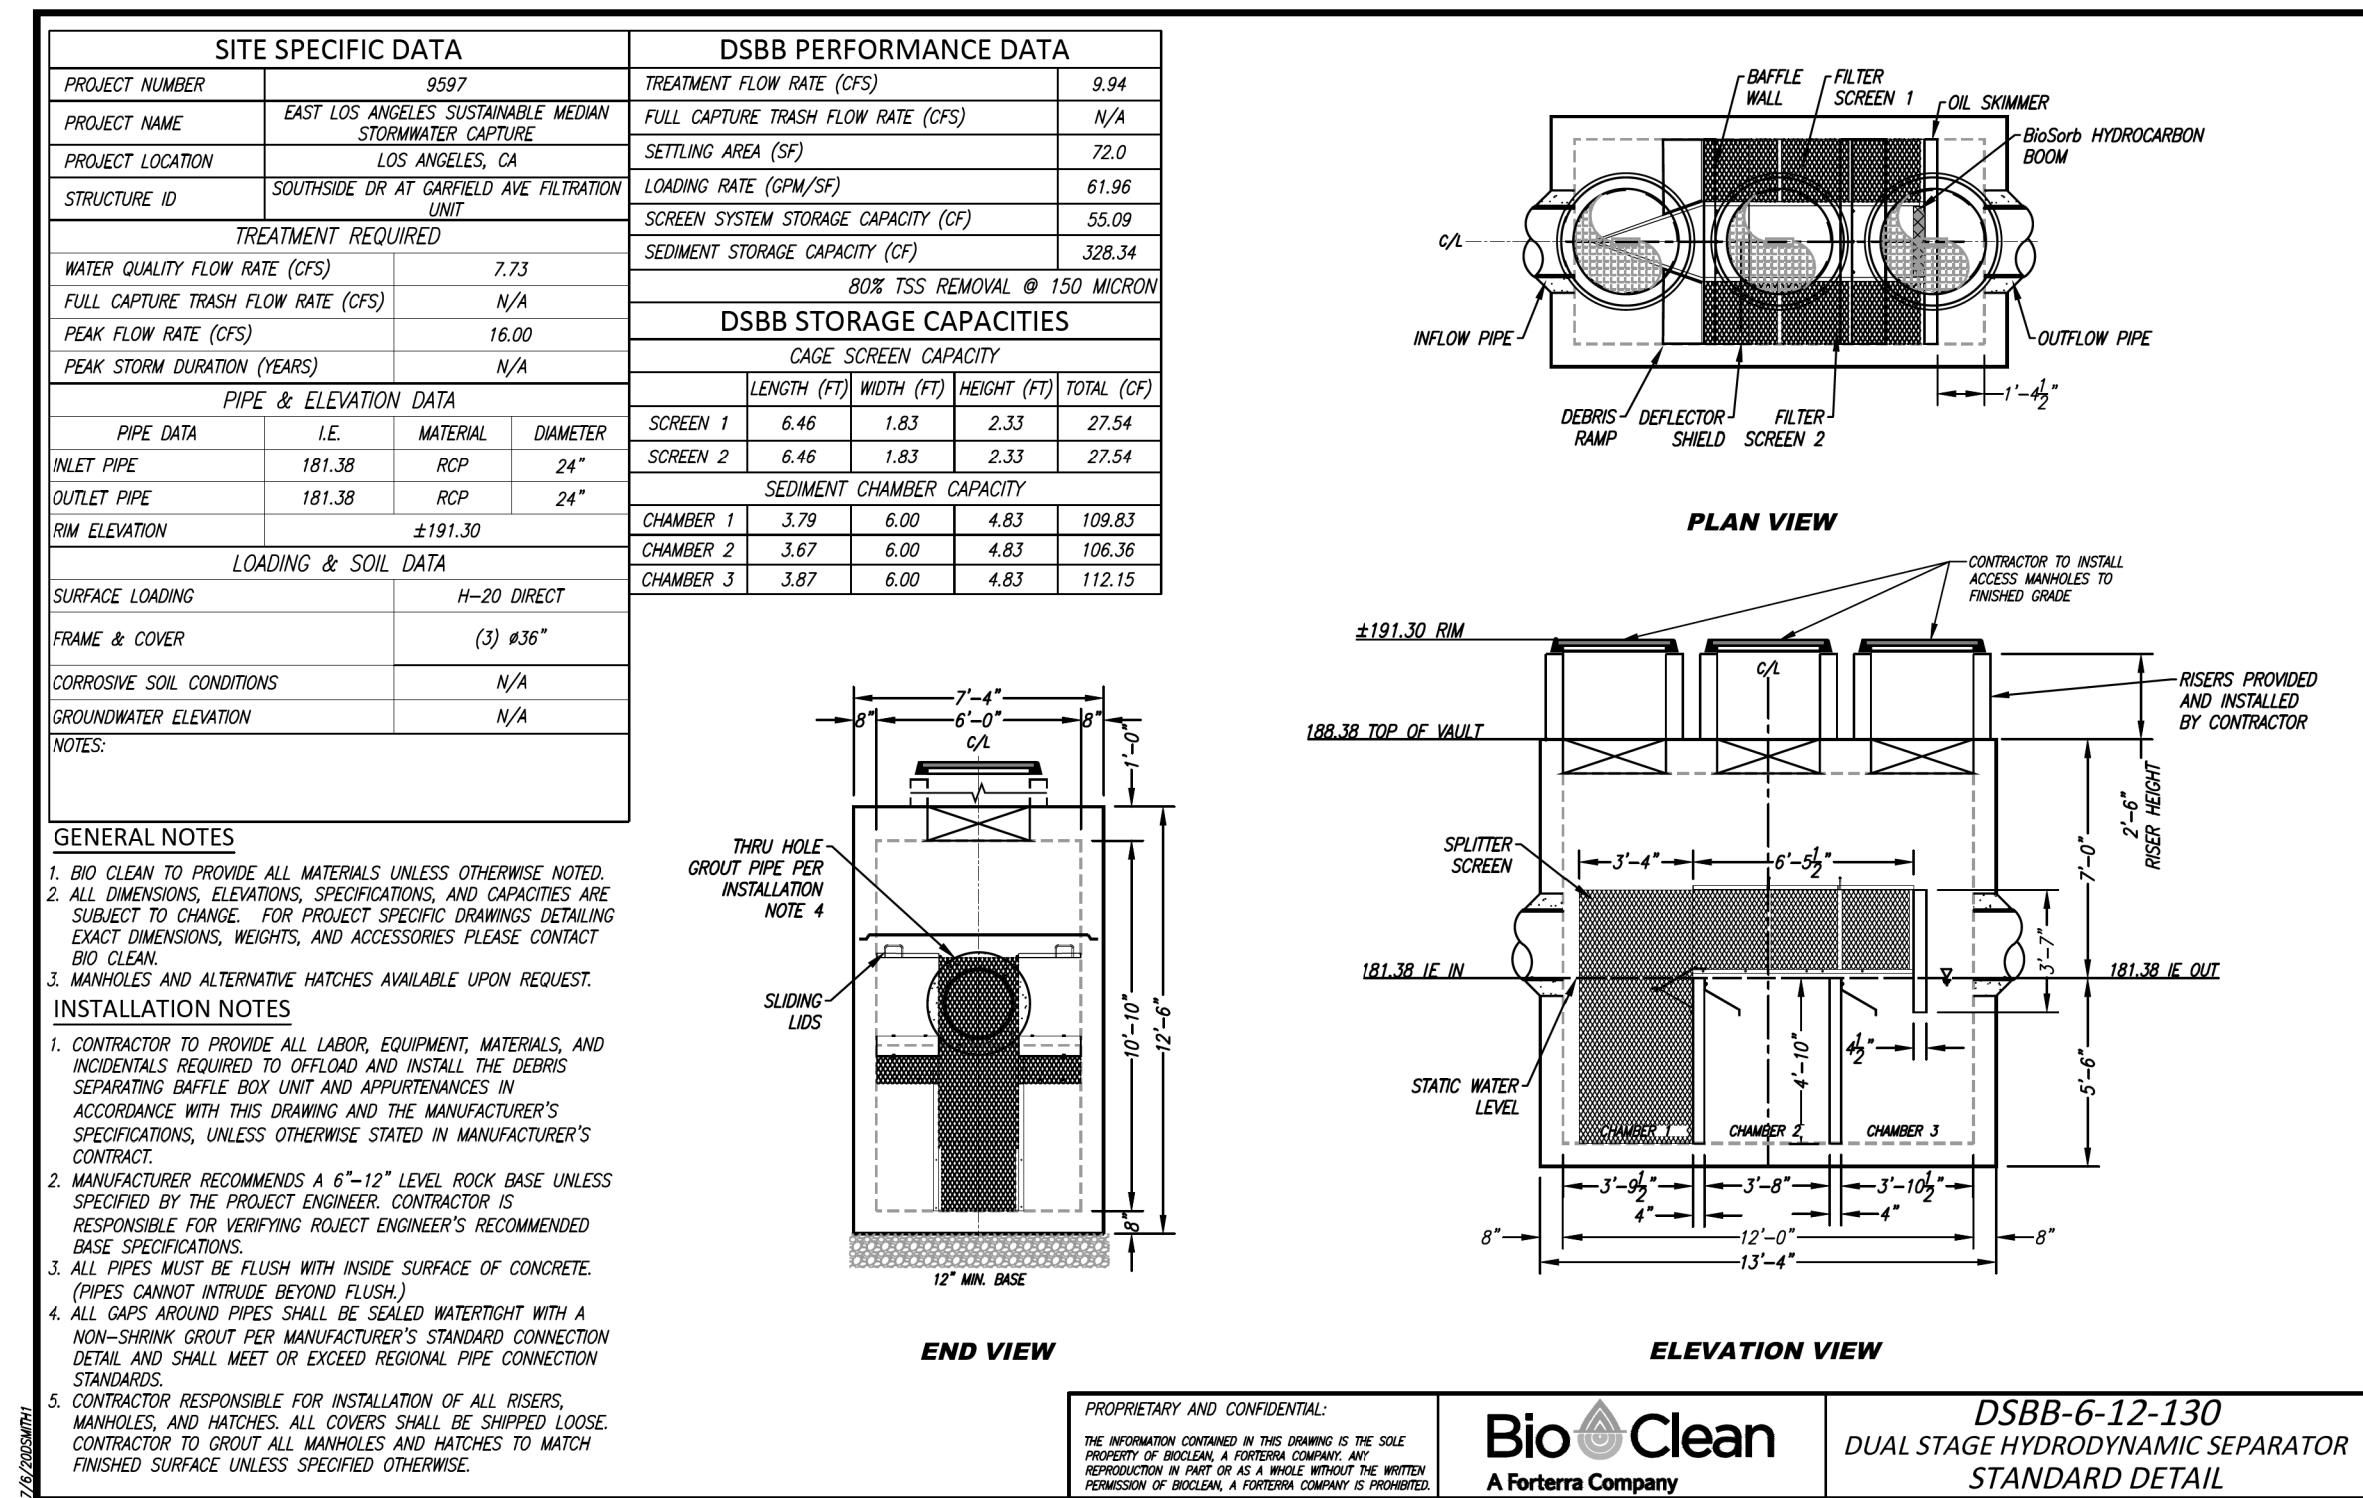


SOUTHSIDE DR AT GARFIELD AVE FILTRATION UNIT (DET I, SH 14)
NO SCALE

CADD PROJECT FILE NAME
EAST LA MEDIANS.DGN

CHECKER
C. RAVE

DESIGNER
C. RAVE

DRAFTER
C. RAVE

			LOS ANGELES COUNTY PUBLIC WORKS		
			EAST LOS ANGELES SUSTAINABLE MEDIAN STORMWATER CAPTURE PROJECT		
			FILTRATION UNIT DETAILS		
			PROJECT ID NO. WMU0000010		
04/28/22	AS BUILT REVISIONS			LACFCD INDEX NO. 116-D27	
DATE	DESCRIPTION	DATE		PD053092	
REVISIONS				SHEET 27 OF 27	

AS BUILT DRAWINGS

PLAN DR