




SCALE: HOR. 1"= 40'
VERT. 1"= 8'

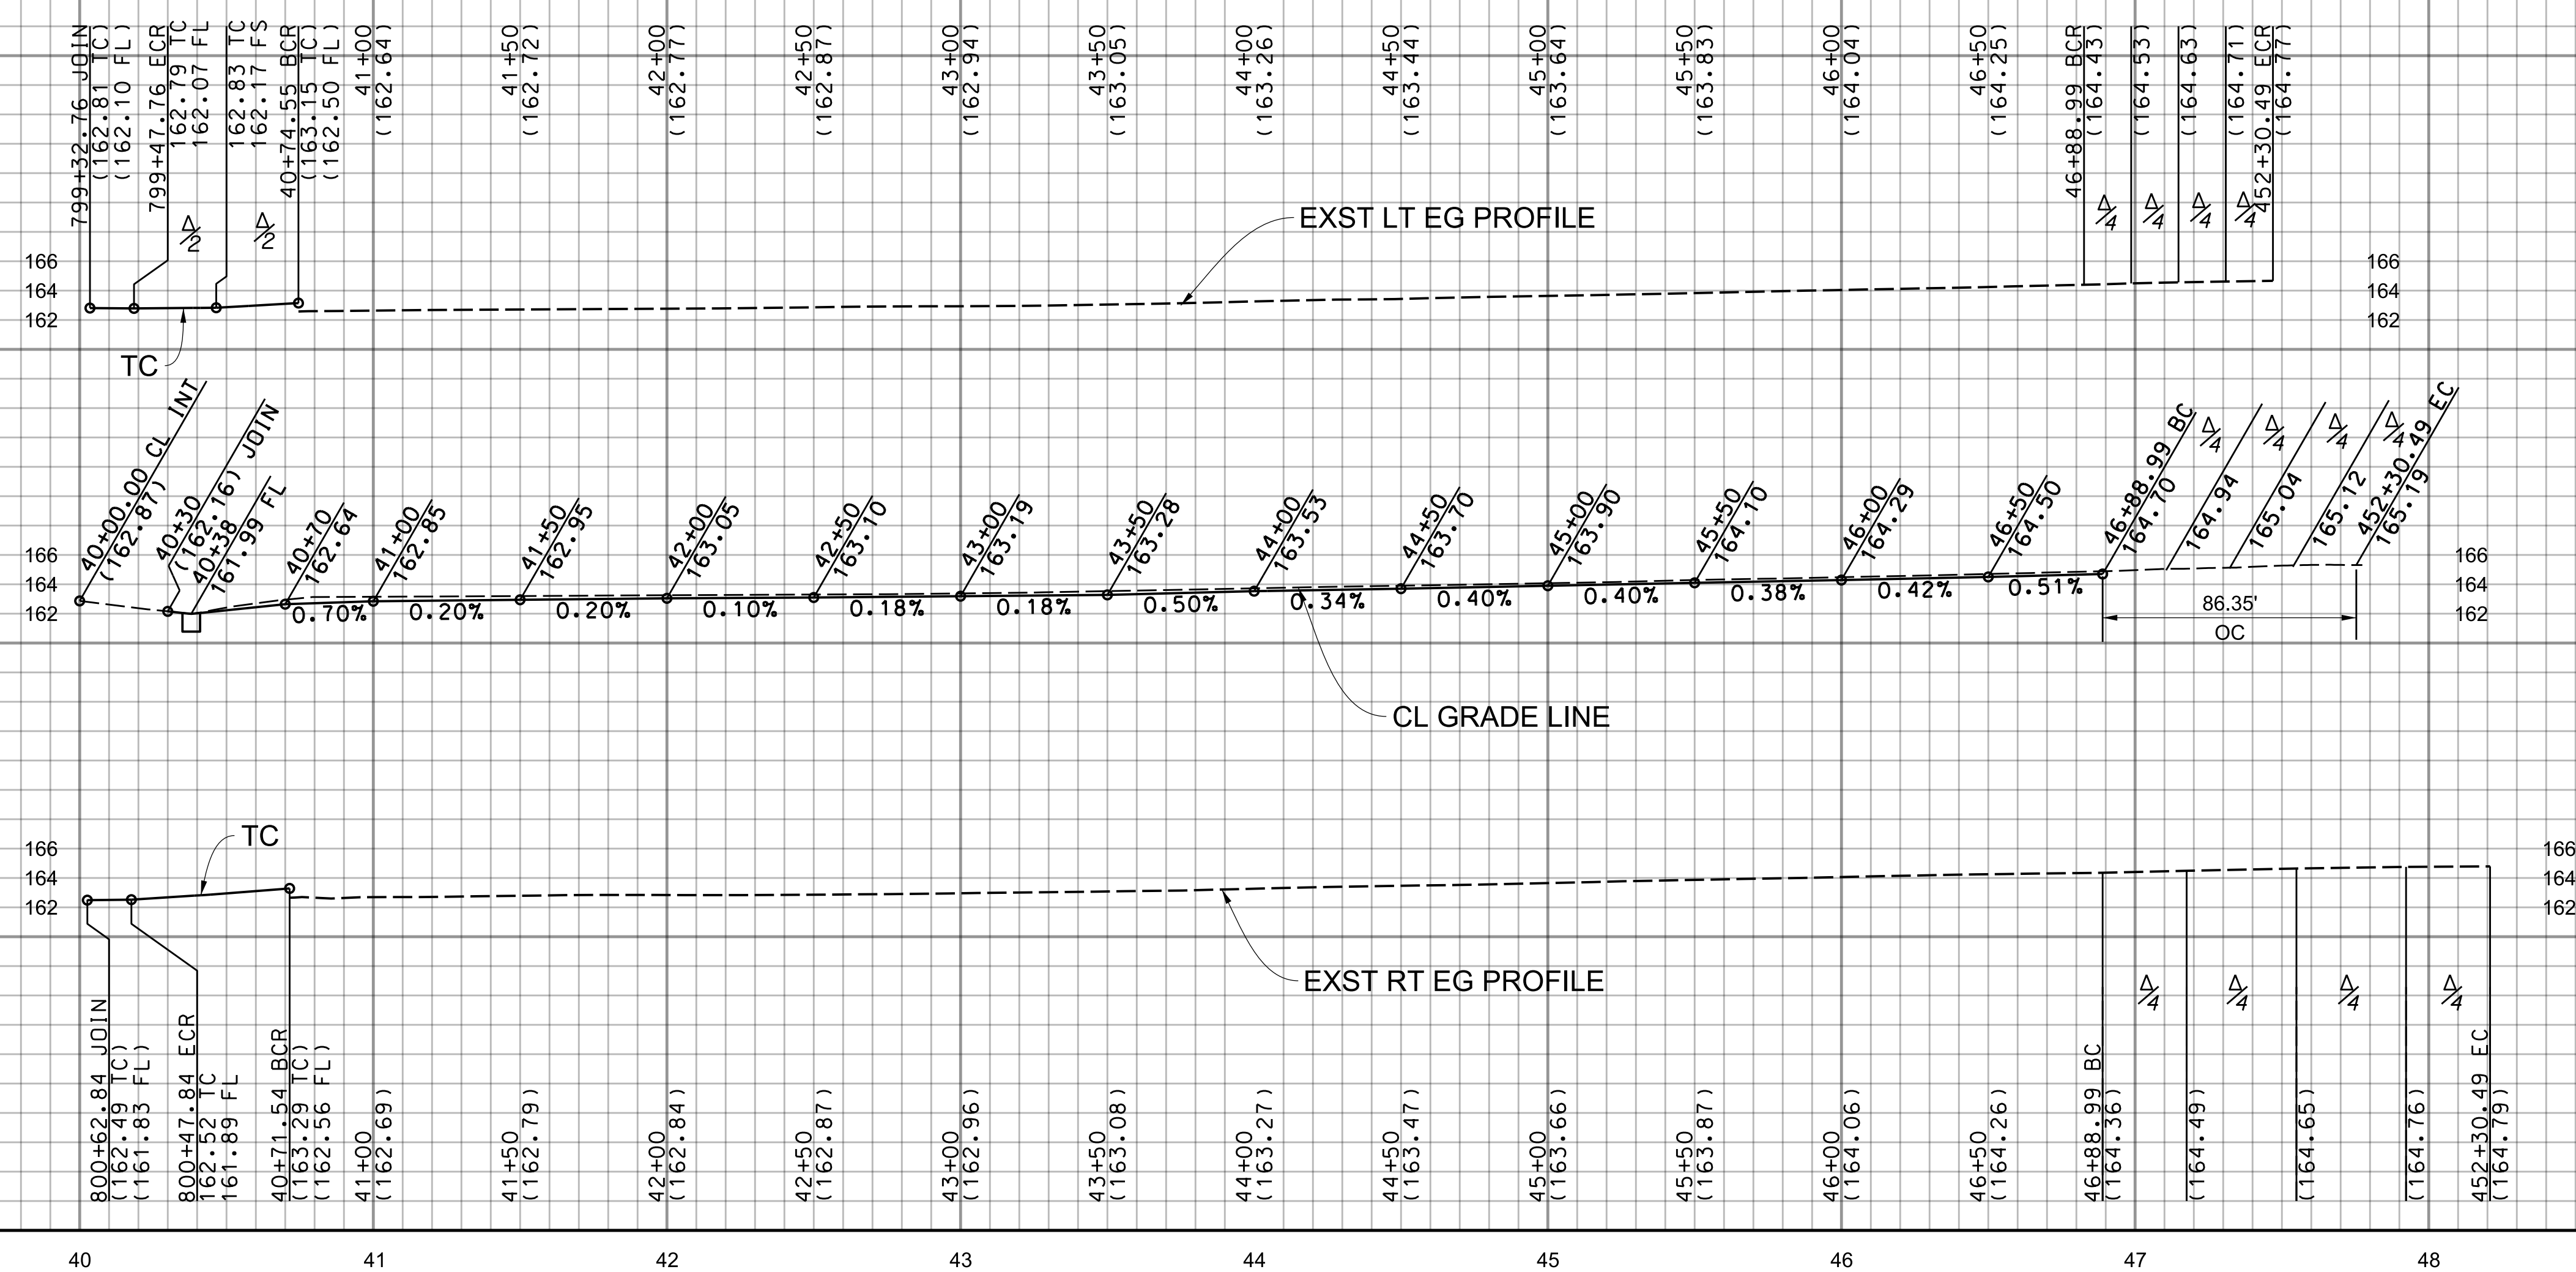

MINES BLVD

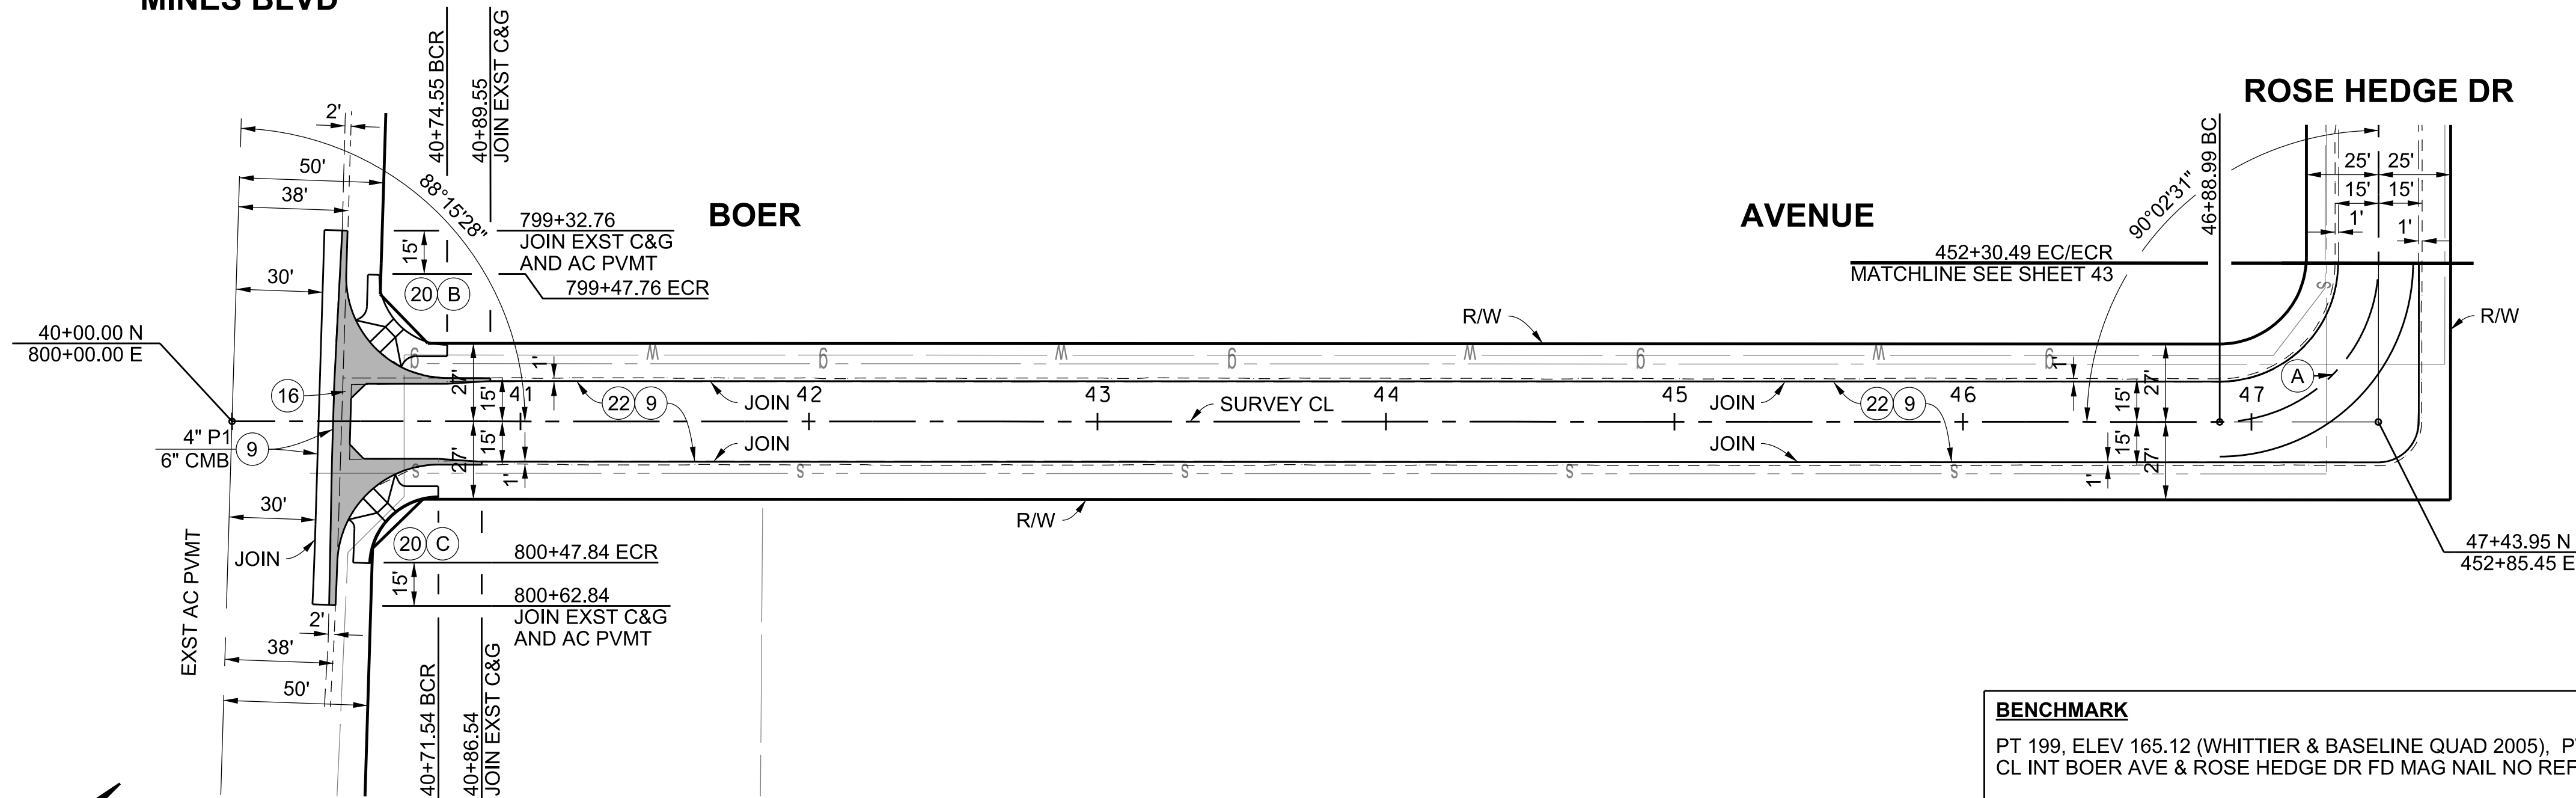

ROSE HEDGE DR

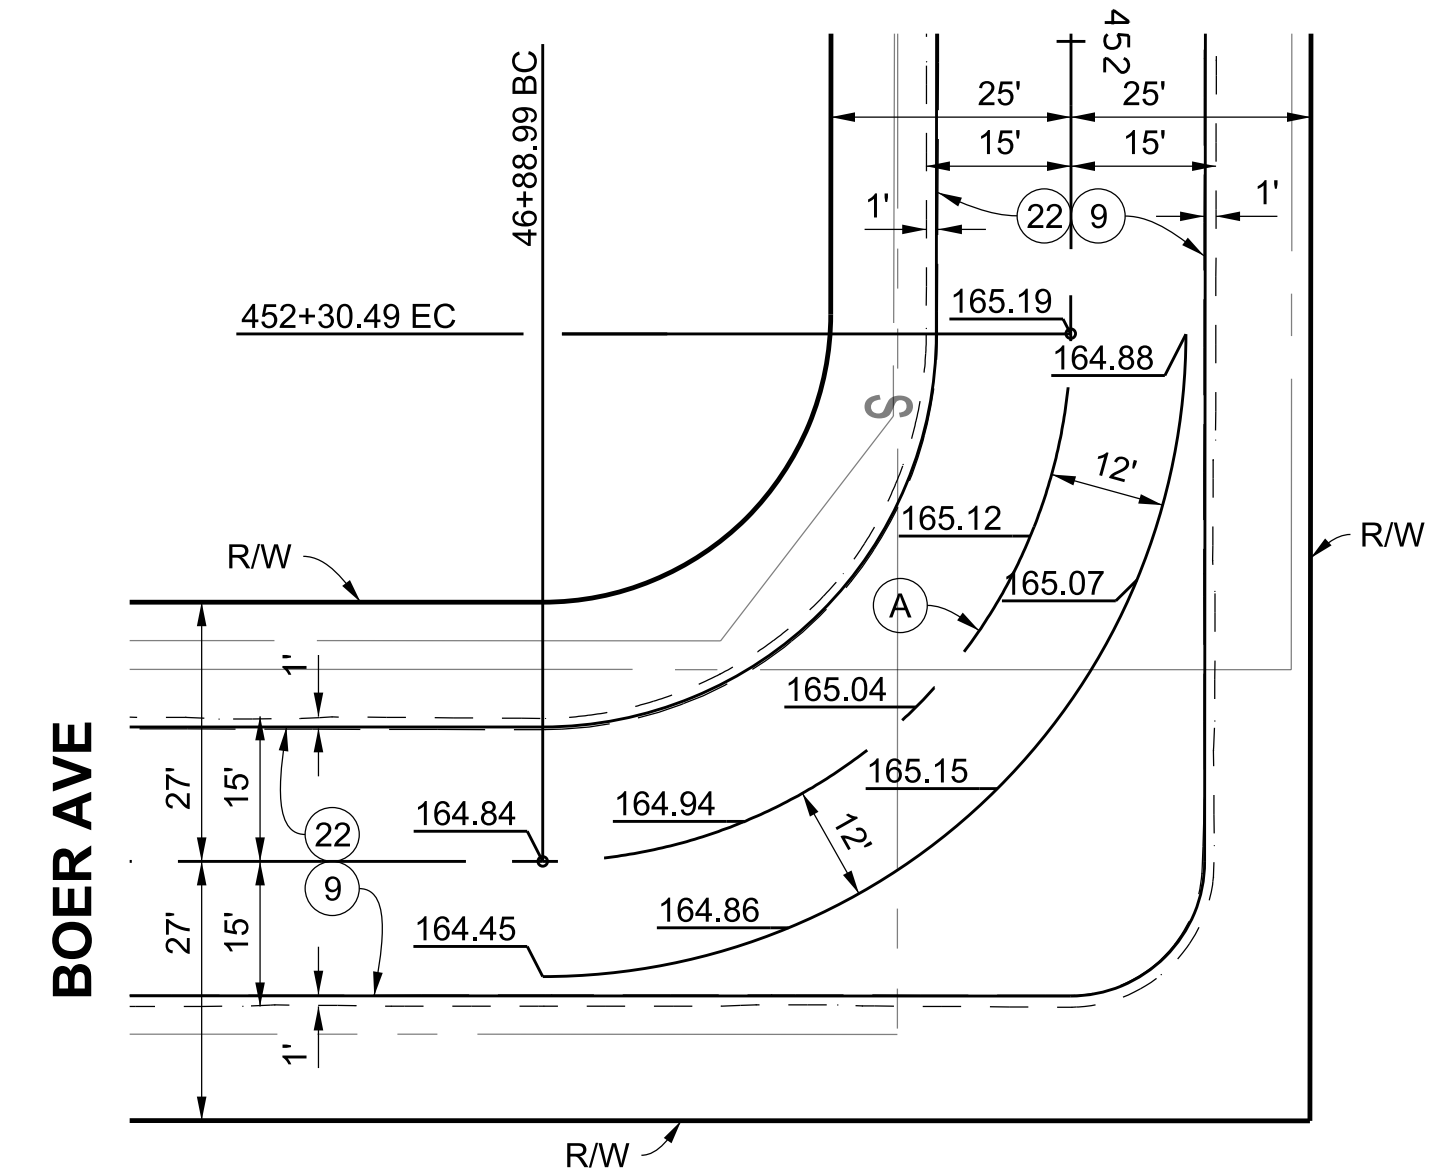

KNUCKLE DETAIL
SCALE: 1" = 20'


CURVE DATA				
CURVE	RADIUS	CENTRAL ANGLE	LENGTH	TANGENT
(A)	55.00'	89° 57' 29"	86.35'	54.96'
(B)	35.00'	91° 44' 32"	56.04'	36.08'
(C)	35.00'	87° 53' 32"	53.93'	33.97'

INTERSECTION DATA		
STATION	OFFSET	ELEV
799+85.00	38' LT	162.03
800+00.00	38' LT	161.99
800+15.00	38' LT	161.96

ELEVATIONS			
CURVE	BCR	Δ/2	ECR
(B)	163.18 TC 162.51 FL	162.85 TC 162.18 FL	162.74 TC 162.07 FL
(C)	163.23 TC 162.56 FL	162.78 TC 162.12 FL	162.56 TC 161.89 FL

BENCHMARK
PT 199, ELEV 165.12 (WHITTIER & BASELINE QUAD 2005), PWFB 1026, PG 2142
CL INT BOER AVE & ROSE HEDGE DR FD MAG NAIL NO REF.

DATE	MARK	DESCRIPTION
10/25/2021	AS-BUILT	
REVISIONS		

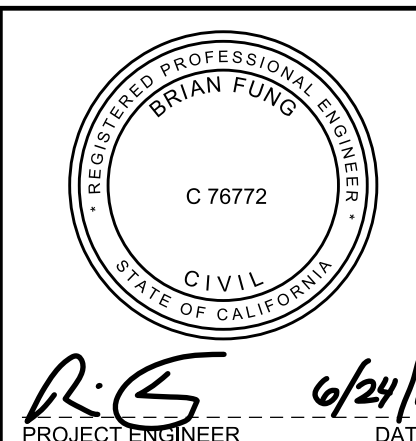

LOS ANGELES COUNTY PUBLIC WORKS

SOUTH WHITTIER LOS NIETOS
KEITH DRIVE, ET AL.

PROJECT ID NO. RMD4408001
PLAN AND PROFILE

DATE: 6/24/19

PD PH086527 SHEET 8 OF 79

CADD PROJECT FILE NAME: RMD4408001-PLAN-RD.DGN
CHECKER: B. FUNG
DESIGNER: J. GARCIA
DRAFTER: J. GARCIA

