



SCALE: HOR. 1"= 40'
VERT. 1"= 8'

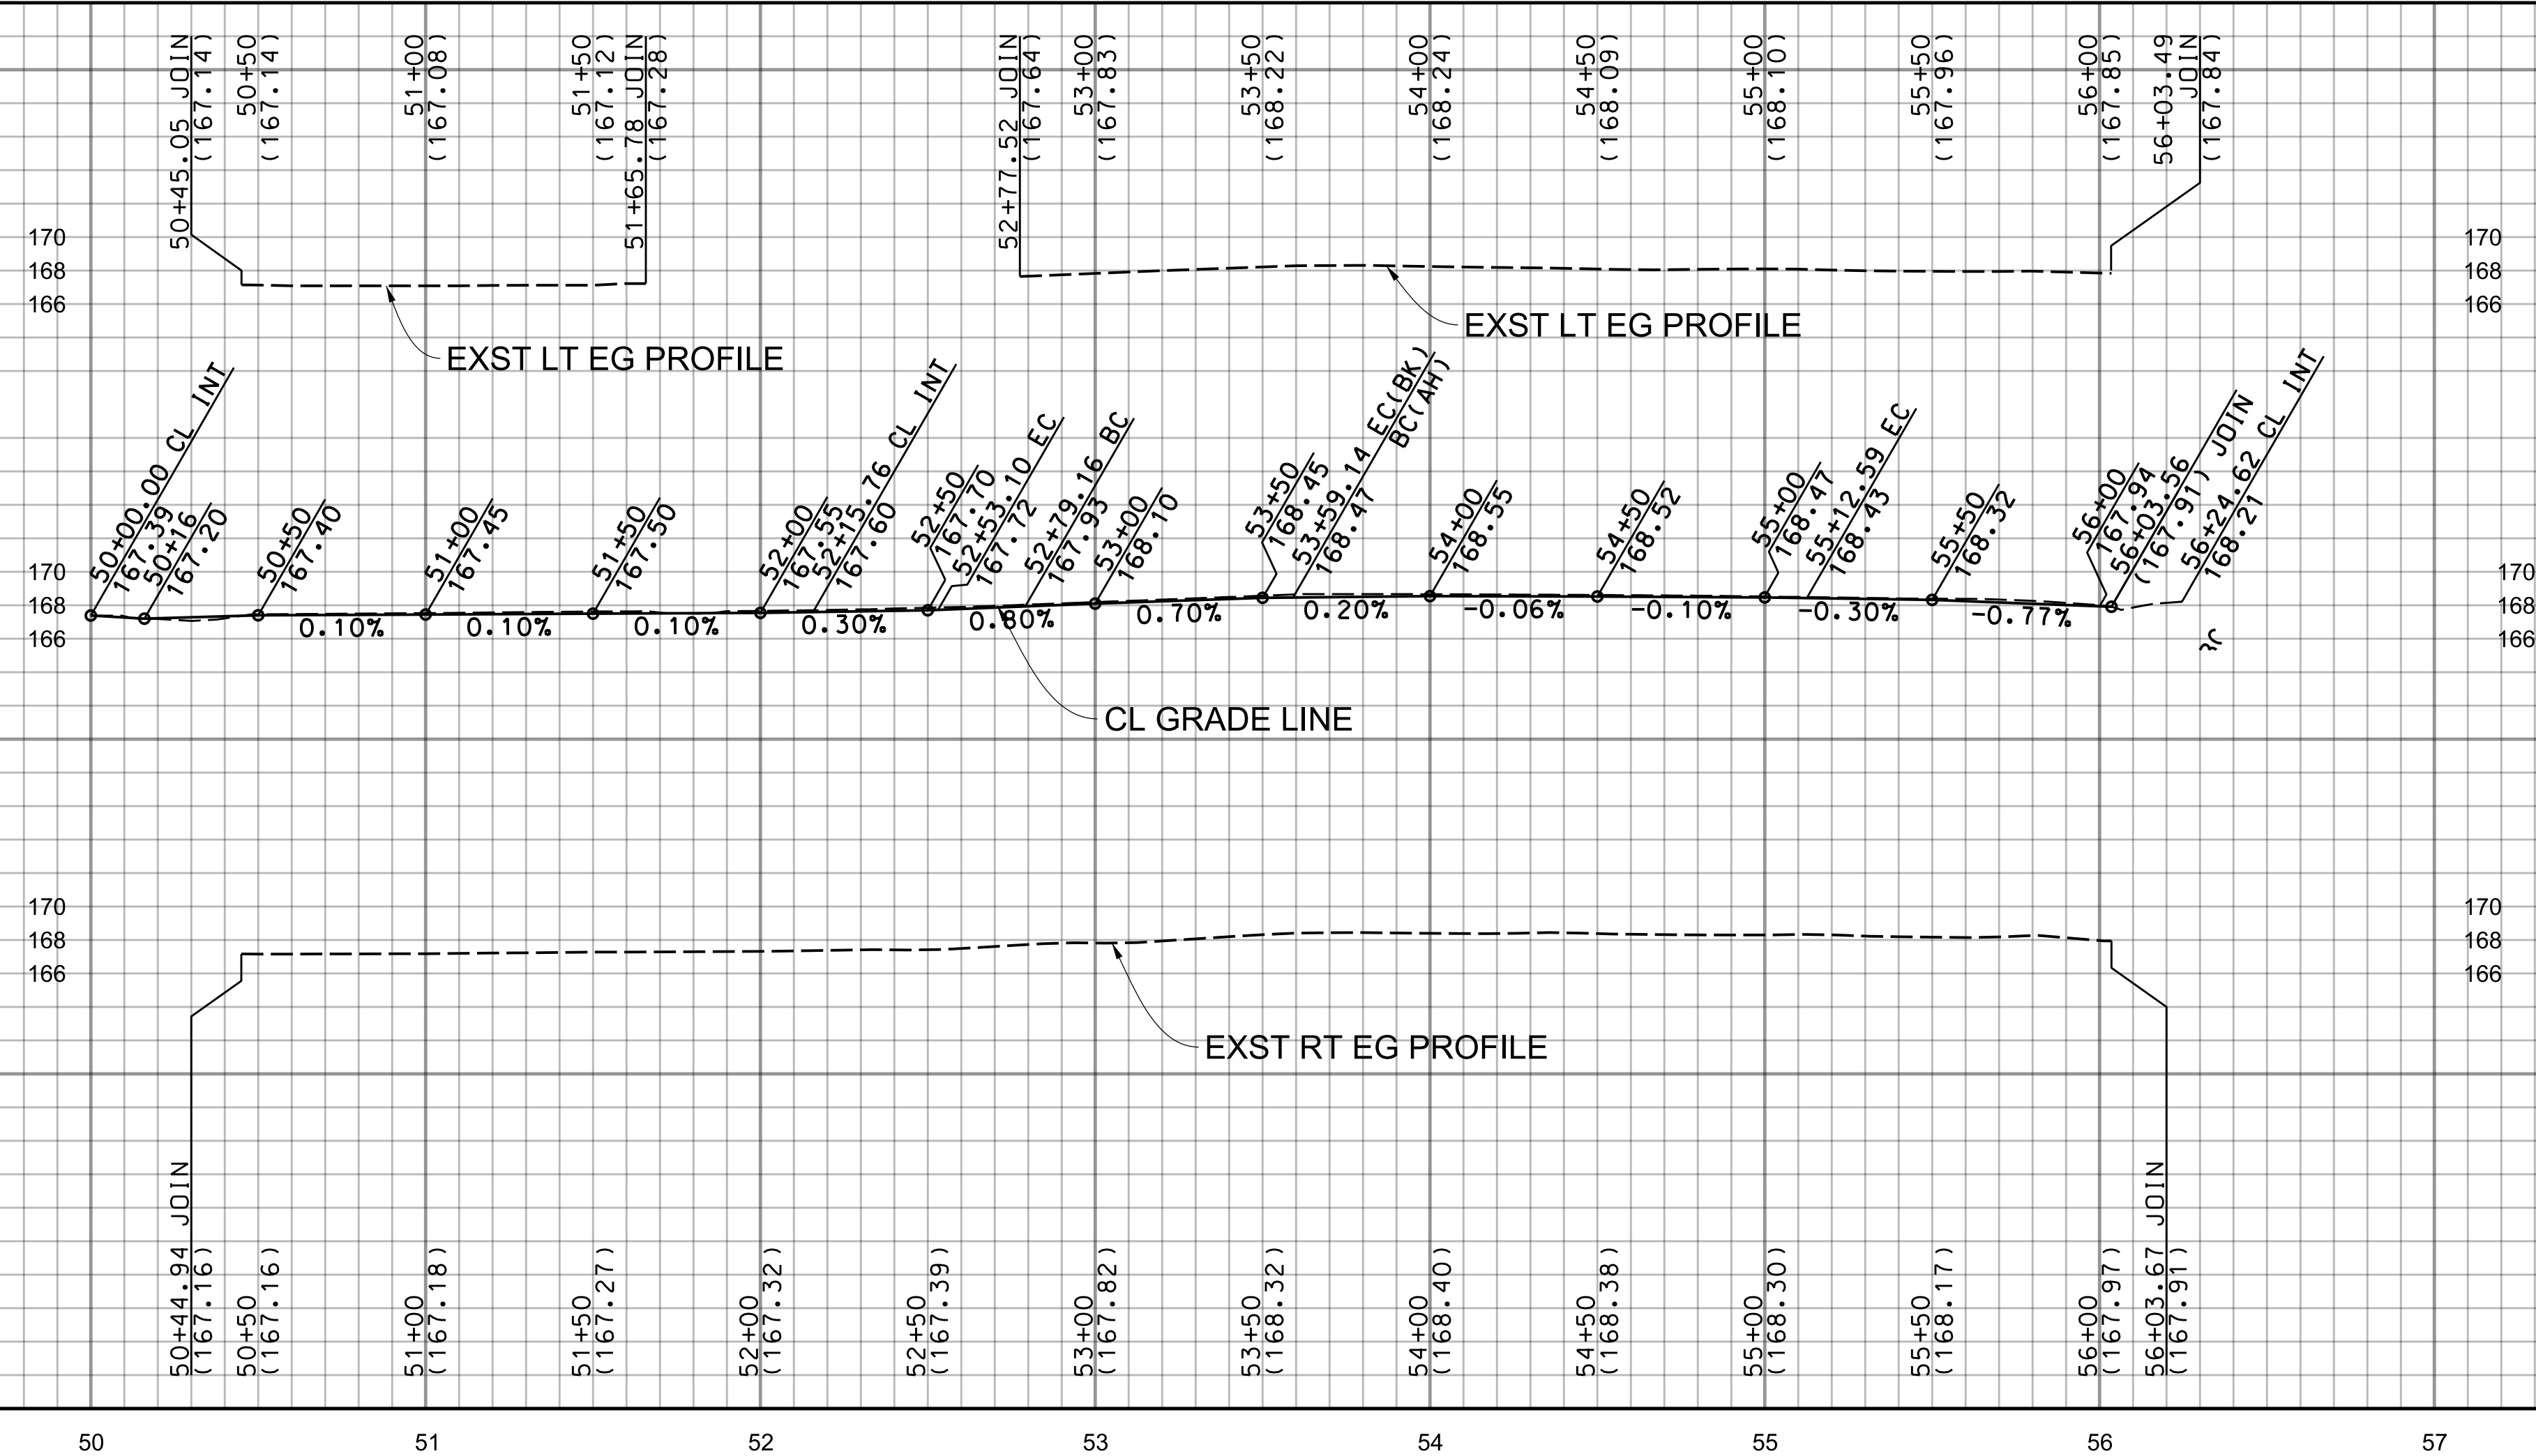

SEE SHEET 68 FOR PARKWAY IMPROVEMENTS

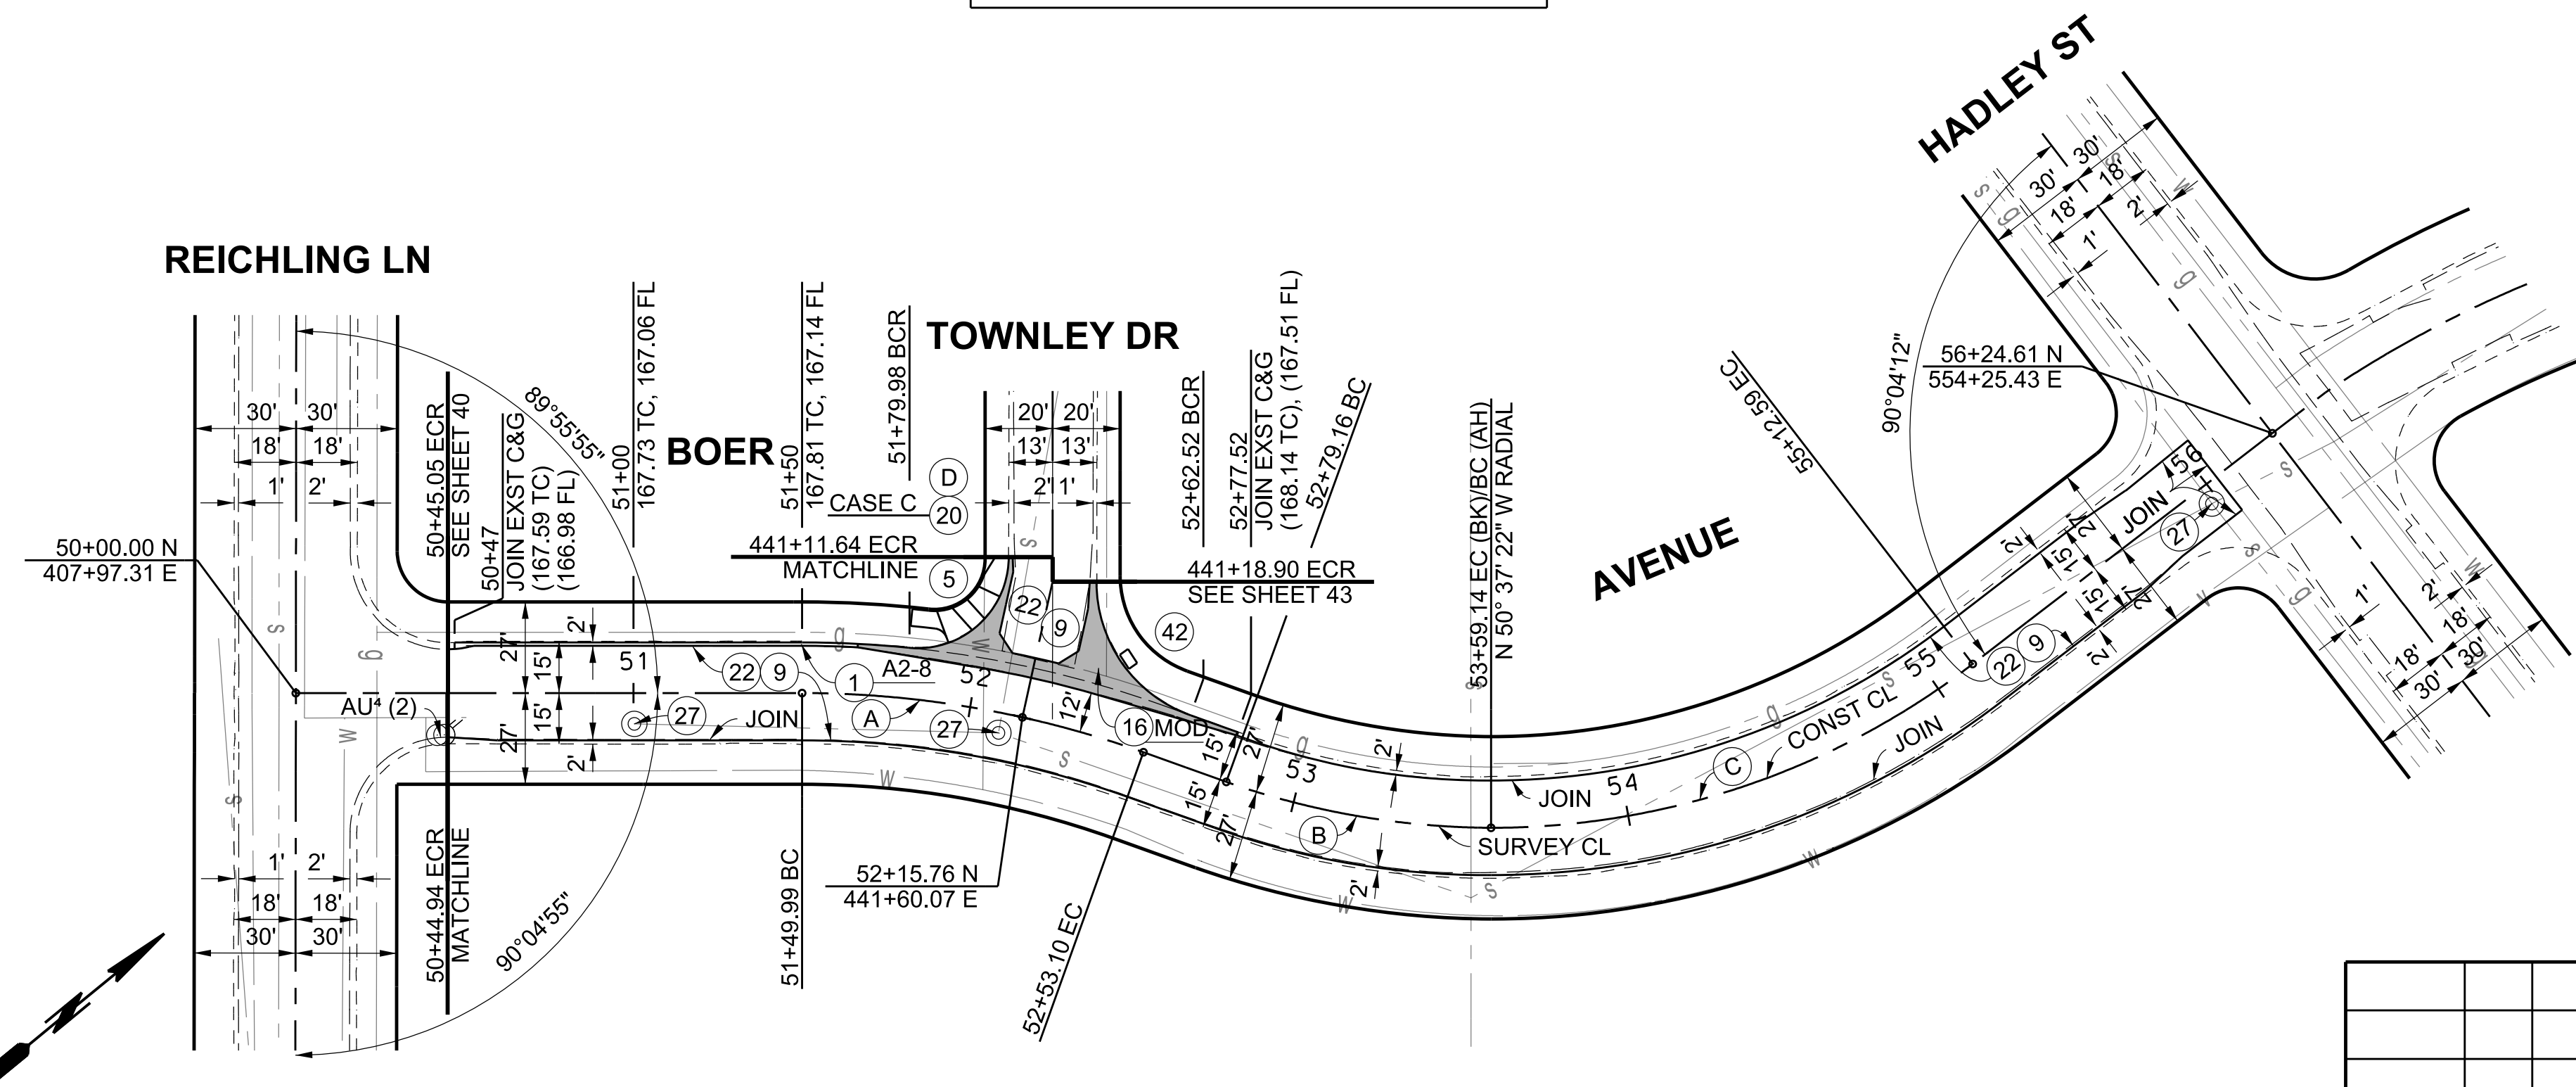

INTERSECTION DATA

STATION	OFFSET	ELEV
52+01.85	15' LT	167.22
52+15.76	15' LT	167.24
52+28.11	15' LT	167.26

ELEVATIONS

CURVE	BCR	Δ/2	ECR
(D)	167.70 TC	167.64 TC	167.82 TC
	167.03 FL	167.14 FL	167.32 FL
(E)	168.00 TC	167.77 TC	167.85 TC
	167.33 FL	167.27 FL	167.35 FL

CURVE DATA

CURVE	RADIUS	CENTRAL ANGLE	LENGTH	TANGENT
(A)	300.15'	19° 41' 02"	103.12'	52.07'
(B)	233.30'	19° 38' 53"	80.00'	40.40'
(C)	233.79'	37° 36' 15"	153.44'	79.60'
(D)	27.00'	95° 43' 44"	45.11'	29.84'

BENCHMARK

PT 660.ELEV 167.68 (WHITTIER & BASELINE QUAD 2005), PWFB 1026, PG 2145
CL INT BOER AVE & TOWNLEY DR FD SPK & TIN PER R1, DN 1"

LOS ANGELES COUNTY PUBLIC WORKS

SOUTH WHITTIER LOS NIETOS
KEITH DRIVE, ET AL.

PROJECT ID NO. RMD4408001
PLAN AND PROFILE

PD PH086528 SHEET 9 OF 79



PROJECT ENGINEER
DATE 6/24/19

DATE	MARK	DESCRIPTION
10/25/2021	AS-BUILT	
REVISIONS		

CADD PROJECT FILE NAME: RMD4408001-PLAN-RD.DGN
CHECKER: B. FUNG
DESIGNER: J. GARCIA
DRAFTER: J. GARCIA

PLAN SCALE: 1"= 40'

