



SCALE: HOR. 1"= 40'  
VERT. 1"= 8'

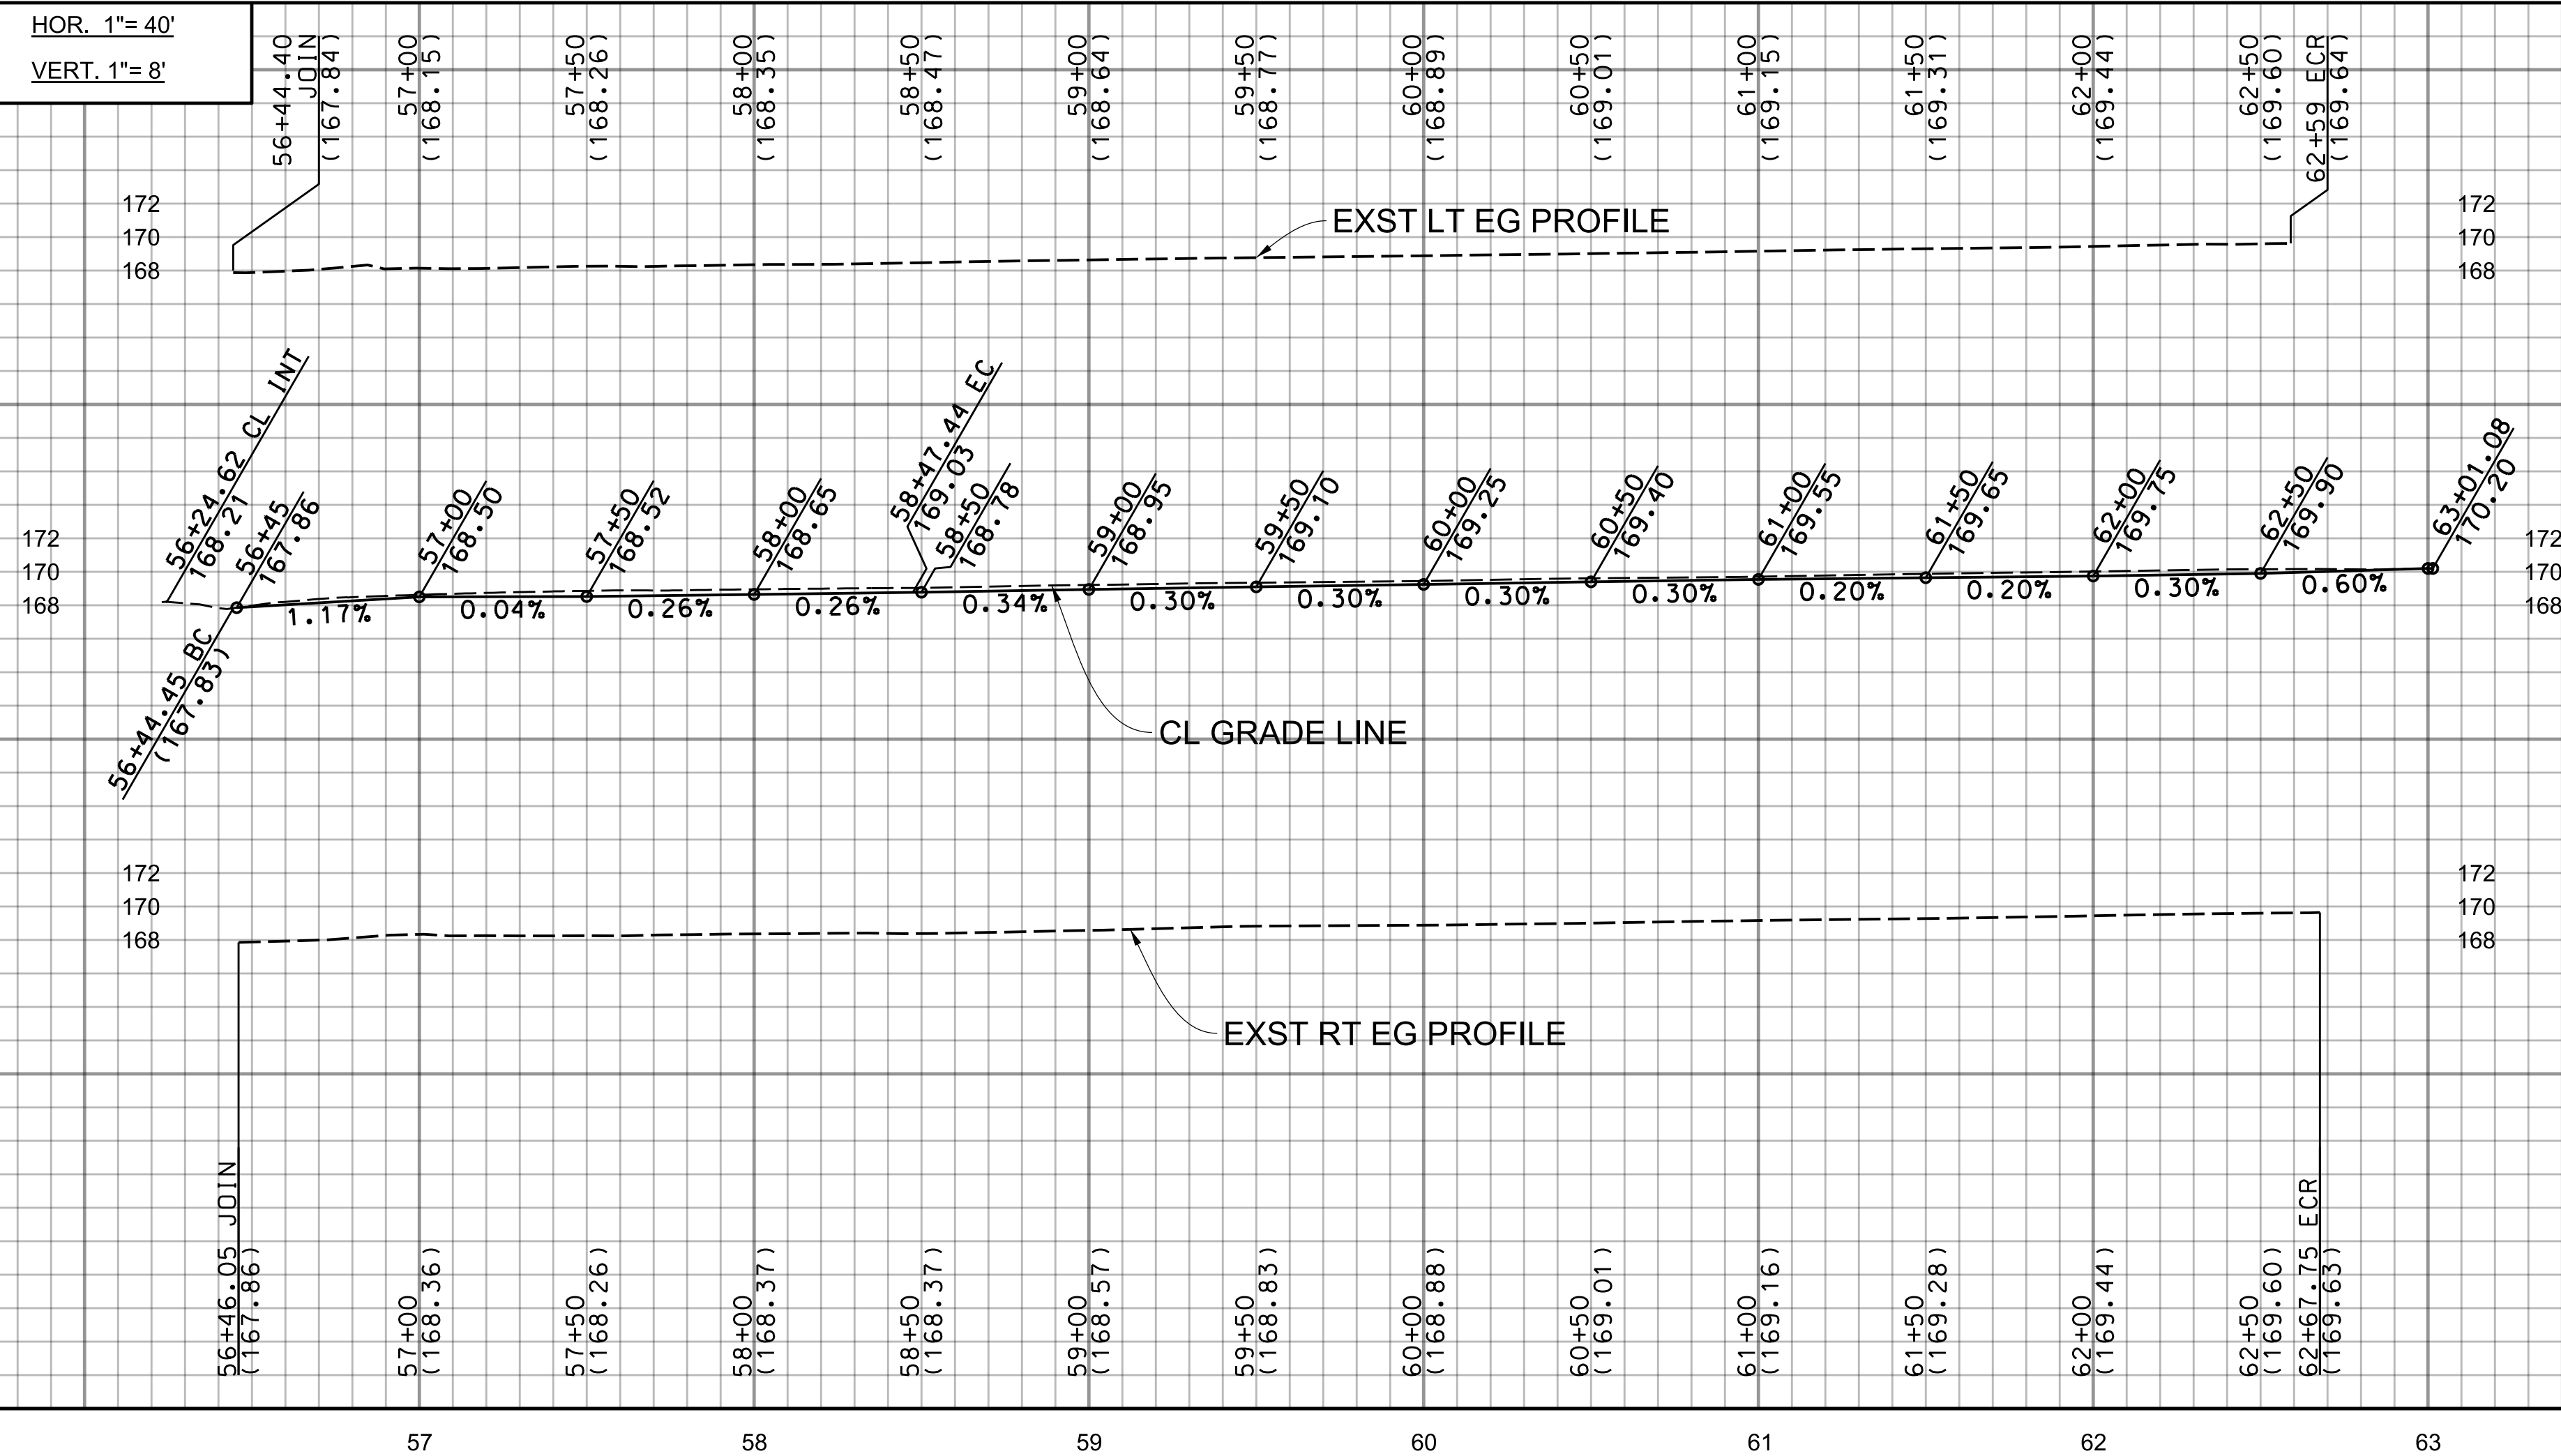


SEE SHEET 68 FOR PARKWAY IMPROVEMENTS

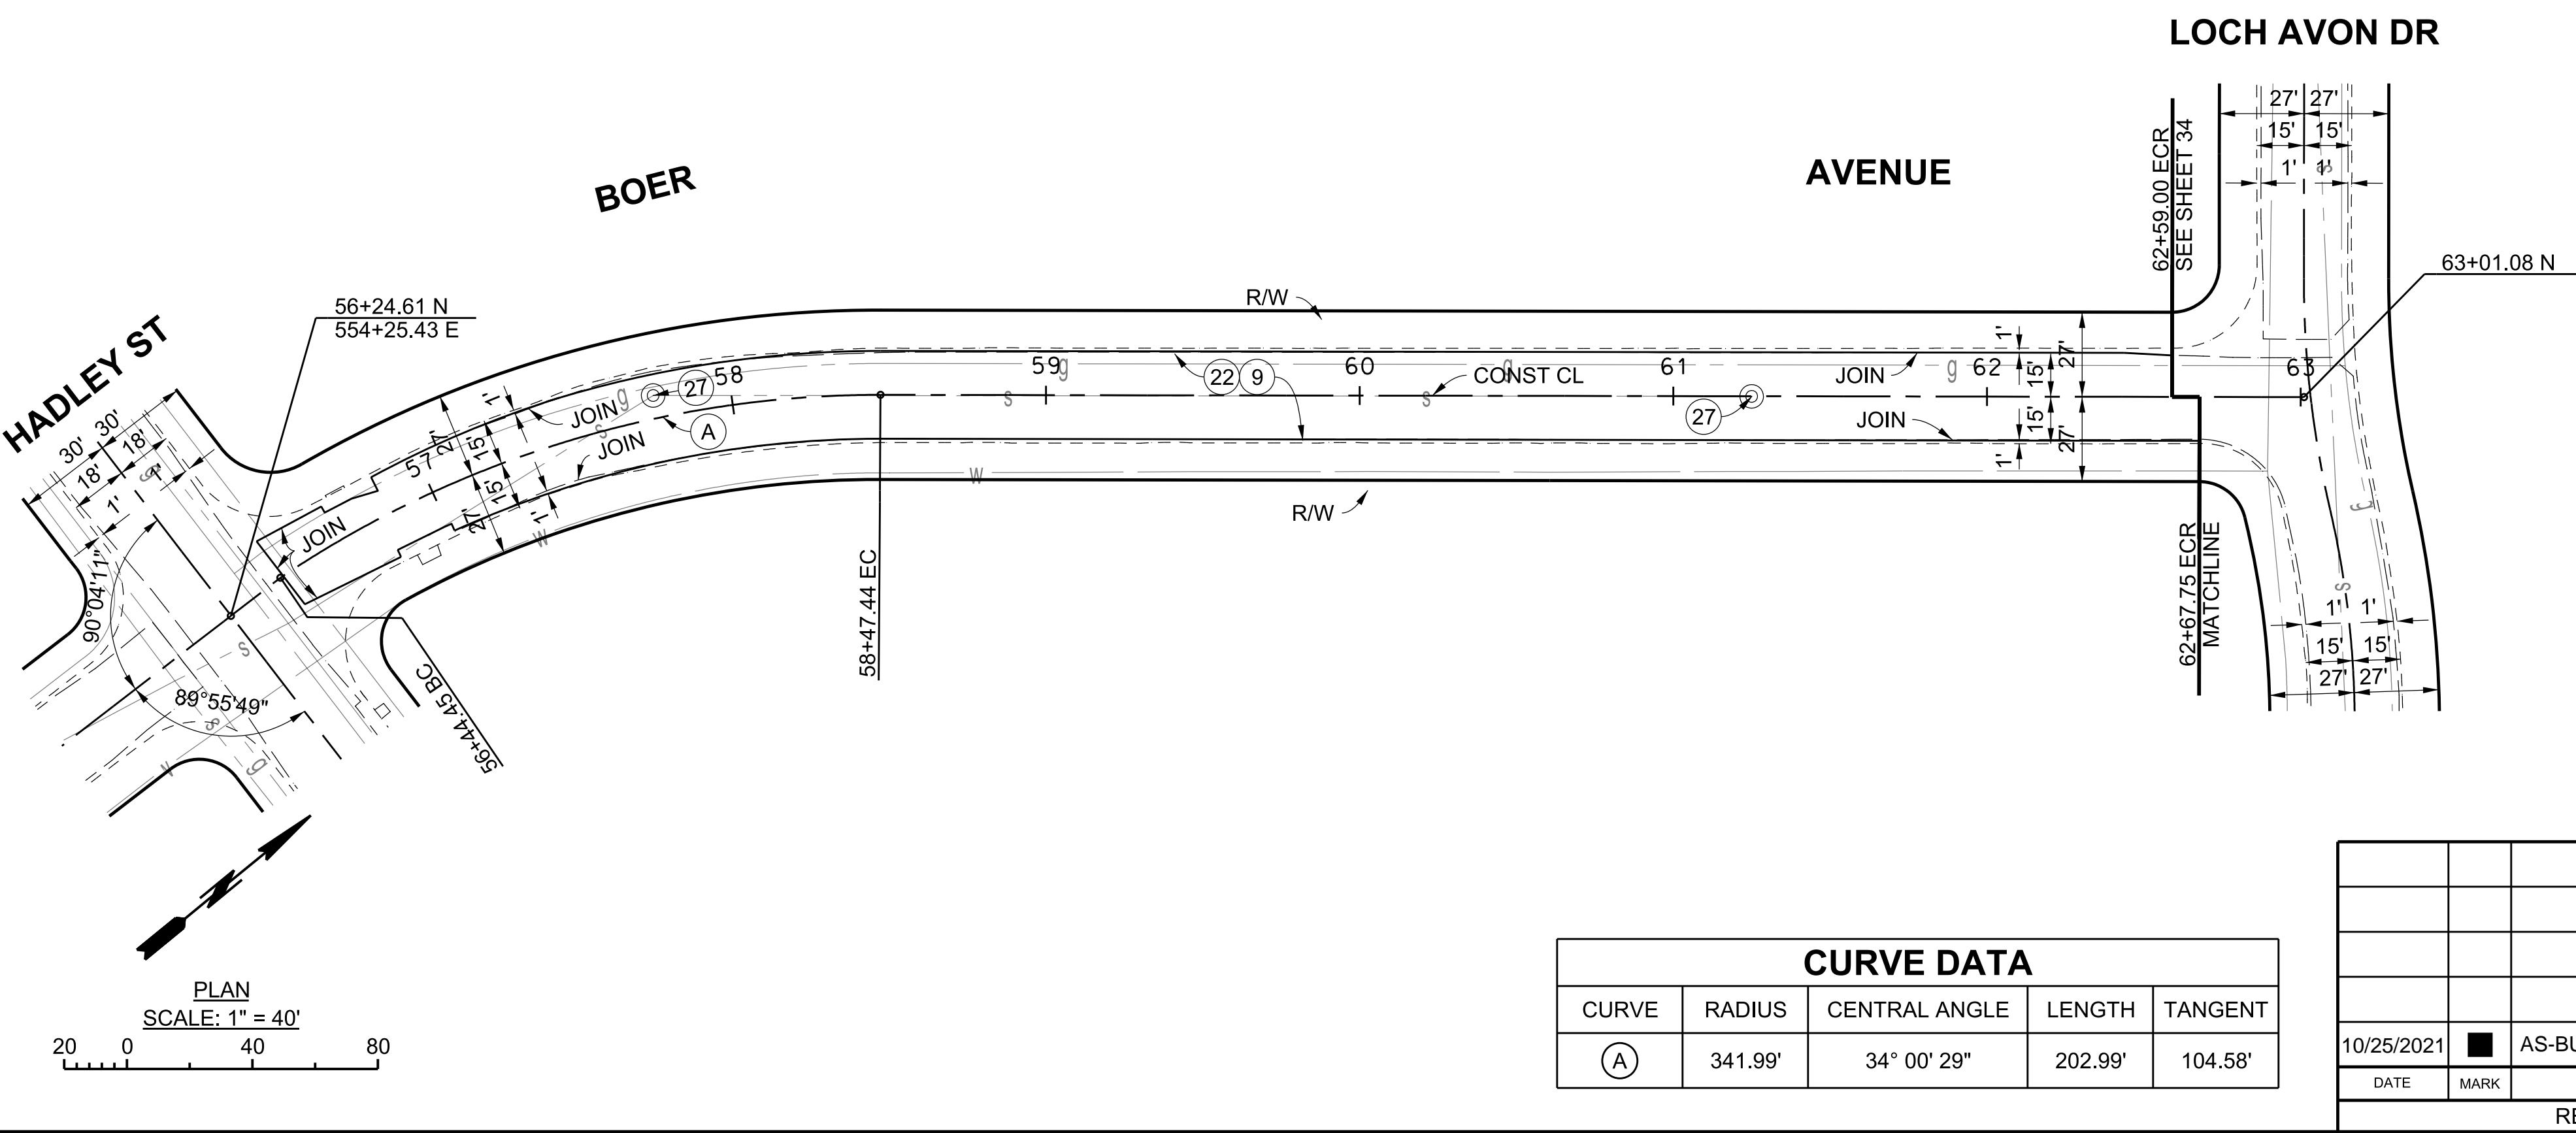

PLAN SCALE: 1"= 40'

CURVE DATA				
CURVE	RADIUS	CENTRAL ANGLE	LENGTH	TANGENT
(A)	341.99'	34° 00' 29"	202.99'	104.58'

DATE	MARK	DESCRIPTION
10/25/2021	AS-BUILT	
REVISIONS		

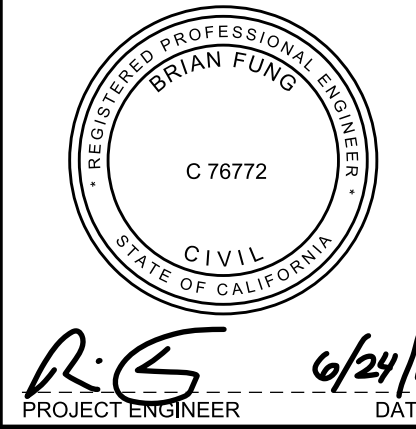

**BENCHMARK**  
PT 808, ELEV ??? (WHITTIER & BASELINE QUAD 2005), PWFB 1026, PG 2168  
CL P. R. C. NOTHING FD/SET POSITION CALC'D PER R1

LOS ANGELES COUNTY PUBLIC WORKS  
**SOUTH WHITTIER LOS NIETOS**  
KEITH DRIVE, ET AL.

PROJECT ID NO. RMD4408001  
PLAN AND PROFILE