

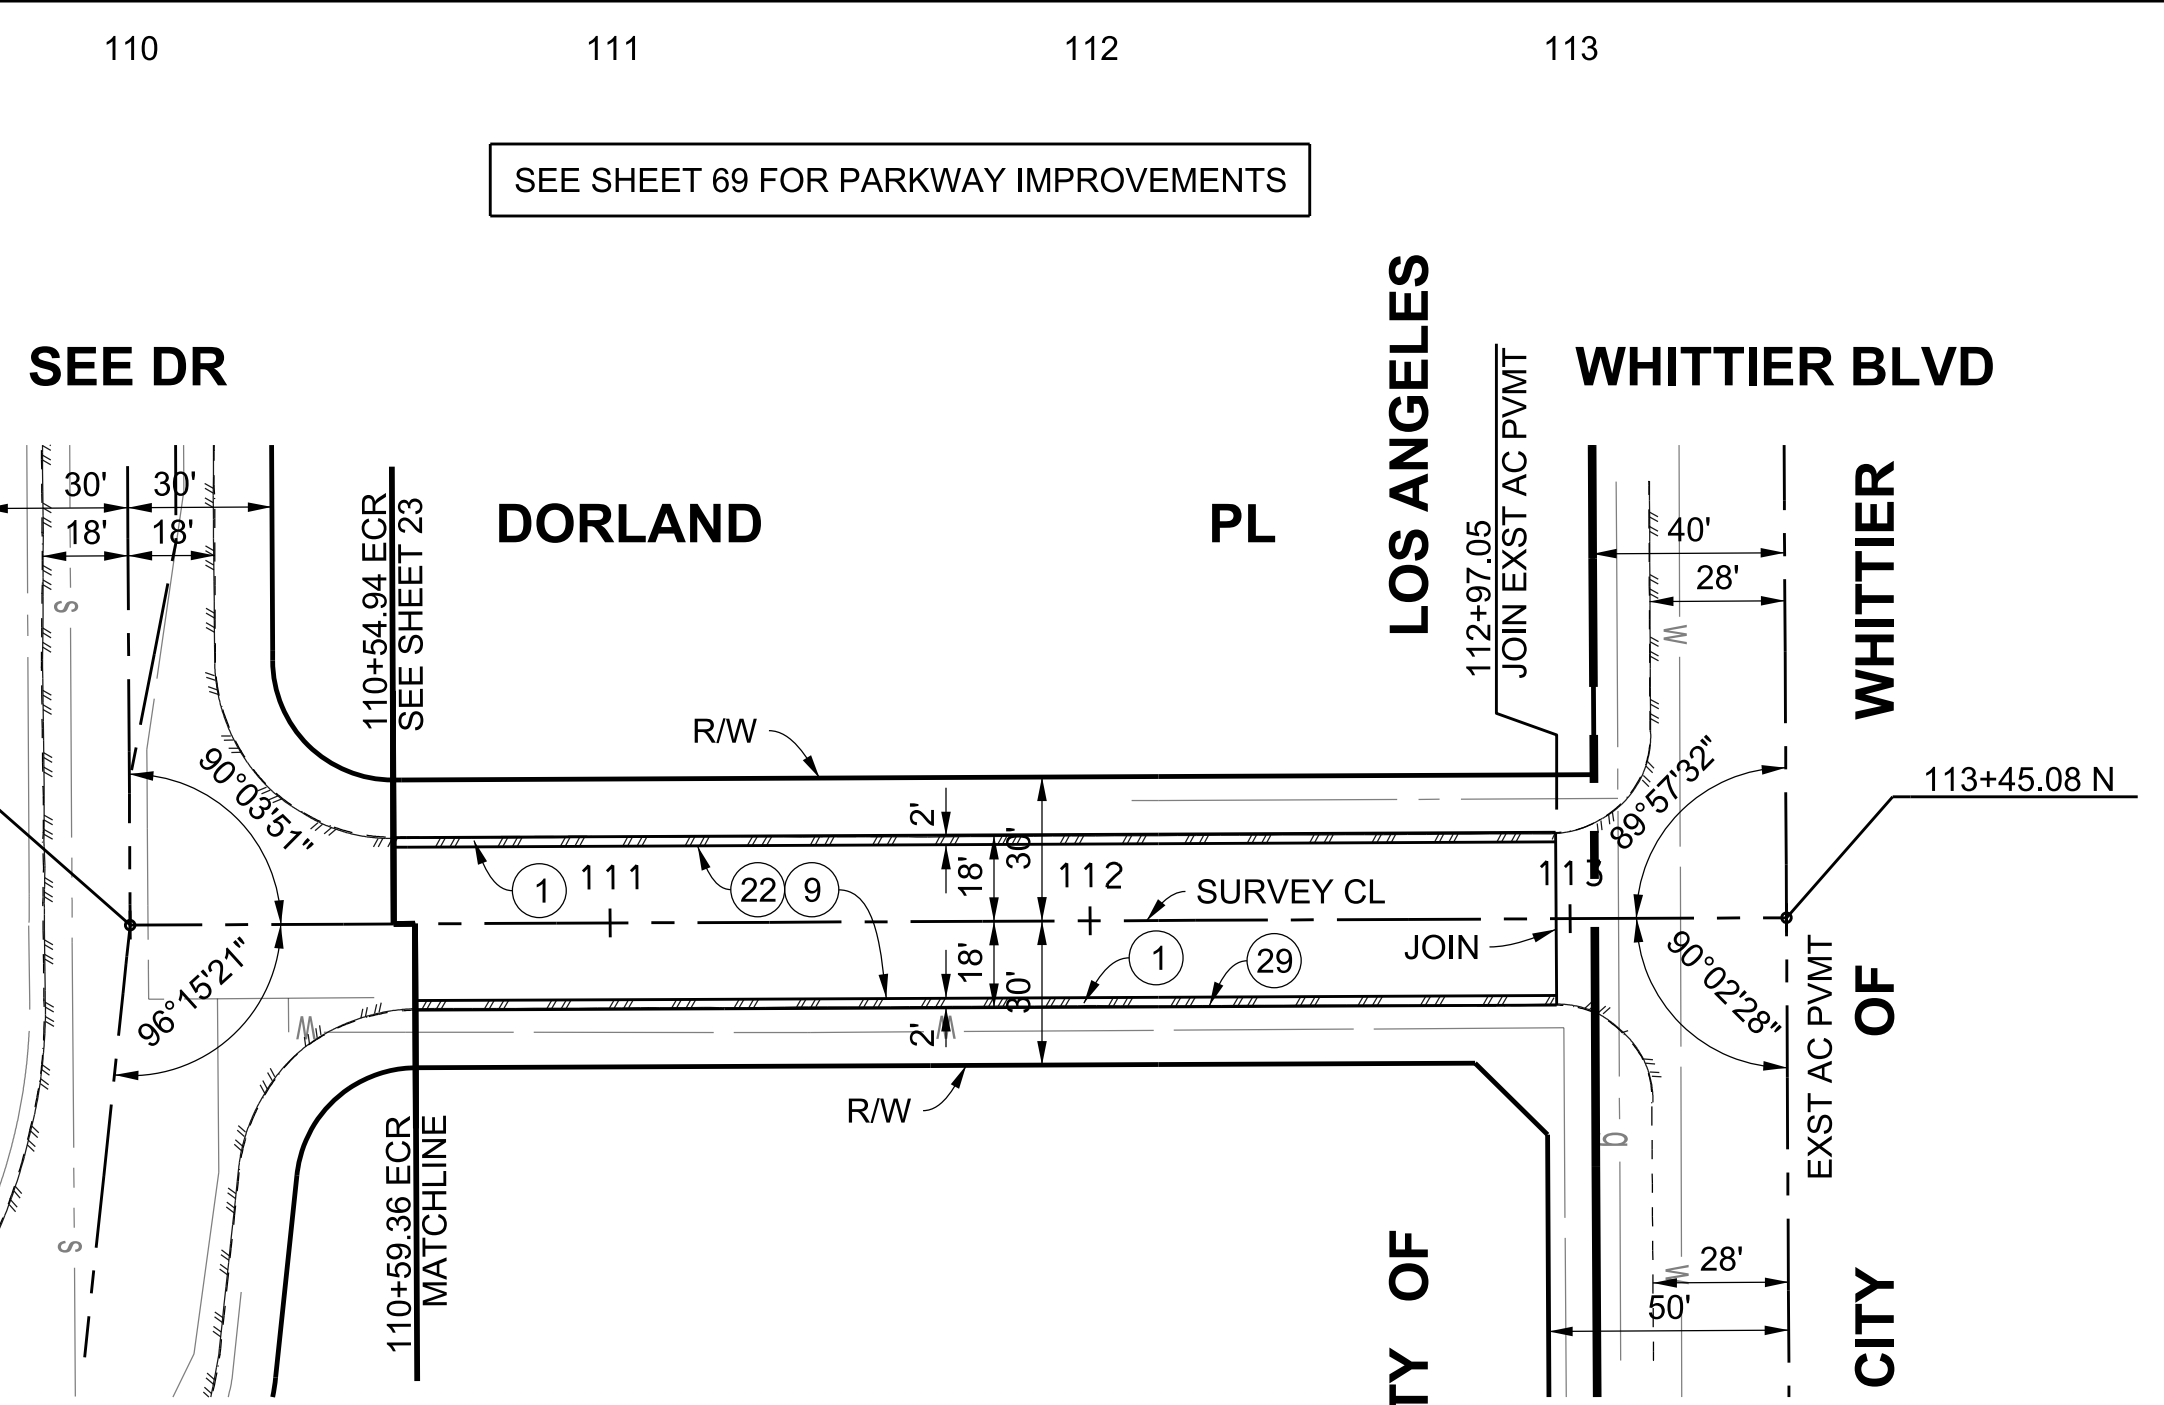


SCALE: HOR. 1"= 40'
VERT. 1"= 8'

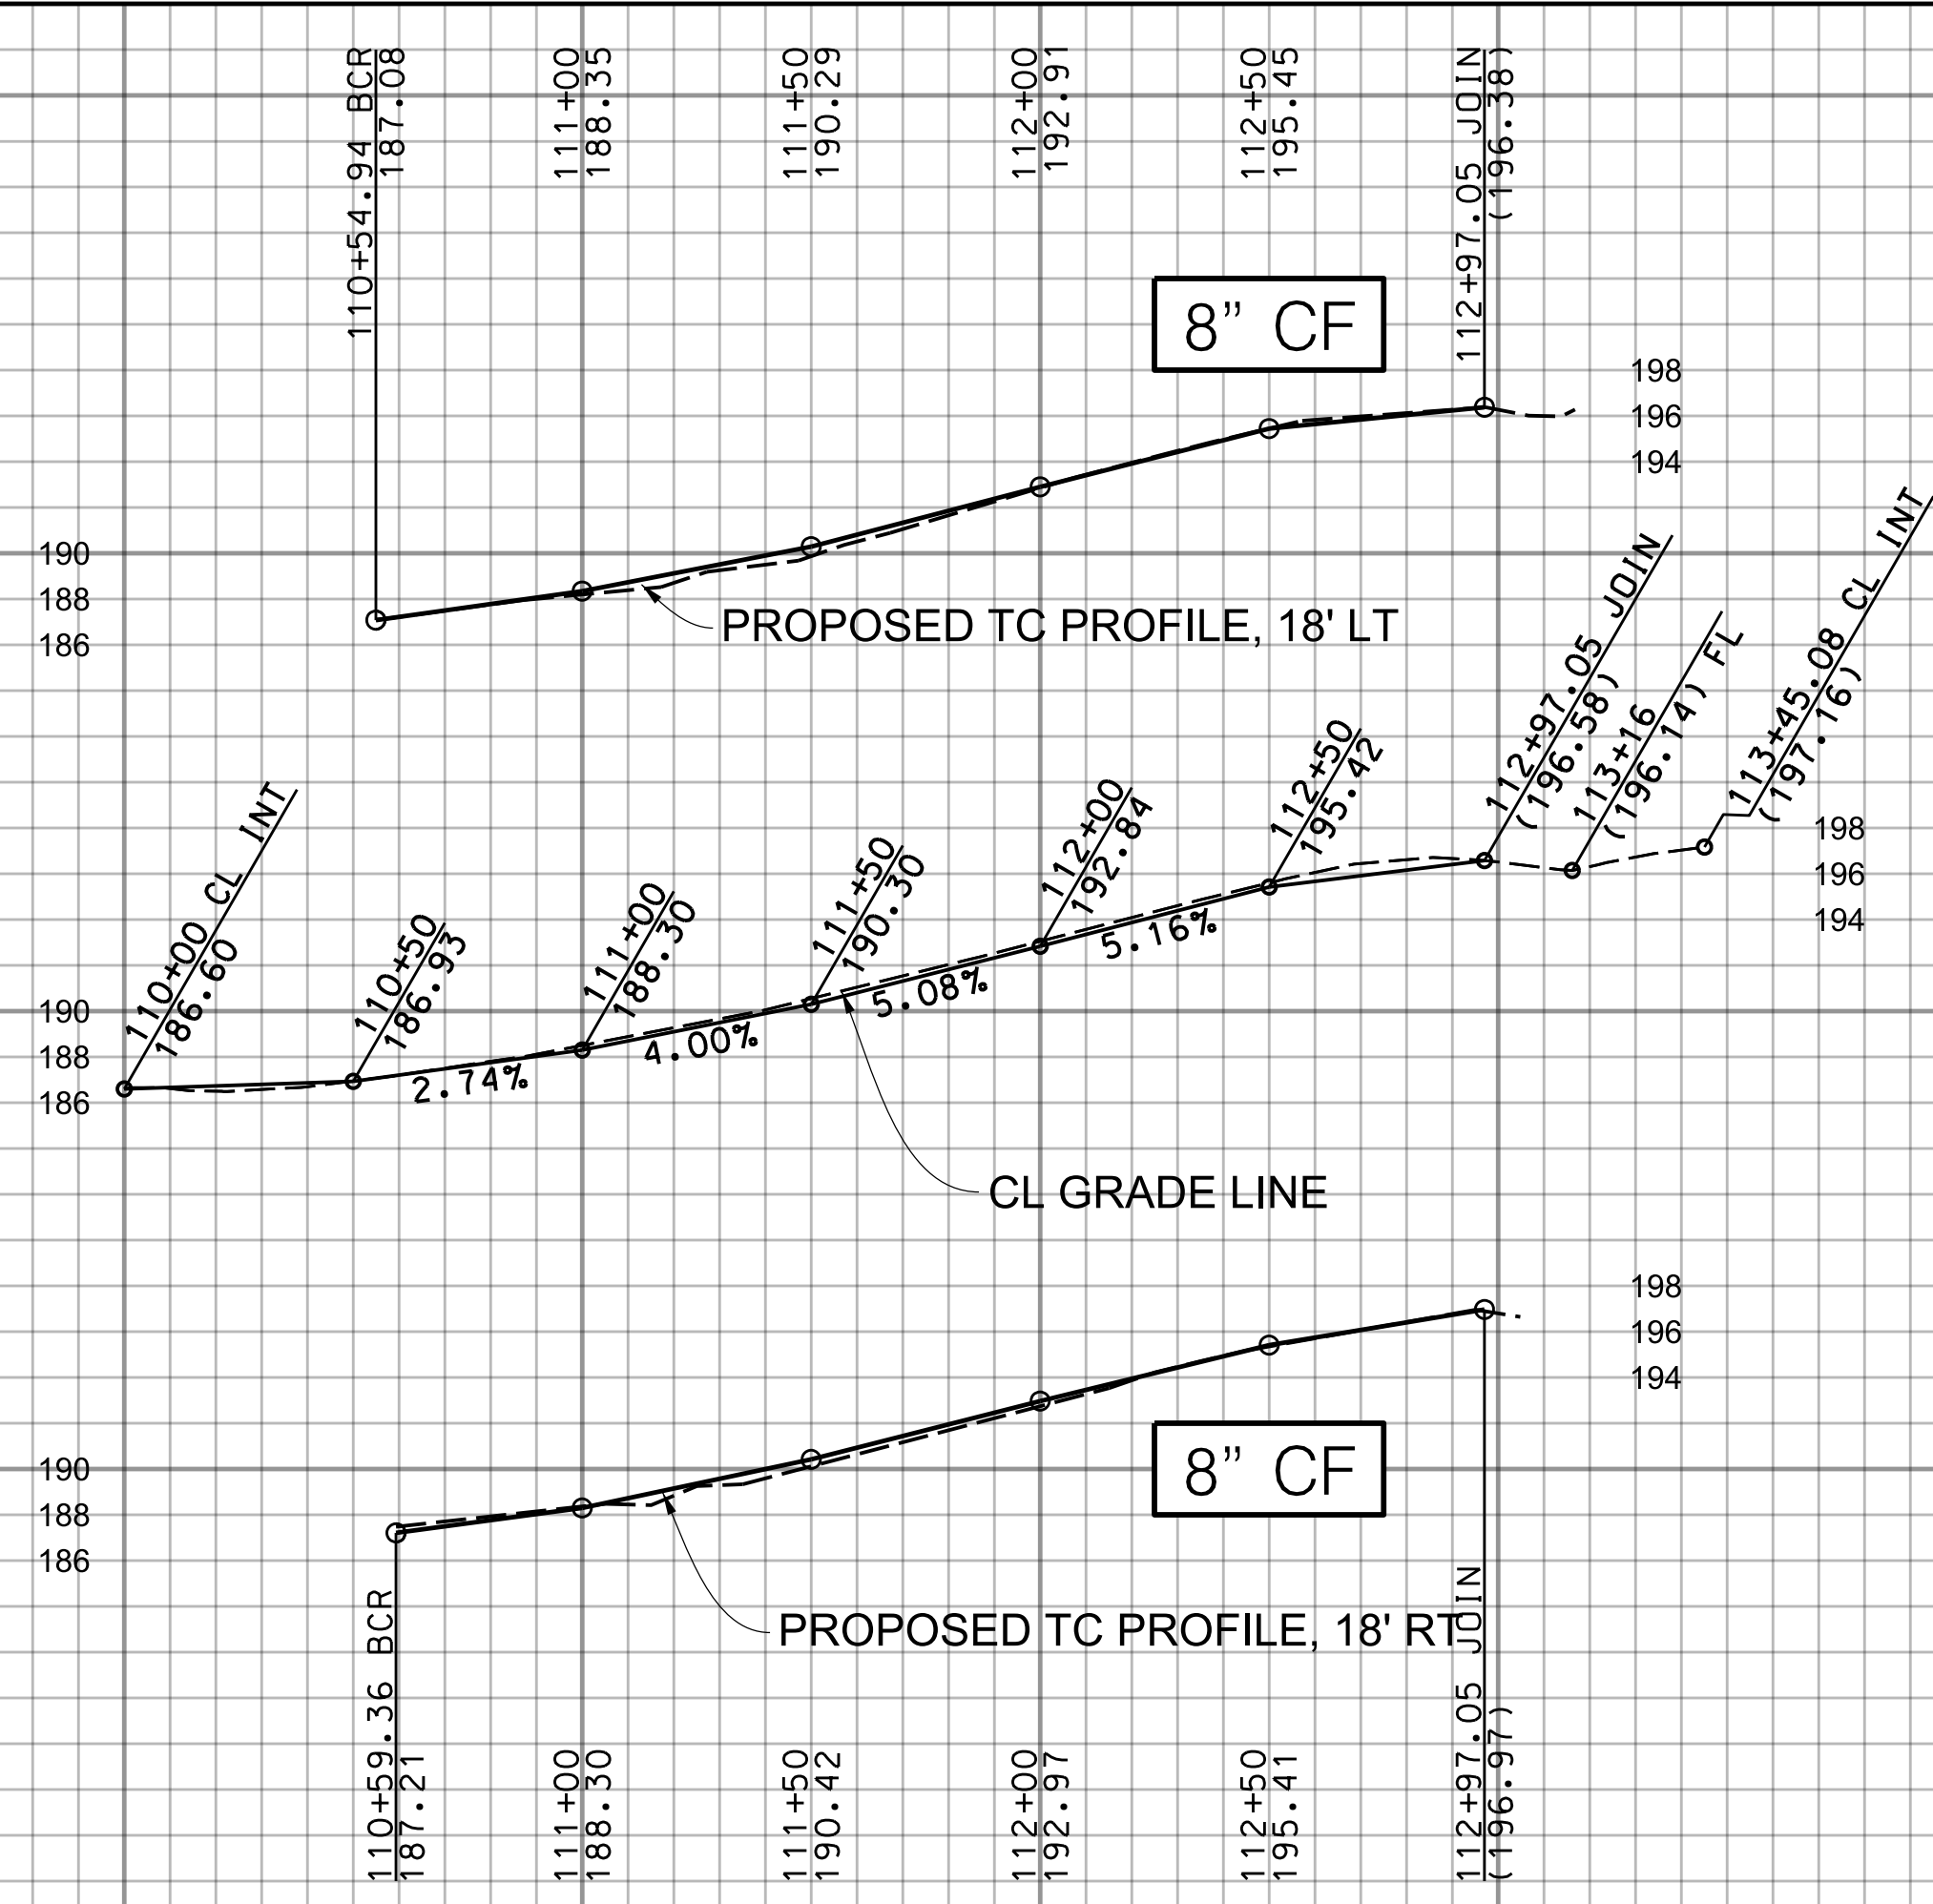


CAD PROJECT FILE NAME: RMD4408001-PLAN-RD.DGN
 CHECKER: B. FUNG
 DESIGNER: J. GARCIA
 DRAFTER: J. GARCIA

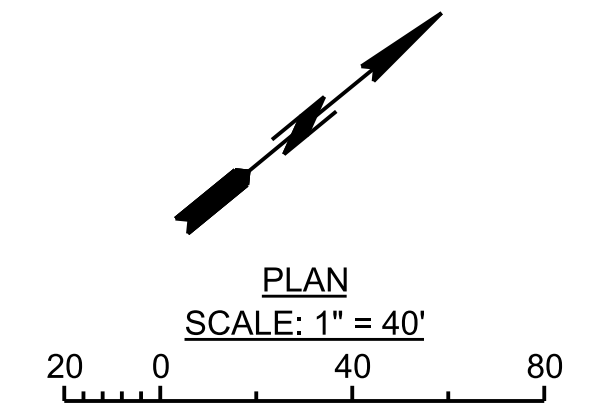

BENCHMARK
 PT 23, ELEV 186.41 (WHITTIER & BASELINE QUAD 2005), PWFB 1027, PG 951
 CL INT DORLAND PL & SEE DR FD SHANK DN 3" NO REF

LOS ANGELES COUNTY PUBLIC WORKS
SOUTH WHITTIER LOS NIETOS
 KEITH DRIVE, ET AL.
 PROJECT ID NO. RMD4408001
PLAN AND PROFILE

DATE	MARK	DESCRIPTION
10/25/2021	■	AS-BUILT
REVISIONS		

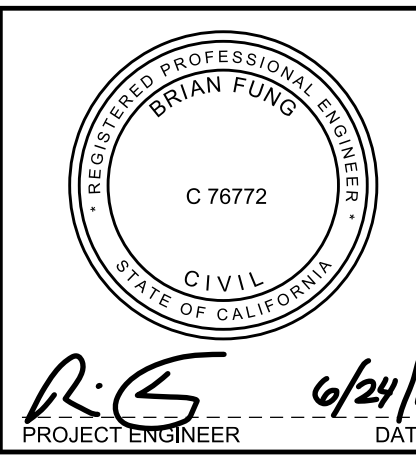

PD PH086533 SHEET 14 OF 79