



SCALE: HOR. 1"= 40'  
VERT. 1"= 8'

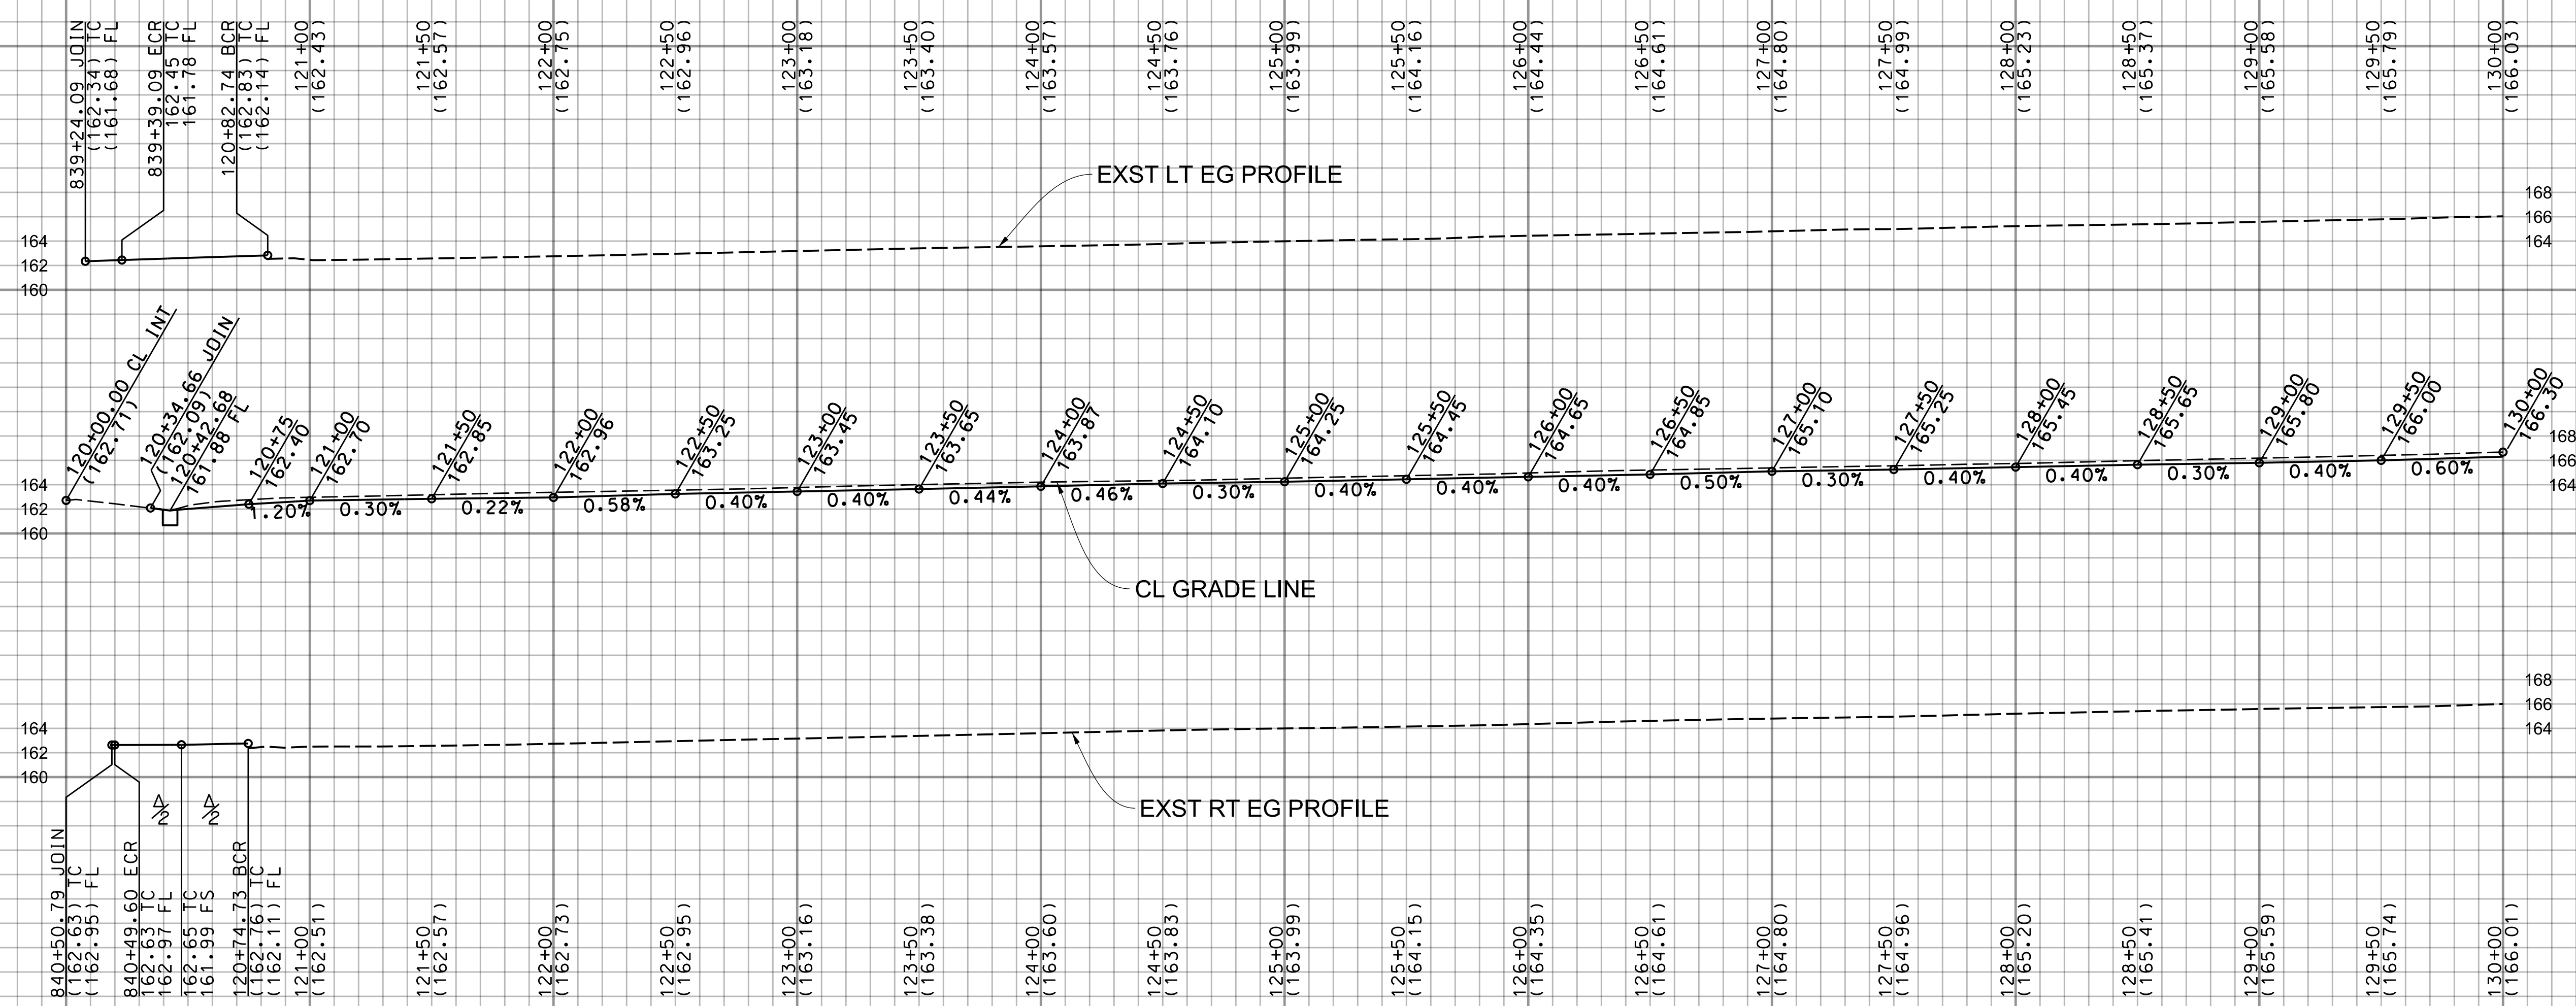

120 121 122 123 124 125 126 127 128 129 130

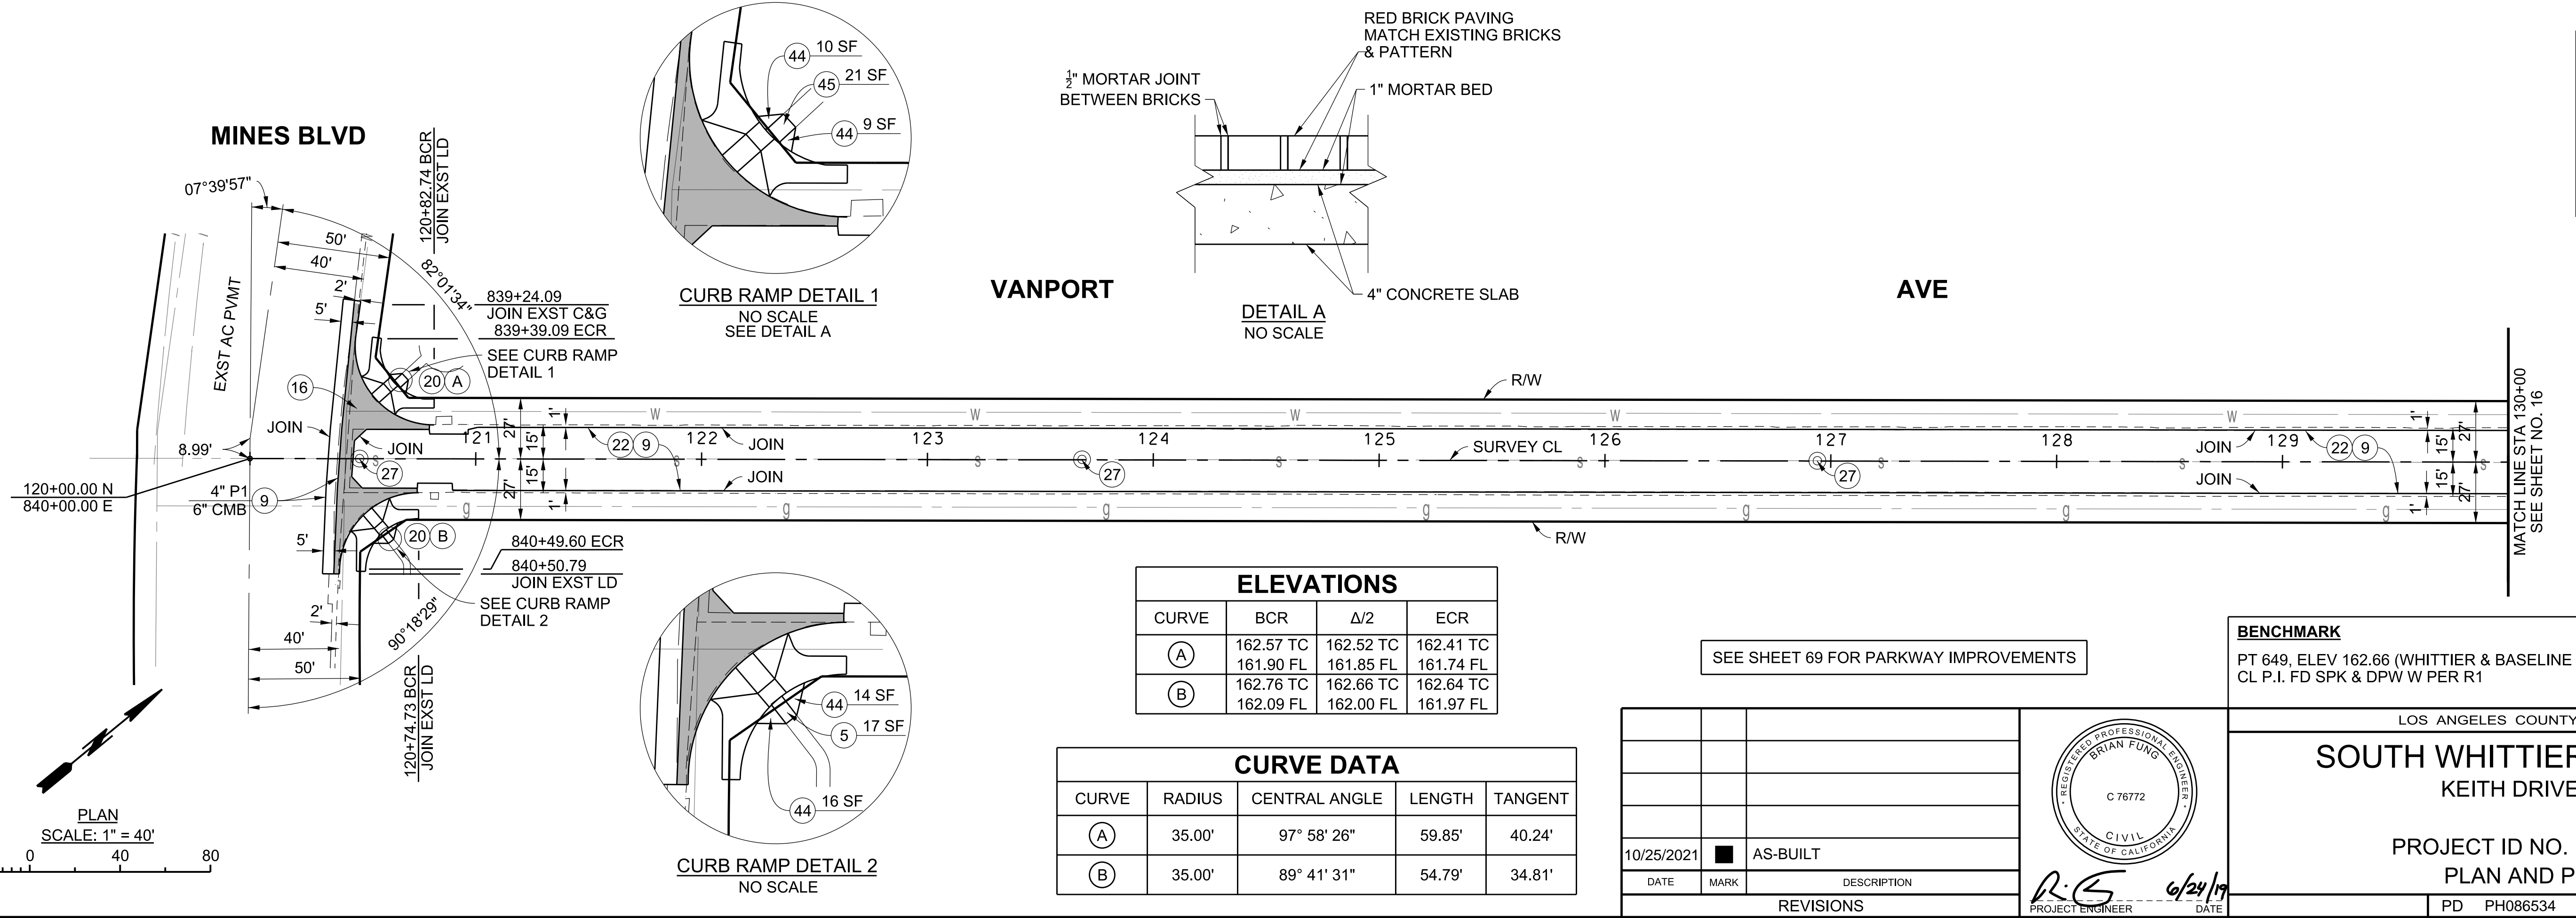

CADD PROJECT FILE NAME: RMD4408001-PLAN-RD.DGN  
CHECKER: B. FUNG  
DESIGNER: J. GARCIA  
DRAFTER: J. GARCIA

**BENCHMARK**  
PT 649, ELEV 162.66 (WHITTIER & BASELINE QUAD 2005), PWFB 1026, PG 2192  
CL P.I. FD SPK & DPW W PER R1

LOS ANGELES COUNTY PUBLIC WORKS  
**SOUTH WHITTIER LOS NIETOS**  
KEITH DRIVE, ET AL.  
PROJECT ID NO. RMD4408001  
PLAN AND PROFILE  
PD PH086534 SHEET 15 OF 79



PROJECT ENGINEER: R. G. DATE: 6/24/19

DATE	MARK	DESCRIPTION
10/25/2021	AS-BUILT	
REVISIONS		