


SCALE: HOR. 1" = 40'  
VERT. 1" = 8'

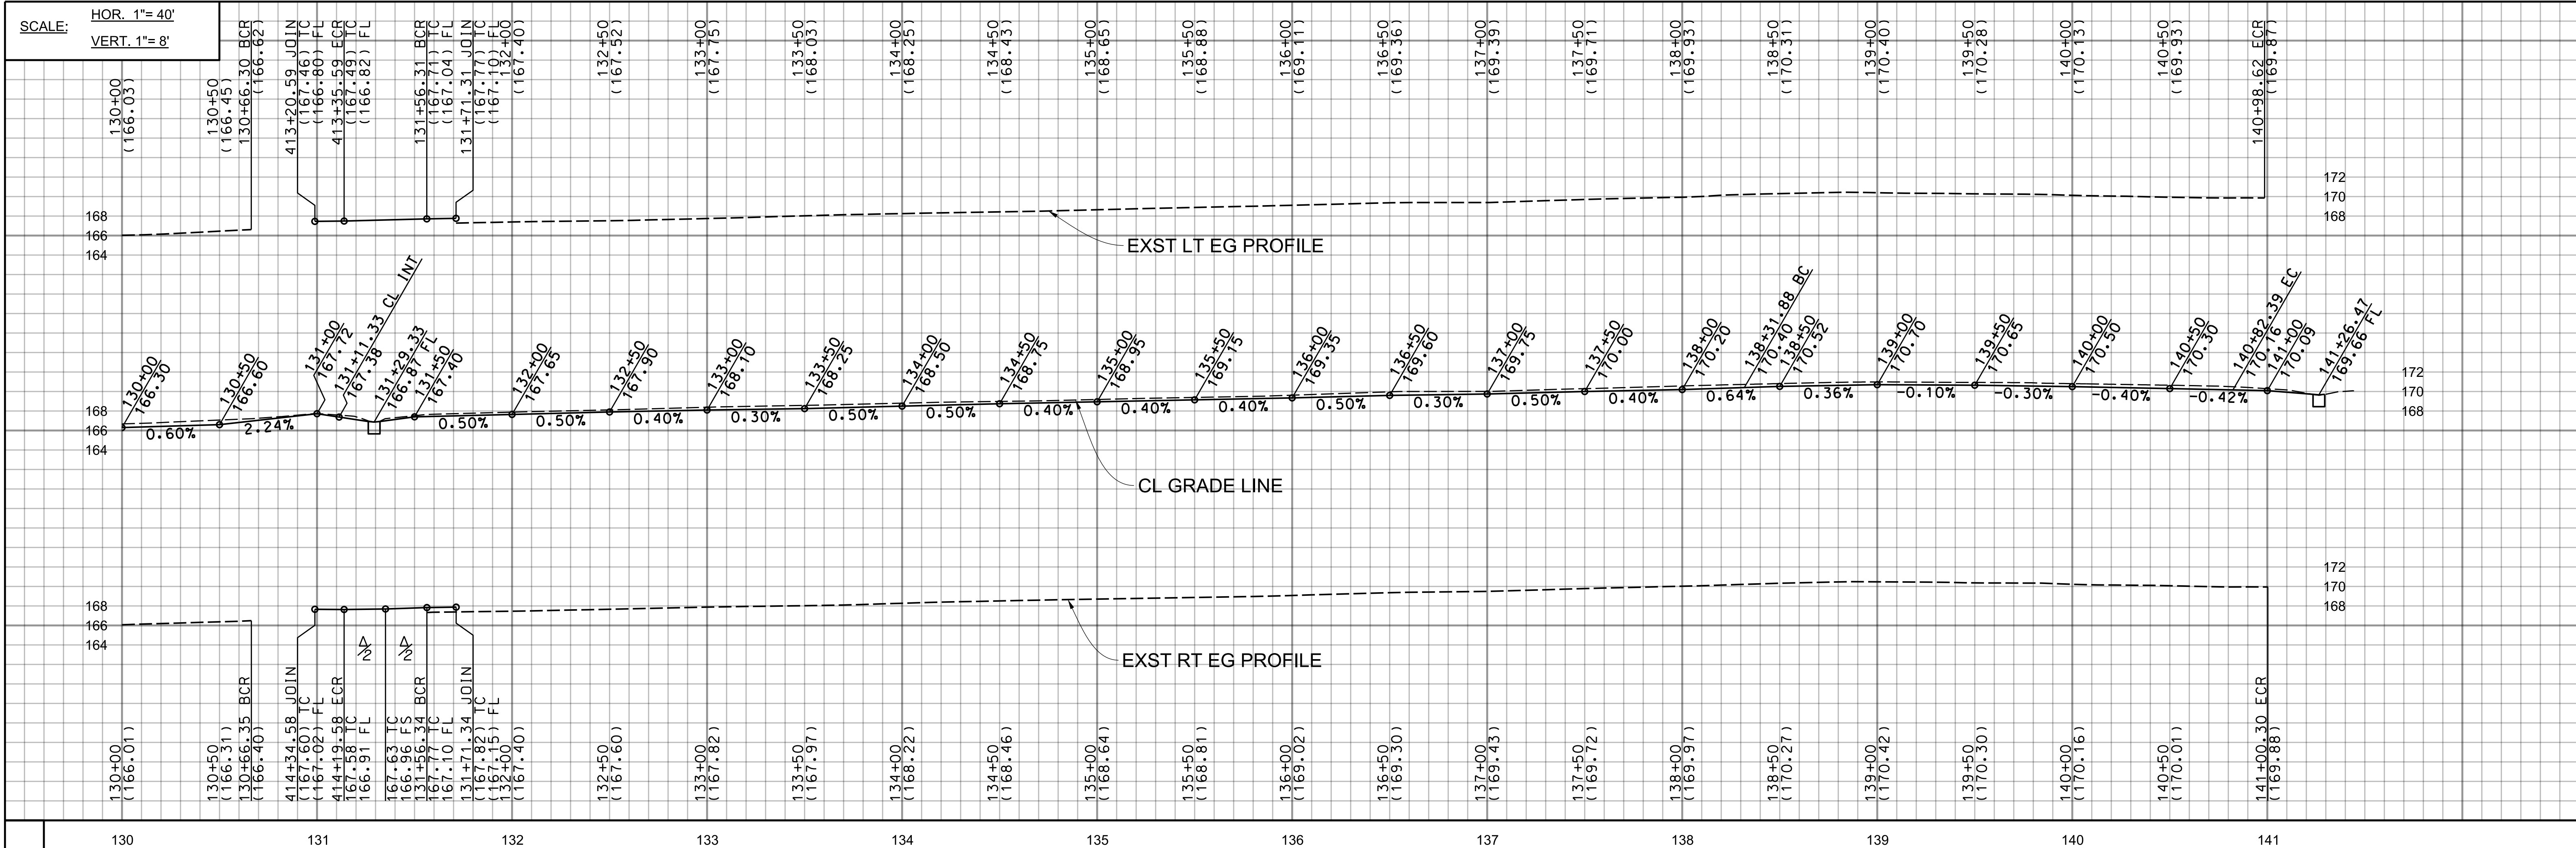


SEE SHEET 69 FOR PARKWAY IMPROVEMENTS

ELEVATIONS			
CURVE	BCR	Δ/2	ECR
(B)	167.15 TC 166.48 FL	167.58 TC 166.91 FL	167.23 TC 166.56 FL
(C)	167.71 TC 167.04 FL	167.56 TC 166.89 FL	167.49 TC 166.82 FL
(D)	166.95 TC 166.28 FL	167.52 TC 166.86 FL	167.31 TC 166.64 FL
(E)	167.77 TC 167.10 FL	167.63 TC 166.96 FL	167.58 TC 166.91 FL

INTERSECTION DATA		
STATION	OFFSET	ELEV
130+94.32	14' LT	167.47
130+94.34	14' RT	167.42
413+62.57	18' LT	166.83
413+77.57	18' LT	166.86
413+92.57	18' LT	166.90

CURVE DATA				
CURVE	RADIUS	CENTRAL ANGLE	LENGTH	TANGENT
(A)	400.00'	35° 52' 57"	250.51'	129.51'
(B)	27.00'	90° 02' 18"	42.43'	27.02'
(C)	27.00'	89° 58' 32"	42.40'	26.99'
(D)	27.00'	89° 58' 24"	42.40'	26.99'
(E)	27.00'	90° 00' 46"	42.42'	27.01'

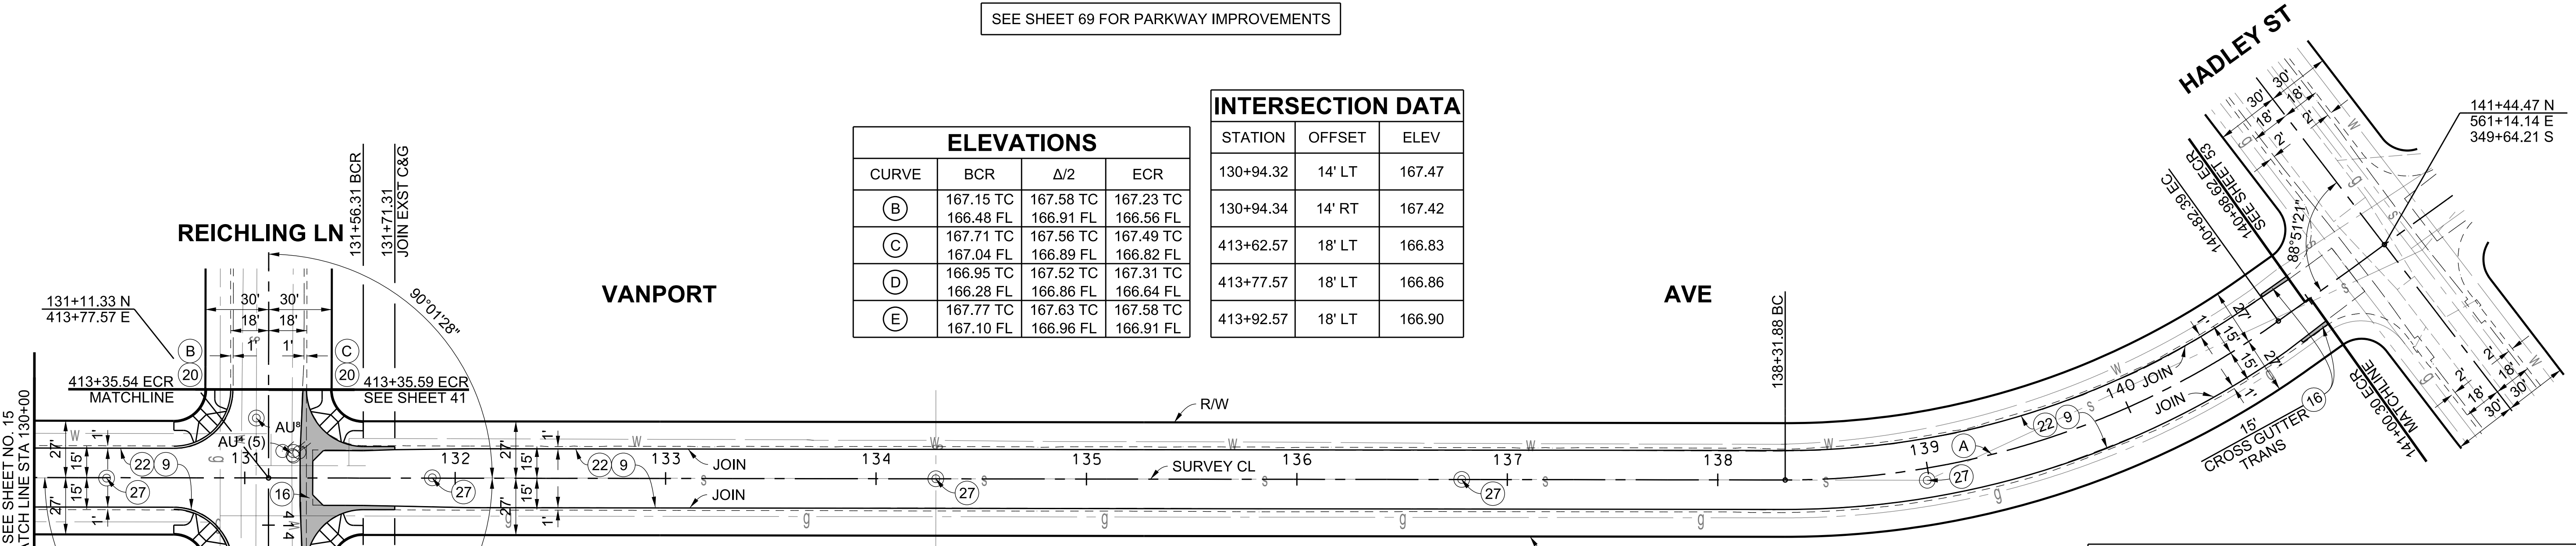


**BENCHMARK**  
PT 645, ELEV 167.68 (WHITTIER & BASELINE QUAD 2005), PWFB 1026, PG 2191  
CL INT VANPORT AVE & REICHLING LN FD SPK & T.FL PER R1

LOS ANGELES COUNTY PUBLIC WORKS  
**SOUTH WHITTIER LOS NIETOS**  
KEITH DRIVE, ET AL.  
PROJECT ID NO. RMD4408001  
PLAN AND PROFILE



PROJECT ENGINEER  
DATE: 6/24/19

DATE	MARK	DESCRIPTION
10/25/2021	AS-BUILT	
REVISIONS		

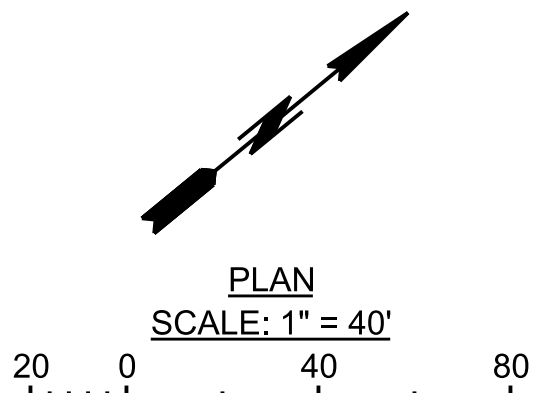

CADD PROJECT FILE NAME: RMD4408001-PLAN-RD.DGN  
CHECKER: B. FUNG  
DESIGNER: J. GARCIA  
DRAFTER: J. GARCIA