


SCALE: HOR. 1"= 40'  
VERT. 1"= 8'

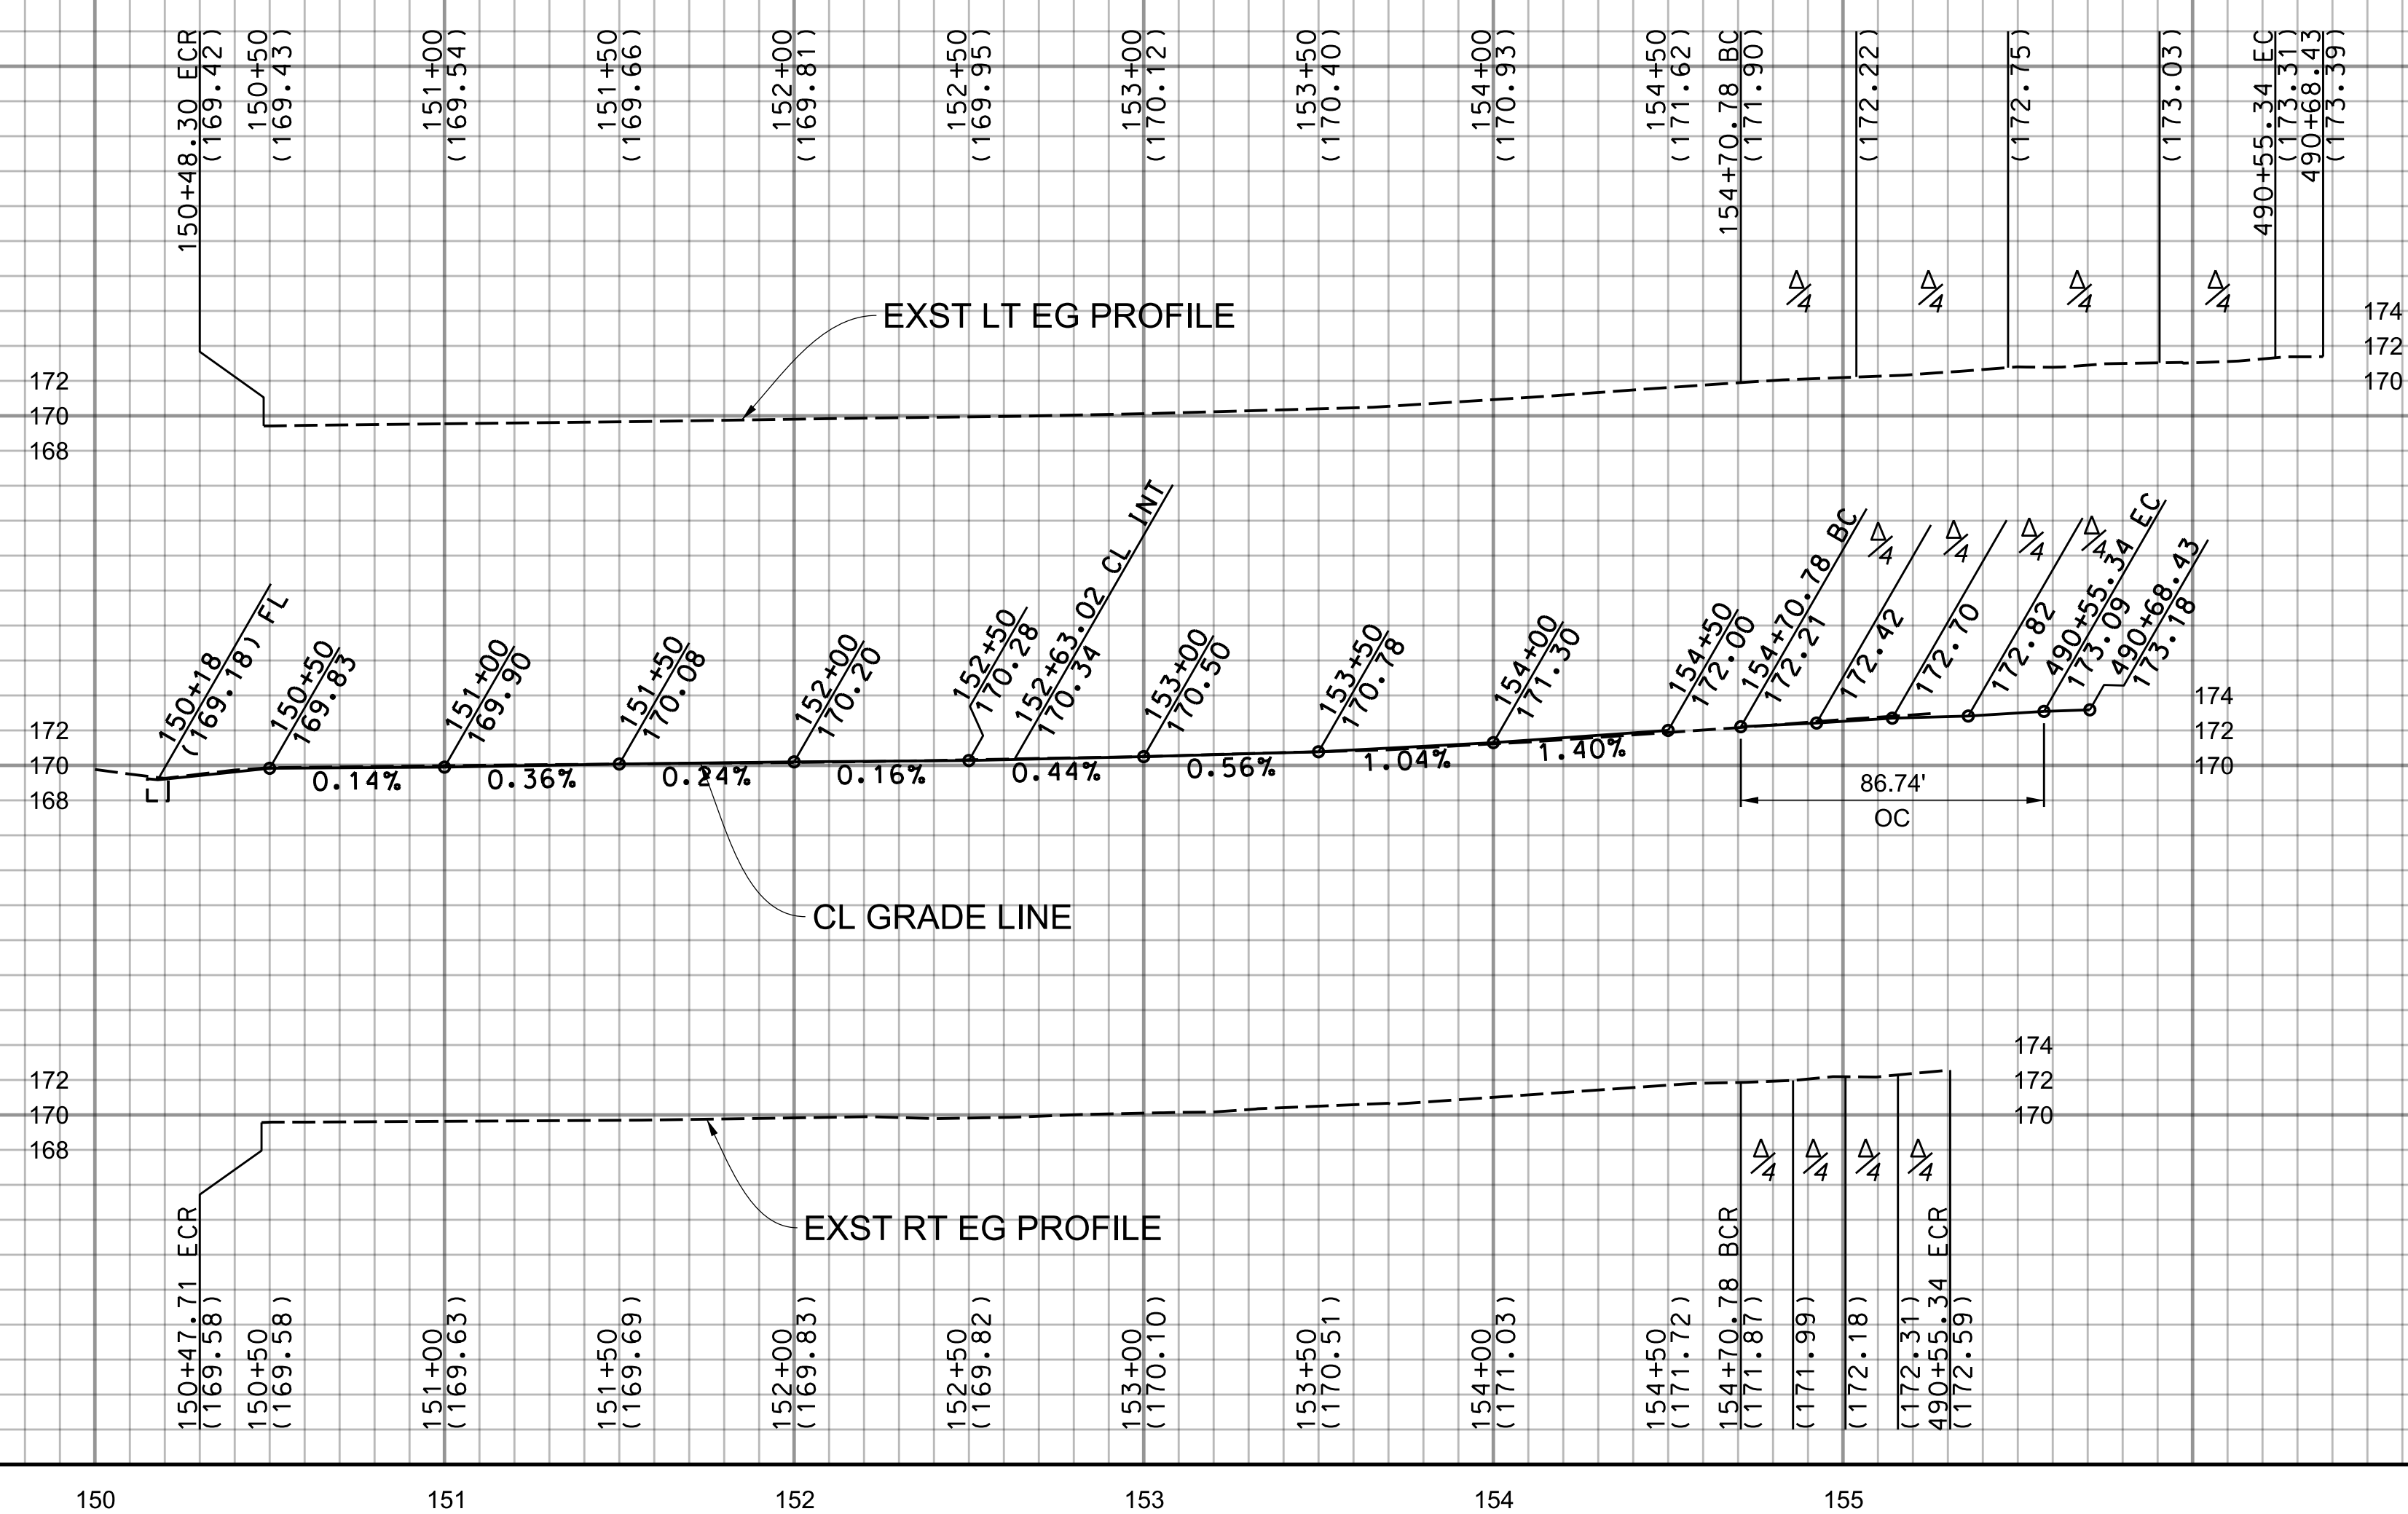


BEXLEY DR

THORNLAKE AVE


AVE

SEE SHEET 69 FOR PARKWAY IMPROVEMENTS

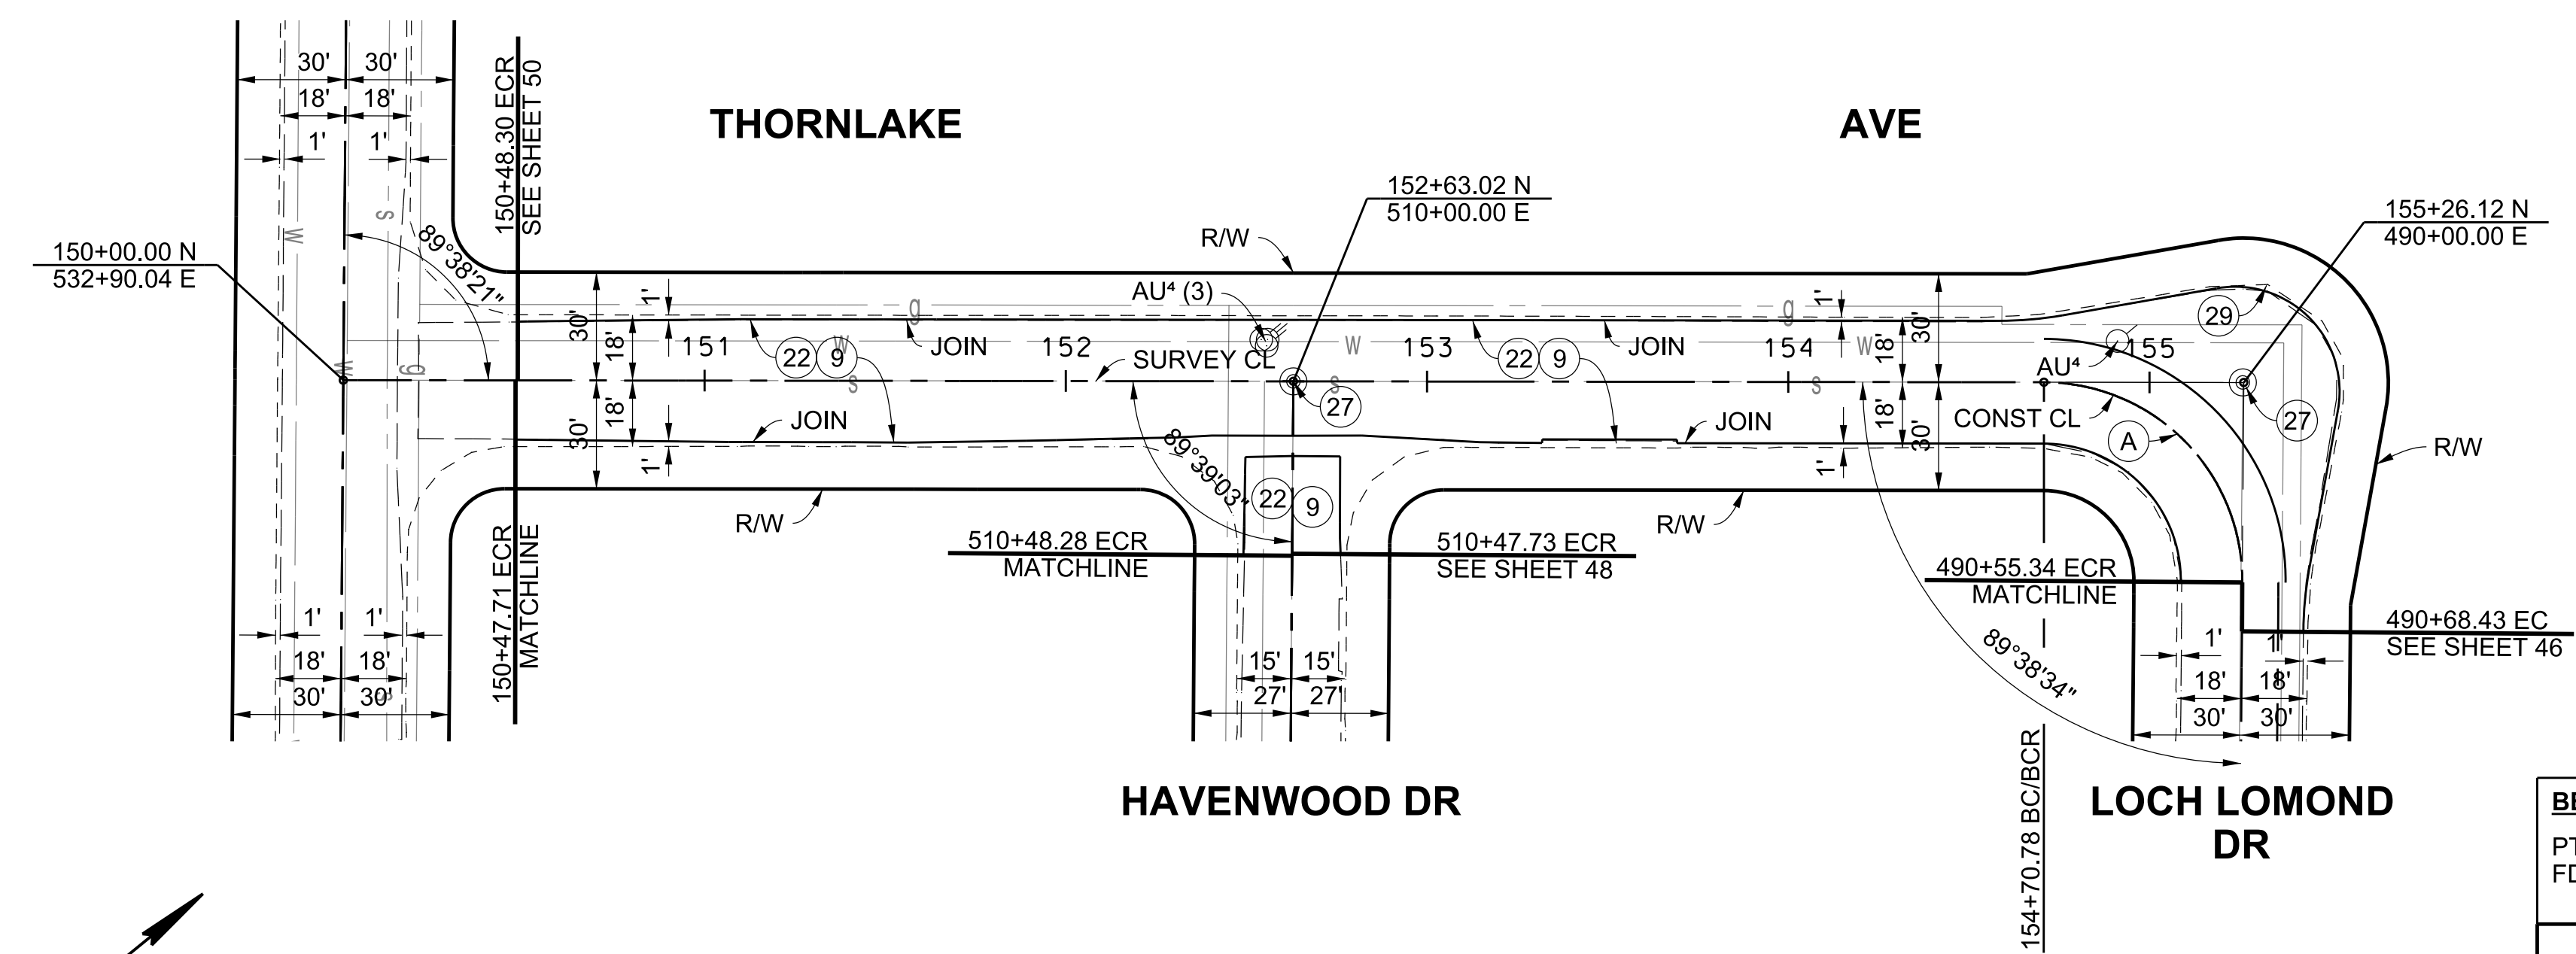

THORNLAKE AVE

LOCH LOMOND DR

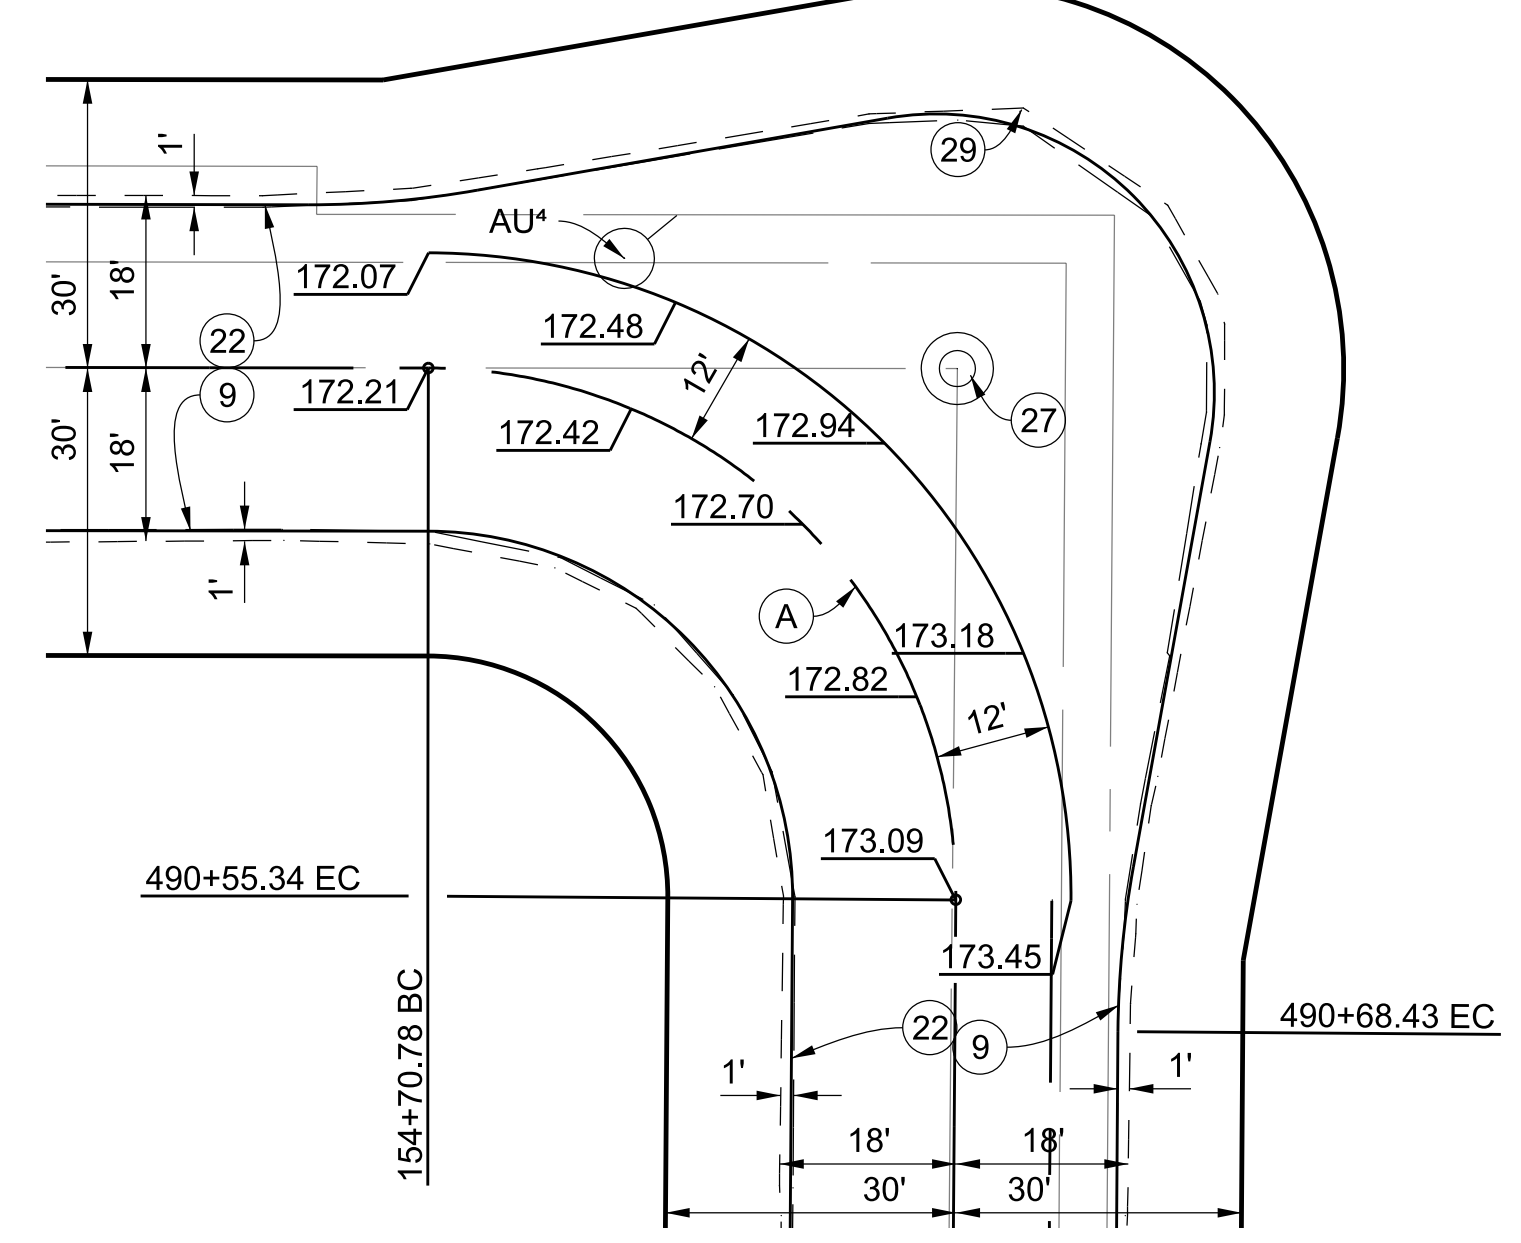


KNUCKLE DETAIL  
SCALE: 1" = 20'

CURVE DATA				
CURVE	RADIUS	CENTRAL ANGLE	LENGTH	TANGENT
(A)	55.00'	90° 21' 26"	86.74'	55.34'

**BENCHMARK**  
PT 630, ELEV 169.79 (WHITTIER & BASELINE QUAD 2005), PWFB 1026, PG 2186  
FD MAG NAIL, NO REF, 0.02' S/O LINE

DATE	MARK	DESCRIPTION
10/25/2021	AS-BUILT	
REVISIONS		

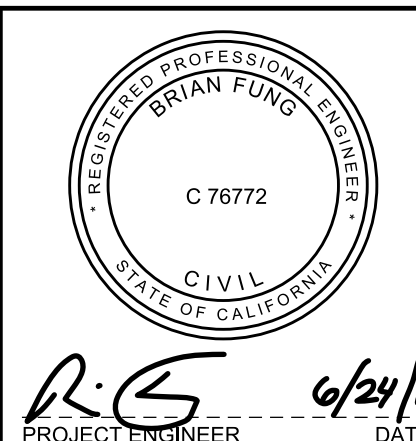

LOS ANGELES COUNTY PUBLIC WORKS  
**SOUTH WHITTIER LOS NIETOS**  
KEITH DRIVE, ET AL.  
PROJECT ID NO. RMD4408001  
PLAN AND PROFILE  
PD PH086536 SHEET 17 OF 79