



SCALE: HOR. 1"=40'  
VERT. 1"=8'

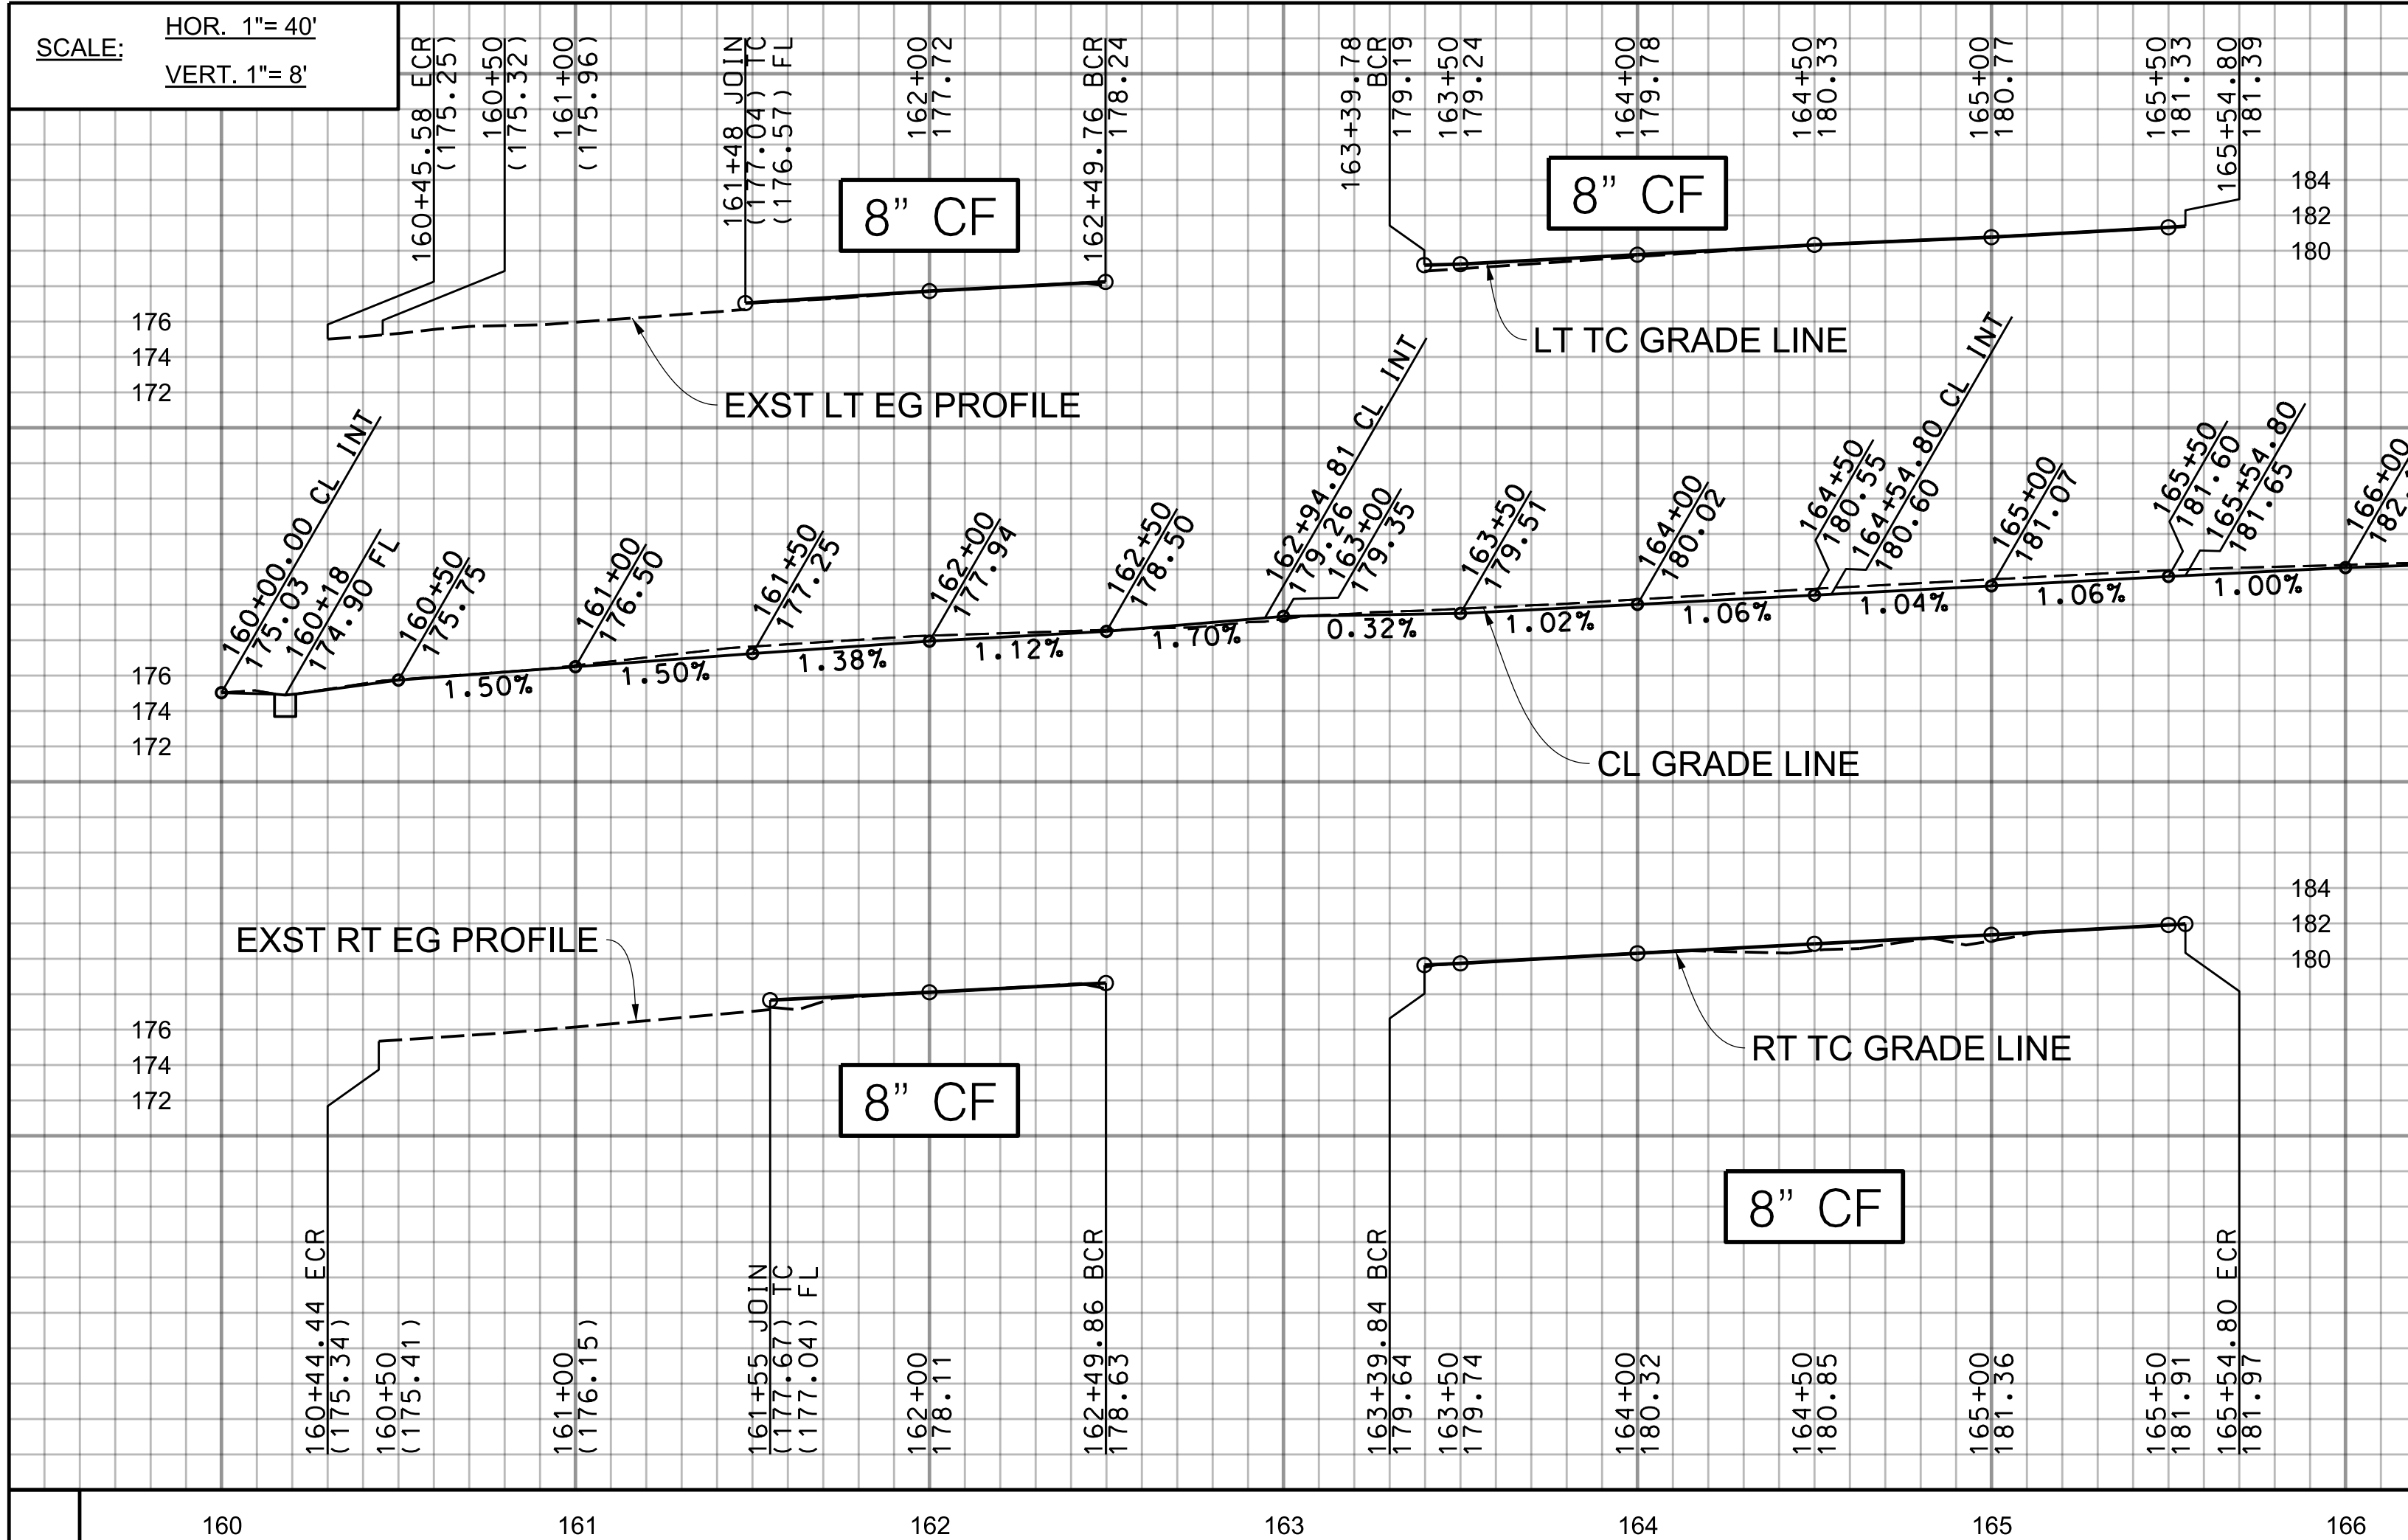


ELEVATIONS			
CURVE	BCR	Δ/2	ECR
(A)	178.24 TC 177.57 FL	178.68 TC 178.10 FL	178.70 TC 178.20 FL
(B)	179.19 TC 178.52 FL	179.10 TC 178.43 FL	179.01 TC 178.34 FL
(C)	178.63 TC 177.96 FL	178.95 TC 178.37 FL	179.11 TC 178.61 FL
(D)	179.64 TC 178.97 FL	179.54 TC 178.95 FL	179.56 TC 179.06 FL

INTERSECTION DATA		
STATION	OFFSET	ELEV
162+76.79	18' LT	178.50
163+12.80	18' LT	179.05
162+74.83	20' RT	178.49
162+94.82	20' RT	178.68
163+14.82	20' RT	178.87

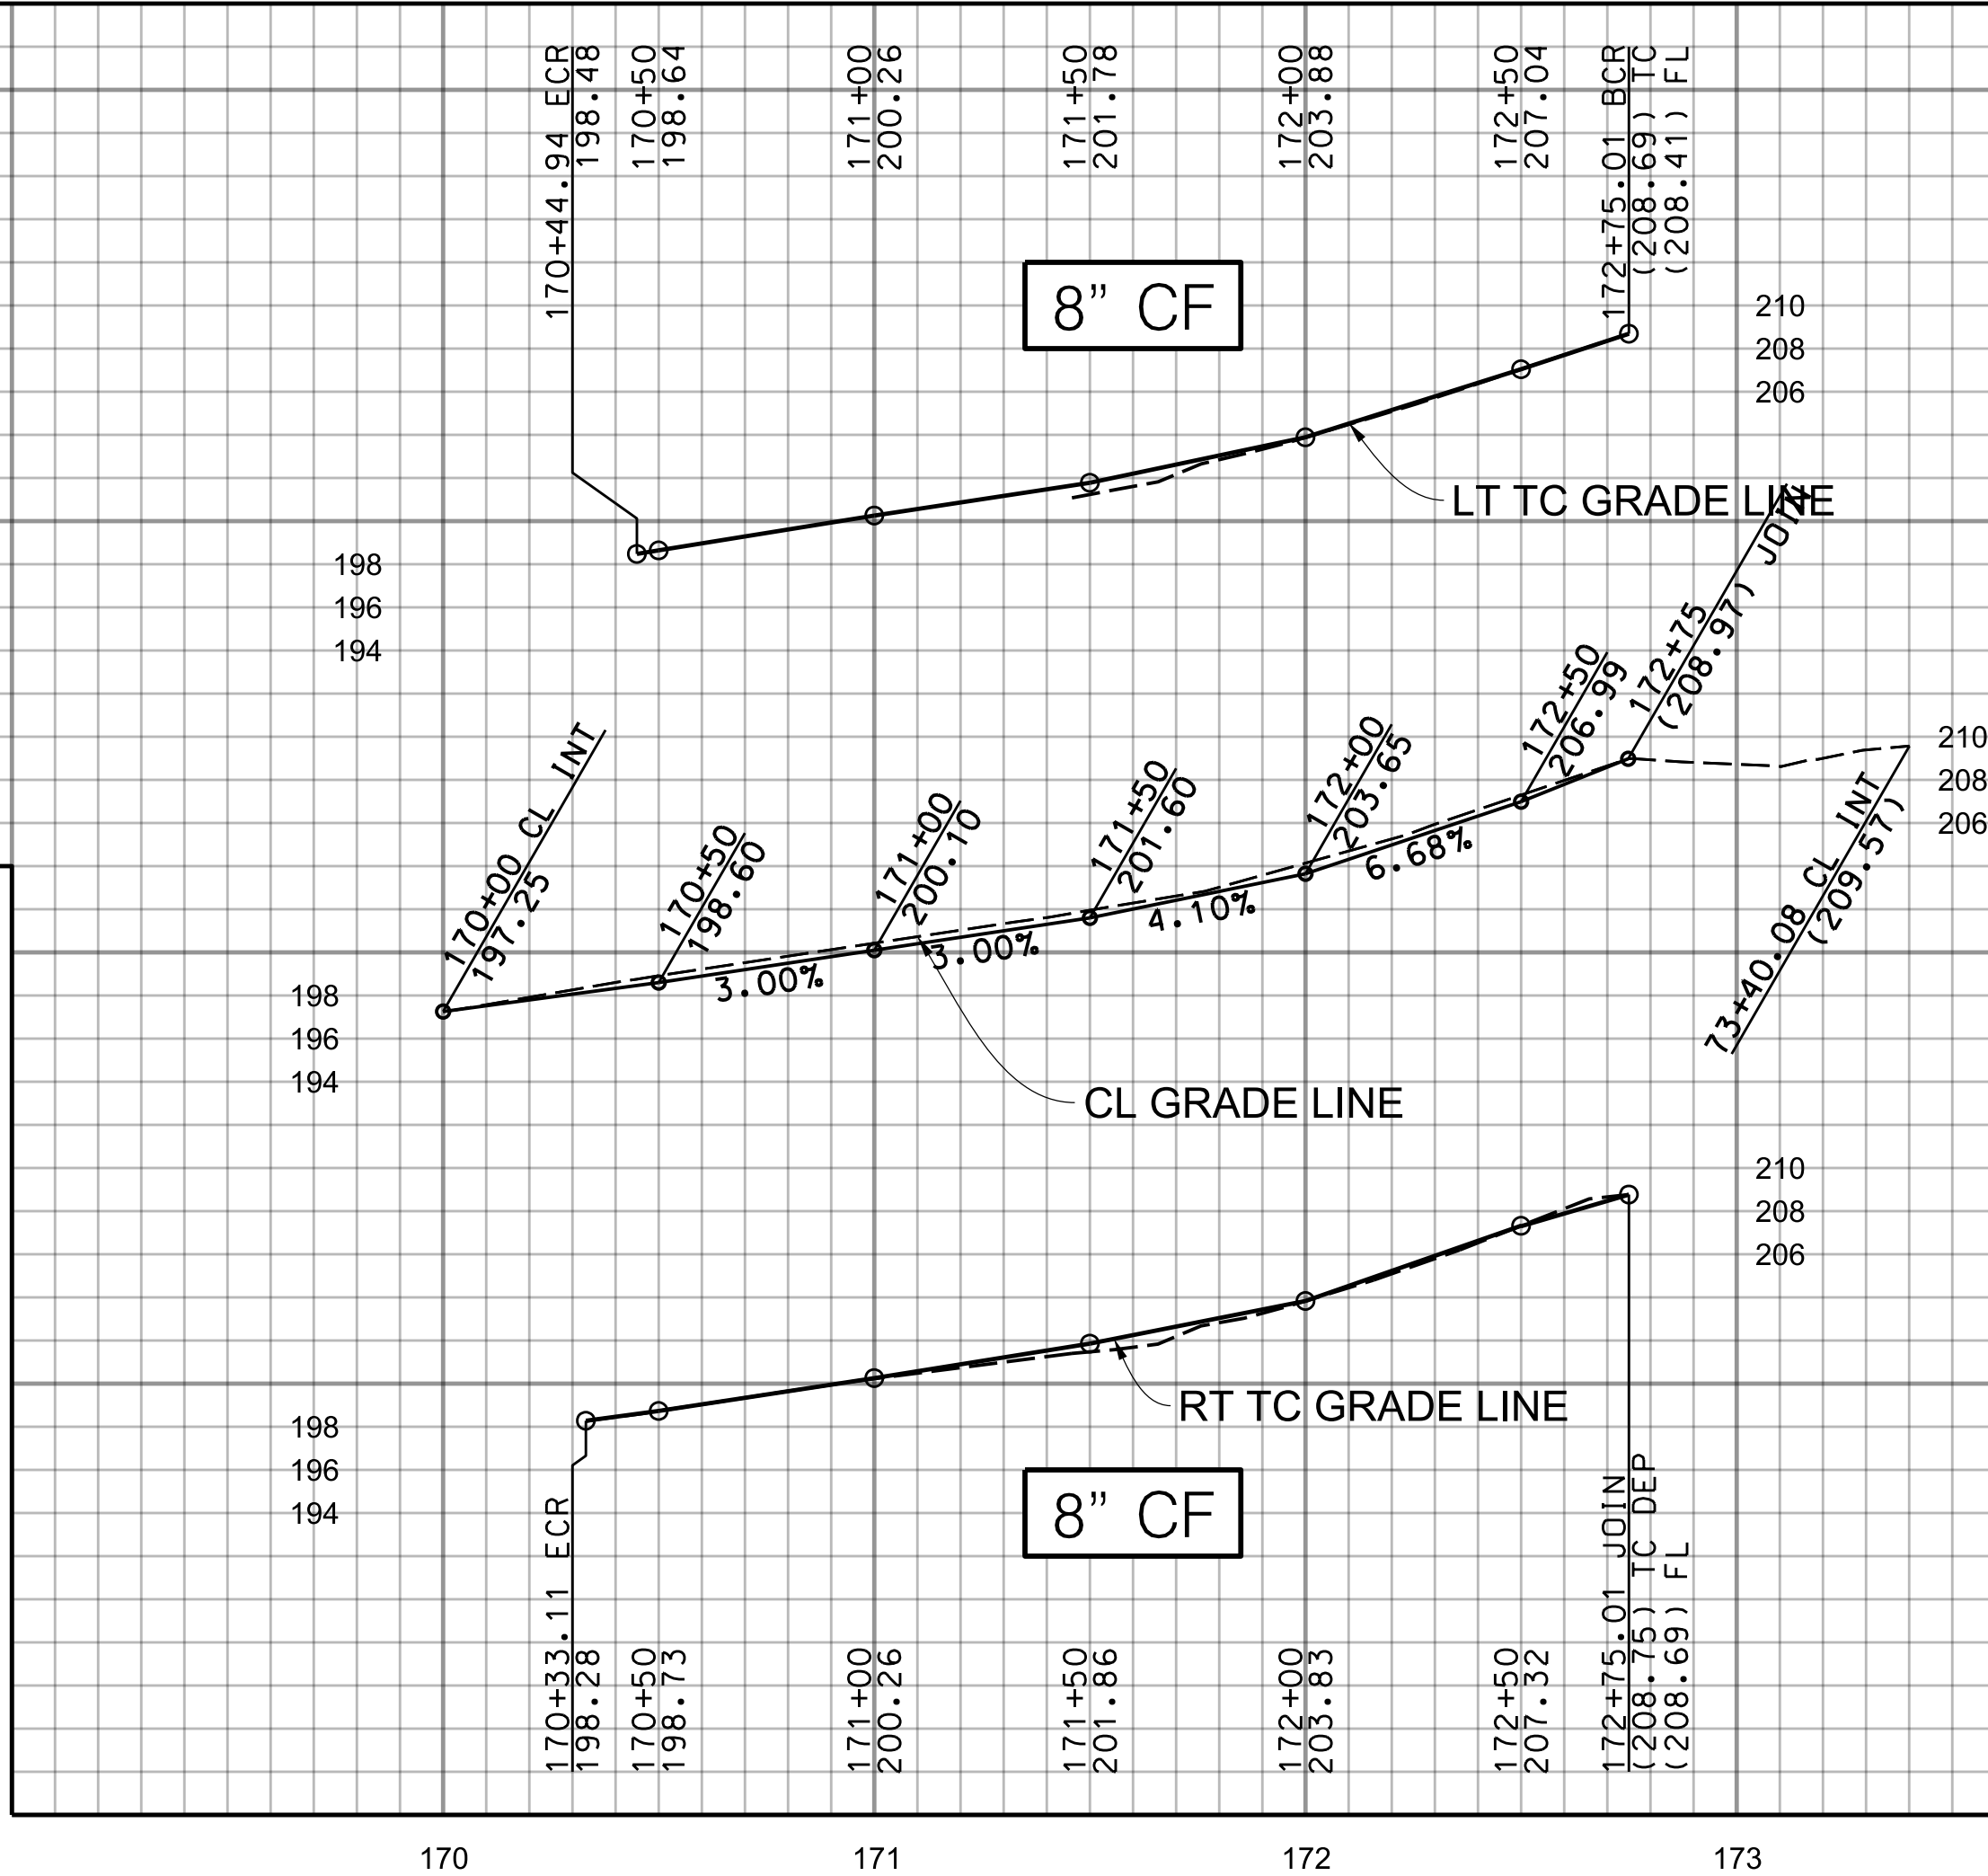

**BENCHMARK**  
PT 605, ELEV 175.09 (WHITTIER & BASELINE QUAD 2005), PWFB 1027, PG 956  
CL INT NOTH. FD OR SET

SEE SHEET 69 FOR PARKWAY IMPROVEMENTS

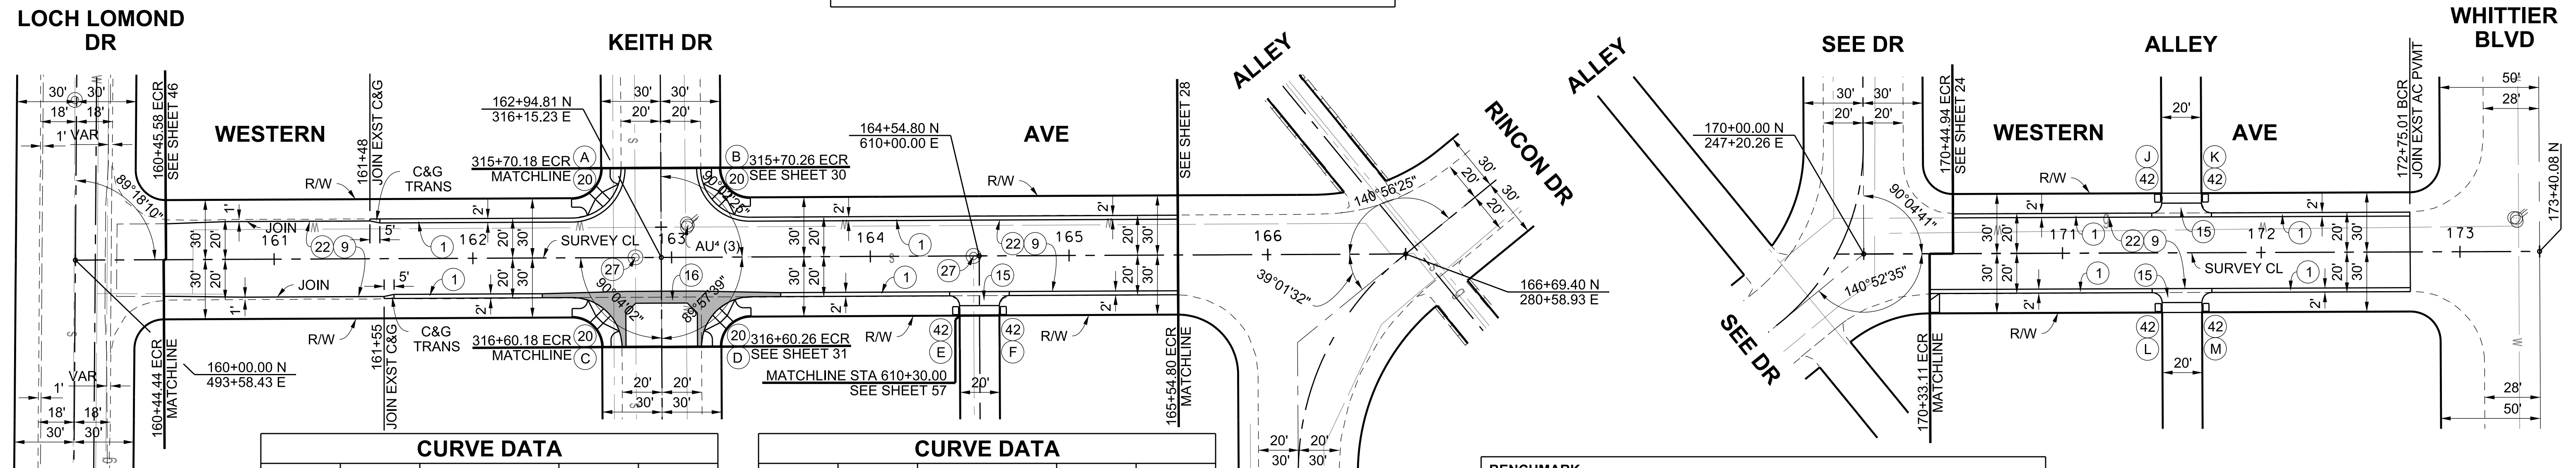


CURVE DATA				
CURVE	RADIUS	CENTRAL ANGLE	LENGTH	TANGENT
(A)	25.00'	90° 04' 06"	39.30'	25.03'
(B)	25.00'	89° 57' 35"	39.25'	24.98'
(C)	25.00'	89° 55' 58"	39.24'	24.97'
(D)	25.00'	90° 02' 21"	39.29'	25.02'
(E)	5.00'	89° 57' 46"	7.85'	5.00'
(F)	5.00'	90° 04' 01"	7.86'	5.01'

CURVE DATA				
CURVE	RADIUS	CENTRAL ANGLE	LENGTH	TANGENT
(G)	37.00'	90° 04' 00"	58.16'	37.04'
(H)	37.00'	89° 56' 00"	58.08'	36.96'
(J)	5.00'	90° 04' 41"	7.86'	5.01'
(K)	5.00'	89° 55' 21"	7.85'	4.99'
(L)	5.00'	89° 55' 19"	7.85'	4.99'
(M)	5.00'	90° 04' 39"	7.86'	5.01'

**BENCHMARK**  
PT 622, ELEV 197.33 (WHITTIER & BASELINE QUAD 2005), PWFB 1027, PG 975  
CL INT SEE DR & ALLEY N/O HADLEY ST FD SPK & W, R1 DN 1"

CADD PROJECT FILE NAME: RMD4408001-PLAN-RD.DGN  
CHECKER: B. FUNG  
DESIGNER: J. GARCIA  
DRAFTER: J. GARCIA

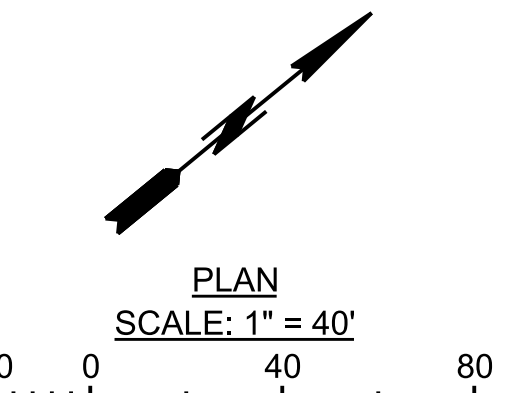

LOS ANGELES COUNTY PUBLIC WORKS  
**SOUTH WHITTIER LOS NIETOS**  
KEITH DRIVE, ET AL.  
PROJECT ID NO. RMD4408001  
PLAN AND PROFILE  
PD PH086537 SHEET 18 OF 79

DATE	MARK	DESCRIPTION
10/25/2021	AS-BUILT	
REVISIONS		

PROJECT ENGINEER: R.S. DATE: 6/24/19