



SCALE: HOR. 1"=40'
VERT. 1"=8'

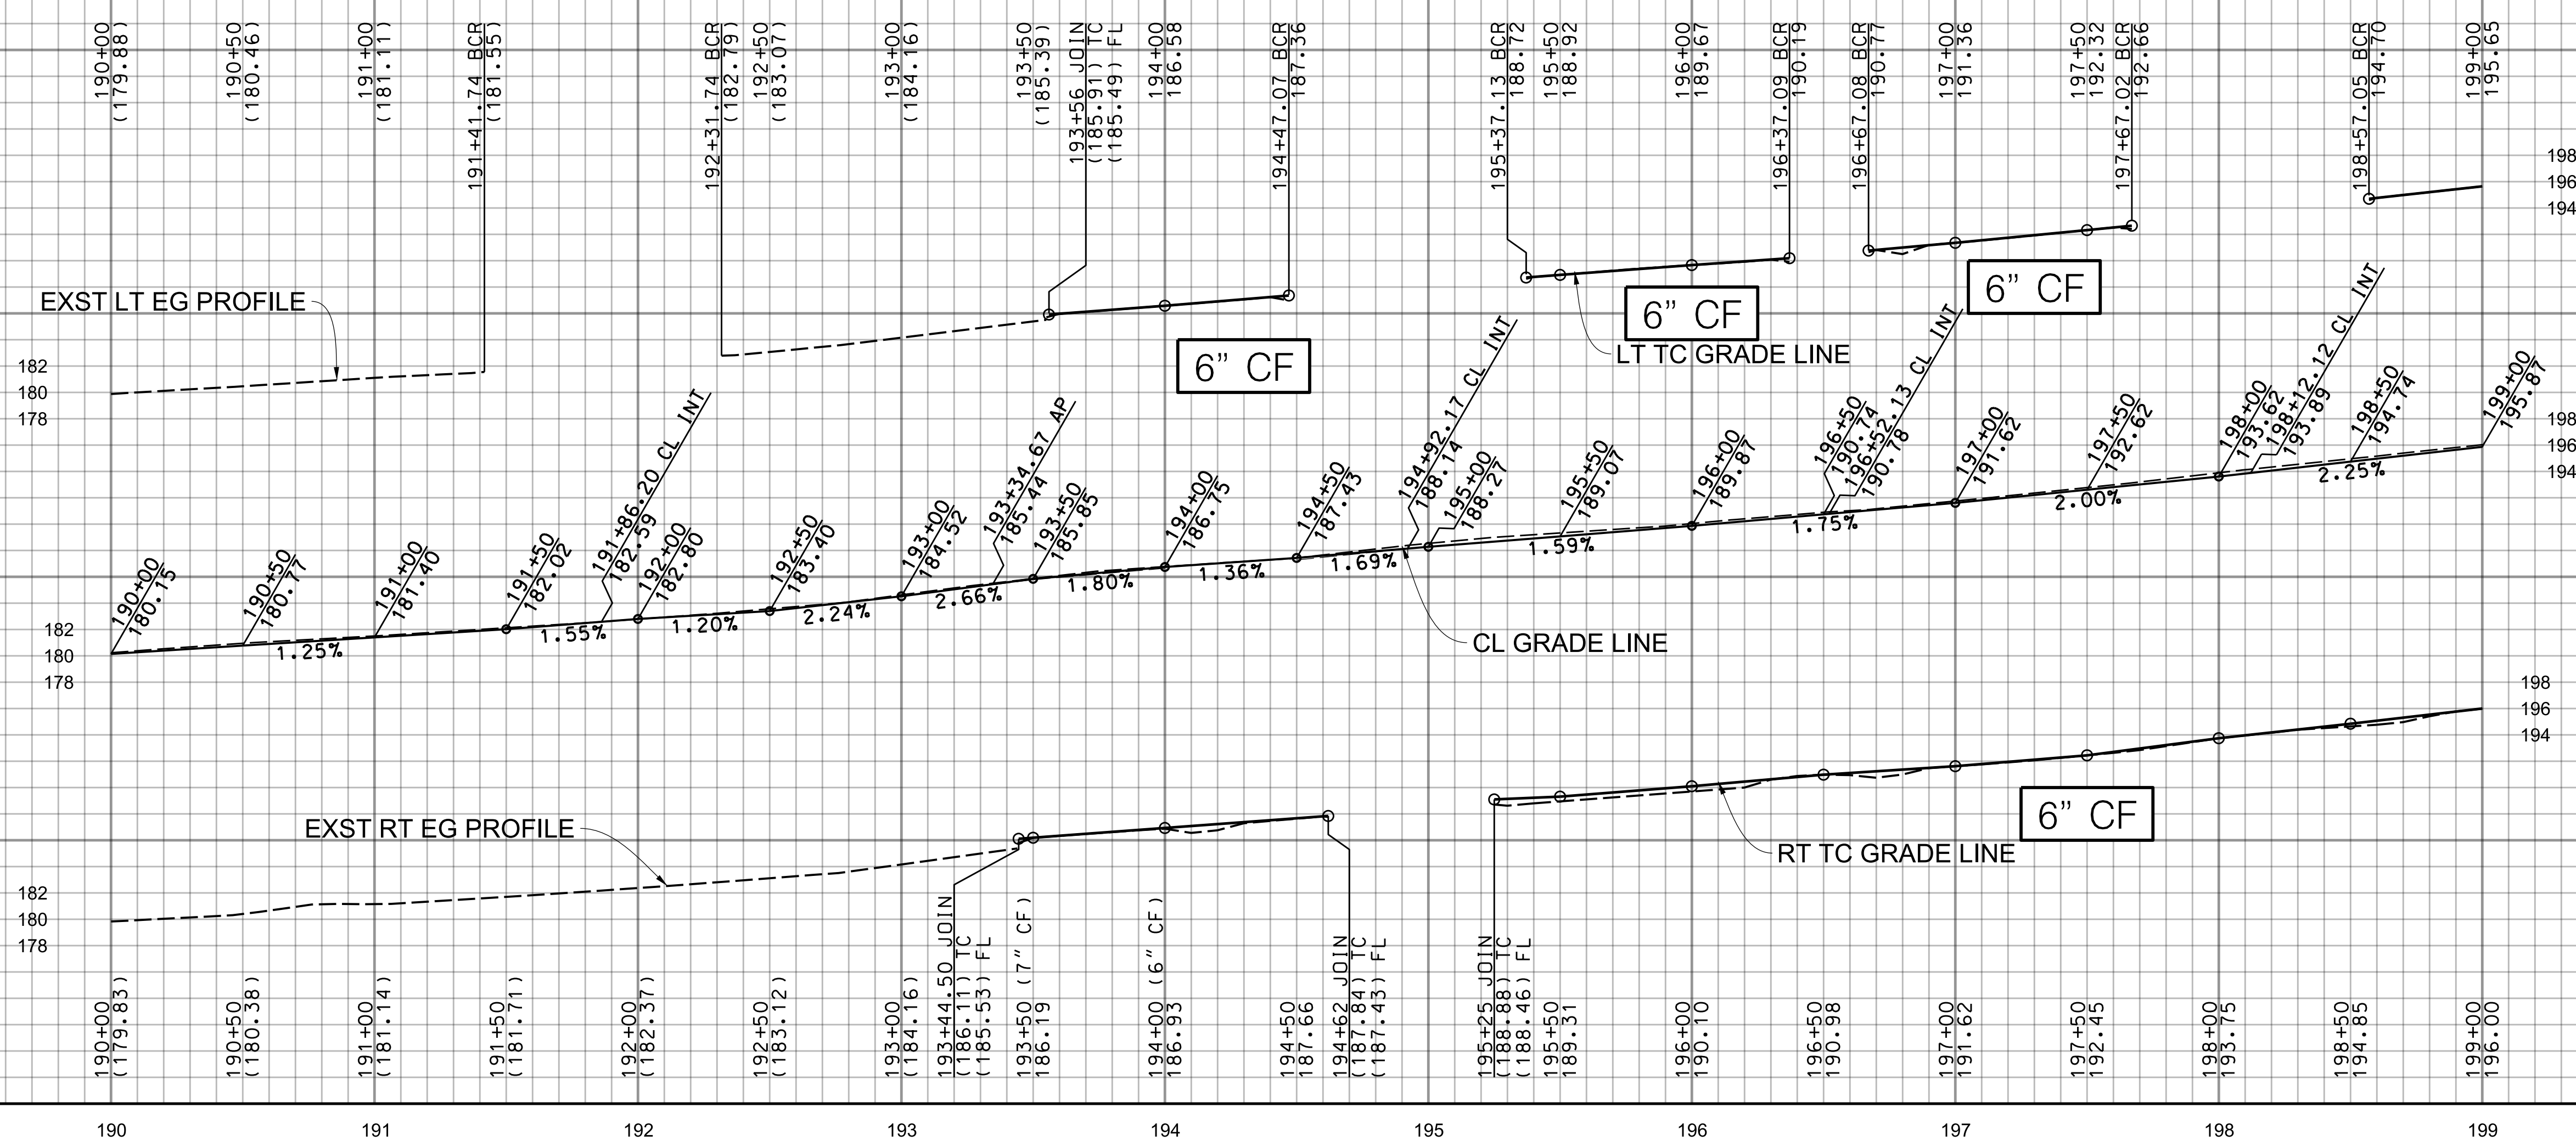

ELEVATIONS			
CURVE	BCR	Δ/2	ECR
(A)	187.36 TC 186.69 FL	187.69 TC 187.11 FL	187.72 TC 187.22 FL
(B)	188.72 TC 188.05 FL	188.53 TC 187.95 FL	188.22 TC 187.72 FL
(E)	192.66 TC 191.99 FL	193.27 TC 192.61 FL	193.38 TC 192.71 FL
(F)	194.70 TC 194.03 FL	194.56 TC 193.89 FL	194.26 TC 193.59 FL

INTERSECTION DATA		
STATION	OFFSET	ELEV
194+74.14	18' LT	187.46
195+10.14	18' LT	188.26
197+94.08	18' LT	193.10
198+30.09	18' LT	193.99

SEE SHEET 70 FOR PARKWAY IMPROVEMENTS

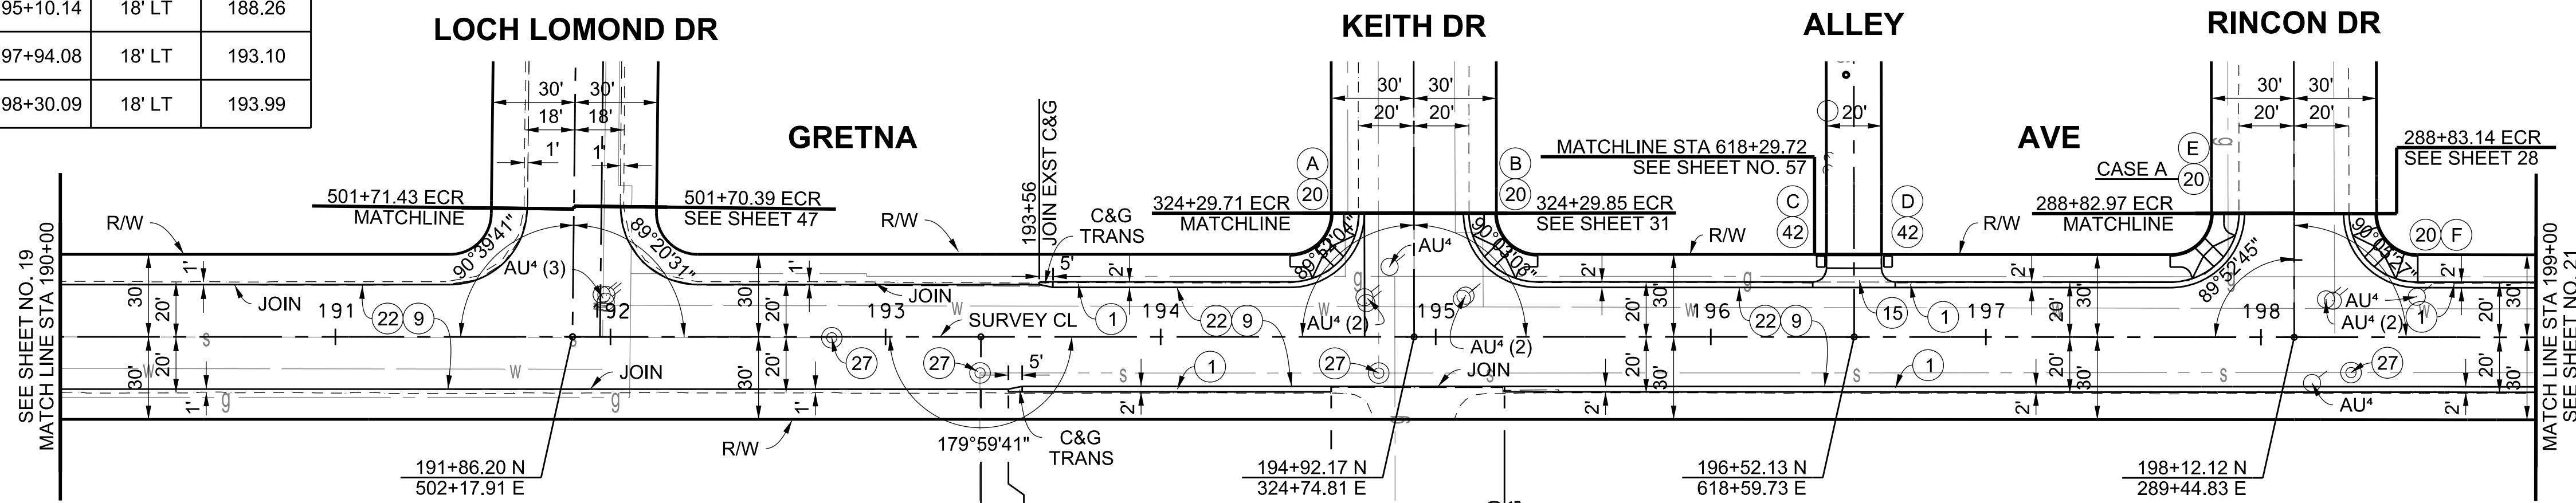

CURVE DATA				
CURVE	RADIUS	CENTRAL ANGLE	LENGTH	TANGENT
(A)	25.00'	90° 5' 30"	39.31'	25.04'
(B)	25.00'	89° 54' 30"	39.23'	24.96'
(C)	5.00'	90° 5' 23"	7.86'	5.01'
(D)	5.00'	89° 52' 57"	7.84'	4.99'
(E)	25.00'	90° 7' 16"	39.32'	25.05'
(F)	25.00'	89° 54' 32"	39.23'	24.96'

BENCHMARK
PT 602, ELEV 182.58 (WHITTIER & BASELINE QUAD 2005), PWFB 1027, PG 955
CL INT. GRETNA AVE & LOCH LOMOND DR FD SQ. HEAD SPK, PER R2, DN 1"

LOS ANGELES COUNTY PUBLIC WORKS
SOUTH WHITTIER LOS NIETOS
KEITH DRIVE, ET AL.
PROJECT ID NO. RMD4408001
PLAN AND PROFILE



PROJECT ENGINEER: R.S. GARCIA
DATE: 6/24/19

DATE	MARK	DESCRIPTION
10/25/2021	AS-BUILT	
REVISIONS		

CAD PROJECT FILE NAME: RMD4408001-PLAN-RD.DGN
 CHECKER: B. FUNG
 DESIGNER: J. GARCIA
 DRAFTER: J. GARCIA

