
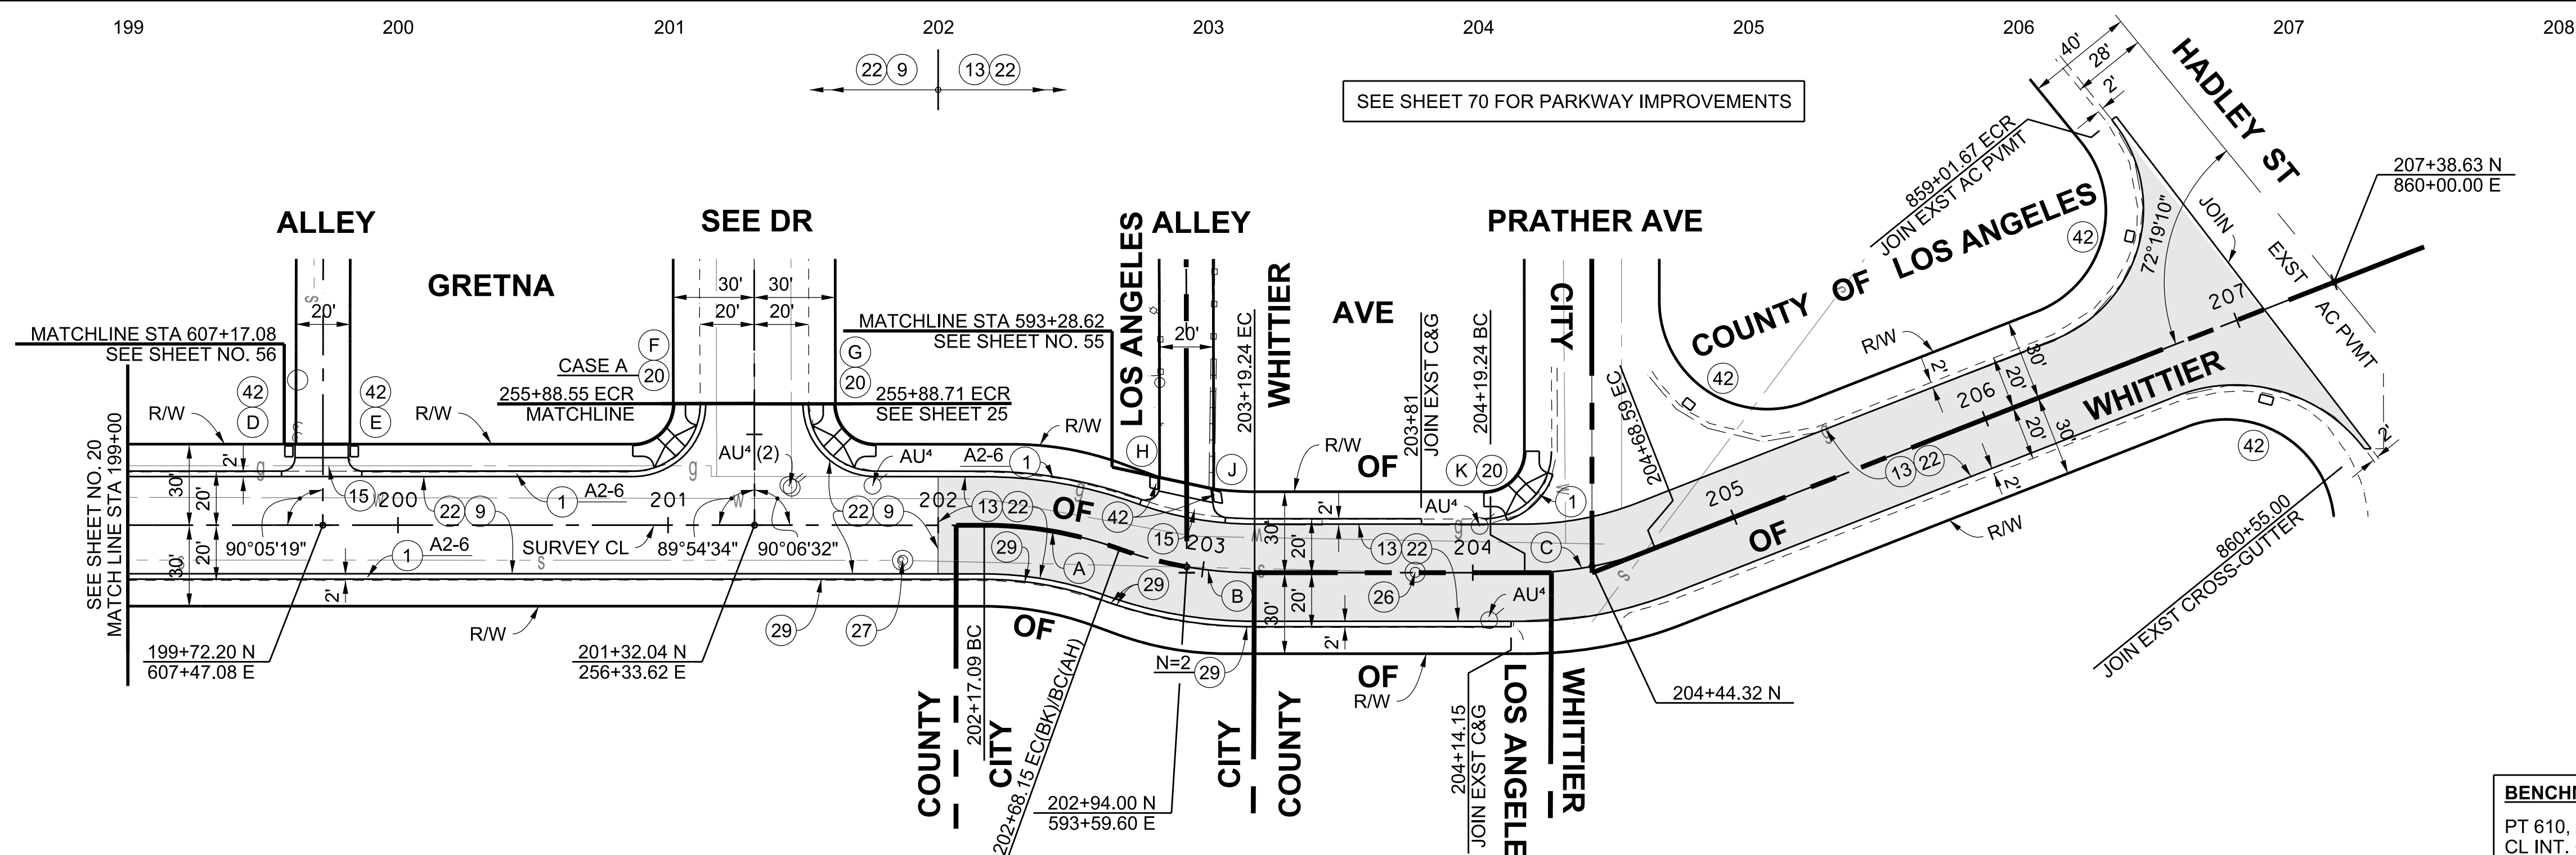


SCALE: HOR. 1"= 40'  
VERT. 1"= 8'

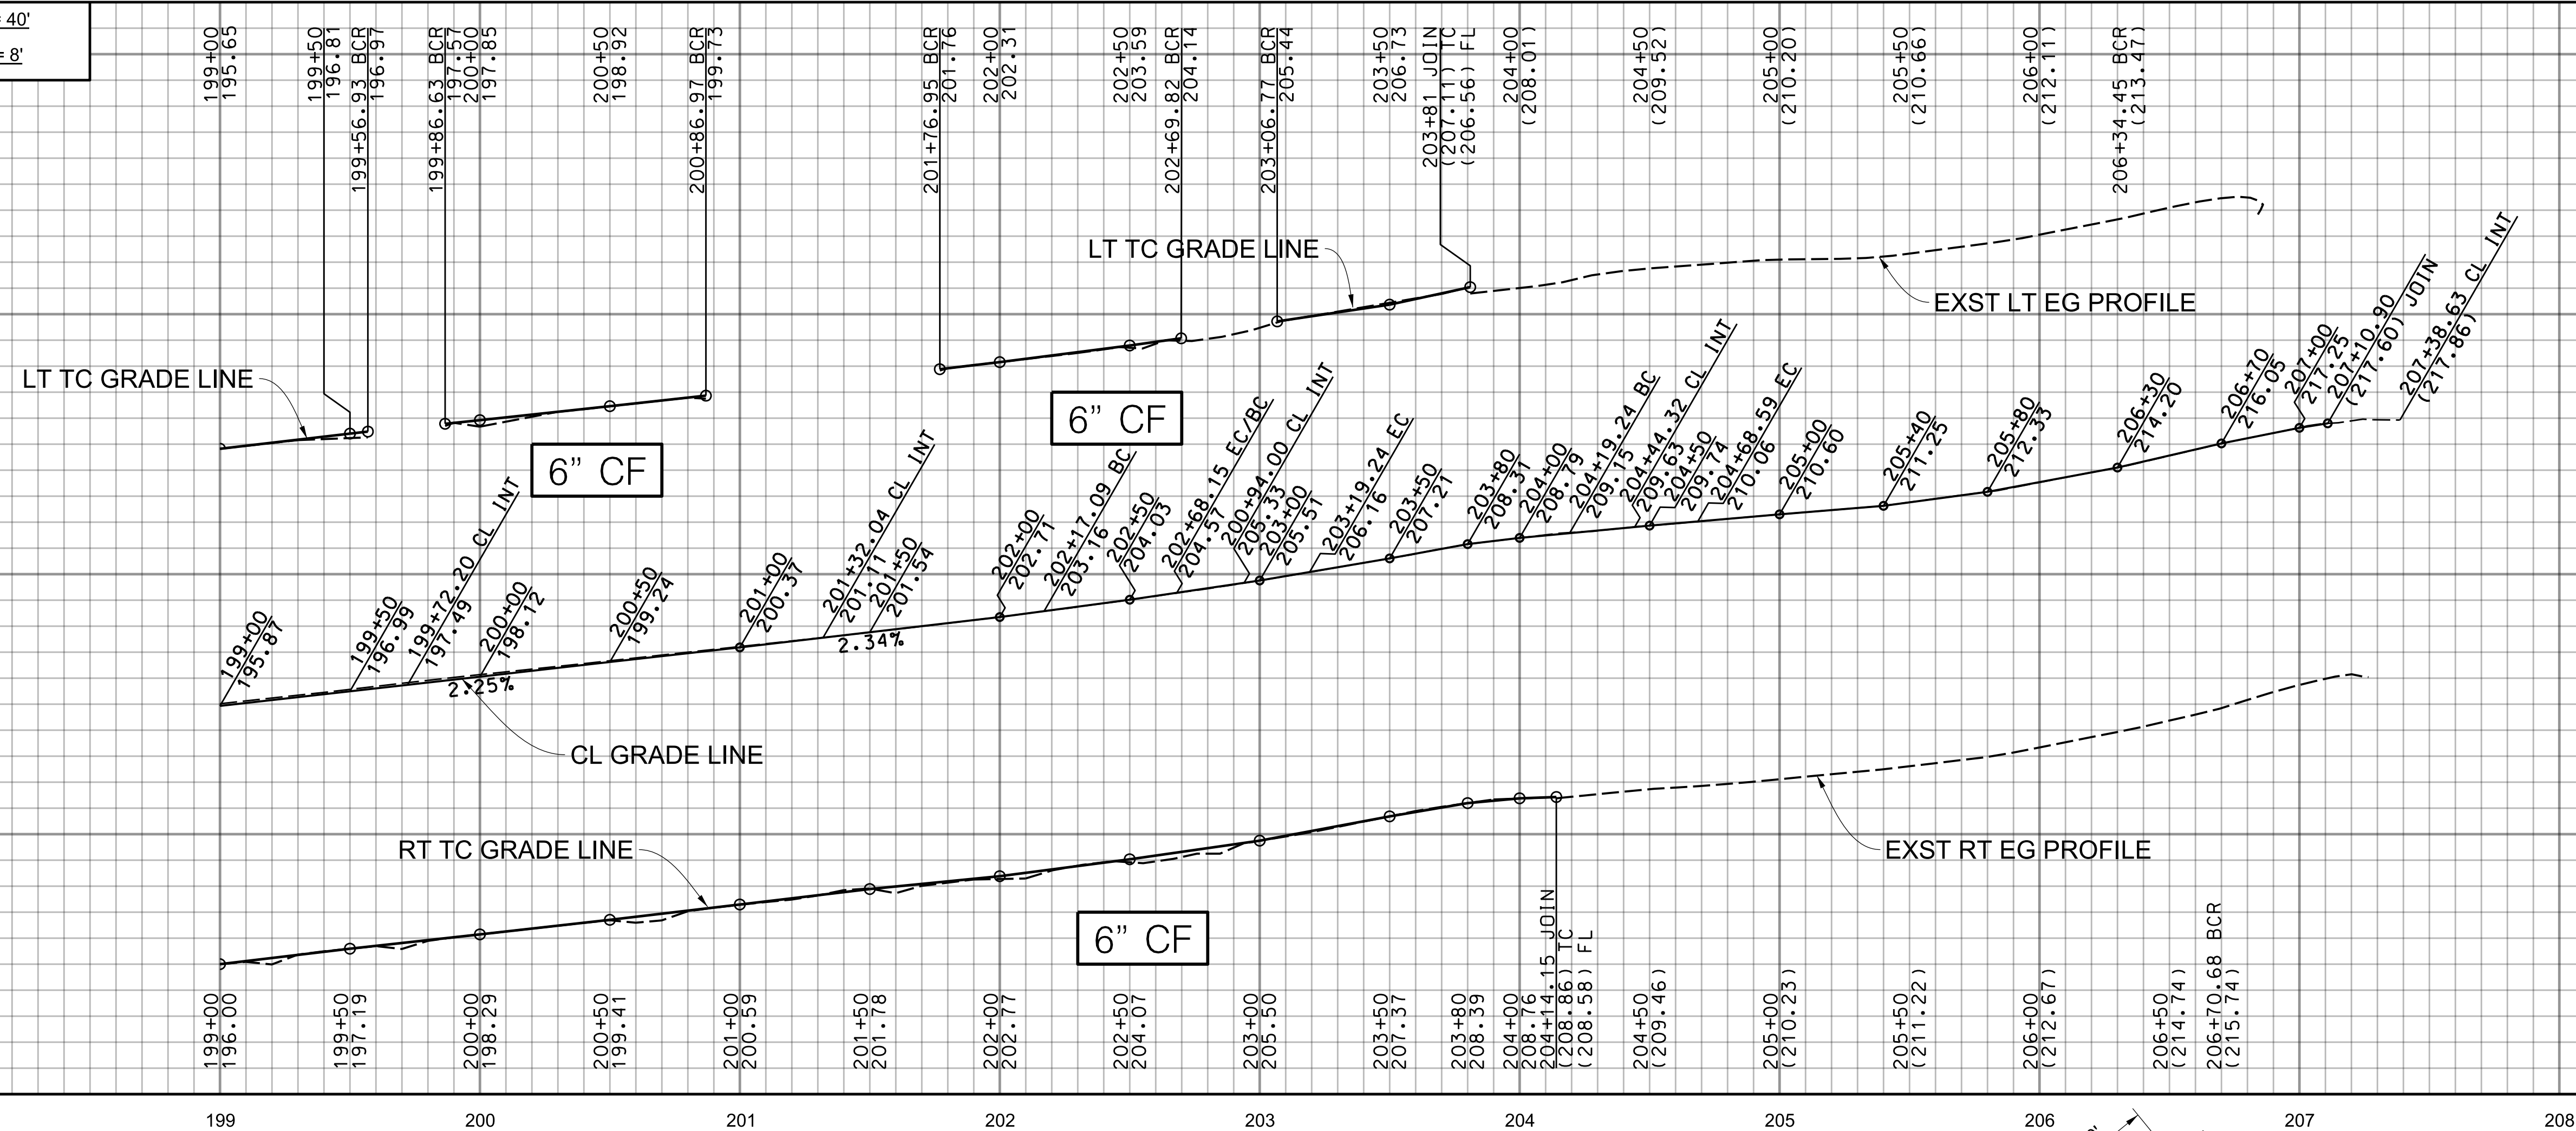

SEE SHEET 70 FOR PARKWAY IMPROVEMENTS

CURVE DATA				
CURVE	RADIUS	CENTRAL ANGLE	LENGTH	TANGENT
(A)	147.23'	19° 52' 22"	51.07'	25.79'
(B)	147.23'	19° 52' 47"	51.08'	25.80'
(C)	132.10'	21° 24' 18"	49.35'	24.97'
(D)	5.00'	89° 54' 41"	7.85'	4.99'
(E)	5.00'	90° 04' 46"	7.86'	5.01'
(F)	25.00'	90° 05' 26"	39.31'	25.04'
(G)	25.00'	89° 53' 28"	39.22'	24.95'
(H)	5.00'	108° 52' 59"	9.50'	6.99'
(J)	5.00'	76° 50' 09"	6.71'	3.97'
(K)	25.00'	90° 04' 33"	39.30'	25.03'
(L)	50.00'	111° 19' 13"	97.15'	73.19'

ELEVATIONS			
CURVE	BCR	Δ/2	ECR
(F)	199.73 TC 199.06 FL	200.25 TC 199.67 FL	200.37 TC 199.87 FL
(G)	201.76 TC 201.09 FL	201.40 TC 200.81 FL	200.74 TC 200.24 FL

INTERSECTION DATA		
STATION	OFFSET	ELEV
201+14.01	18' LT	200.08
201+50.00	18' LT	201.06

**BENCHMARK**  
PT 610, ELEV 197.65 (WHITTIER & BASELINE QUAD 2005), PWFB 1027, PG 969  
CL INT. GREYNA AVE & ALLEY S/O SEE DR FD SPK & W PER R1, FL

LOS ANGELES COUNTY PUBLIC WORKS  
**SOUTH WHITTIER LOS NIETOS**  
KEITH DRIVE, ET AL.  
PROJECT ID NO. RMD4408001  
PLAN AND PROFILE  
PD PH086540 SHEET 21 OF 79



PROJECT ENGINEER: R.S. 6/24/19

DATE	MARK	DESCRIPTION
10/25/2021	AS-BUILT	
REVISIONS		

CADD PROJECT FILE NAME: RMD4408001-PLAN-RD.DGN  
CHECKER: B. FUNG  
DESIGNER: J. GARCIA  
DRAFTER: J. GARCIA

