



SCALE: HOR. 1"=40'
VERT. 1"=8'

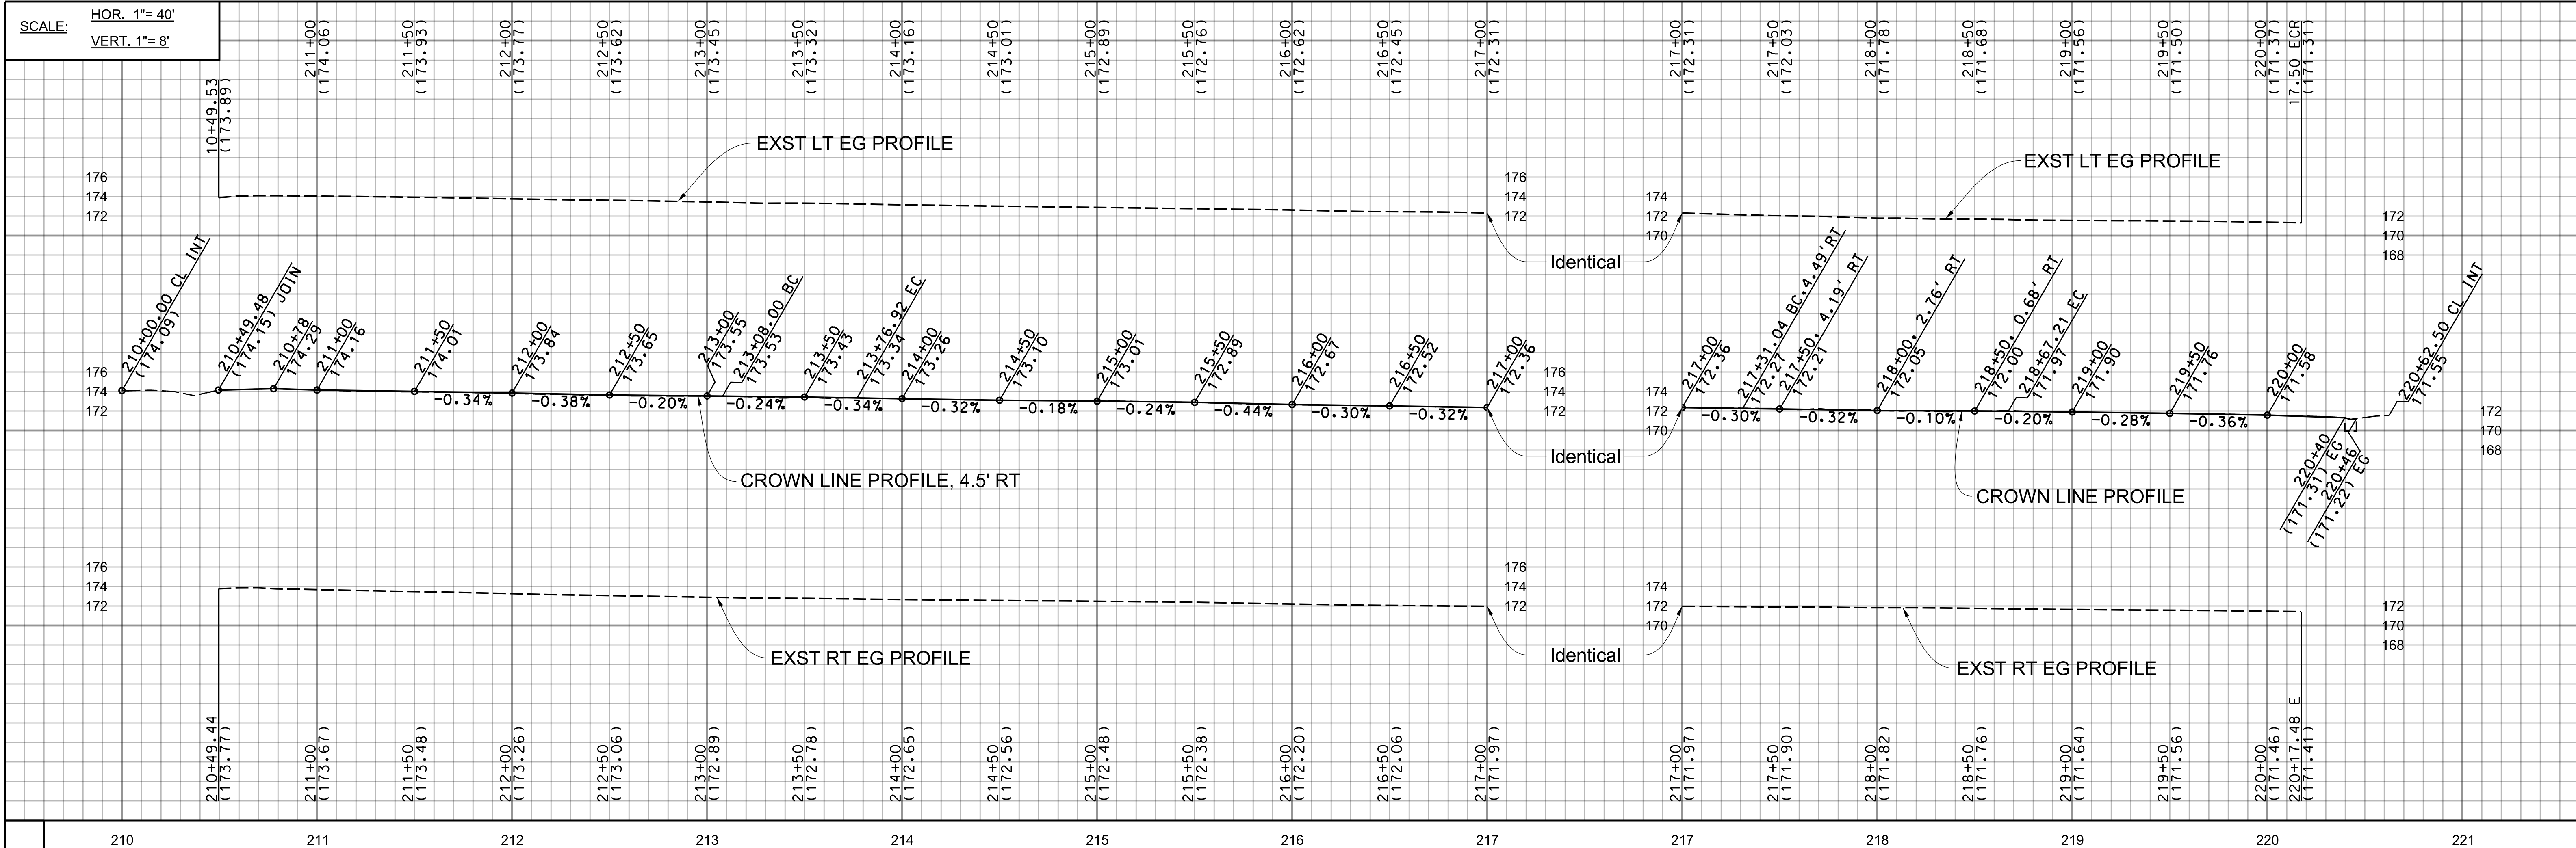

NORWALK BLVD

SEE SHEET 70 FOR PARKWAY IMPROVEMENTS

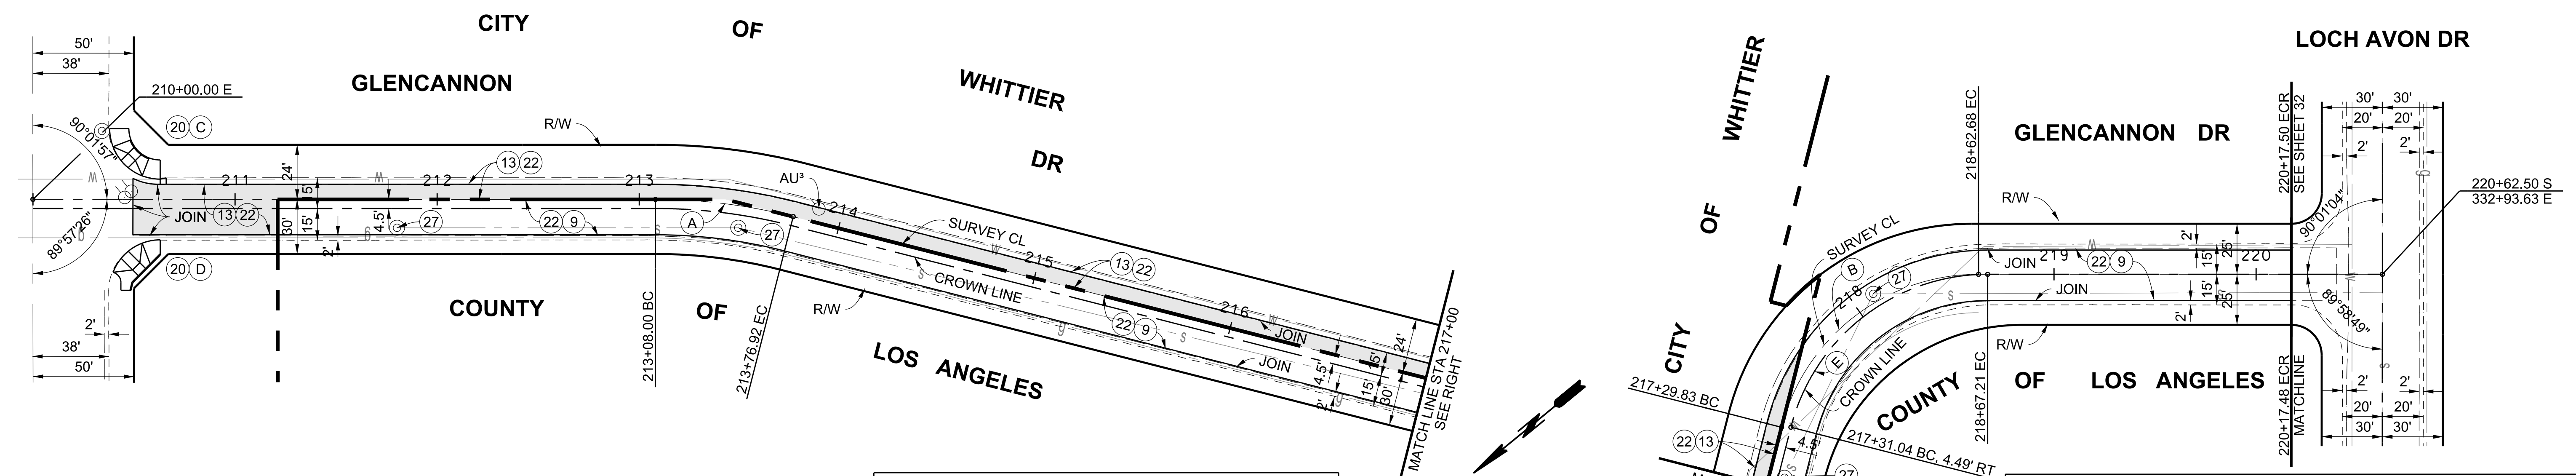

| CURVE DATA | | | | |
|------------|---------|---------------|---------|---------|
| CURVE | RADIUS | CENTRAL ANGLE | LENGTH | TANGENT |
| (A) | 276.08' | 14° 18' 14" | 68.92' | 34.64' |
| (B) | 100.58' | 75° 41' 00" | 132.85' | 78.13' |
| (C) | 25.00' | 89° 58' 03" | 39.26' | 24.99' |
| (D) | 25.00' | 90° 02' 34" | 39.29' | 25.02' |
| (E) | 100.50' | 75° 40' 56" | 132.75' | 78.07' |

| ELEVATIONS | | | |
|------------|-----------|-----------|-----------|
| CURVE | BCR | Δ/2 | ECR |
| (C) | 174.70 TC | 174.43 TC | 174.39 TC |
| | 174.03 FL | 173.77 FL | 173.72 FL |
| (D) | 174.51 TC | 174.18 TC | 173.97 TC |
| | 173.84 FL | 173.50 FL | 173.30 FL |

BENCHMARK
PI, PT 119, ELEV 173.38 (WHITTIER & BASELINE QUAD 2005), PWFB 1026, PG 2119
FD BT S&DPW W DN 1", PER R1

LOS ANGELES COUNTY PUBLIC WORKS
SOUTH WHITTIER LOS NIETOS
KEITH DRIVE, ET AL.
PROJECT ID NO. RMD4408001
PLAN AND PROFILE

CADD PROJECT FILE NAME: RMD4408001-PLAN-RD.DGN
CHECKER: B. FUNG
DESIGNER: J. GARCIA
DRAFTER: J. GARCIA



| DATE | MARK | DESCRIPTION |
|------------|----------|-------------|
| 10/25/2021 | AS-BUILT | |
| REVISIONS | | |

PROJECT ENGINEER: R.S. DATE: 6/24/19

PD PH086541 SHEET 22 OF 79