


SCALE: HOR. 1"=40'
VERT. 1"=8'


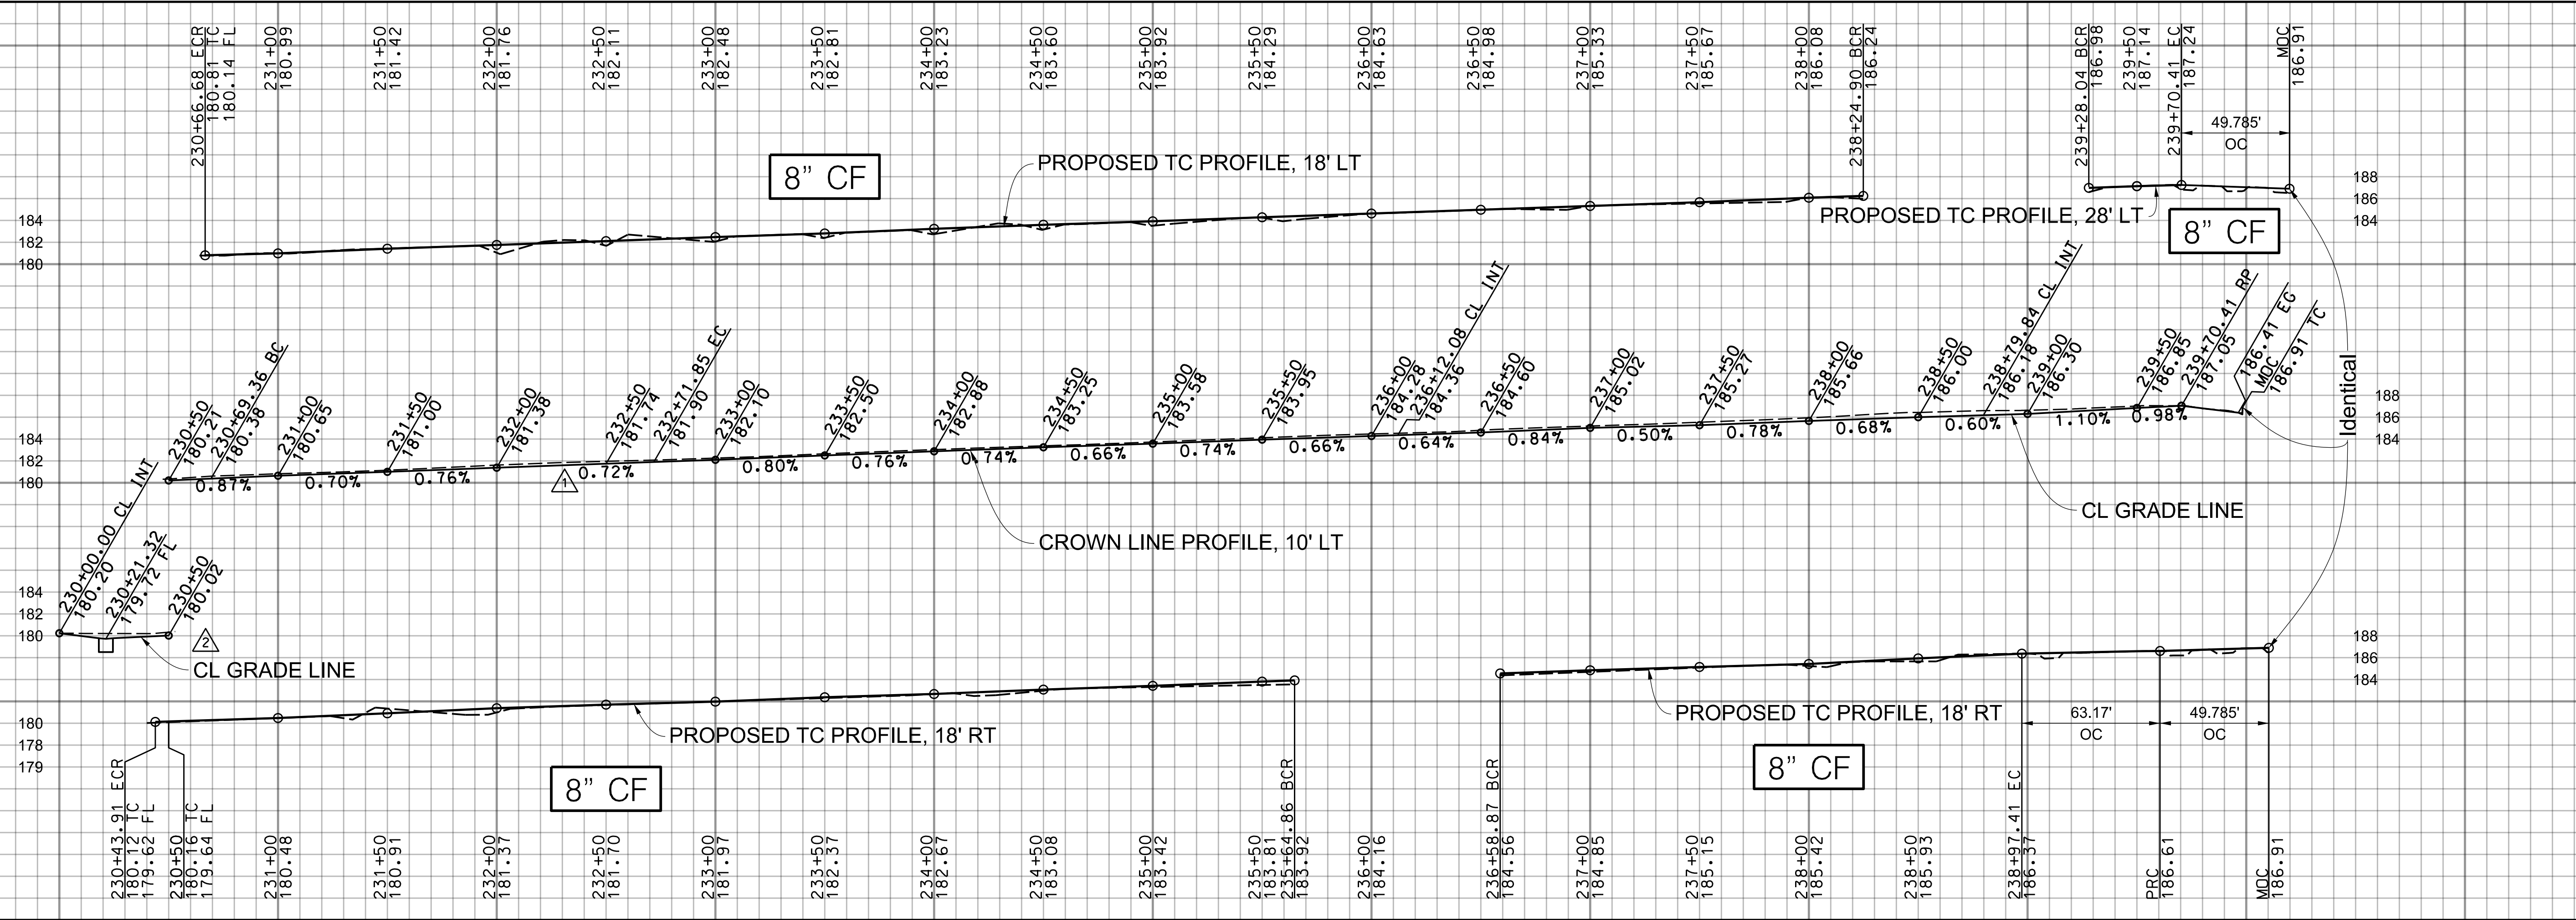


SEE SHEET 70 FOR PARKWAY IMPROVEMENTS

ELEVATIONS			
CURVE	BCR	Δ/2	ECR
(B)	183.92 TC	184.19 TC	183.75 TC
	183.25 FL	183.52 FL	183.08 FL
(C)	184.56 TC	184.46 TC	184.16 TC
	183.89 FL	183.79 FL	183.49 FL
(D)	186.24 TC	186.78 TC	187.08 TC
	185.57 FL	186.11 FL	186.41 FL
(E)	186.98 TC	187.16 TC	187.21 TC
	186.31 FL	186.50 FL	186.54 FL

INTERSECTION DATA		
STATION	OFFSET	ELEV
235+94.00	16' RT	184.09
236+30.00	16' RT	184.42
238+63.86	16' LT	186.32
238+93.09	26' LT	186.58


CURVE DATA				
CURVE	RADIUS	CENTRAL ANGLE	LENGTH	TANGENT
(A)	580.06'	20° 00' 03"	202.49'	102.28'
(B)	27.00'	90° 16' 29"	42.54'	27.13'
(C)	27.00'	89° 43' 35"	42.28'	26.87'
(D)	37.00'	89° 56' 09"	58.08'	36.96'
(E)	37.00'	83° 44' 39"	54.08'	33.17'
(F)	120.35'	30° 04' 24"	63.17'	32.33'
(G)	28.00'	203° 45' 11"	99.57'	-

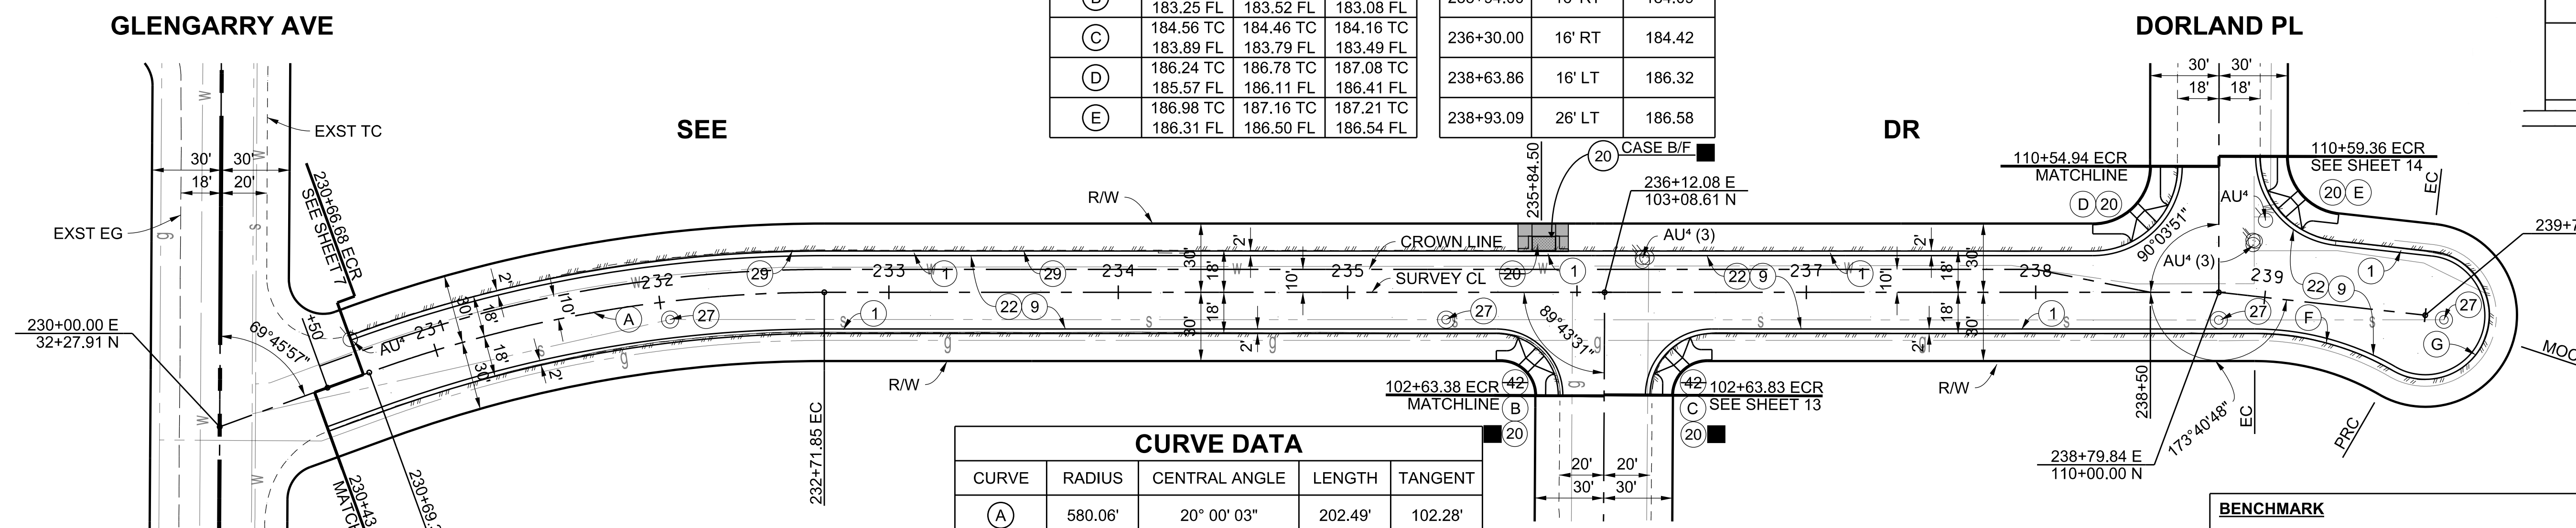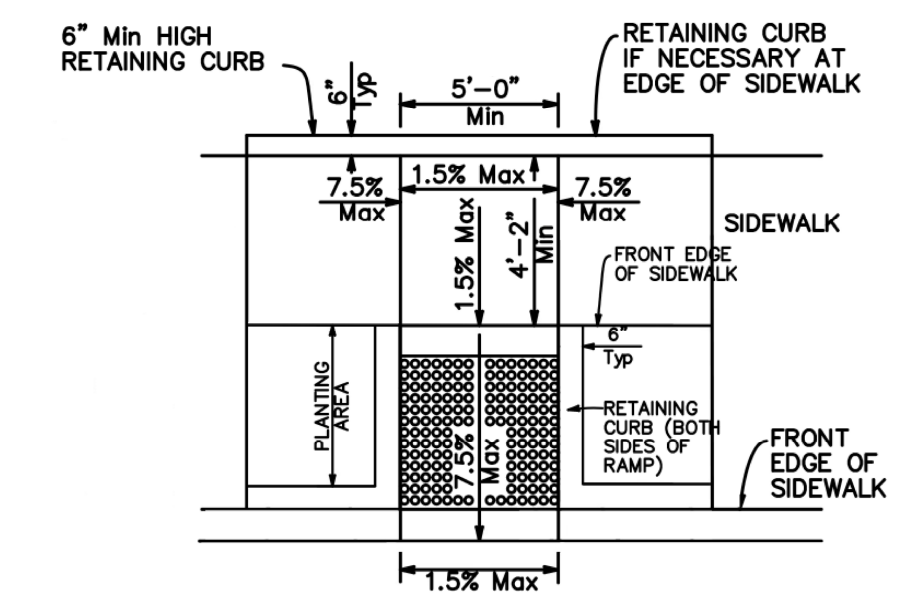

BENCHMARK
PT 23, ELEV 186.41 (WHITTIER & BASELINE QUAD 2005), PWFB 1027, PG 951
CL INT SEE DR & DORLAND PL FD SHANK DN 3" NO REF

LOS ANGELES COUNTY PUBLIC WORKS
SOUTH WHITTIER LOS NIETOS
KEITH DRIVE, ET AL.
PROJECT ID NO. RMD4408001
PLAN AND PROFILE

DATE	MARK	DESCRIPTION
10/25/2021	■	AS-BUILT
9/22/20	△	ADDED PROPOSED PROFILE
9/22/20	①	REVISED PROPOSED PROFILE

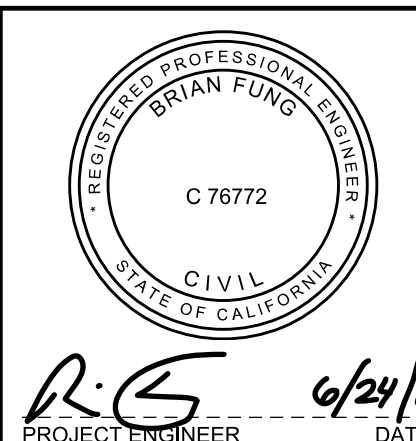

PROJECT ENGINEER: *R.S.* DATE: 6/24/19

CADD PROJECT FILE NAME: RMD4408001-PLAN-RD.DGN
CHECKER: B. FUNG
DESIGNER: J. GARCIA
DRAFTER: J. GARCIA