



SCALE: HOR. 1"= 40'
VERT. 1"= 8'

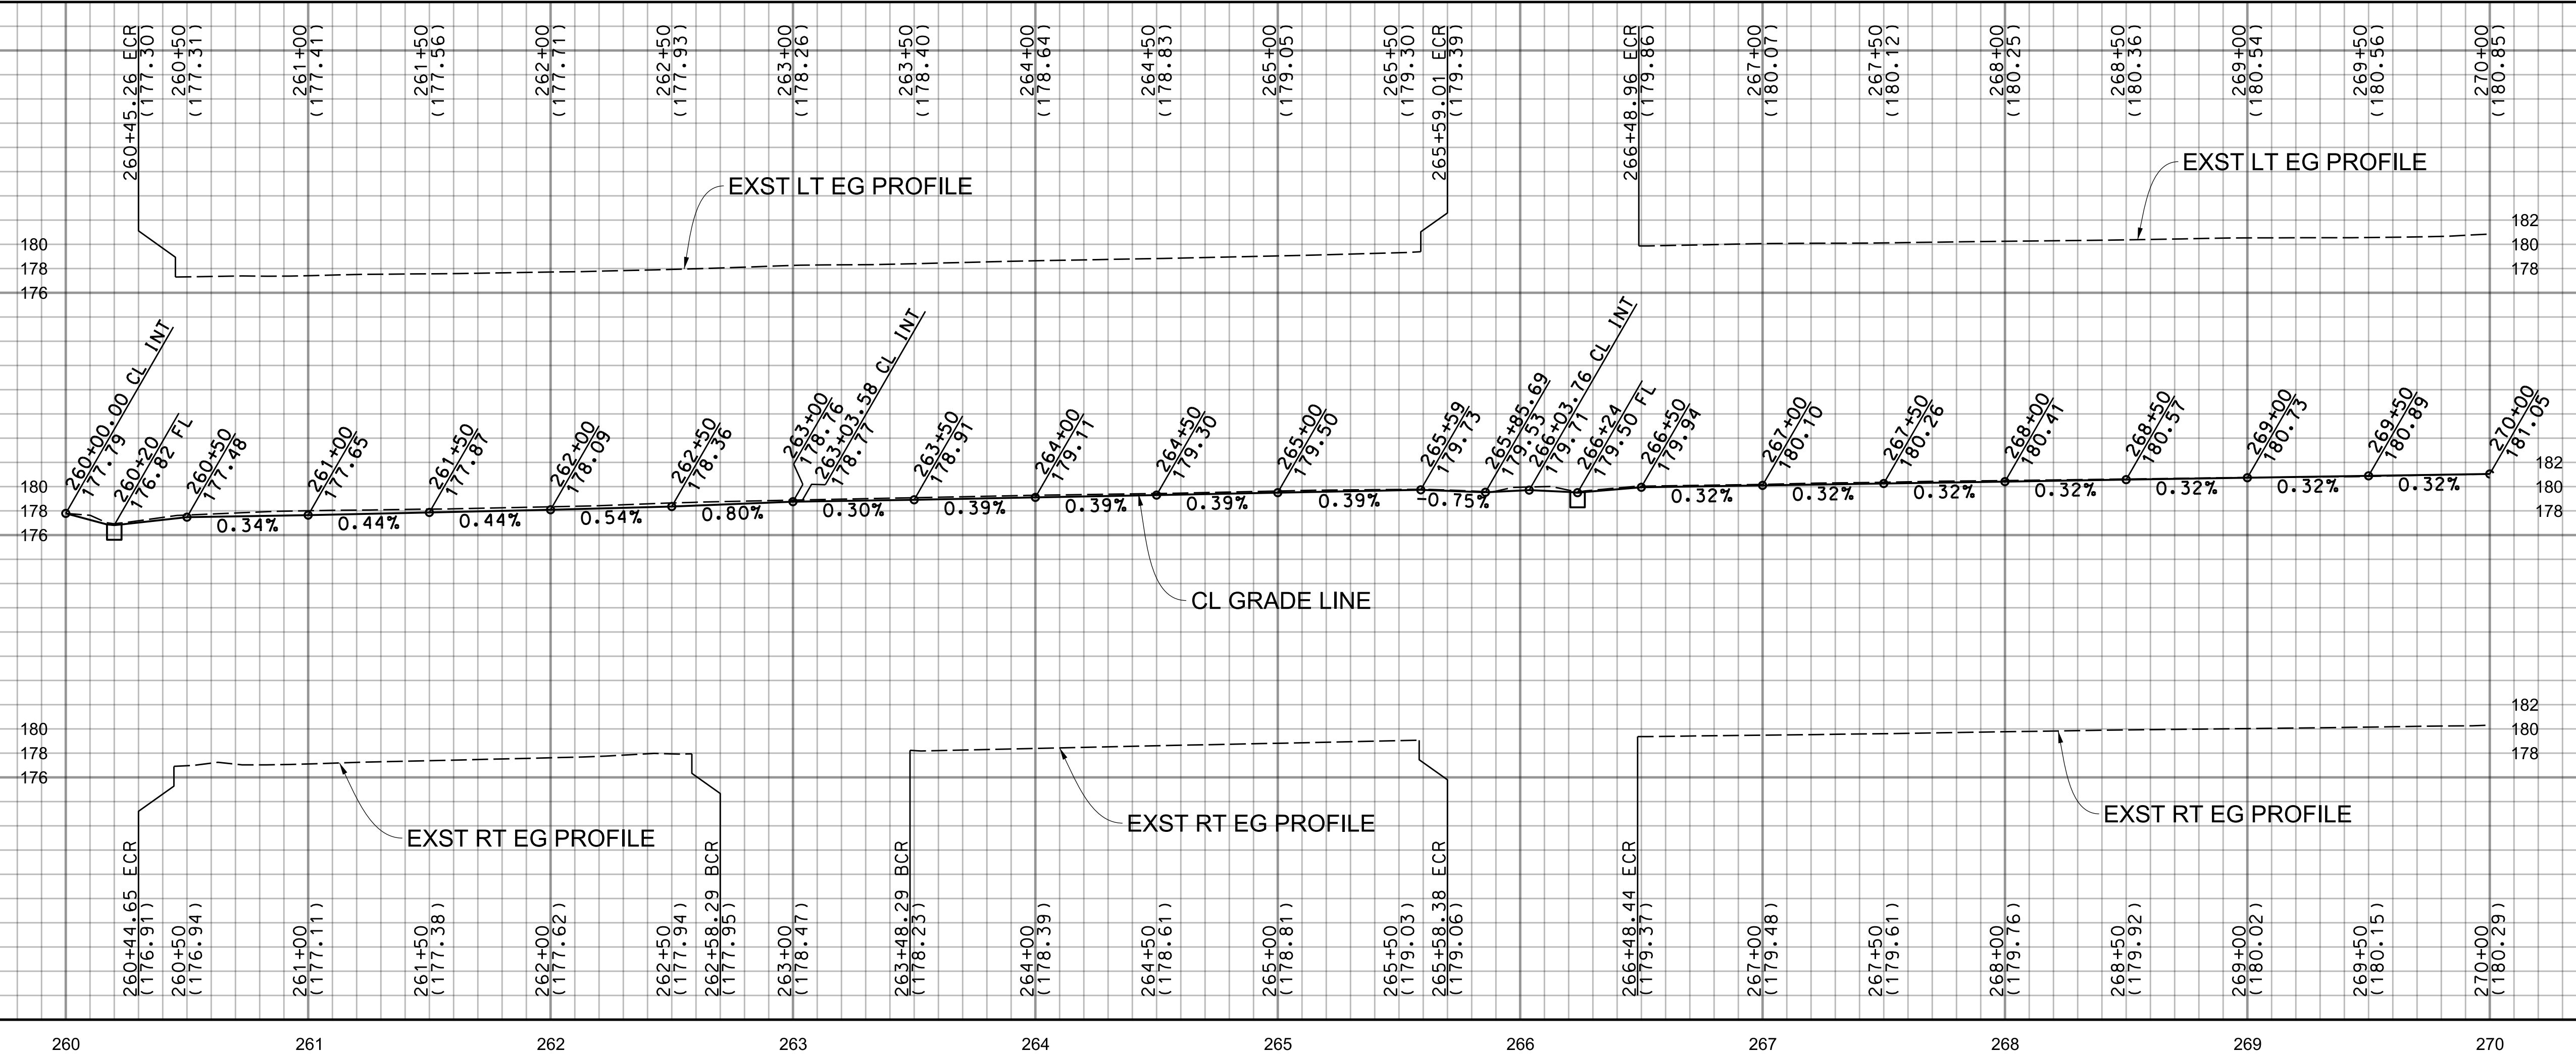

GLENGARRY AVE

DUCHESS DR

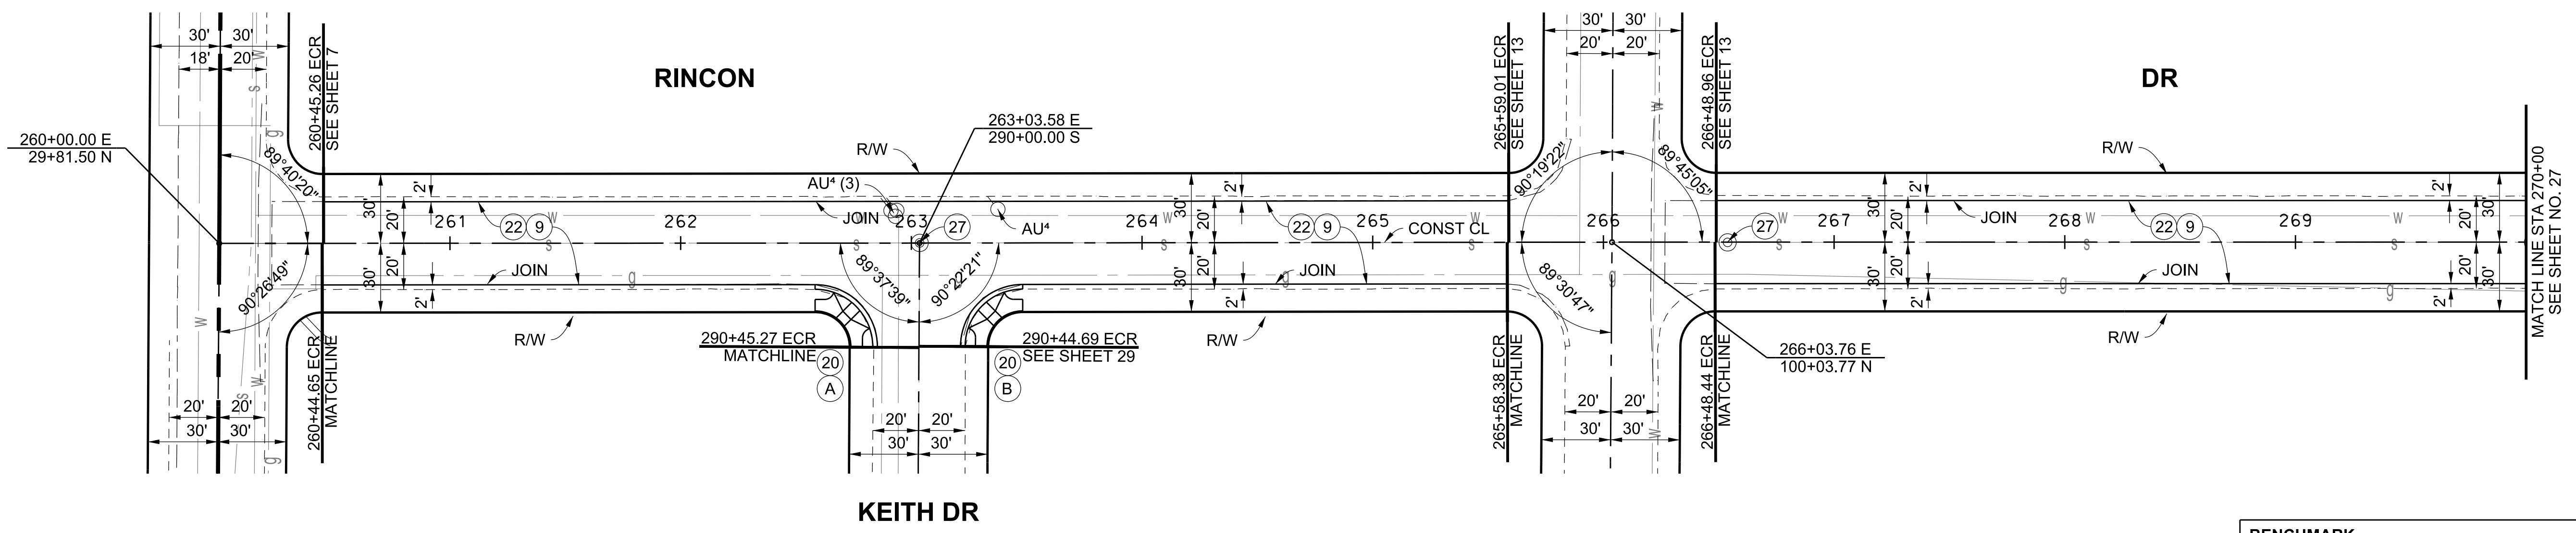

SEE SHEET 71 FOR PARKWAY IMPROVEMENTS

BENCHMARK
PT 24, ELEV 179.98 (WHITTIER & BASELINE QUAD 2005), PWFB 1026, PG 2164
CL INT. RINCON DR & DUCHESS DR FD R.D. SPK & W. PER R3, DN 2"

LOS ANGELES COUNTY PUBLIC WORKS

SOUTH WHITTIER LOS NIETOS
KEITH DRIVE, ET AL.


PROJECT ID NO. RMD4408001
PLAN AND PROFILE

ELEVATIONS			
CURVE	BCR	Δ/2	ECR
(A)	178.43 TC 177.76 FL	178.27 TC 177.60 FL	177.93 TC 177.26 FL
(B)	178.64 TC 177.97 FL	178.50 TC 177.83 FL	178.35 TC 177.68 FL

INTERSECTION DATA		
STATION	OFFSET	ELEV
262+85.47	18' RT	178.23
263+21.46	18' RT	178.47

CURVE DATA				
CURVE	RADIUS	CENTRAL ANGLE	LENGTH	TANGENT
(A)	25.00'	90° 20' 57"	39.42'	25.15'
(B)	25.00'	89° 36' 14"	39.10'	24.83'

DATE	MARK	DESCRIPTION
10/25/2021	AS-BUILT	
REVISIONS		

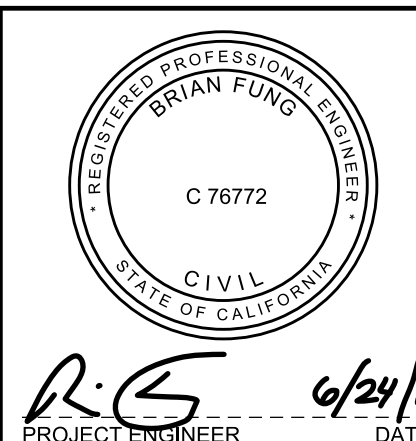

PROJECT ENGINEER: R.S. 6/24/19