

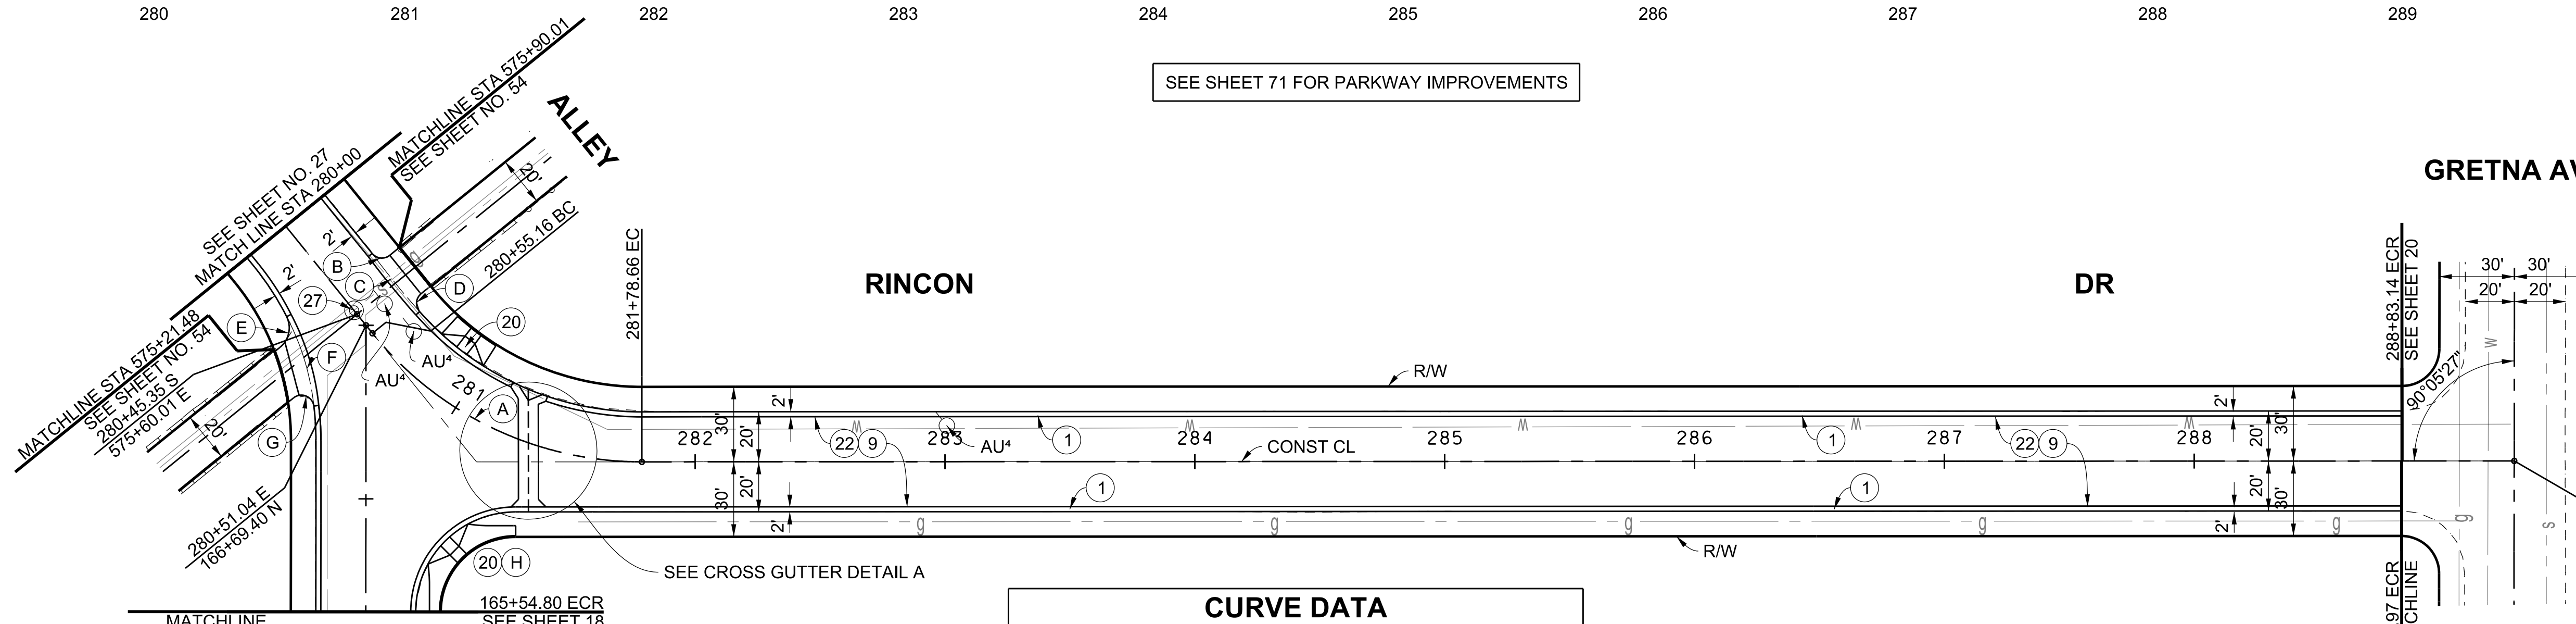
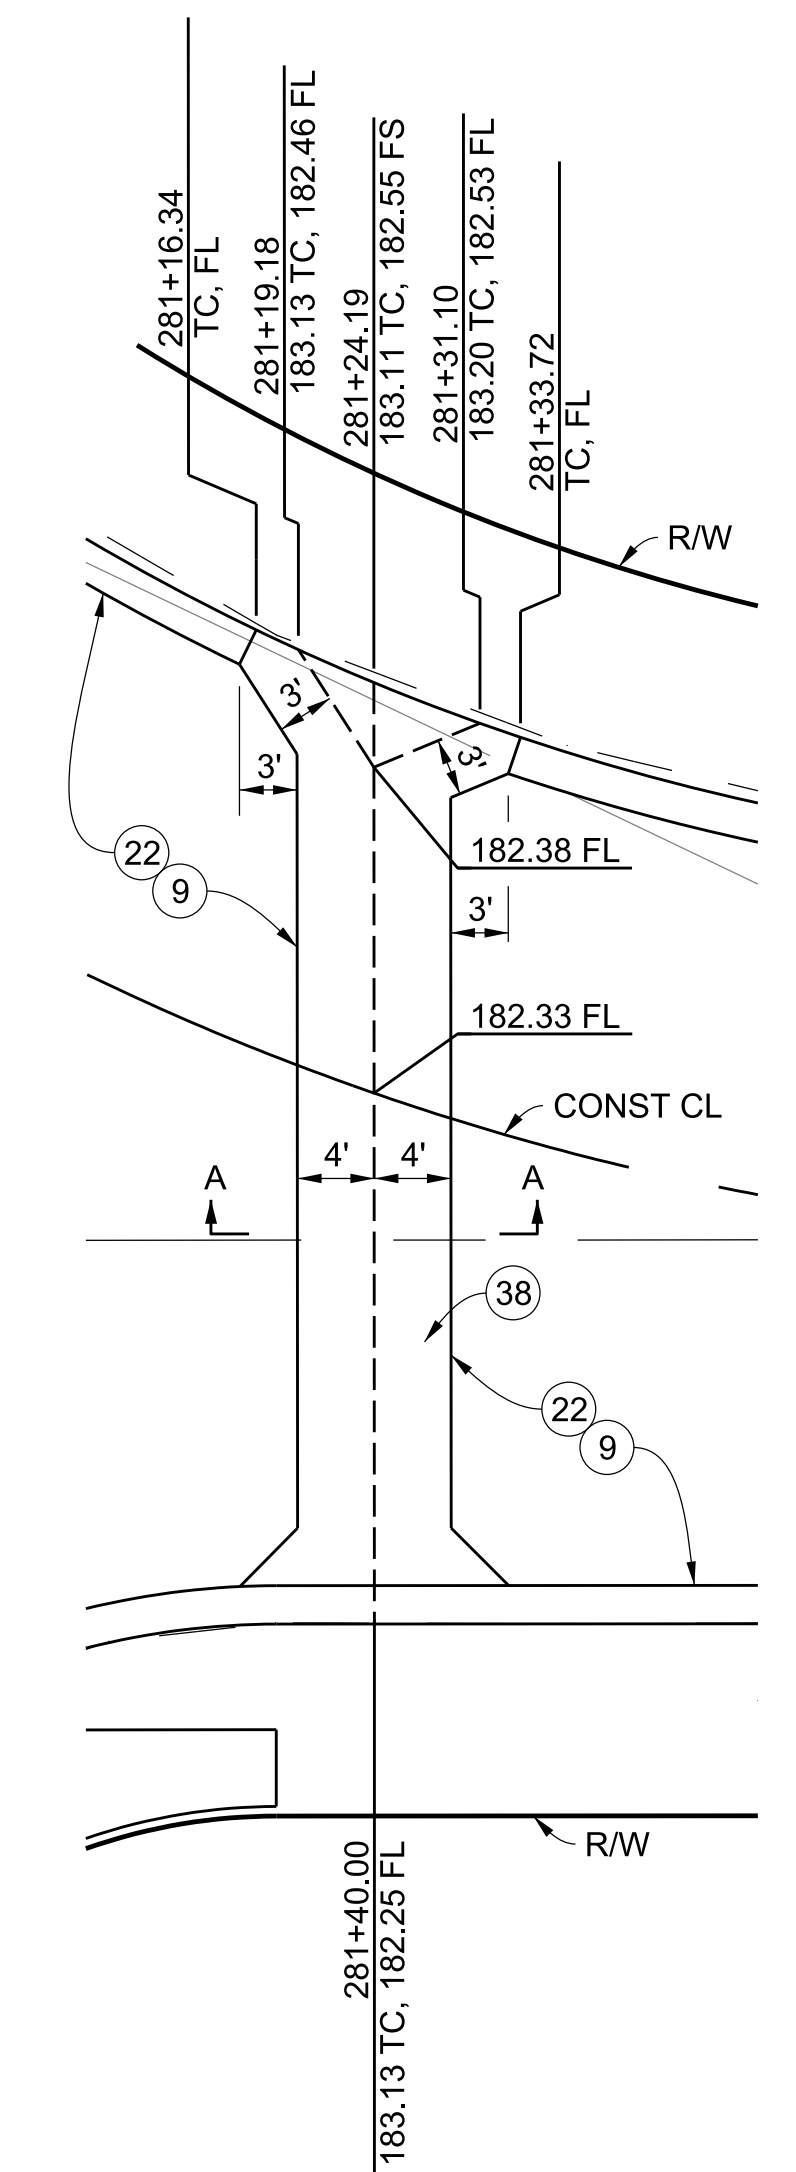


SCALE: HOR. 1"=40'
VERT. 1"=8'

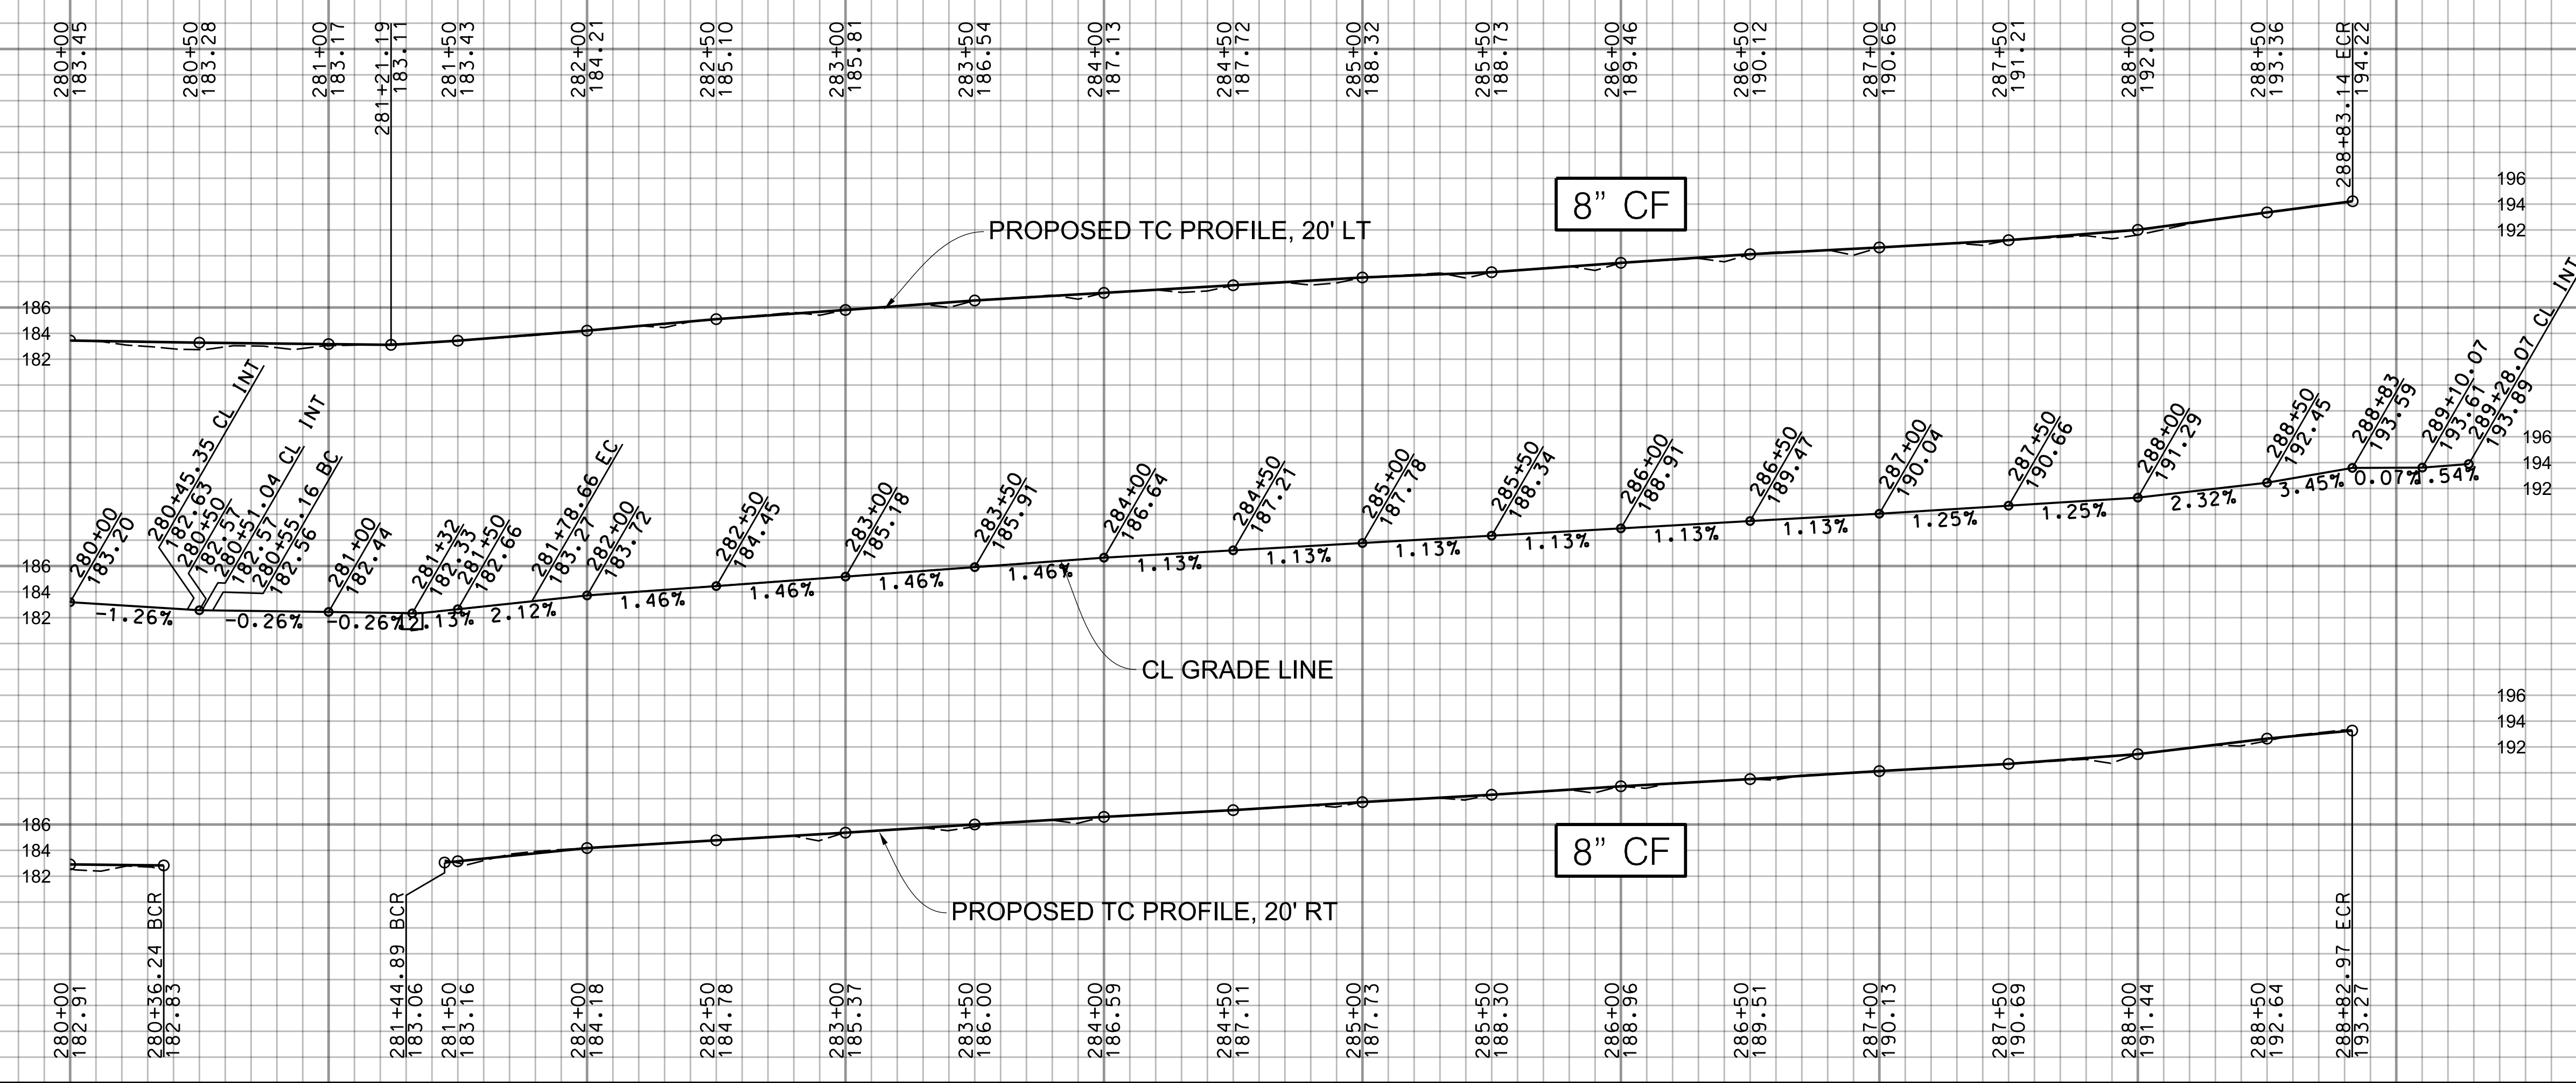

CROSS GUTTER DETAIL A
NO SCALE

GRETNA AVE

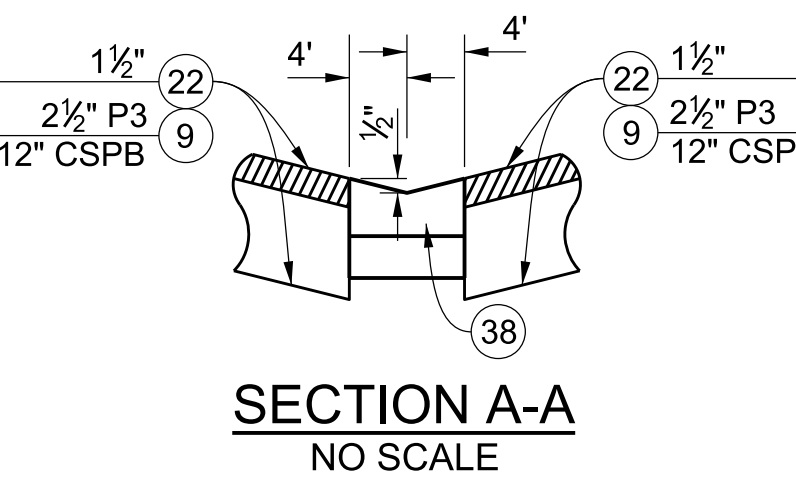

SECTION A-A
NO SCALE

SEE SHEET 71 FOR PARKWAY IMPROVEMENTS

| CURVE DATA | | | | |
|------------|---------|---------------|---------|---------|
| CURVE | RADIUS | CENTRAL ANGLE | LENGTH | TANGENT |
| (A) | 138.64' | 51° 02' 20" | 123.50' | 66.19' |
| (B) | 5.00' | 88° 37' 29" | 7.73' | 4.88' |
| (C) | 348.00' | 4° 56' 17" | 29.99' | 15.01' |
| (D) | 5.00' | 93° 06' 12" | 8.12' | 5.28' |
| (E) | 10.00' | 77° 42' 48" | 13.56' | 8.06' |
| (F) | 98.00' | 21° 56' 42" | 37.54' | 19.00' |
| (G) | 5.00' | 121° 51' 05" | 10.63' | 8.99' |
| (H) | 40.00' | 89° 55' 46" | 62.78' | 39.95' |

| ELEVATIONS | | | |
|------------|------------------------|------------------------|------------------------|
| CURVE | BCR | Δ/2 | ECR |
| (F) | 182.72 TC 182.22 FL | 182.58 TC 182.08 FL | 182.28 TC 181.78 FL |
| (H) | 183.09 TC 182.59 FL | 182.78 TC 182.28 FL | 181.95 TC 181.45 FL |

| INTERSECTION DATA | | |
|-------------------|-----------|--------|
| STATION | OFFSET | ELEV |
| 281+07.52 | 13.64' RT | 182.87 |
| 281+29.16 | 5.57' RT | 182.93 |
| 165+99.53 | 20' RT | 182.66 |

BENCHMARK
PT 823, ELEV 182.71 (WHITTIER & BASELINE QUAD 2005), PWFB 1027, PG 972
CL INT. RINCON DR & ALLEY S/O HADLEY ST FD SQ HD SPK & T, FL PER R1


LOS ANGELES COUNTY PUBLIC WORKS
SOUTH WHITTIER LOS NIETOS
KEITH DRIVE, ET AL.
PROJECT ID NO. RMD4408001
PLAN AND PROFILE



PROJECT ENGINEER
DATE 6/24/19

| DATE | MARK | DESCRIPTION |
|------------|----------|-------------|
| 10/25/2021 | AS-BUILT | |
| REVISIONS | | |

CADD PROJECT FILE NAME: \$FILESS
CHECKER: B. FUNG
DESIGNER: J. GARCIA
DRAFTER: J. GARCIA

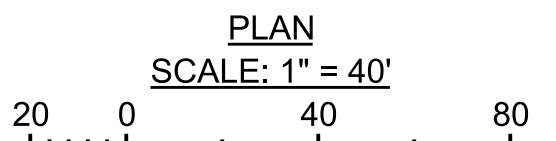

PLAN SCALE: 1"=40'