


SCALE: HOR. 1"= 40'
VERT. 1"= 8'

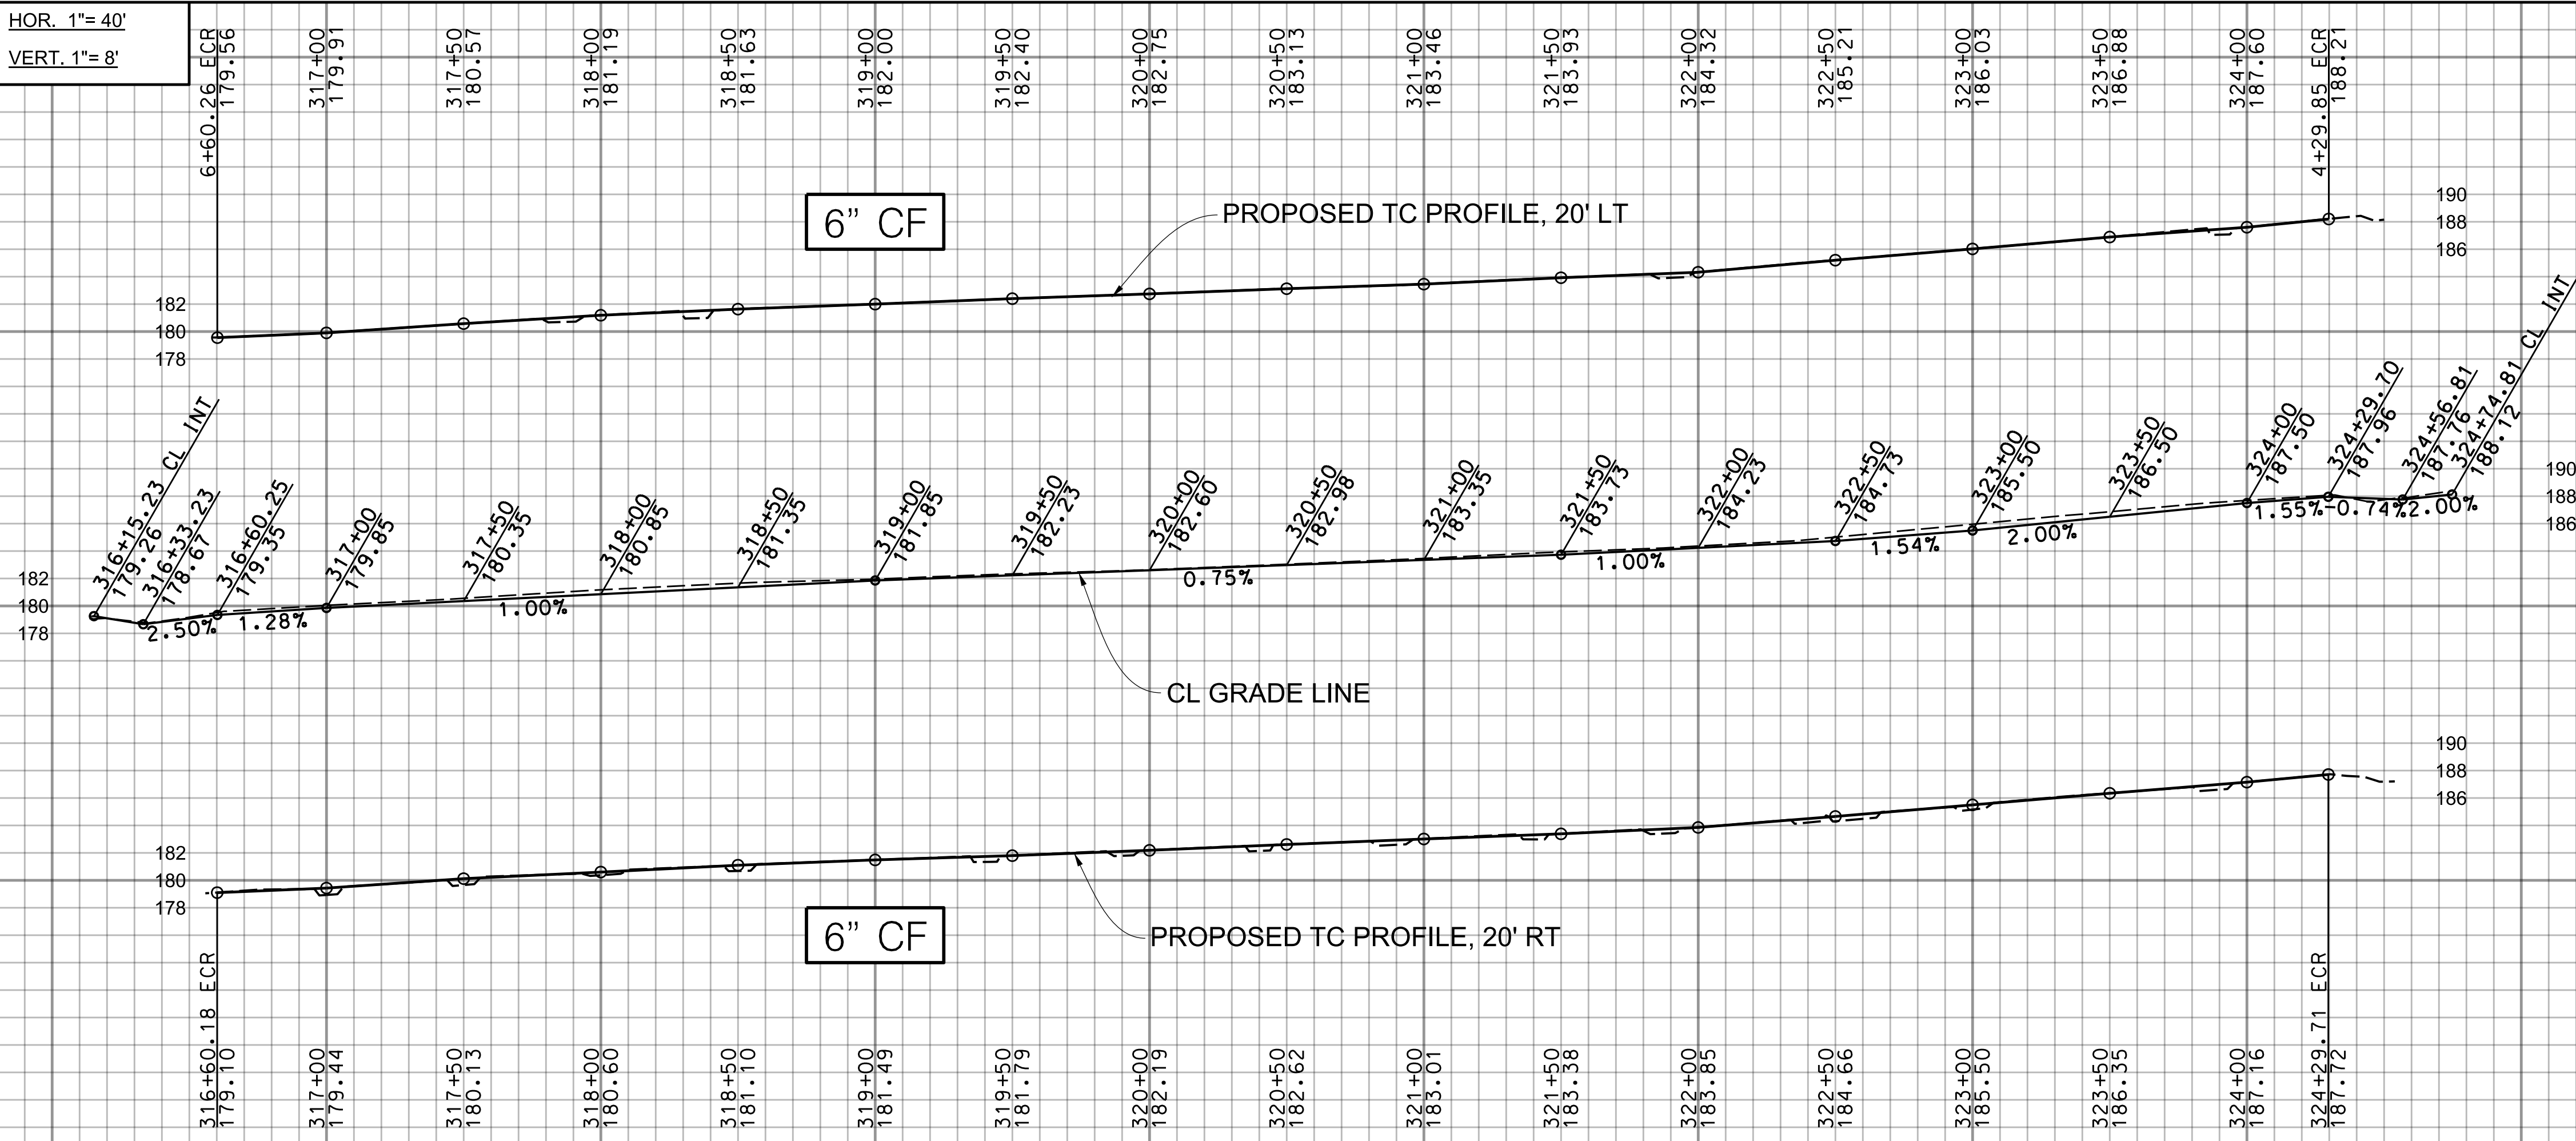


SEE SHEET 72 FOR PARKWAY IMPROVEMENTS

WESTERN AVE

GRETNA AVE

KEITH

DR

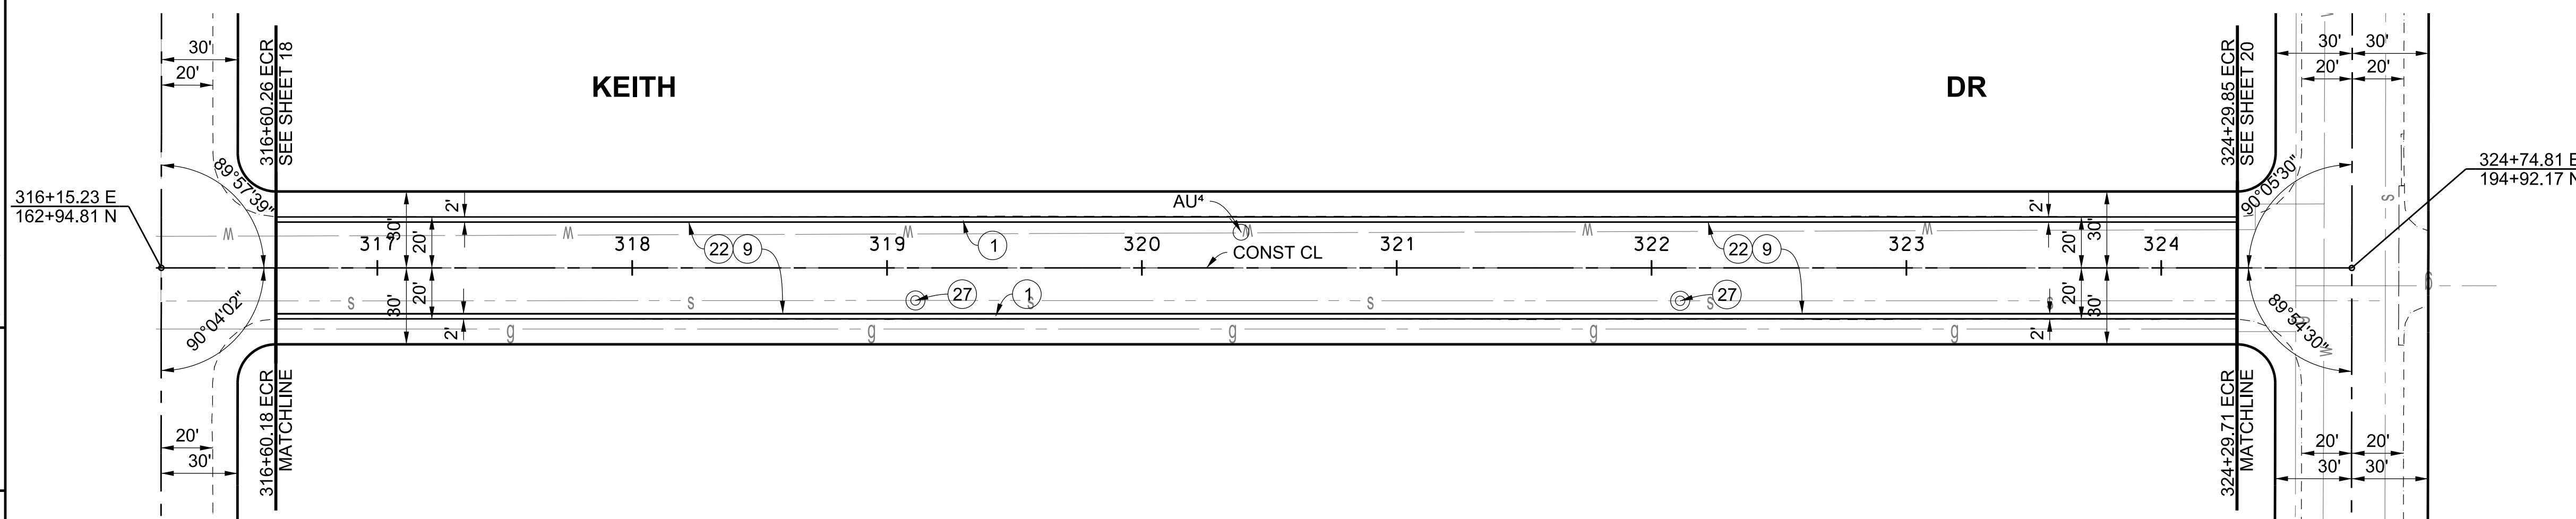

BENCHMARK

PT 606, ELEV 179.06 (WHITTIER & BASELINE QUAD 2005), PWFB 1027, PG 957
CL INT KEITH DR & WESTERN AVE FD.SQ.HD.SPK&T PER R1, FL

LOS ANGELES COUNTY PUBLIC WORKS

SOUTH WHITTIER LOS NIETOS
KEITH DRIVE, ET AL.

PROJECT ID NO. RMD4408001
PLAN AND PROFILE

PD PH086550 SHEET 31 OF 79

DATE	MARK	DESCRIPTION
10/25/2021	■	AS-BUILT
REVISIONS		



PROJECT ENGINEER: *R.S.* DATE: 6/24/19