

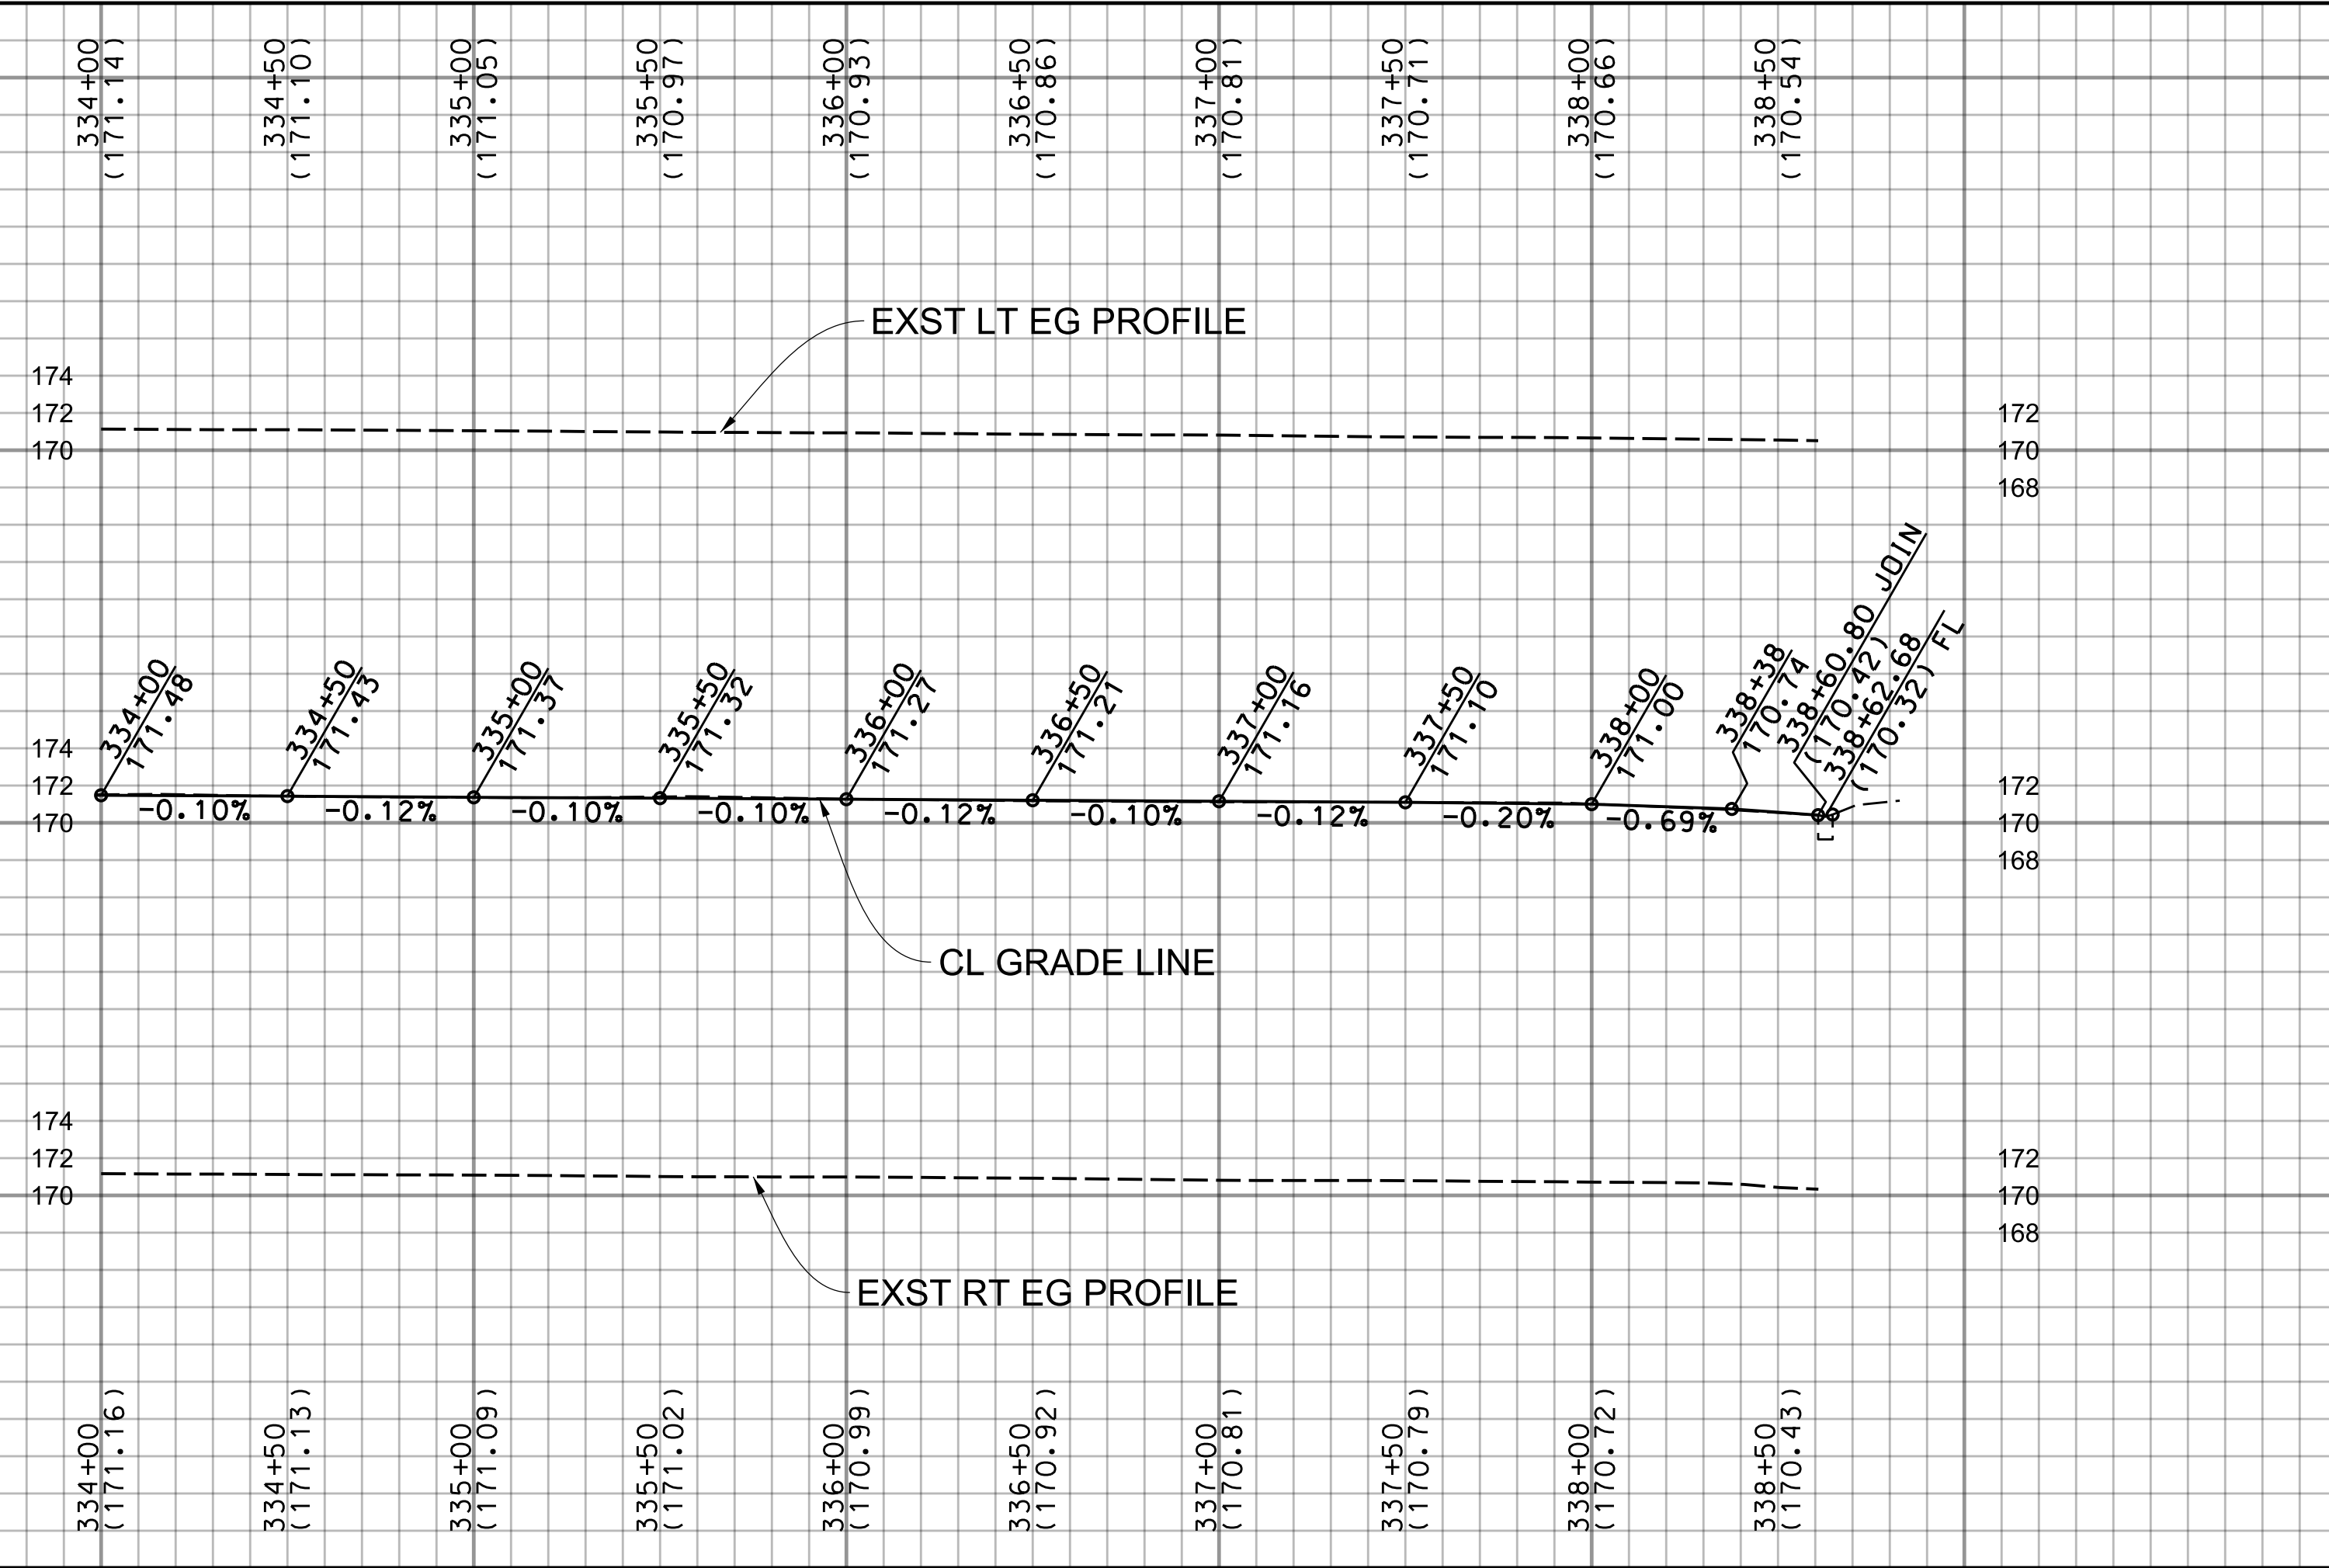
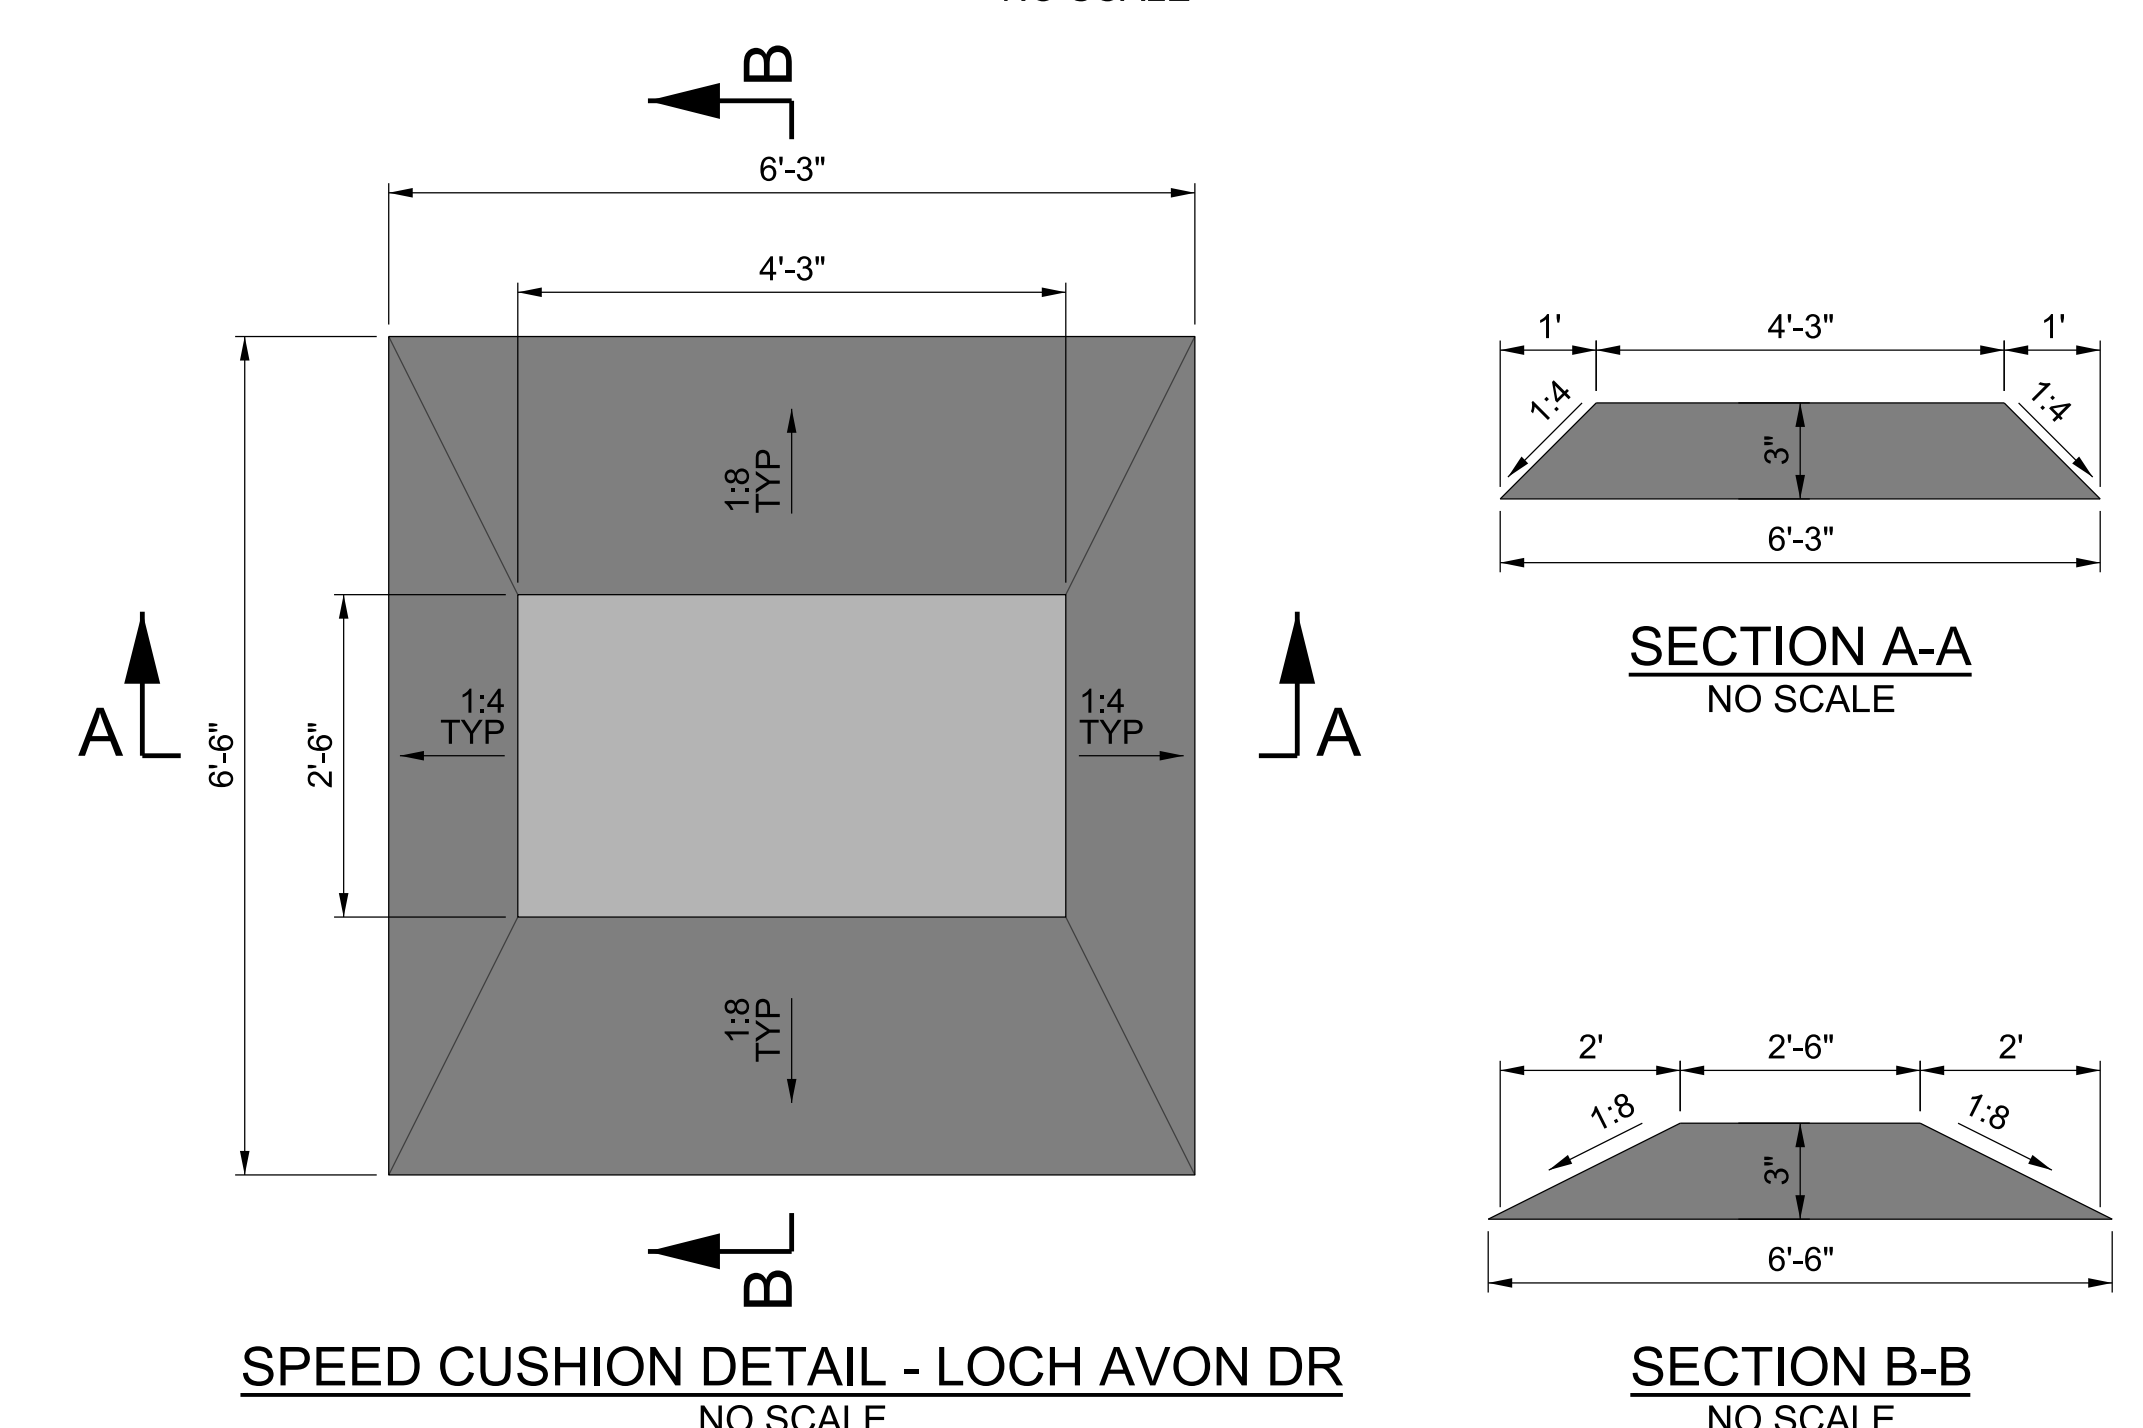


SCALE: HOR. 1"= 40'
VERT. 1"= 8'

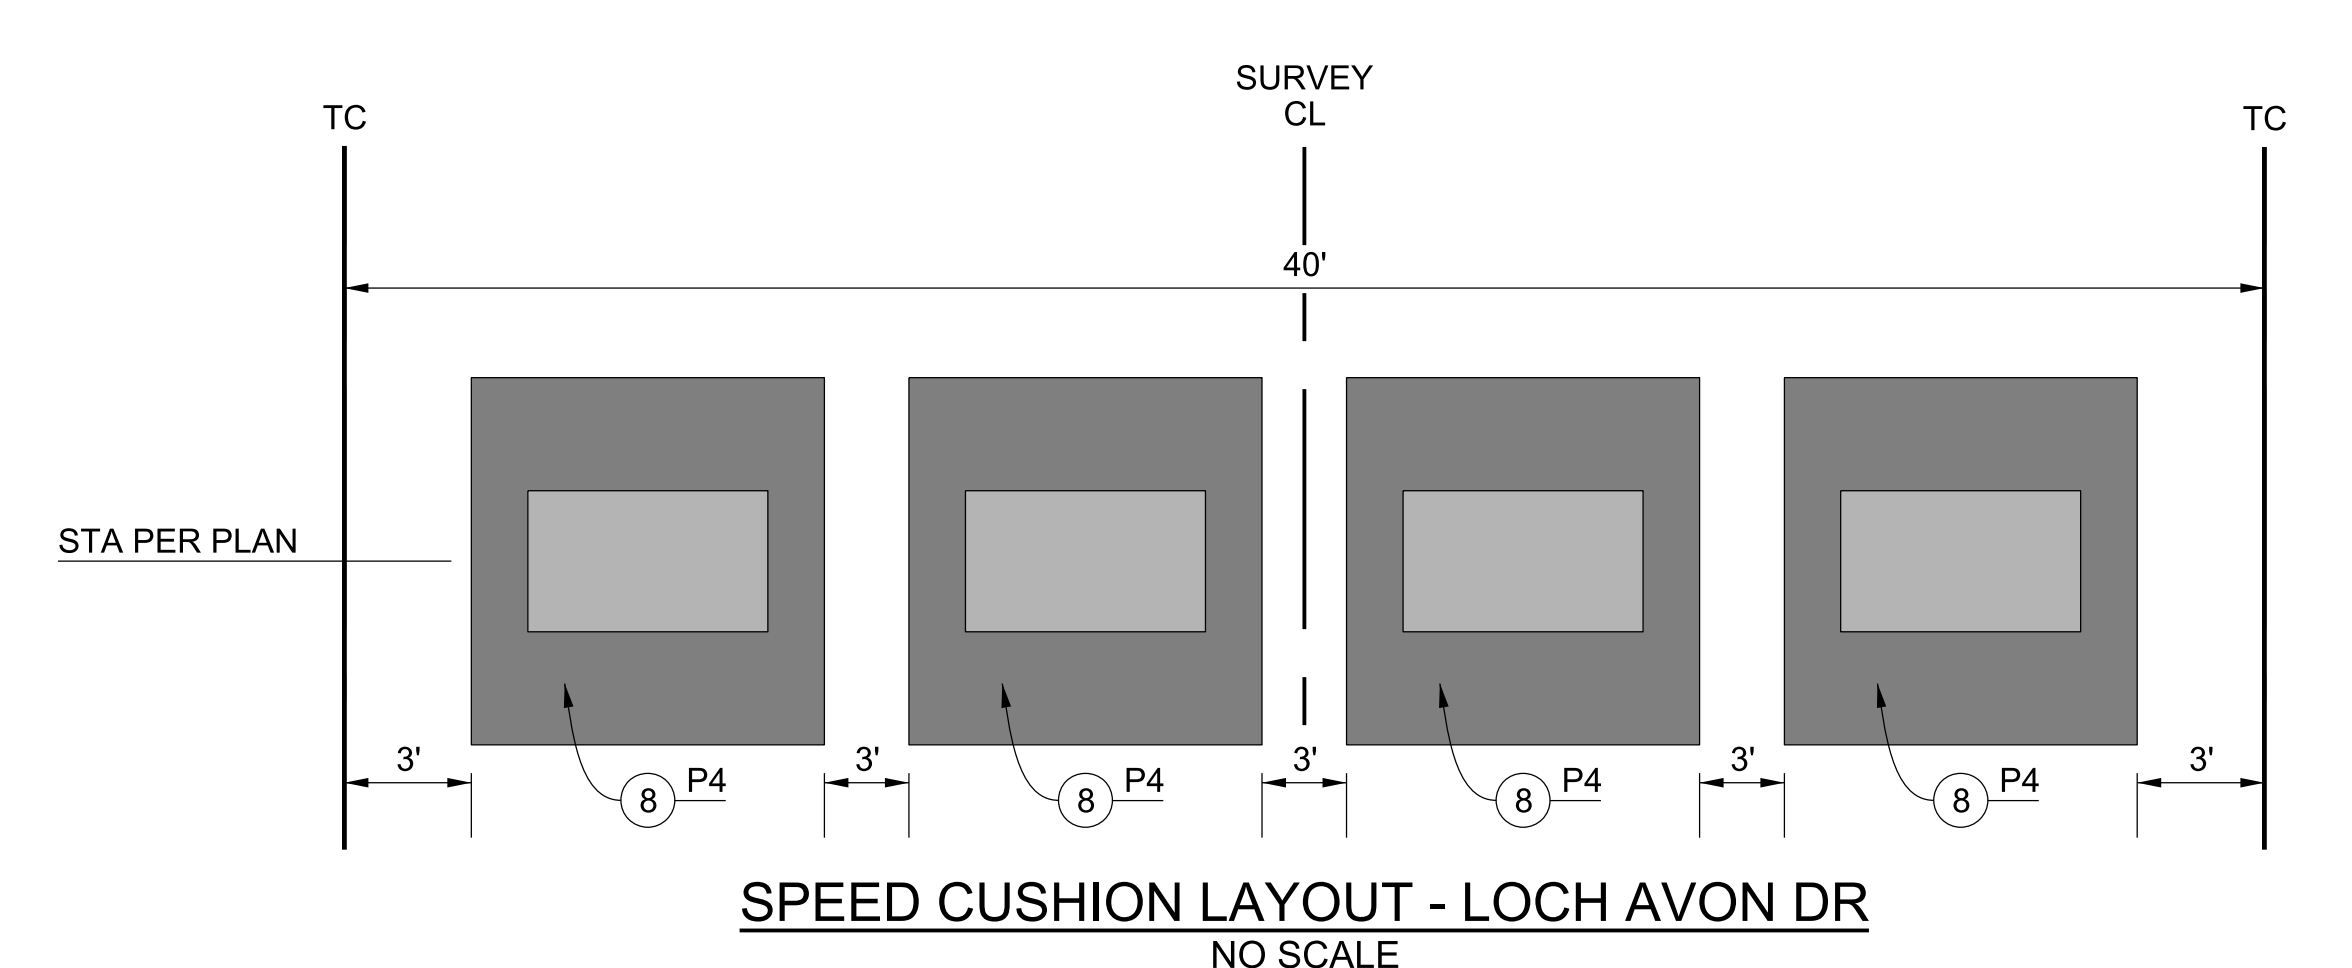


334 335 336 337 338 339
SEE SHEET 72 FOR PARKWAY IMPROVEMENTS

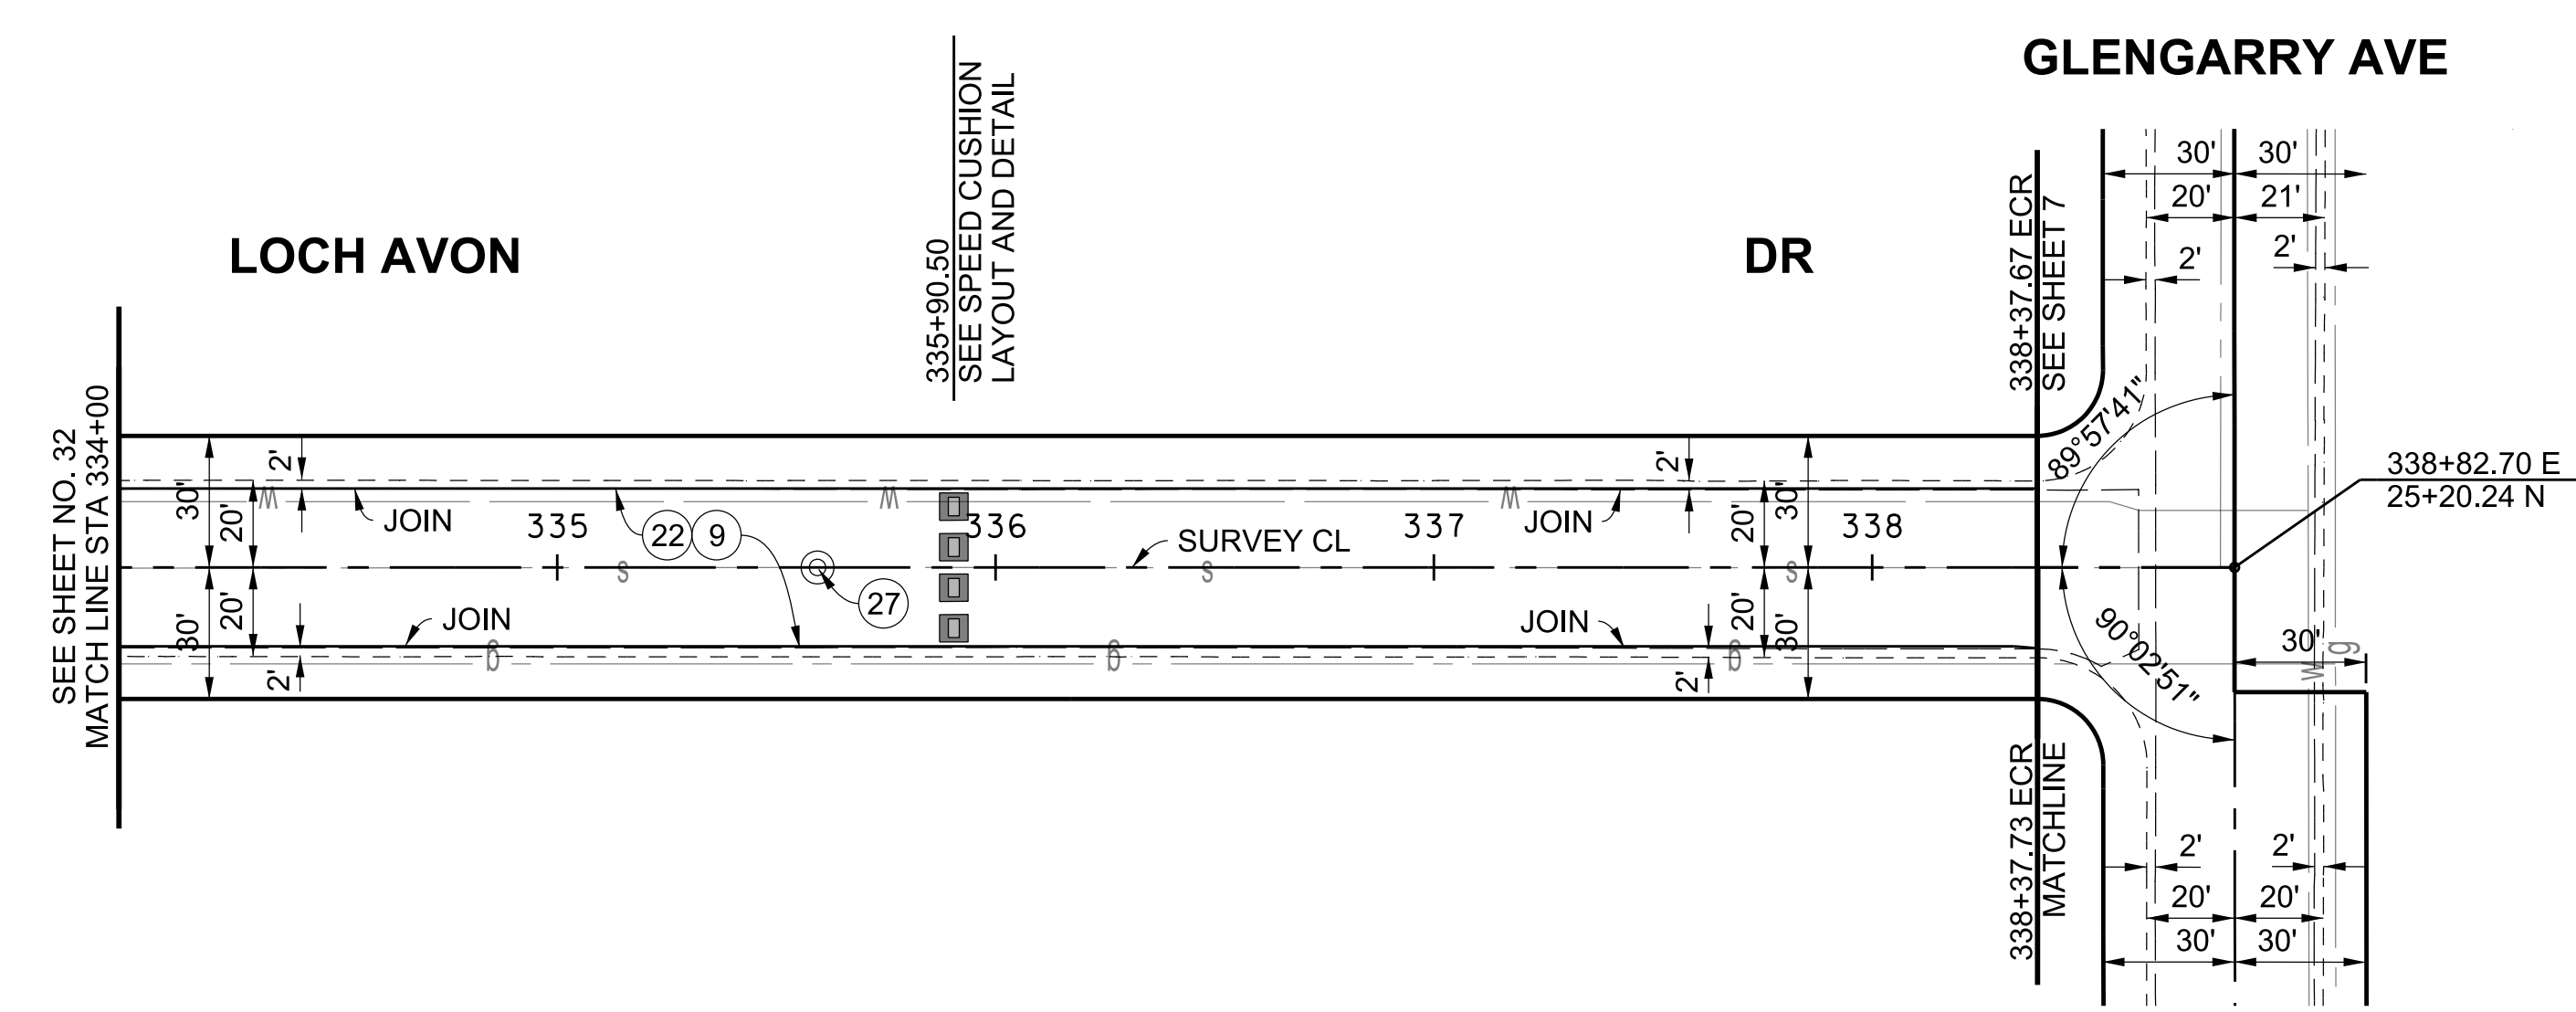

BENCHMARK
PT 33, ELEV 169.63 (WHITTIER & BASELINE QUAD 2005), PWFB 1026, PG 2122
CL INT LOCH AVON DR & GLENGARRY AVE FD Co ENG MON IN WELL, PER R1
RAISED LID 5"

LOS ANGELES COUNTY PUBLIC WORKS
SOUTH WHITTIER LOS NIETOS
KEITH DRIVE, ET AL.
PROJECT ID NO. RMD4408001
PLAN AND PROFILE

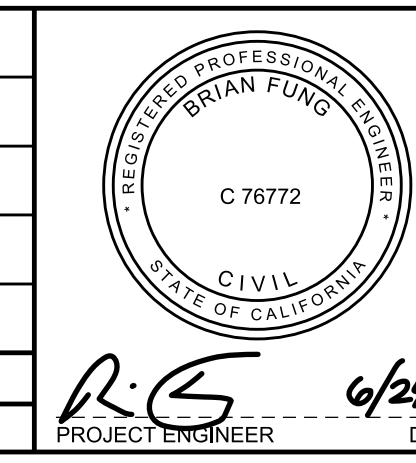

DATE	MARK	DESCRIPTION
10/25/2021	AS-BUILT	
REVISIONS		

PROJECT ENGINEER: R. G. DATE: 6/24/19

PD PH086552 SHEET 33 OF 79