
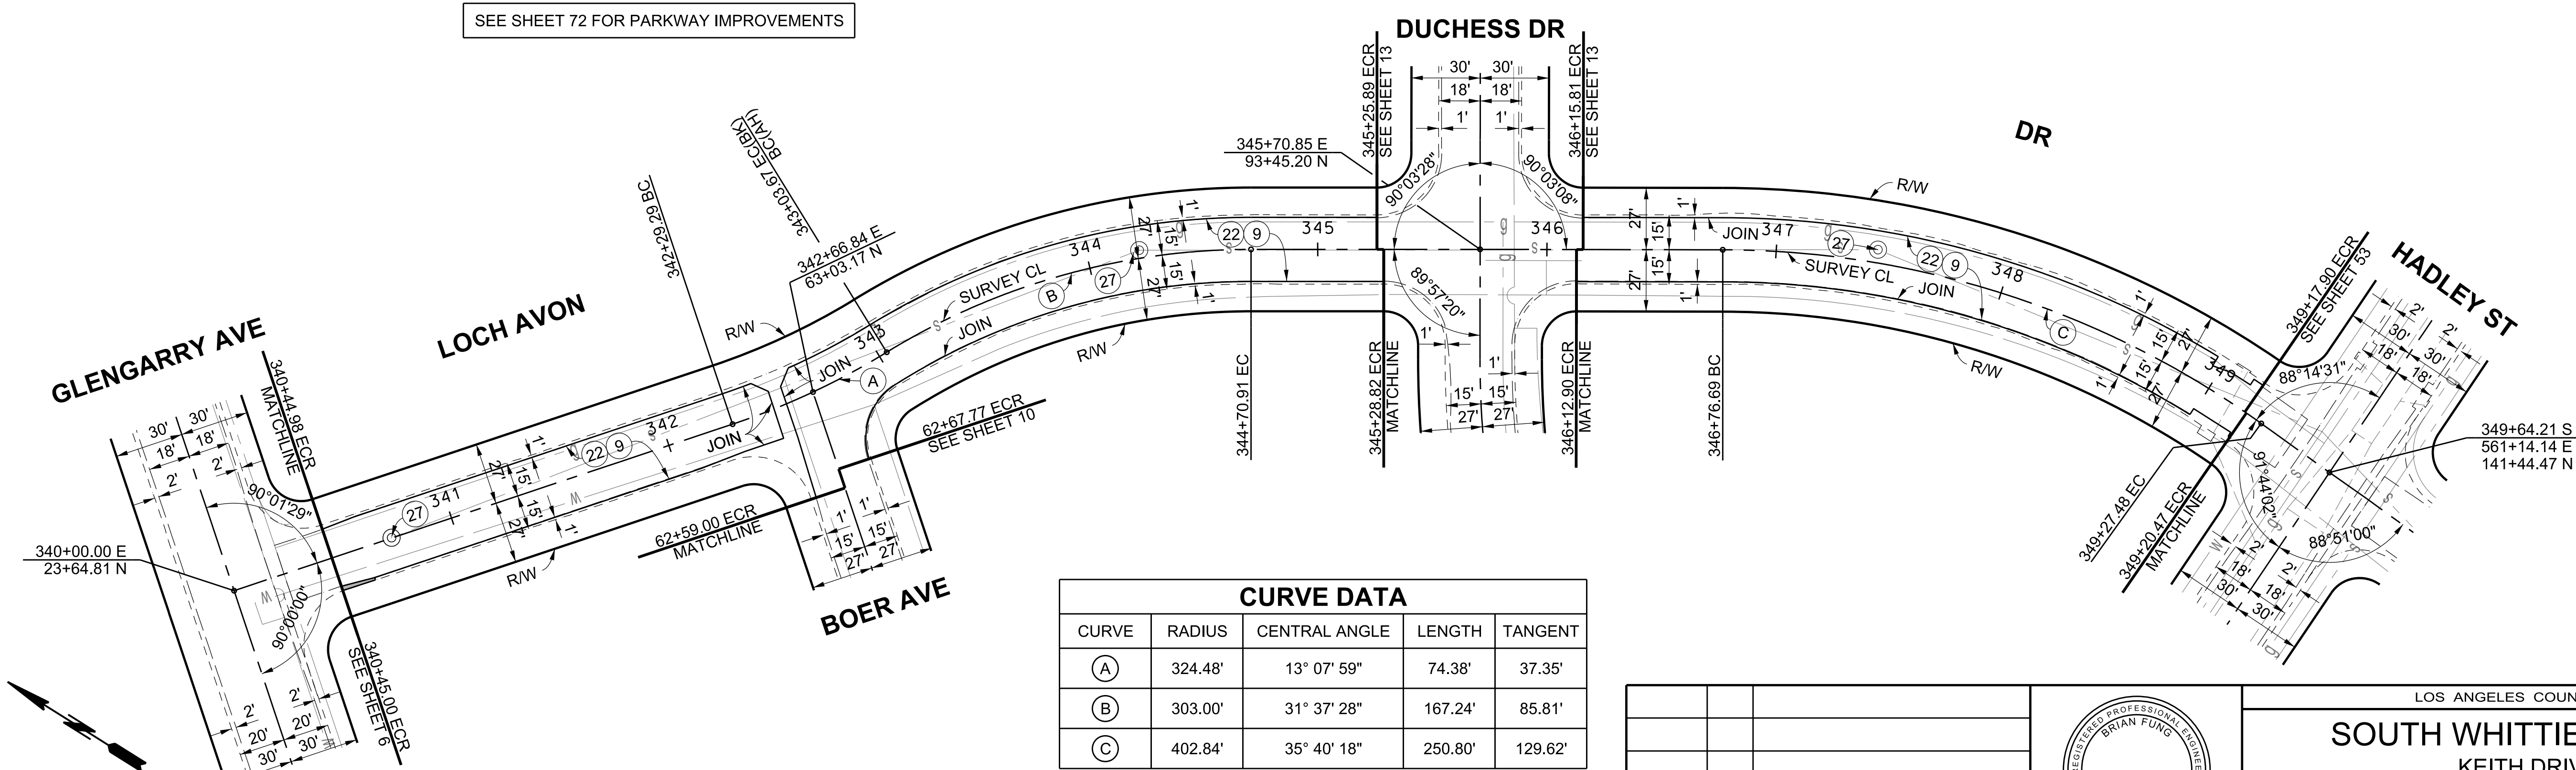


SCALE: HOR. 1"= 40'  
VERT. 1"= 8'

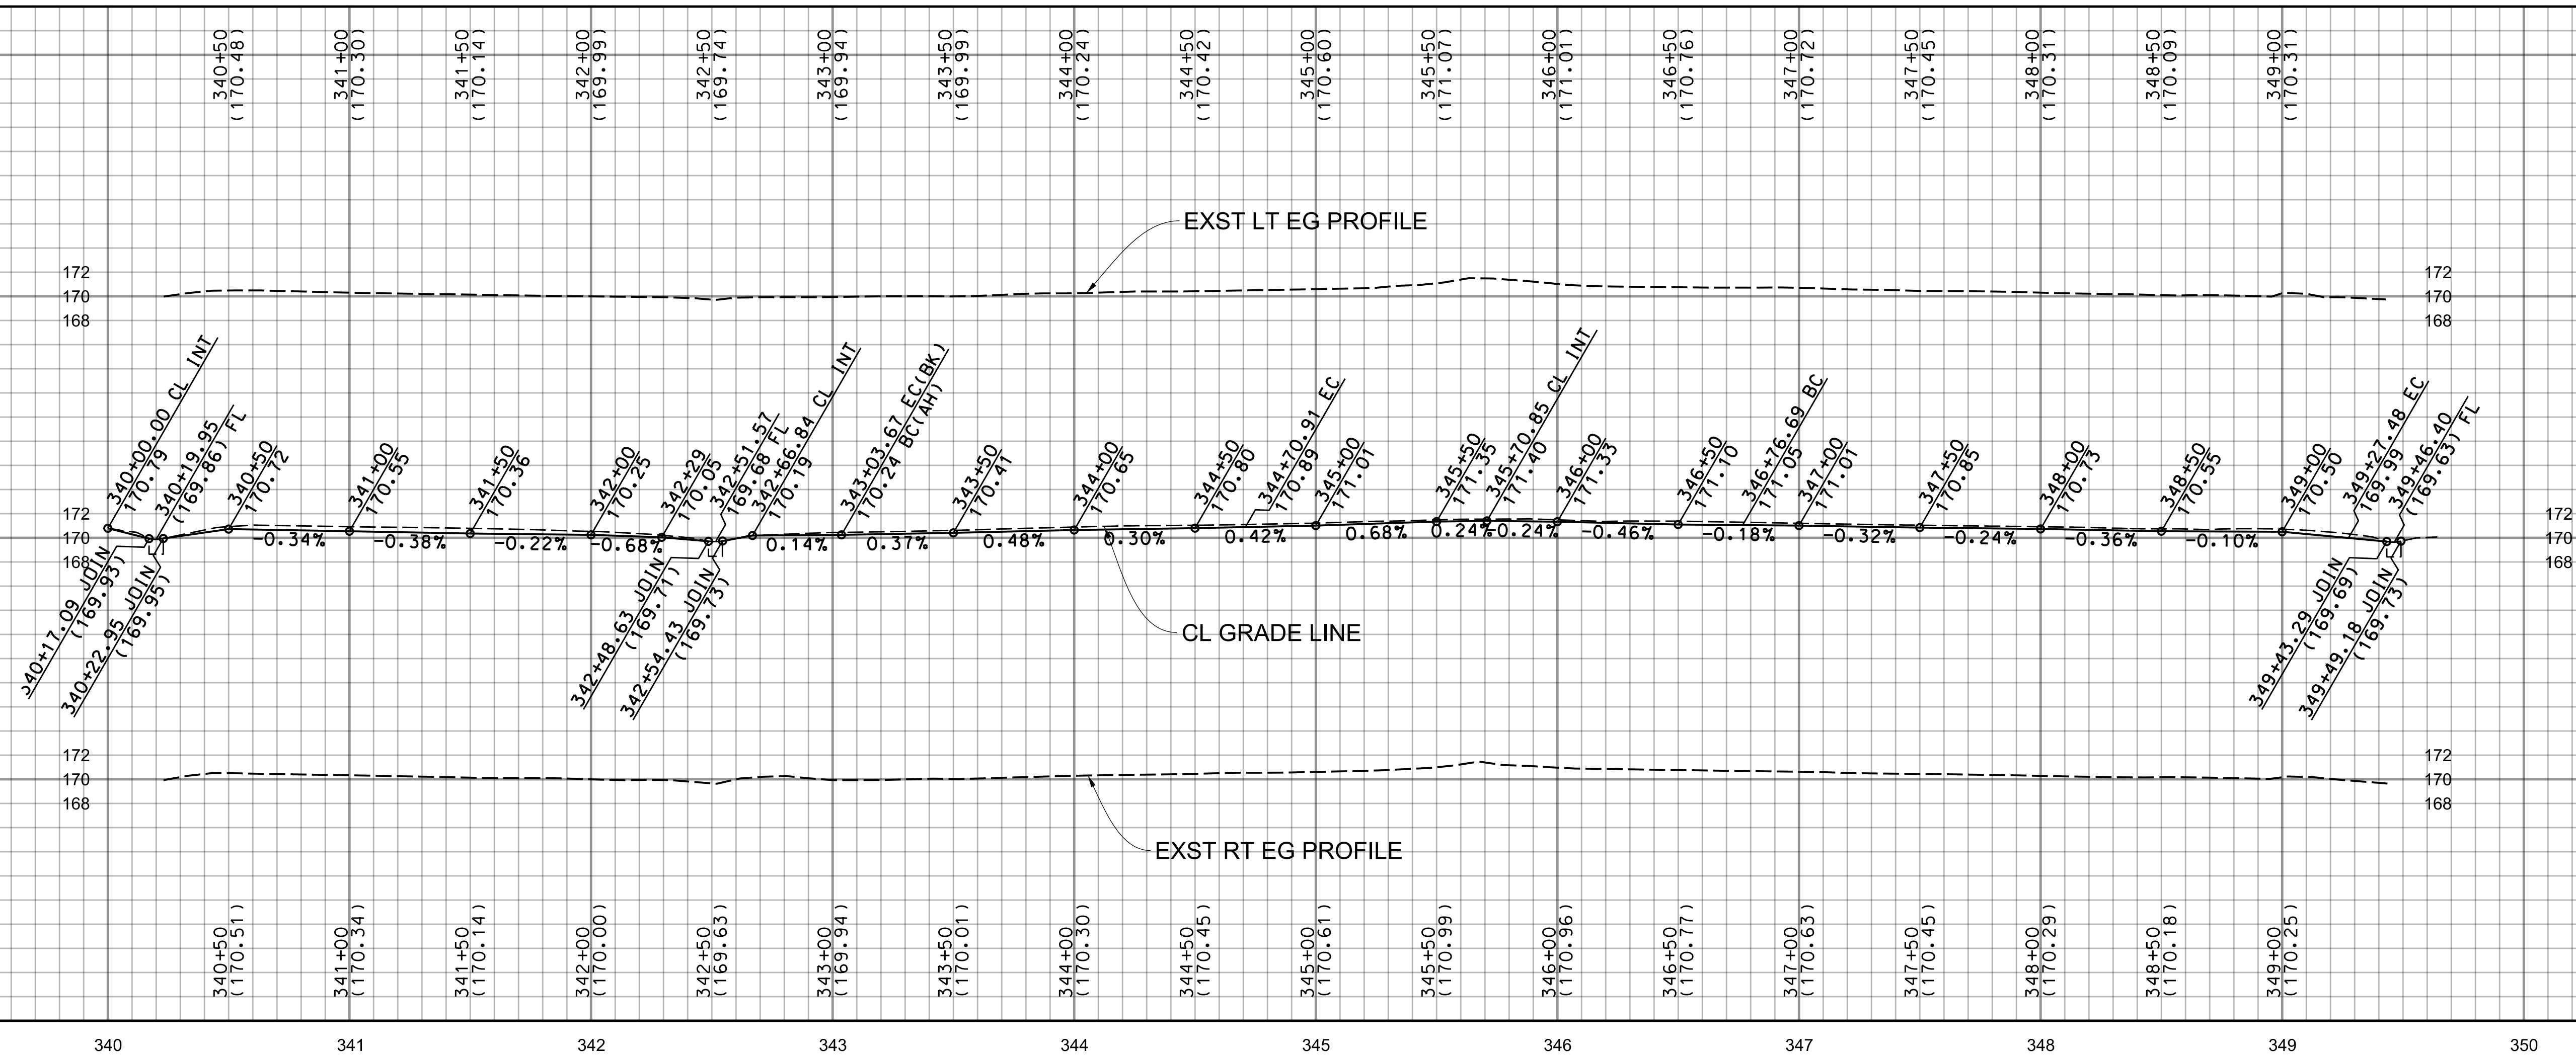


SEE SHEET 72 FOR PARKWAY IMPROVEMENTS

CURVE DATA				
CURVE	RADIUS	CENTRAL ANGLE	LENGTH	TANGENT
(A)	324.48'	13° 07' 59"	74.38'	37.35'
(B)	303.00'	31° 37' 28"	167.24'	85.81'
(C)	402.84'	35° 40' 18"	250.80'	129.62'

**BENCHMARK**  
PT 672, ELEV 171.68 (WHITTIER & BASELINE QUAD 2005), PWFB 1026, PG 2169  
CL INT LOCH AVON DR & DUCHESS DR 4 PT. FD C-NAIL & TAG LS 5748, NO REF. FL

DATE	MARK	DESCRIPTION
10/25/2021	AS-BUILT	
REVISIONS		

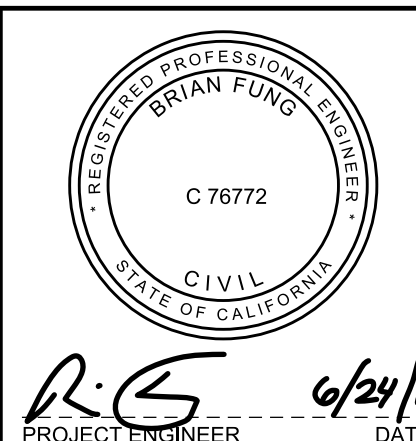

LOS ANGELES COUNTY PUBLIC WORKS  
**SOUTH WHITTIER LOS NIETOS**  
KEITH DRIVE, ET AL.  
PROJECT ID NO. RMD4408001  
PLAN AND PROFILE  
PD PH086553 SHEET 34 OF 79

DRAFTER: J. GARCIA  
 DESIGNER: J. GARCIA  
 CHECKER: B. FUNG  
 CADD PROJECT FILE NAME: \$FILESS\$