



SCALE: HOR. 1"= 40'  
VERT. 1"= 8'

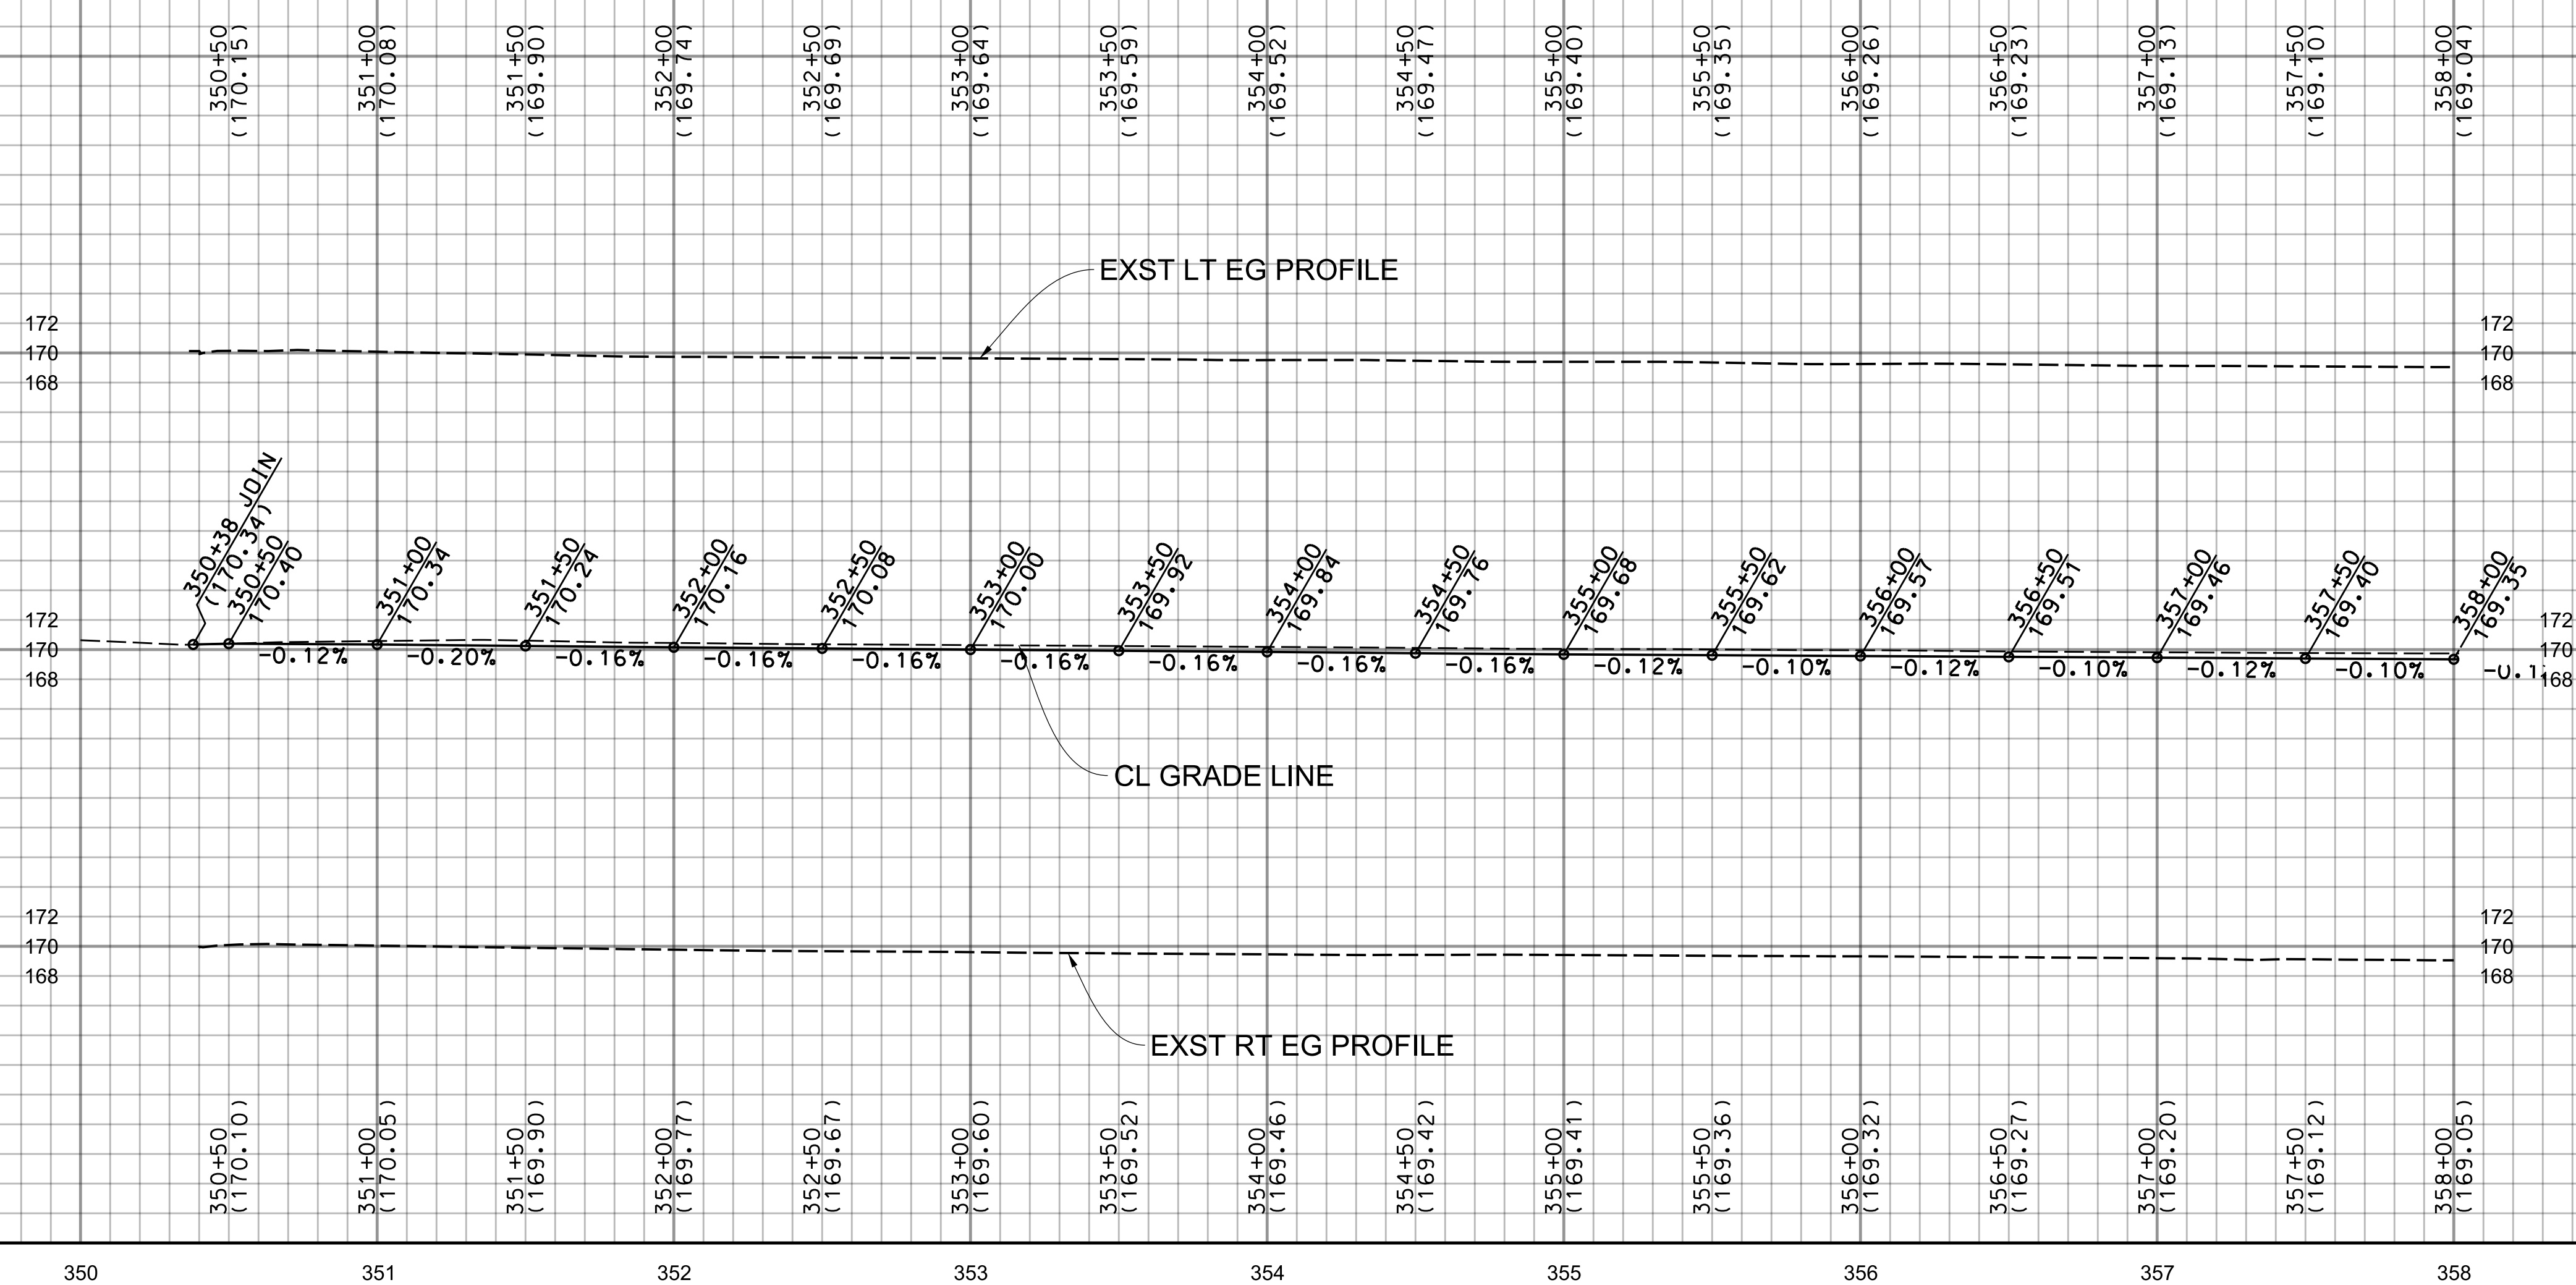

SEE SHEET 73 FOR PARKWAY IMPROVEMENTS

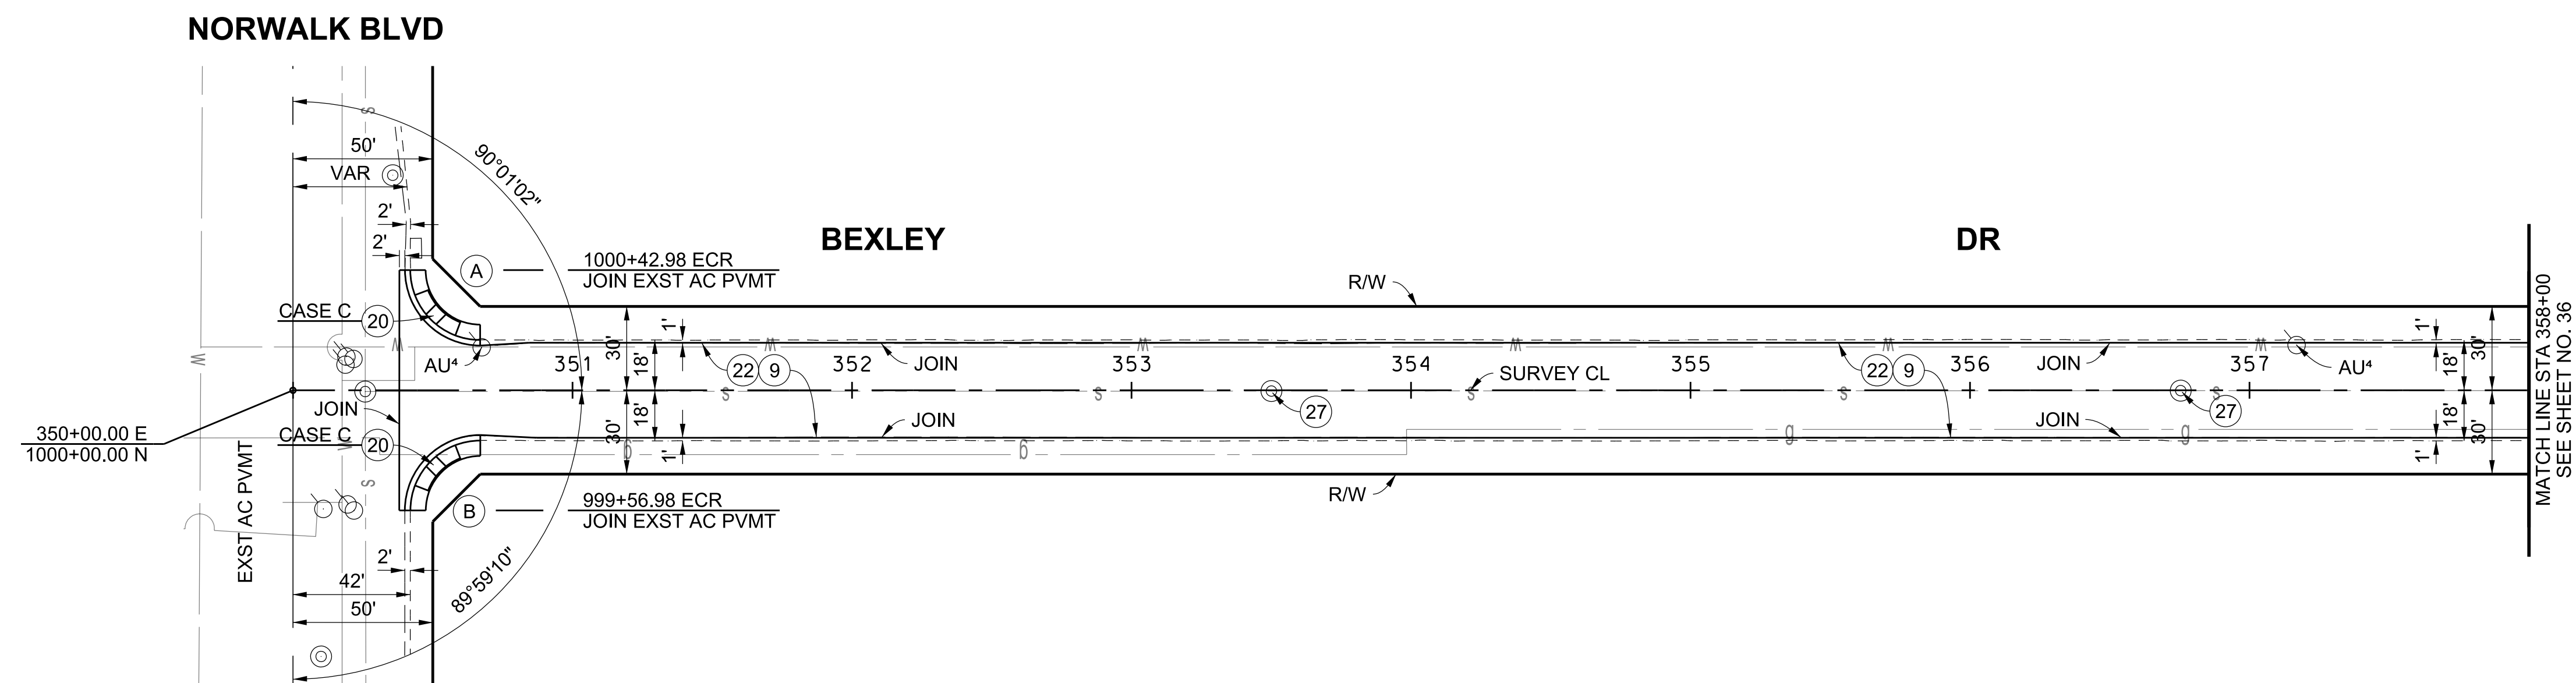


ELEVATIONS			
CURVE	BCR	Δ/2	ECR
(G)	170.62 TC 169.95 FL	170.67 TC 170.00 FL	170.33 TC 169.66 FL
(H)	170.72 TC 170.05 FL	170.75 TC 170.09 FL	170.53 TC 169.86 FL

INTERSECTION DATA		
STATION	OFFSET	ELEV
350+40.08	16' LT	170.28
350+40.05	16' RT	170.27

CURVE DATA				
CURVE	RADIUS	CENTRAL ANGLE	LENGTH	TANGENT
(A)	25.00'	89° 58' 58"	39.26'	24.99'
(B)	25.00'	90° 00' 50"	39.28'	25.01'

DATE	MARK	DESCRIPTION
10/25/2021	AS-BUILT	
REVISIONS		

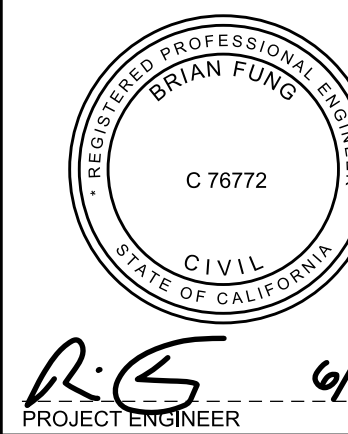

**BENCHMARK**  
PT 139, ELEV 170.66 (WHITTIER & BASELINE QUAD 2005), PWFB 1026, PG 2129  
CL INT REICHLING LN & NORWALK BLVD FD S&W FL PER R1 (RDFB 1026-79B).

LOS ANGELES COUNTY PUBLIC WORKS

**SOUTH WHITTIER LOS NIETOS**  
KEITH DRIVE, ET AL.

PROJECT ID NO. RMD4408001  
PLAN AND PROFILE

PD PH086554 SHEET 35 OF 79

PLAN RD