



SCALE: HOR. 1"=40  
VERT. 1"=8

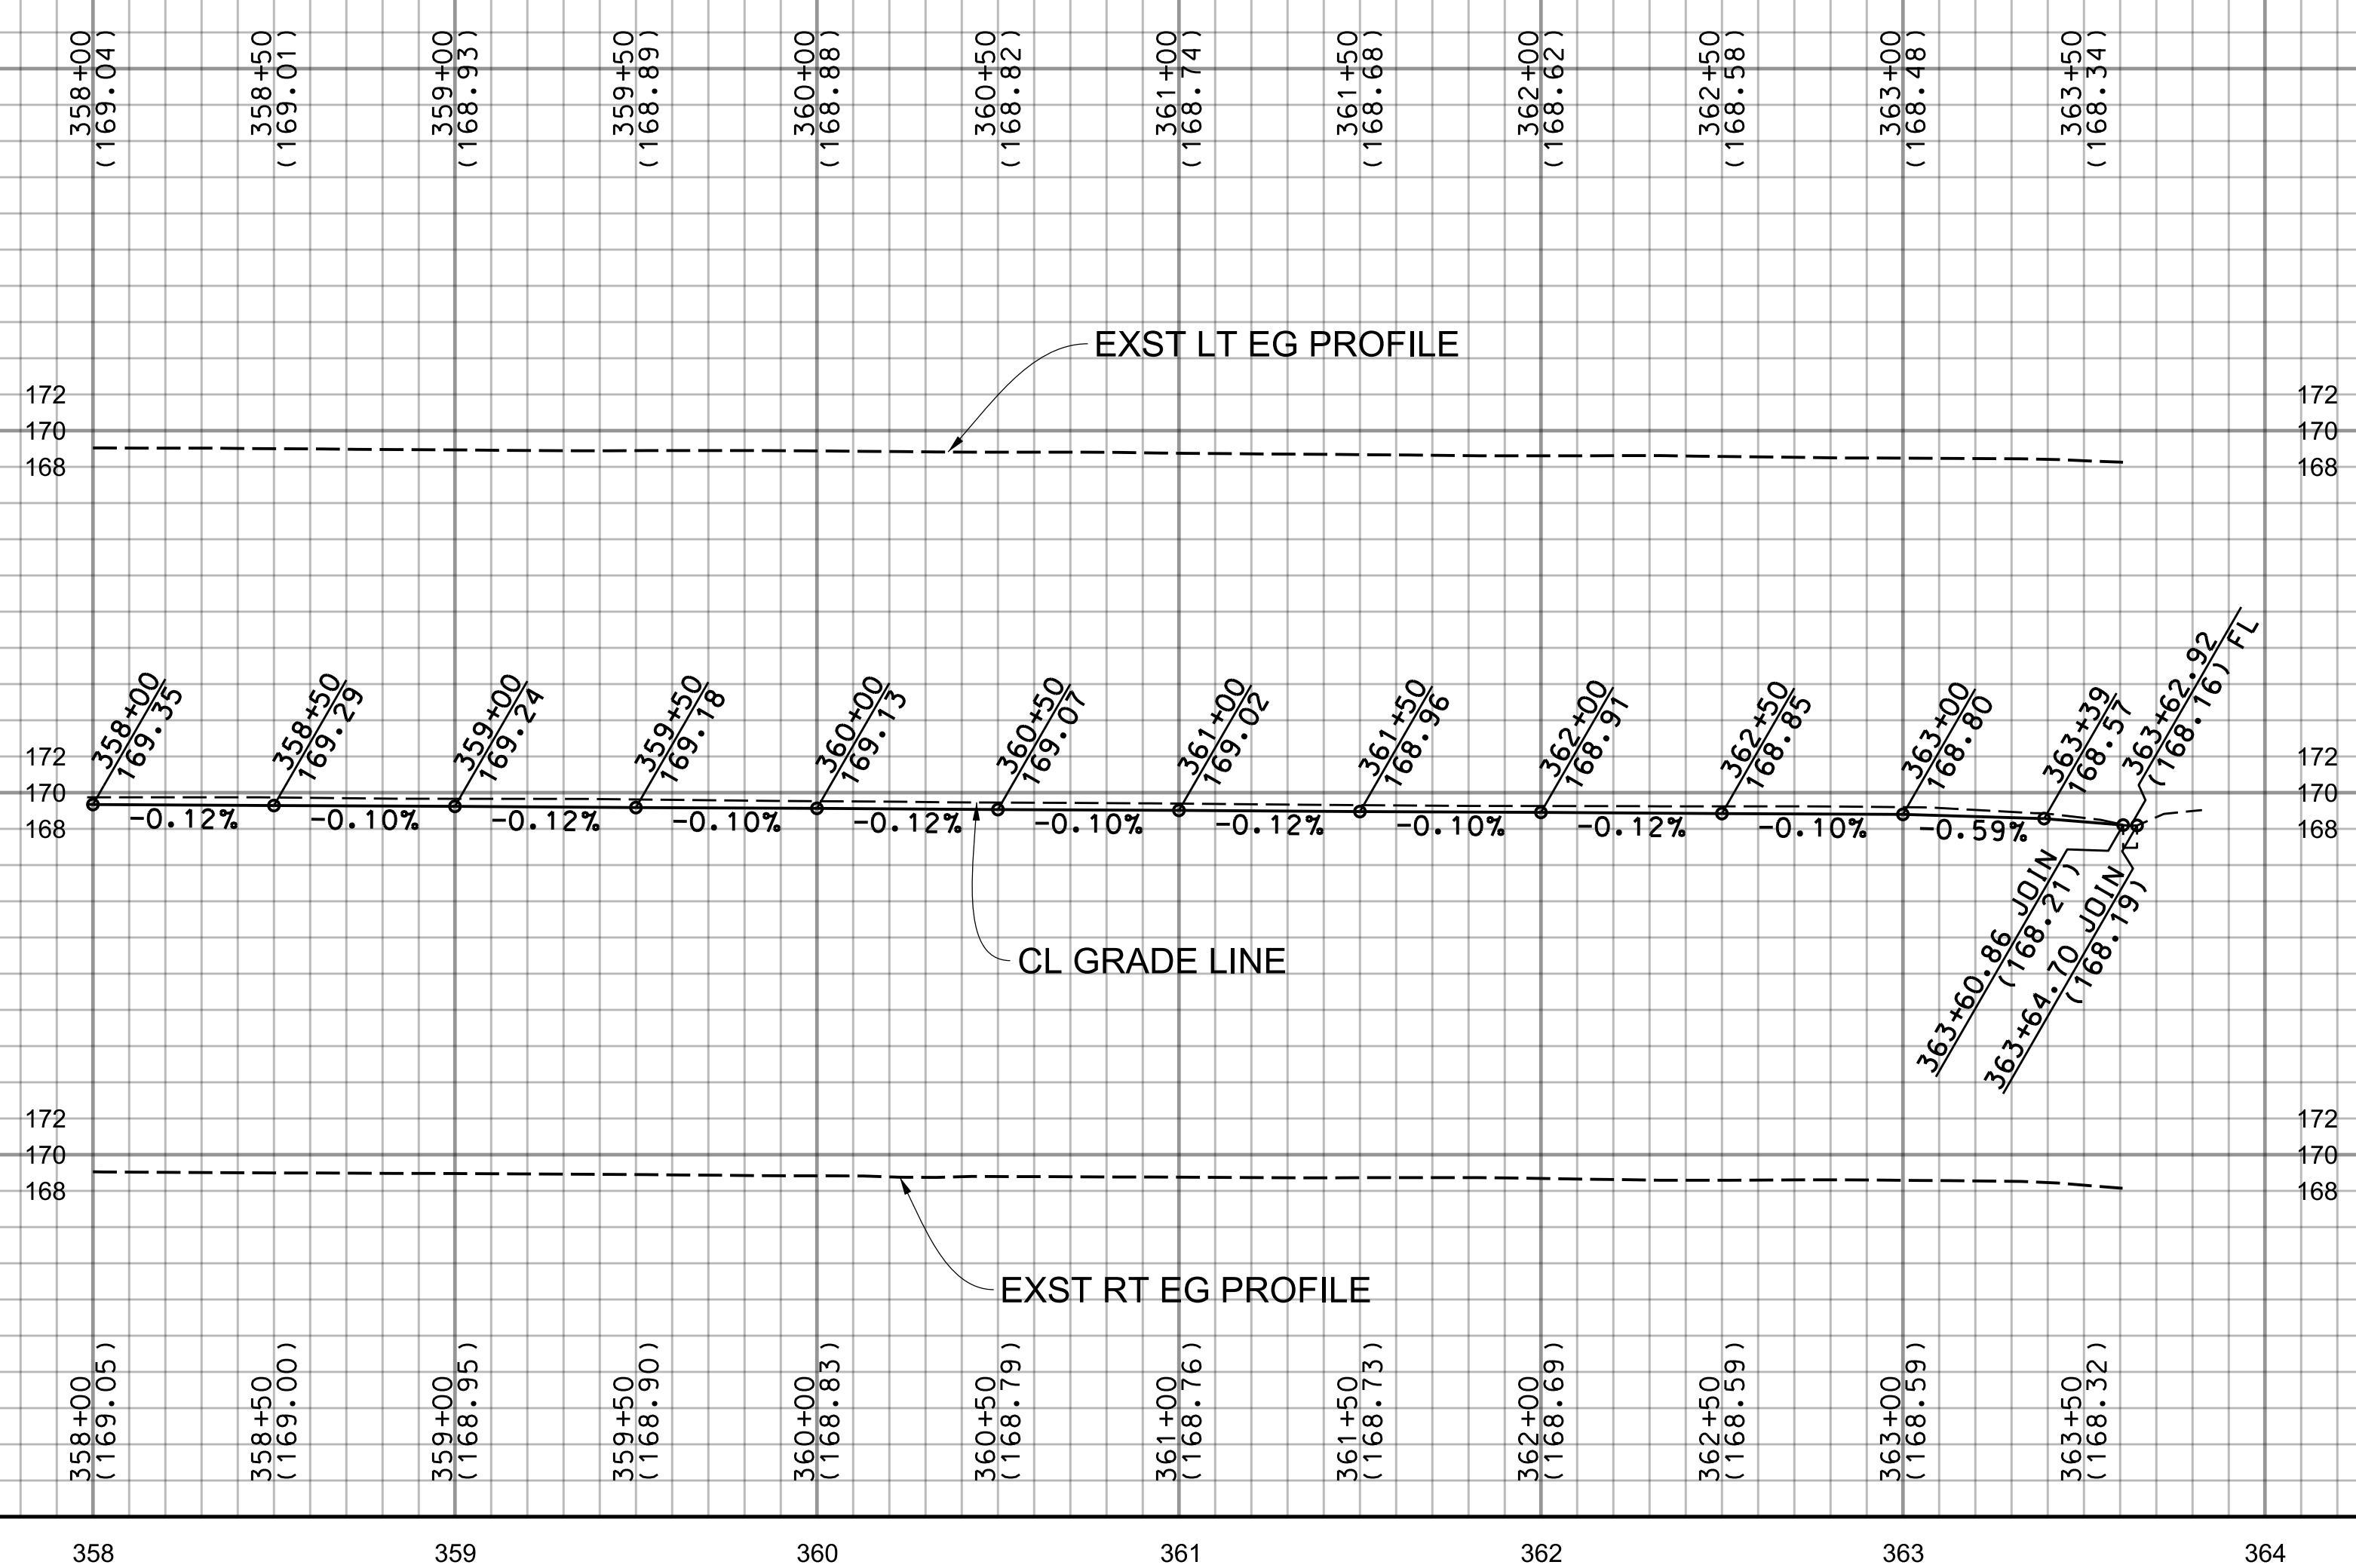

SEE SHEET 73 FOR PARKWAY IMPROVEMENTS

GLENGARRY AVE

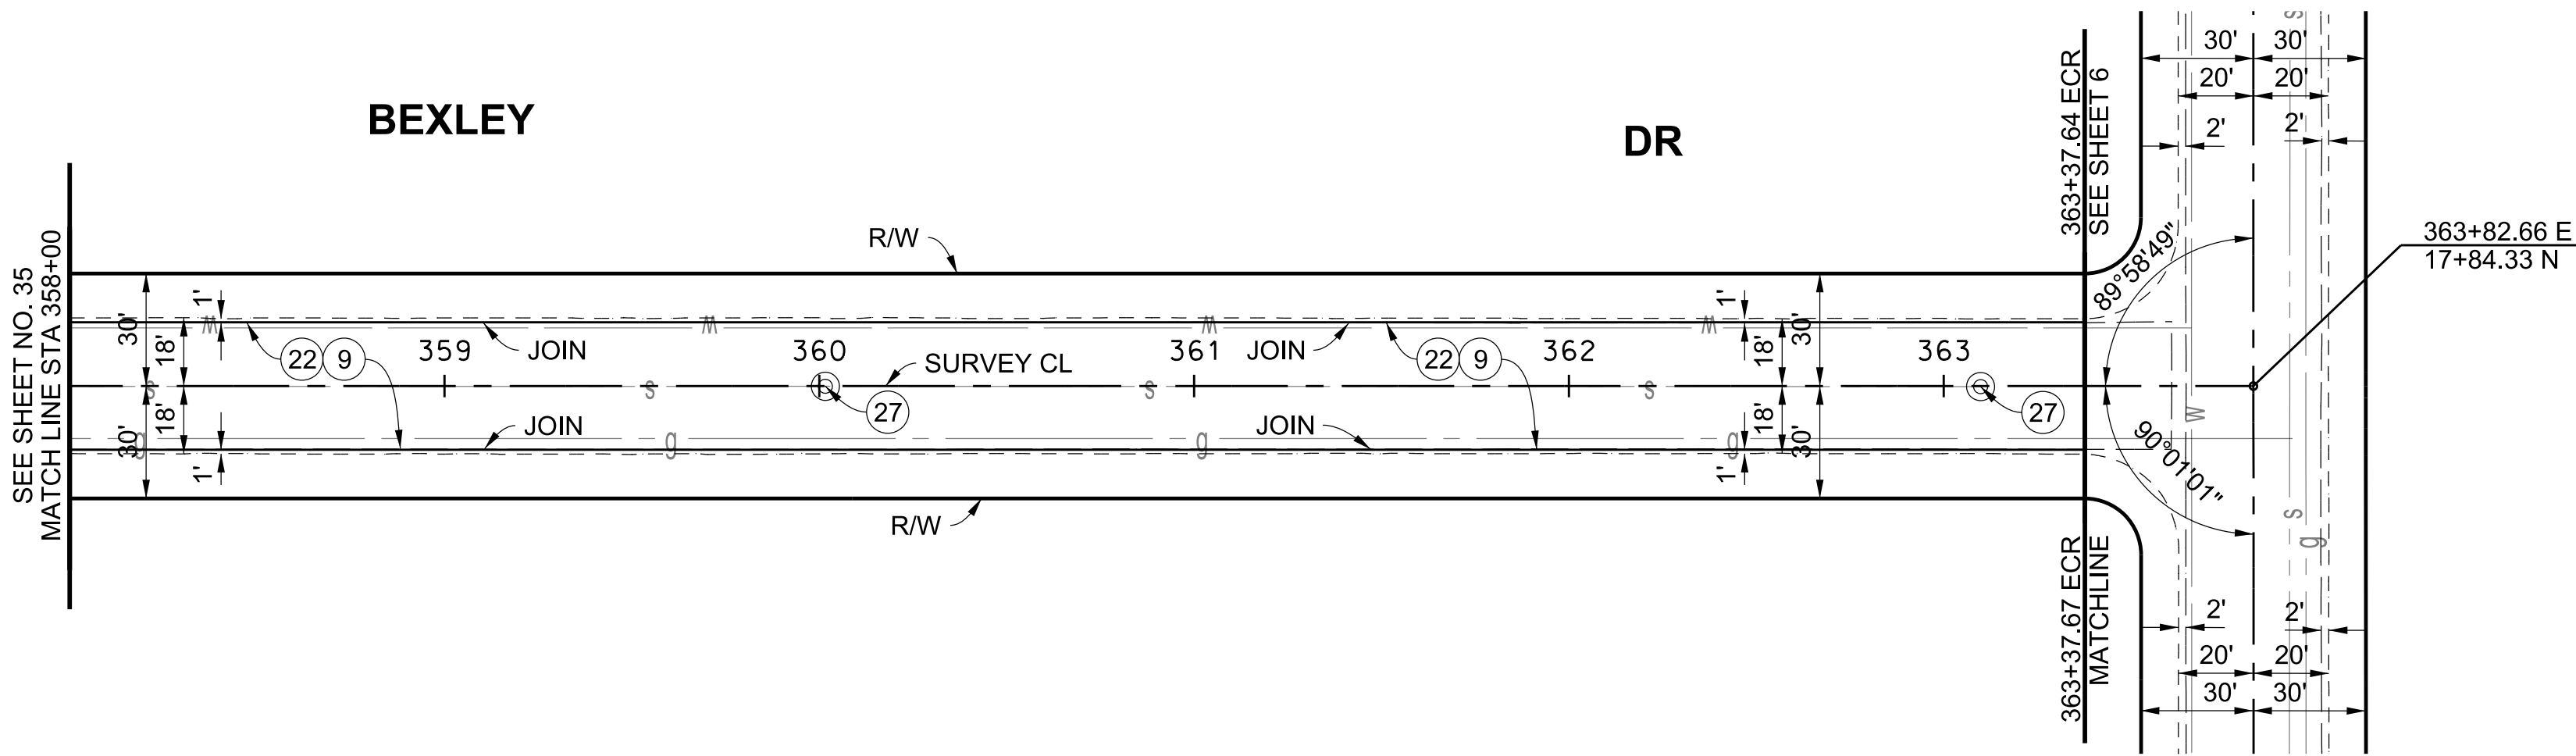

**BENCHMARK**  
PT 125, ELEV 168.97 (WHITTIER & BASELINE QUAD 2005), PWFB 1026, PG 2125  
C/L INT BEXLEY DR & GLENGARRY AVE FD S&T, DN 1" PER R1

LOS ANGELES COUNTY PUBLIC WORKS  
**SOUTH WHITTIER LOS NIETOS**  
KEITH DRIVE, ET AL.  
PROJECT ID NO. RMD4408001  
PLAN AND PROFILE



PROJECT ENGINEER: R. S. DATE: 6/24/19

DATE	MARK	DESCRIPTION
10/25/2021	■	AS-BUILT
REVISIONS		

PLAN  
SCALE: 1"=40'

