



SCALE: HOR. 1"= 40'  
VERT. 1"= 8'

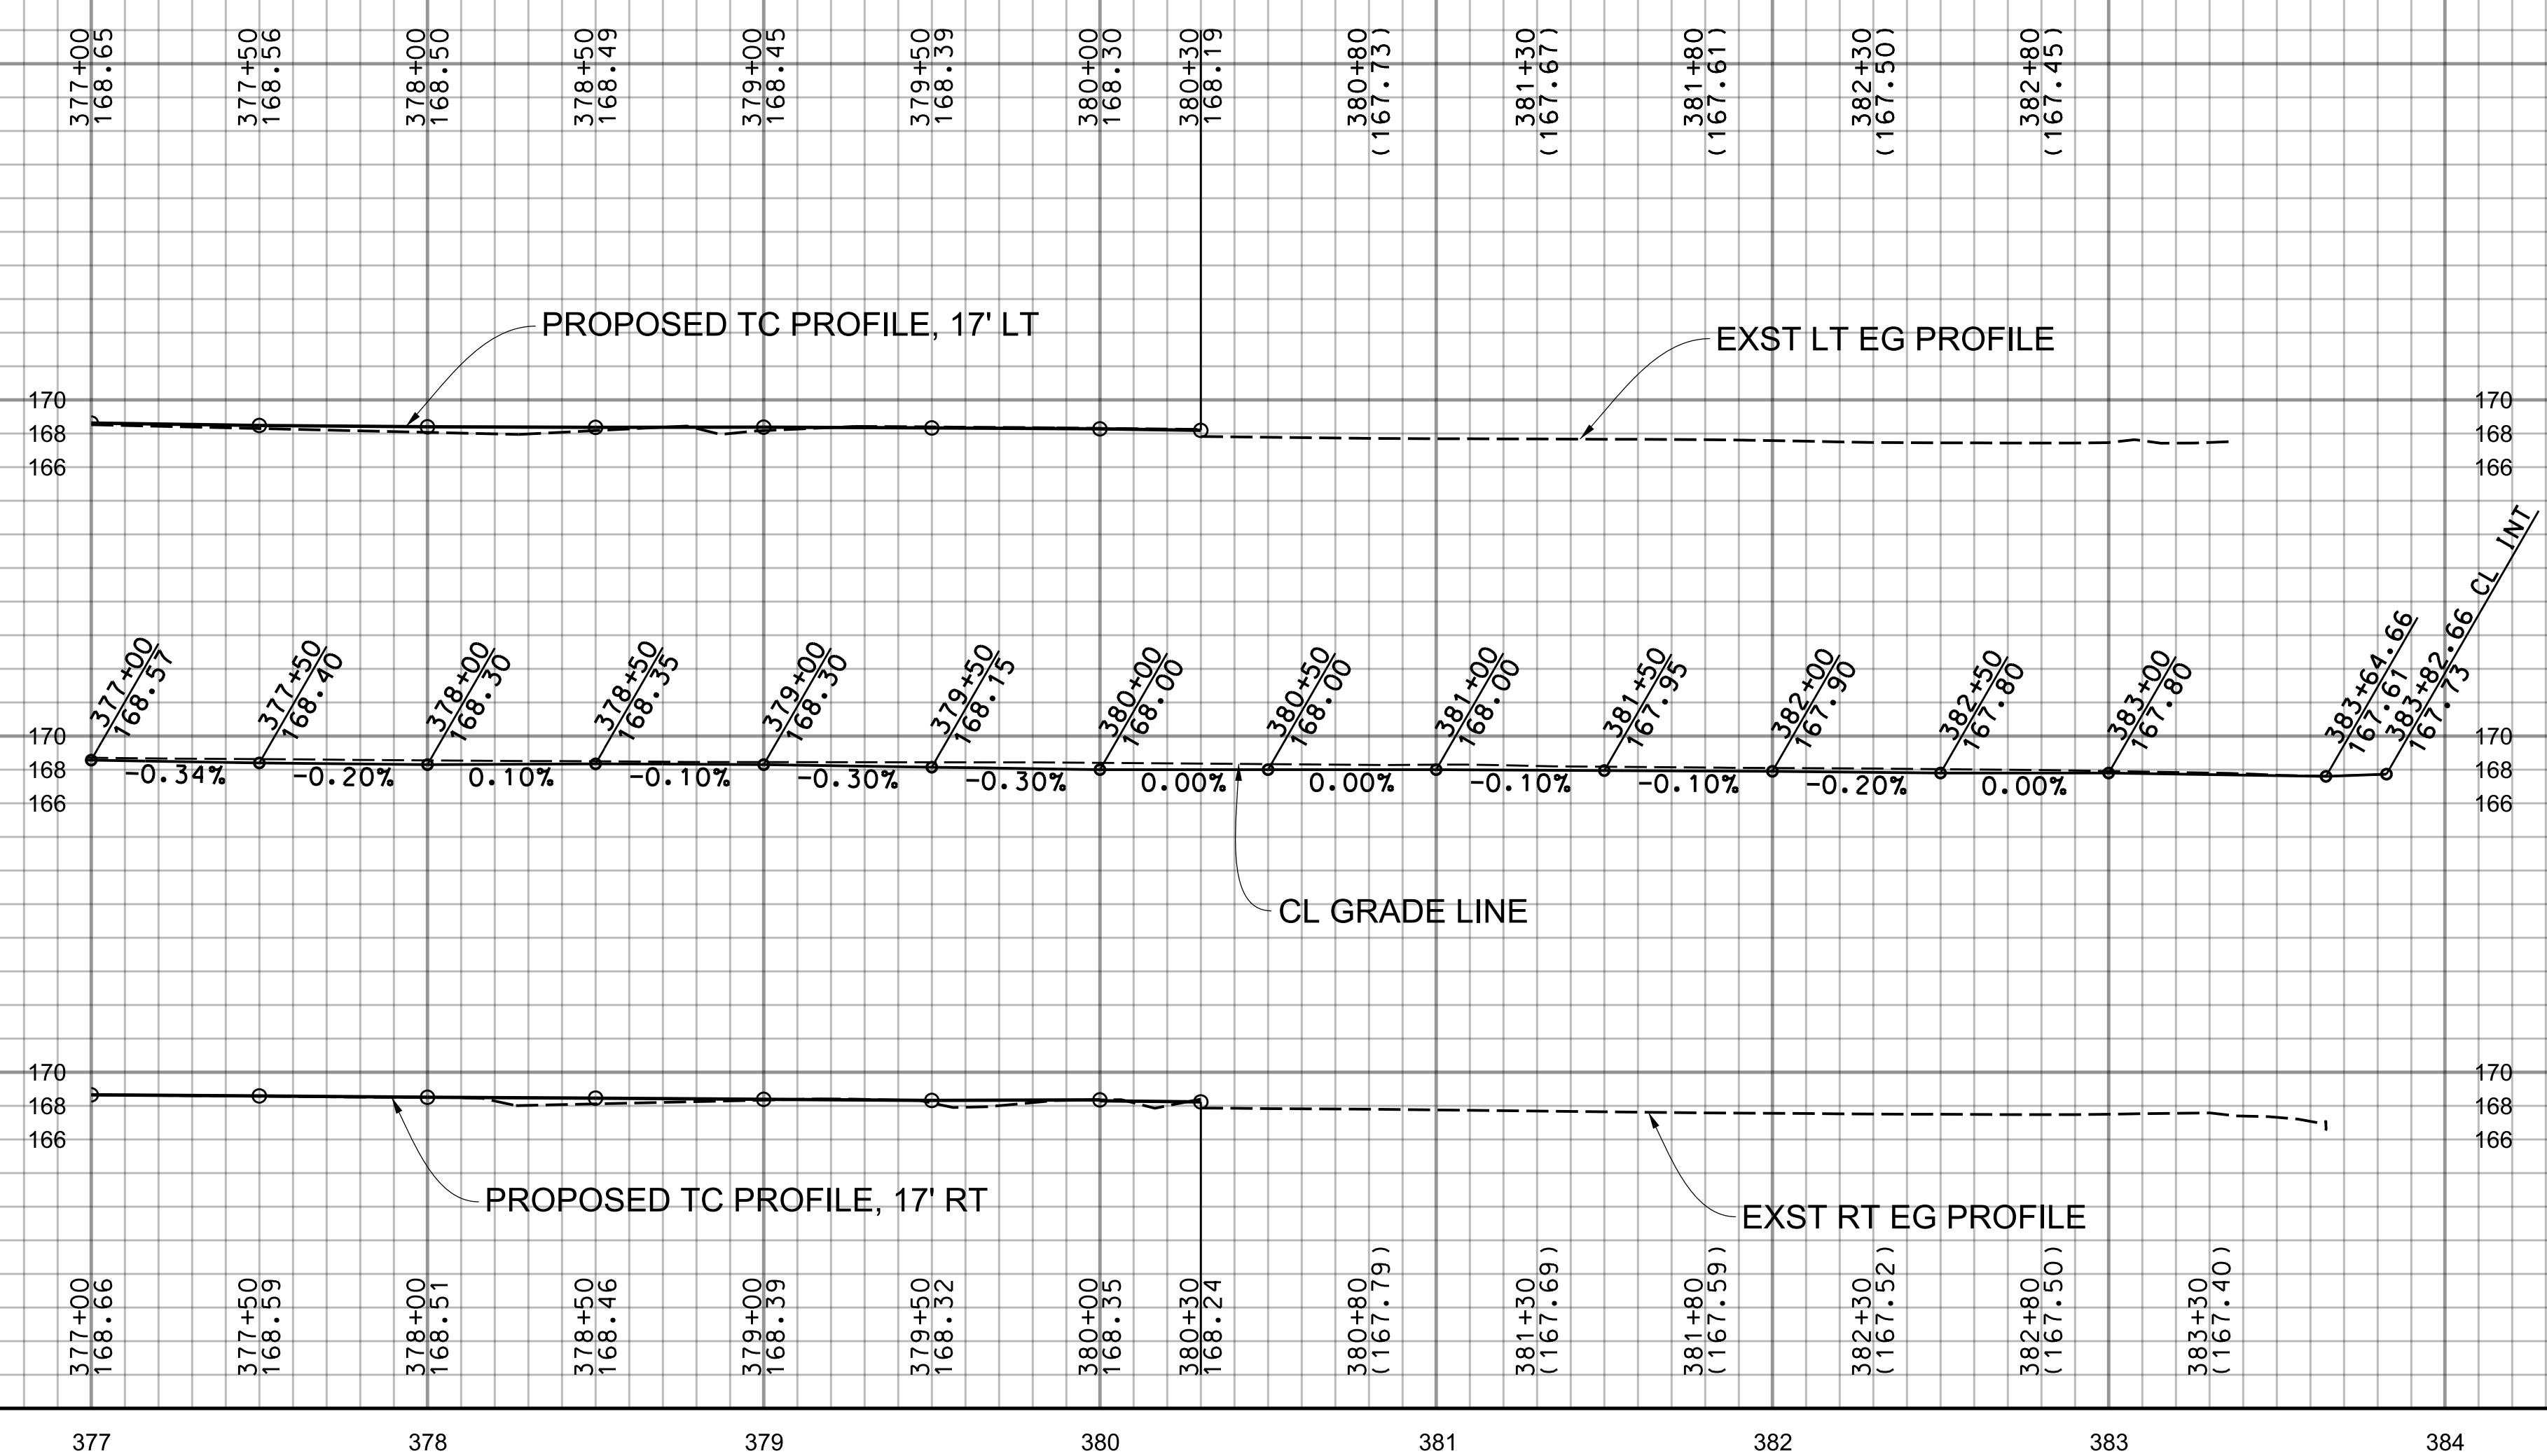

377 378 379 380 381 382 383 384

SEE SHEET 73 FOR PARKWAY IMPROVEMENTS

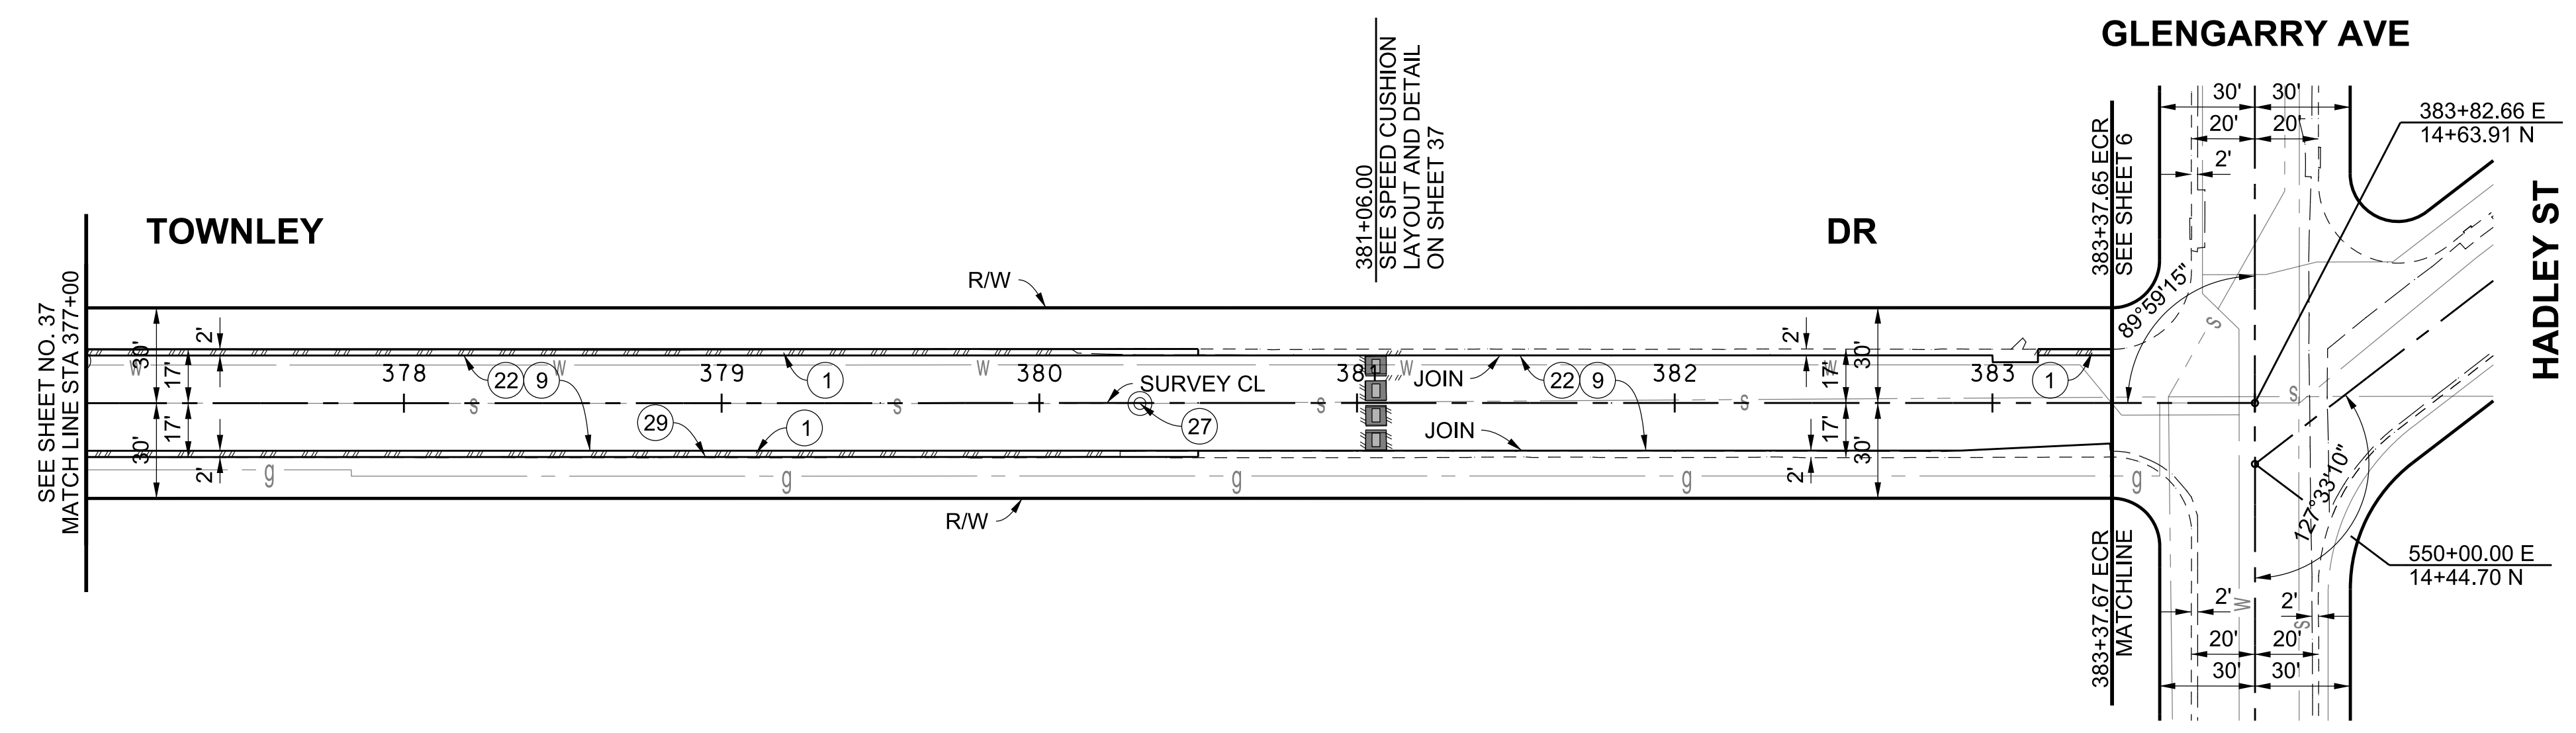

**BENCHMARK**  
PT 136, ELEV 166.77 (WHITTIER & BASELINE QUAD 2005), PWFB 1026, PG 2126  
CL INT TOWNLEY DR & GLENGARRY AVE FD CO SUR MON IN HH, PER R1  
RAISED LID TO SURF.

LOS ANGELES COUNTY PUBLIC WORKS


**SOUTH WHITTIER LOS NIETOS**  
KEITH DRIVE, ET AL.

PROJECT ID NO. RMD4408001  
PLAN AND PROFILE



PROJECT ENGINEER: R.S. 6/24/19

DATE	MARK	DESCRIPTION
10/25/2021	AS-BUILT	
REVISIONS		

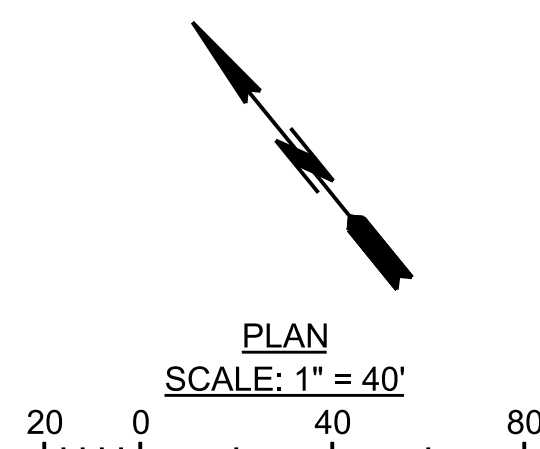

CADD PROJECT FILE NAME: \$FILESS  
CHECKER: B. FUNG  
DESIGNER: J. GARCIA  
DRAFTER: J. GARCIA