
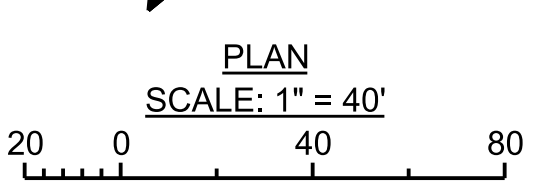
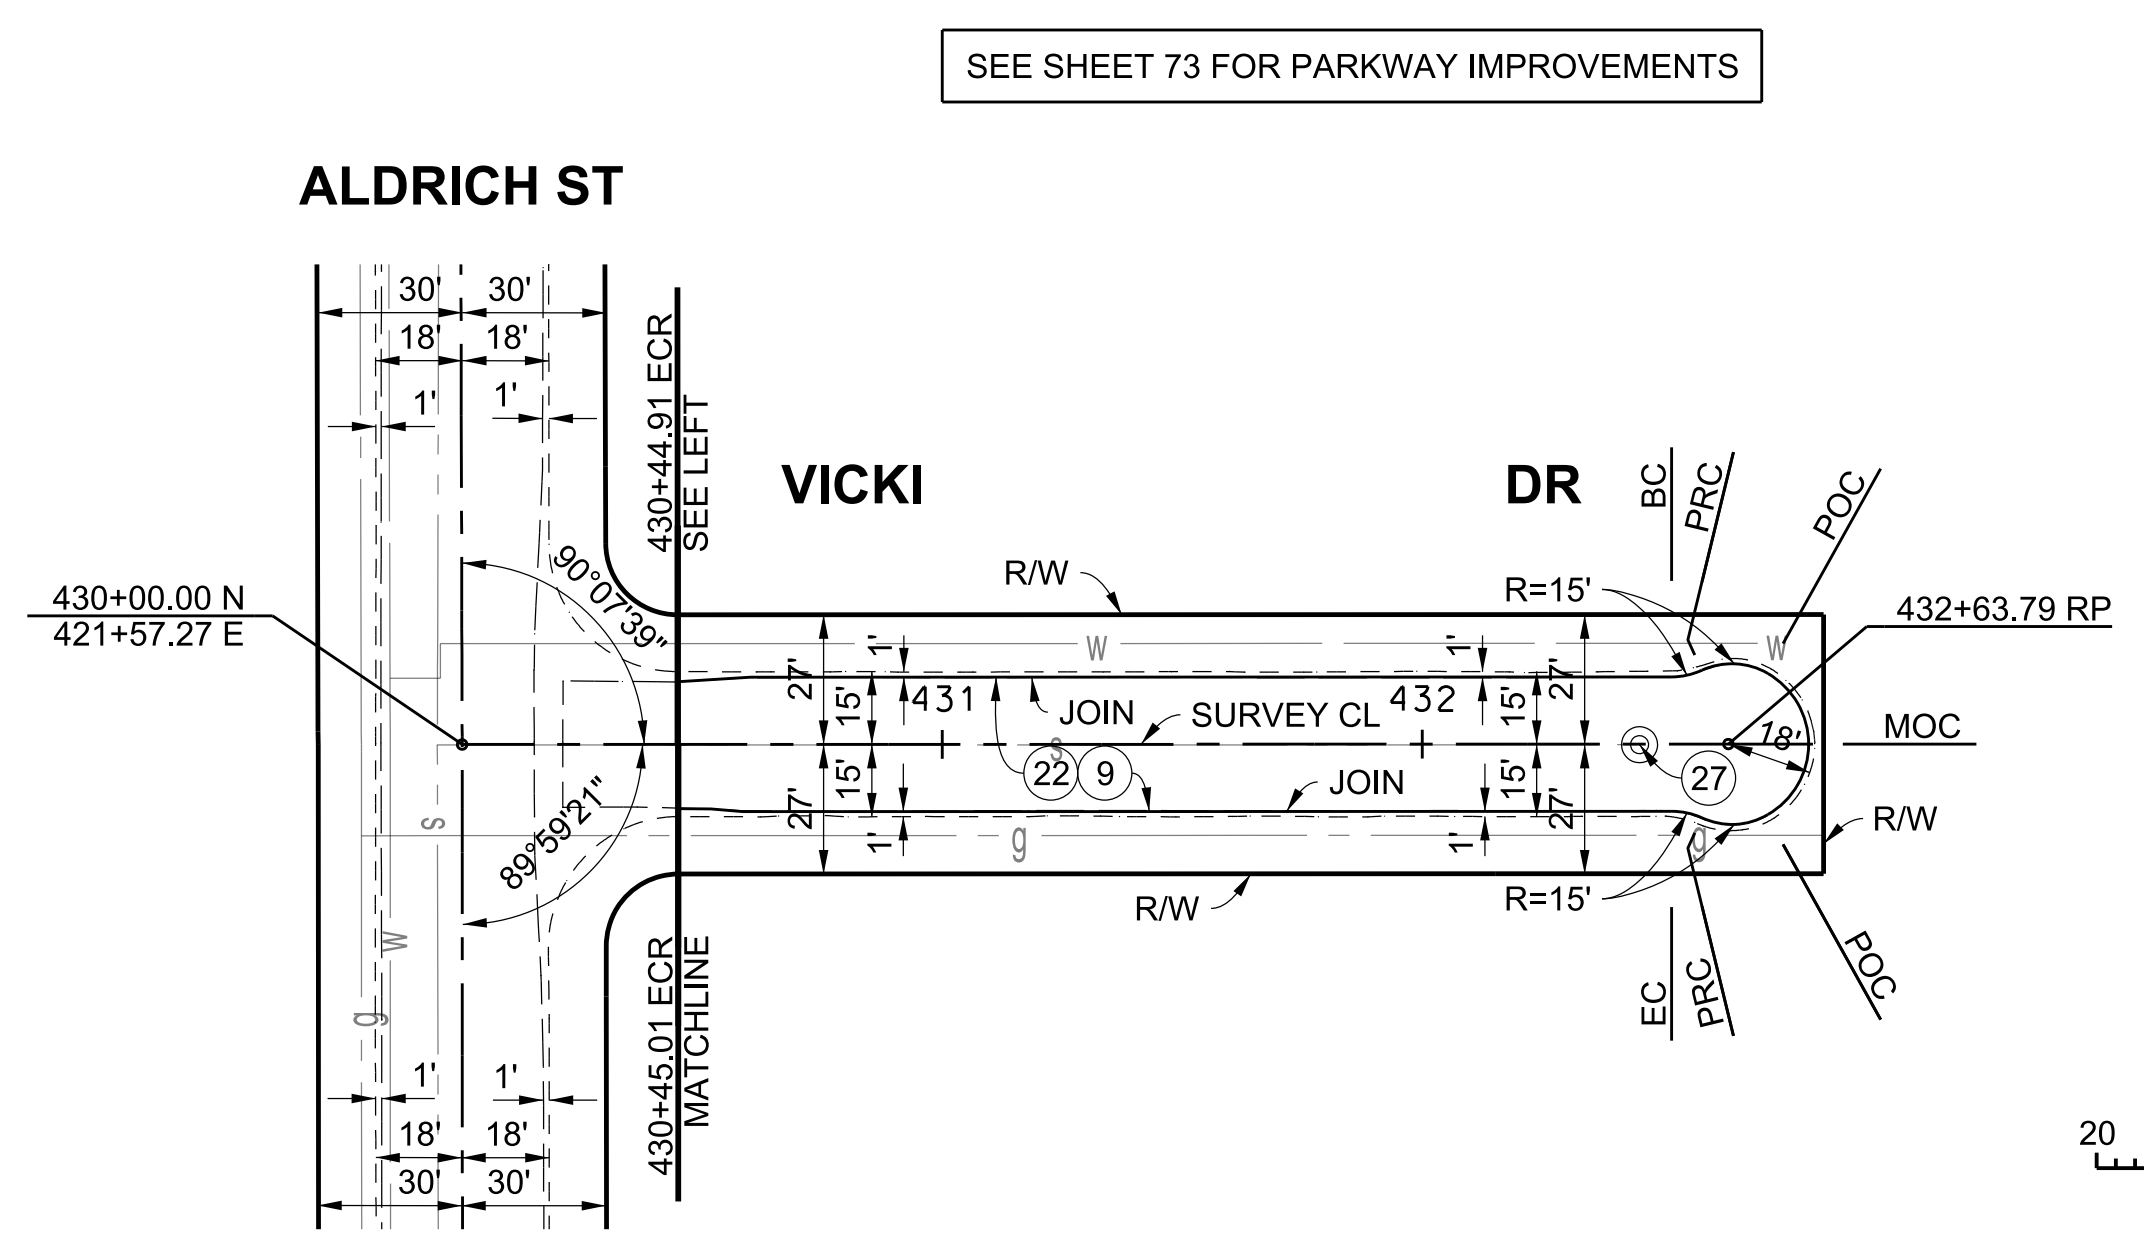
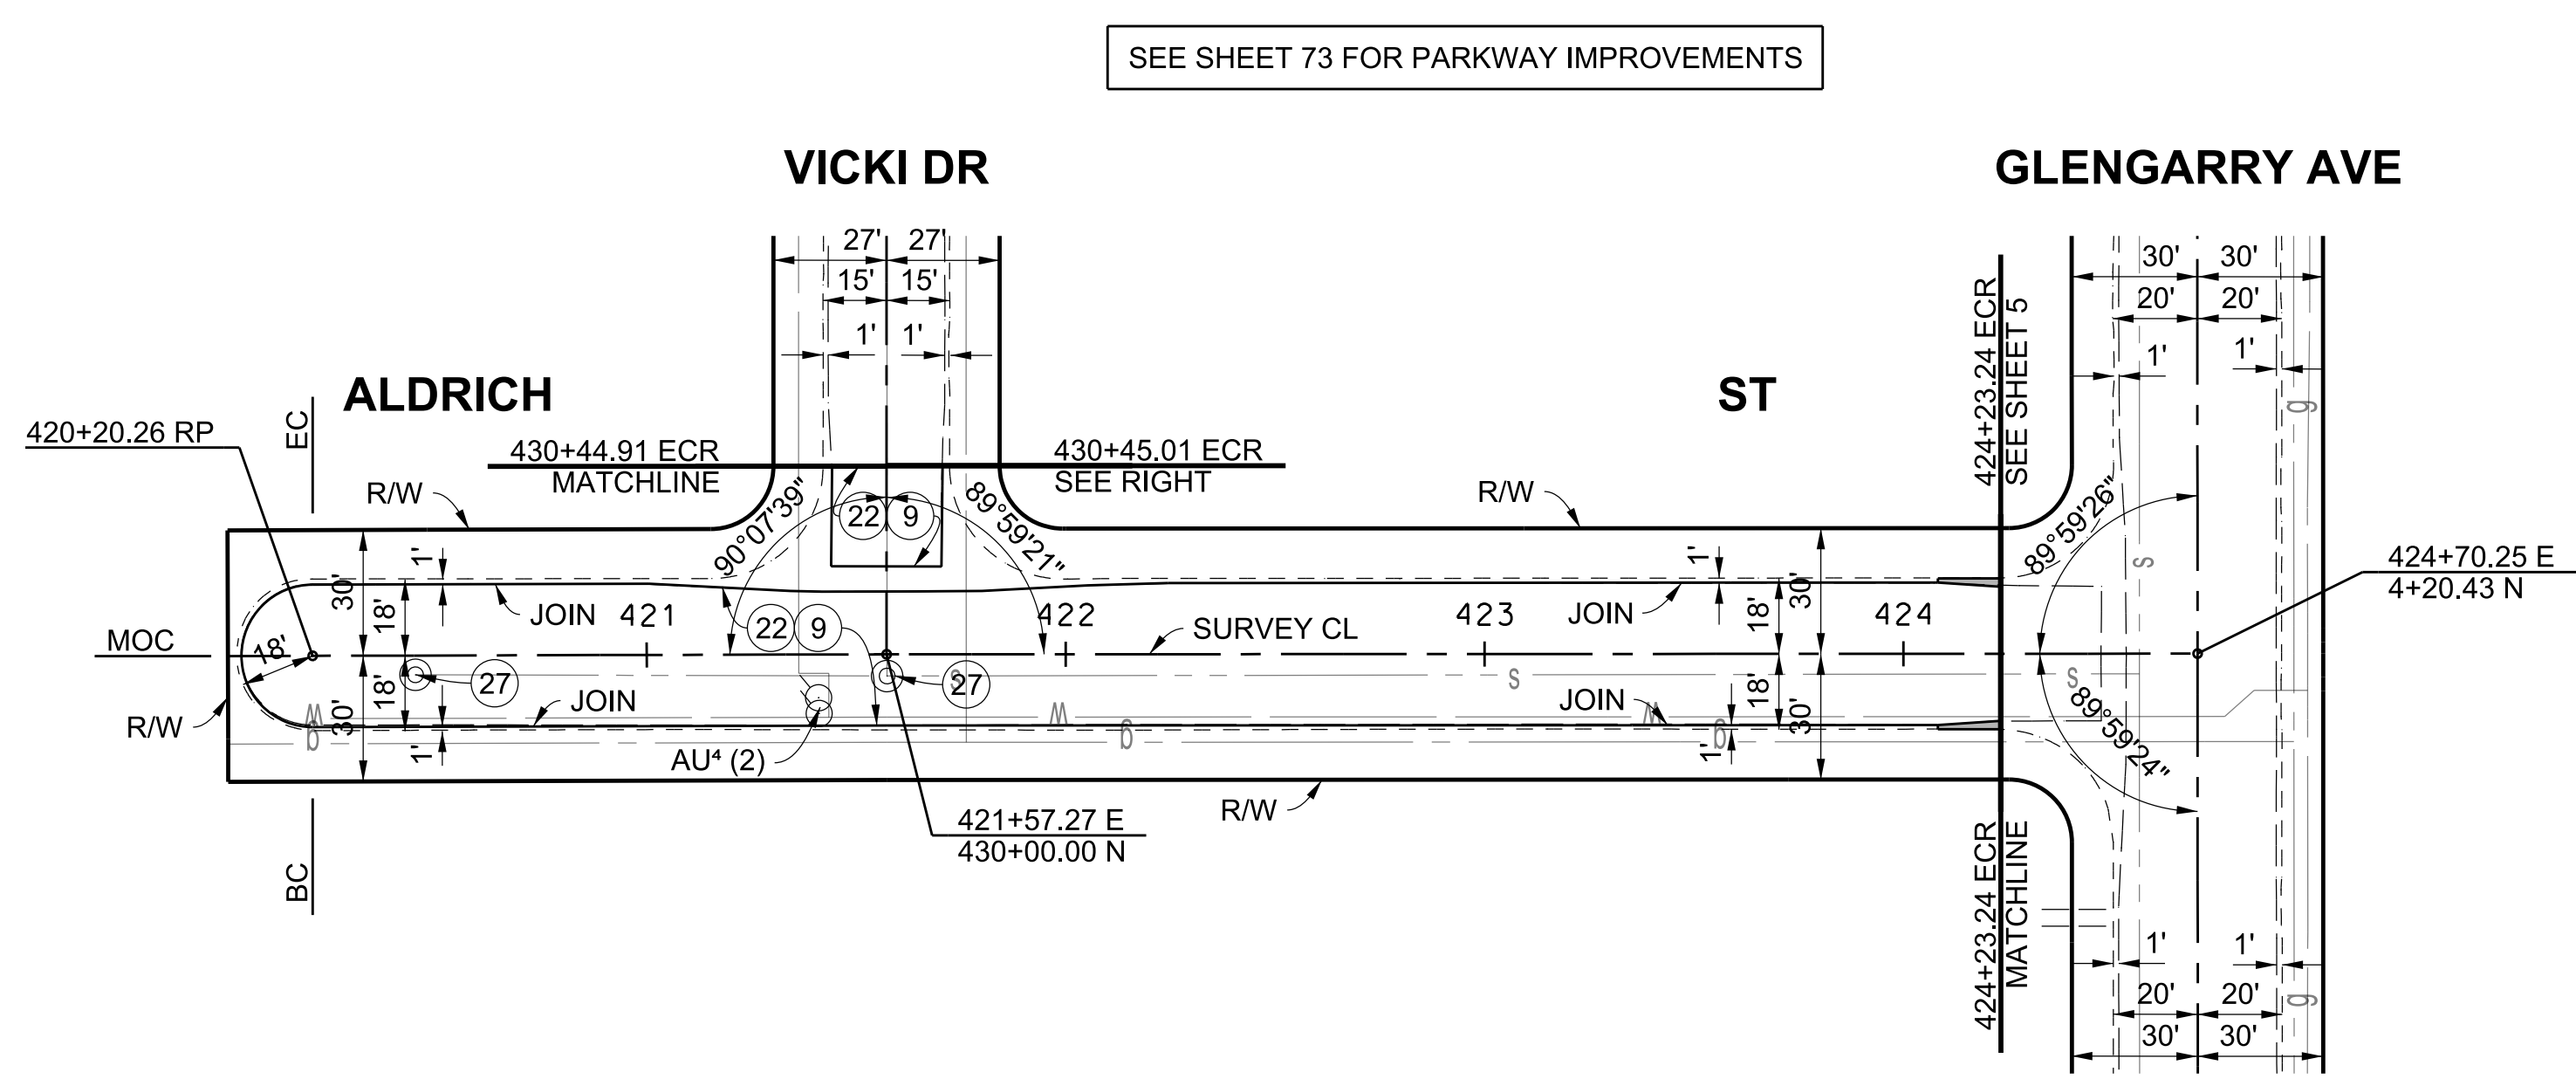
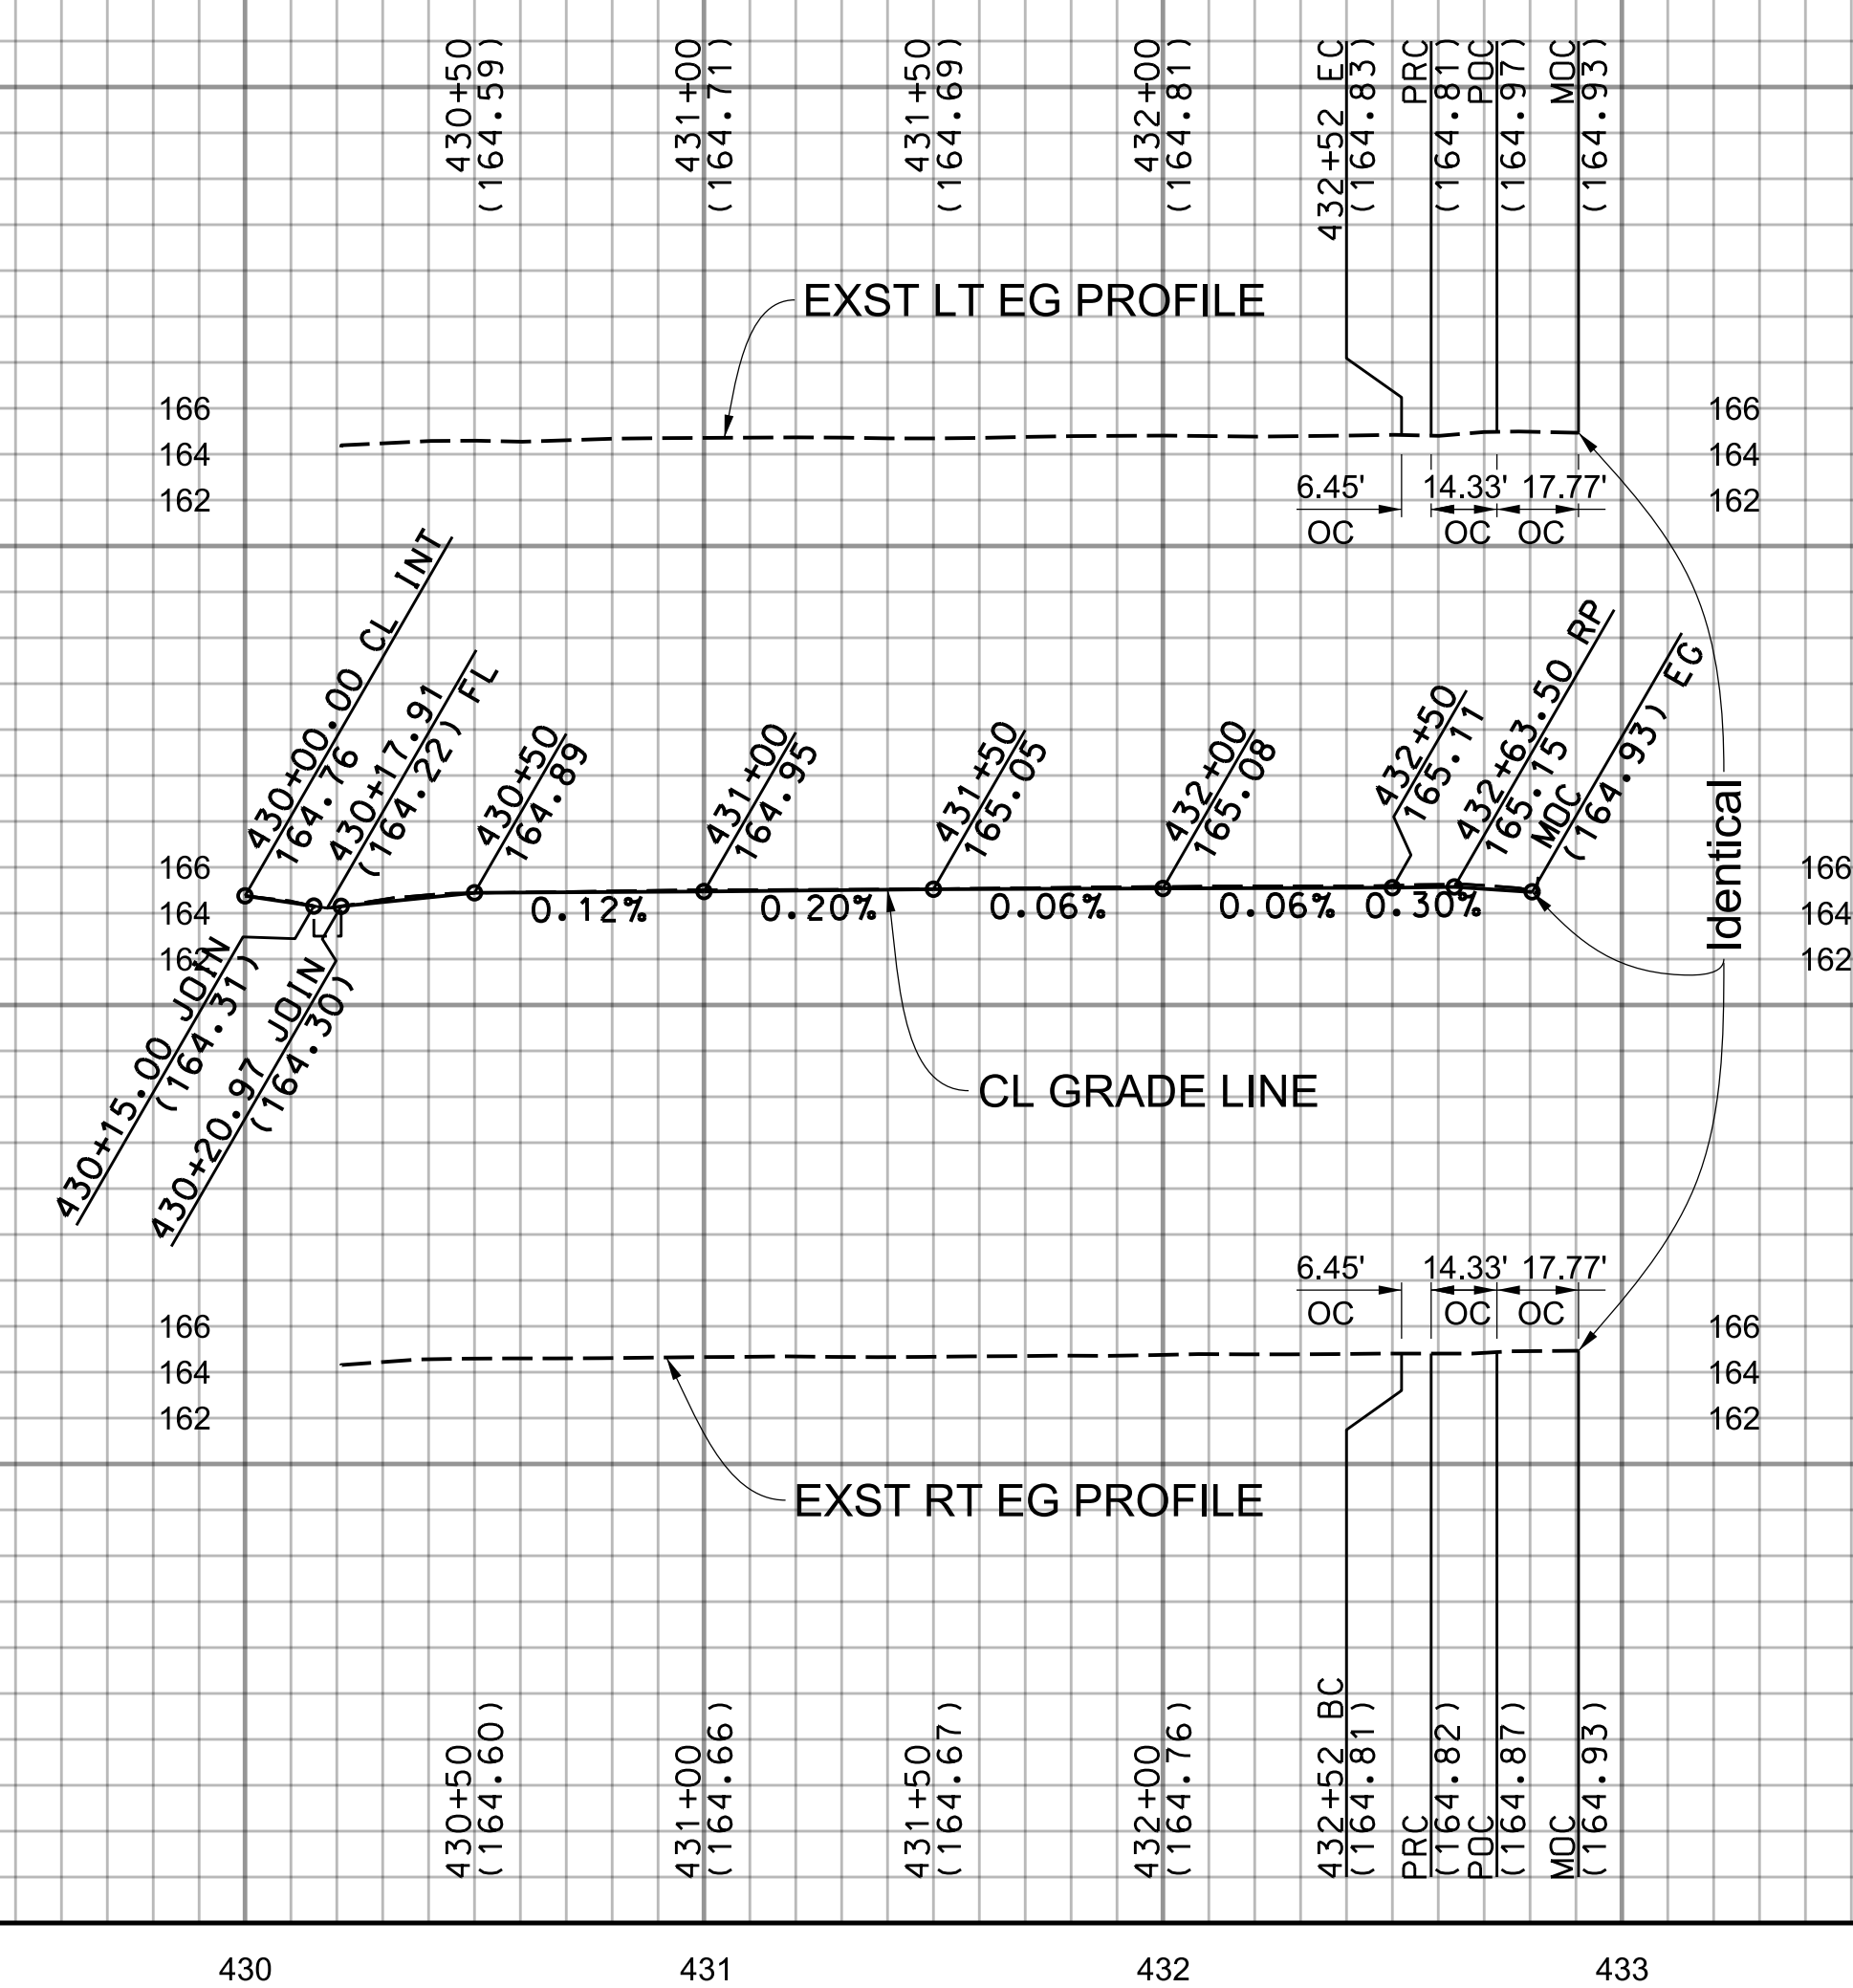


SCALE: HOR. 1"= 40'
VERT. 1"= 8'

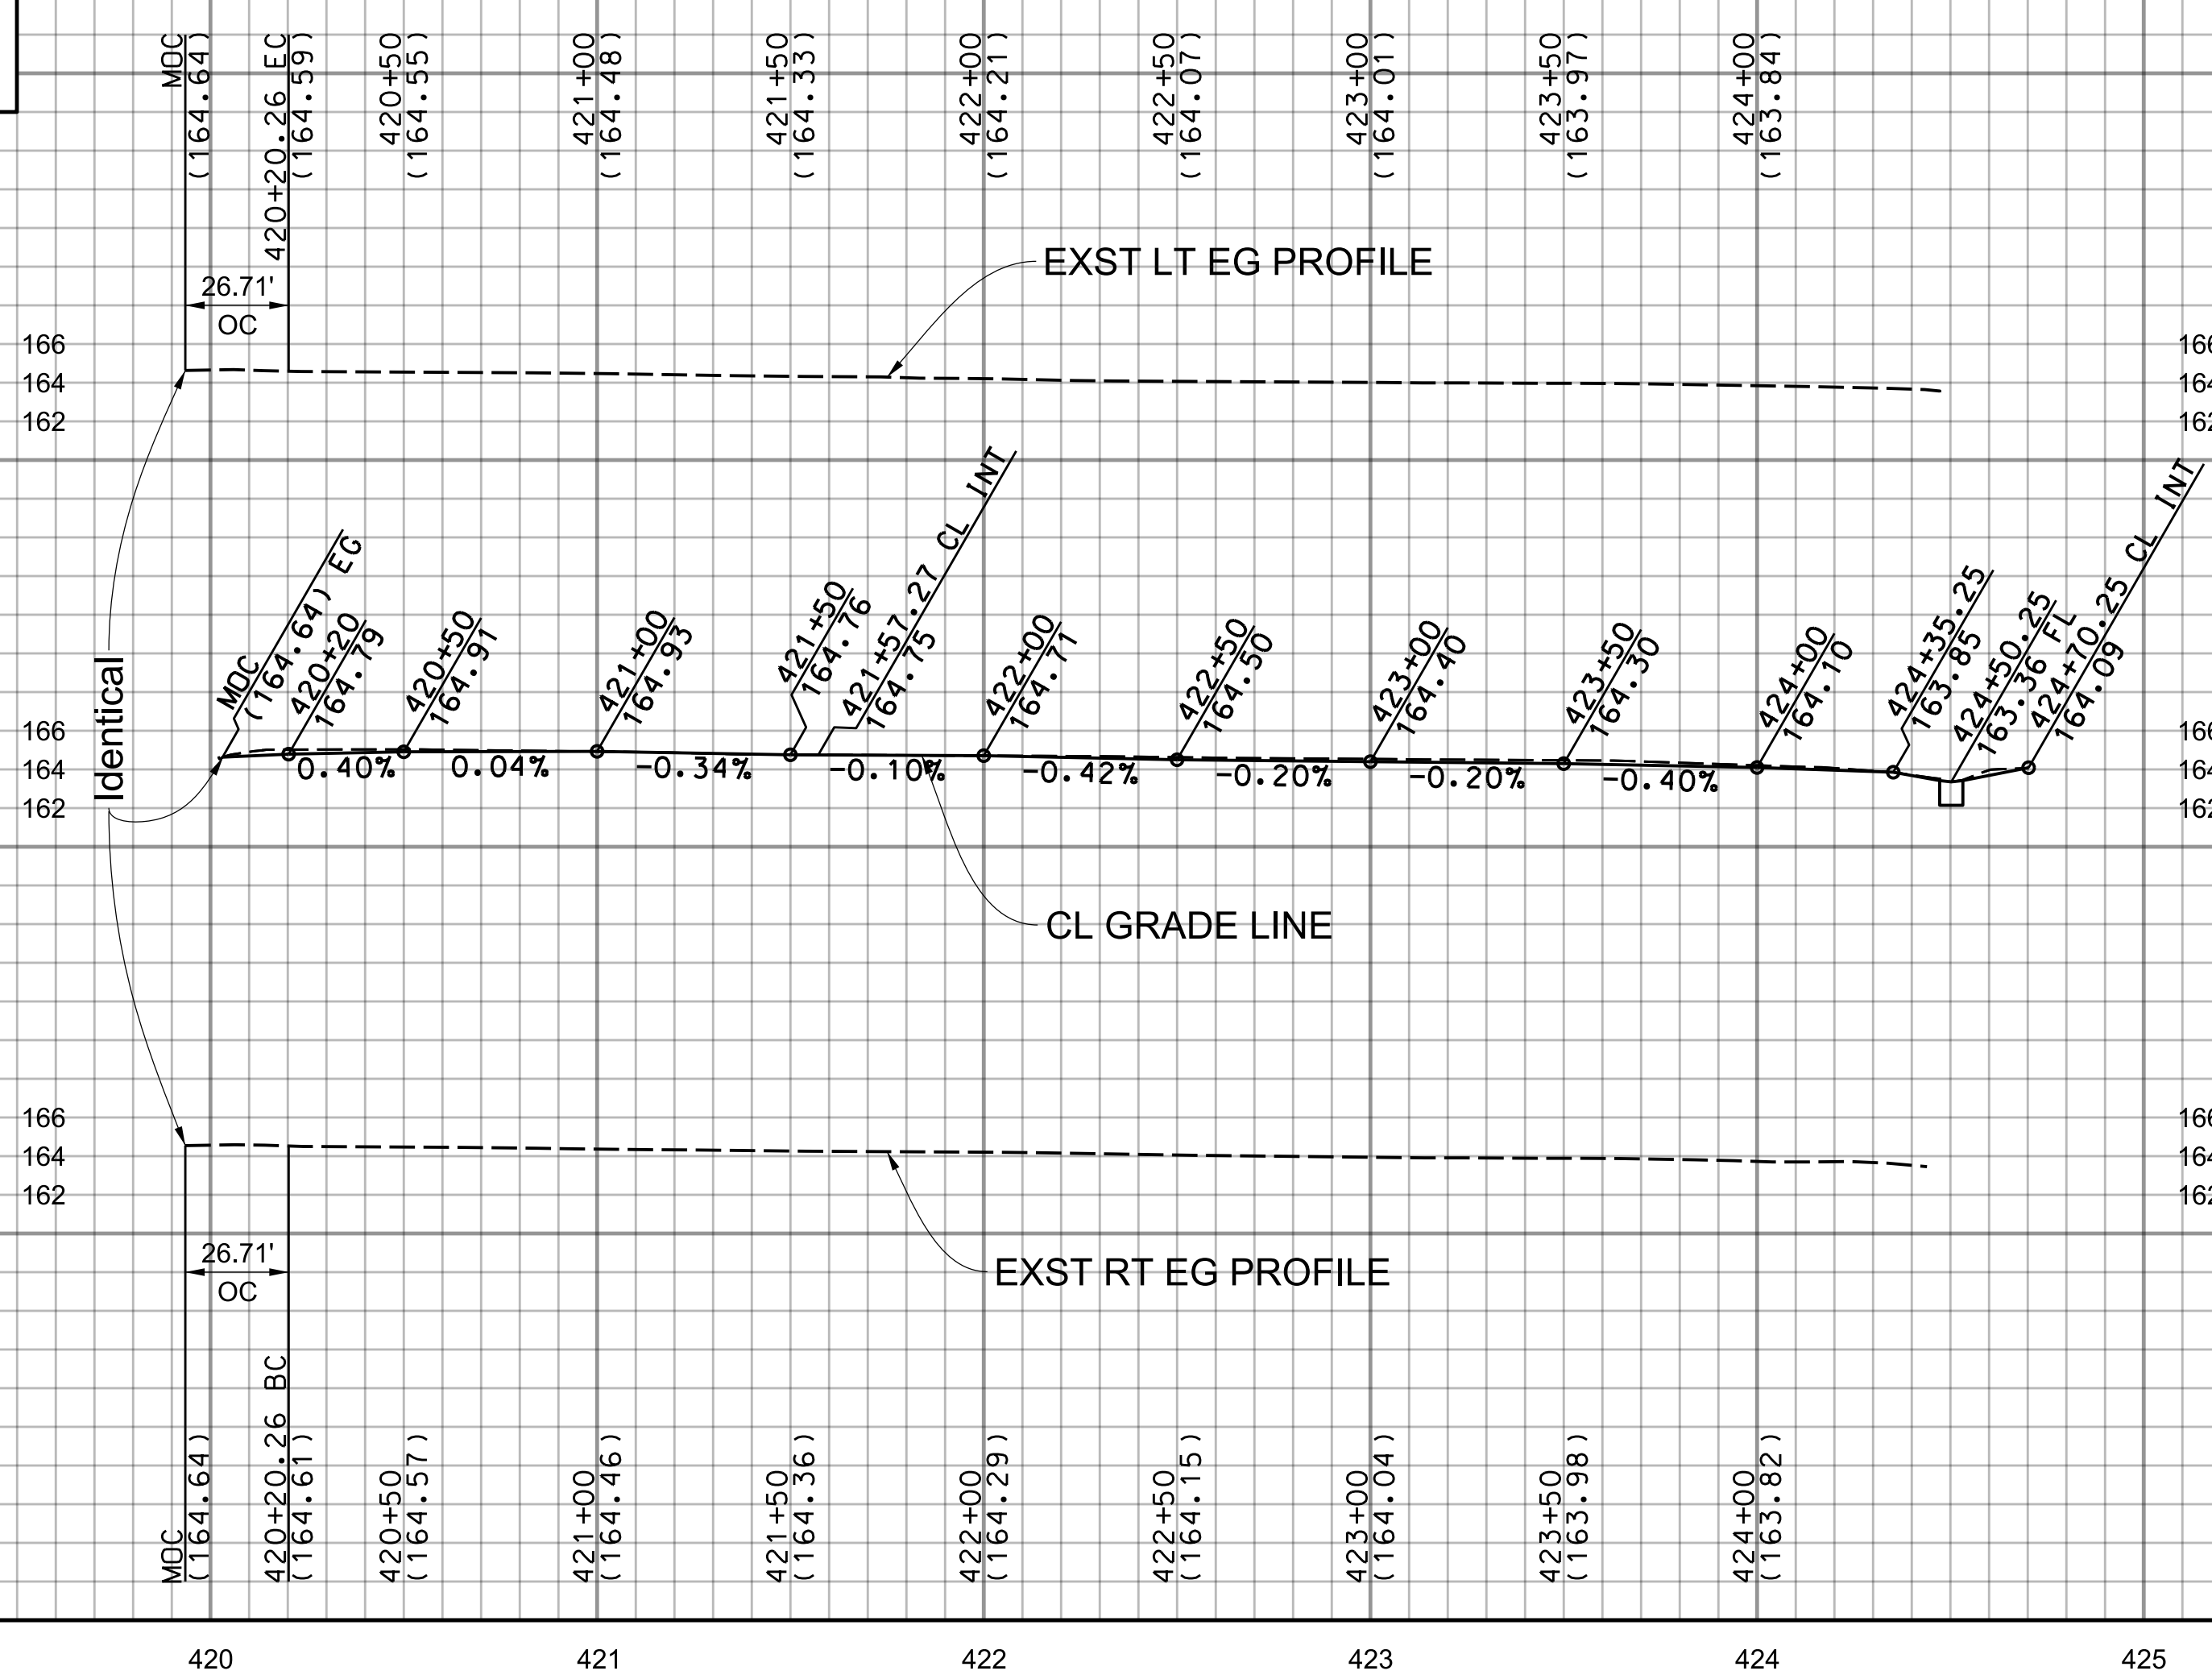


SEE SHEET 73 FOR PARKWAY IMPROVEMENTS

SEE SHEET 73 FOR PARKWAY IMPROVEMENTS

BENCHMARK
PT 207, ELEV 164.72 (WHITTIER & BASELINE QUAD 2005), PWFB 1026, PG 2139
CL INT ALDRICH ST & VICKI DR PT. FD SPK. W & T PER R1, FLUSH

BENCHMARK
PT 207, ELEV 164.72 (WHITTIER & BASELINE QUAD 2005), PWFB 1026, PG 2139
CL INT ALDRICH ST & VICKI DR PT. FD SPK. W & T PER R1, FLUSH

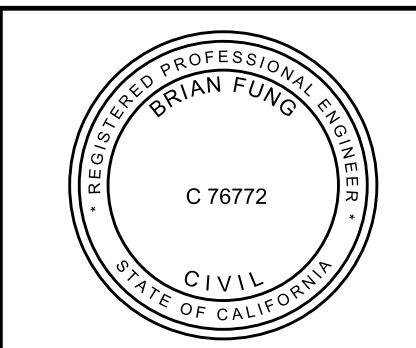

PROJECT ENGINEER: R.S. 6/24/19

LOS ANGELES COUNTY PUBLIC WORKS
SOUTH WHITTIER LOS NIETOS
KEITH DRIVE, ET AL.

PROJECT ID NO. RMD4408001
PLAN AND PROFILE

PD PH086561 SHEET 42 OF 79

10/25/2021	AS-BUILT	
DATE	MARK	DESCRIPTION
REVISIONS		

CADD PROJECT FILE NAME: \$FILESS\$
CHECKER: B. FUNG
DESIGNER: J. GARCIA
DRAFTER: J. GARCIA