
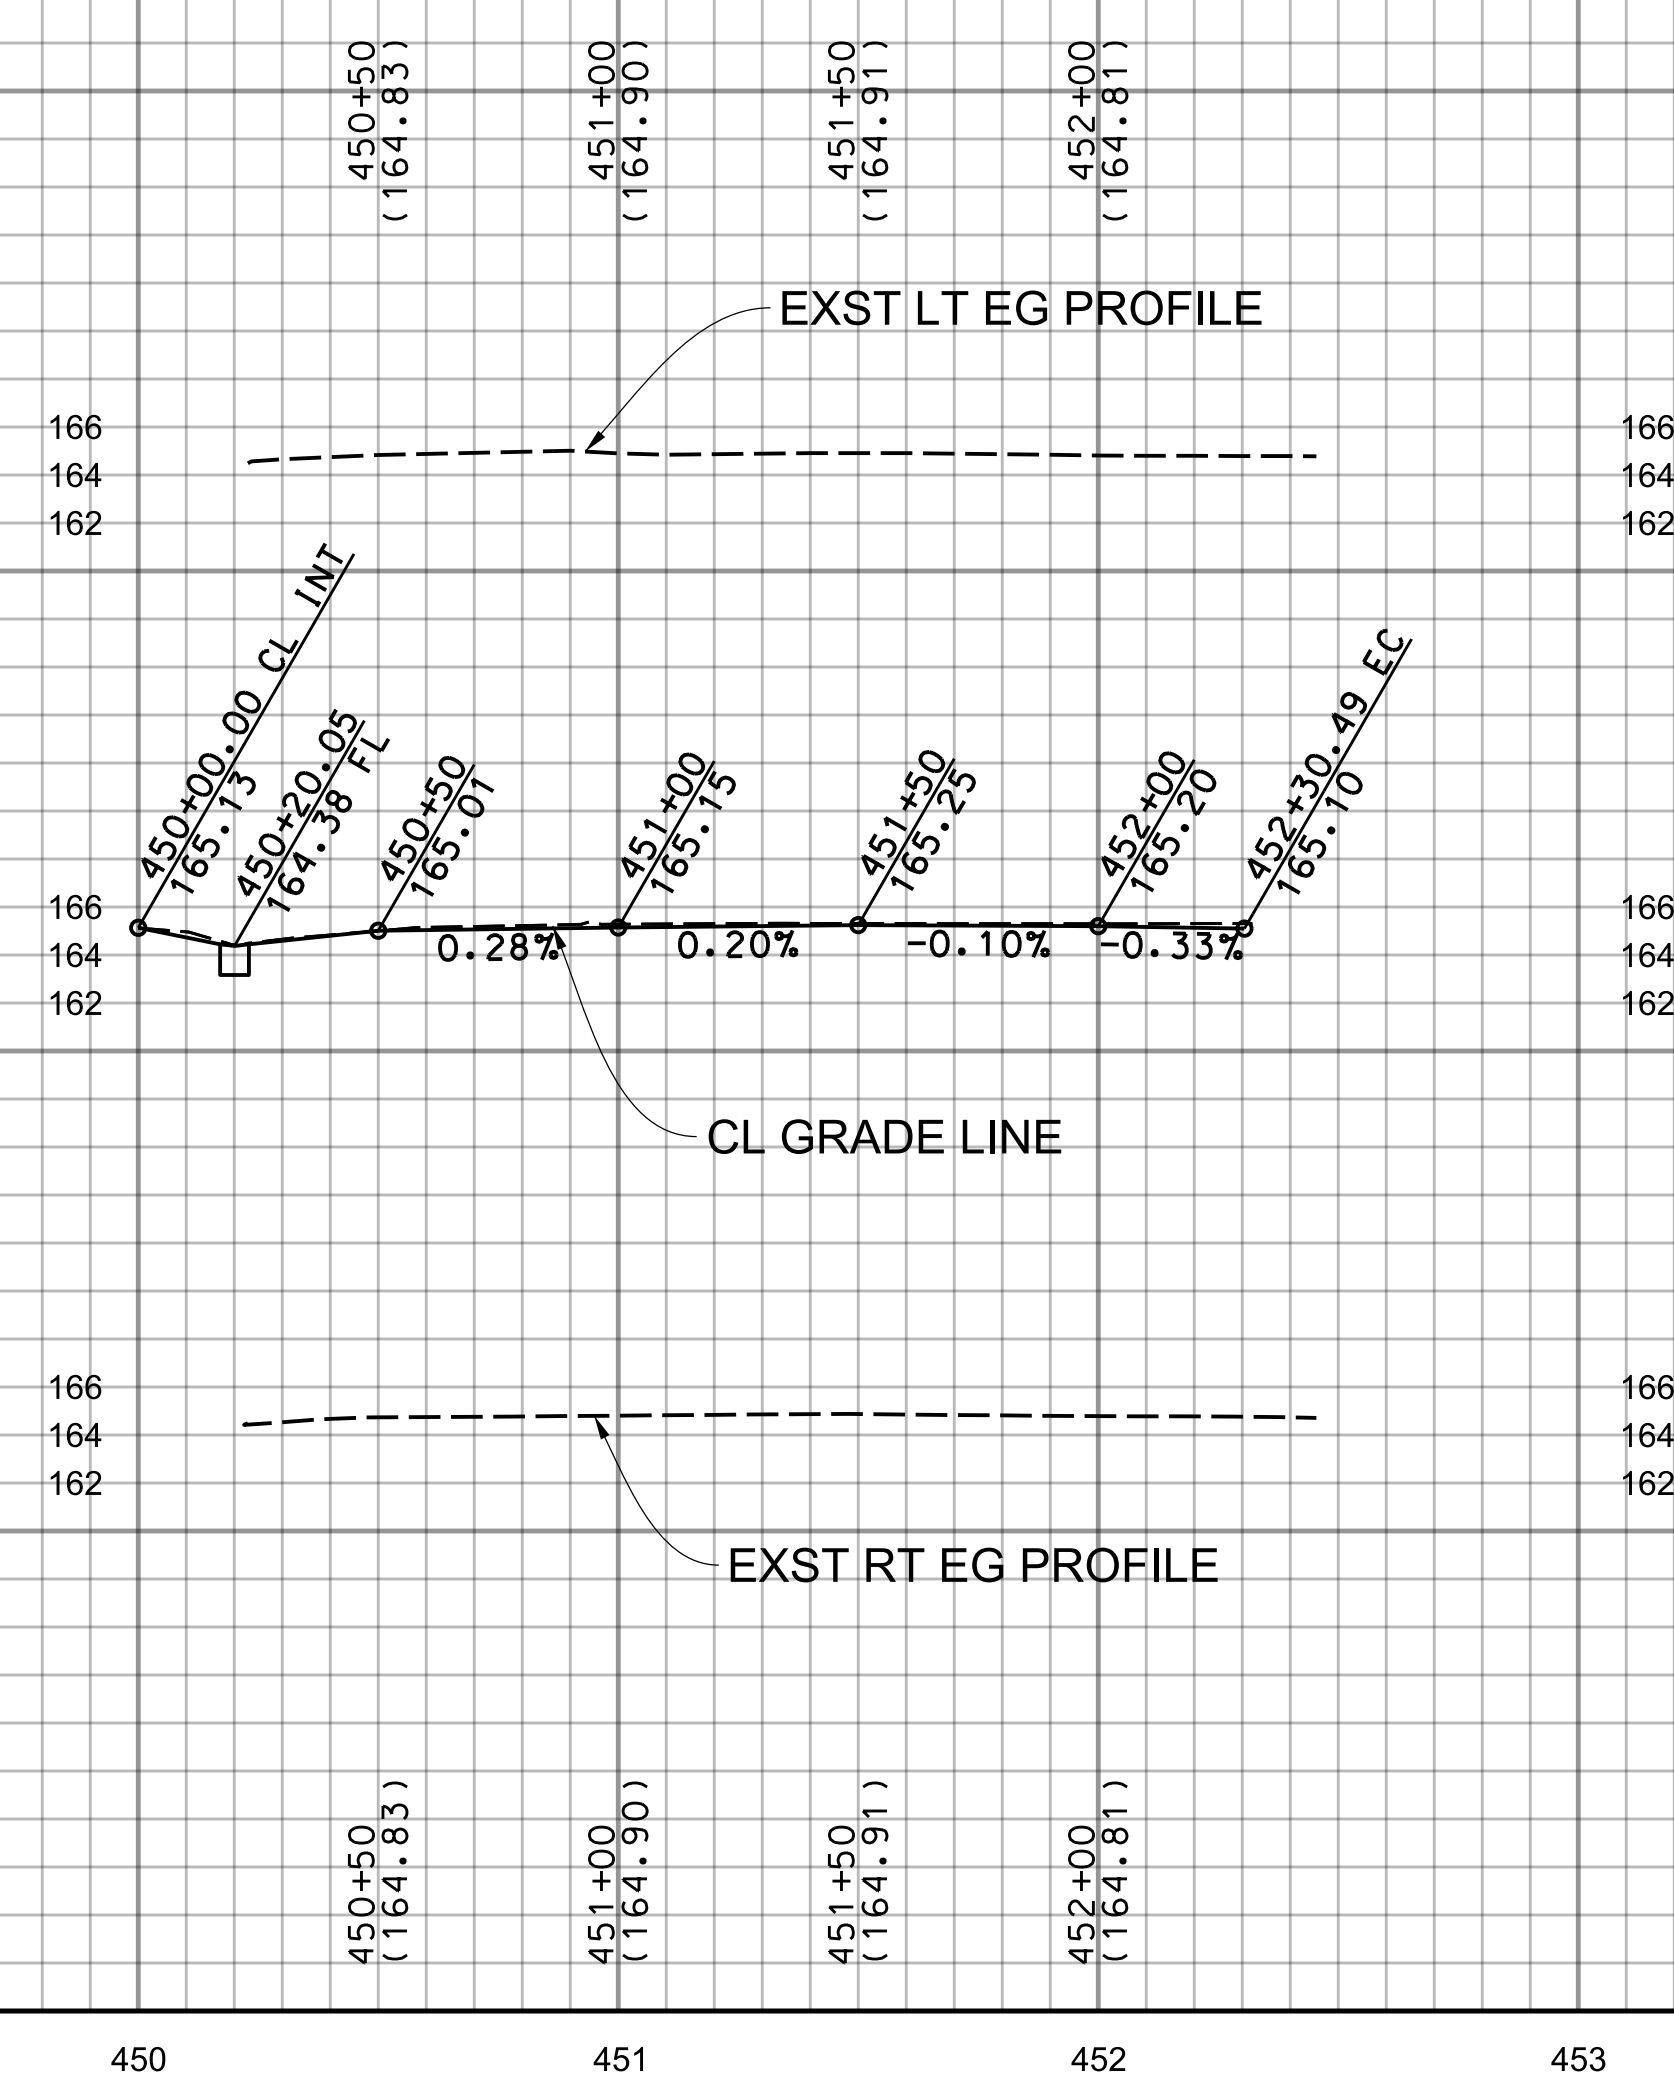






SCALE: HOR. 1" = 40'
VERT. 1" = 8'

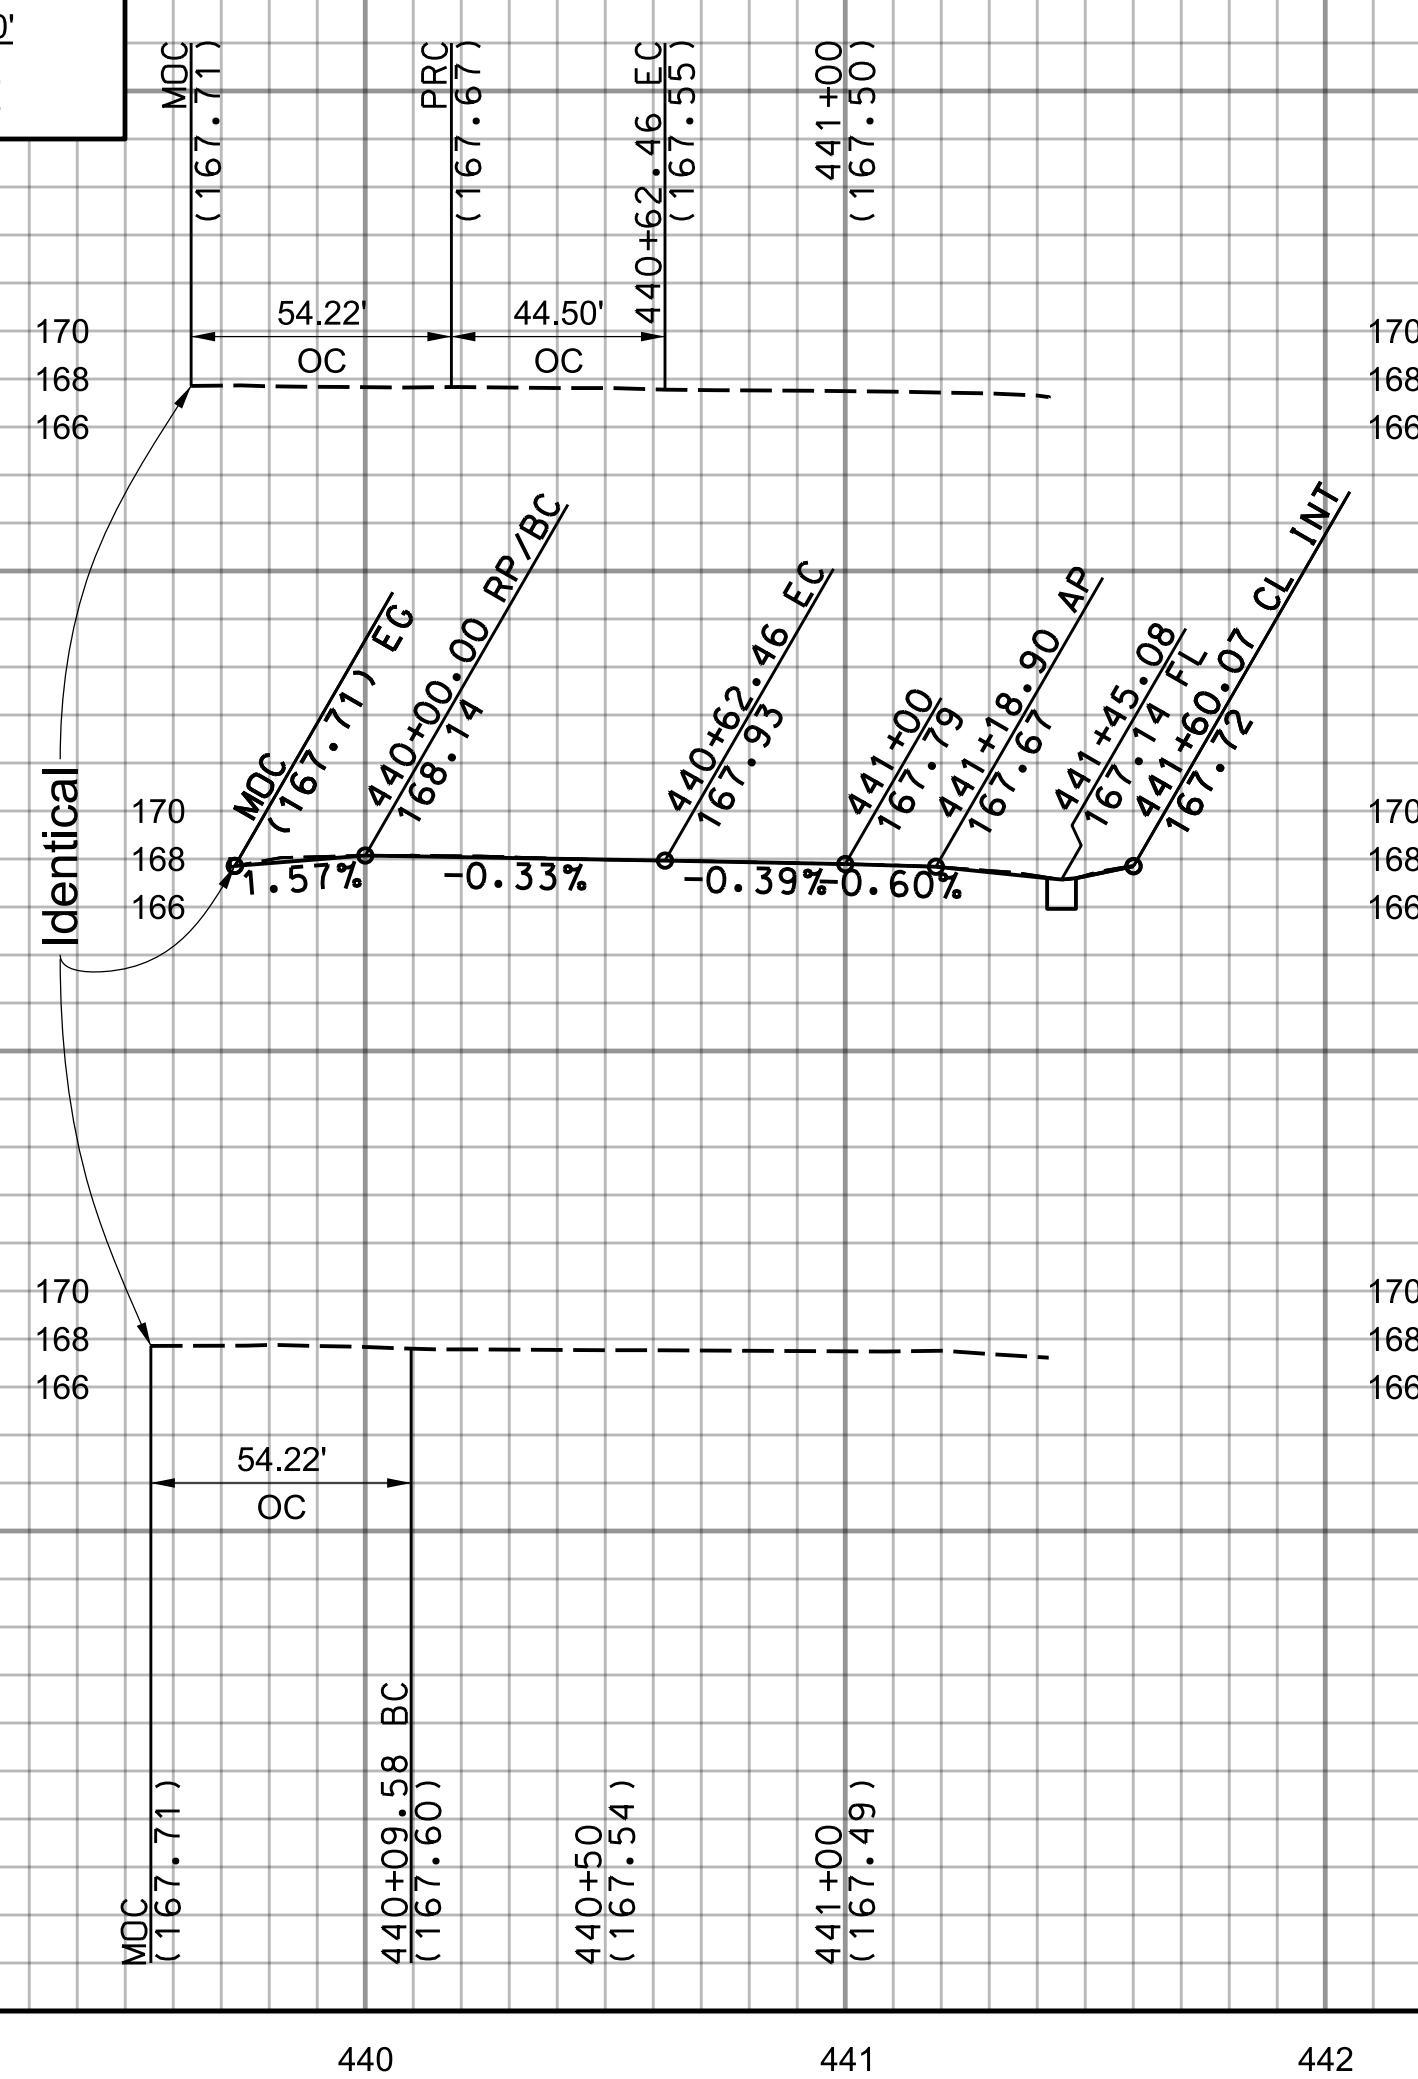

440 441 442 450 451 452 453 454

SEE SHEET 74 FOR PARKWAY IMPROVEMENTS


SEE SHEET 74 FOR PARKWAY IMPROVEMENTS

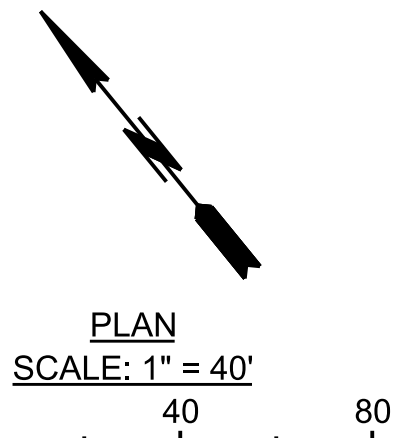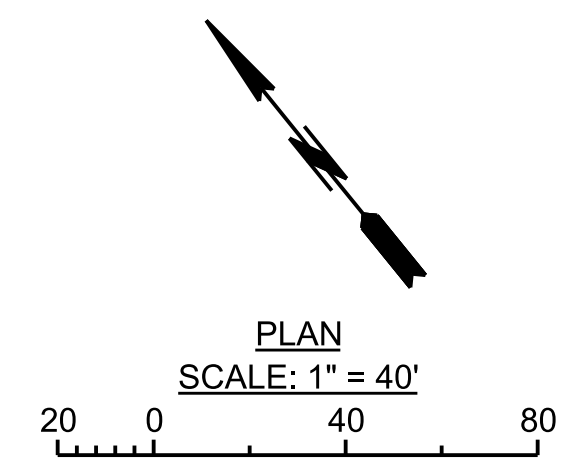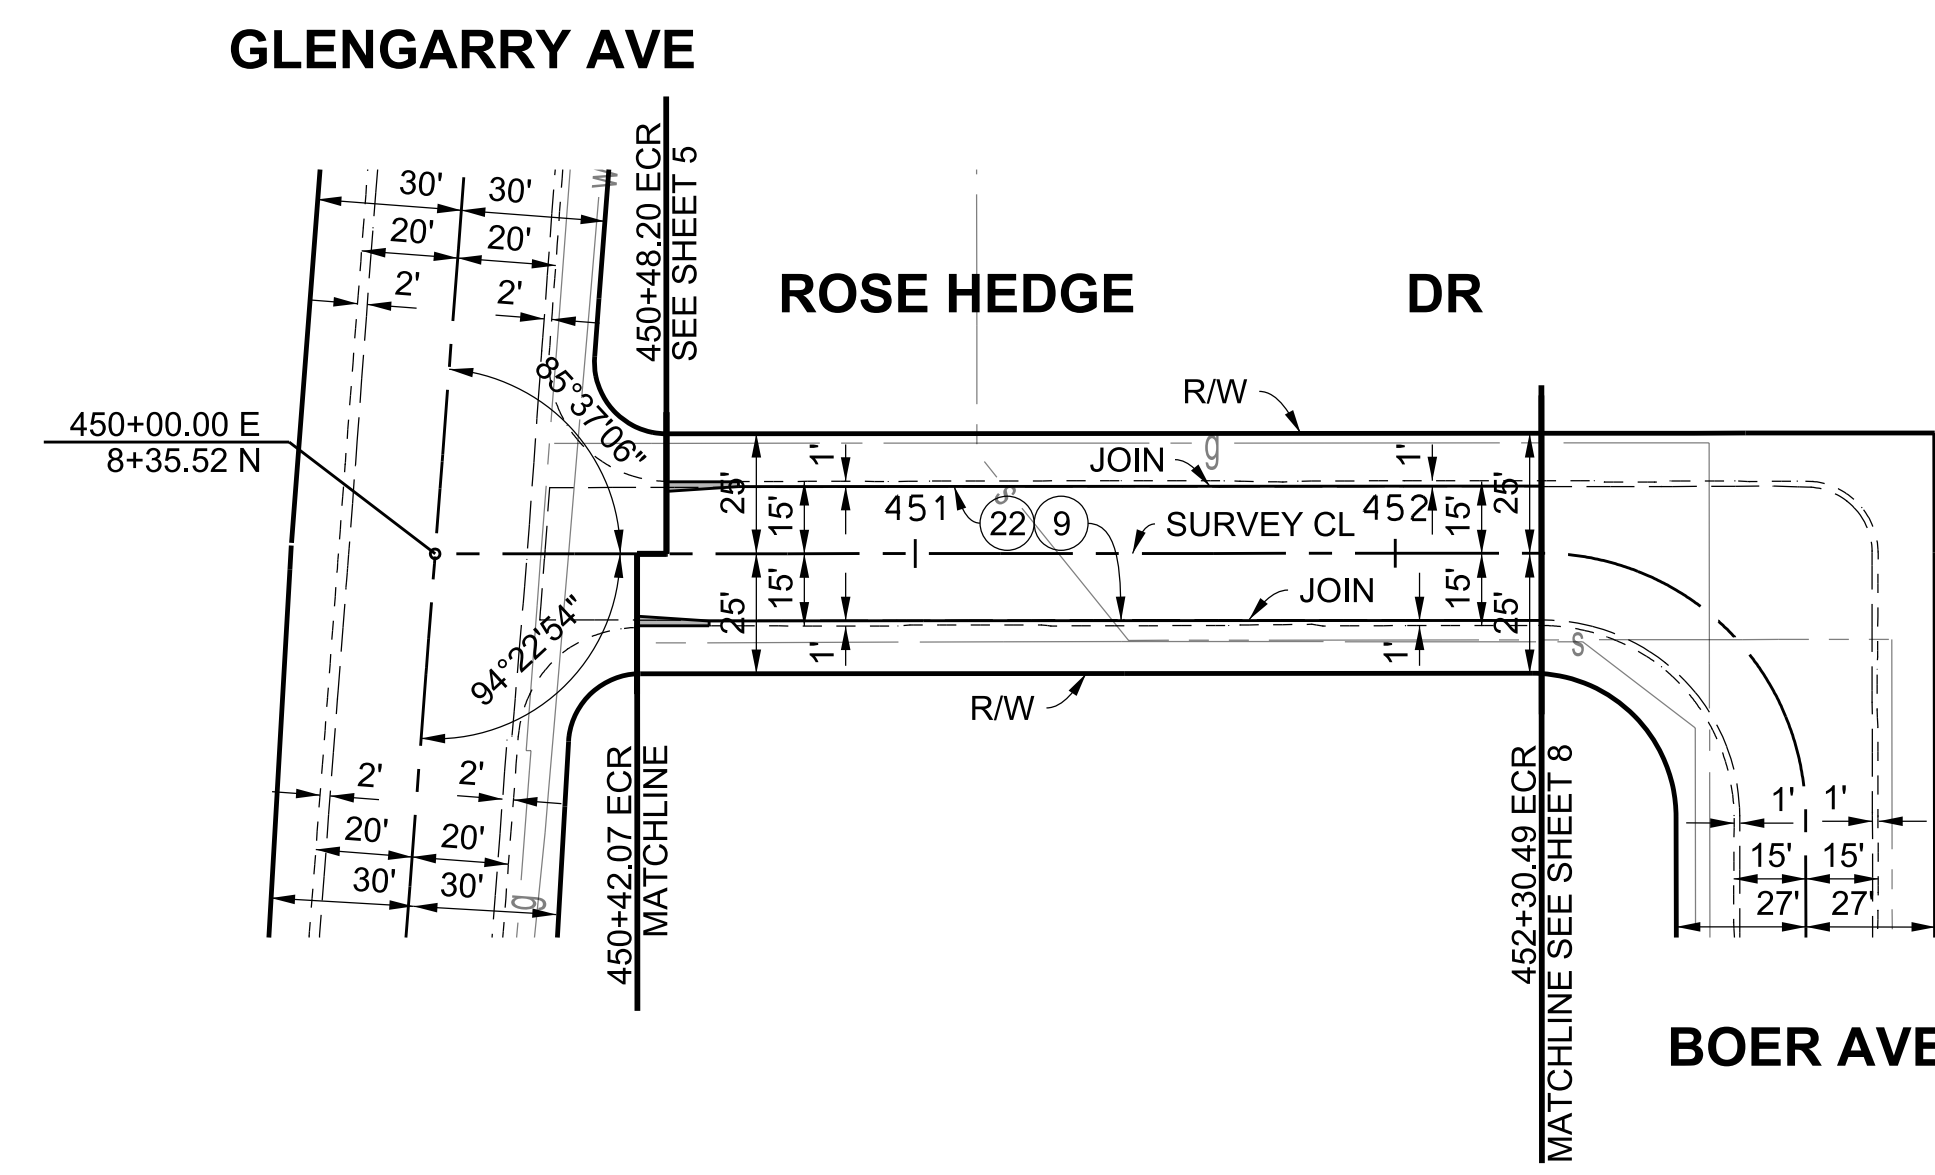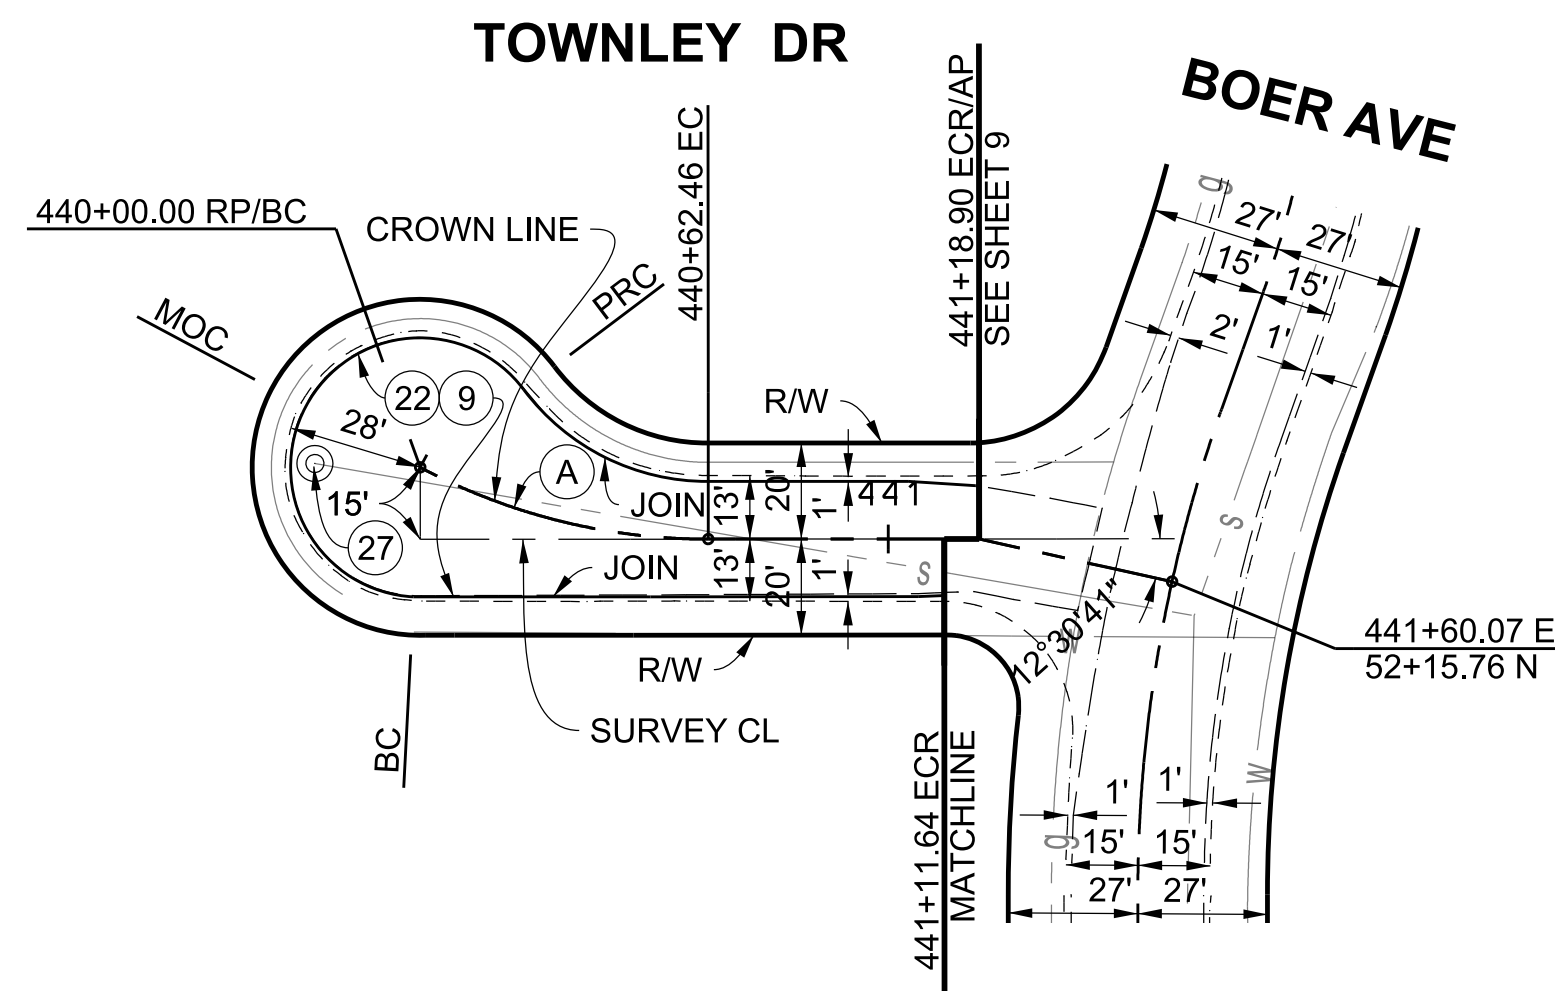

BENCHMARK
PT 660, ELEV 167.68 (WHITTIER & BASELINE QUAD 2005), PWFB 1026, PG 2145
CL INT TOWNLEY DR & BOER AVE FD SPK & TIN PER R1, DN 1"

CURVE DATA				
CURVE	RADIUS	CENTRAL ANGLE	LENGTH	TANGENT
(A)	127.57'	28° 3' 5"	62.46'	31.87'

DATE	MARK	DESCRIPTION
10/25/2021	AS-BUILT	
REVISIONS		

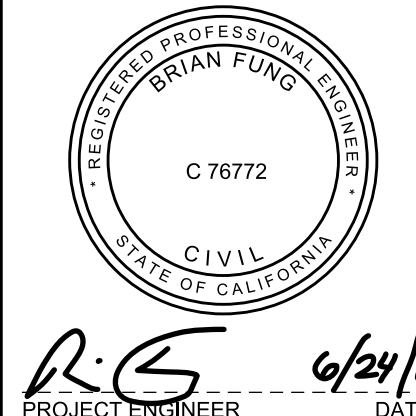

BENCHMARK
PT 199, ELEV 165.12 (WHITTIER & BASELINE QUAD 2005), PWFB 1026, PG 2142
CL INT ROSE HEDGE DR & BOER AVE FD MAG NAIL NO REF.

LOS ANGELES COUNTY PUBLIC WORKS

SOUTH WHITTIER LOS NIETOS
KEITH DRIVE, ET AL.

PROJECT ID NO. RMD4408001
PLAN AND PROFILE

PD PH086562 SHEET 43 OF 79

PLAN RD