

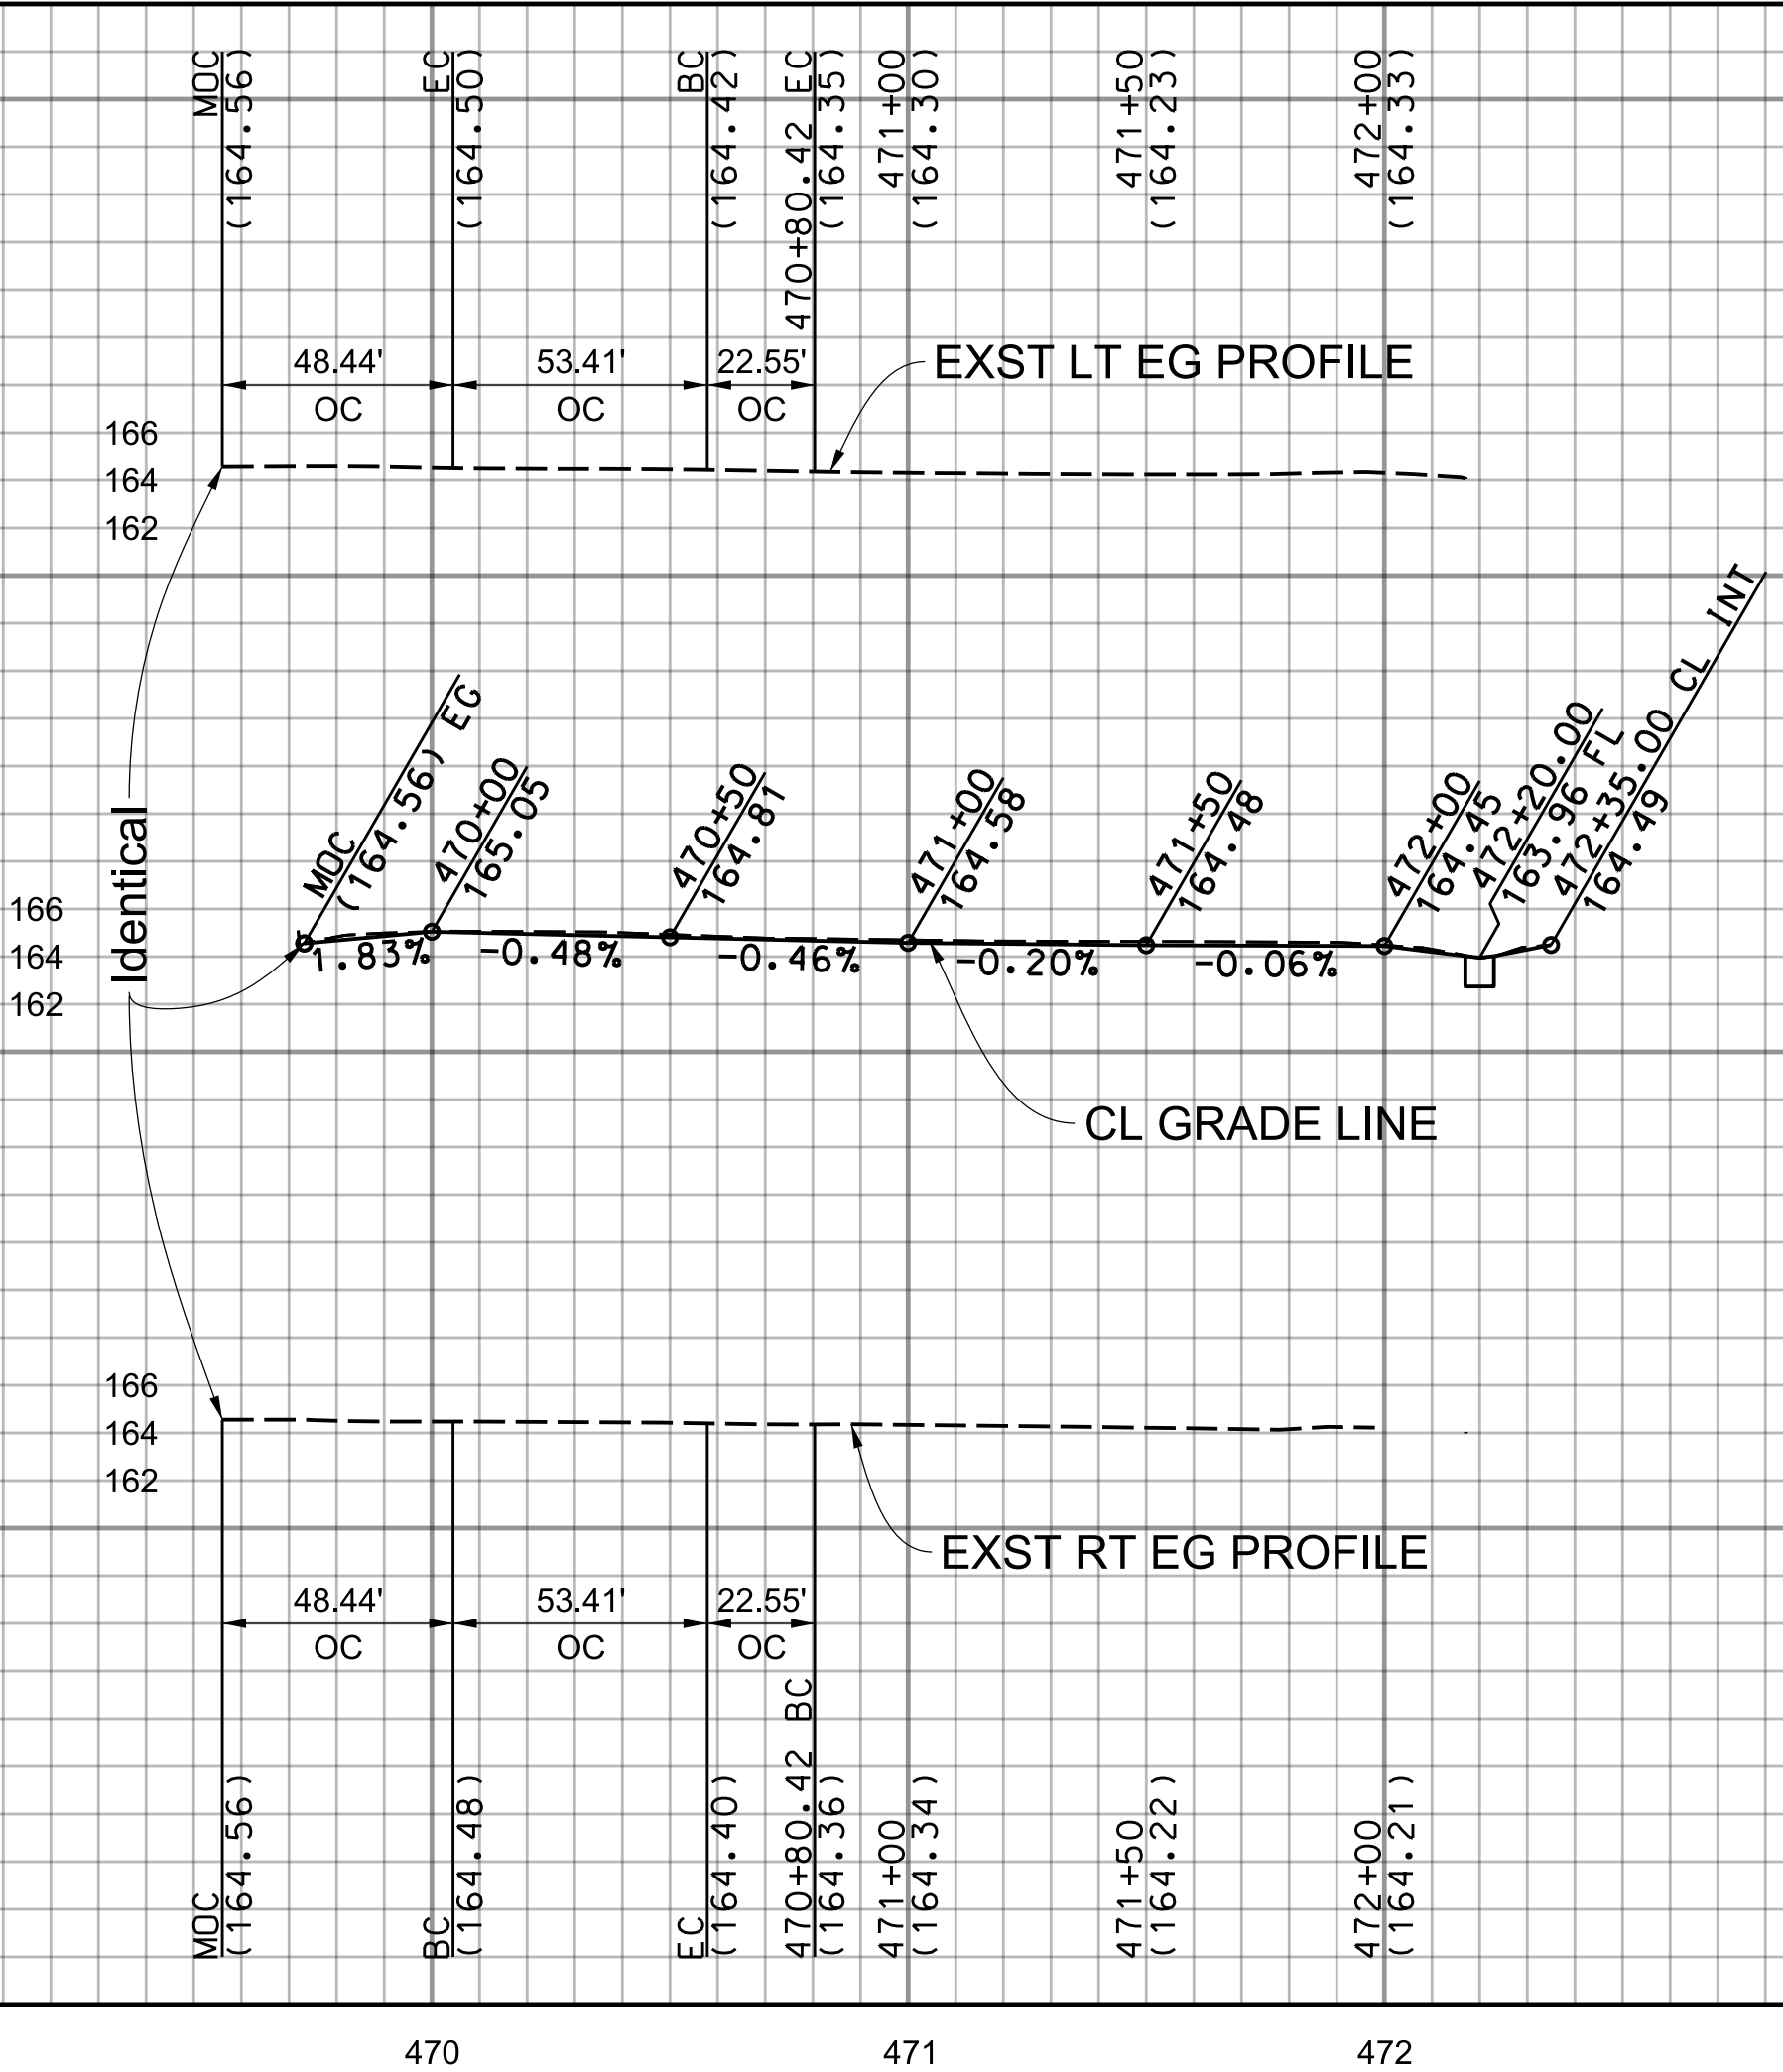
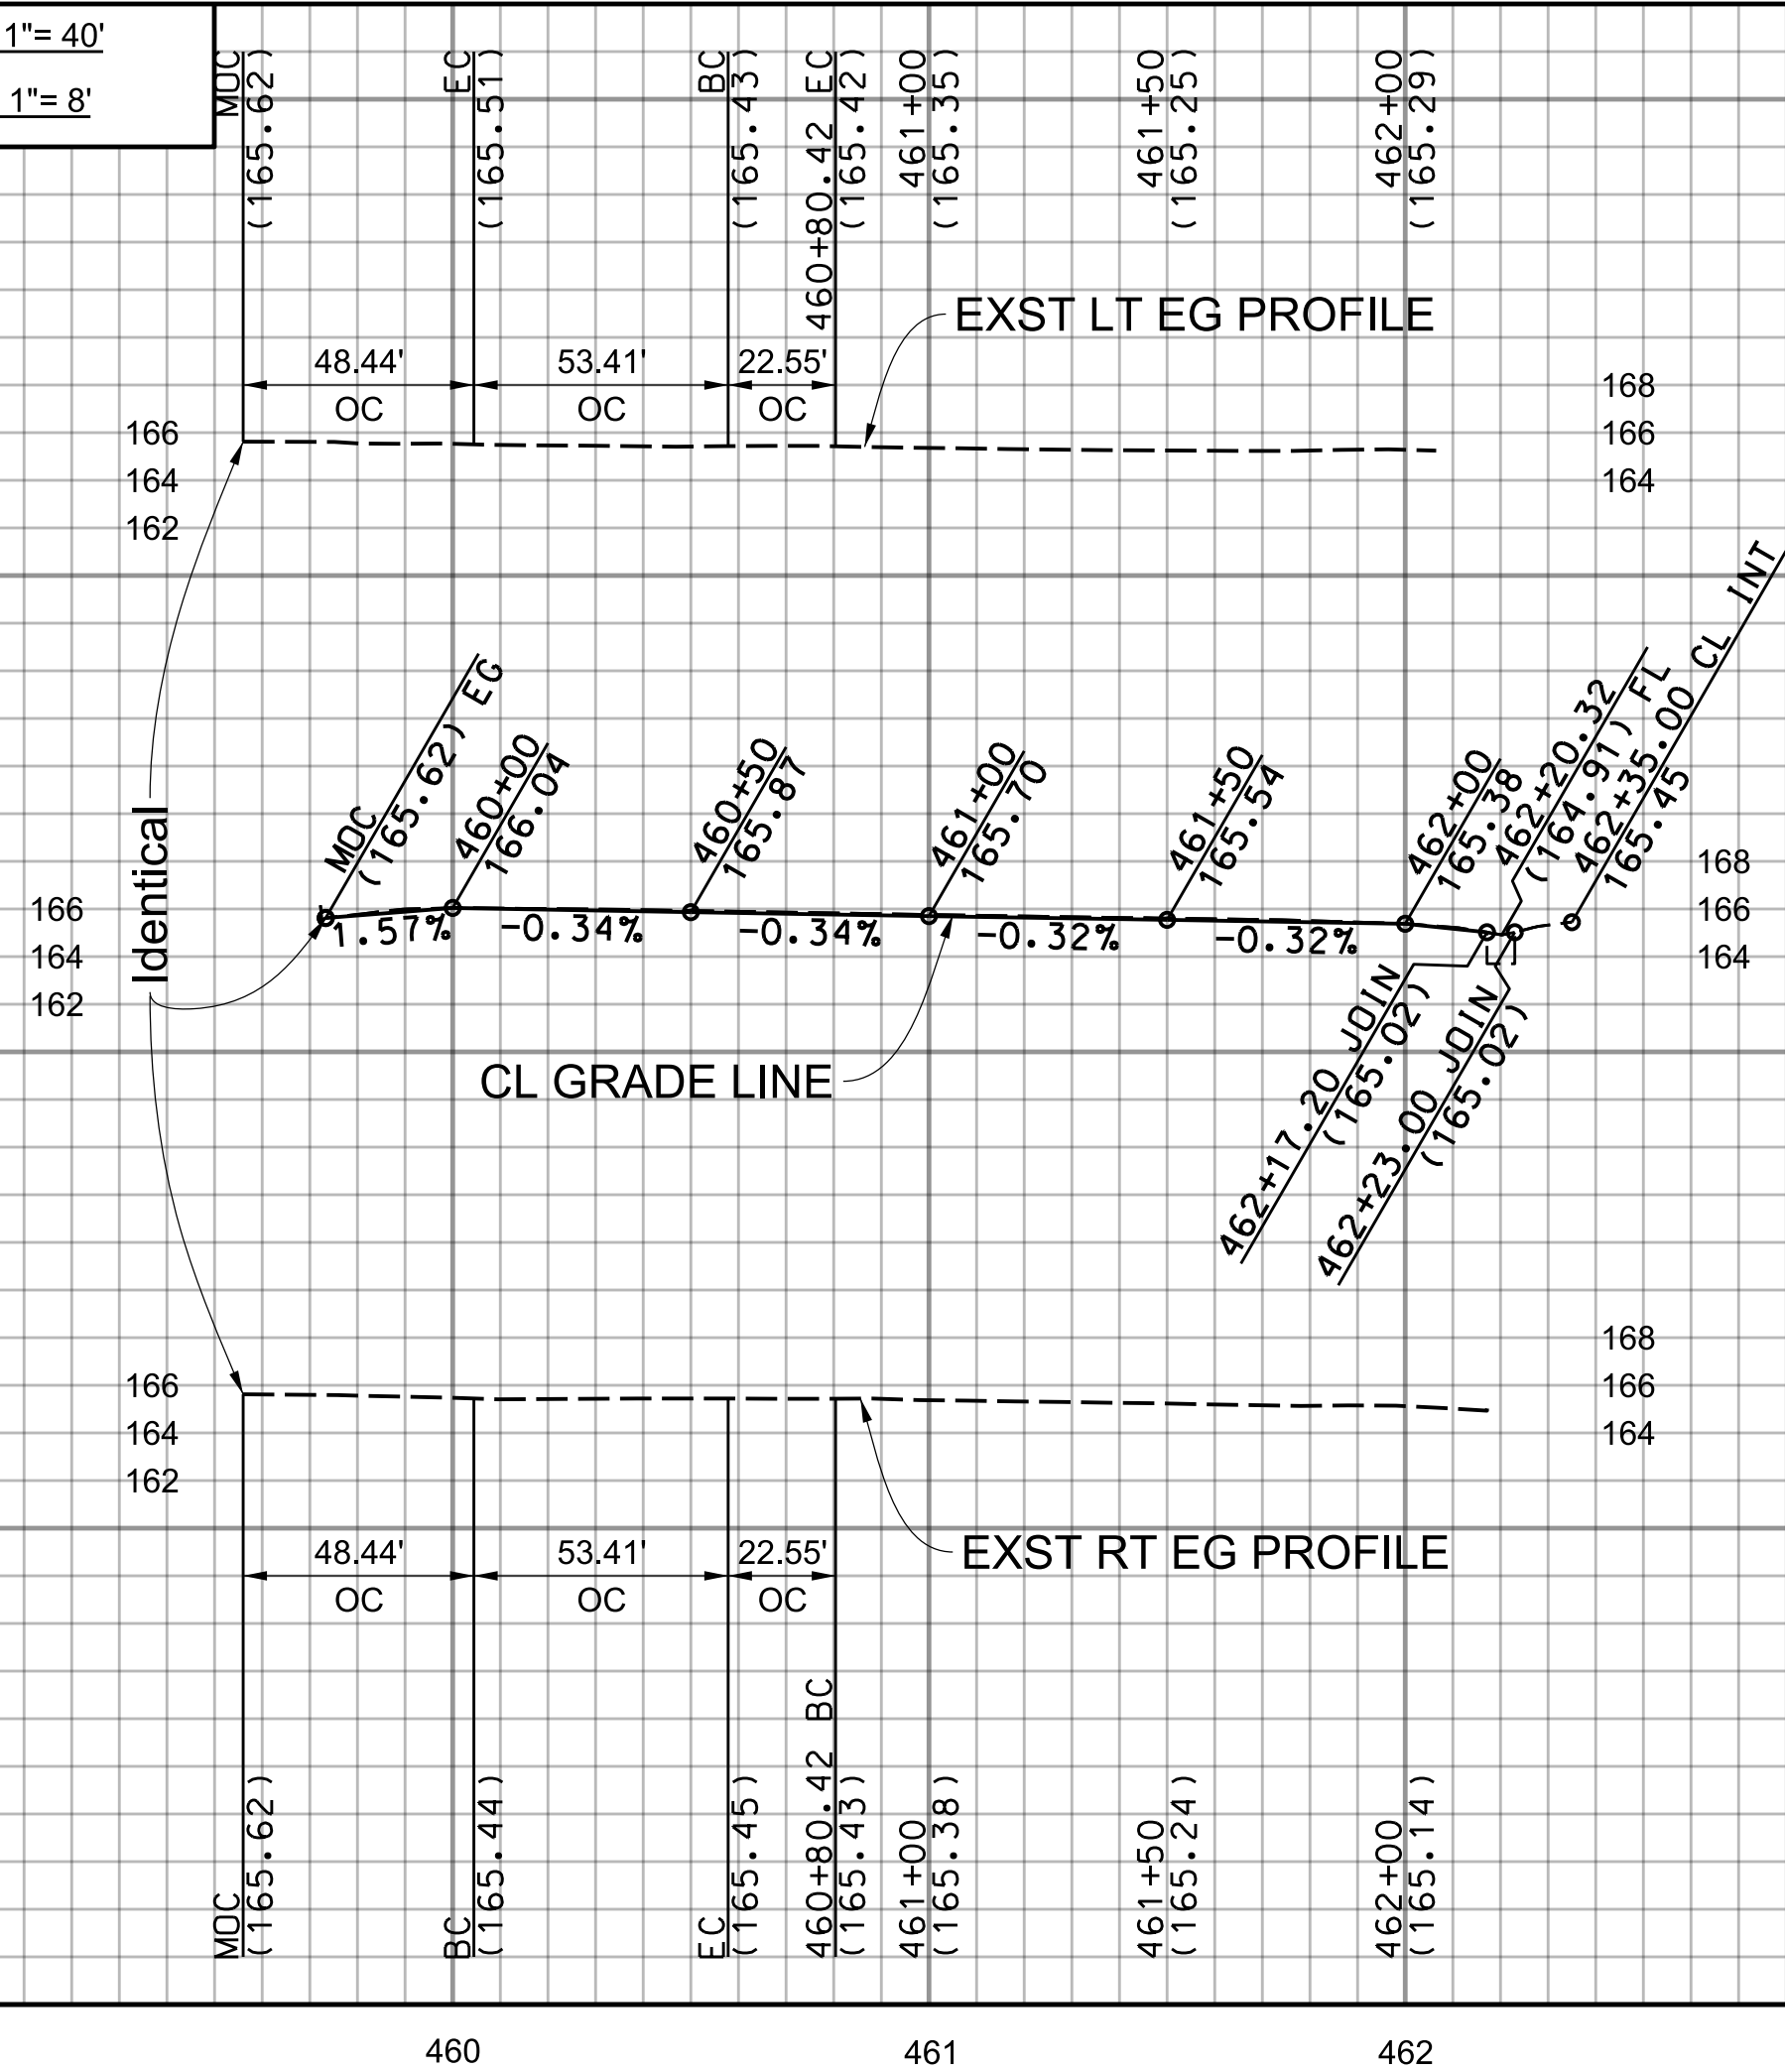
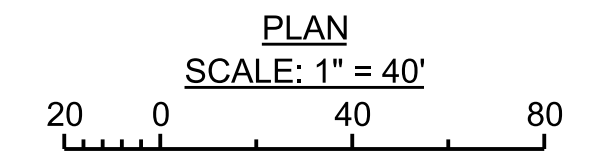
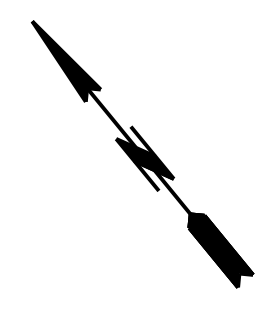


SCALE: HOR. 1"= 40'  
VERT. 1"= 8'

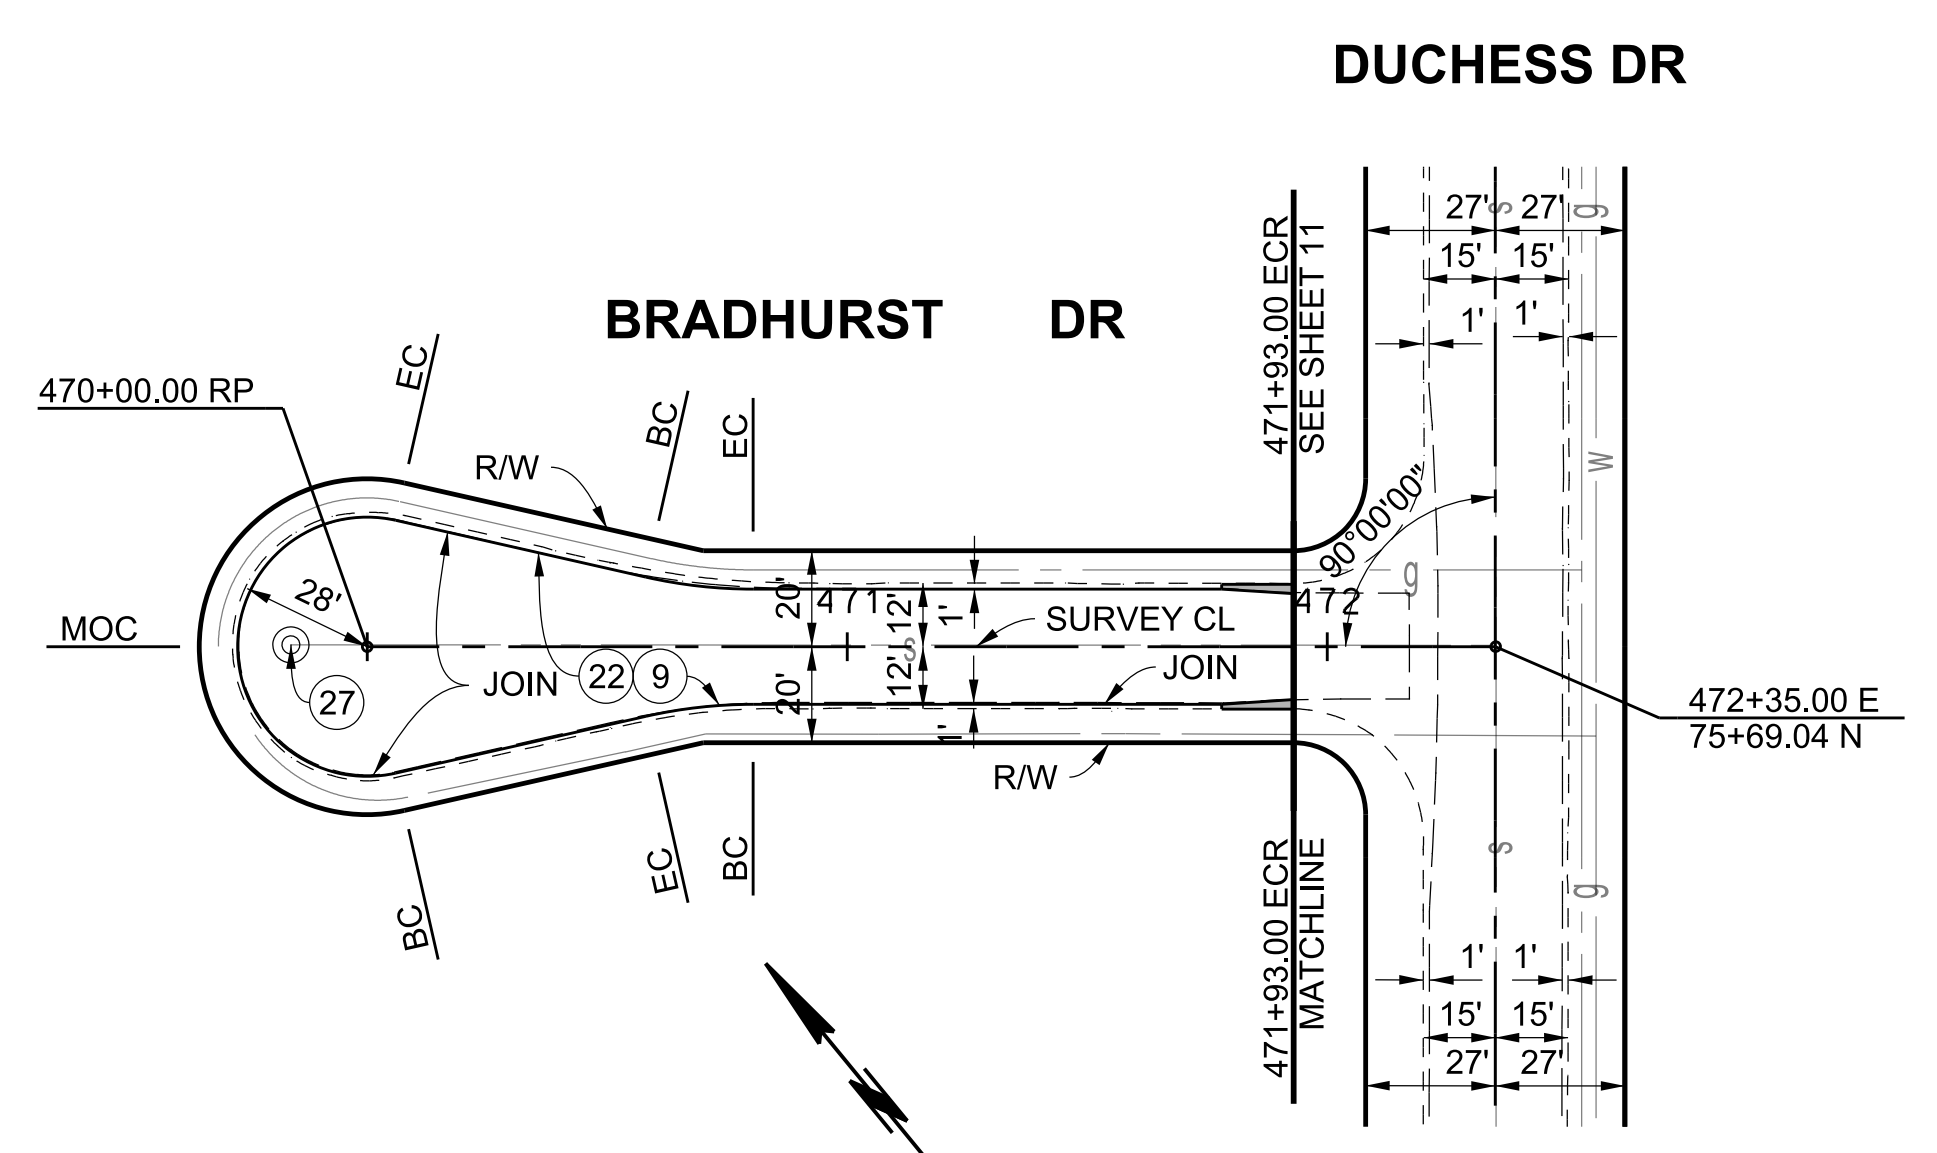

SEE SHEET 74 FOR PARKWAY IMPROVEMENTS

SEE SHEET 74 FOR PARKWAY IMPROVEMENTS

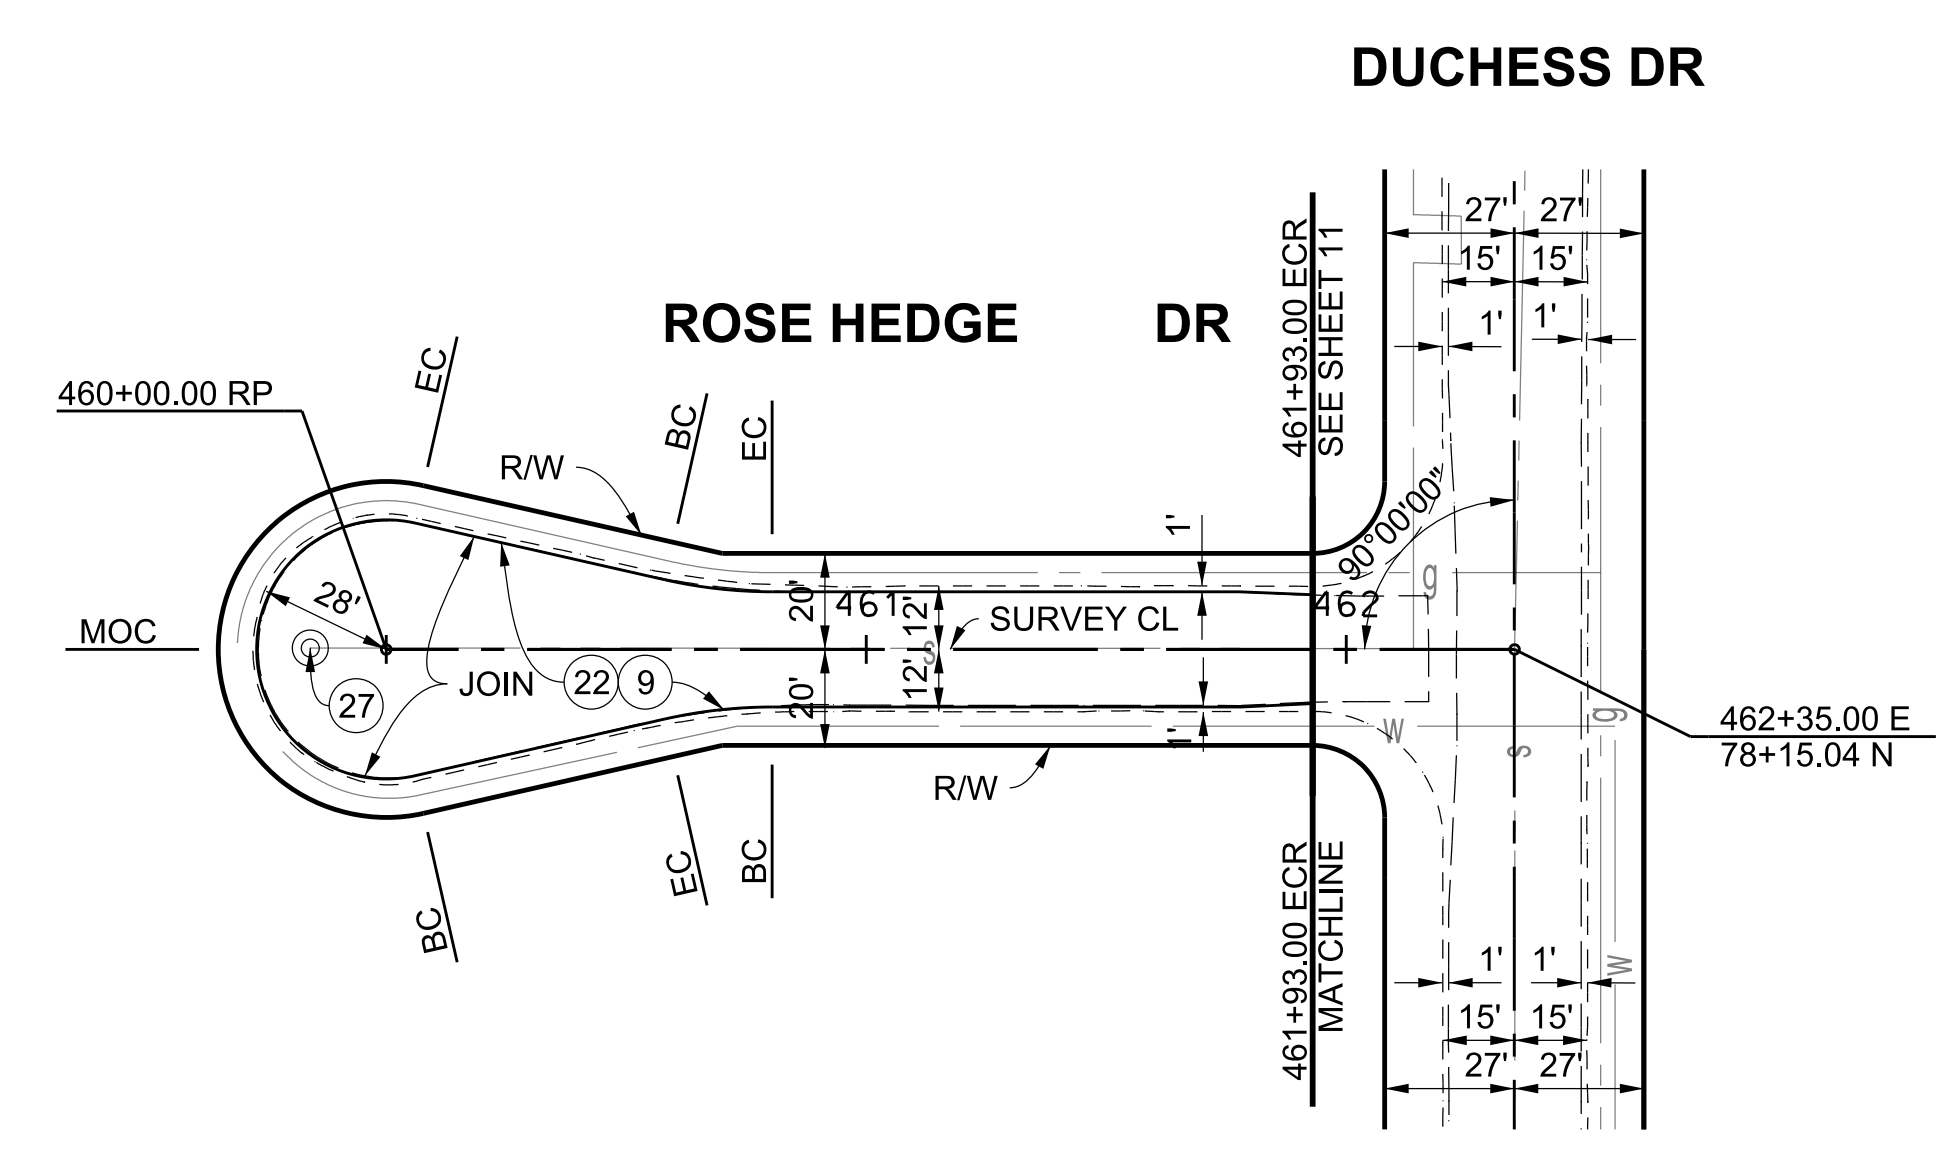

**BENCHMARK**  
PT 832, ELEV ??? (WHITTIER & BASELINE QUAD 2005), PWFB 1026, PG 2176  
CL INT ROSE HEDGE DR & DUCHESS DR NOTHING FD/SET ESTAB'D @ 27' OFF  
FD R/W MONUMENTS

**BENCHMARK**  
PT 831, ELEV ??? (WHITTIER & BASELINE QUAD 2005), PWFB 1026, PG 2177  
CL INT BRADHURST DR & DUCHESS DR NOTHING FD/SET ESTAB'D @ 27' OFF  
FD R/W MONUMENTS @ BRADHURST & ALDRICH STS.



PROJECT ENGINEER: R.S. DATE: 6/24/19

LOS ANGELES COUNTY PUBLIC WORKS  
**SOUTH WHITTIER LOS NIETOS**  
KEITH DRIVE, ET AL.  
PROJECT ID NO. RMD4408001  
**PLAN AND PROFILE**  
PD PH086563 SHEET 44 OF 79

DATE	MARK	DESCRIPTION
10/25/2021	AS-BUILT	
REVISIONS		