

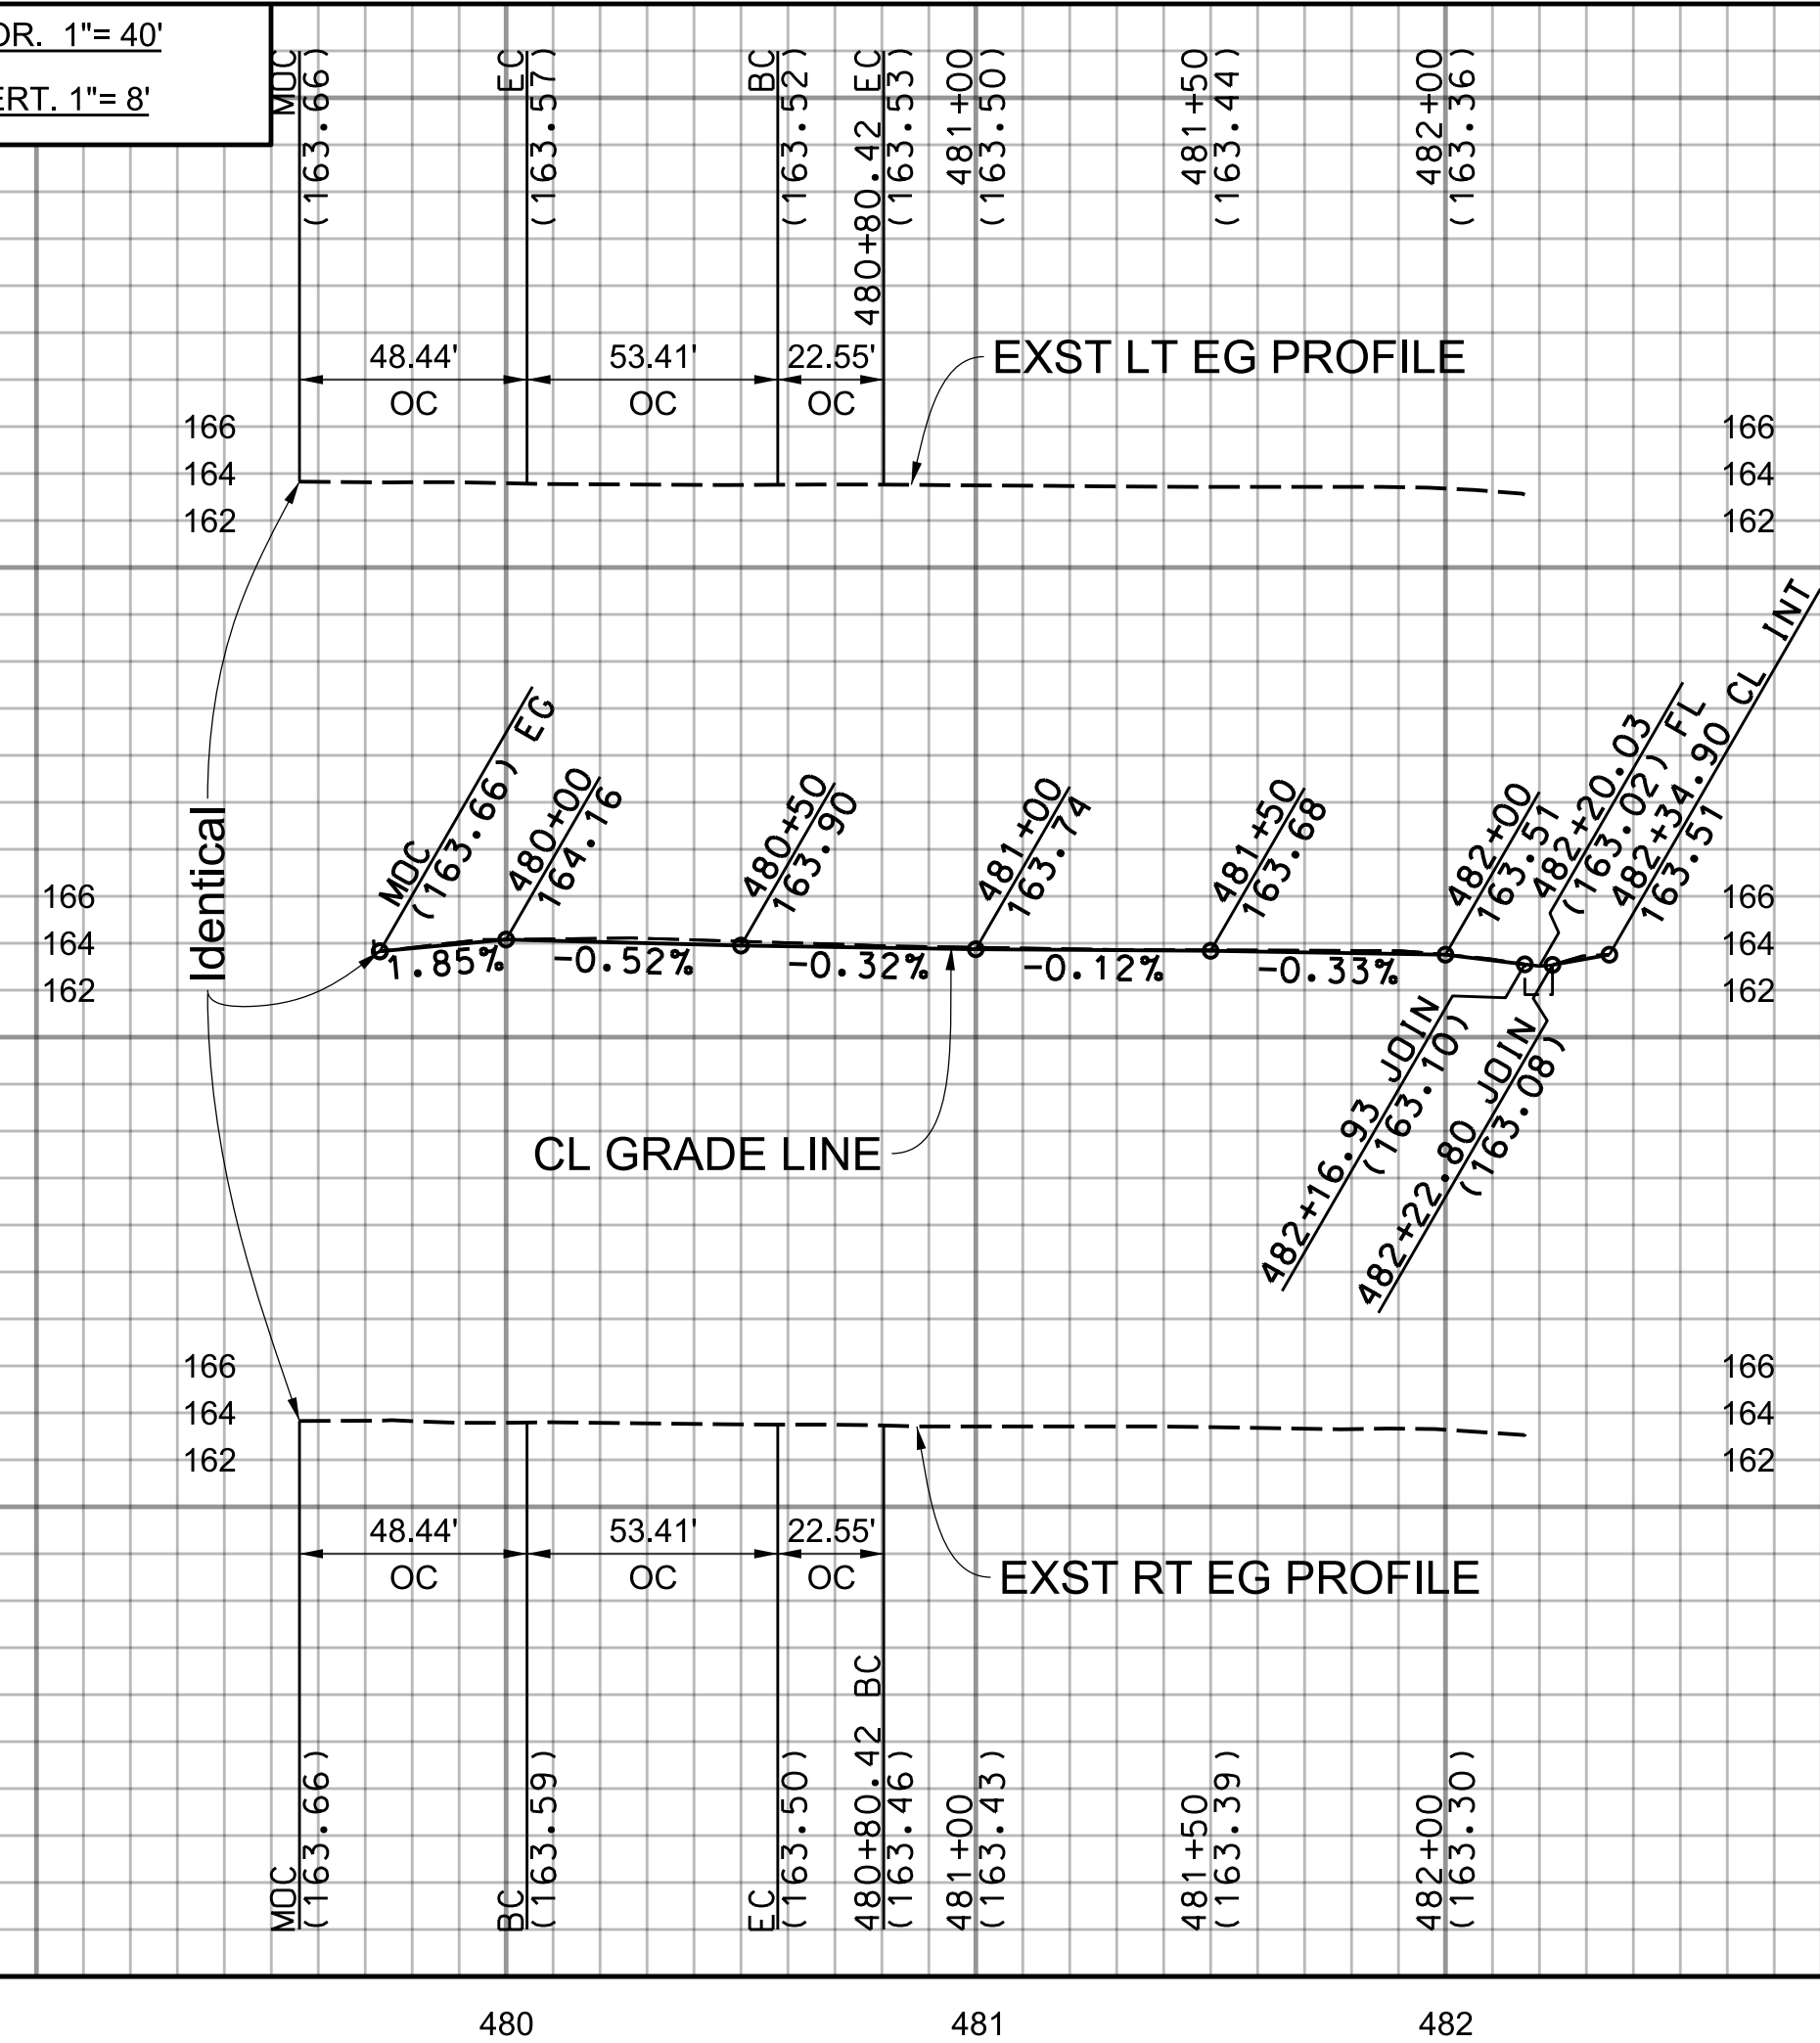


SCALE: HOR. 1"= 40'  
VERT. 1"= 8'

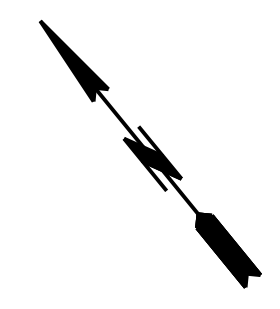


480 481 482

SEE SHEET 74 FOR PARKWAY IMPROVEMENTS

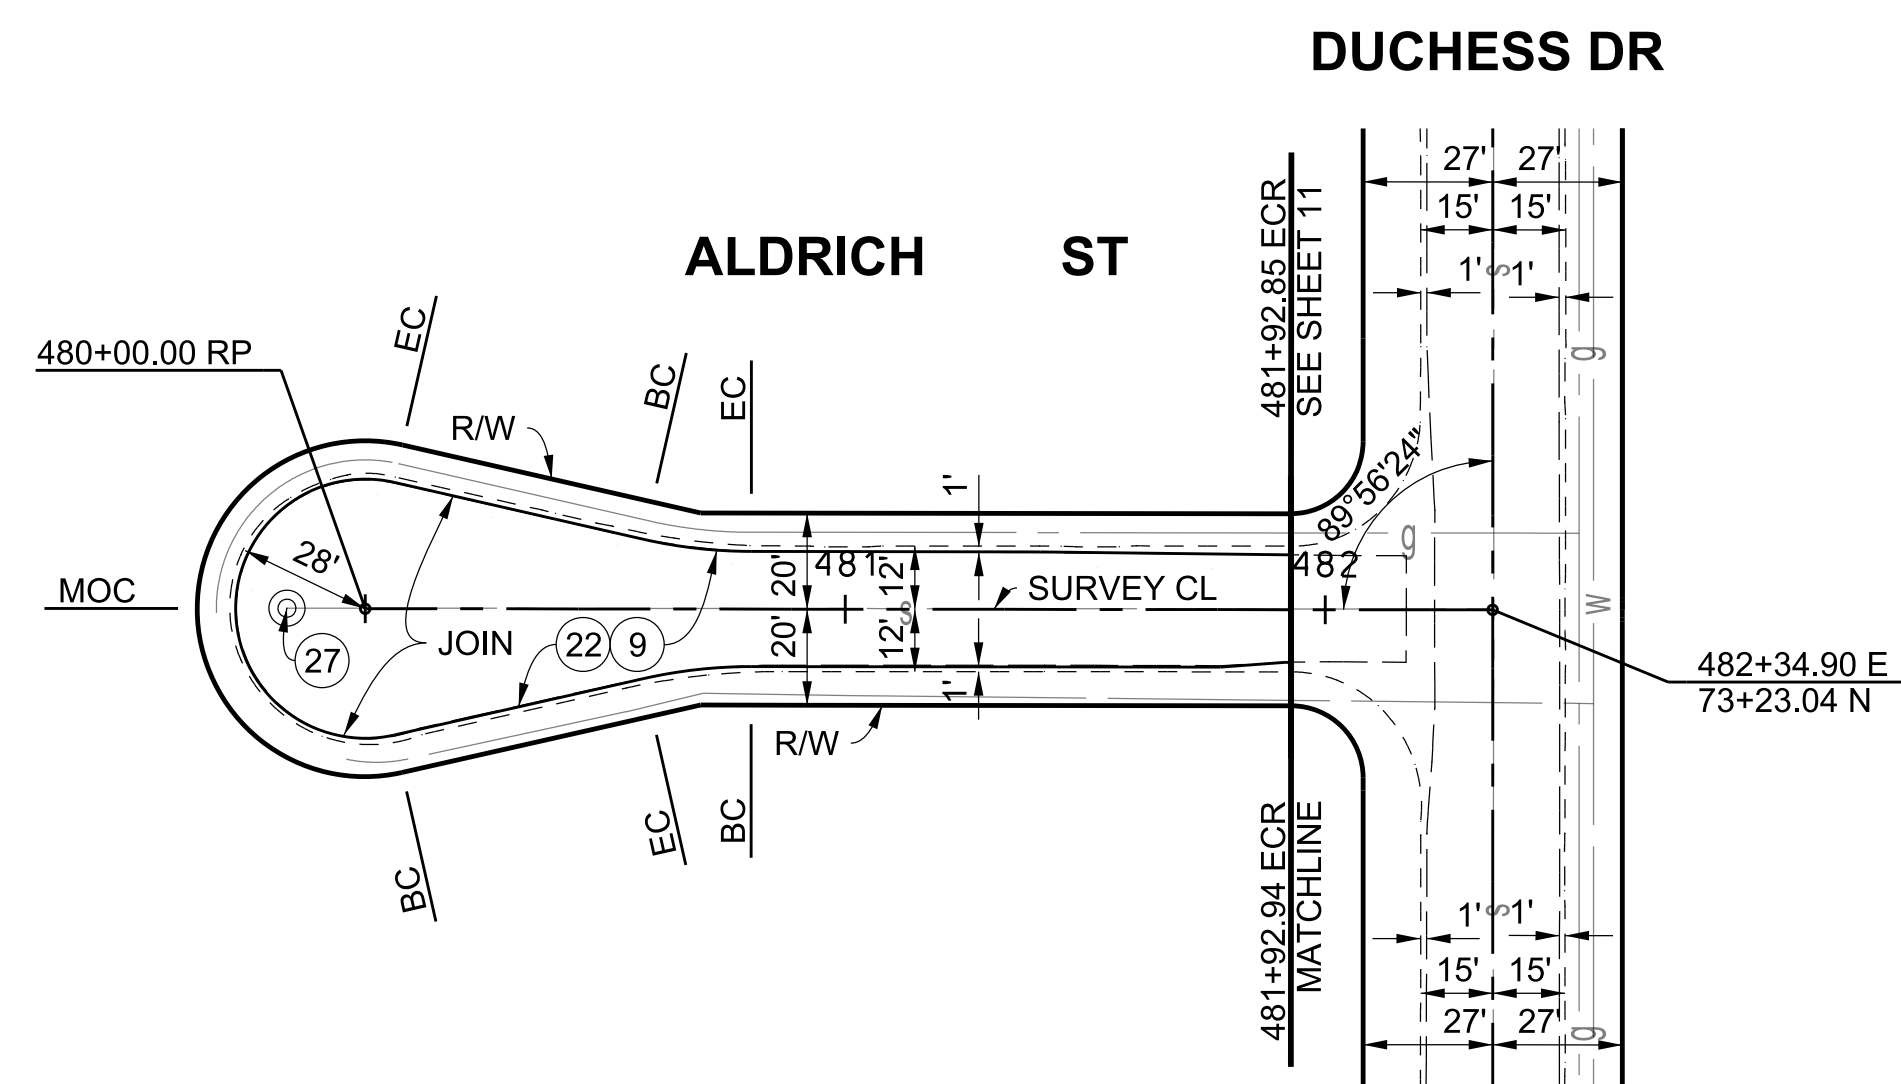

PLAN  
SCALE: 1"= 40'

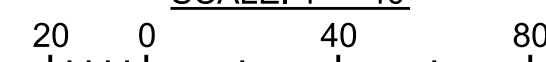

CADD PROJECT FILE NAME: \$FILESS  
CHECKER: B. FUNG  
DESIGNER: J. GARCIA  
DRAFTER: J. GARCIA

DATE	MARK	DESCRIPTION
10/25/2021	■	AS-BUILT
REVISIONS		



PROJECT ENGINEER: R.S. DATE: 6/24/19

**BENCHMARK**  
PT 830, ELEV ??? (WHITTIER & BASELINE QUAD 2005), PWFB 1026, PG 2178  
CL INT ALDRICH ST & DUCHESS DR NOTHING FD/SET ESTAB'D @ 27' OFF  
MEAN OF FD R/W MONUMENTS @ BRADHURST & ALDRICH STS.

LOS ANGELES COUNTY PUBLIC WORKS  
**SOUTH WHITTIER LOS NIETOS**  
KEITH DRIVE, ET AL.  
PROJECT ID NO. RMD4408001  
PLAN AND PROFILE  
PD PH086564 SHEET 45 OF 79