
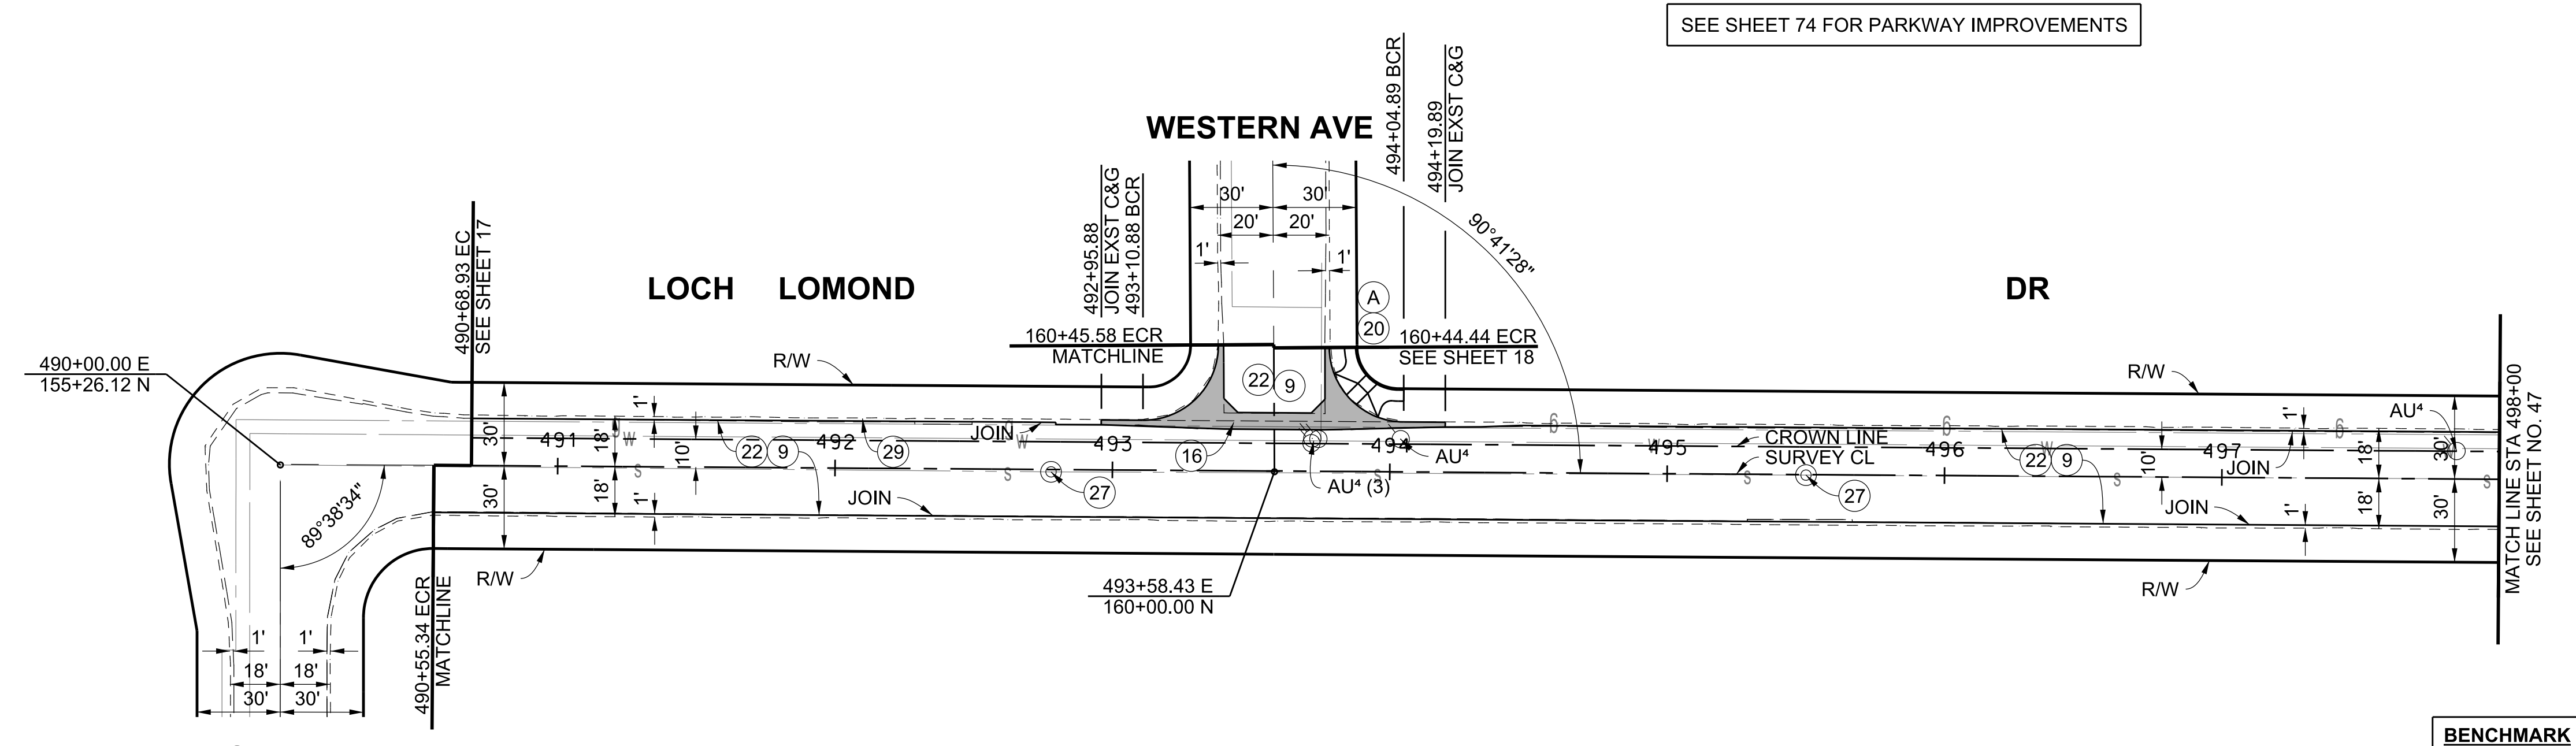


SCALE: HOR. 1"= 40'
VERT. 1"= 8'

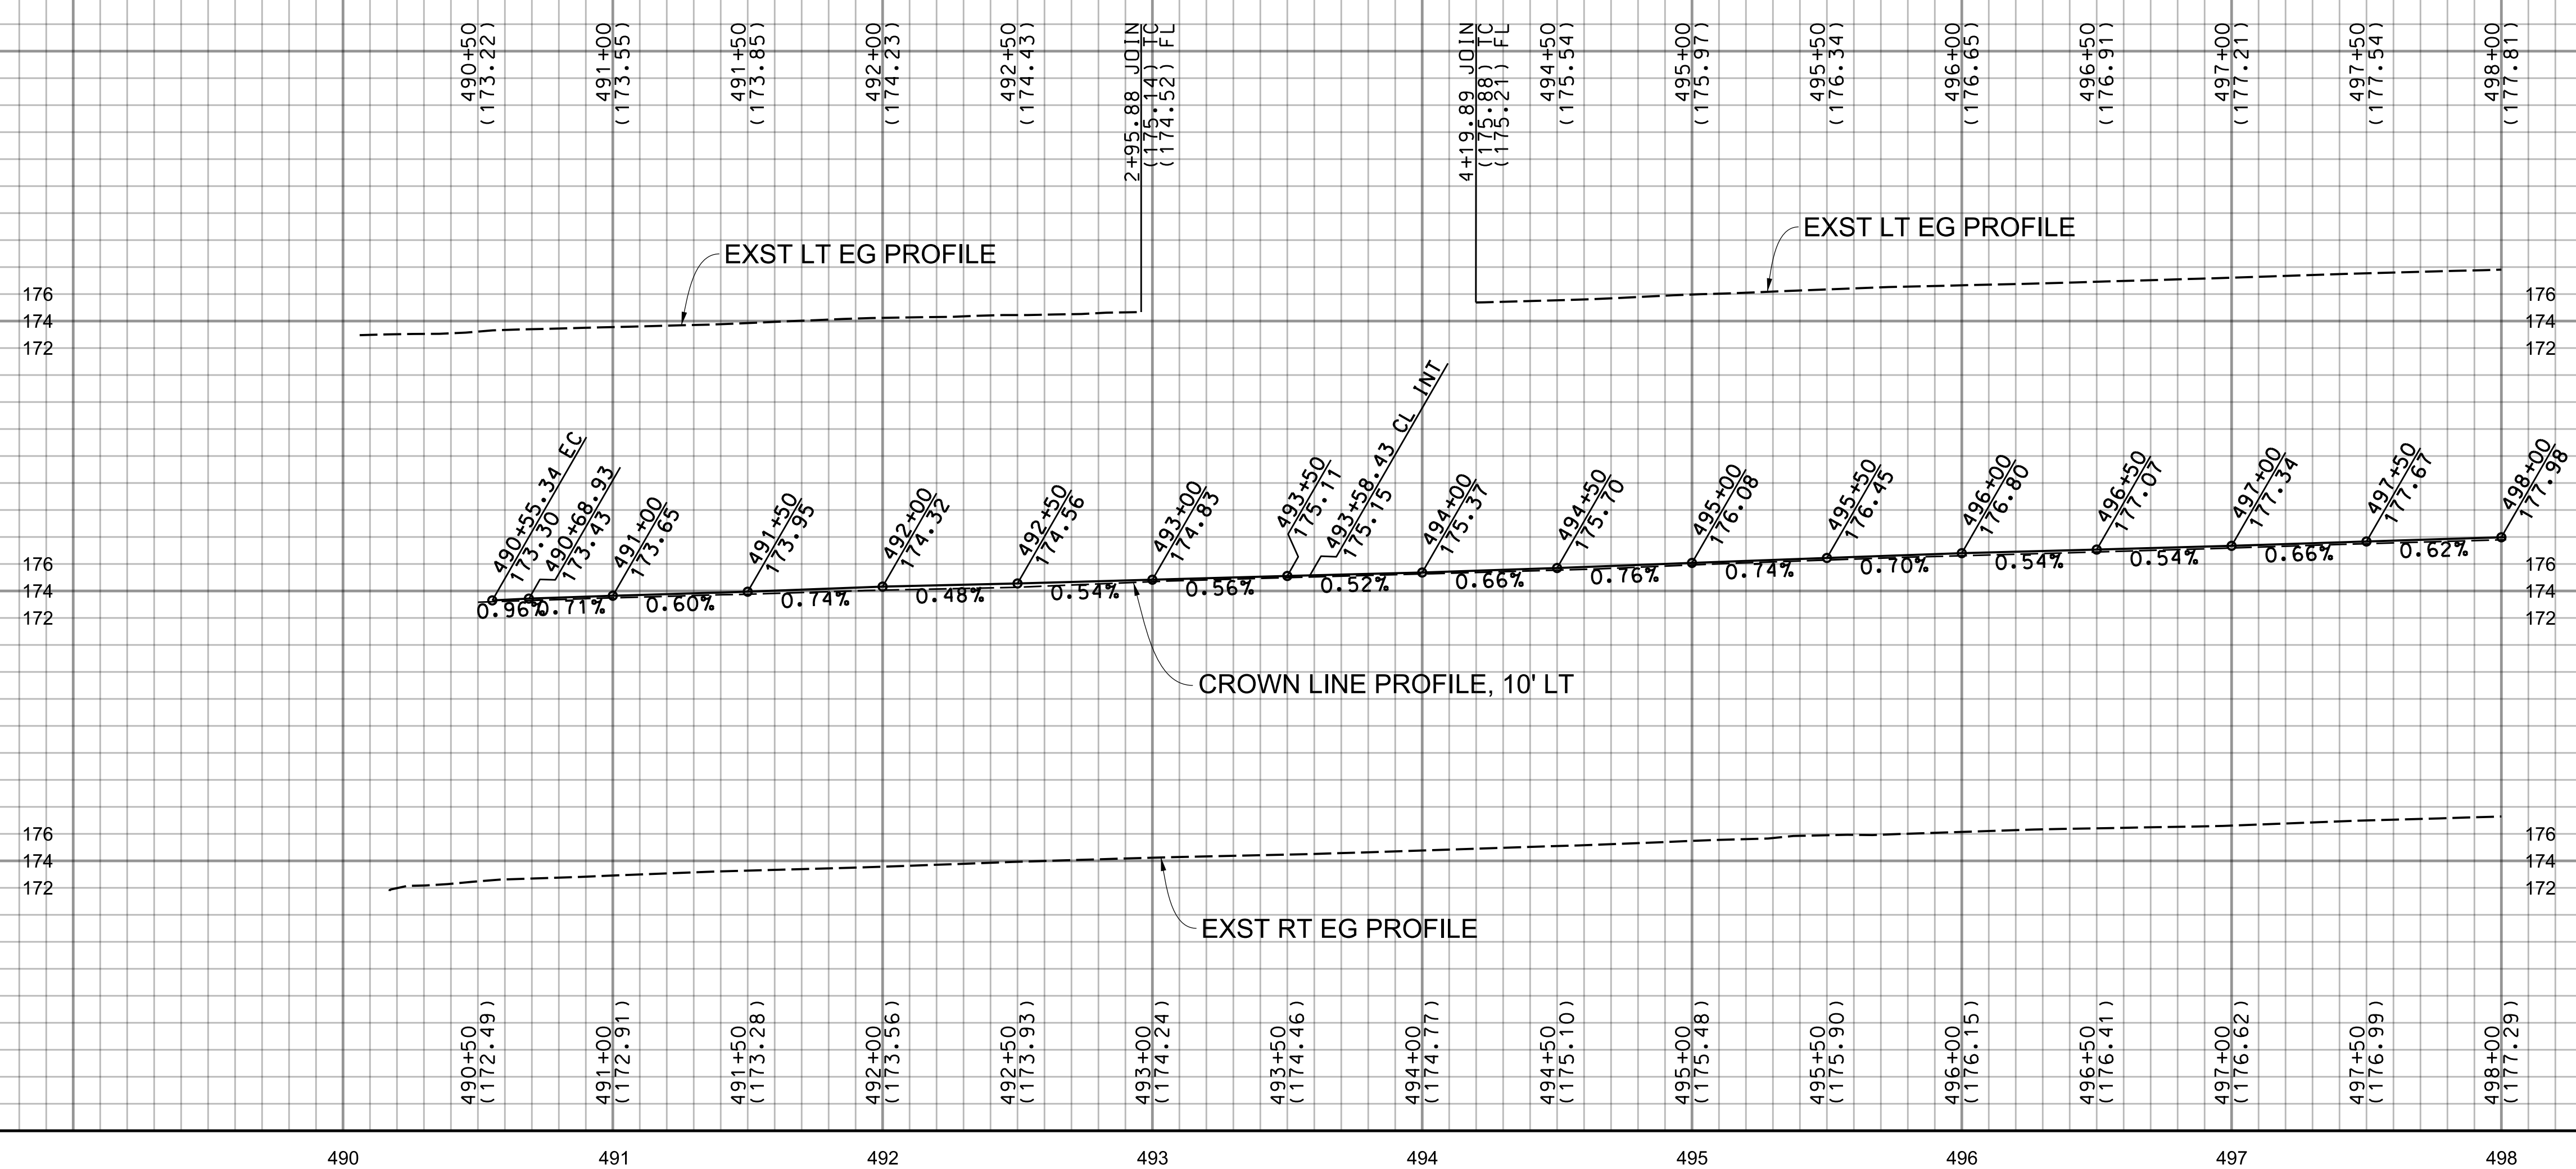

SEE SHEET 74 FOR PARKWAY IMPROVEMENTS

ELEVATIONS			
CURVE	BCR	$\Delta/2$	ECR
(A)	175.80 TC 175.13 FL	175.76 TC 175.09 FL	175.85 TC 175.18 FL

INTERSECTION DATA		
STATION	OFFSET	ELEV
493+38.43	18' LT	174.76
493+58.43	18' LT	174.89
493+78.43	18' LT	175.00

CURVE DATA				
CURVE	RADIUS	CENTRAL ANGLE	LENGTH	TANGENT
(A)	27.00'	89° 18' 32"	42.09'	26.68'

DATE	MARK	DESCRIPTION
10/25/2021	AS-BUILT	
REVISIONS		



BENCHMARK
PT 626, ELEV 172.985 (WHITTIER & BASELINE QUAD 2005), PWFB 1026, PG 2187
CL INT LOCH LOMOND DR & THORNLAKE AVE FD CHS X (4) IN MH. RIM, R1

LOS ANGELES COUNTY PUBLIC WORKS

SOUTH WHITTIER LOS NIETOS
KEITH DRIVE, ET AL.

PROJECT ID NO. RMD4408001
PLAN AND PROFILE

PD PH086565 SHEET 46 OF 79

PLAN RD