



SCALE: HOR. 1"=40'
VERT. 1"=8'

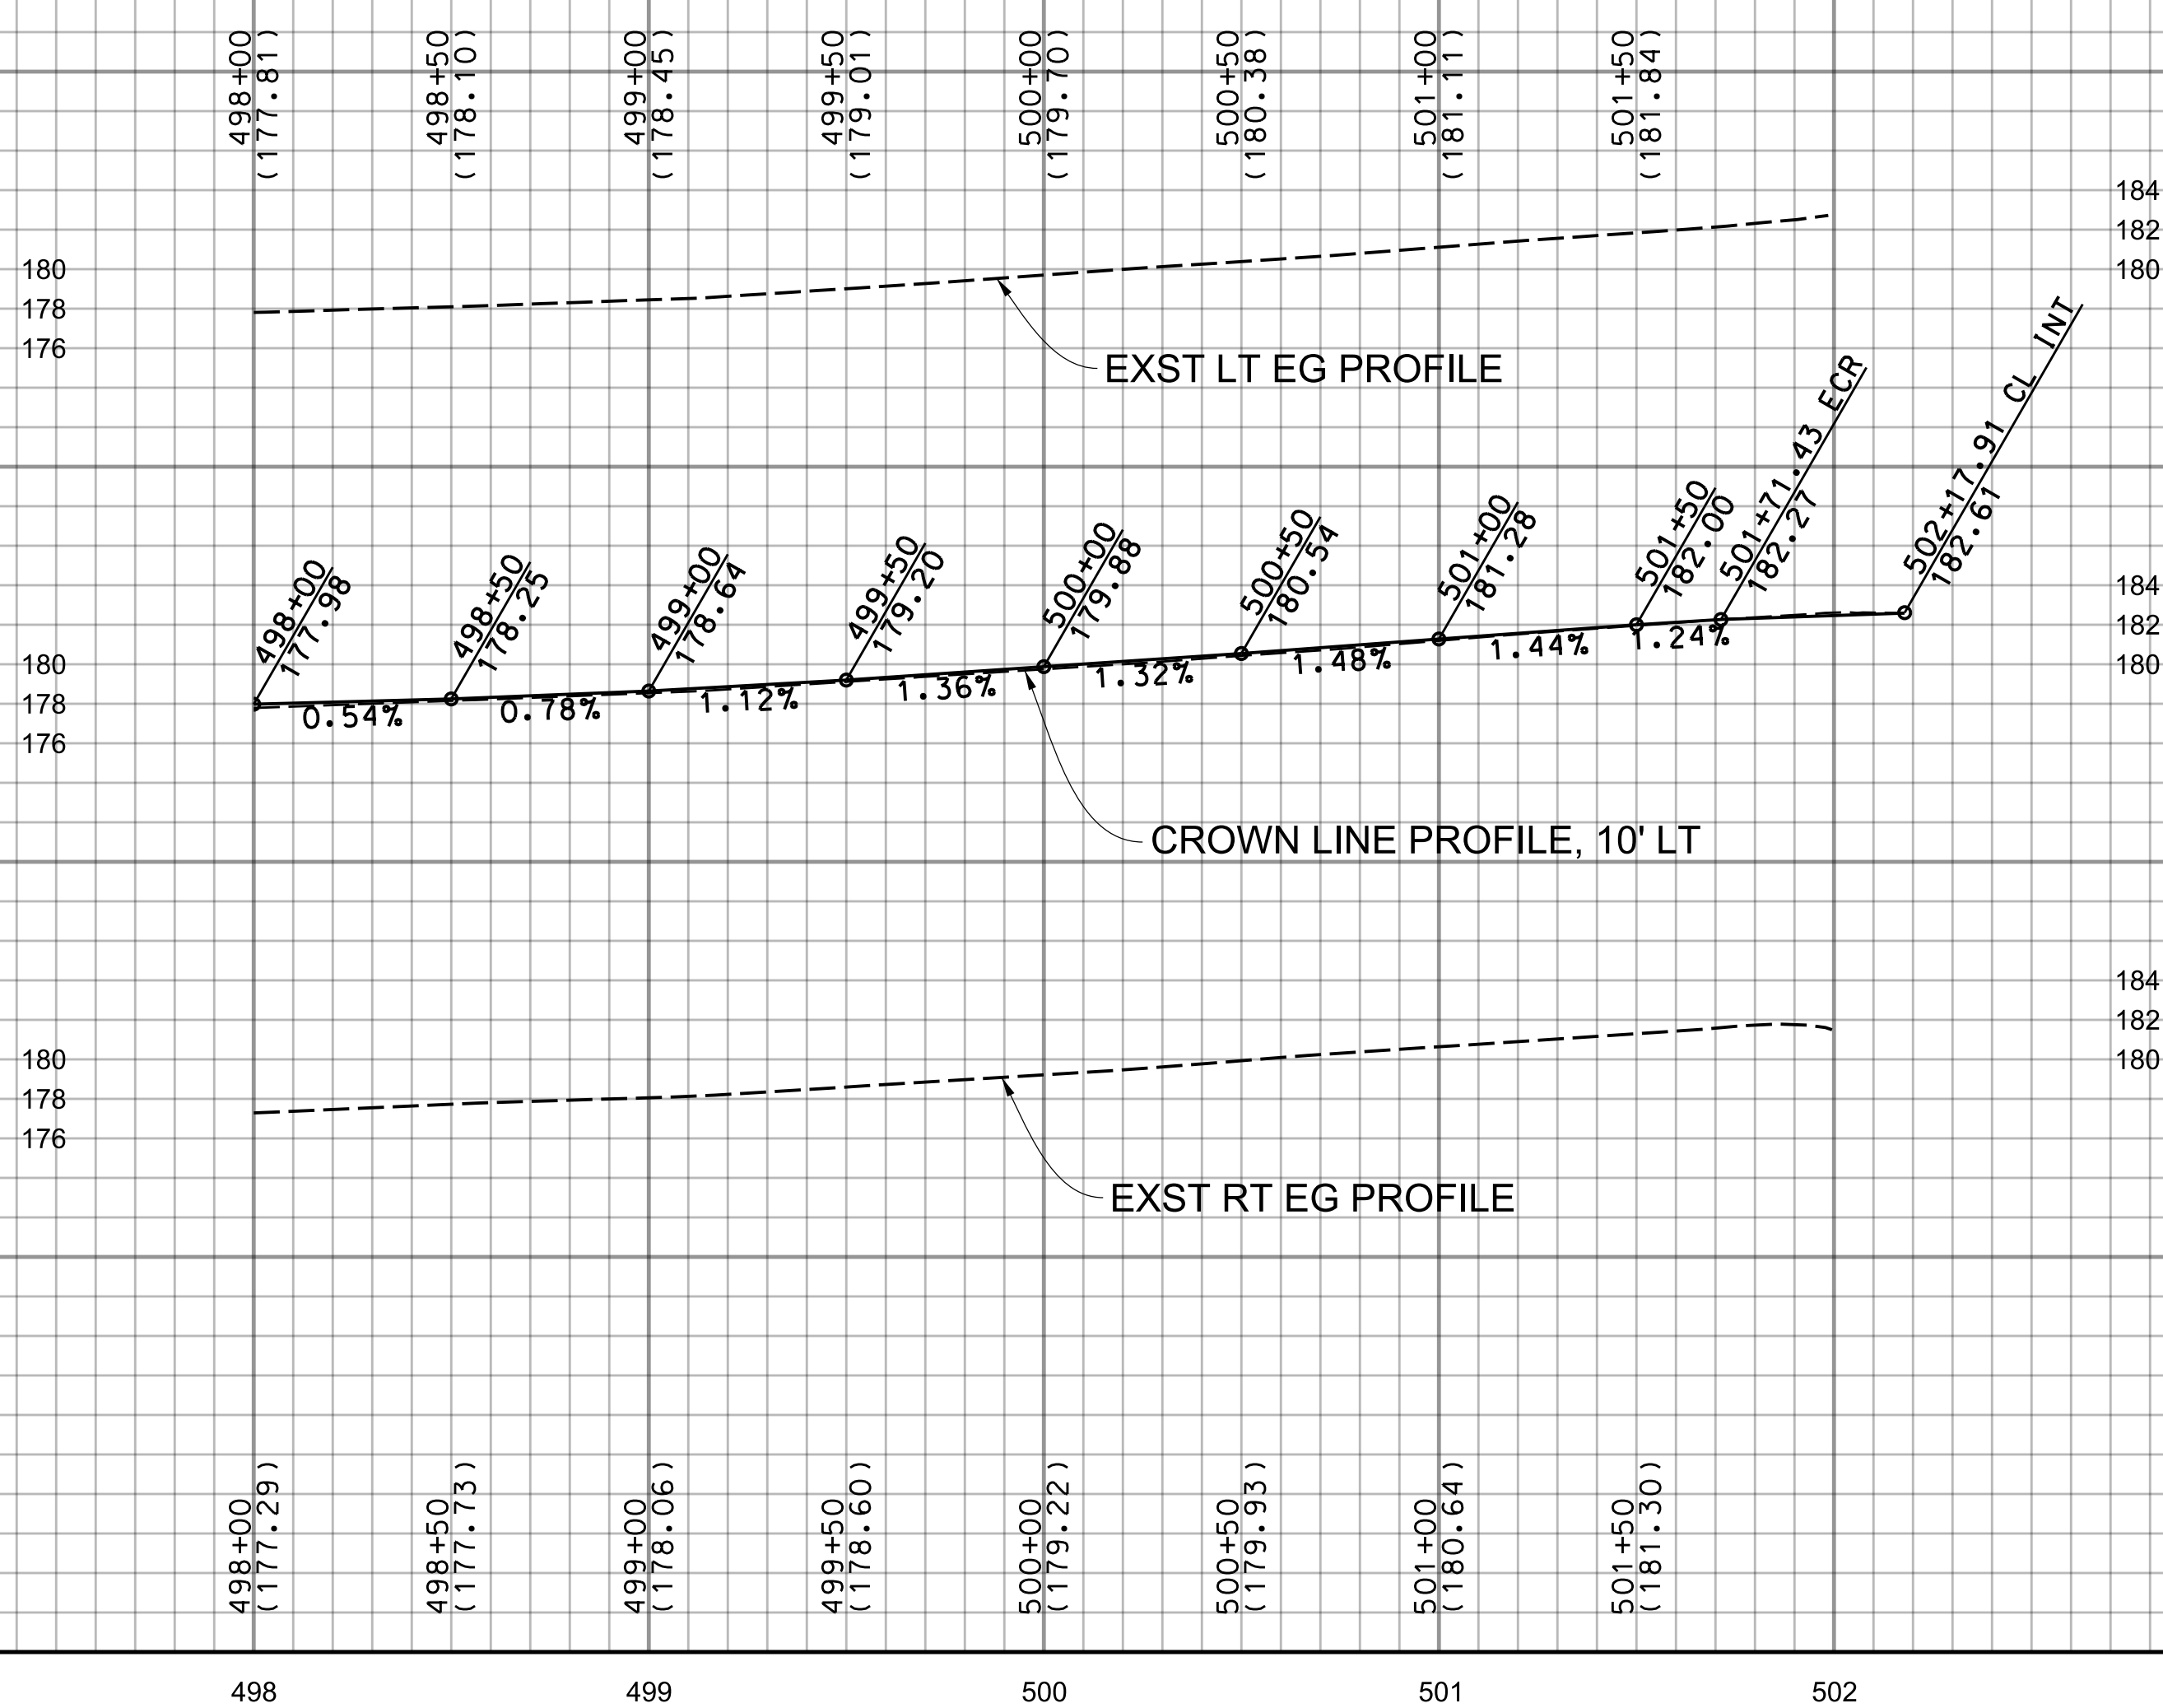

SEE SHEET 74 FOR PARKWAY IMPROVEMENTS

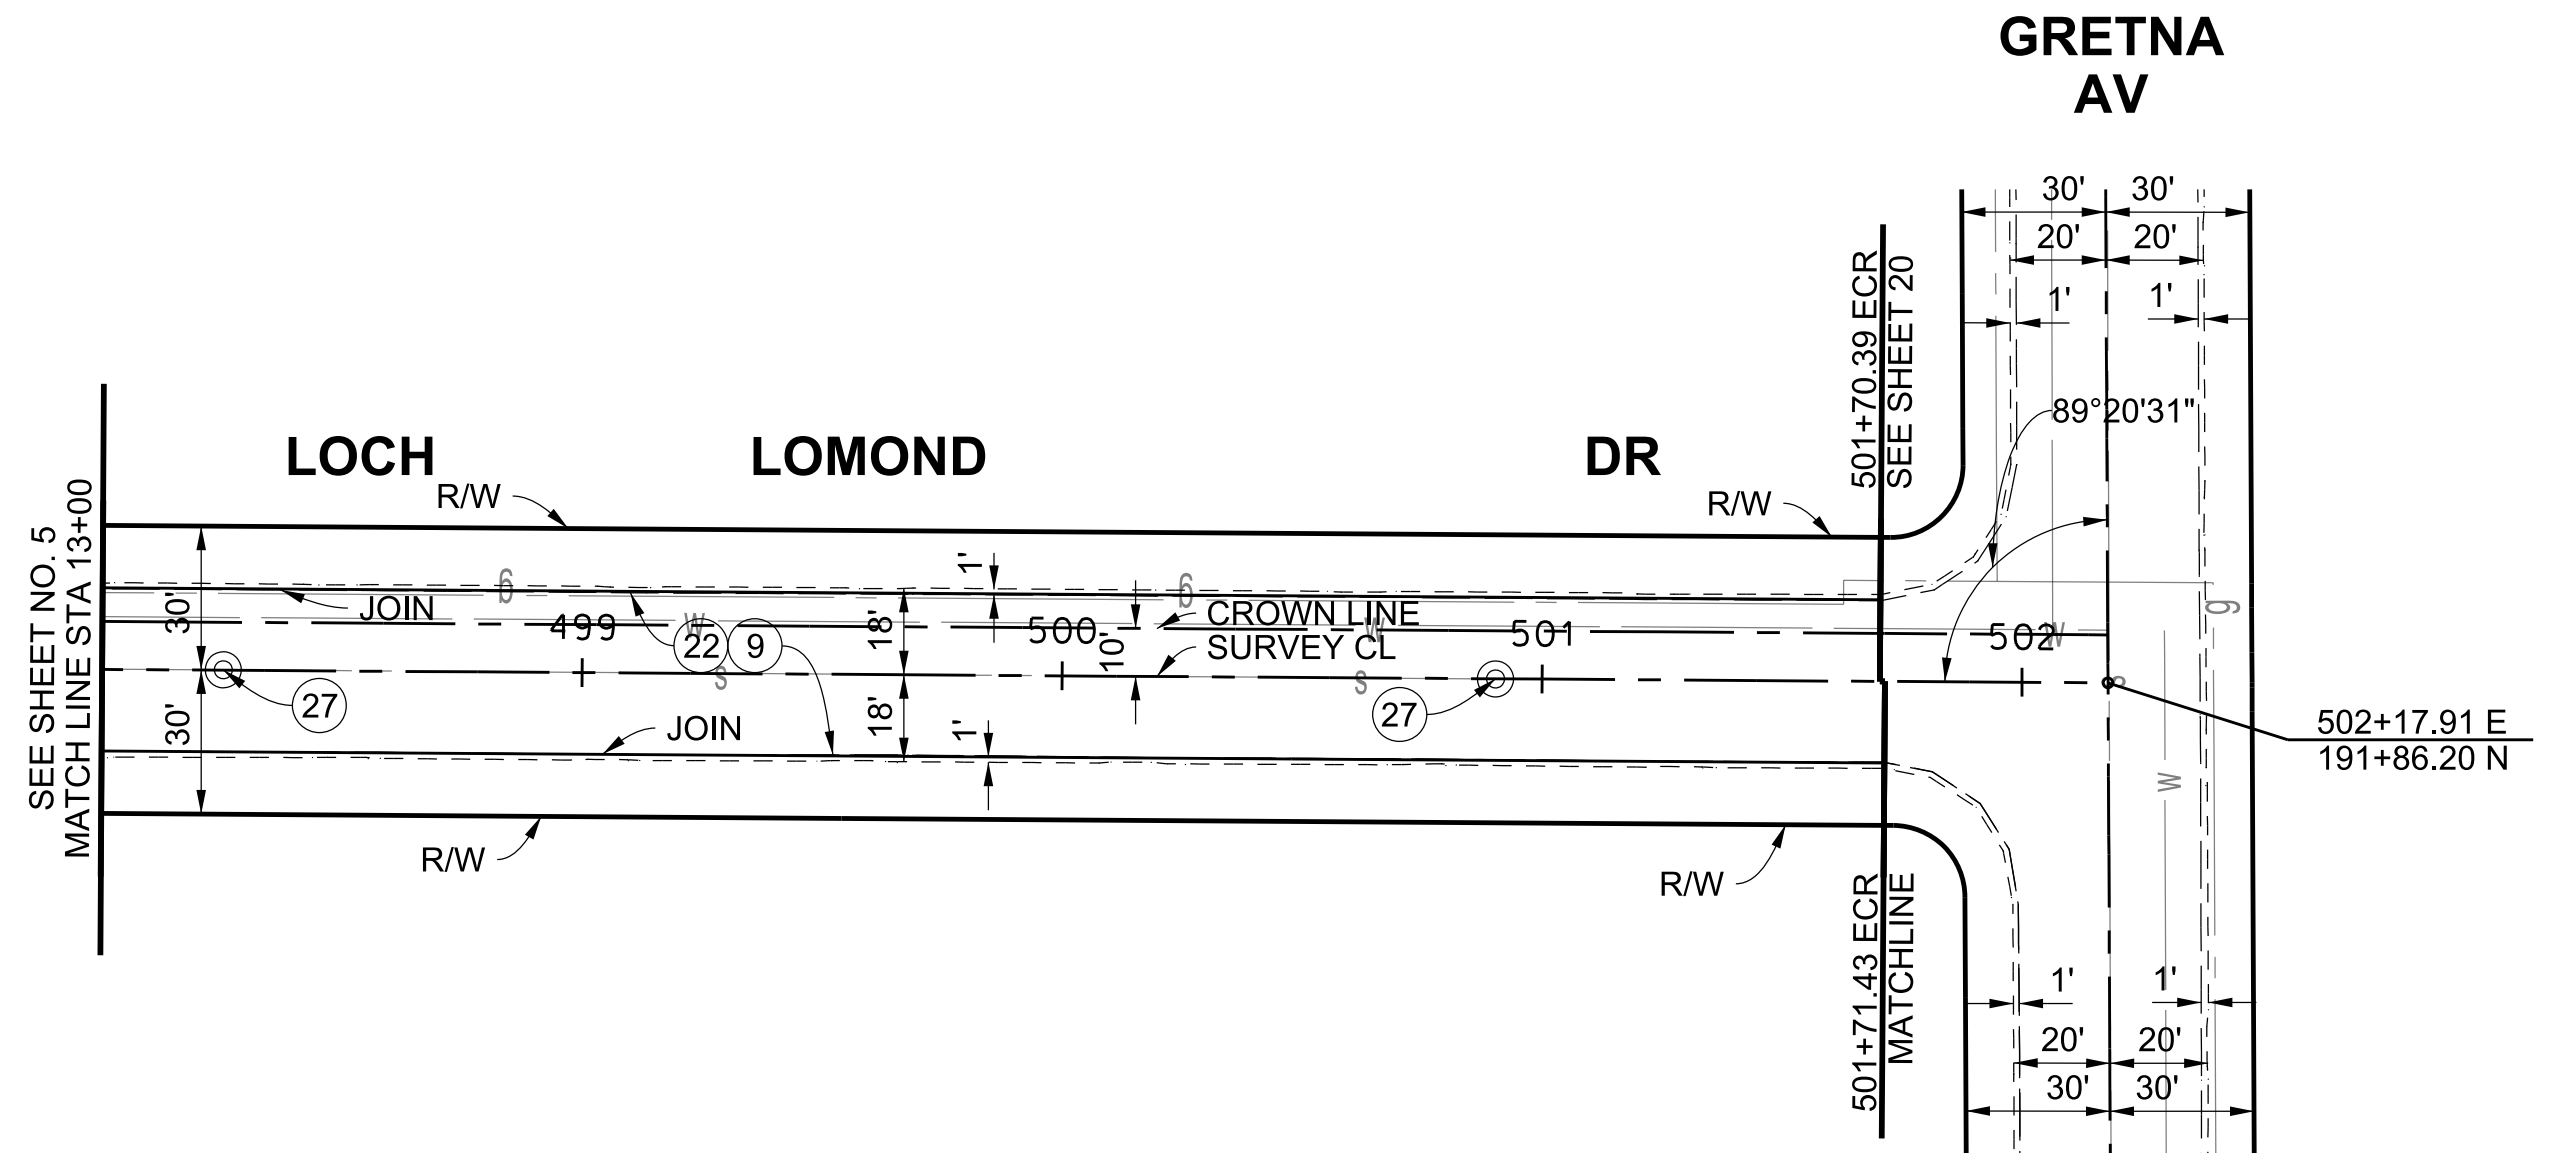

BENCHMARK
PT 602, ELEV 182.58 (WHITTIER & BASELINE QUAD 2005), PWFB 1027, PG 955
CL INT LOCH LOMOND DR & GREYNA AVE FD SQ. HEAD SPK, PER R2, DN 1"

LOS ANGELES COUNTY PUBLIC WORKS
SOUTH WHITTIER LOS NIETOS
KEITH DRIVE, ET AL.
PROJECT ID NO. RMD4408001
PLAN AND PROFILE



PROJECT ENGINEER: *R.S.* DATE: 6/24/19

DATE	MARK	DESCRIPTION
10/25/2021	■	AS-BUILT
REVISIONS		

PLAN
SCALE: 1"=40'

