



SCALE: HOR. 1"= 40'
VERT. 1"= 8'

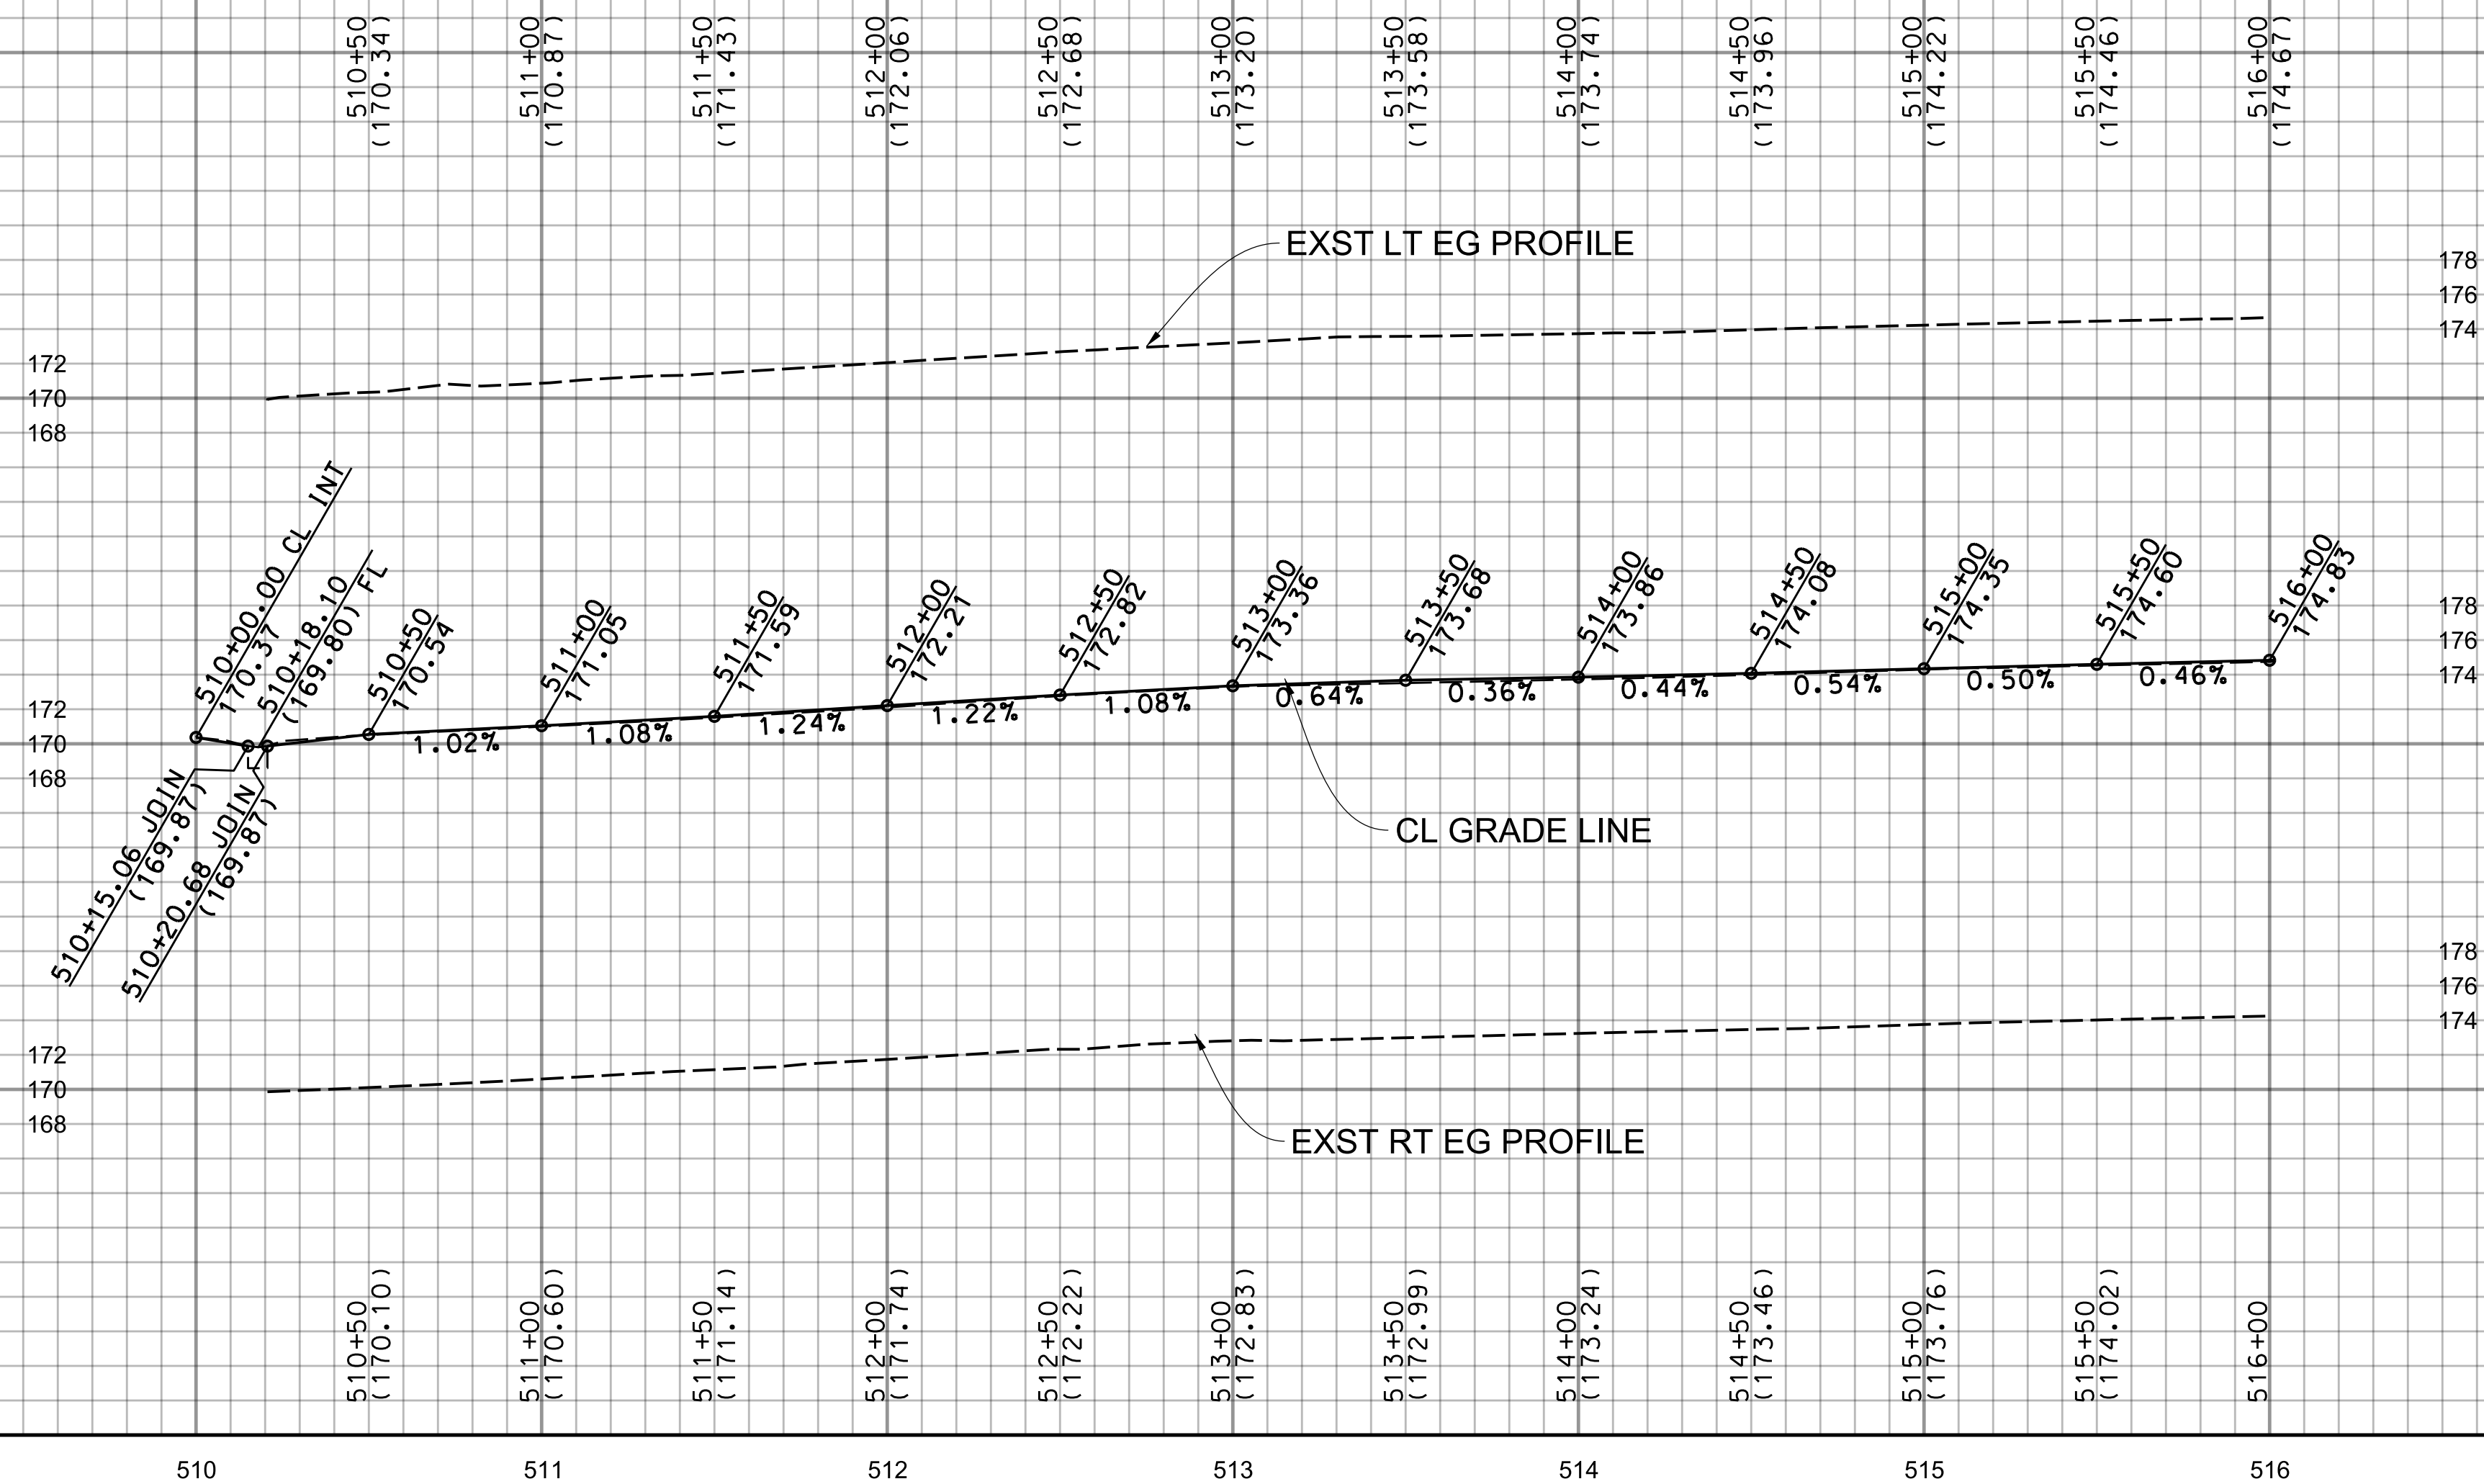

THORNLAKE AV

SEE SHEET 74 FOR PARKWAY IMPROVEMENTS

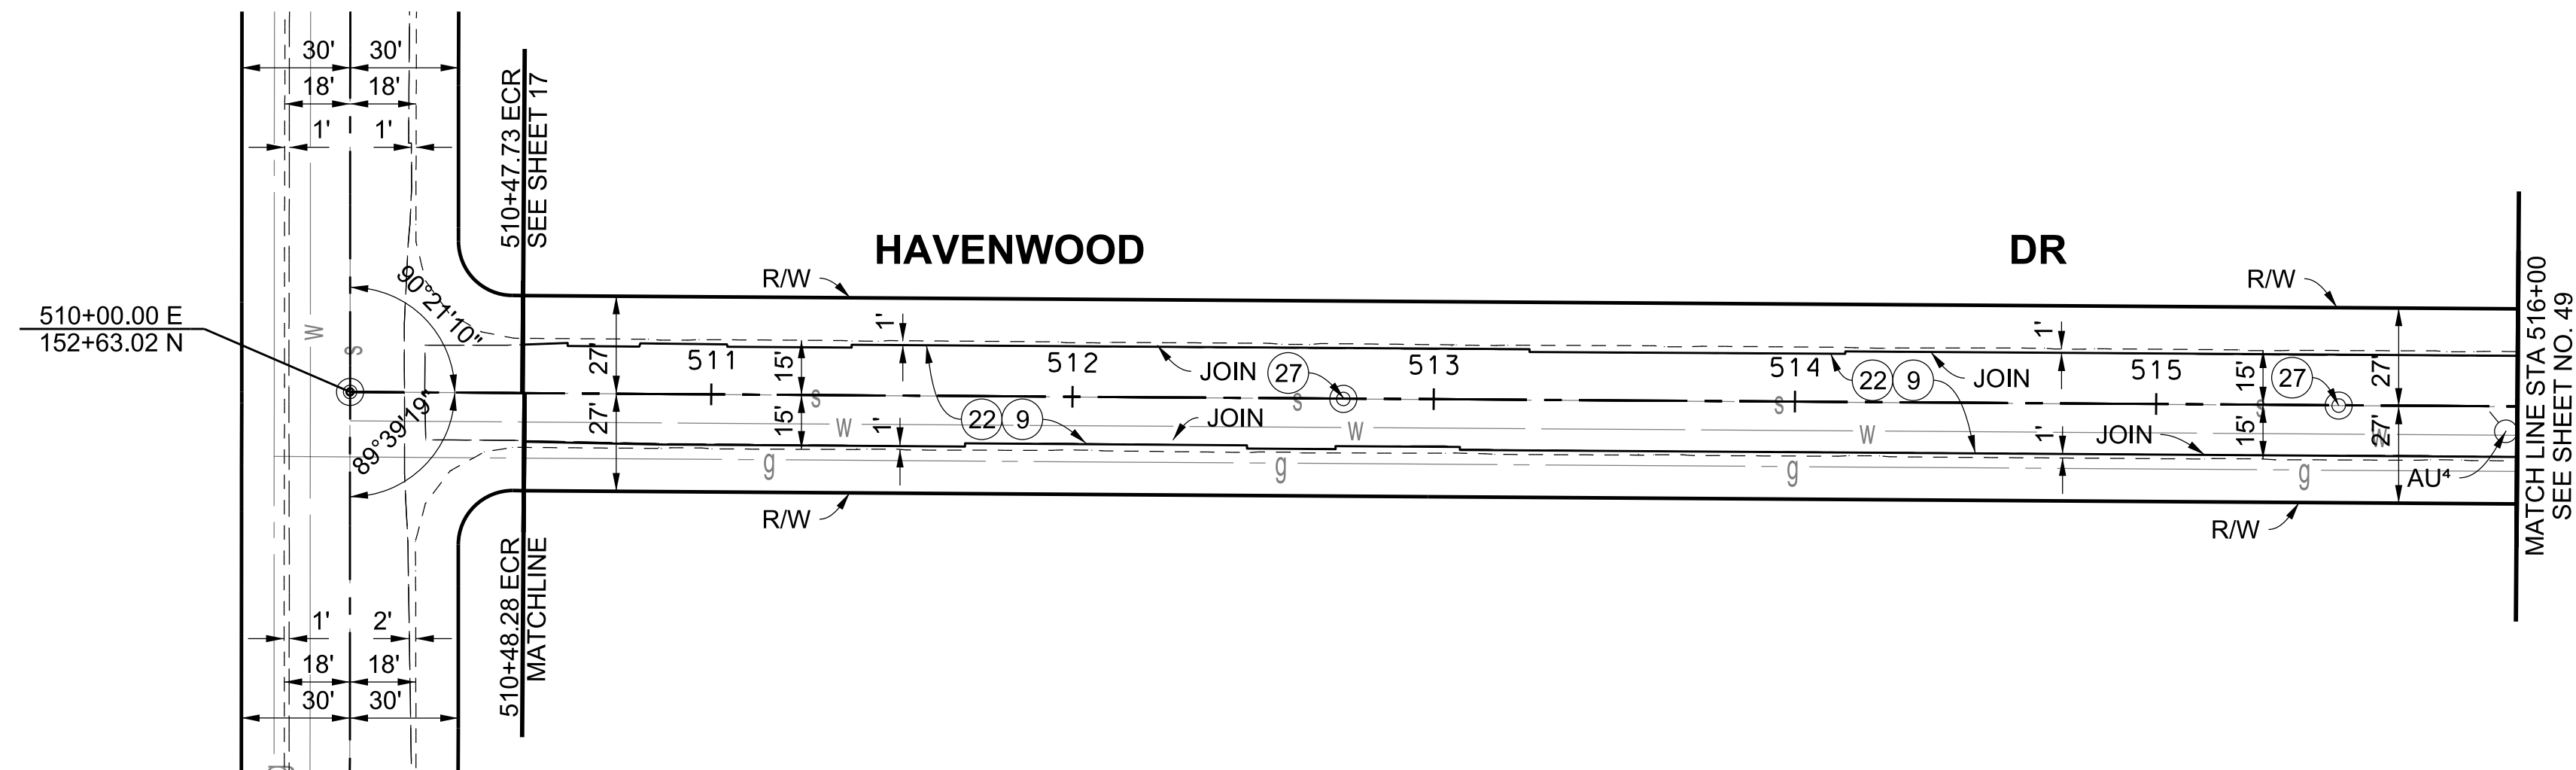

BENCHMARK
PT 629, ELEV 170.375 (WHITTIER & BASELINE QUAD 2005), PWFB 1026, PG 2188
CL INT HAVENWOOD & THORNLAKE AVE FD PM'S(4) IN MH RIM, PER R2

LOS ANGELES COUNTY PUBLIC WORKS

SOUTH WHITTIER LOS NIETOS
KEITH DRIVE, ET AL.

PROJECT ID NO. RMD4408001
PLAN AND PROFILE

PD PH086567 SHEET 48 OF 79

CADD PROJECT FILE NAME: \$FILESS
CHECKER: B. FUNG
DESIGNER: J. GARCIA
DRAFTER: J. GARCIA

PLAN
SCALE: 1"= 40'



DATE	MARK	DESCRIPTION
10/25/2021	AS-BUILT	
REVISIONS		



PROJECT ENGINEER: R. G. DATE: 6/24/19