



SCALE: HOR. 1"= 40'
VERT. 1"= 8'

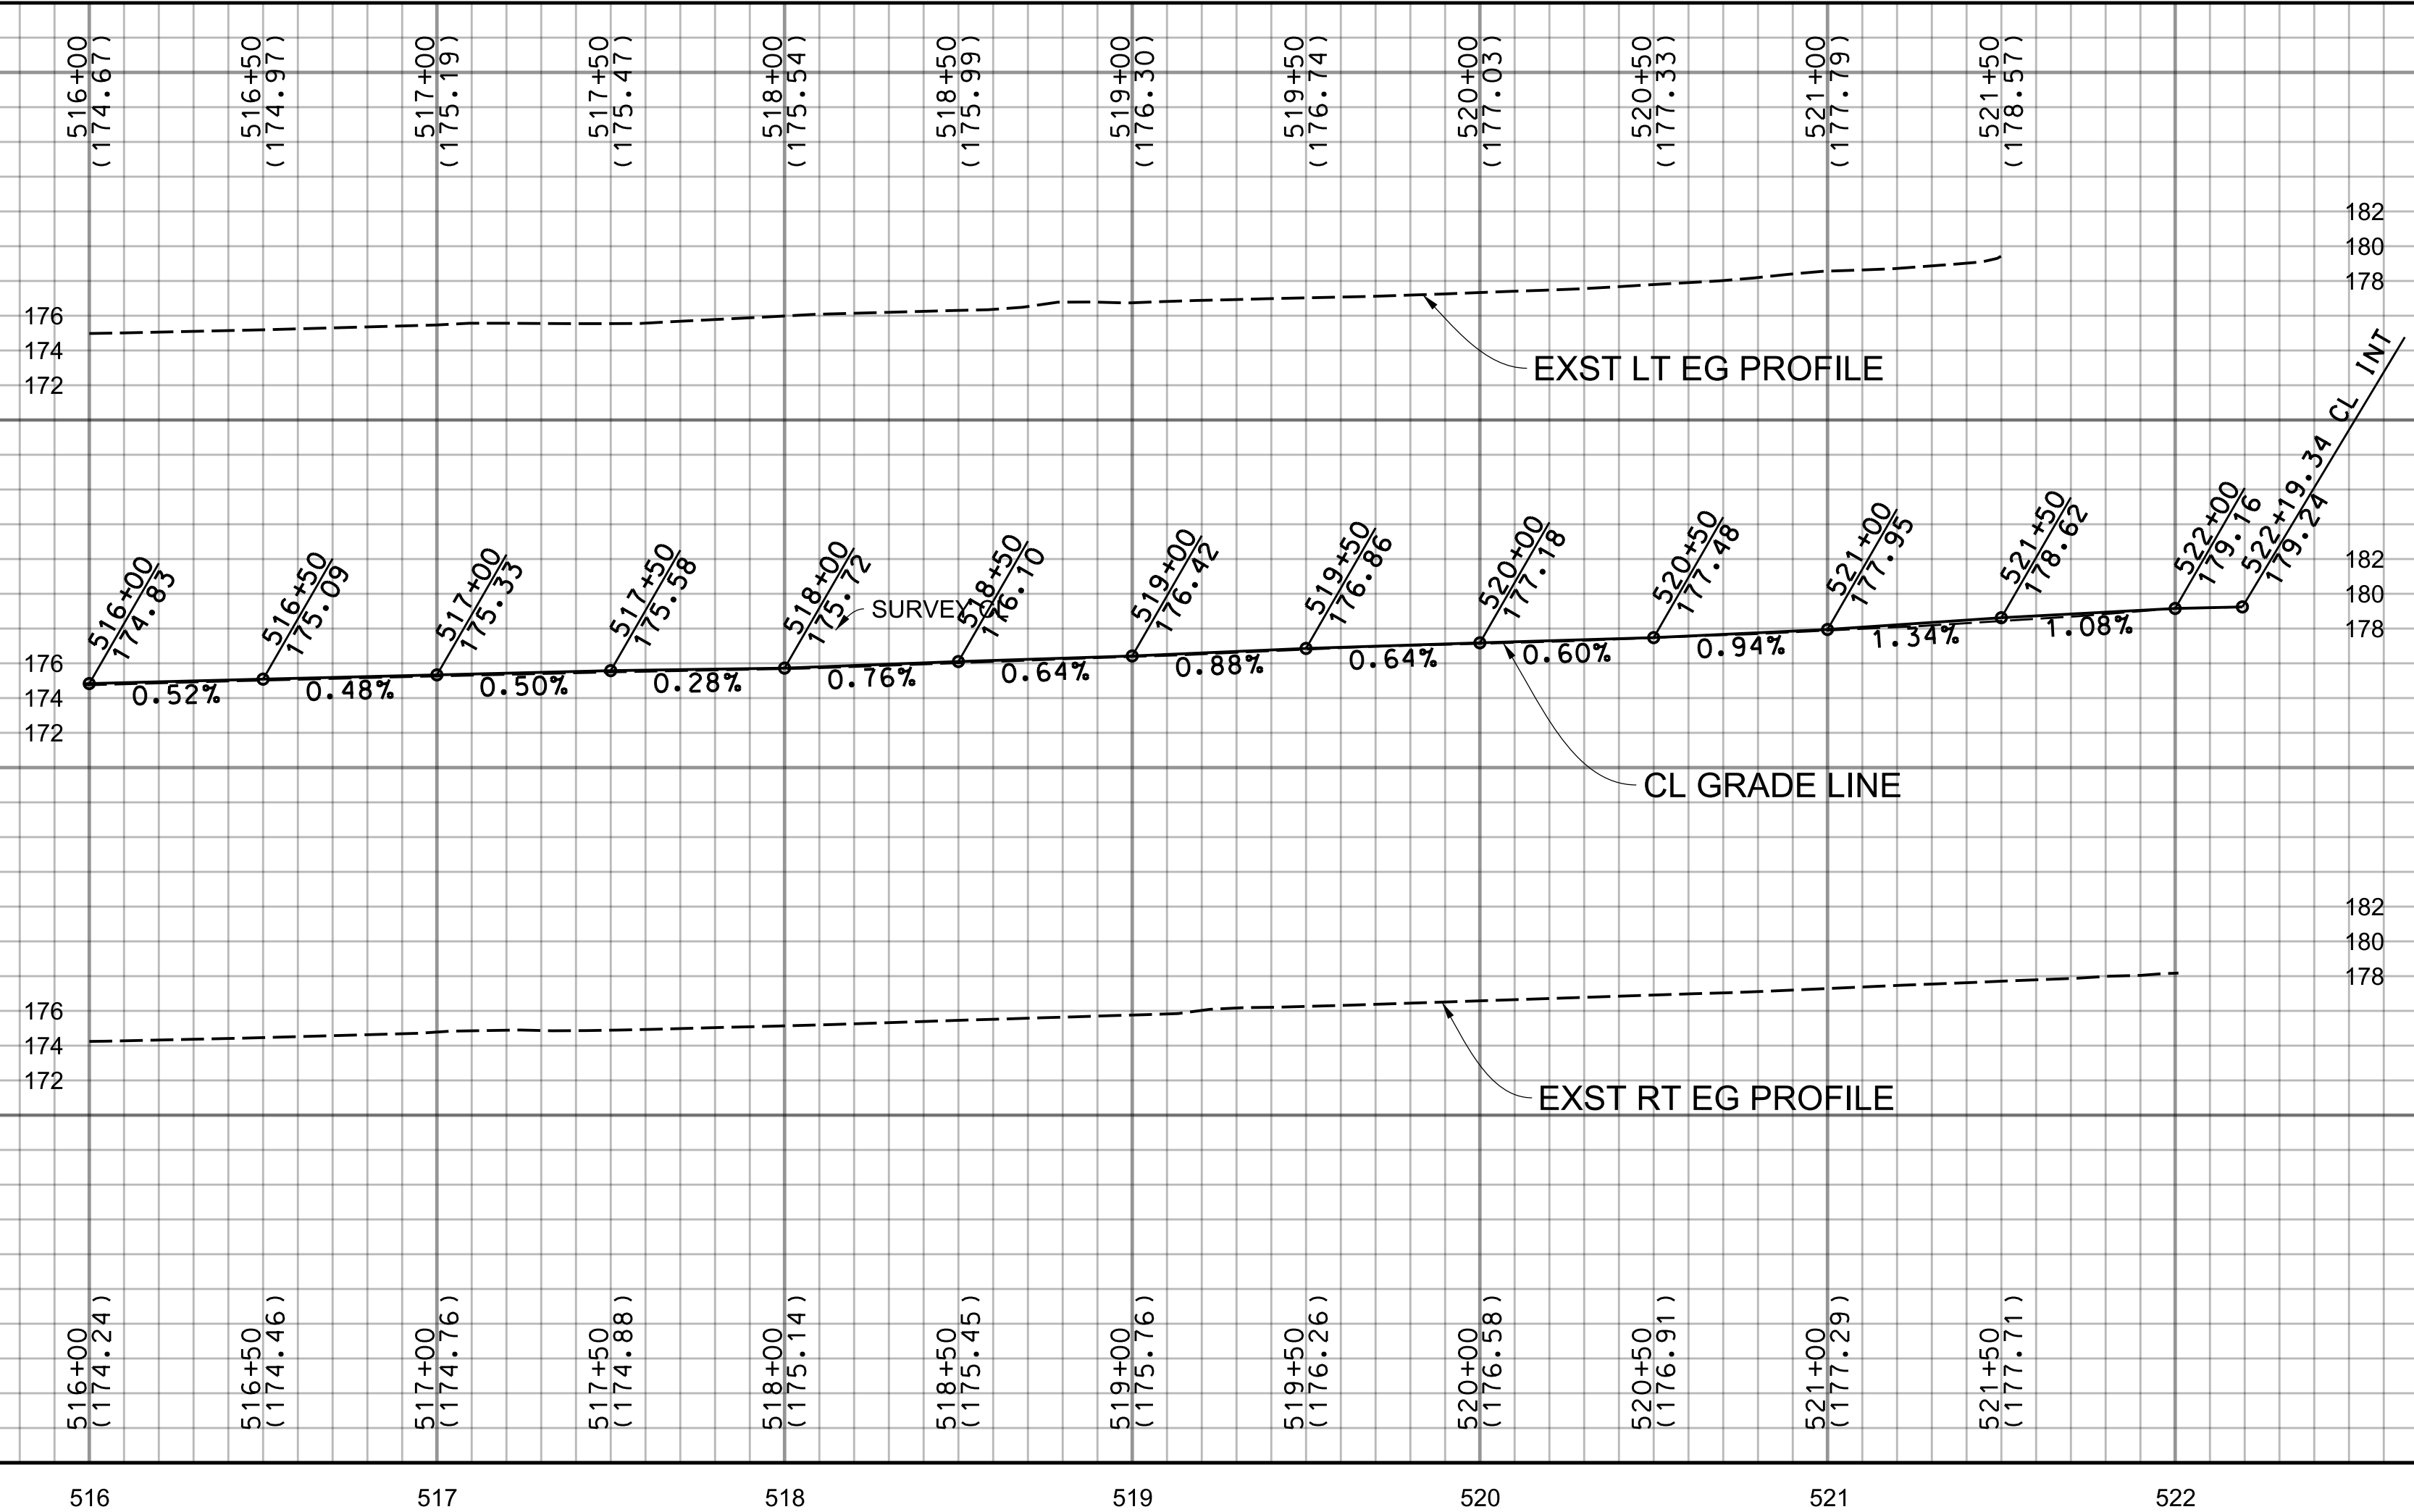


516 517 518 519 520 521 522

SEE SHEET 74 FOR PARKWAY IMPROVEMENTS

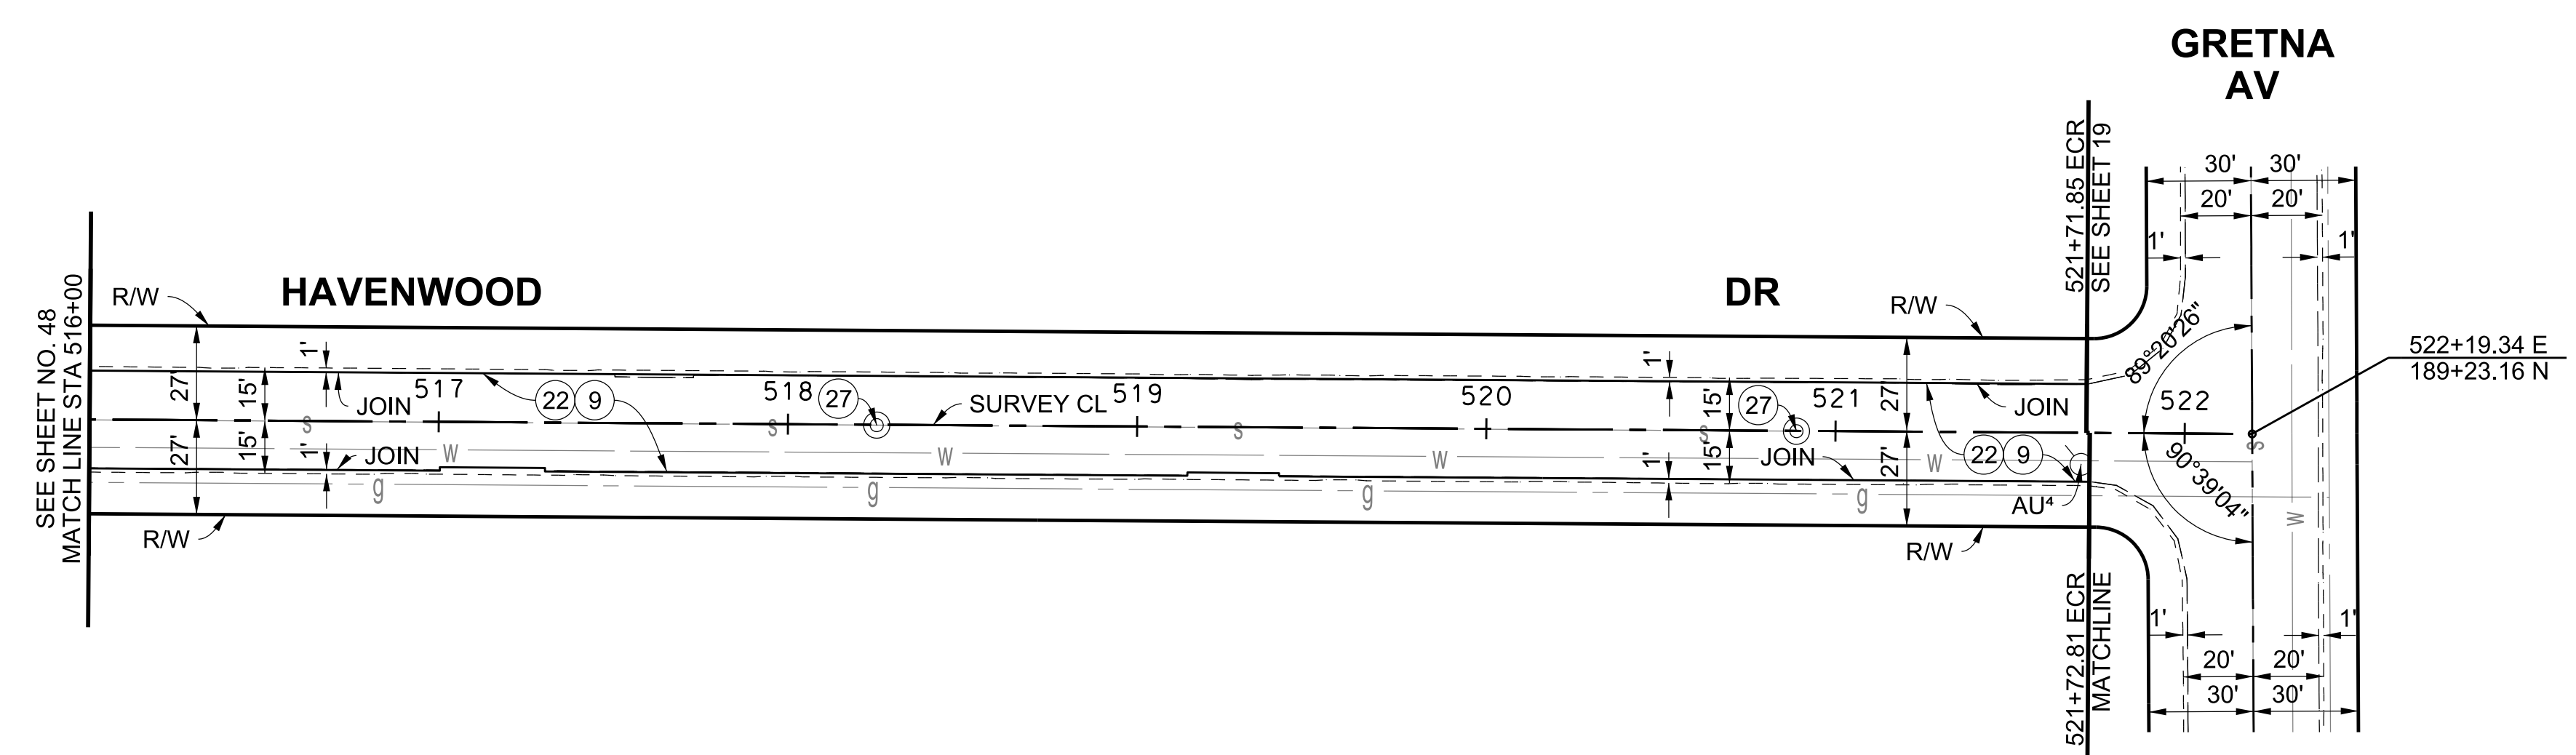

CADD PROJECT FILE NAME: \$FILES\$
 CHECKER: B. FUNG
 DESIGNER: J. GARCIA
 DRAFTER: J. GARCIA

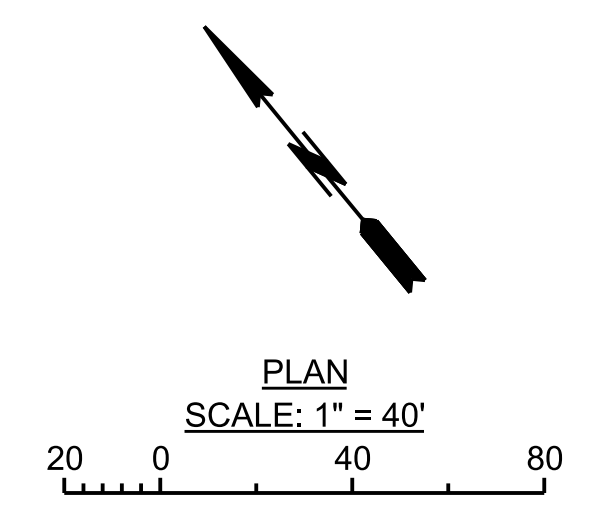

BENCHMARK
 PT 601, ELEV 179.245 (WHITTIER & BASELINE QUAD 2005), PWFB 1027, PG 954
 CL INT. HAVENWOOD DR & GRETNA AVE FD SQ. HEAD APK, R2, FL

LOS ANGELES COUNTY PUBLIC WORKS
SOUTH WHITTIER LOS NIETOS
 KEITH DRIVE, ET AL.
 PROJECT ID NO. RMD4408001
 PLAN AND PROFILE
 PD PH086568 SHEET 49 OF 79

DATE	MARK	DESCRIPTION
10/25/2021	AS-BUILT	
REVISIONS		

REGISTERED PROFESSIONAL ENGINEER
 BRIAN FUNG
 C 76772
 CIVIL
 STATE OF CALIFORNIA
 PROJECT ENGINEER DATE: 6/24/19