



SCALE: HOR. 1"= 40'
VERT. 1"= 8'

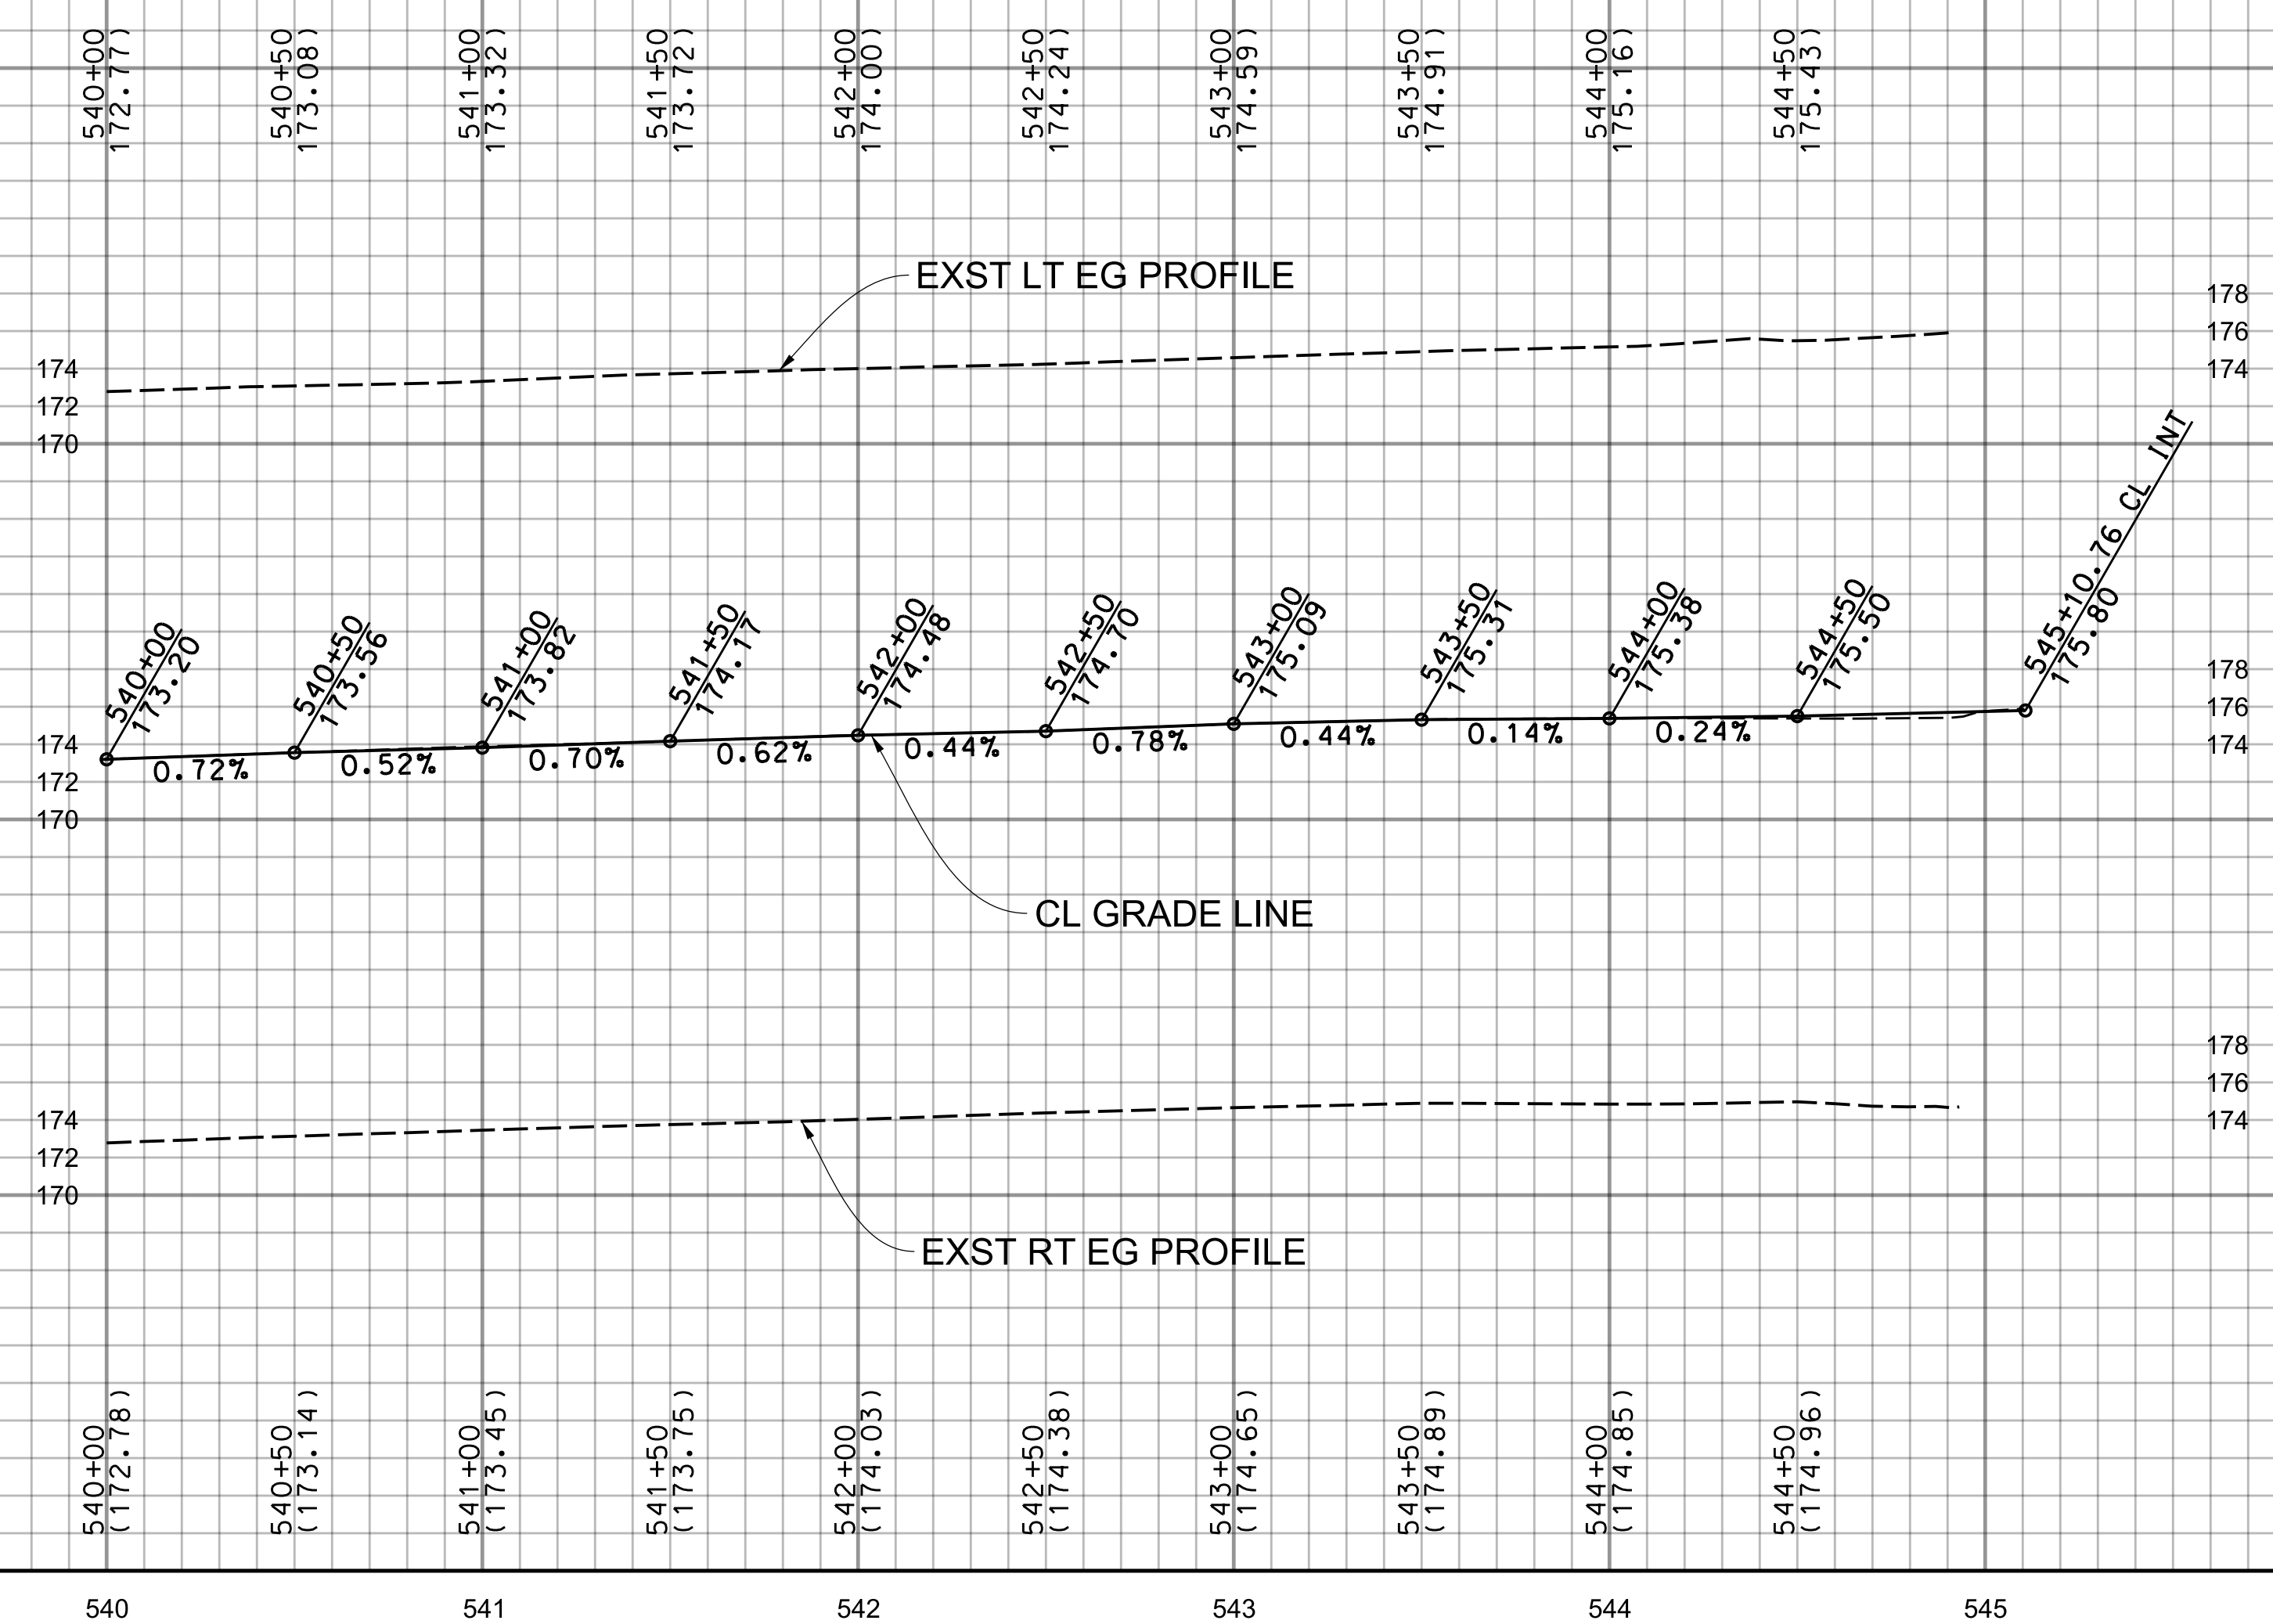

SEE SHEET 74 FOR PARKWAY IMPROVEMENTS

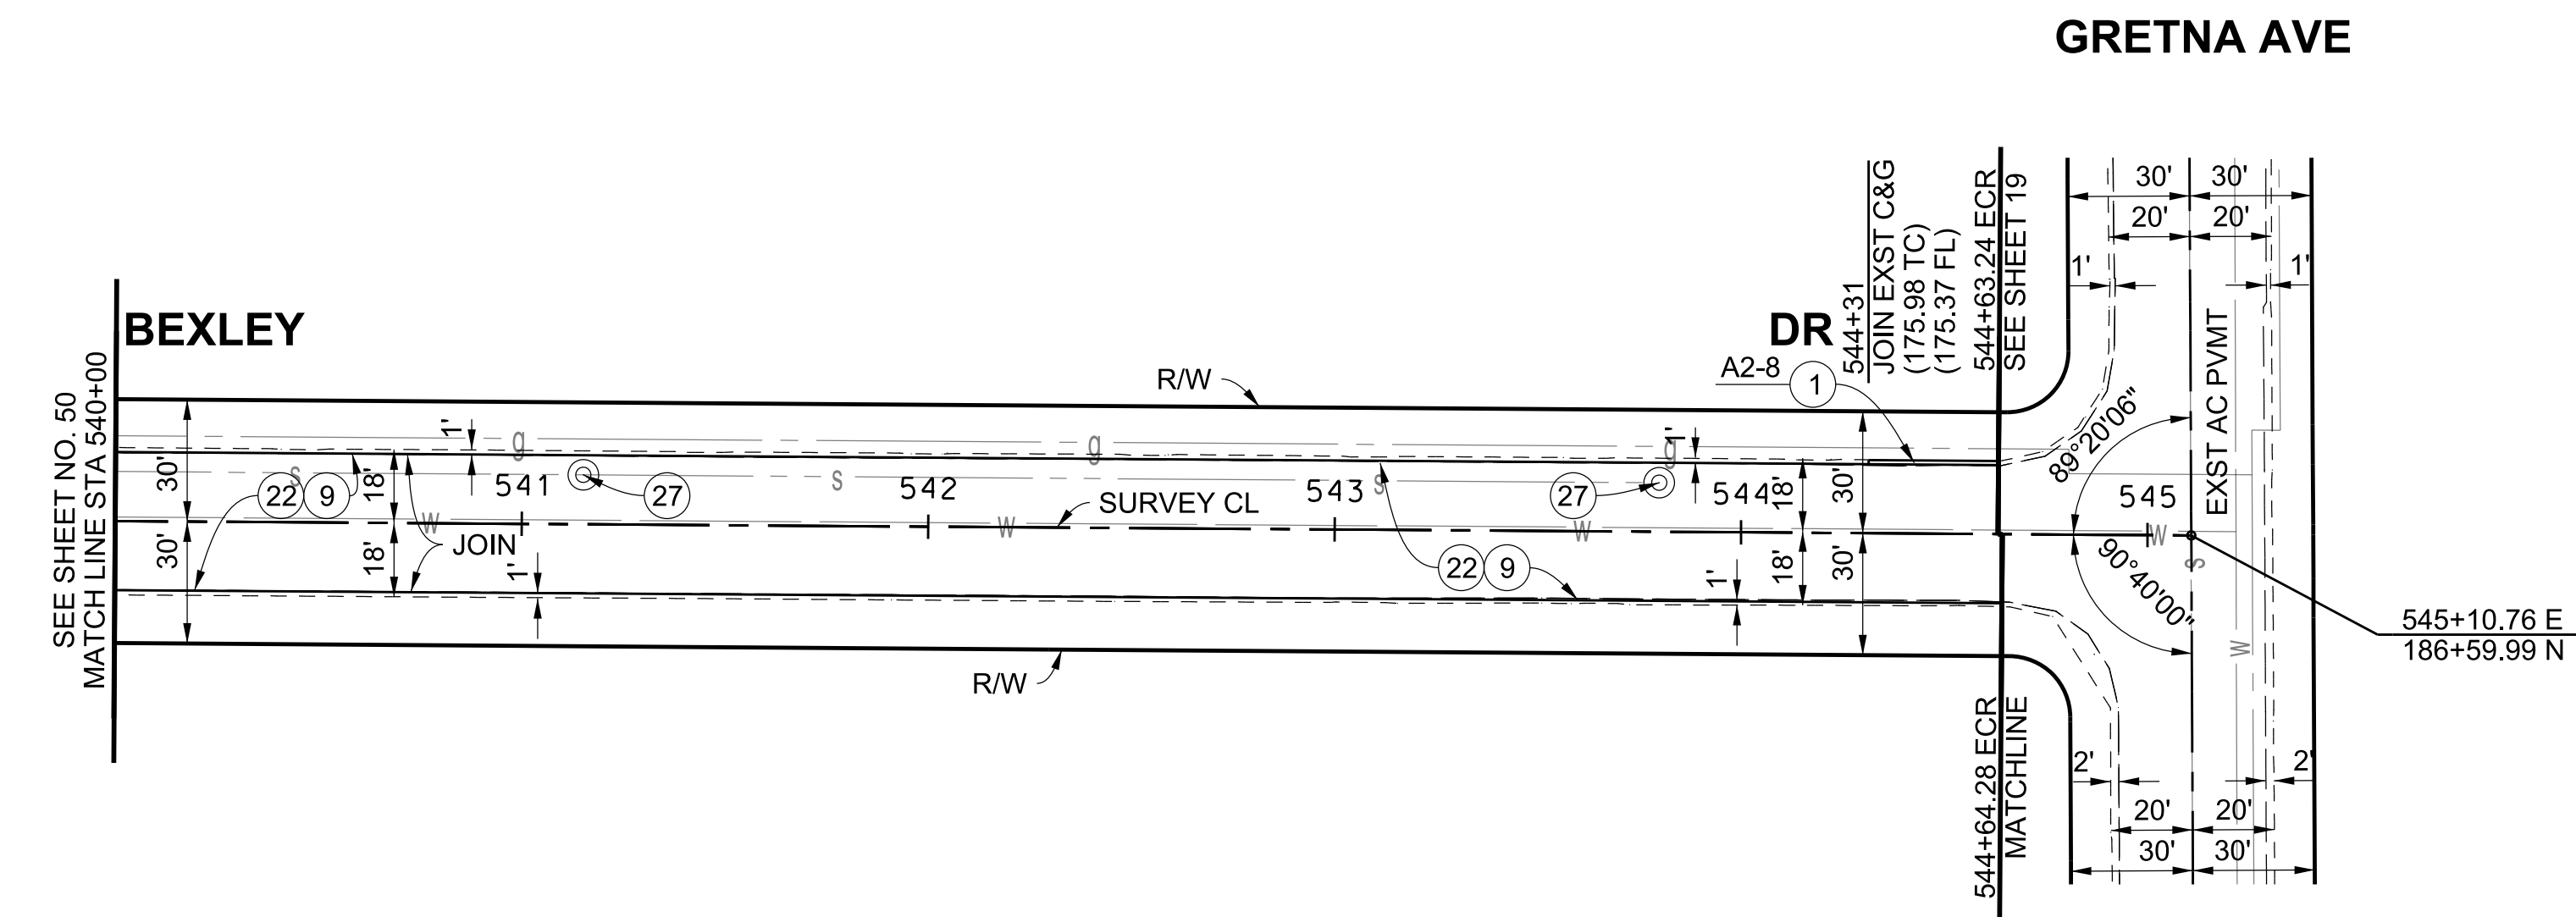

BENCHMARK
PT 600, ELEV 175.755 (WHITTIER & BASELINE QUAD 2005), PWFB 1027, PG 953
CL INT. BEXLEY DR & GRETTNA AVE FD PK NAIL, FL IN LIEU OF SQ. HD SPK & T PER R2

LOS ANGELES COUNTY PUBLIC WORKS

SOUTH WHITTIER LOS NIETOS
KEITH DRIVE, ET AL.


PROJECT ID NO. RMD4408001
PLAN AND PROFILE

PD PH086570 SHEET 51 OF 79



PROJECT ENGINEER: *B. Fung*
DATE: 6/24/19

DATE	MARK	DESCRIPTION
10/25/2021	AS-BUILT	
REVISIONS		

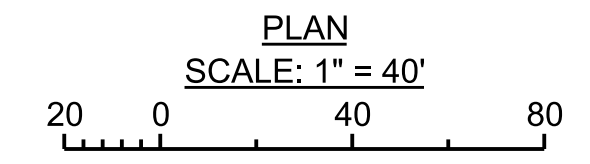

CADD PROJECT FILE NAME: \$FILESS
CHECKER: B. FUNG
DESIGNER: J. GARCIA
DRAFTER: J. GARCIA