

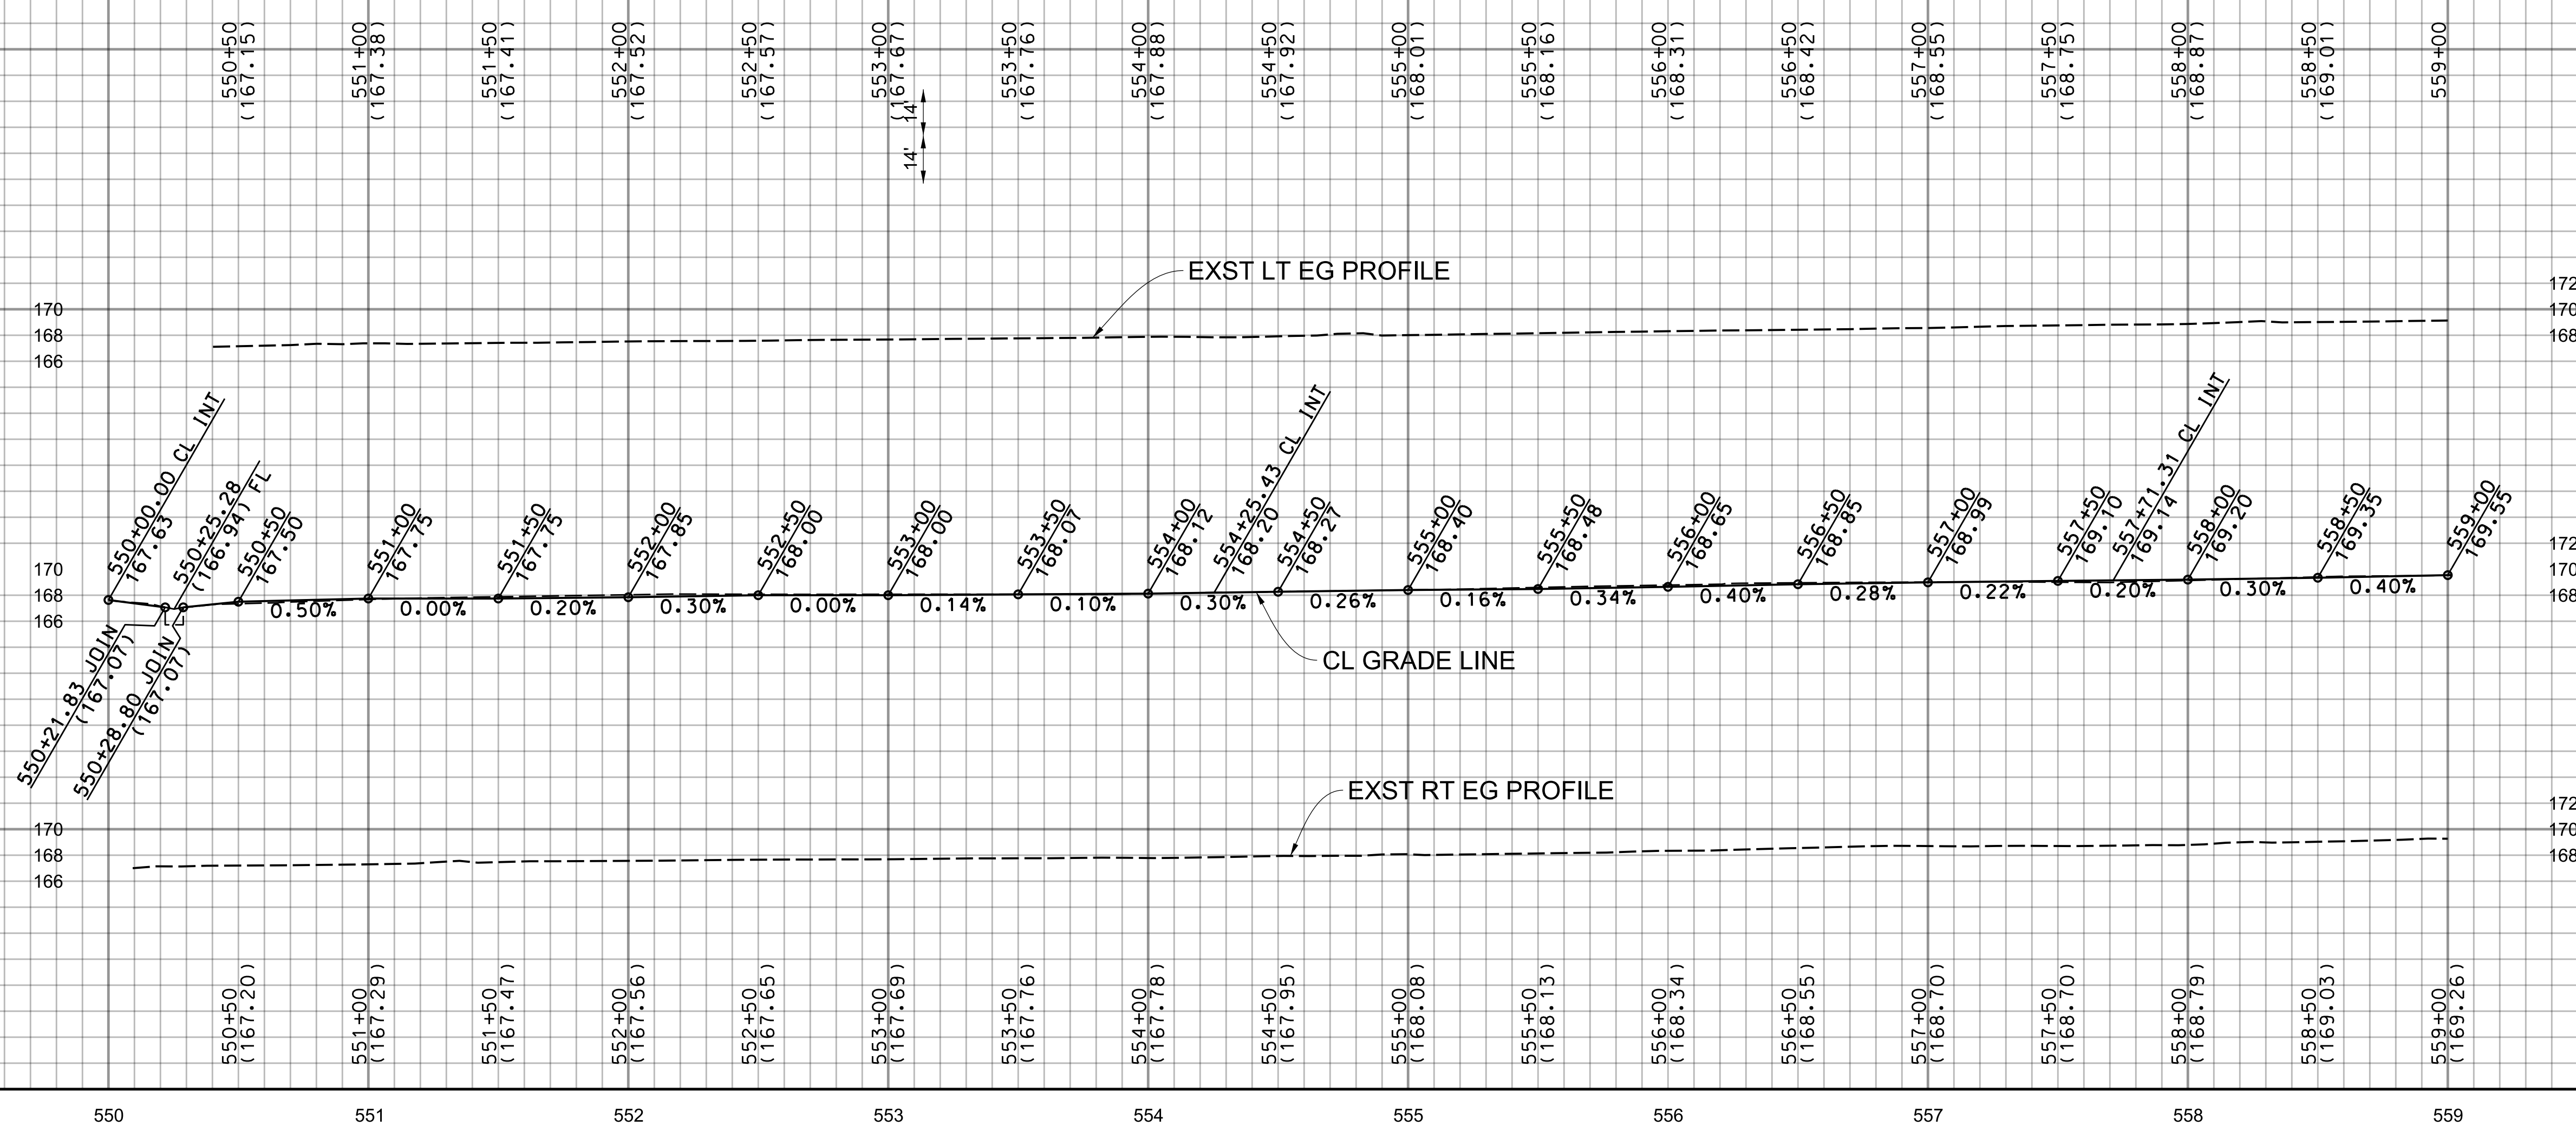


SCALE: HOR. 1"= 40'
VERT. 1"= 8'

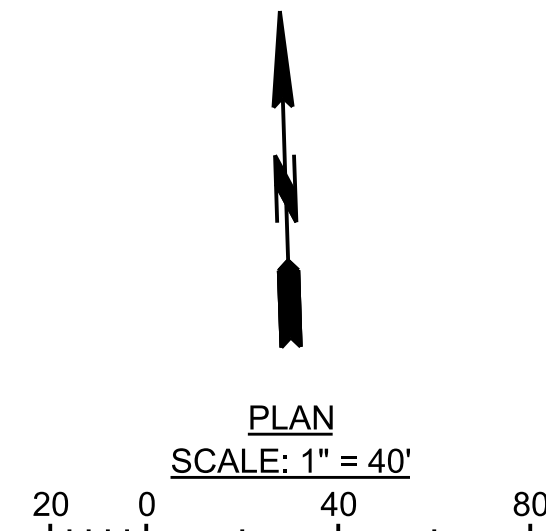

SEE SHEET 75 FOR PARKWAY IMPROVEMENTS

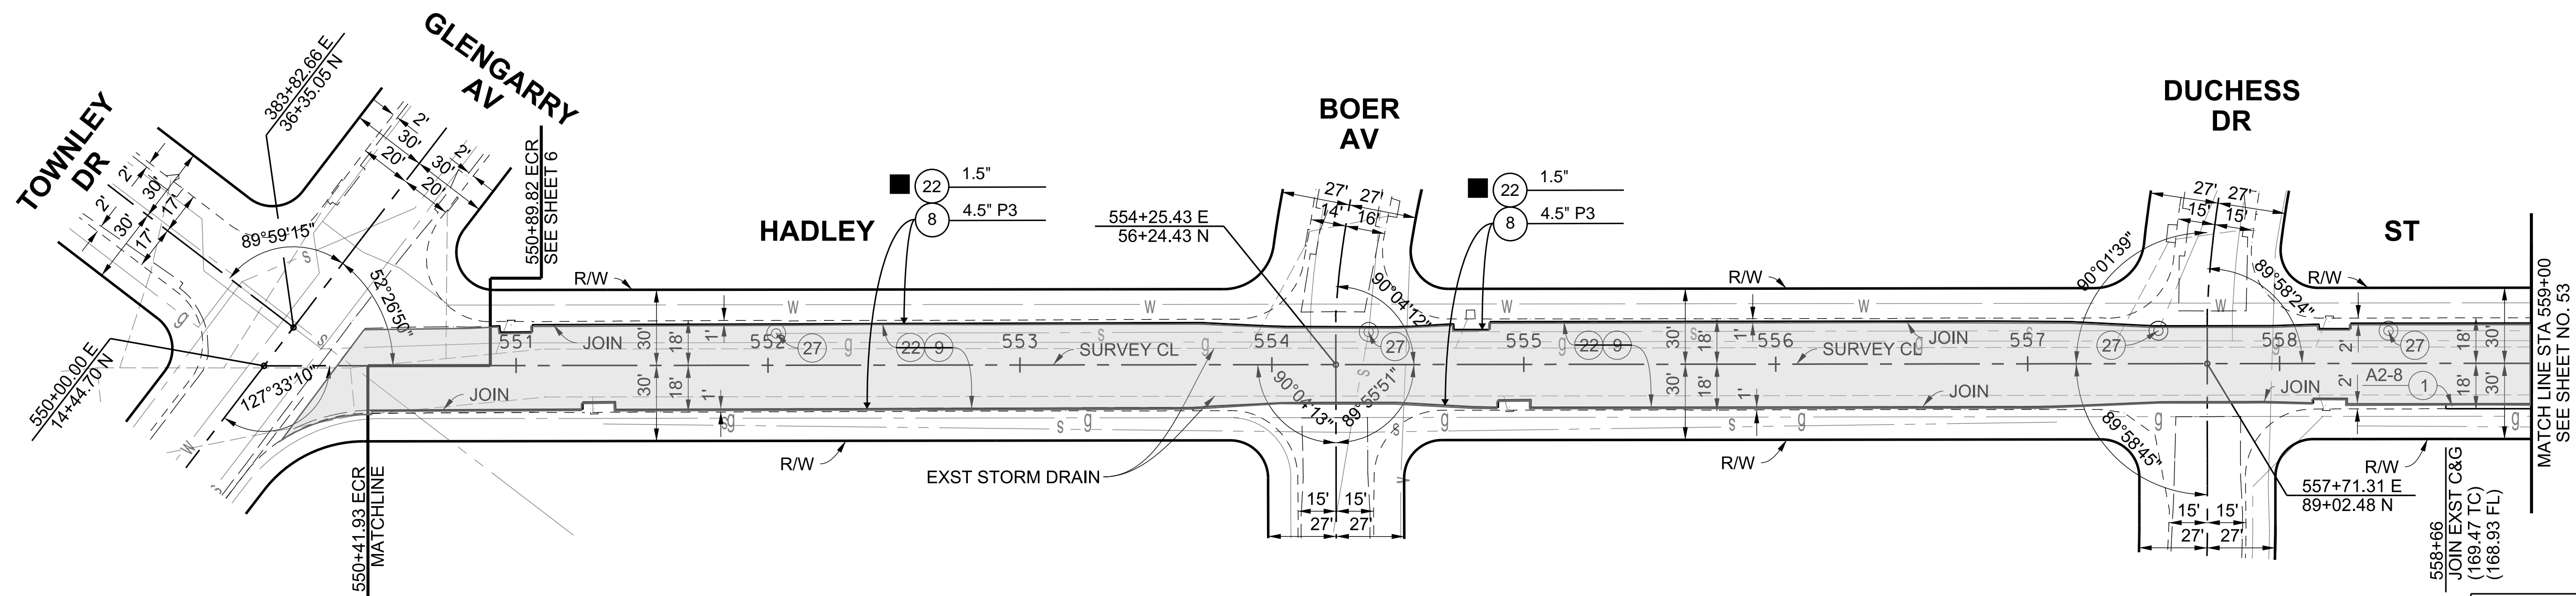

BENCHMARK
PT 136, ELEV 166.77 (WHITTIER & BASELINE QUAD 2005), PWFB 1026, PG 2126
CL INT. TOWNLEY DR & GLENGARRY AVE FD CO SUR MON IN HH, PER R1
RAISED LID TO SURF.

LOS ANGELES COUNTY PUBLIC WORKS
SOUTH WHITTIER LOS NIETOS
KEITH DRIVE, ET AL.
PROJECT ID NO. RMD4408001
PLAN AND PROFILE



R.S. PROJECT ENGINEER
6/24/19 DATE

DATE	MARK	DESCRIPTION
10/25/2021	AS-BUILT	
REVISIONS		