

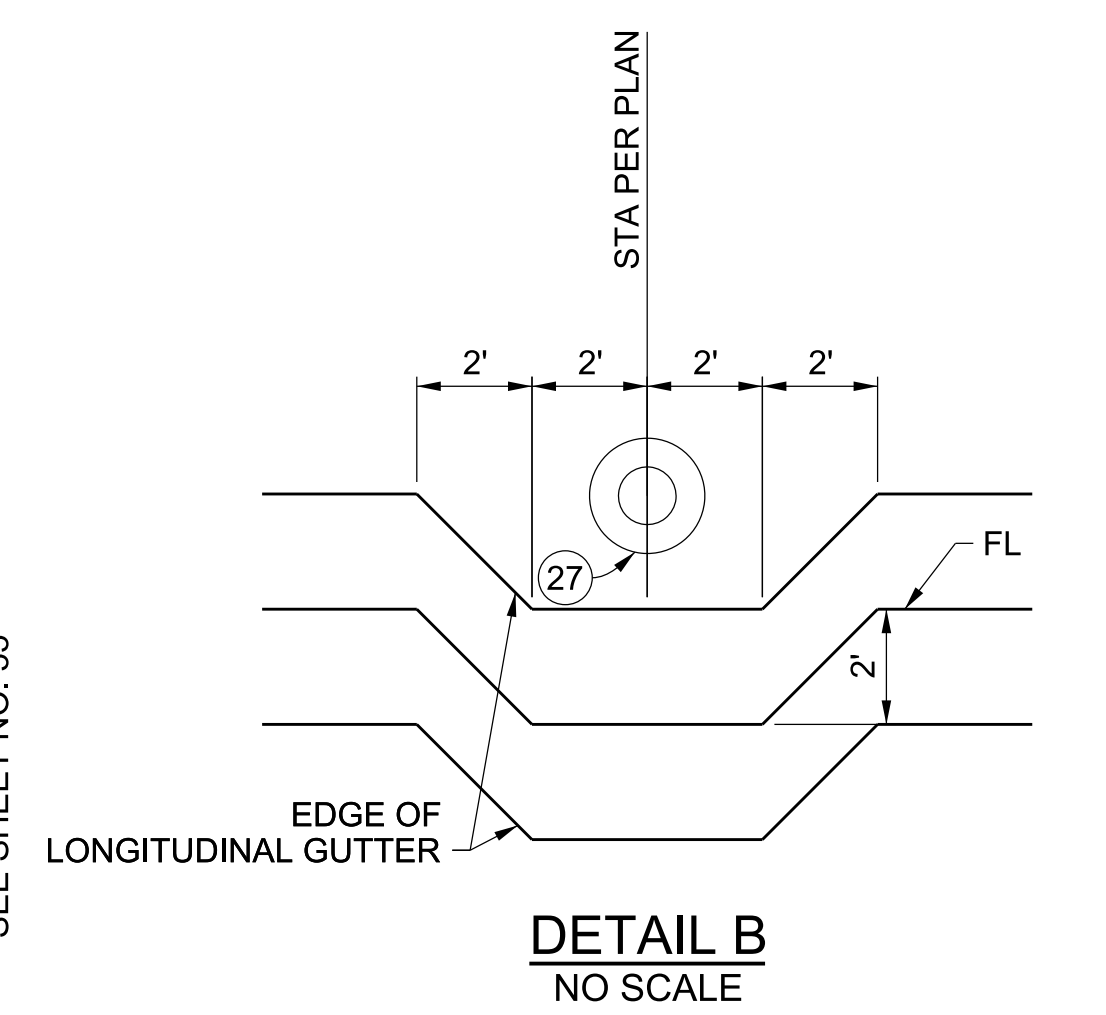
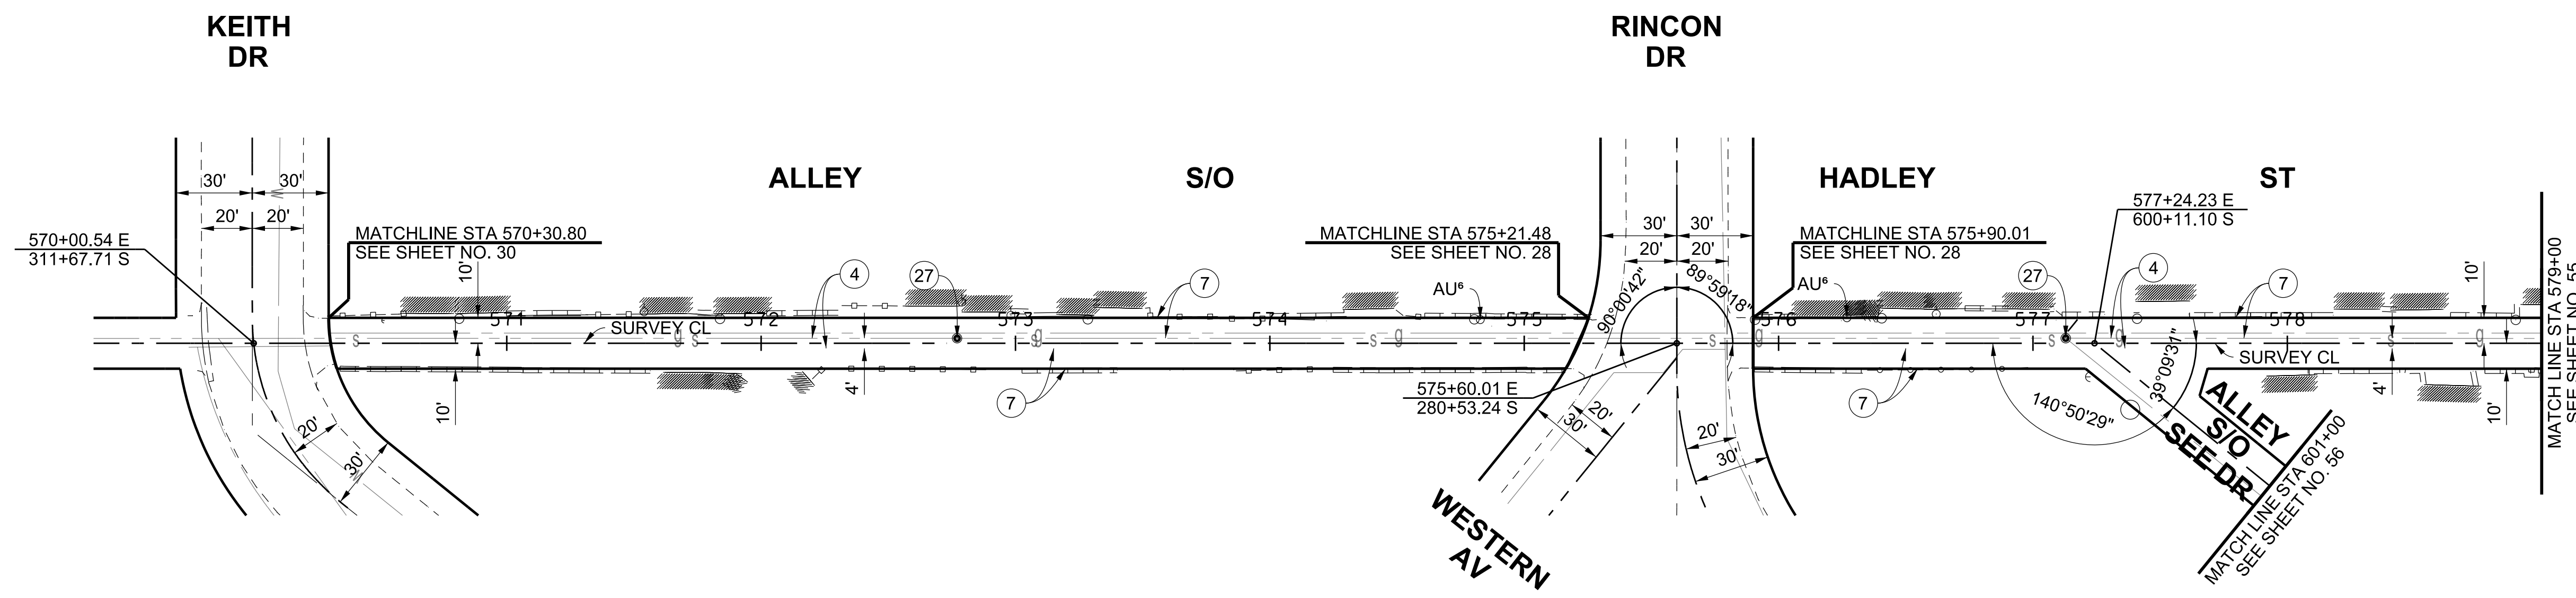



SCALE: HOR. 1"=40'
VERT. 1"=8'

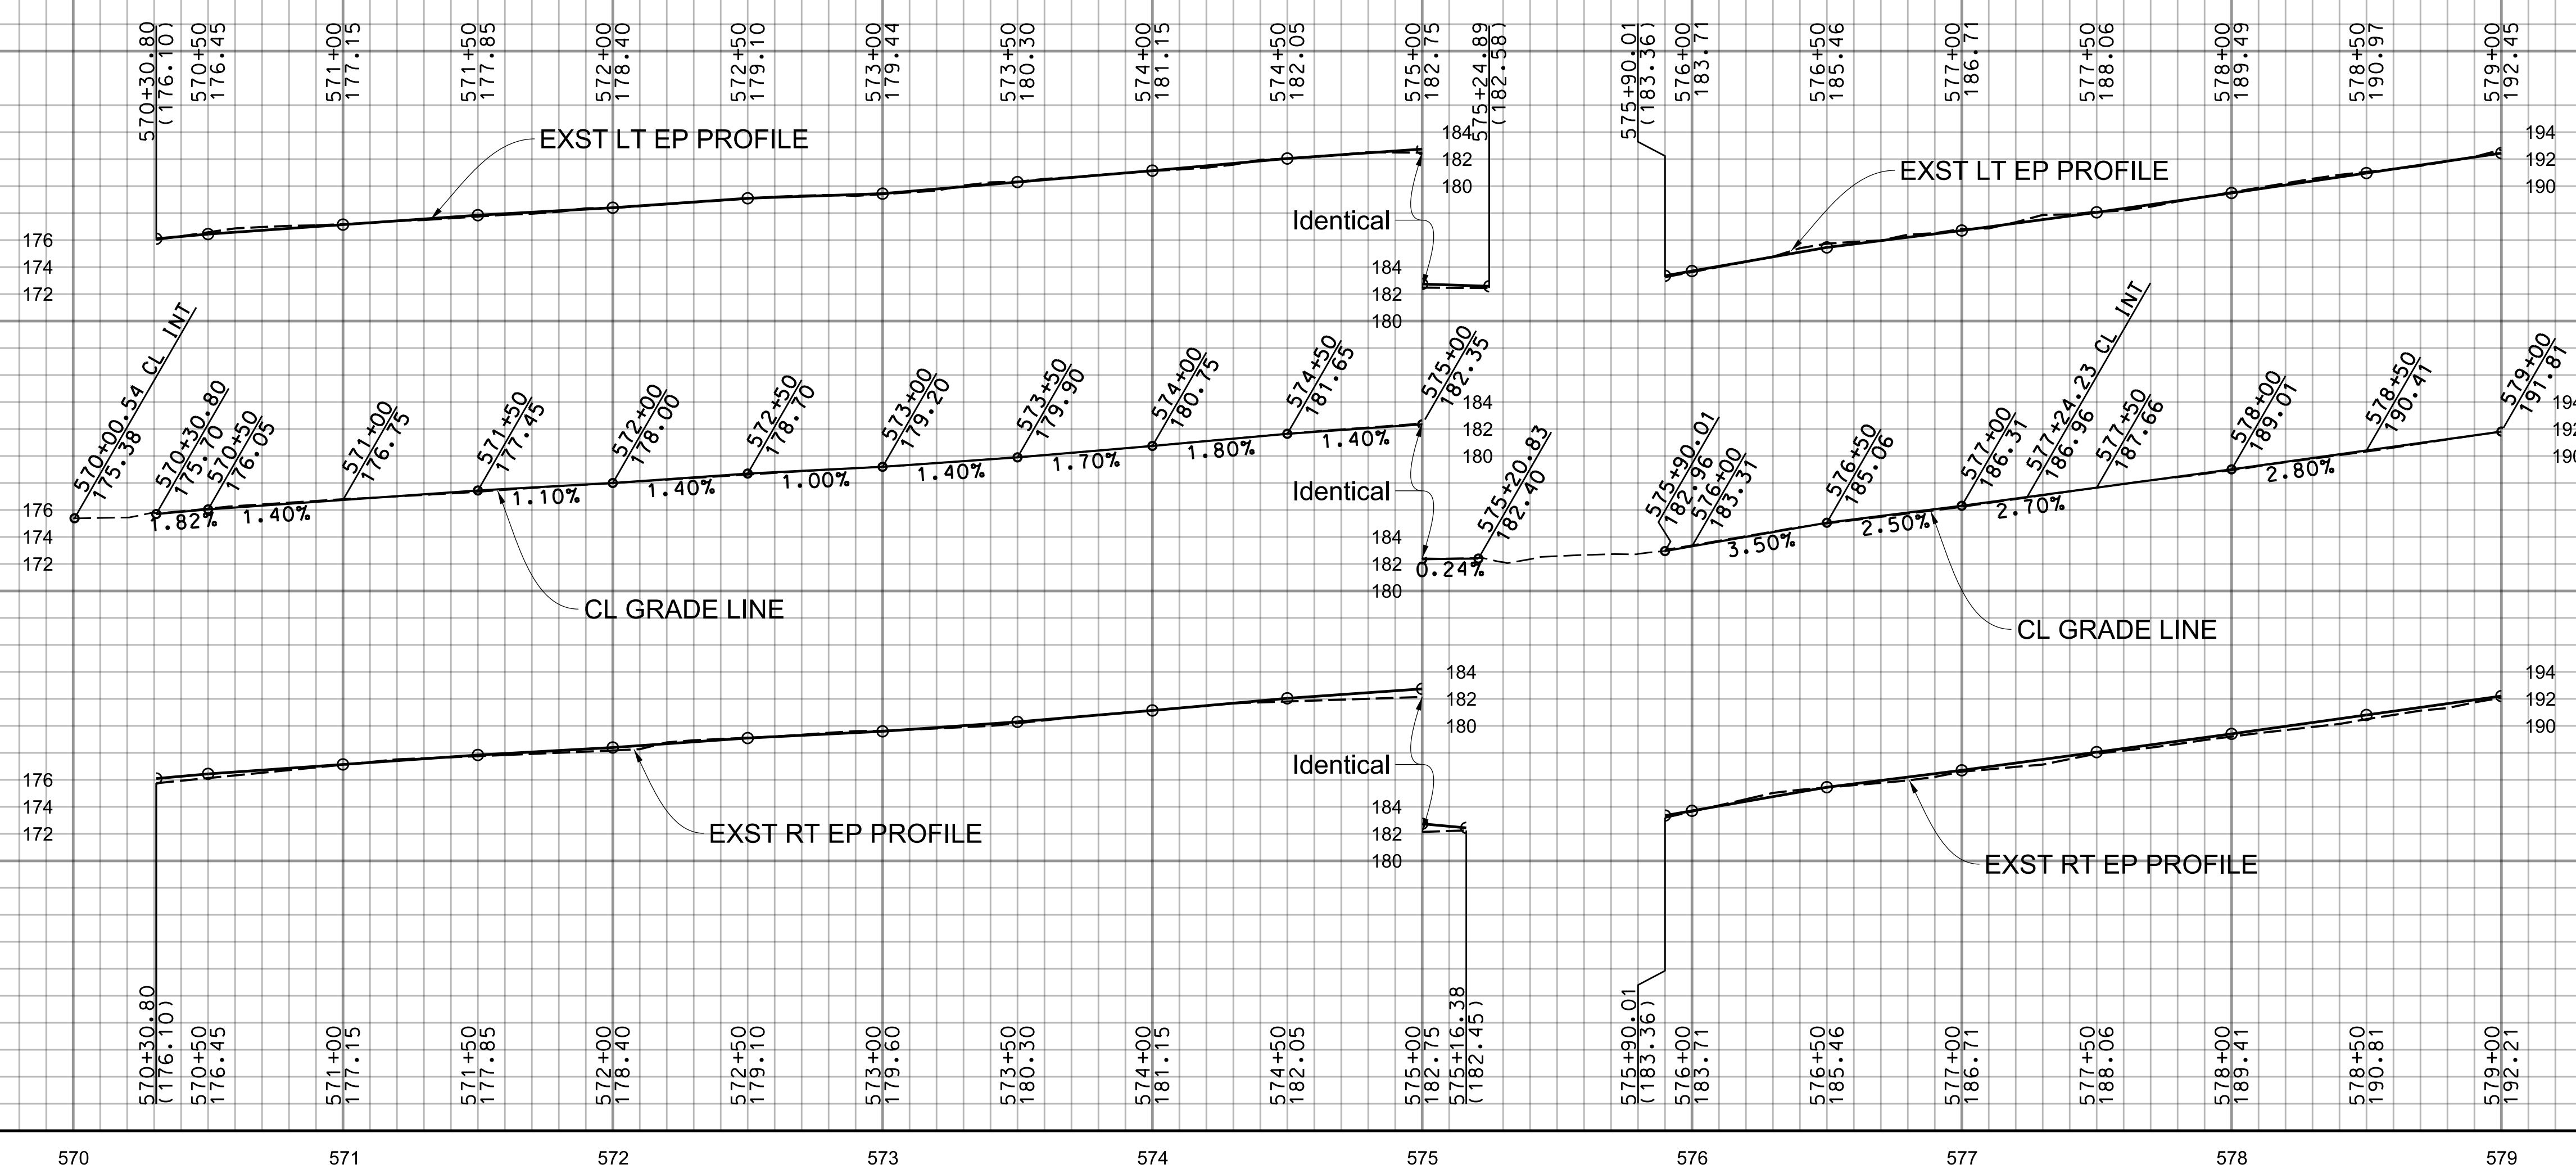

CADD PROJECT FILE NAME: \$FILESS
CHECKER: B. FUNG
DESIGNER: J. GARCIA
DRAFTER: J. GARCIA

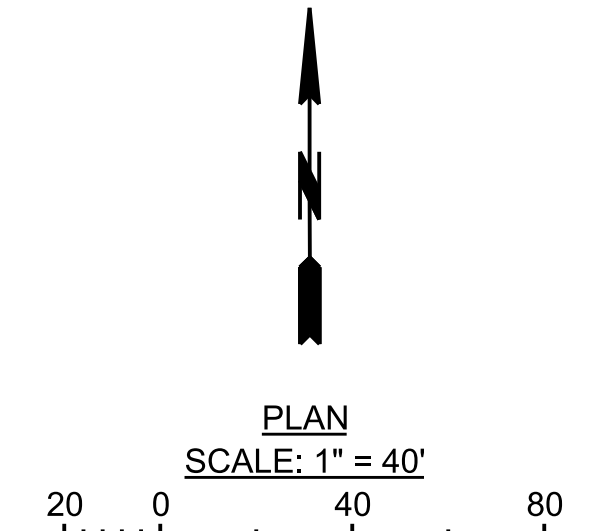

DATE	MARK	DESCRIPTION
10/25/2021	AS-BUILT	
REVISIONS		

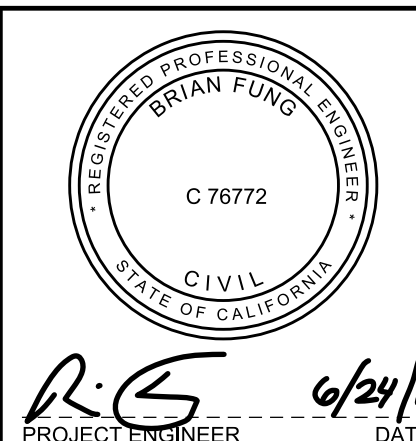

BENCHMARK
PT 638, ELEV 175.38 (WHITTIER & BASELINE QUAD 2005), PWFB 1027, PG 962
CL INT. KEITH DR & ALLEY S/O HADLEY ST FD SQ. HD. SPK&T PER R1, FL

LOS ANGELES COUNTY PUBLIC WORKS
SOUTH WHITTIER LOS NIETOS
KEITH DRIVE, ET AL.
PROJECT ID NO. RMD4408001
PLAN AND PROFILE
PD PH086573 SHEET 54 OF 79