

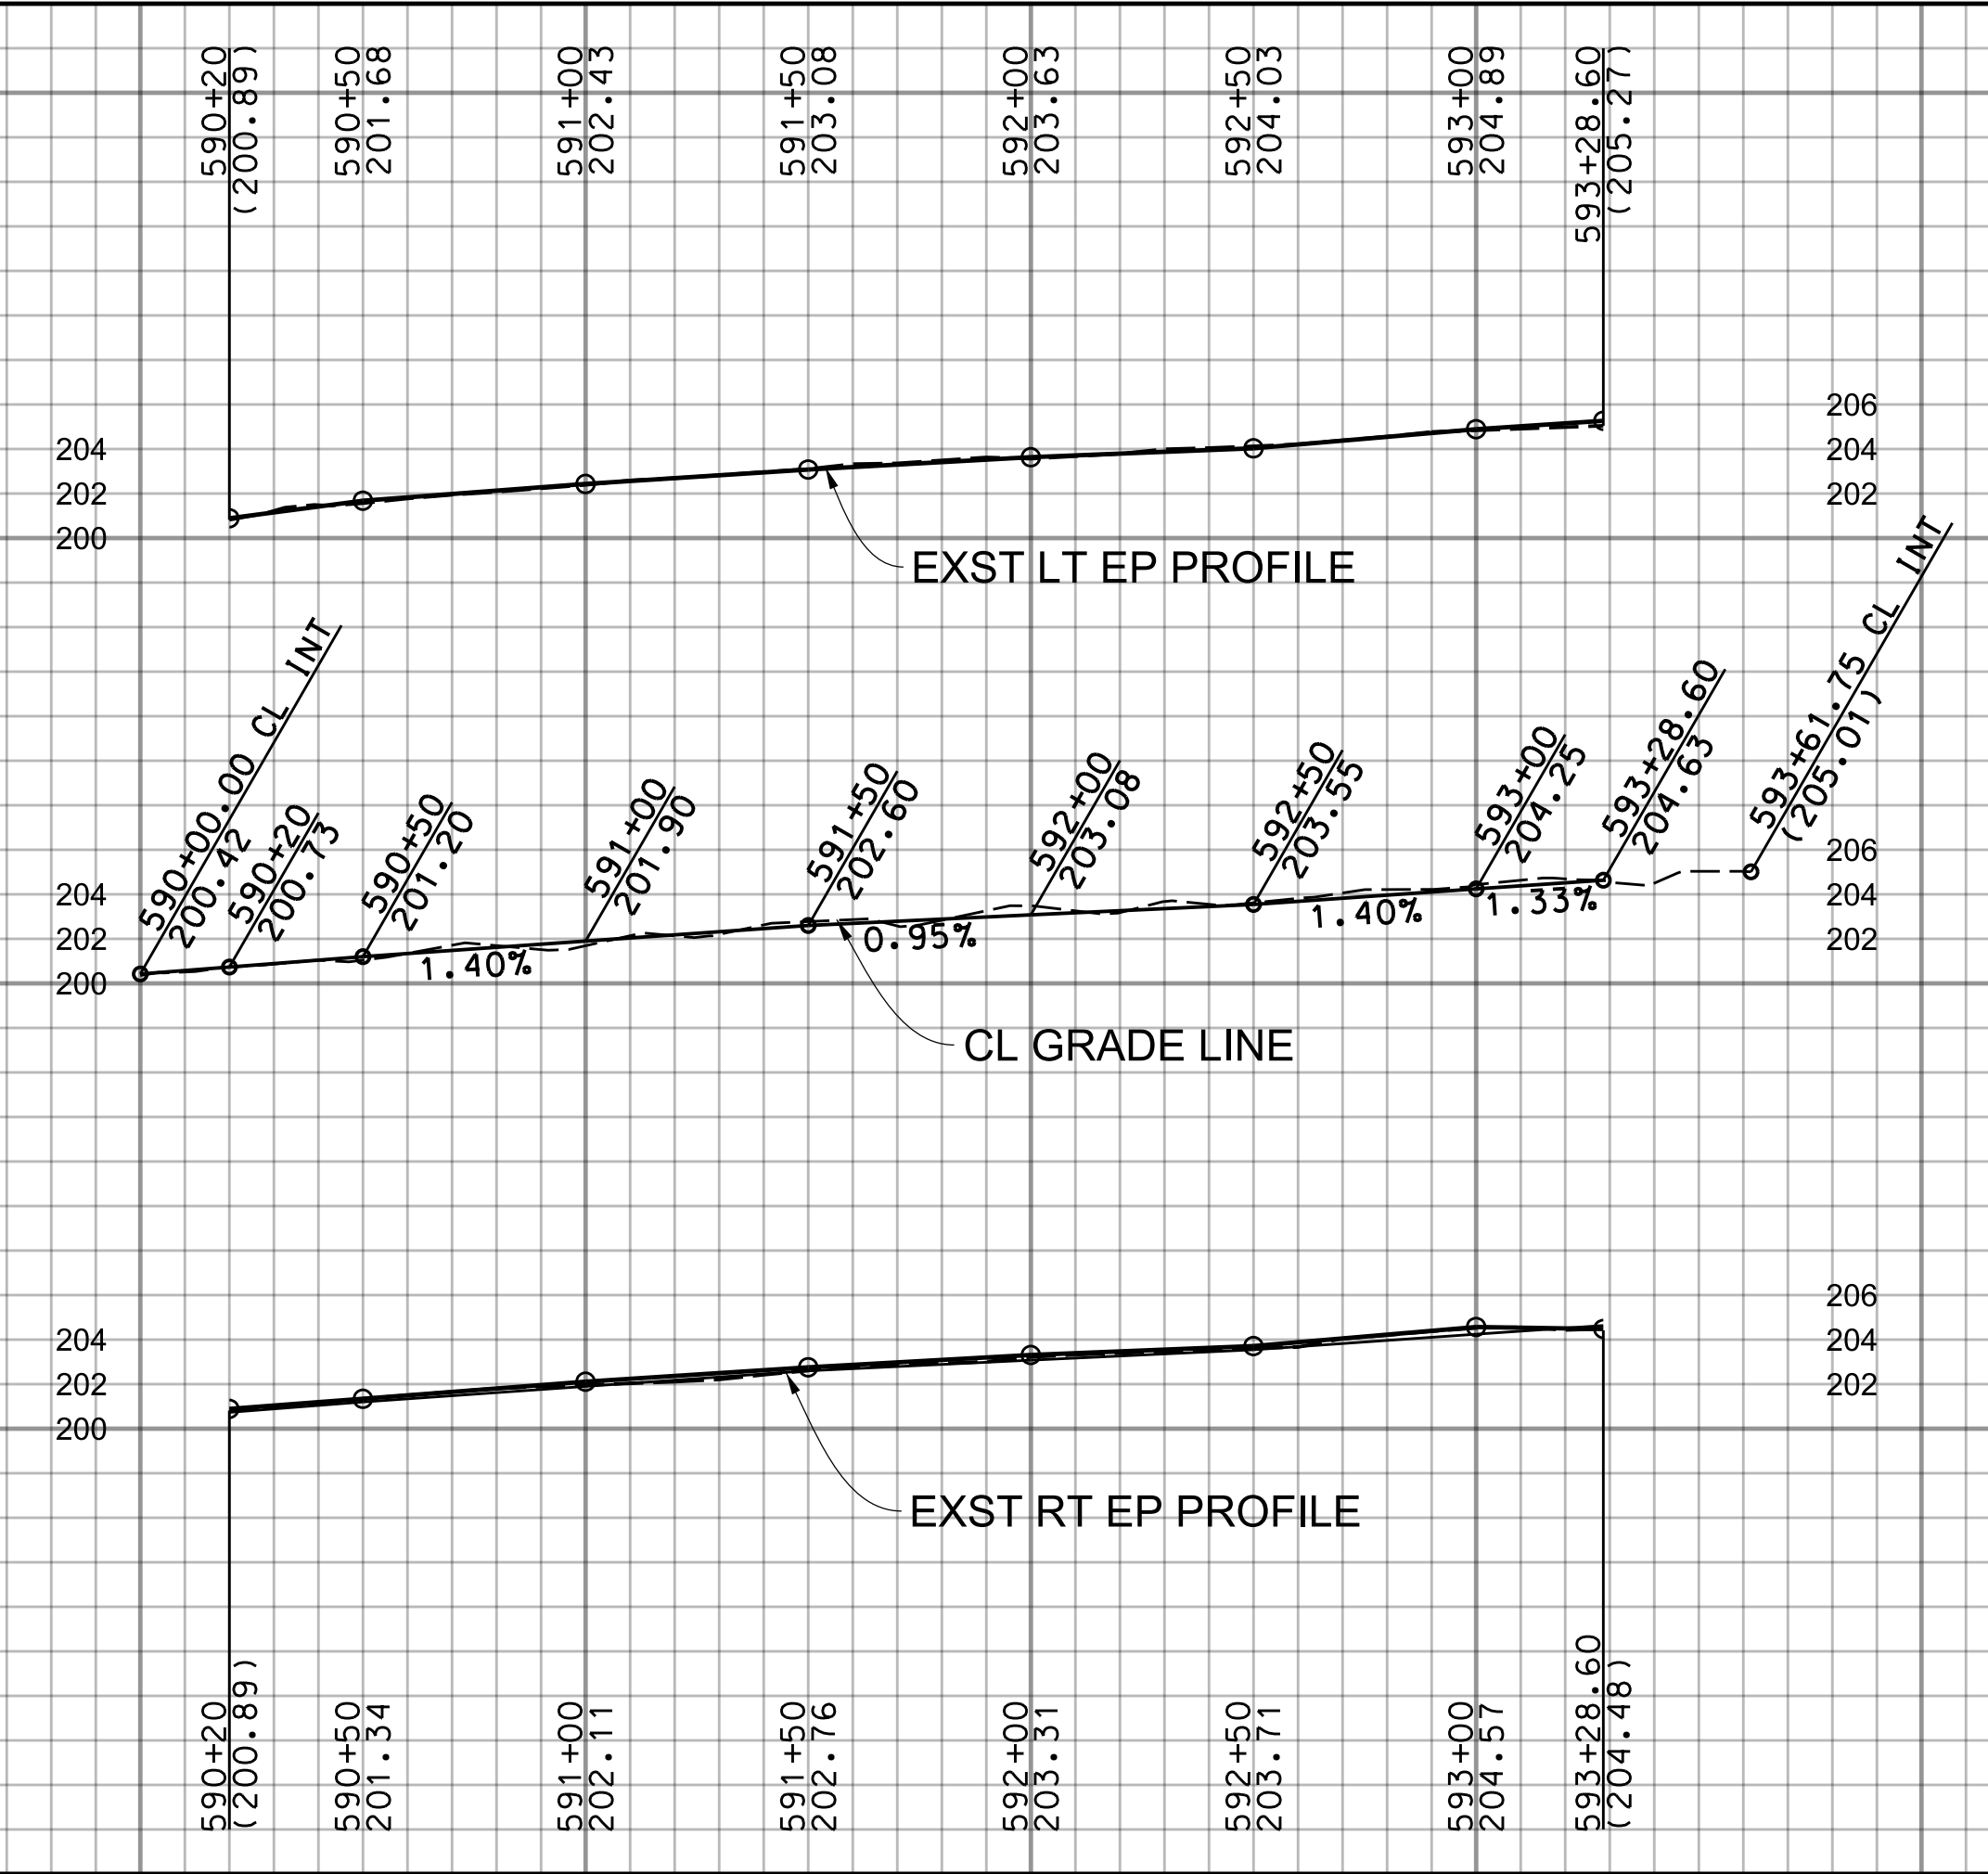



SCALE: HOR. 1"= 40'
VERT. 1"= 8'

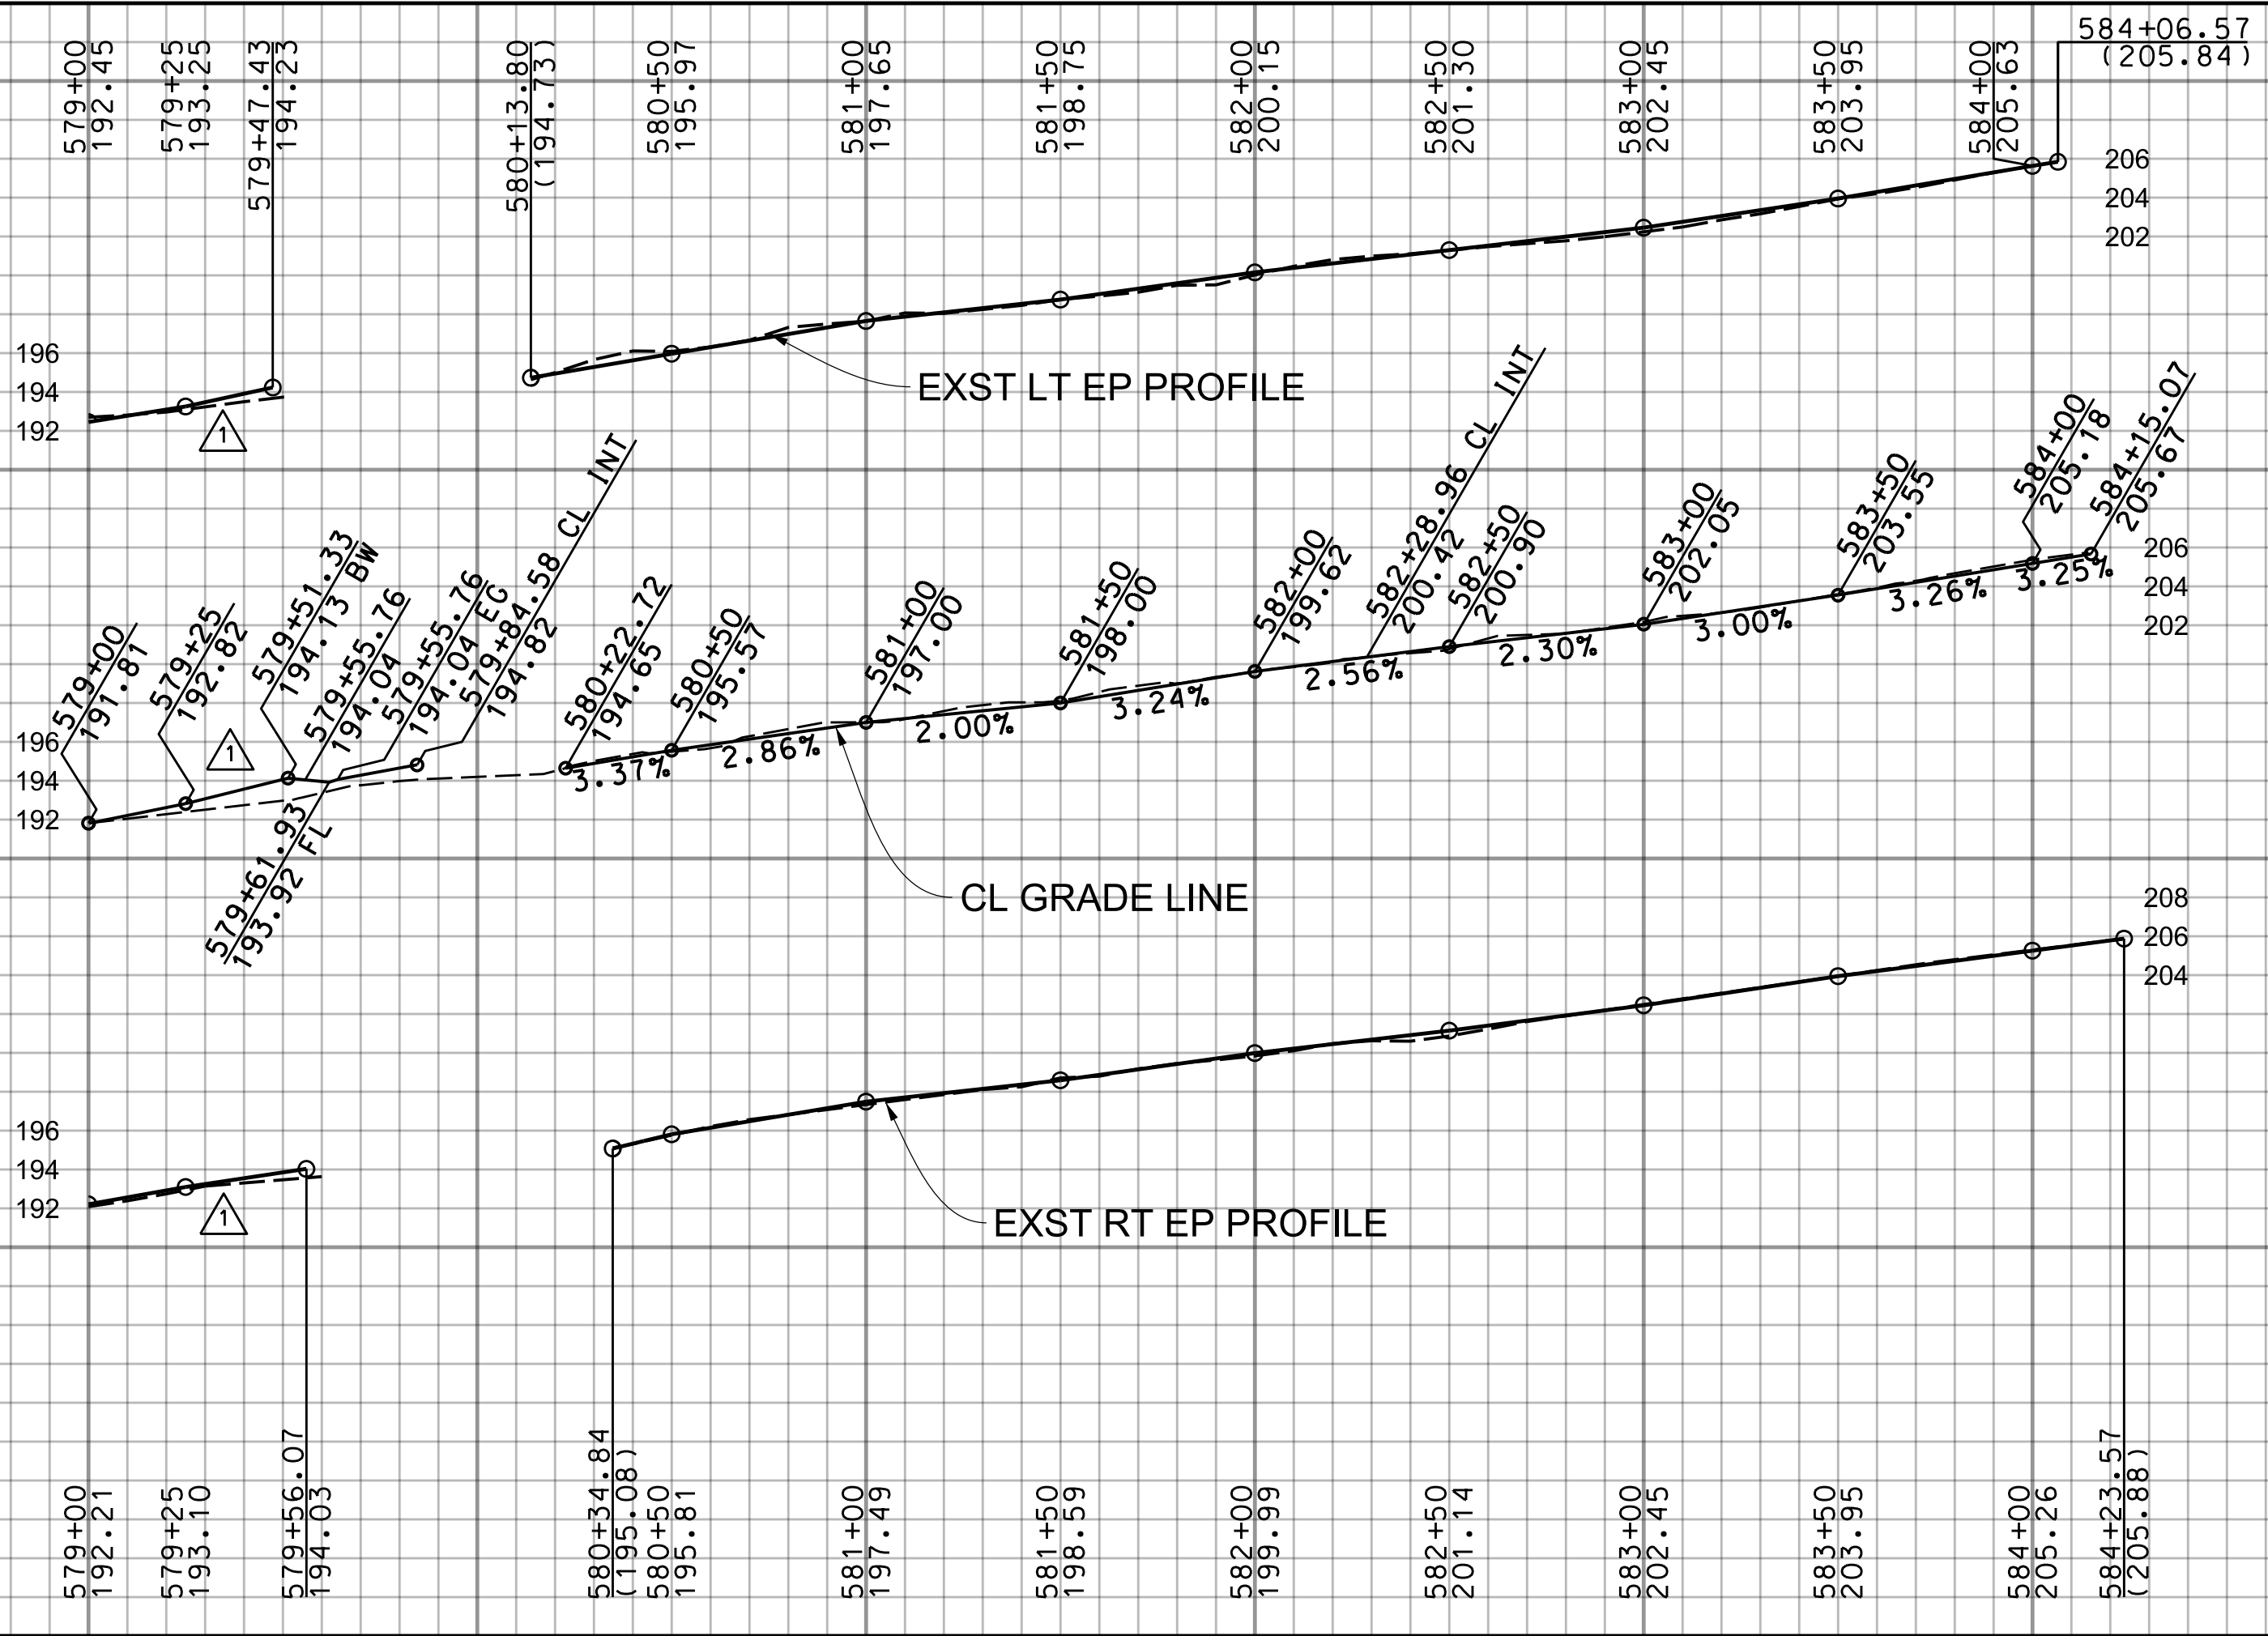

579 580 581 582 583 584 590 591 592 593 594

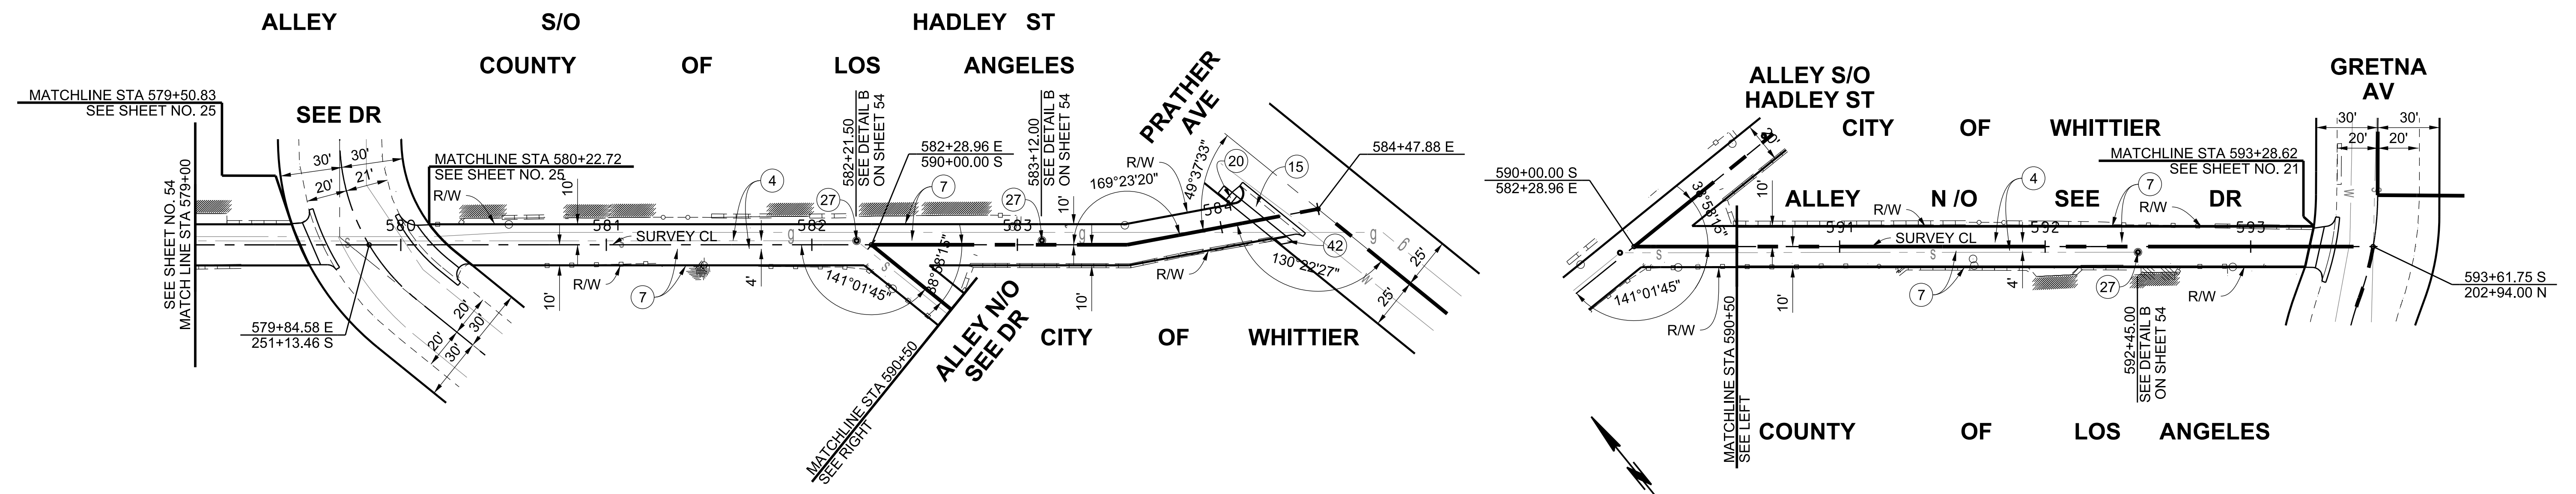


CADD PROJECT FILE NAME: \$FILESS
CHECKER: B. FUNG
DESIGNER: J. GARCIA
DRAFTER: J. GARCIA

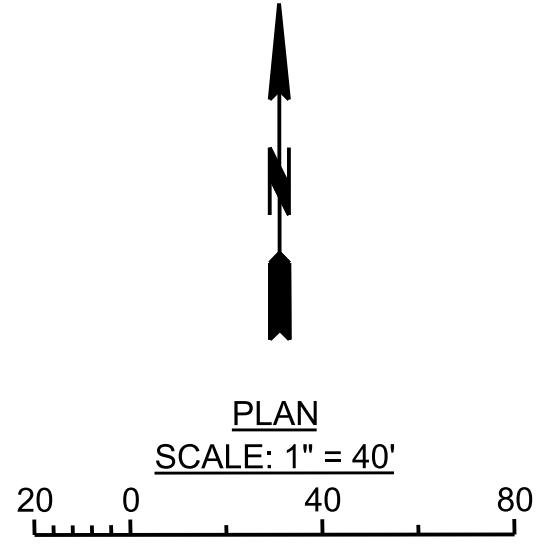

PLAN SCALE: 1" = 40'

BENCHMARK
PT 613, ELEV 193.835 (WHITTIER & BASELINE QUAD 2005), PWFB 1027, PG 977
CL ANGLE PT. FD SQ HD SPK PER R1, DN 1"
SEE DR ± 3.7' N & 4.6' W/O CL INT OF ALLEY

DATE	MARK	DESCRIPTION
10/25/2021	■	AS-BUILT
5/27/20	▲	REVISED PROPOSED PROFILE
REVISIONS		

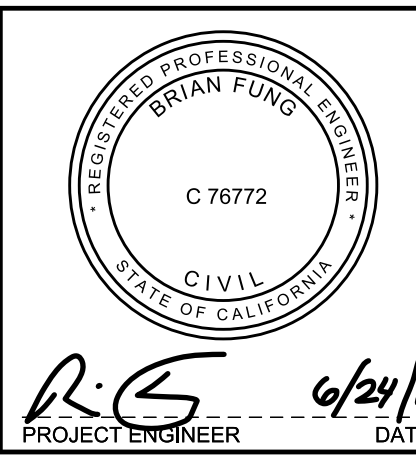

LOS ANGELES COUNTY PUBLIC WORKS
SOUTH WHITTIER LOS NIETOS
KEITH DRIVE, ET AL.
PROJECT ID NO. RMD4408001
PLAN AND PROFILE
PD PH086574 SHEET 55 OF 79