
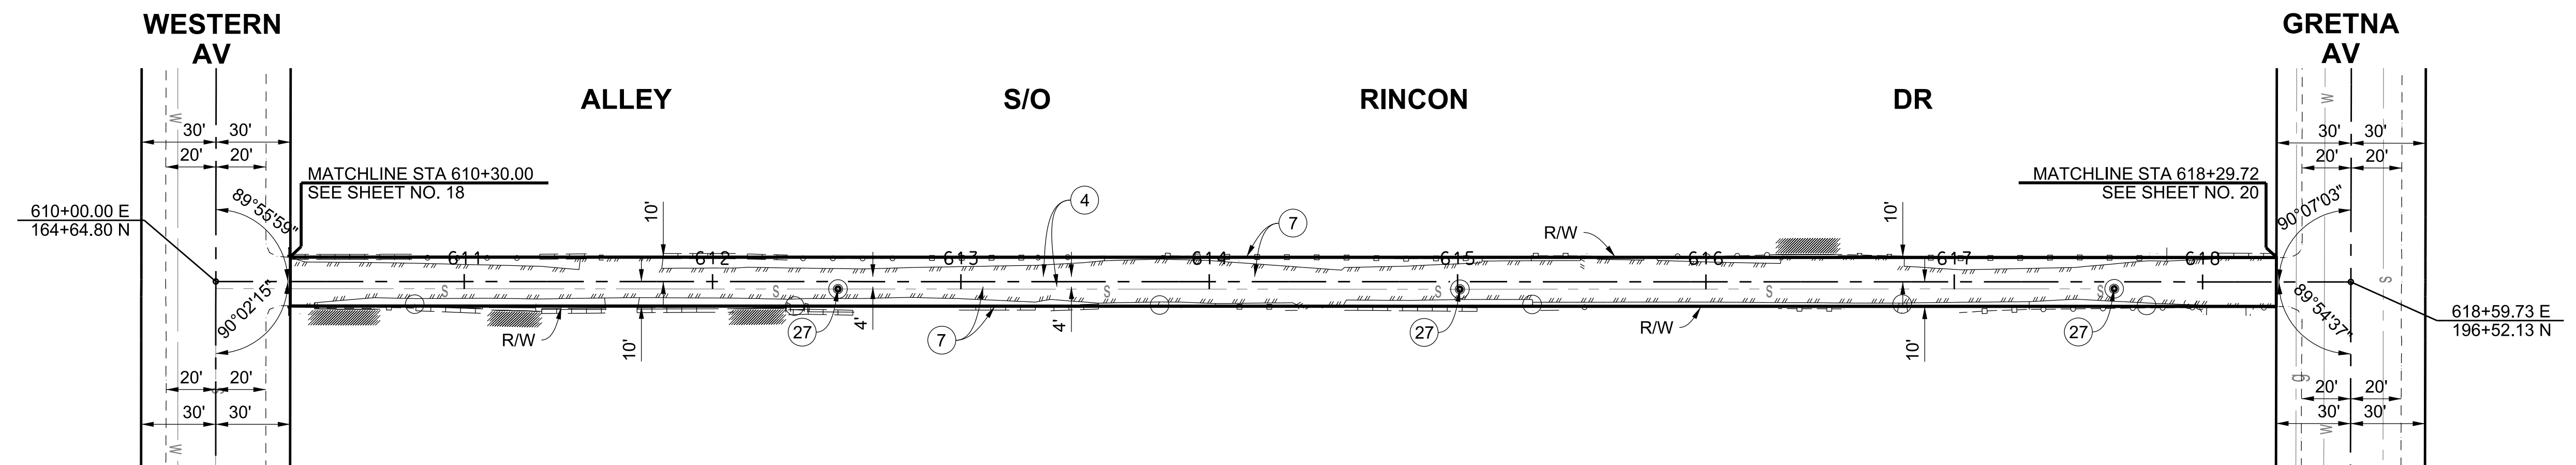


SCALE: HOR. 1"= 40'
VERT. 1"= 8'

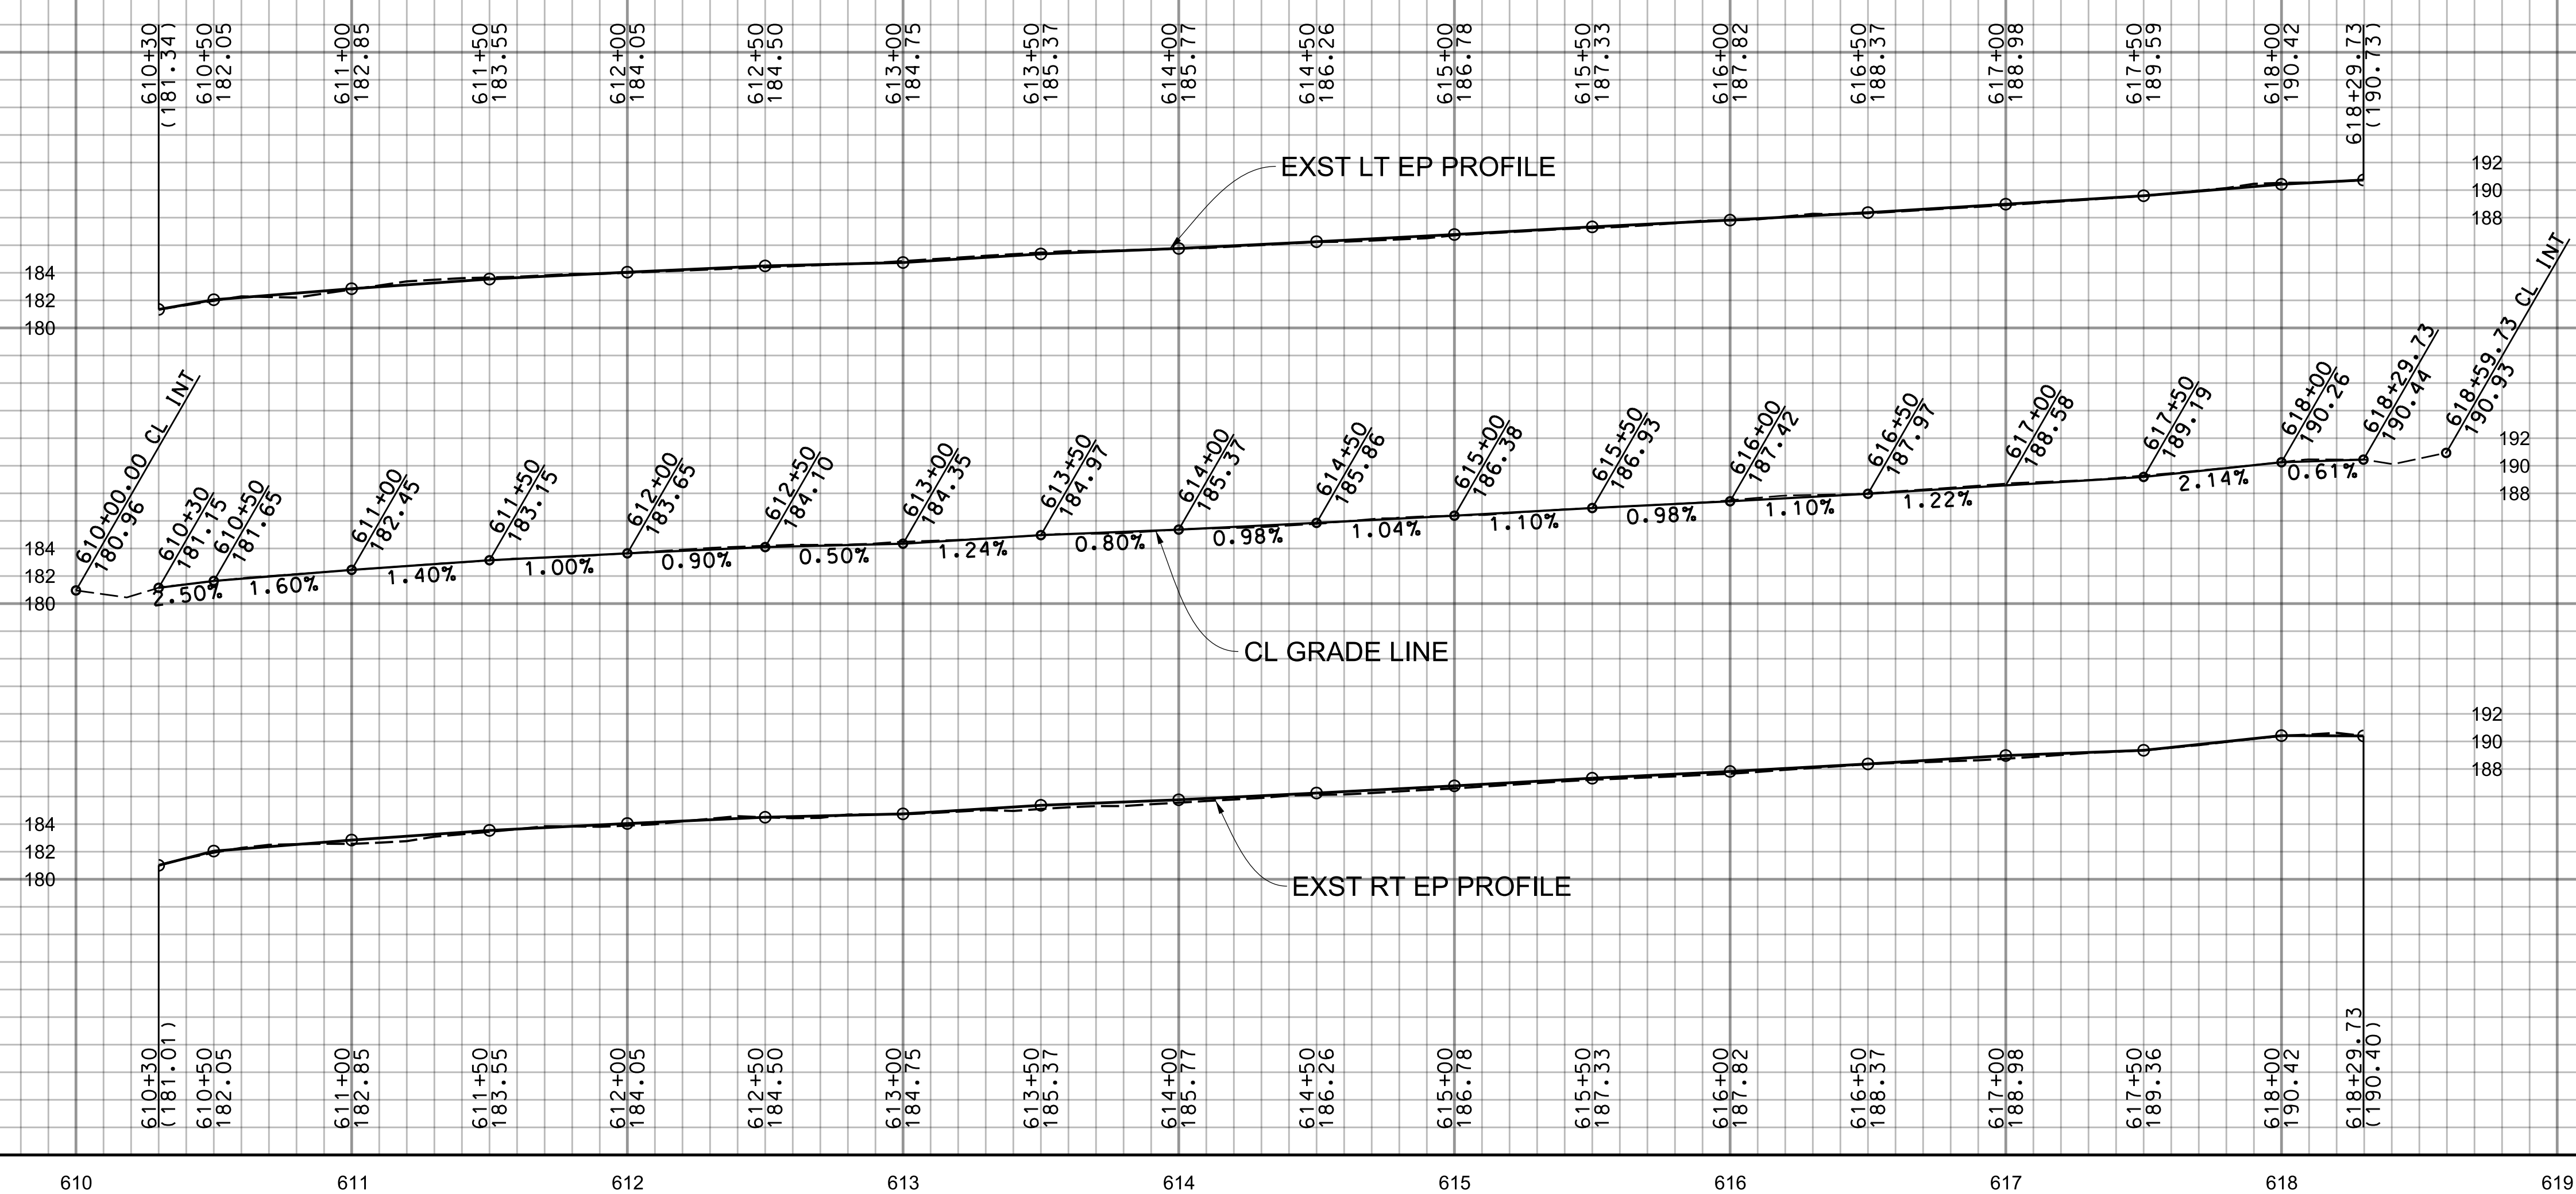

CADD PROJECT FILE NAME: \$FILESS\$
CHECKER: B. FUNG
DESIGNER: J. GARCIA
DRAFTER: J. GARCIA

PLAN SCALE: 1"= 40'

BENCHMARK
PT 609, ELEV 190.93 (WHITTIER & BASELINE QUAD 2005), PWFB 1027, PG 960 /FD SPK&W, R1, DN, 1" 0.06' S'LY & 0.04' W'LY OF CL INT. GRETNA AVE & ALLEY N/O KEITH DR



PROJECT ENGINEER: R. S. DATE: 6/24/19

DATE	MARK	DESCRIPTION
10/25/2021	■	AS-BUILT
REVISIONS		

LOS ANGELES COUNTY PUBLIC WORKS
SOUTH WHITTIER LOS NIETOS
KEITH DRIVE, ET AL.
PROJECT ID NO. RMD4408001
PLAN AND PROFILE
PD PH086576 SHEET 57 OF 79