
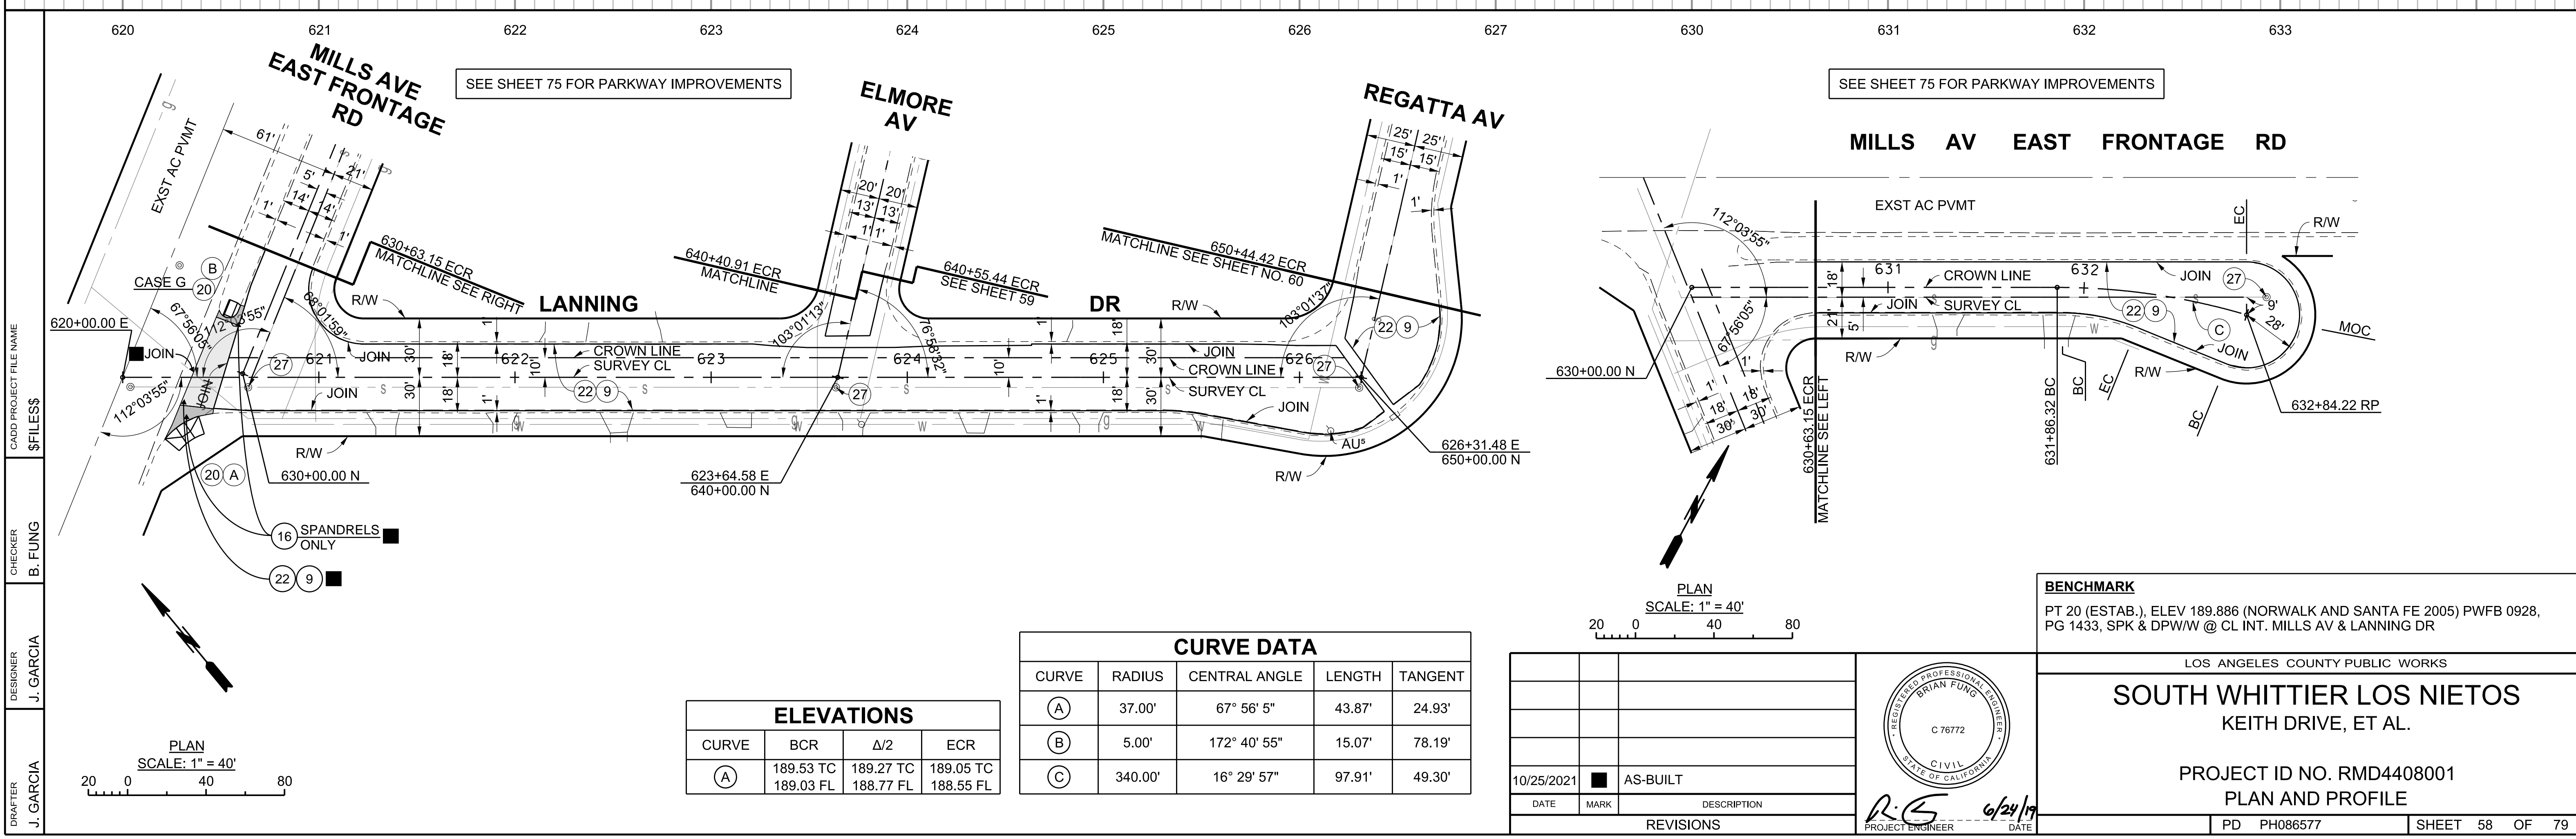


SCALE: HOR. 1"= 40'
VERT. 1"= 8'

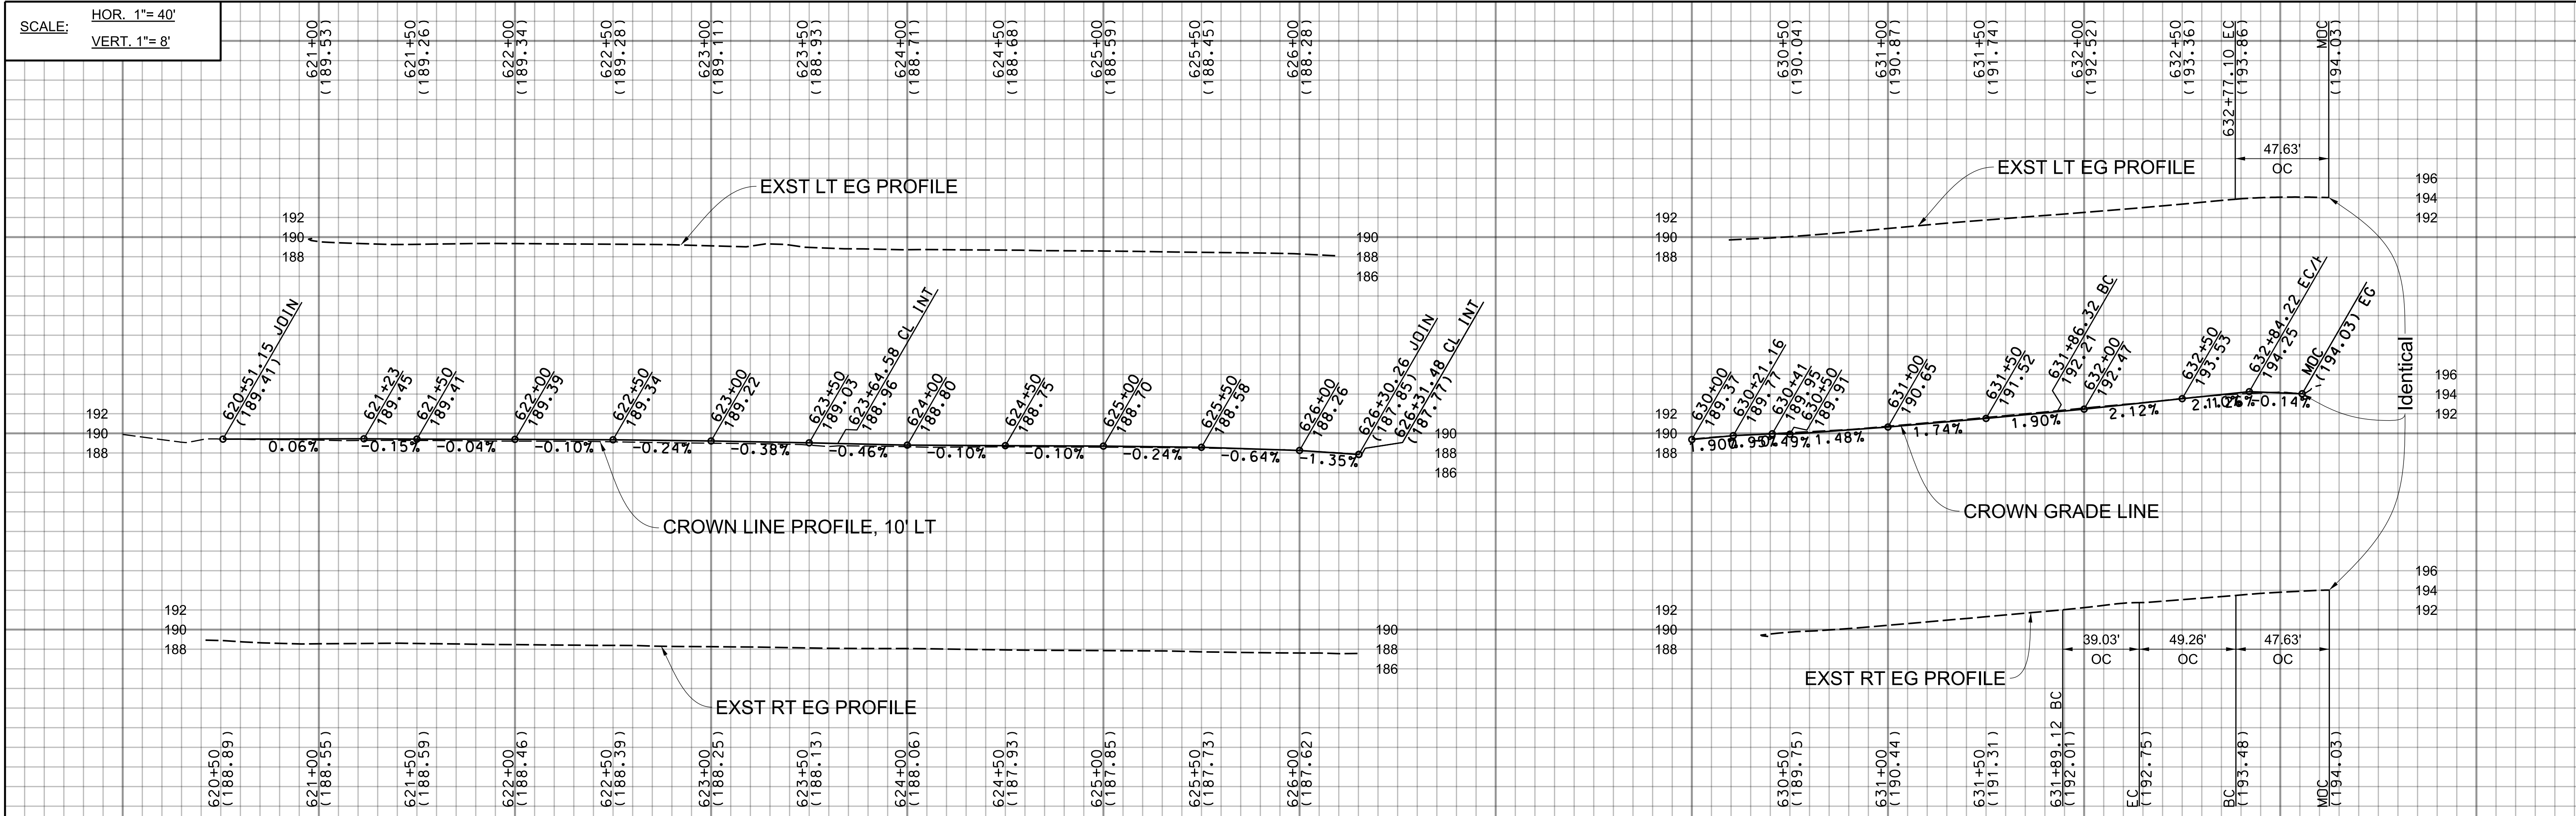


SEE SHEET 75 FOR PARKWAY IMPROVEMENTS

SEE SHEET 75 FOR PARKWAY IMPROVEMENTS

CURVE DATA				
CURVE	RADIUS	CENTRAL ANGLE	LENGTH	TANGENT
(A)	37.00'	67° 56' 5"	43.87'	24.93'
(B)	5.00'	172° 40' 55"	15.07'	78.19'
(C)	340.00'	16° 29' 57"	97.91'	49.30'

ELEVATIONS			
CURVE	BCR	Δ/2	ECR
(A)	189.53 TC 189.03 FL	189.27 TC 188.77 FL	189.05 TC 188.55 FL

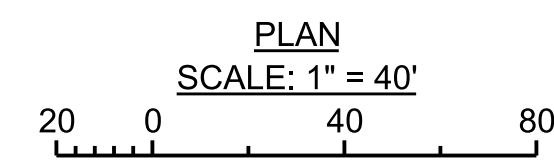

BENCHMARK
PT 20 (ESTAB.), ELEV 189.886 (NORWALK AND SANTA FE 2005) PWFB 0928,
PG 1433, SPK & DP/WW @ CL INT. MILLS AV & LANNING DR



LOS ANGELES COUNTY PUBLIC WORKS
SOUTH WHITTIER LOS NIETOS
KEITH DRIVE, ET AL.
PROJECT ID NO. RMD4408001
PLAN AND PROFILE

DATE	MARK	DESCRIPTION
10/25/2021	AS-BUILT	
REVISIONS		

PROJECT ENGINEER: R. S. G. / DATE: 6/24/19