

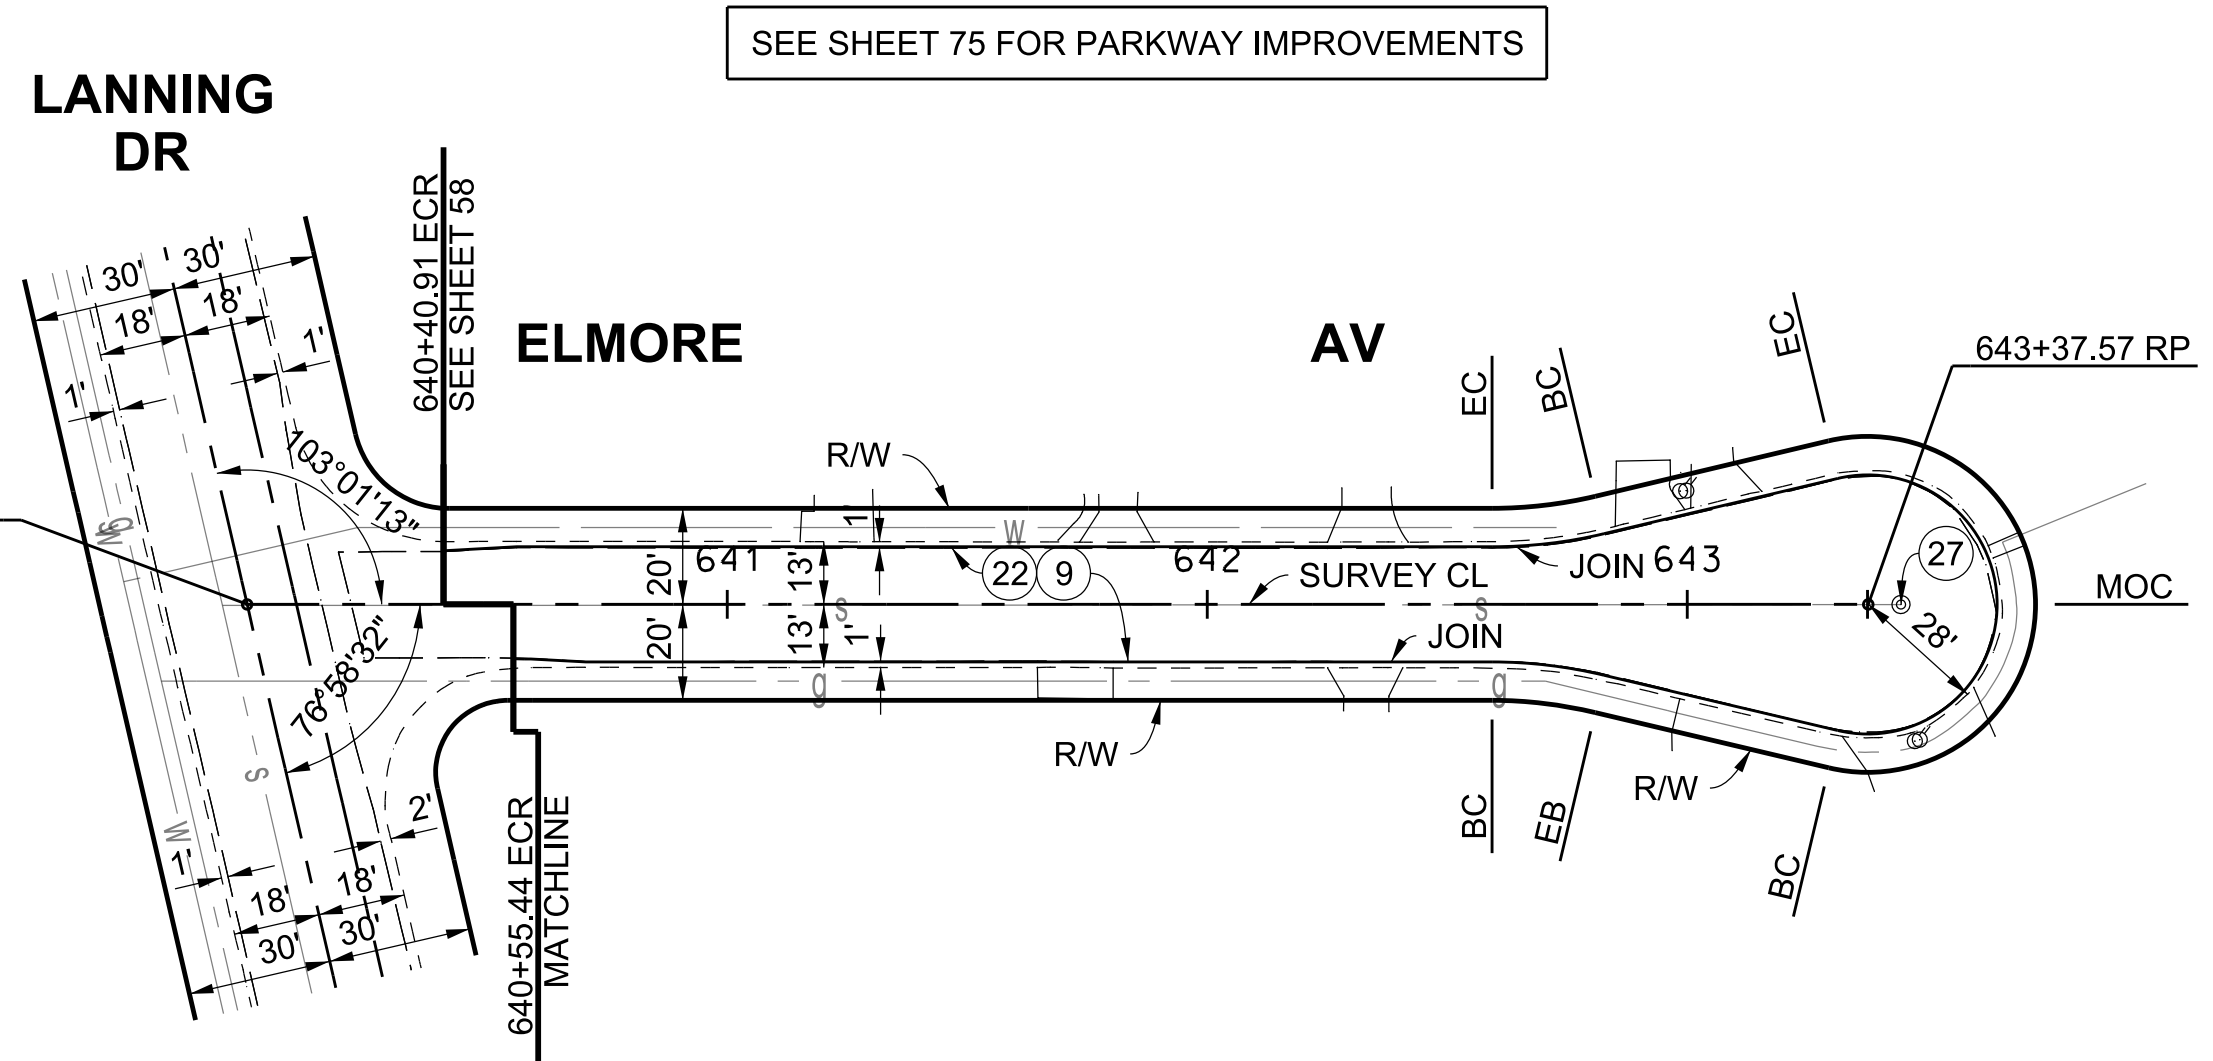


SCALE: HOR. 1"= 40'  
VERT. 1"= 8'

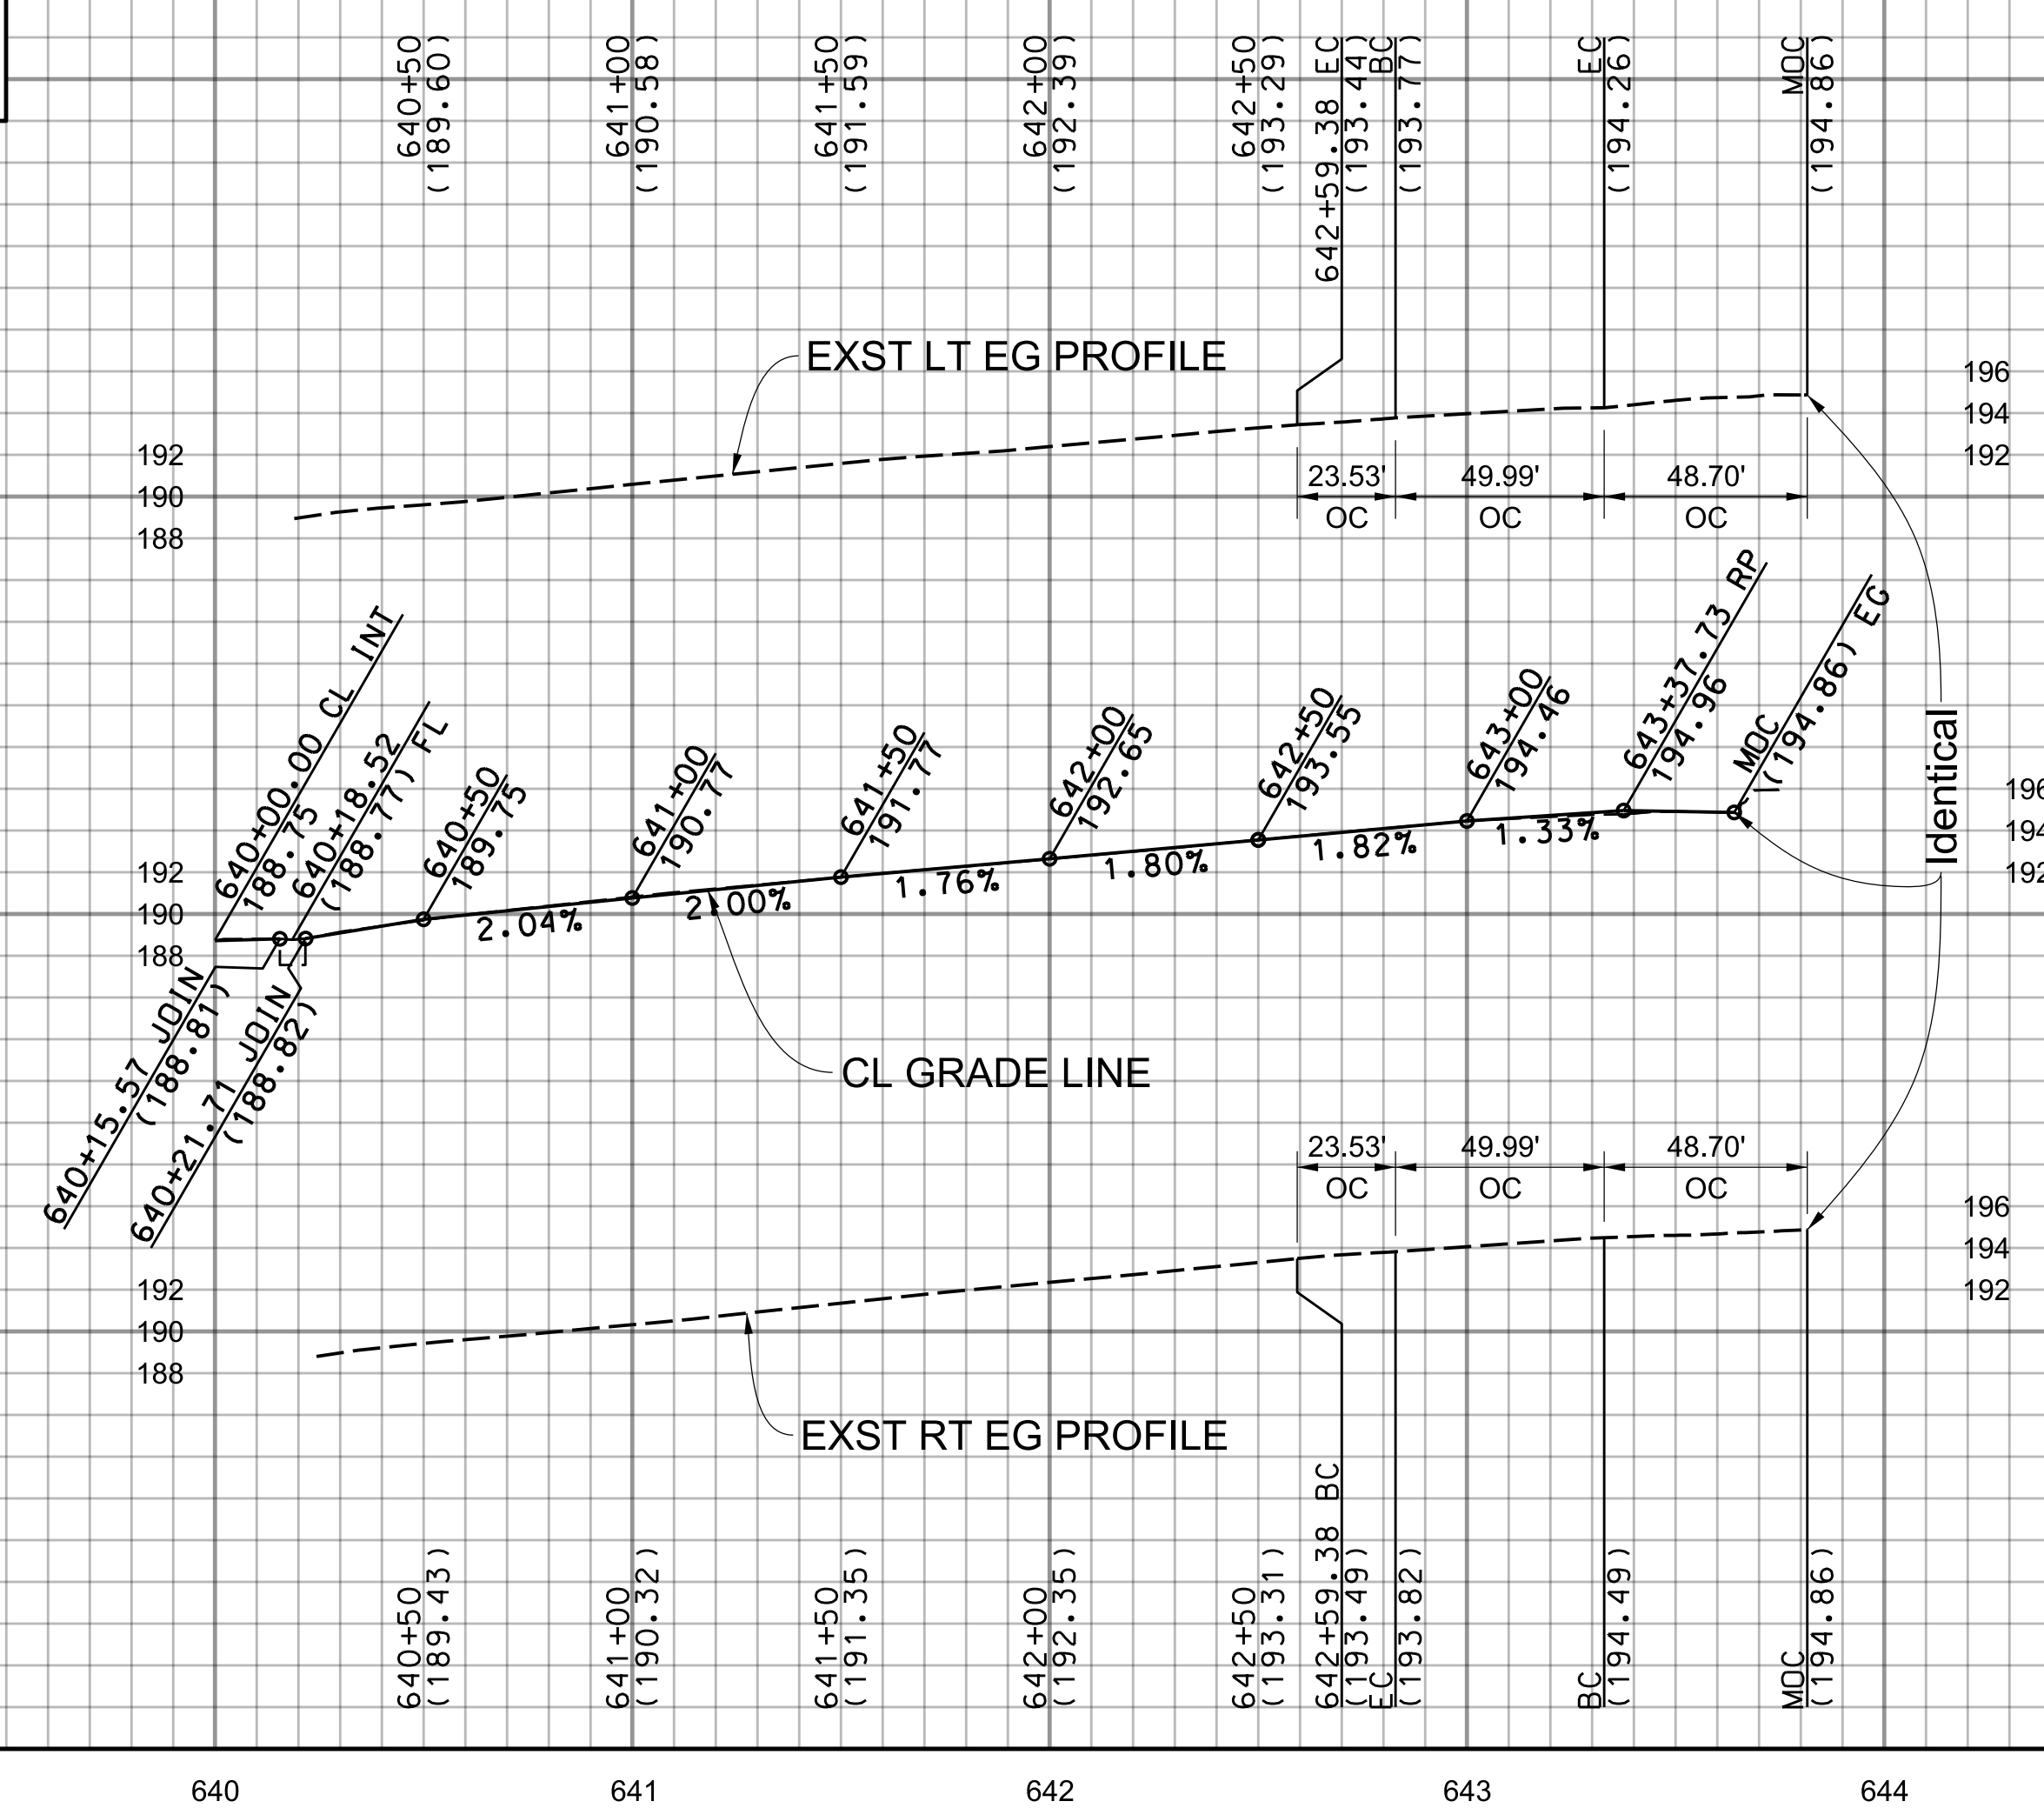

CADD PROJECT FILE NAME: \$FILESS  
CHECKER: B. FUNG  
DESIGNER: J. GARCIA  
DRAFTER: J. GARCIA

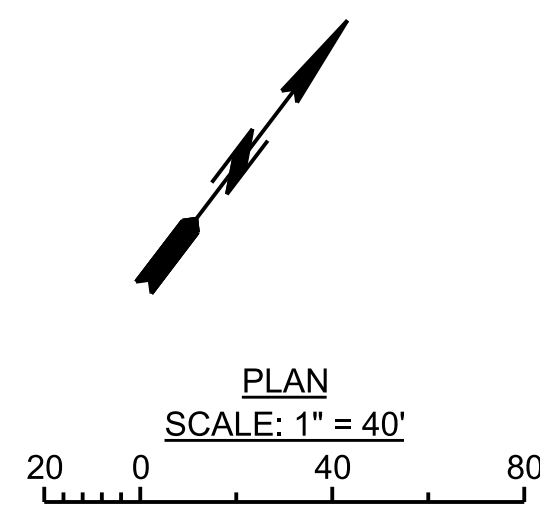

**BENCHMARK**  
PT 20 (ESTAB.), ELEV 189.886 (NORWALK AND SANTA FE 2005) PWFB 0928,  
PG 1433, SPK & DPWW @ CL INT. MILLS AV & LANNING DR

LOS ANGELES COUNTY PUBLIC WORKS  
**SOUTH WHITTIER LOS NIETOS**  
KEITH DRIVE, ET AL.  
PROJECT ID NO. RMD4408001  
PLAN AND PROFILE  
PD PH086578 SHEET 59 OF 79

DATE	MARK	DESCRIPTION
10/25/2021	■	AS-BUILT
REVISIONS		

**BRIAN FUNG**  
REGISTERED PROFESSIONAL ENGINEER  
C 76772  
CIVIL  
STATE OF CALIFORNIA  
6/24/19