

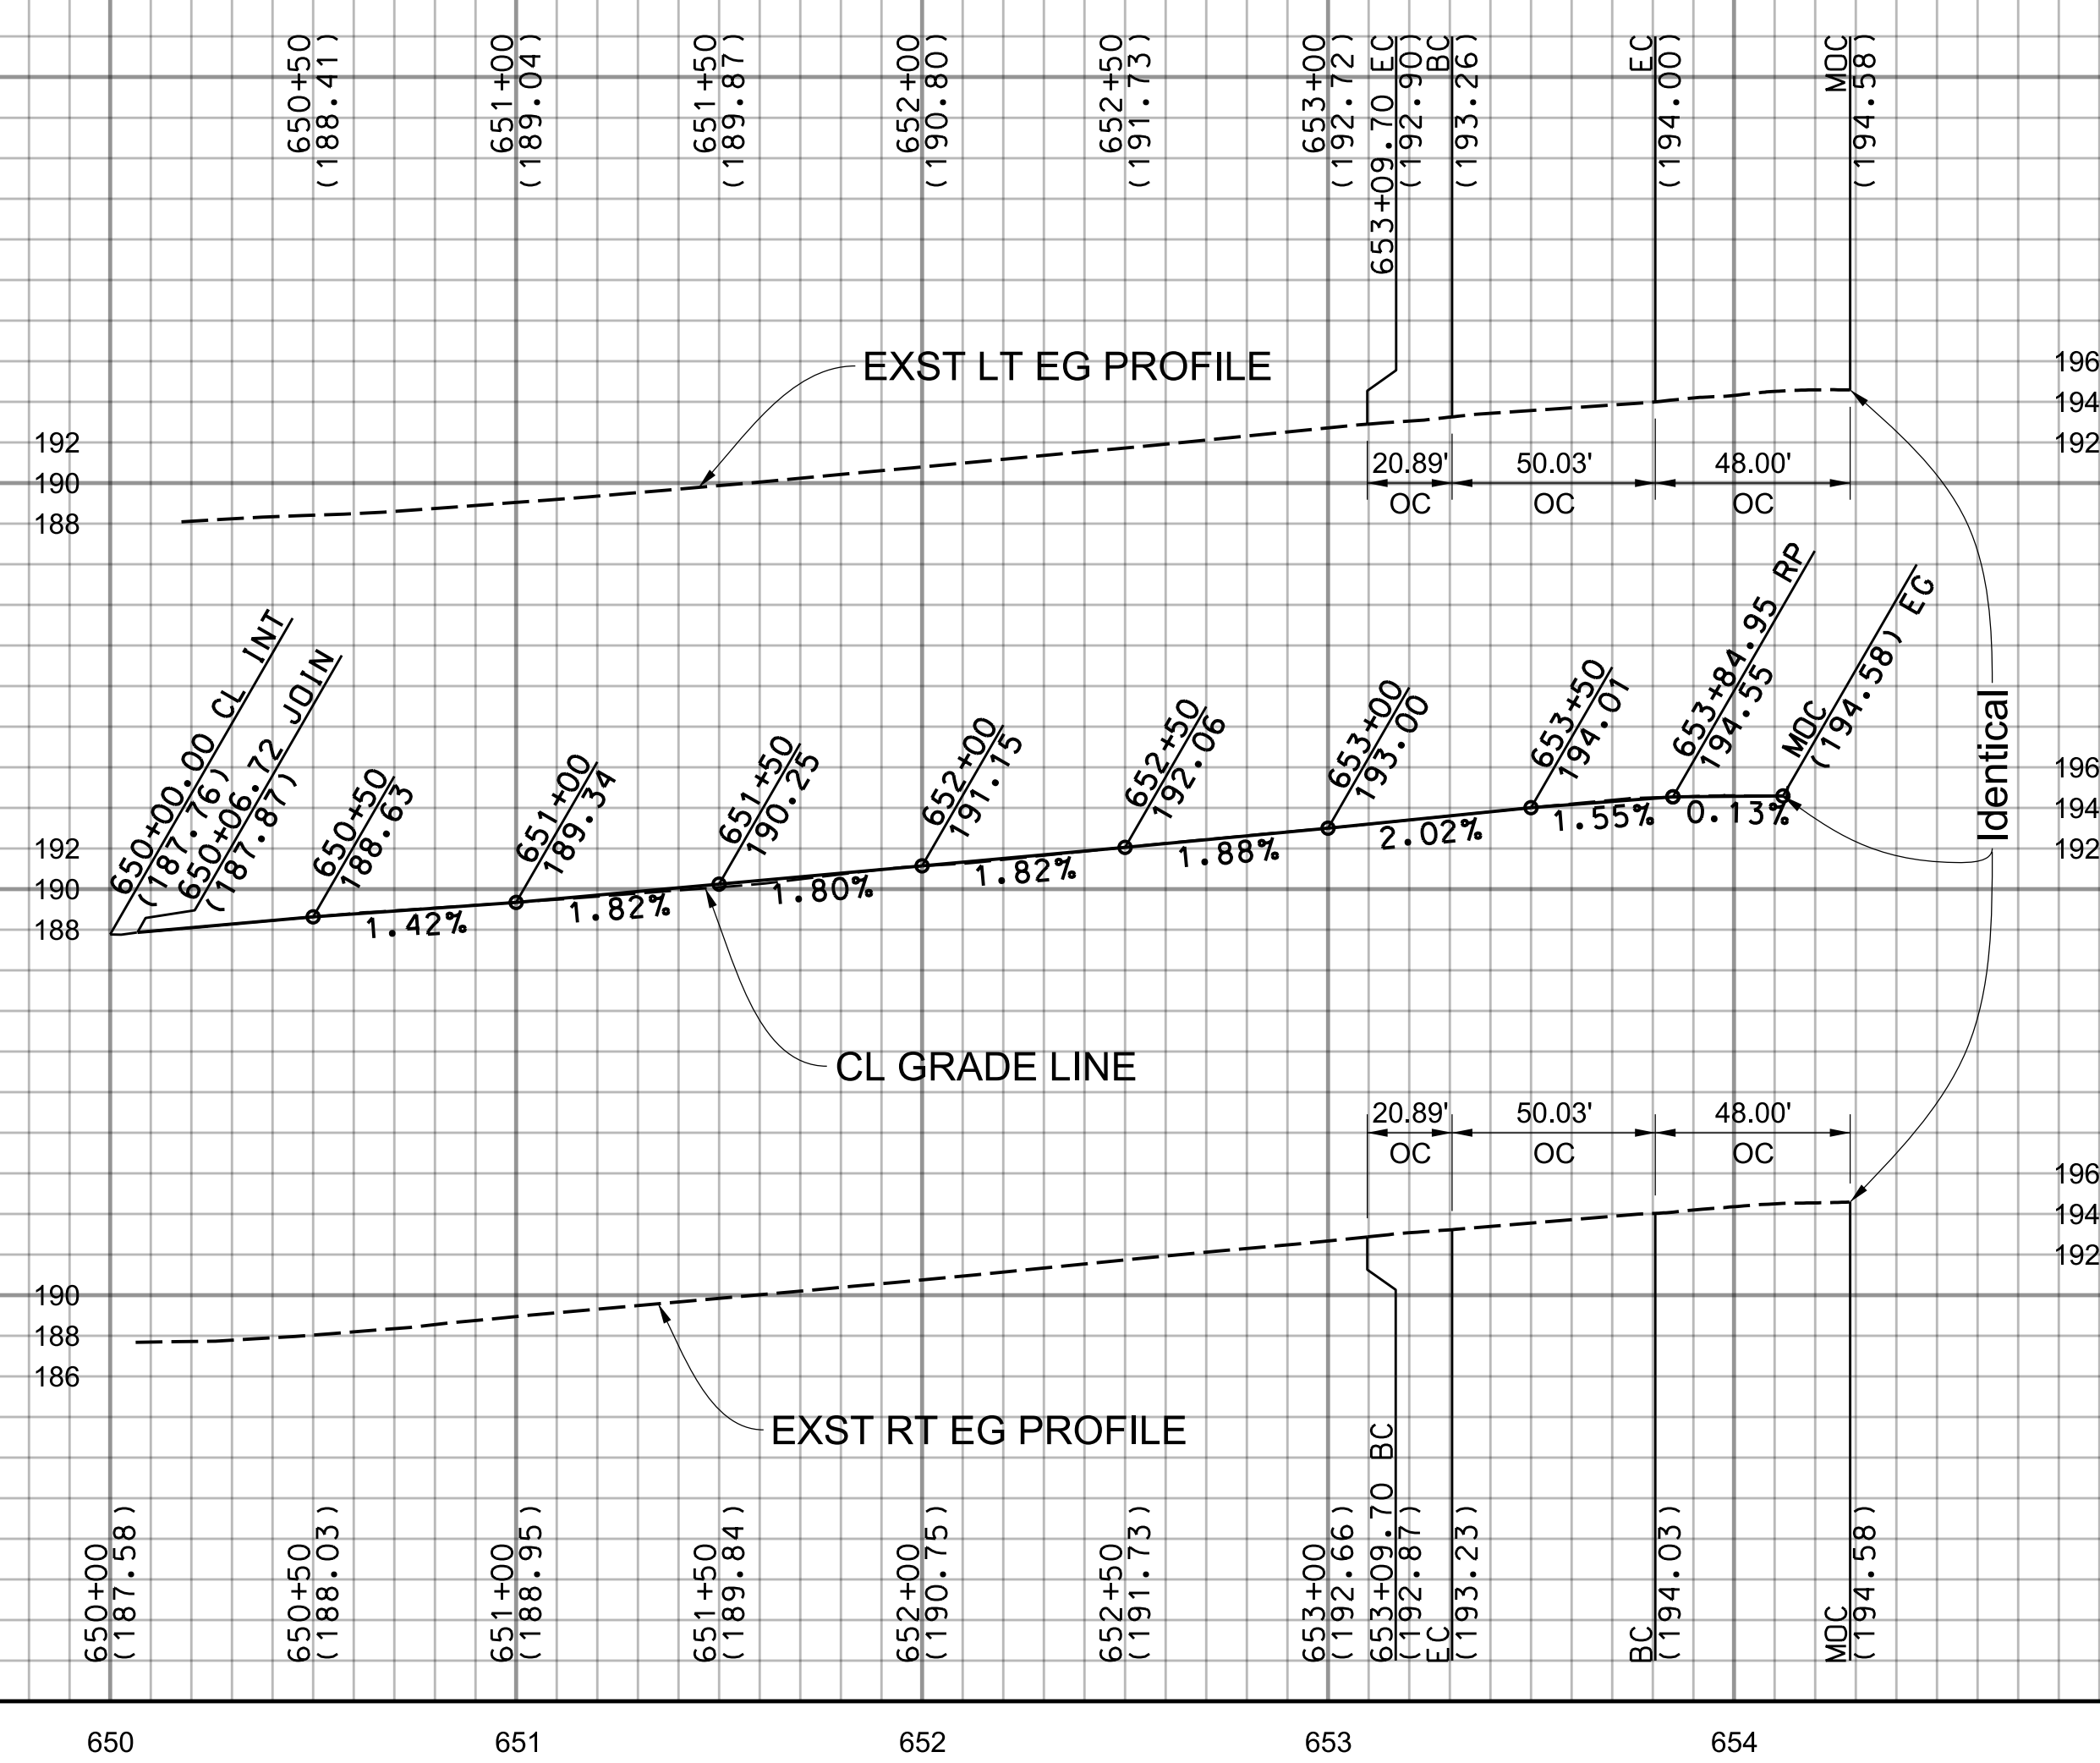



SCALE: HOR. 1"= 40'
VERT. 1"= 8'

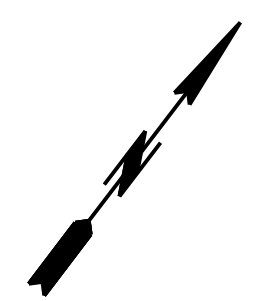

SEE SHEET 75 FOR PARKWAY IMPROVEMENTS

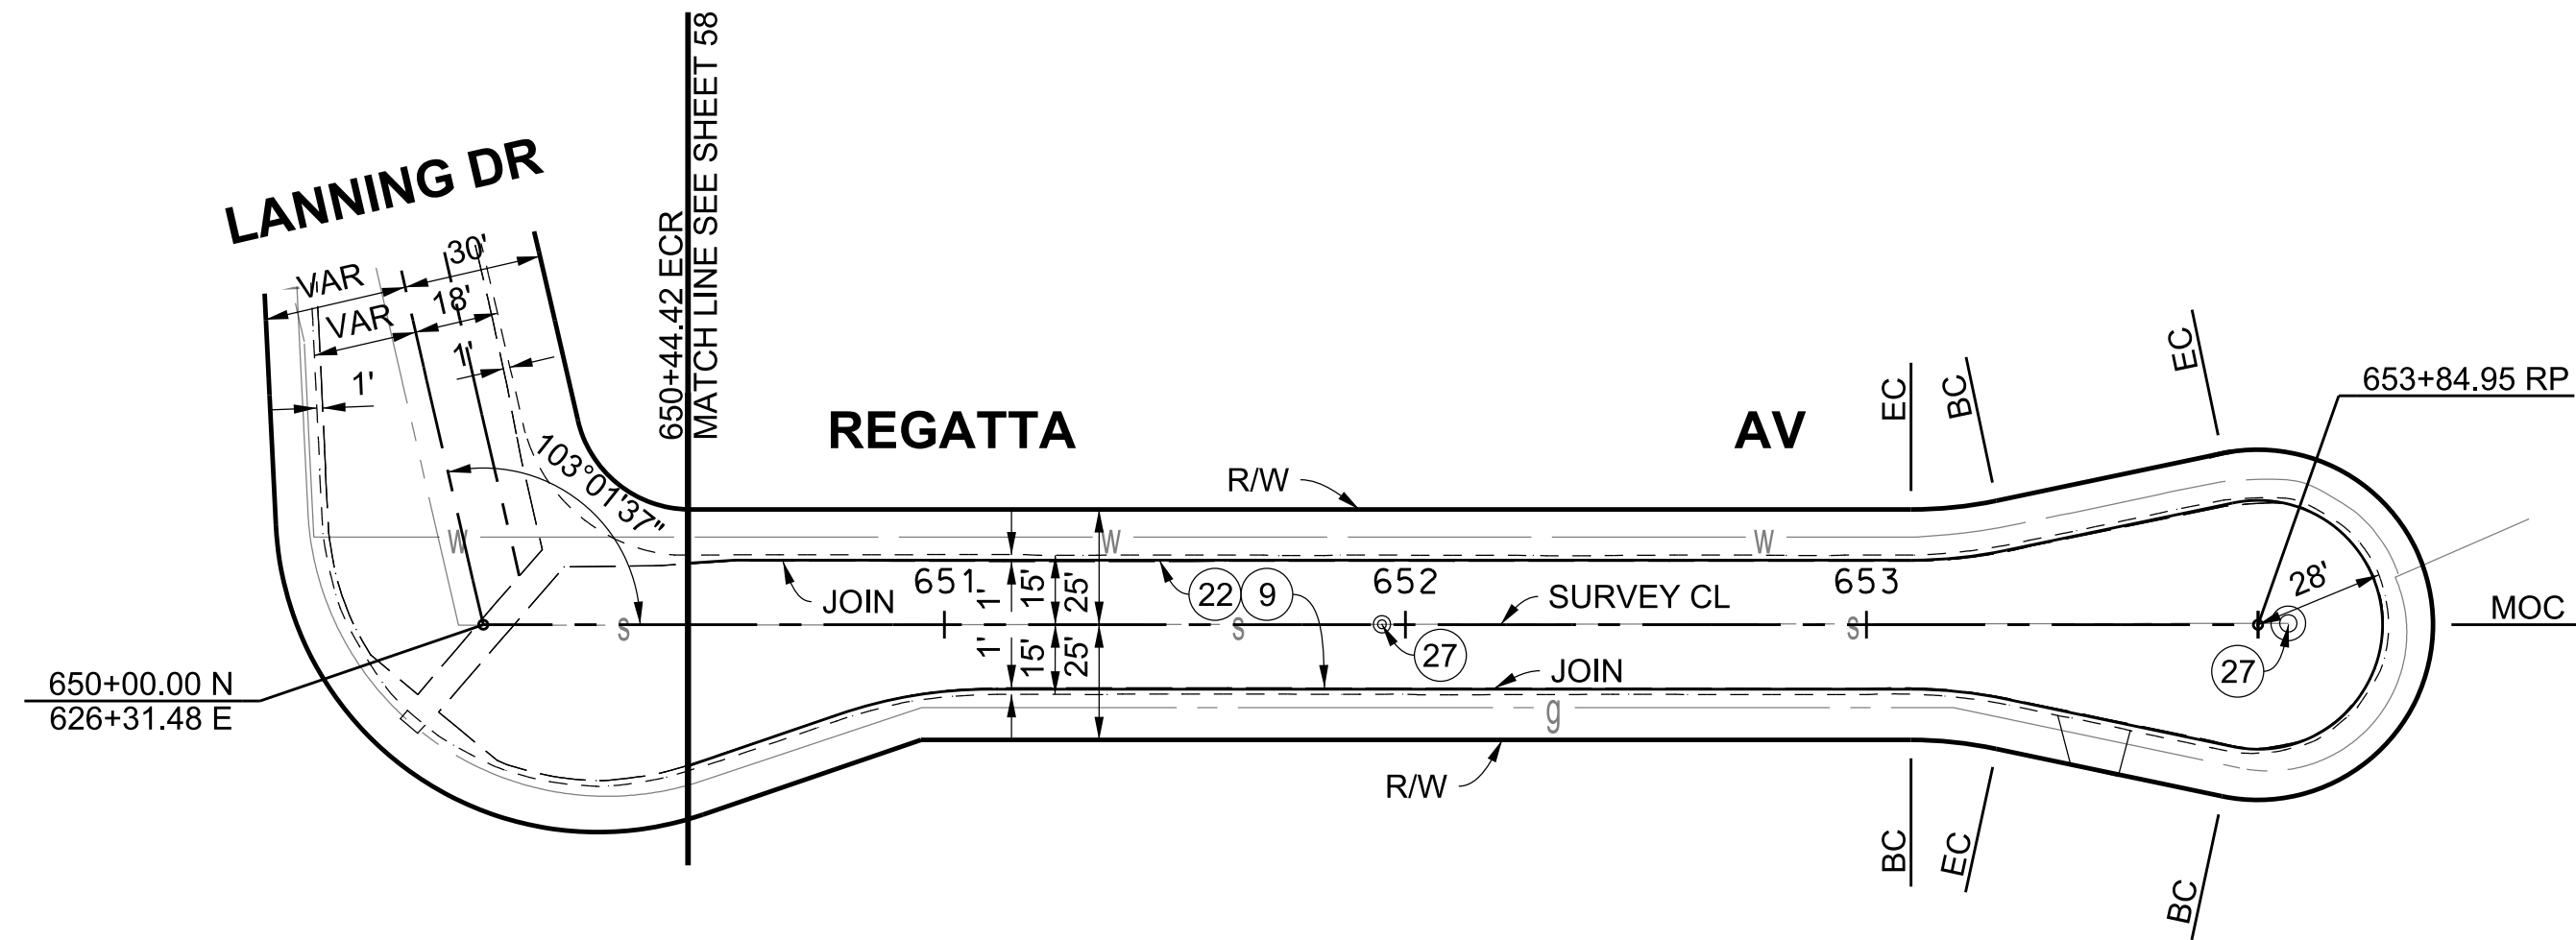

PLAN
SCALE: 1"= 40'

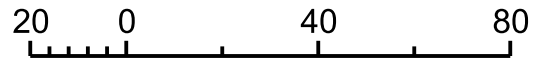

CADD PROJECT FILE NAME: \$FILESS
CHECKER: B. FUNG
DESIGNER: J. GARCIA
DRAFTER: J. GARCIA

BENCHMARK
PT 20 (ESTAB.), ELEV 189.886 (NORWALK AND SANTA FE 2005) PWFB 0928,
PG 1433, SPK & DPWW @ CL INT. MILLS AV & LANNING DR

LOS ANGELES COUNTY PUBLIC WORKS
SOUTH WHITTIER LOS NIETOS
KEITH DRIVE, ET AL.
PROJECT ID NO. RMD4408001
PLAN AND PROFILE
PD PH086579 SHEET 60 OF 79

DATE	MARK	DESCRIPTION
10/25/2021	■	AS-BUILT
REVISIONS		



PROJECT ENGINEER: R. S. DATE: 6/24/19