

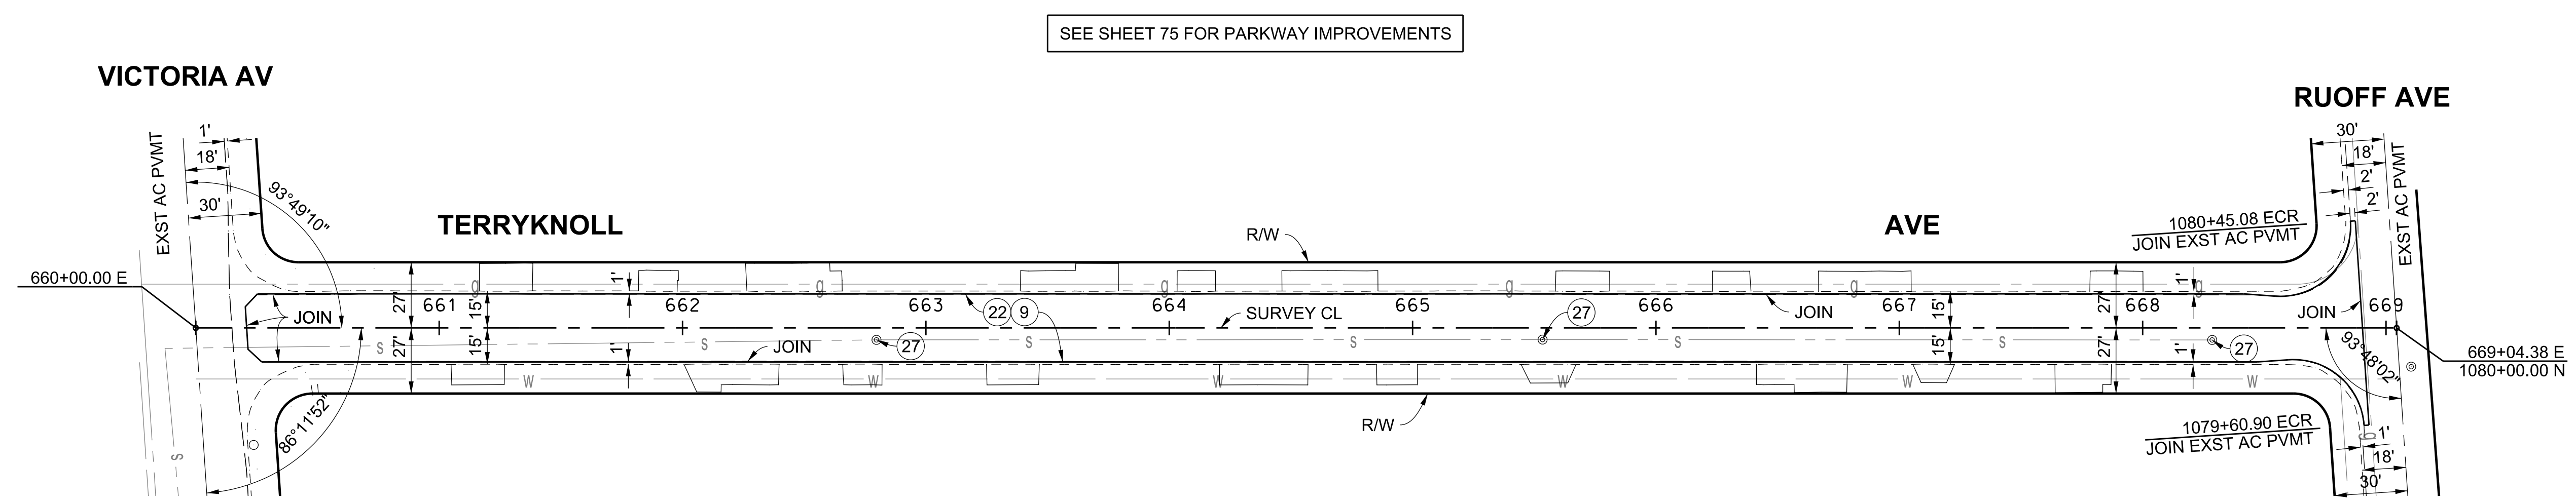


SCALE: HOR. 1"= 40'
VERT. 1"= 8'

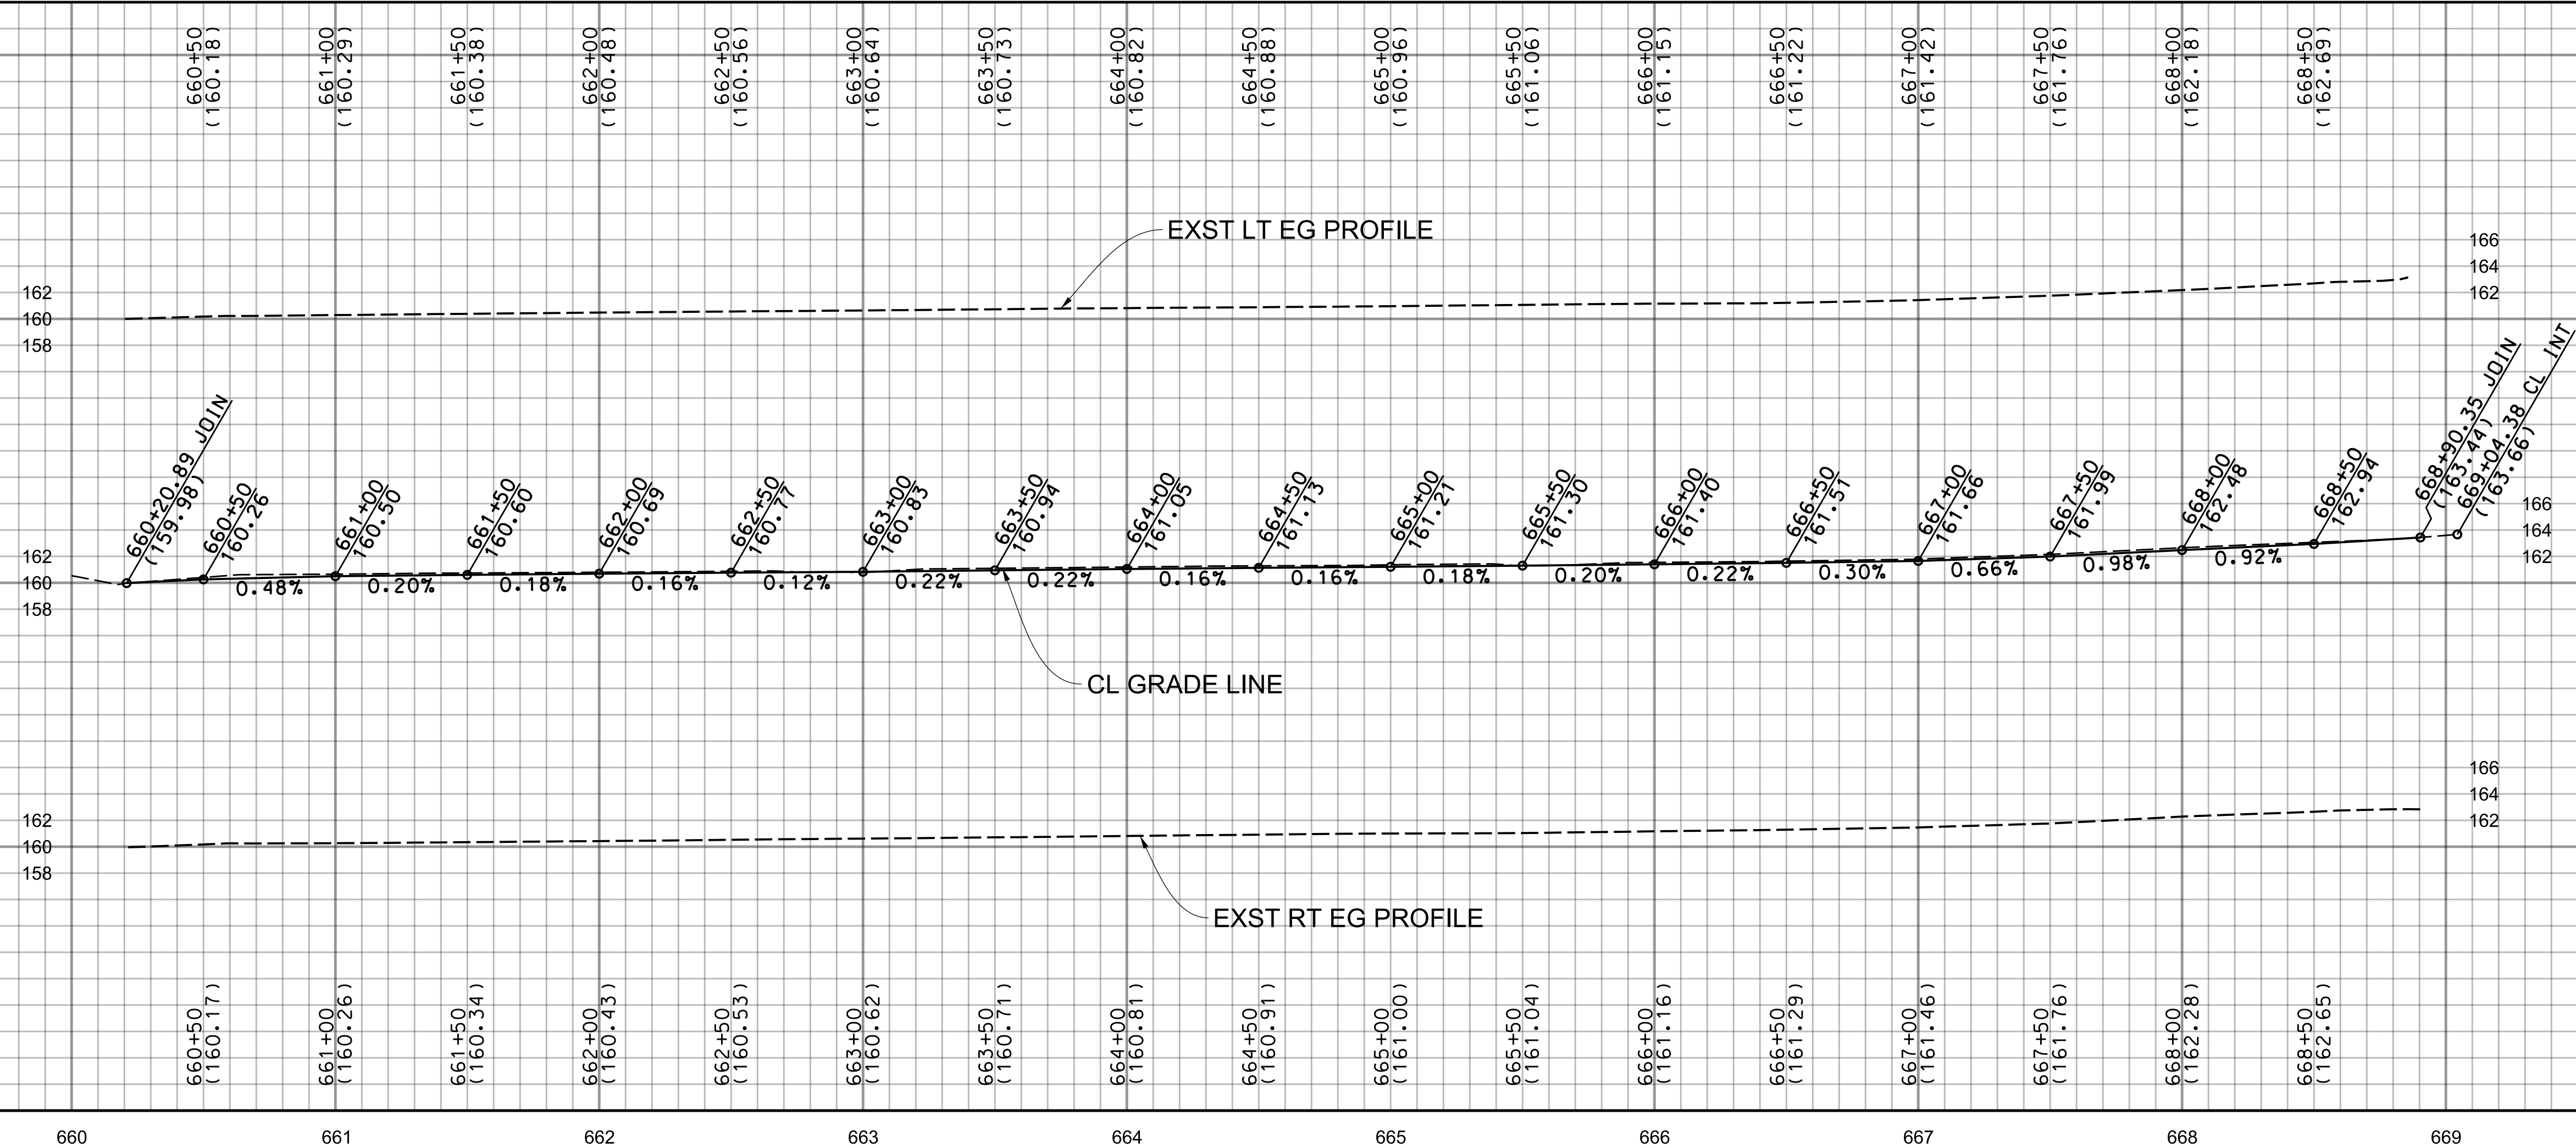


SEE SHEET 75 FOR PARKWAY IMPROVEMENTS

CADD PROJECT FILE NAME: \$FILESS\$
CHECKER: B. FUNG
DESIGNER: J. GARCIA
DRAFTER: J. GARCIA

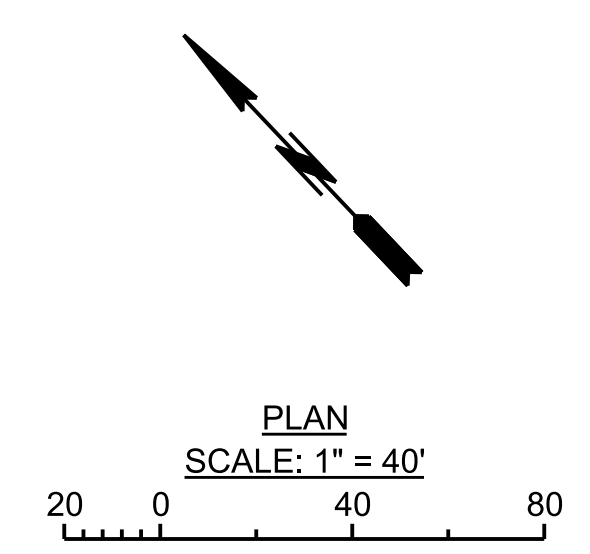

BENCHMARK
PT 35, ELEV 160.53 (NORWALK AND SANTA FE 2005) PWFB 0928,
PG 1396, CL INT. TERRYKNOLL DR & VICTORIA AVE ANGLE PT SPK & DPWW

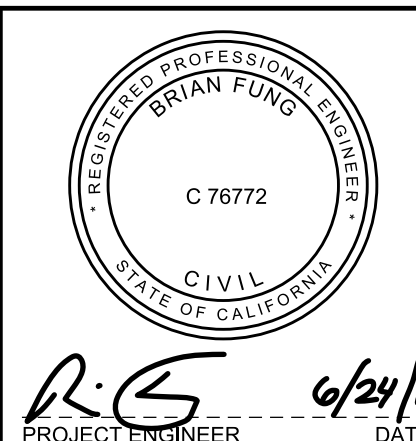

LOS ANGELES COUNTY PUBLIC WORKS
SOUTH WHITTIER LOS NIETOS
KEITH DRIVE, ET AL.
PROJECT ID NO. RMD4408001
PLAN AND PROFILE

DATE	MARK	DESCRIPTION
10/25/2021	AS-BUILT	
REVISIONS		