


SCALE: HOR. 1"= 40'  
VERT. 1"= 8'



670+00 (159.37) 670+50 (159.63) 671+00 (159.72) 671+50 (159.80) 672+00 (159.89) 672+50 (159.93) 673+00 (160.00) 673+50 (160.14) 674+00 (160.21) 674+50 (160.25) 675+00 (160.30) 675+50 (160.42) 676+00 (160.51) 676+50 (160.61) 677+00 (160.73) 677+50 (160.86) 678+00 (161.14) 678+50 (161.36) 679+00 (162.03)

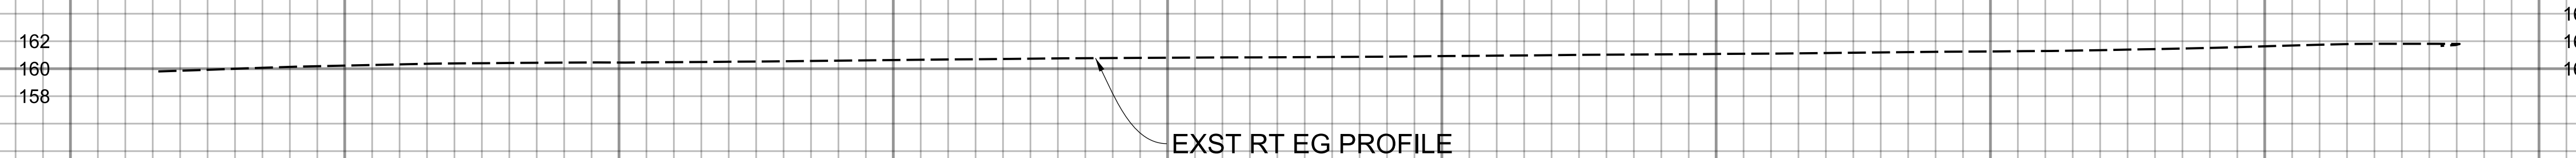

670+50 (159.92) 671+00 (160.23) 671+50 (160.40) 672+00 (160.44) 672+50 (160.52) 673+00 (160.63) 673+50 (160.73) 674+00 (160.79) 674+50 (160.84) 675+00 (160.91) 675+50 (161.00) 676+00 (161.07) 676+50 (161.16) 677+00 (161.26) 677+50 (161.39) 678+00 (161.63) 678+50 (161.81)

670 671 672 673 674 675 676 677 678 679

SEE SHEET 75 FOR PARKWAY IMPROVEMENTS

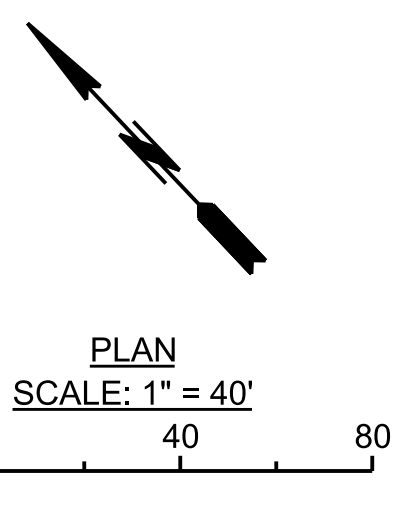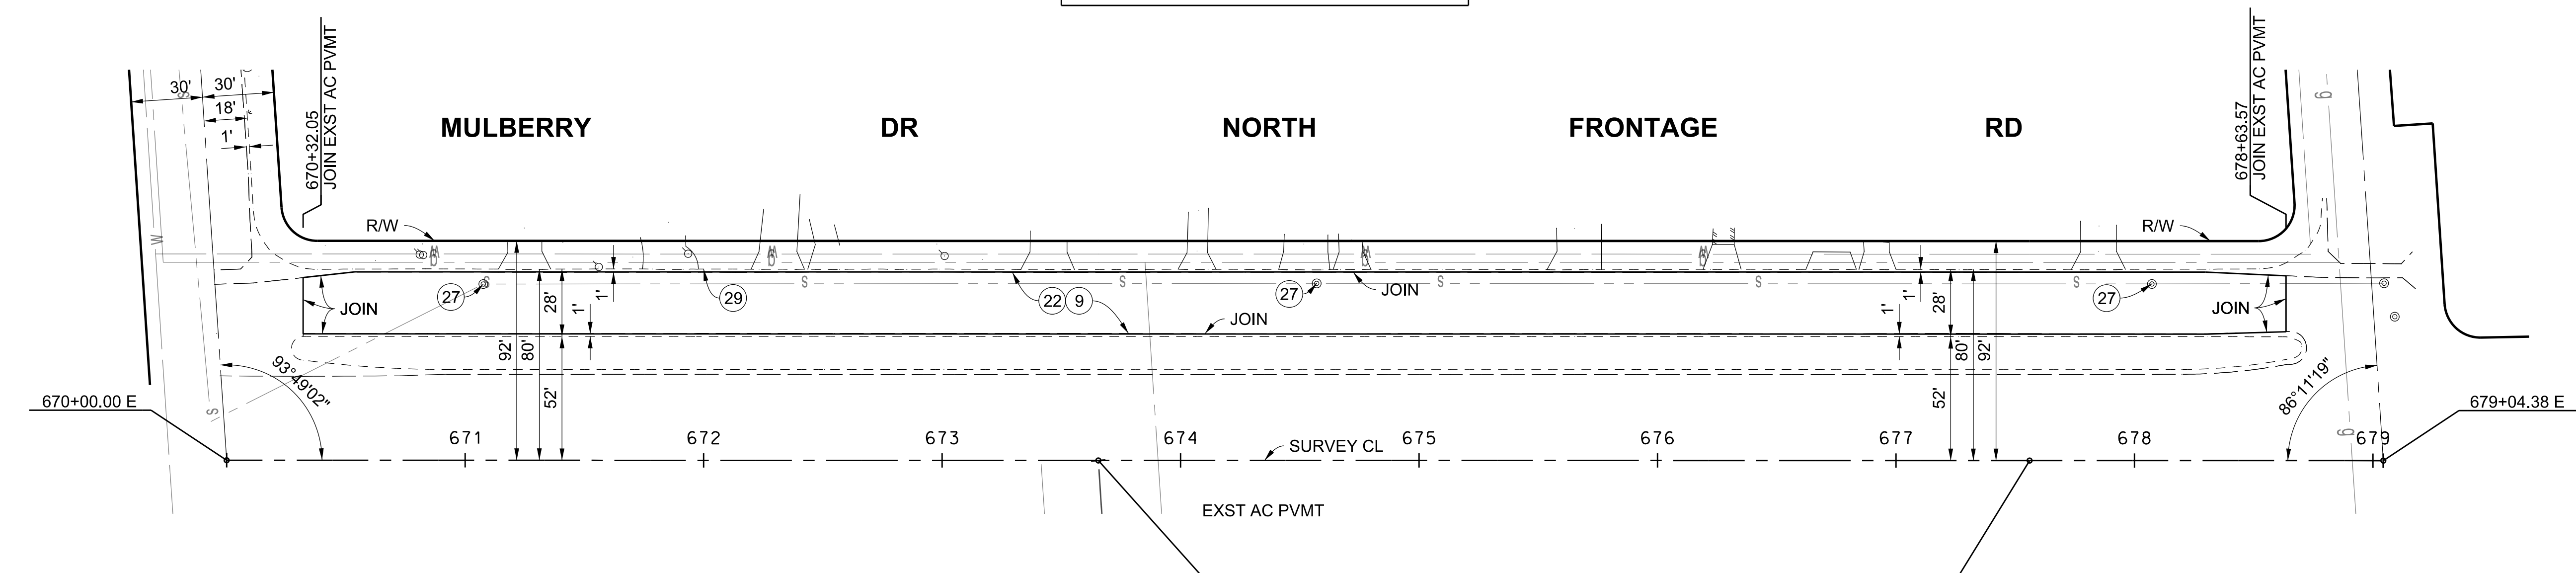

**BENCHMARK**  
PT 20 (ESTAB.), ELEV 189.886 (NORWALK AND SANTA FE 2005) PWFB 0928,  
PG 1433, SPK & DPWW @ CL INT. MILLS AV & LANNING DR

LOS ANGELES COUNTY PUBLIC WORKS

**SOUTH WHITTIER LOS NIETOS**  
KEITH DRIVE, ET AL.

PROJECT ID NO. RMD4408001  
PLAN AND PROFILE



PROJECT ENGINEER: *R.S.* DATE: 6/24/19

DATE	MARK	DESCRIPTION
10/25/2021	■	AS-BUILT
REVISIONS		