





SCALE: HOR. 1"= 40'
VERT. 1"= 8'

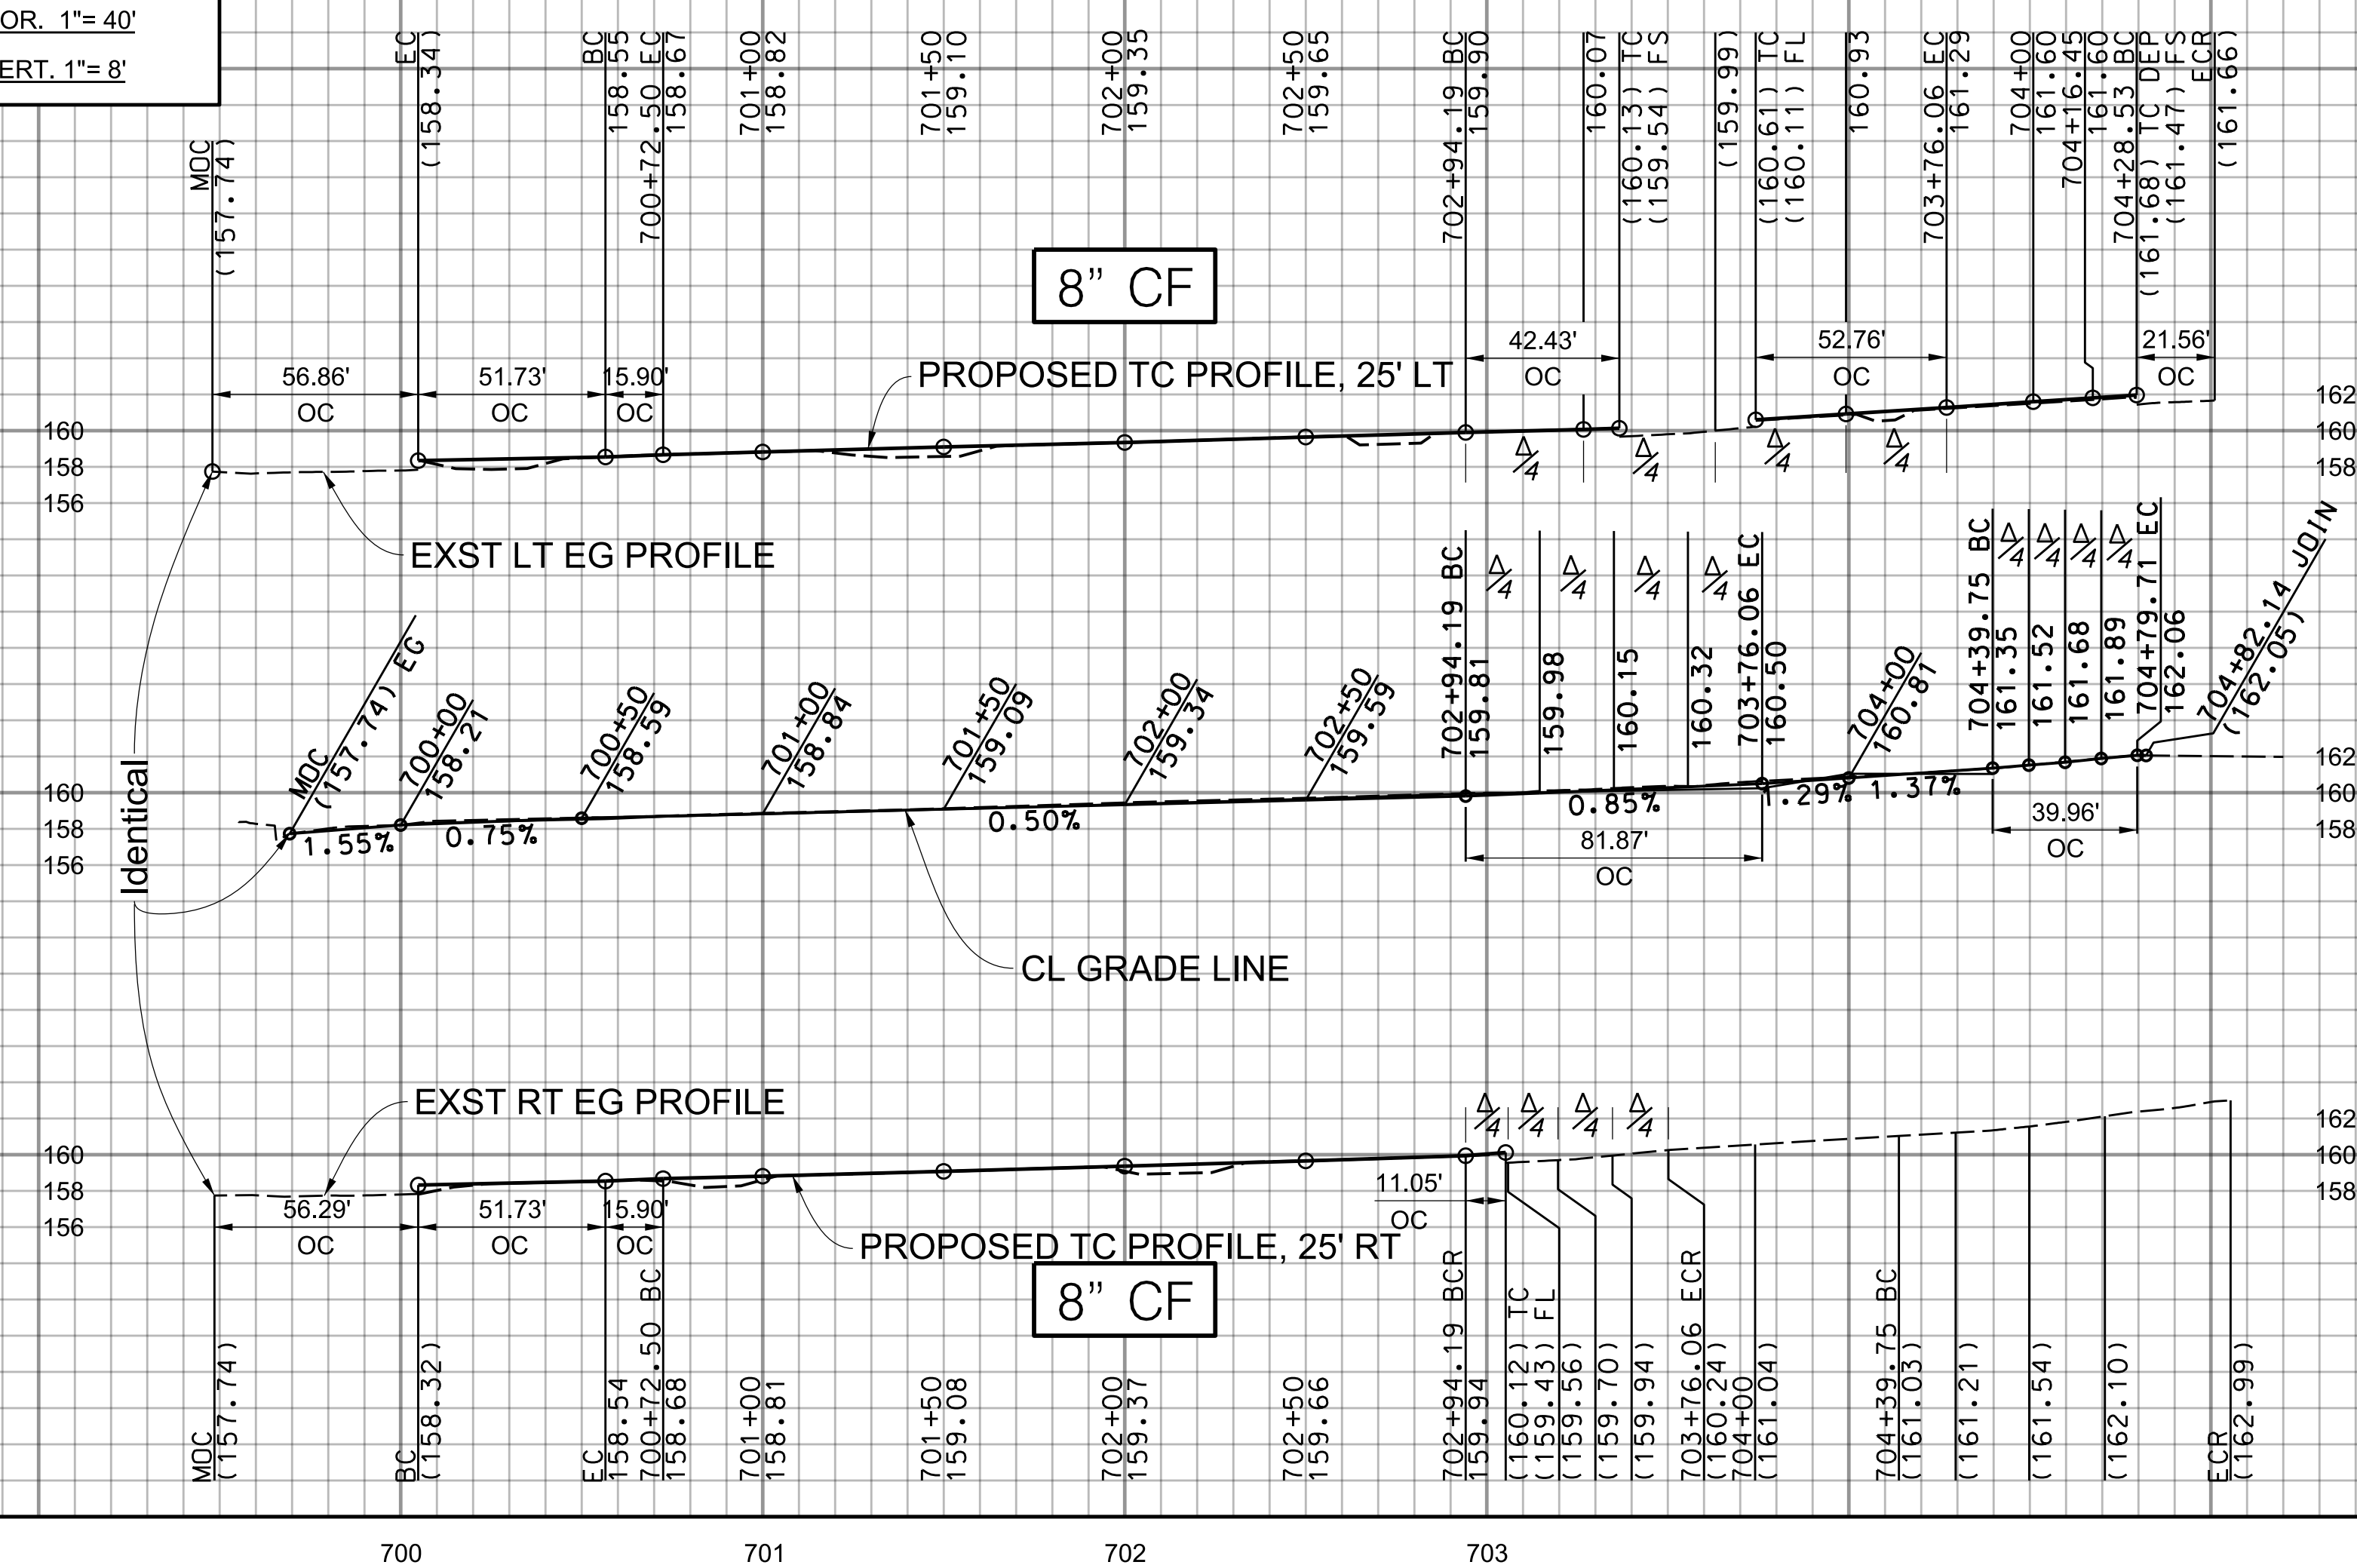

SEE SHEET 75 FOR PARKWAY IMPROVEMENTS

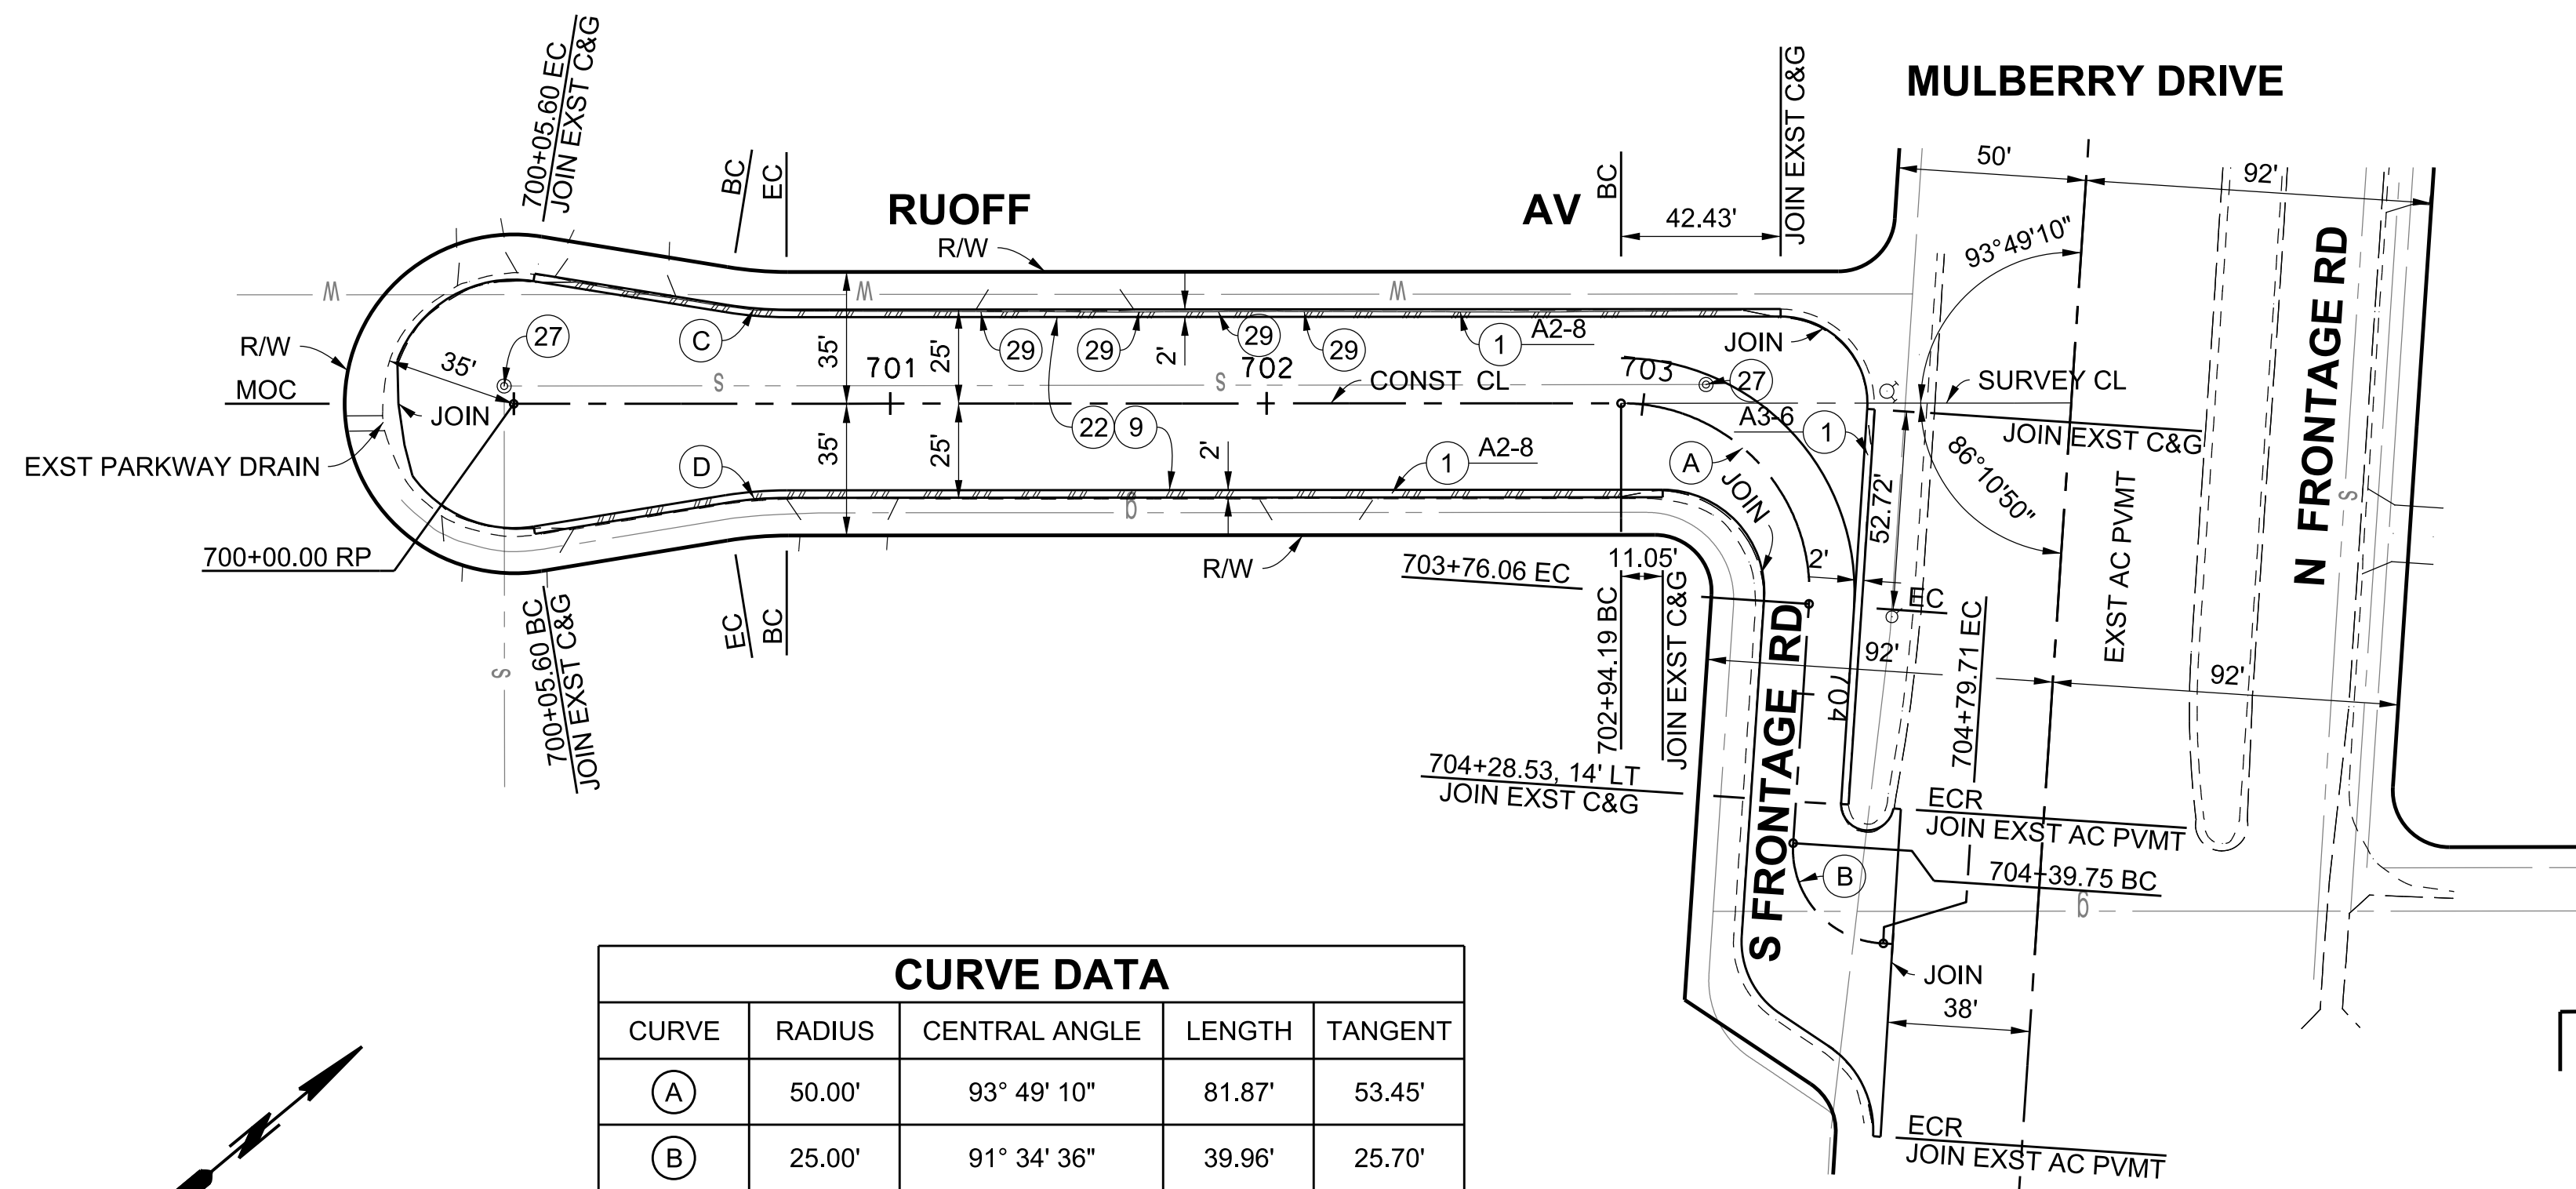


CURVE DATA				
CURVE	RADIUS	CENTRAL ANGLE	LENGTH	TANGENT
(A)	50.00'	93° 49' 10"	81.87'	53.45'
(B)	25.00'	91° 34' 36"	39.96'	25.70'
(C)	110.00'	9° 18' 44"	17.88'	8.96'
(D)	110.00'	9° 18' 28"	17.87'	8.95'

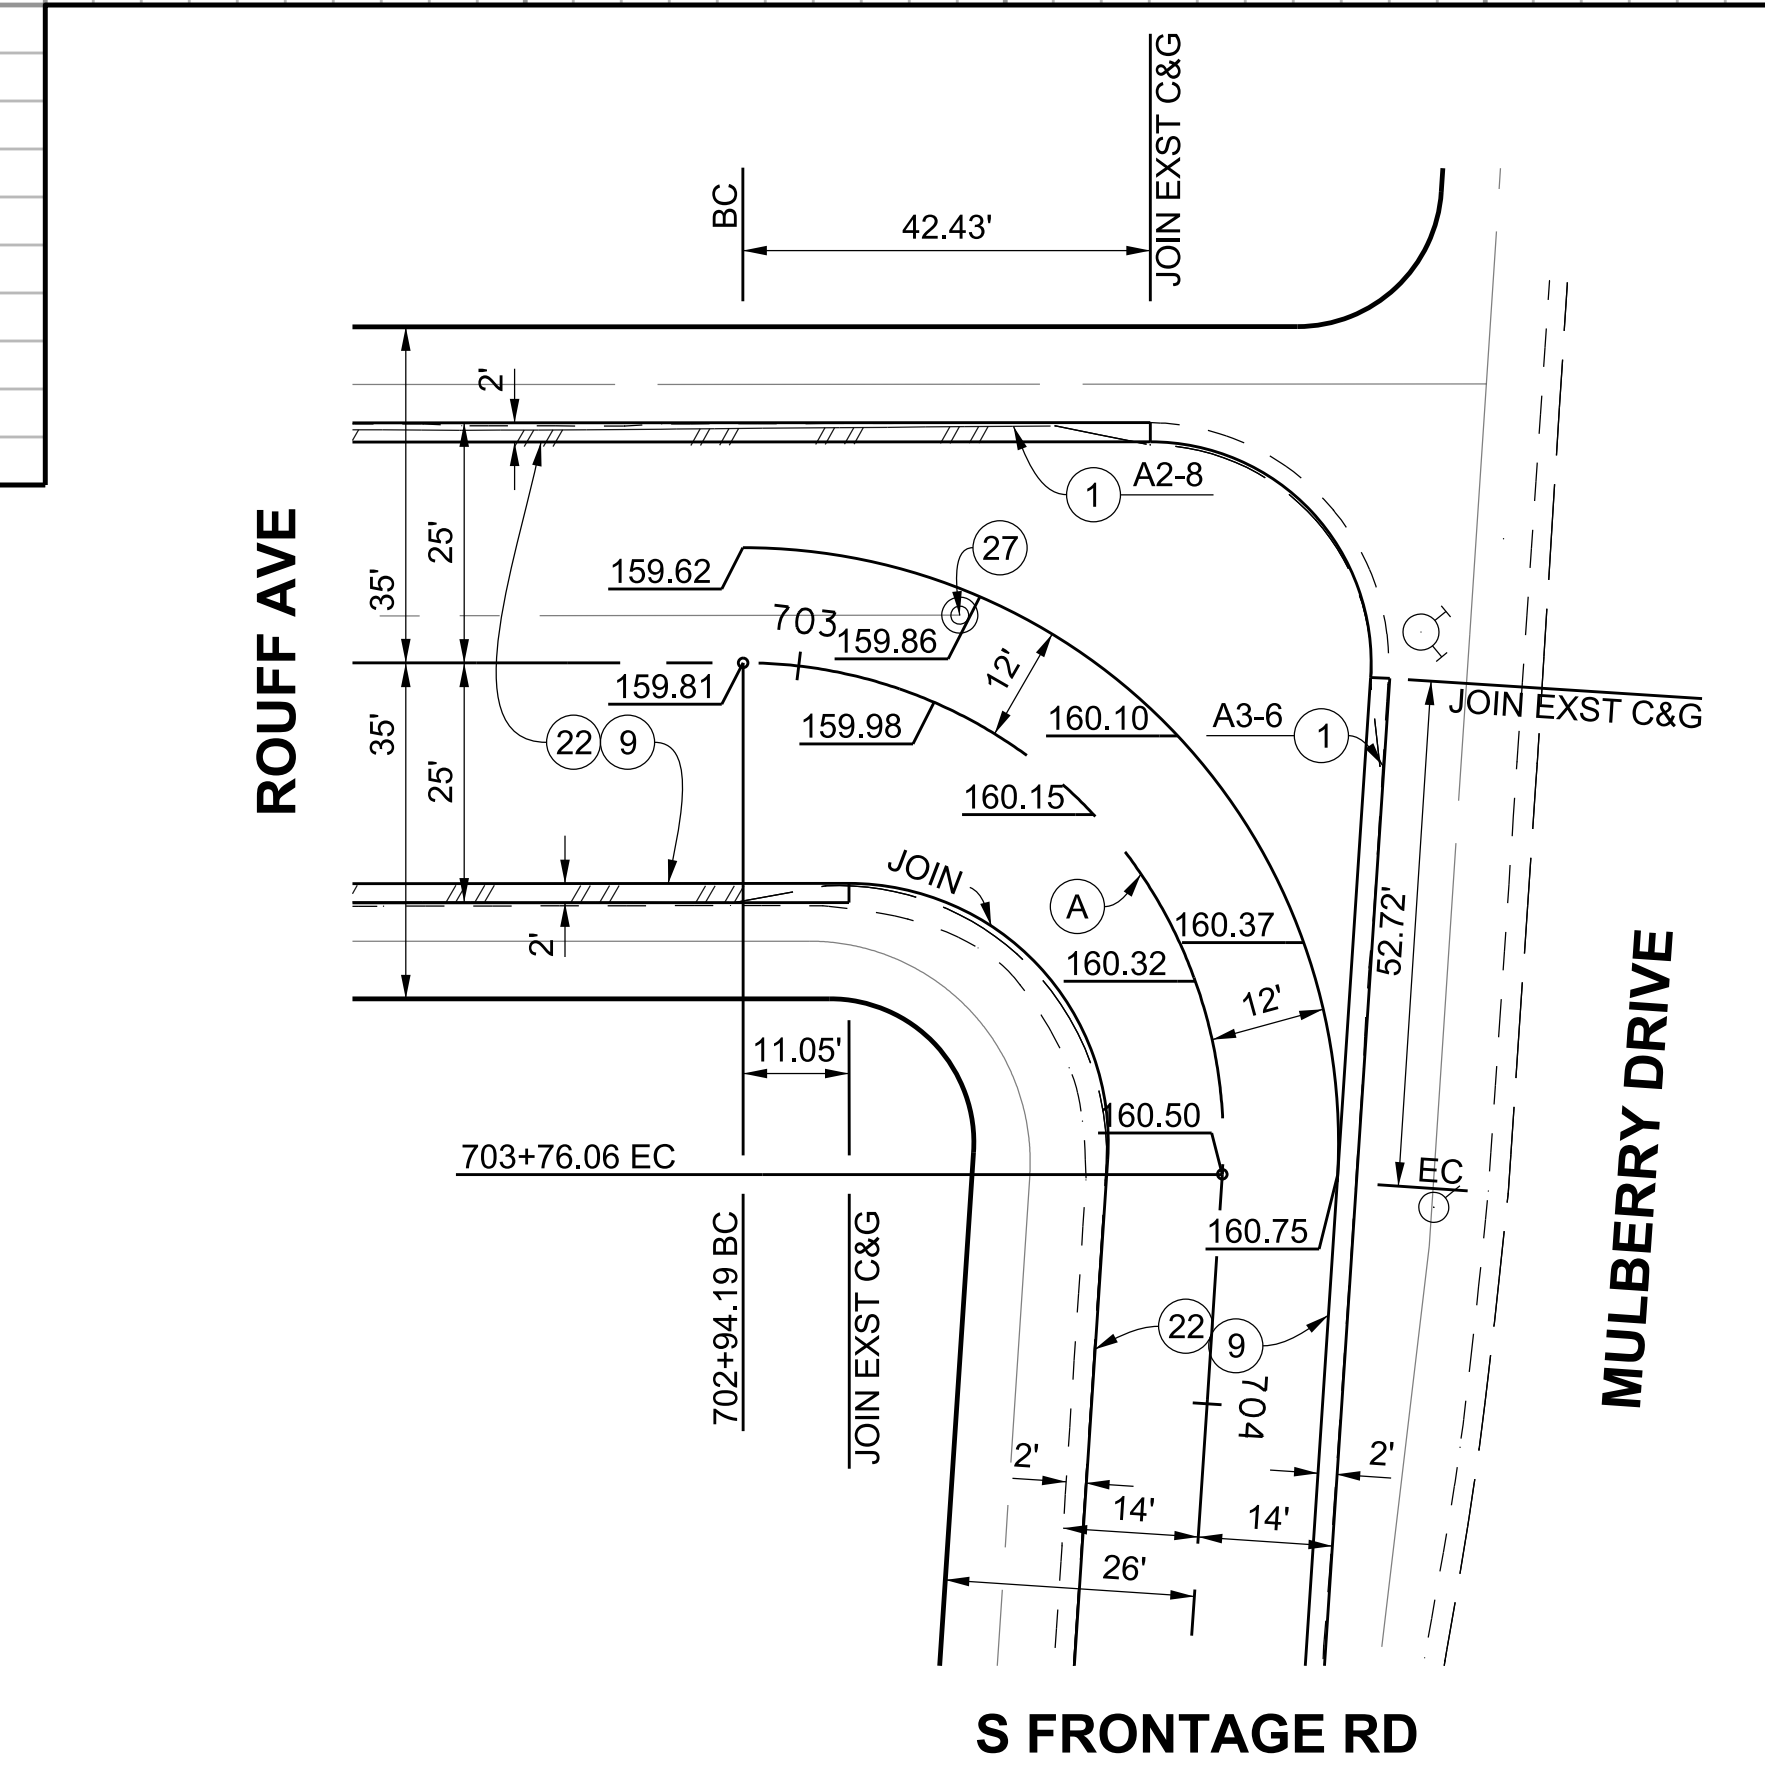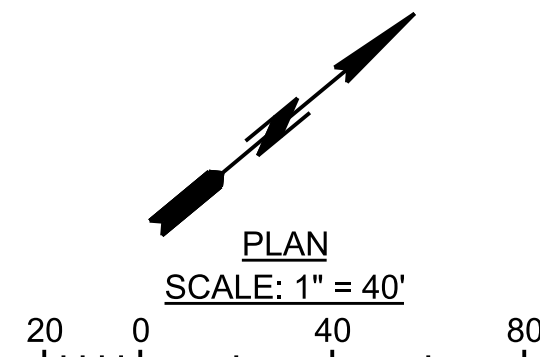

KNUCKLE DETAIL
SCALE: 1" = 20'

BENCHMARK
PT 20 (ESTAB.), ELEV 189.886 (NORWALK AND SANTA FE 2005) PWFB 0928,
PG 1433, SPK & DPW/W @ CL INT. MILLS AV & LANNING DR

10/25/2021	AS-BUILT
DATE	MARK
DESCRIPTION	REVISIONS

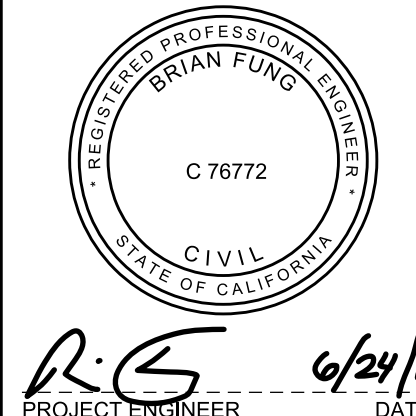

LOS ANGELES COUNTY PUBLIC WORKS
SOUTH WHITTIER LOS NIETOS
KEITH DRIVE, ET AL.
PROJECT ID NO. RMD4408001
PLAN AND PROFILE
PD PH086583 SHEET 64 OF 79