

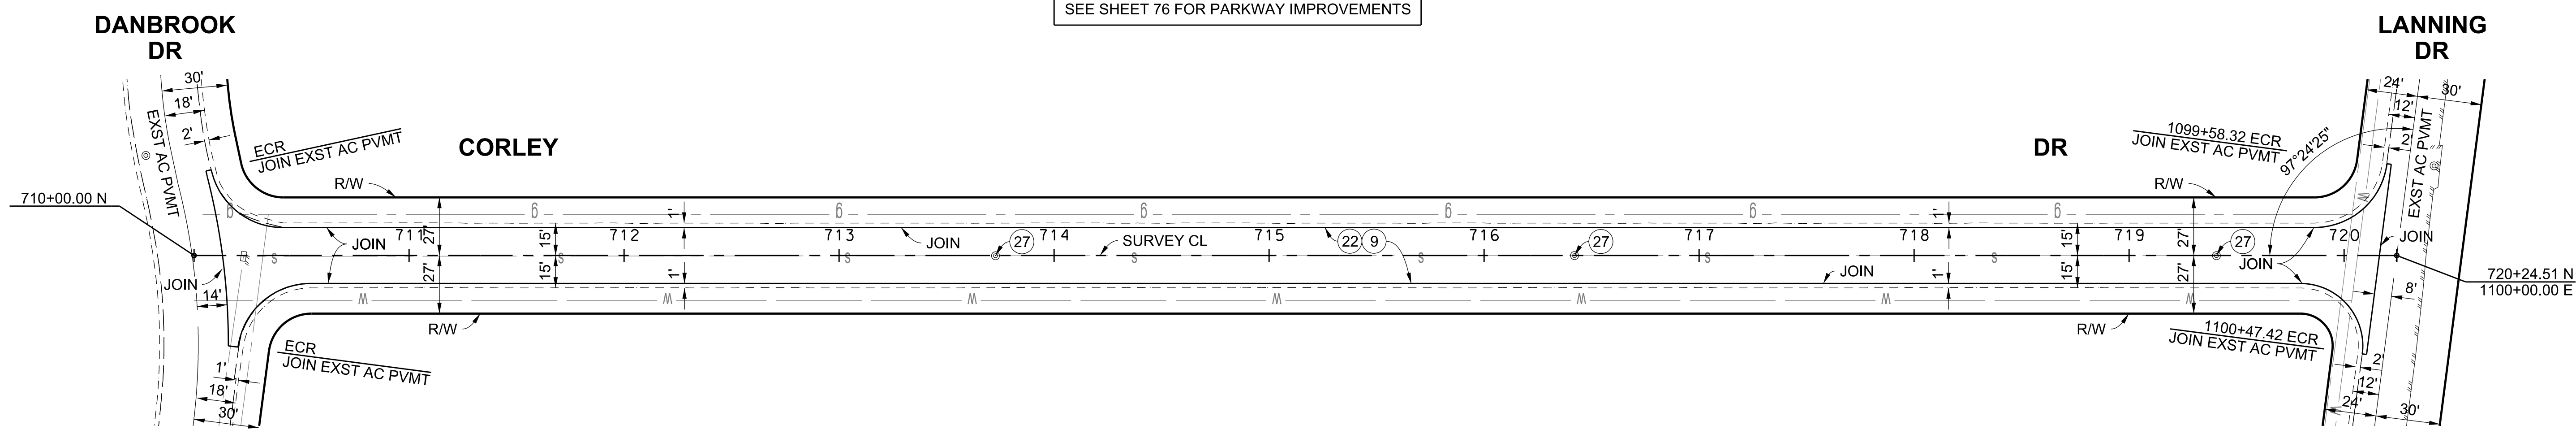



SCALE: HOR. 1"=40'  
VERT. 1"=8'

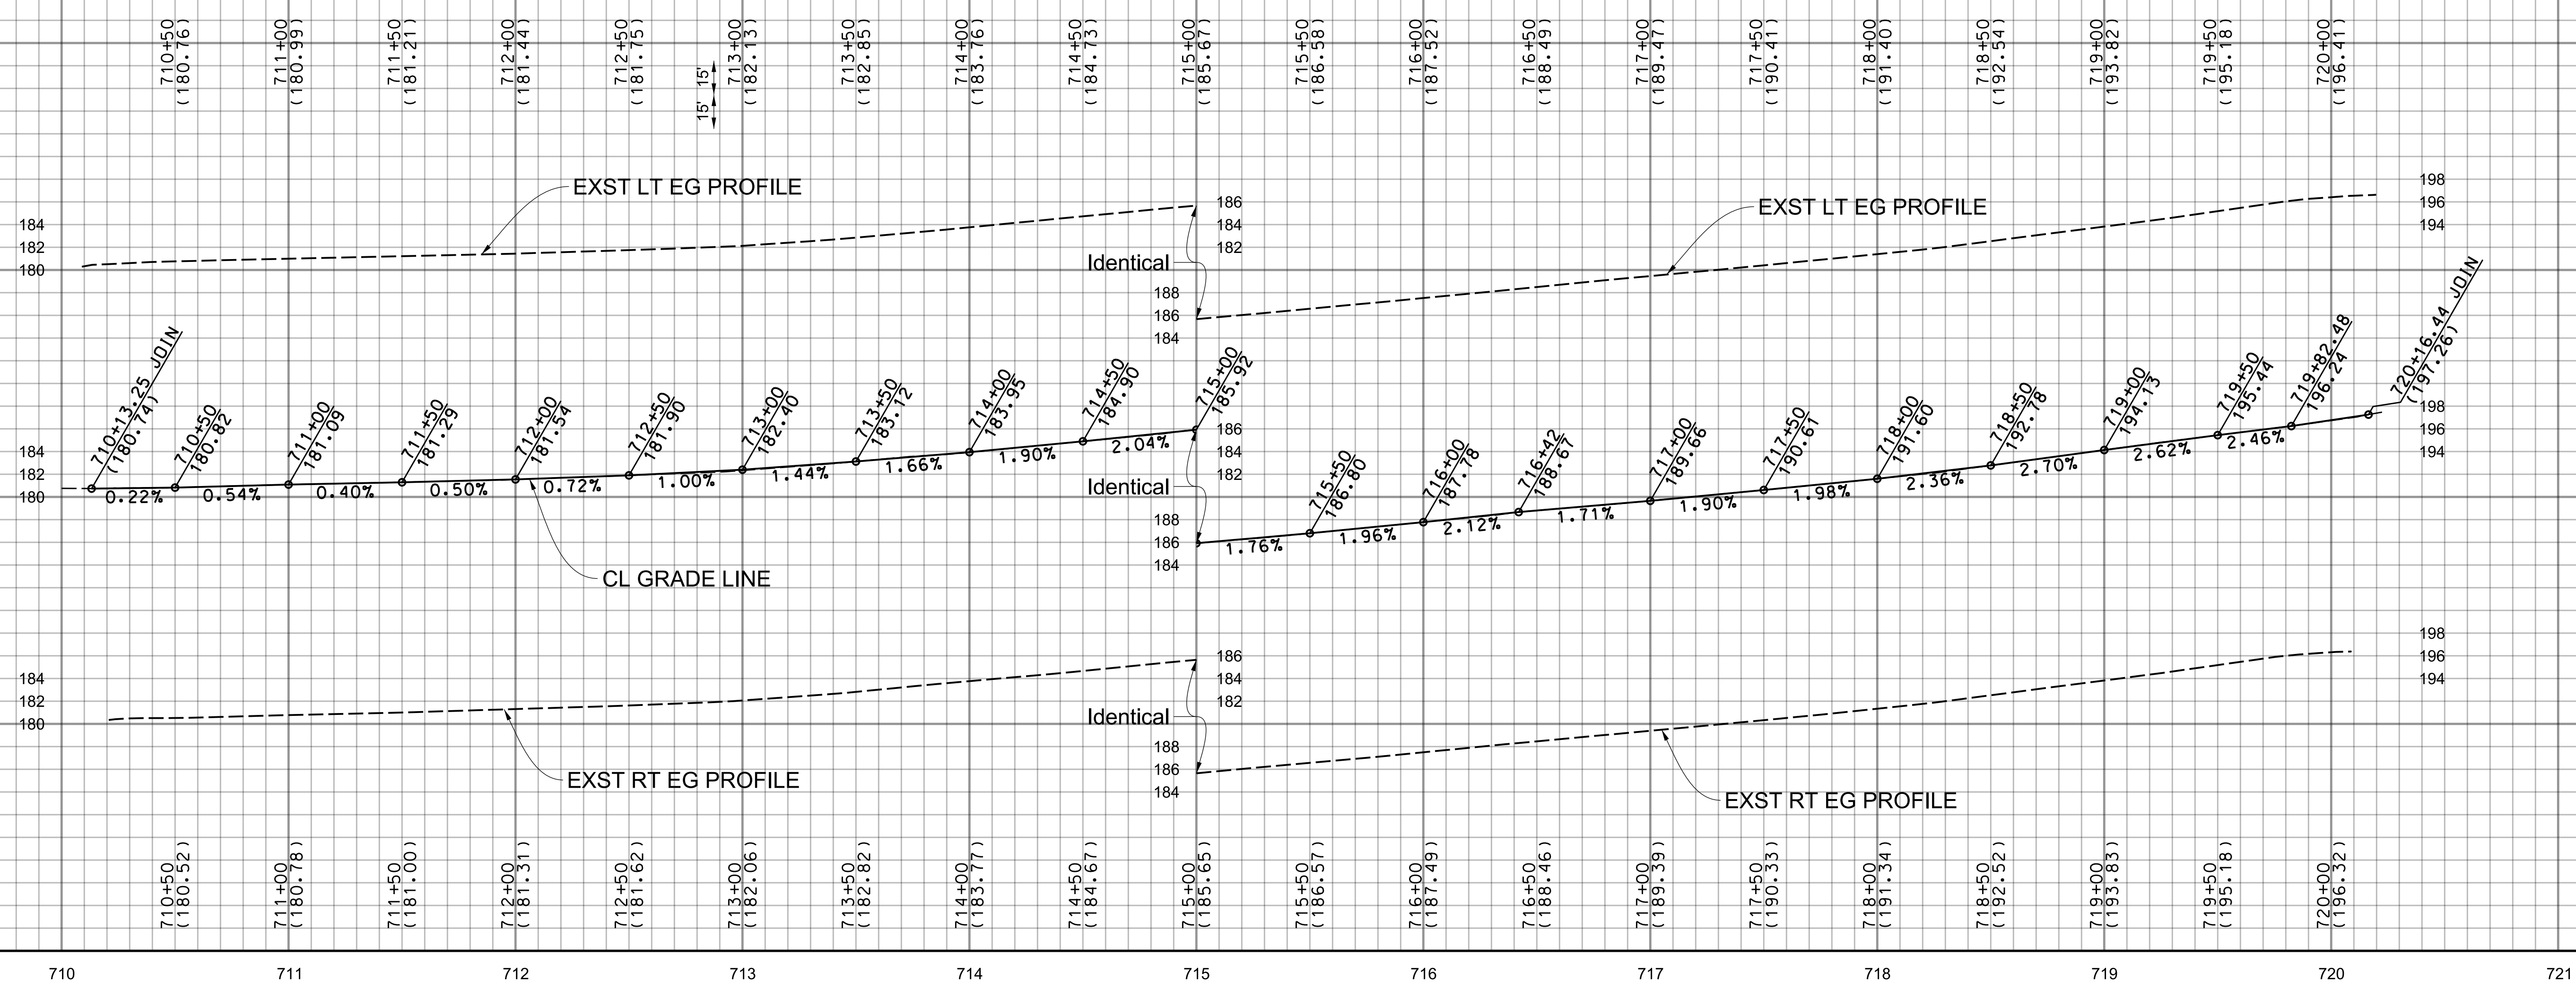

CADD PROJECT FILE NAME: \$FILESS\$  
CHECKER: B. FUNG  
DESIGNER: J. GARCIA  
DRAFTER: J. GARCIA

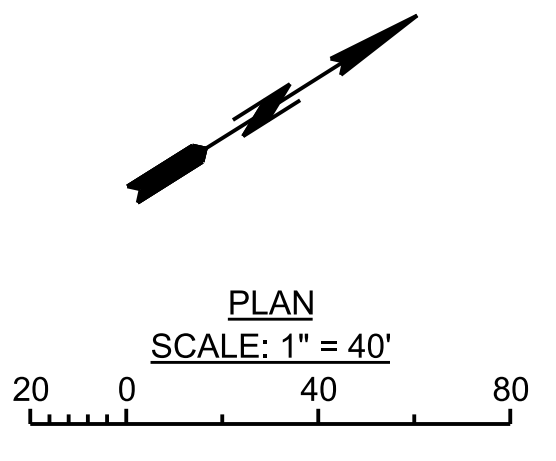

DATE	MARK	DESCRIPTION
10/25/2021	AS-BUILT	
REVISIONS		

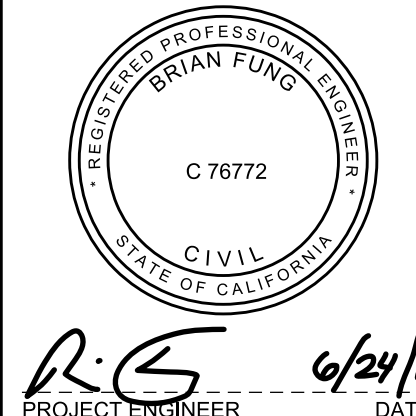

**BENCHMARK**  
PT 108 ELEV ??? (NORWALK AND SANTA FE 2005) PWFB 0928, PG 1479, P.O.S.T. SET SPK & DPWW BY INT. CORLEY DR & DANBROOK DR

LOS ANGELES COUNTY PUBLIC WORKS

**SOUTH WHITTIER LOS NIETOS**  
KEITH DRIVE, ET AL.

PROJECT ID NO. RMD4408001  
PLAN AND PROFILE

PD PH086584 SHEET 65 OF 79