
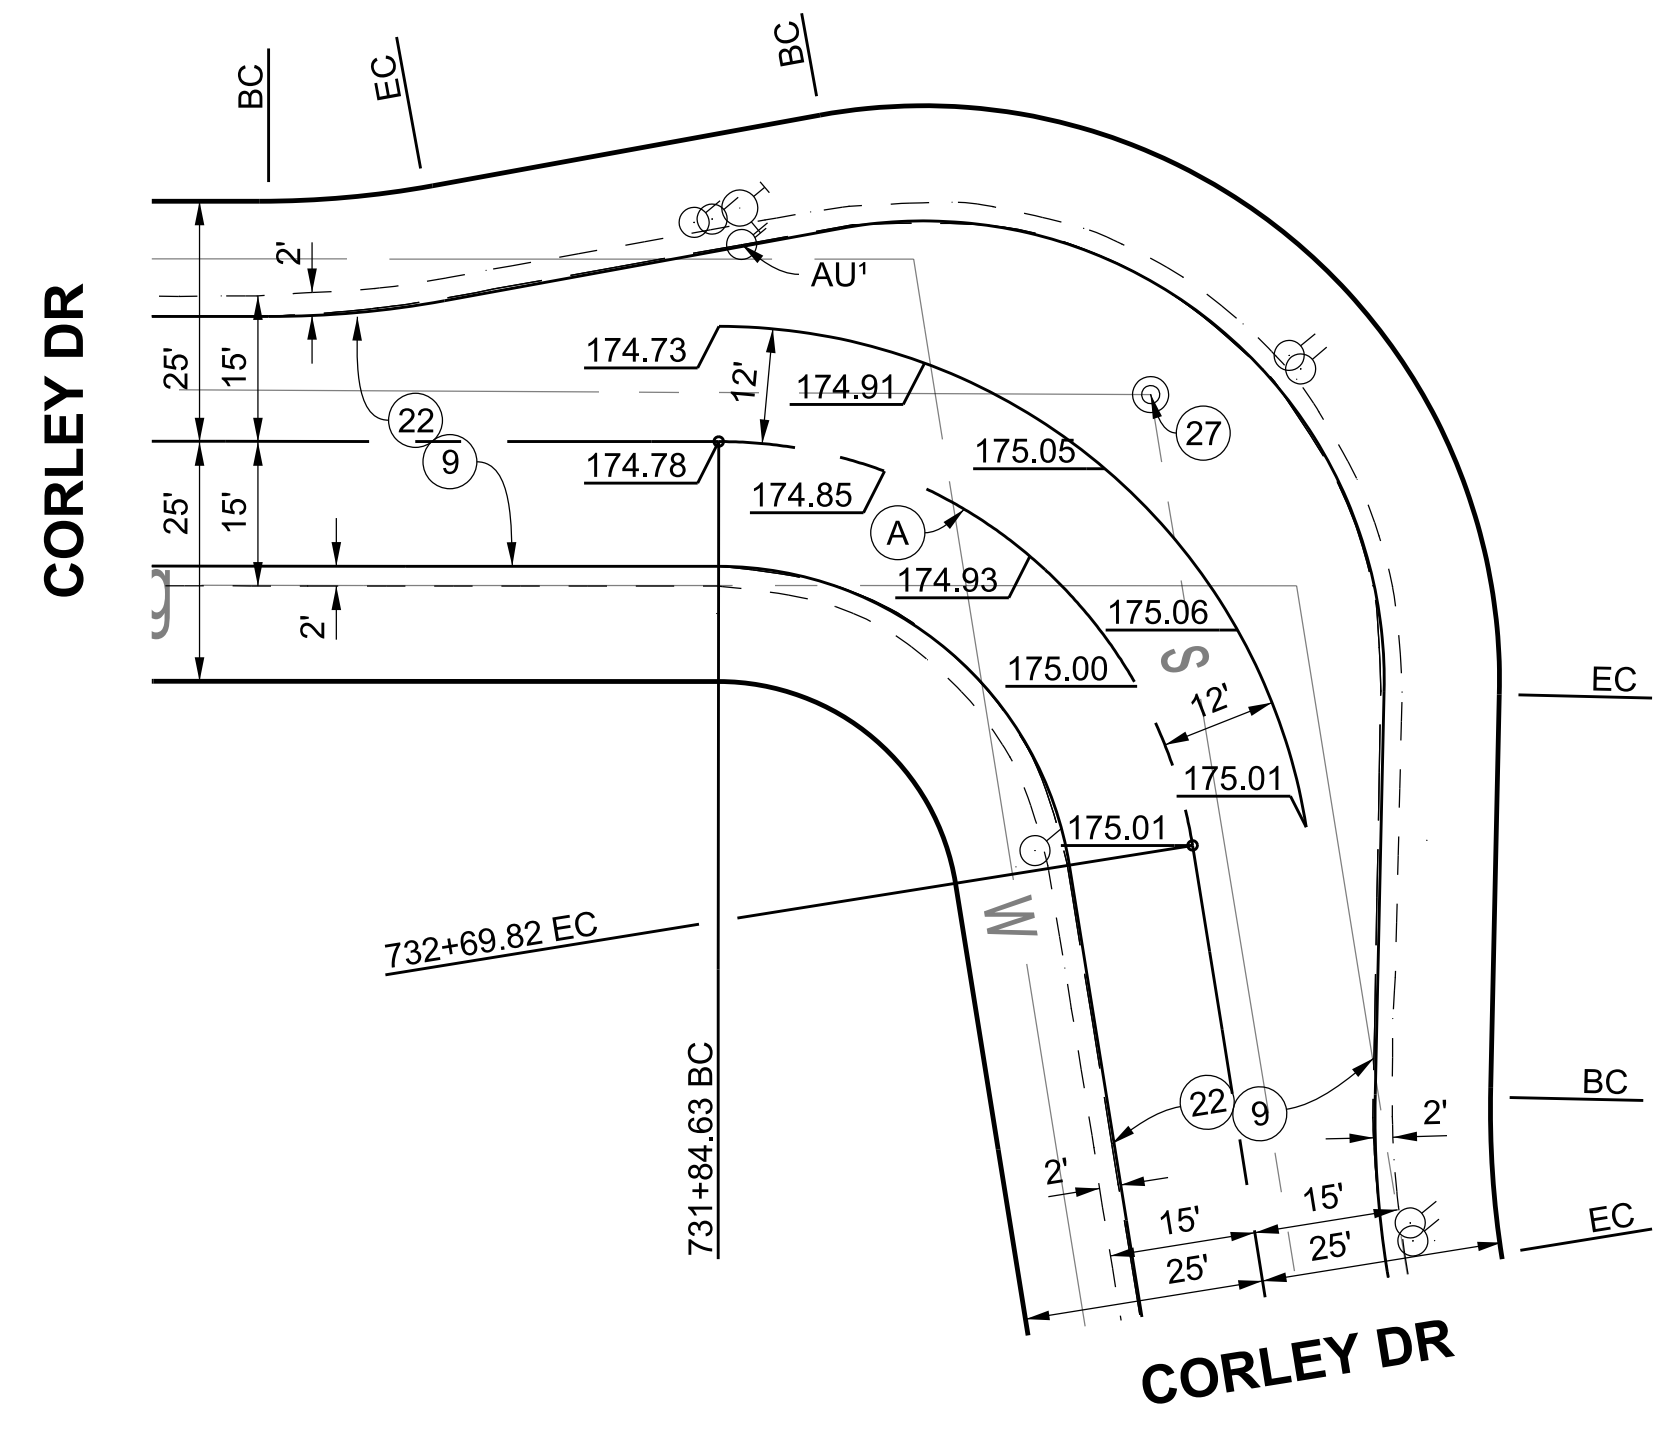
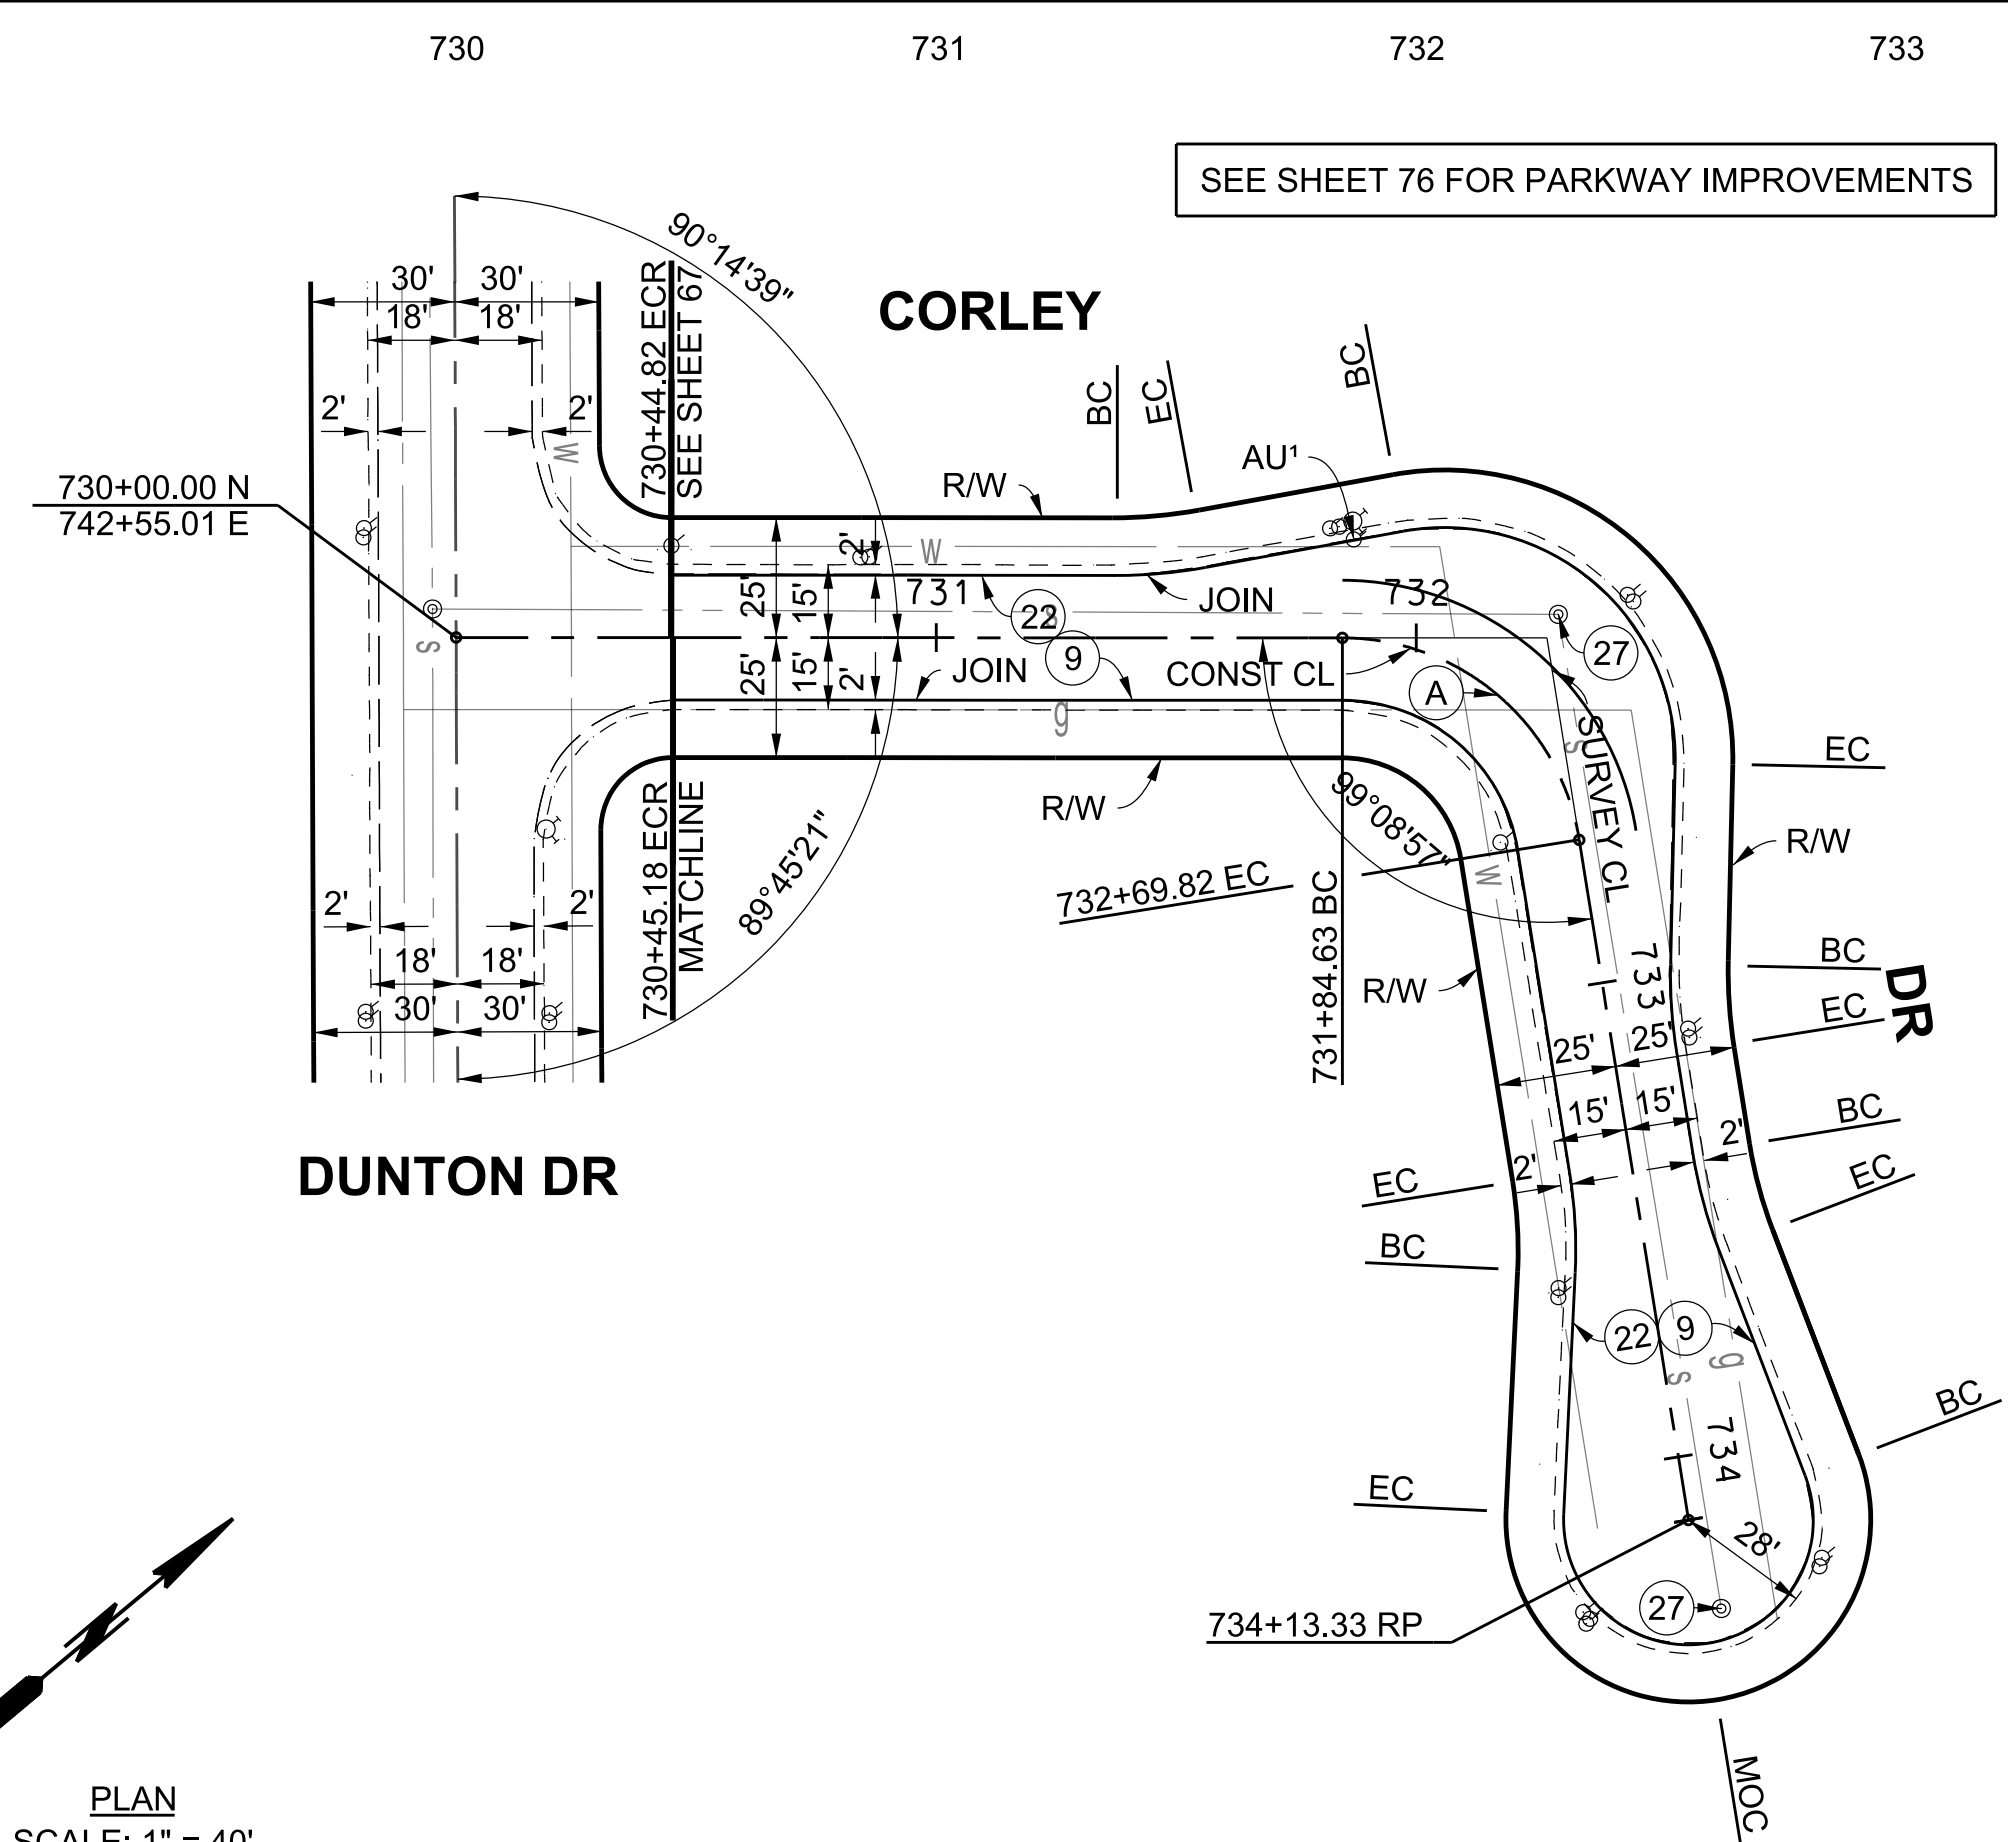


SCALE: HOR. 1"= 40'
VERT. 1"= 8'

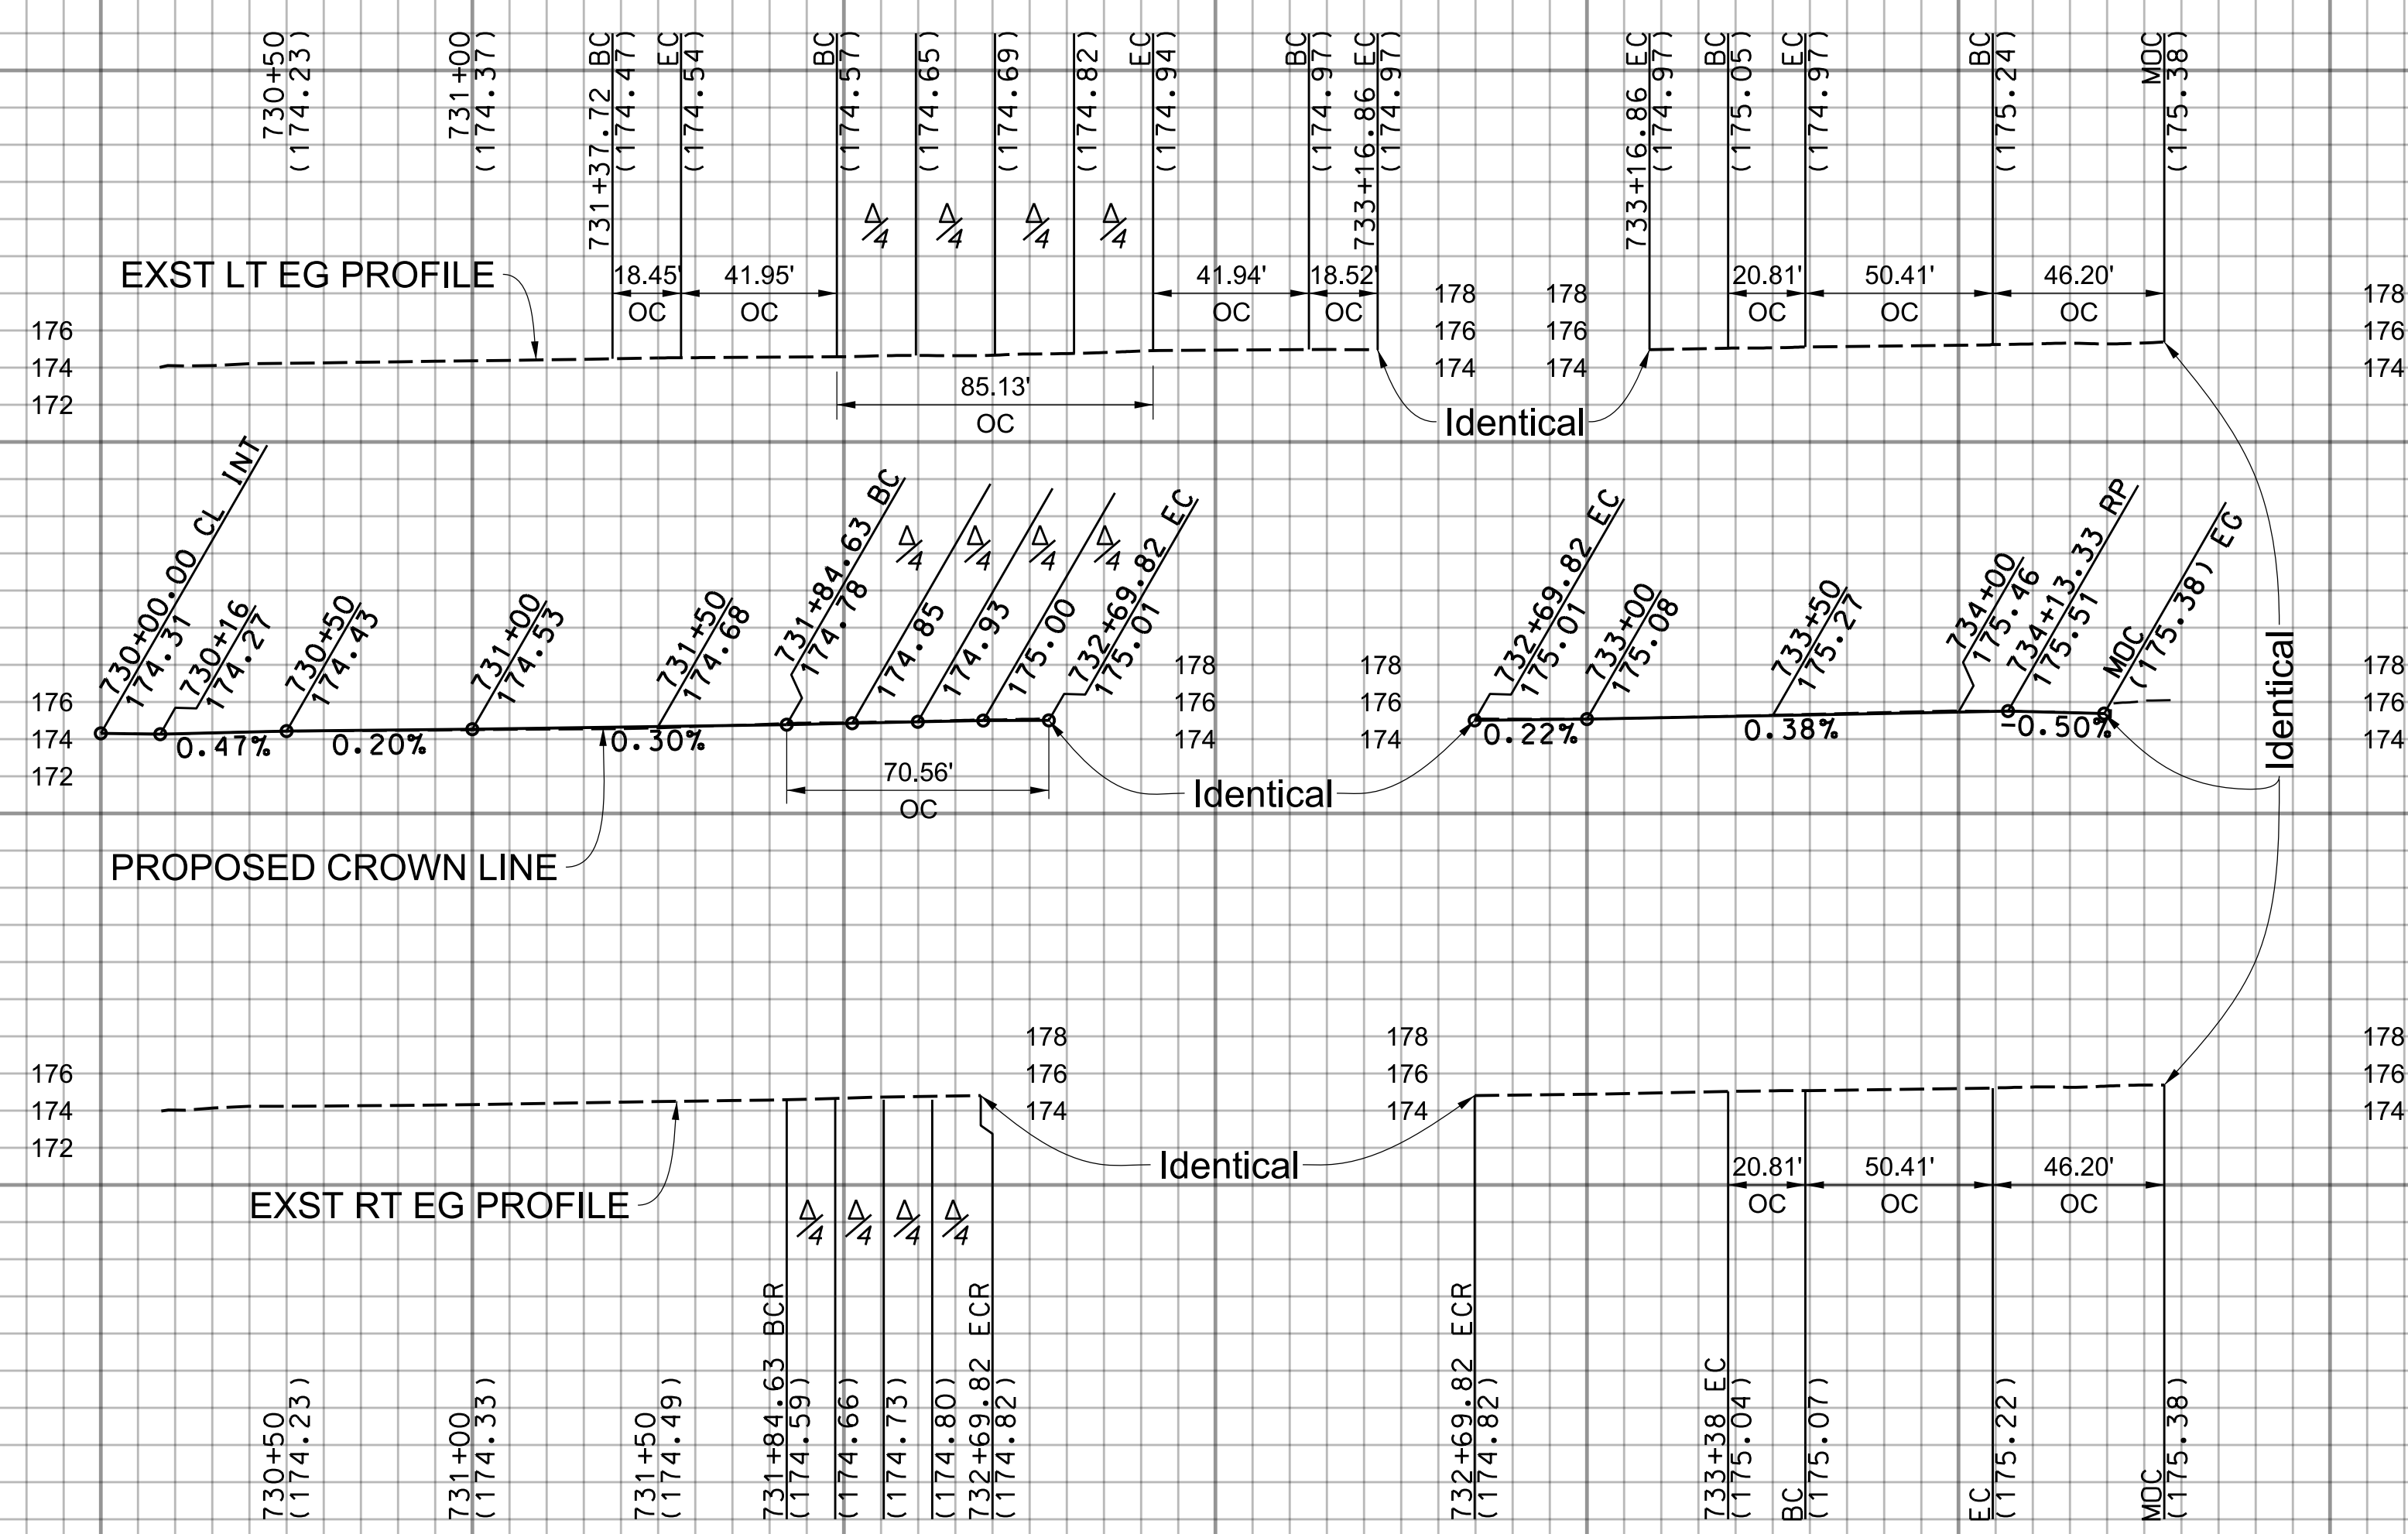

KNUCKLE DETAIL
SCALE: 1" = 20'

CURVE DATA				
CURVE	RADIUS	CENTRAL ANGLE	LENGTH	TANGENT
(A)	50.00'	80° 51' 3"	70.56'	42.59'

BENCHMARK
PT 24, ELEV 173.595 (NORWALK AND SANTA FE 2005) PWFB 0928,
PG 1381, CL INT DUNTON DR & VALLEY VIEW AVE SPK & W

LOS ANGELES COUNTY PUBLIC WORKS

SOUTH WHITTIER LOS NIETOS
KEITH DRIVE, ET AL.

PROJECT ID NO. RMD4408001
PLAN AND PROFILE

PD PH086585 SHEET 66 OF 79

DATE	MARK	DESCRIPTION
10/25/2021	AS-BUILT	
REVISIONS		



PROJECT ENGINEER: R.S. 6/24/19