

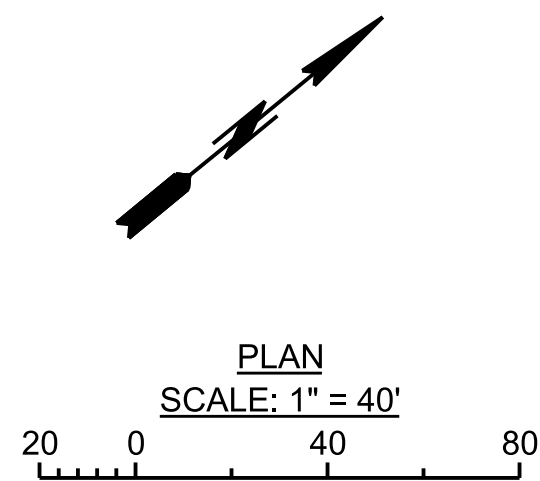


SCALE: HOR. 1"=40'
VERT. 1"=8'

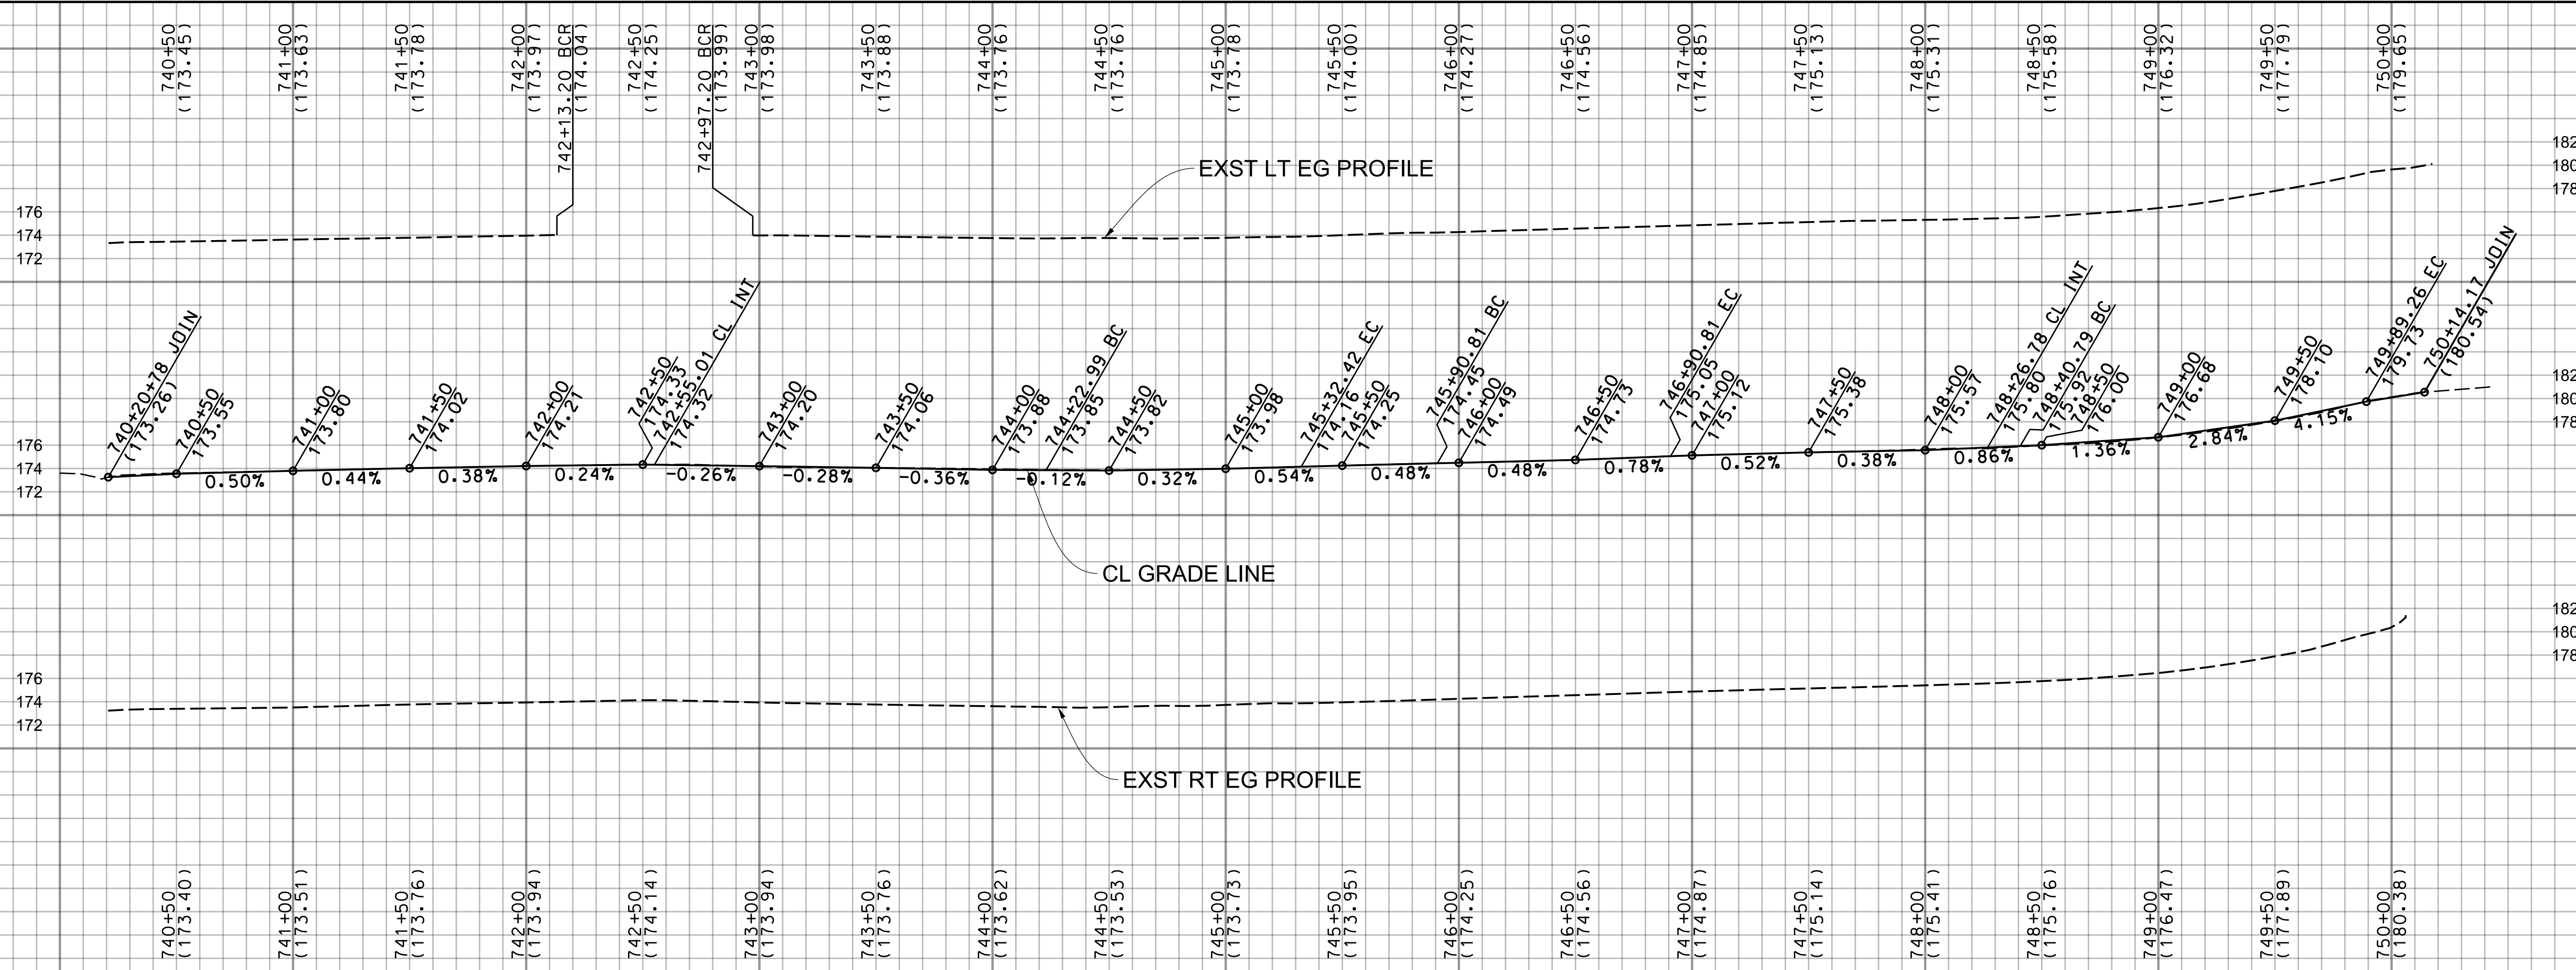

SEE SHEET 76 FOR PARKWAY IMPROVEMENTS

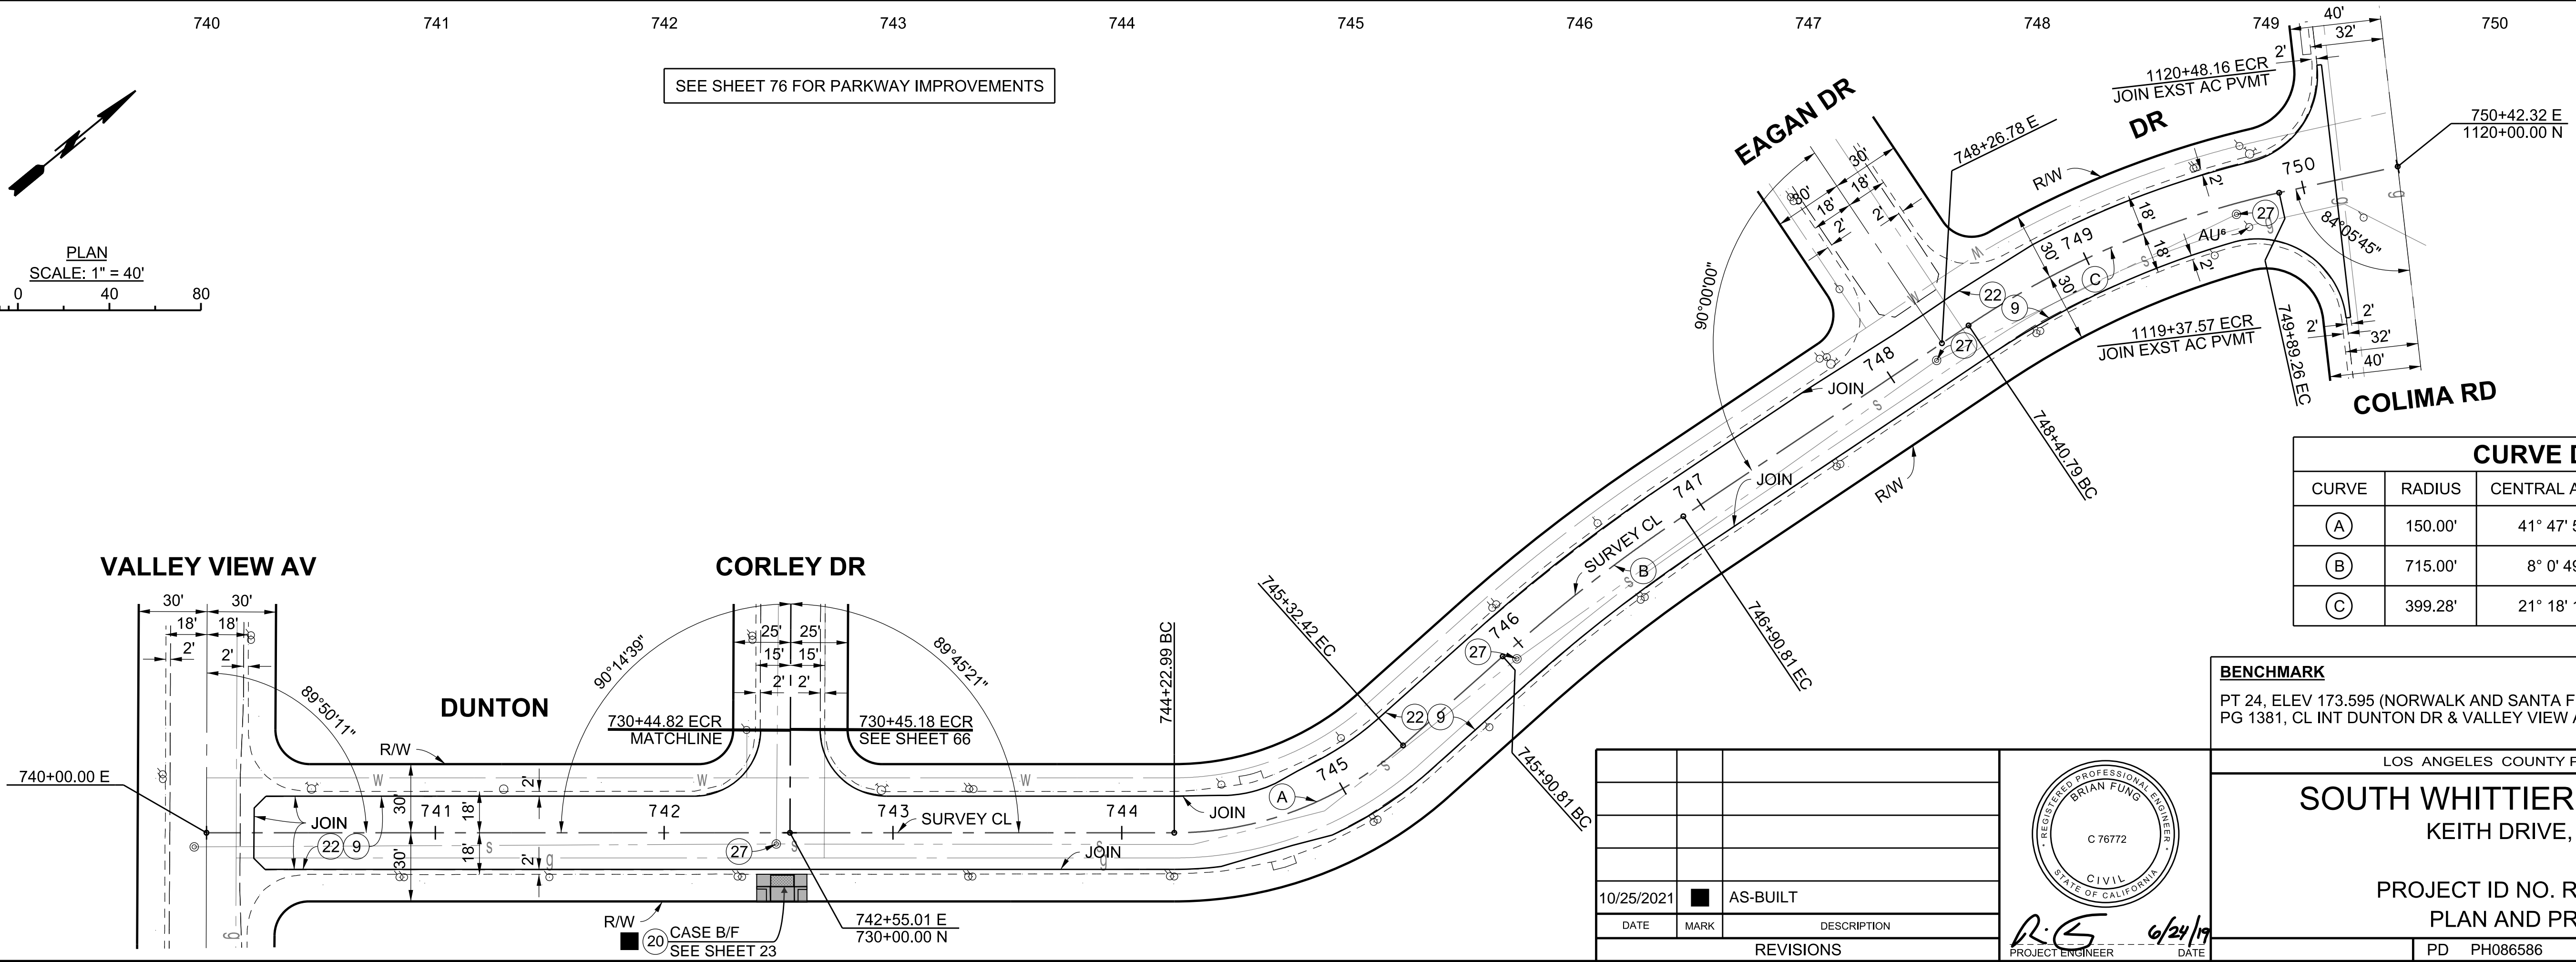

CURVE DATA				
CURVE	RADIUS	CENTRAL ANGLE	LENGTH	TANGENT
(A)	150.00'	41° 47' 51"	109.43'	57.28'
(B)	715.00'	8° 0' 49"	100.00'	50.08'
(C)	399.28'	21° 18' 17"	148.47'	75.10'

BENCHMARK
PT 24, ELEV 173.595 (NORWALK AND SANTA FE 2005) PWFB 0928,
PG 1381, CL INT DUNTON DR & VALLEY VIEW AVE SPK & W

LOS ANGELES COUNTY PUBLIC WORKS

SOUTH WHITTIER LOS NIETOS
KEITH DRIVE, ET AL.

PROJECT ID NO. RMD4408001
PLAN AND PROFILE



PROJECT ENGINEER: R.S. DATE: 6/24/19

DATE	MARK	DESCRIPTION
10/25/2021	AS-BUILT	
REVISIONS		