

SHEET 52													
LOCATION	⑤			⑭			Case (see Sheet 76)	① A2-8			⑳	Utilities*	Remarks
	Width (LF)	Length (LF)	Area (SF)	Width (LF)	Length (LF)	Area (SF)		Length (LF)	6"-12" dia.	13"-24" dia.			
11114 Hadley St	4	14	56	16	7	112	1	-	-	-	-	-	AC driveway
11155 Hadley St	4	14	56	16	7	112	1	-	-	-	-	-	AC driveway
11156 Hadley St	4	14	56	16	7	112	1	-	-	-	-	-	AC driveway
11159 Hadley St	4	14	56	16	7	112	1	-	-	-	-	-	AC driveway
11162 Hadley St	4	14	56	16	7	112	1	-	-	-	-	-	AC driveway
11165 Hadley St	4	14	56	16	7	112	1	-	-	-	-	-	AC driveway
Sheet total			336			672		0	0	0	0	0	

SHEET 53													
LOCATION	⑤			⑭			Case (see Sheet 76)	① A2-8			⑳	Utilities*	Remarks
	Width (LF)	Length (LF)	Area (SF)	Width (LF)	Length (LF)	Area (SF)		Length (LF)	6"-12" dia.	13"-24" dia.			
11208 Hadley St	4	55	220	16	7	112	1	-	-	-	1	-	-
11212 Hadley St	4	20	80	16	7	112	1	-	-	-	1	-	-
11218 Hadley St	4	38	152	16	7	112	1	-	-	-	1	-	-
11224 Hadley St	4	60	240	-	-	-	-	-	-	-	1	-	-
6704 Vanport Av	4	65	260	-	-	-	-	35	-	1	-	-	on Hadley St
11244 Hadley St	4	146	584	16	7	112	1	-	-	-	1	-	-
11244 Hadley St	4	7	28	-	-	-	-	-	-	-	-	-	Housewalk
Sheet total			1536			448		35	0	1	5	0	

SHEET 58													
LOCATION	⑤			⑭			Case (see Sheet 76)	① A2-8			⑳	Utilities*	Remarks
	Width (LF)	Length (LF)	Area (SF)	Width (LF)	Length (LF)	Area (SF)		Length (LF)	6"-12" dia.	13"-24" dia.			
14502 Lanning Dr	13	10	130	-	-	-	-	-	-	-	-	-	water meter ⁵ , gas meter ⁶
14514 Lanning Dr	-	-	-	20	7	140	3	50	-	-	-	-	-
14520 Lanning Dr	-	-	-	-	-	-	-	22	-	-	-	-	-
9635 Elmore Av	-	-	-	-	-	-	-	55	-	-	2	-	on Lanning Dr
9604 Mills Av	-	-	-	16	11	176	3	50	-	-	-	-	-
9612 Mills Av	-	-	-	-	-	-	-	-	-	-	1	-	-
9630 Mills Av	-	-	-	-	-	-	-	150	-	-	-	-	-
Sheet total			130			316		277	0	0	2	1	

SHEET 59													
LOCATION	⑤			⑭			Case (see Sheet 76)	① A2-8			⑳	Utilities*	Remarks
	Width (LF)	Length (LF)	Area (SF)	Width (LF)	Length (LF)	Area (SF)		Length (LF)	6"-12" dia.	13"-24" dia.			
Sheet total													

SHEET 60													
LOCATION	⑤			⑭			Case (see Sheet 76)	① A2-8			⑳	Utilities*	Remarks
	Width (LF)	Length (LF)	Area (SF)	Width (LF)	Length (LF)	Area (SF)		Length (LF)	6"-12" dia.	13"-24" dia.			
9628 Regatta Av	-	-	-	-	-	-	-	-	-	-	1	-	-
Sheet total			0			0		0	0	0	1	0	

SHEET 61													
LOCATION	⑤			⑭			Case (see Sheet 76)	① A2-8			⑳	Utilities*	Remarks
	Width (LF)	Length (LF)	Area (SF)	Width (LF)	Length (LF)	Area (SF)		Length (LF)	6"-12" dia.	13"-24" dia.			
14343 Terryknoll Dr	4	8	32	-	-	-	-	-	-	-	-	-	-
14349 Terryknoll Dr	4	24	96	-	-	-	-	-	-	-	-	-	-
14355 Terryknoll Dr	4	24	96	13	8	104	4	3	-	-	-	-	water meter ¹
14377 Terryknoll Dr	-	-	-	40	8	320	4	3	40	-	-	-	water meter ¹
14378 Terryknoll Dr	4	10	40	-	-	-	-	-	-	-	-	-	-
14384 Terryknoll Dr	-	-	-	-	-	-	-	-	-	1	-	-	-
14414 Terryknoll Dr	-	-	-	-	-	-	-	-	-	1	-	-	-
14420 Terryknoll Dr	-	-	-	30	10	300	3	-	-	-	-	-	-
Sheet total			264			724		0	0	2	0	0	

SHEET 62													
LOCATION	⑤			⑭			Case (see Sheet 76)	① A2-8			⑳	Utilities*	Remarks
	Width (LF)	Length (LF)	Area (SF)	Width (LF)	Length (LF)	Area (SF)		Length (LF)	6"-12" dia.	13"-24" dia.			
14313 Mulberry Dr	-	-	-	-	-	-	-	25	-	-	-	1	-
14319 Mulberry Dr	-	-	-	-	-	-	-	50	-	-	-	1	-
14325 Mulberry Dr	-	-	-	-	-	-	-	50	-	-	-	1	-
14331 Mulberry Dr	-	-	-	25	11	275	3	-	-	-	-	-	-
14335 Mulberry Dr	-	-	-	16	11	176	3	23	-	-	-	-	-
14341 Mulberry Dr	-	-	-	16	7	112	3	14	-	-	-	-	-
14347 Mulberry Dr	-	-	-	16	11	176	3	-	-	-	-	-	-
14353 Mulberry Dr	-	-	-	4	8	32	3	11	-	-	-	1	-
14357 Mulberry Dr	-	-	-	-	-	-	-	13	-	-	-	1	-
14369 Mulberry Dr	-	-	-	20	11	220	1	26	-	-	-	1	-
14375 Mulberry Dr	-	-	-	-	-	-	-	32	-	-	-	1	-
Sheet total			0			991		244	0	0	0	7	


SHEET 63													
LOCATION	⑤			⑭			Case (see Sheet 76)	① A2-8			⑳	Utilities*	Remarks
	Width (LF)	Length (LF)	Area (SF)	Width (LF)	Length (LF)	Area (SF)		Length (LF)	6"-12" dia.	13"-24" dia.			
10145 Regatta Av	4	20	80	-	-	-	-	-	-	-	-	-	-
14326 Mulberry Dr	4	50	200	-	-	-	-	-	-	-	-	-	on Regatta Av
Sheet total			280			0		0	0	0	0	0	

SHEET 64													
LOCATION	⑤			⑭			Case (see Sheet 76)	① A2-8			⑳	Utilities*	Remarks
	Width (LF)	Length (LF)	Area (SF)	Width (LF)	Length (LF)	Area (SF)		Length (LF)	6"-12" dia.	13"-24" dia.			
10227 Ruoff Av	4	24	96	-	-	-	-	-	-	-	-	-	-
10208 Ruoff Av	4	32	128	-	-	-	-	-	-	-	-	-	on Mulberry Dr
10203 Ruoff Av	-	-	-	25	5	125	2	-	-	-	-	-	-
10215 Ruoff Av	-	-	-	44	5	220	2	-	-	-	-	-	-
10218 Ruoff Av	-	-	-	28	5	140	2	-	-	-	-	-	-
10232 Ruoff Av	-	-	-	35	5	175	2	-	-	-	-	-	-
10235 Ruoff Av	-	-	-	34	5	170	2	-	-	-	-	-	-
10241 Ruoff Av	-	-	-	17	5	85	2	-	-	-	-	-	-
Sheet total			224			915		0	0	0	0	0	

CADD PROJECT FILE NAME: \$FILESS
 CHECKER: B. FUNG
 DESIGNER: J. GARCIA
 DRAFTER: J. GARCIA

* UTILITIES TO BE ADJUSTED BY OWNER
 1 ORCHARD DALE WATER DISTRICT
 5 SUBURBAN WATER SYSTEMS
 6 SOUTHERN CALIFORNIA GAS COMPANY

10/25/2021	AS-BUILT
DATE	MARK
DESCRIPTION	
REVISIONS	

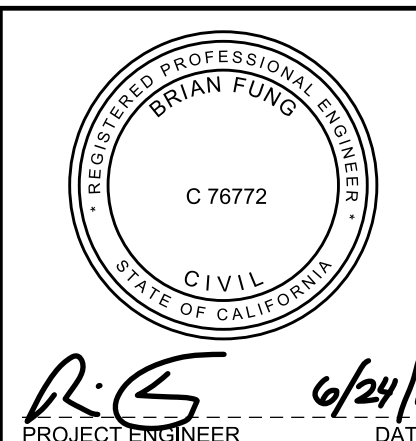

LOS ANGELES COUNTY PUBLIC WORKS
SOUTH WHITTIER LOS NIETOS
 KEITH DRIVE, ET AL.
 PROJECT ID NO. RMD4408001
 PARKWAY IMPROVEMENTS TABLES
 PD PH086594 SHEET 75 OF 79