

SHEET 65

LOCATION	⑤			⑭			Case (see Sheet 76)	① A2-8			⑳	Utilities*	Remarks
	Width (LF)	Length (LF)	Area (SF)	Width (LF)	Length (LF)	Area (SF)		Length (LF)	6"-12" dia.	13"-24" dia.			
10405 Corley Dr	-	-	-	16	7	112	3	-	-	-	-	-	-
10353 Corley Dr	-	-	-	16	10	160	3	-	-	-	-	-	-
10316 Corley Dr	-	-	-	31	11	341	3	-	-	-	-	water meter <sup>§</sup>	-
Sheet total			0			613		0	0	0	0		

SHEET 66


LOCATION	⑤			⑭			Case (see Sheet 76)	① A2-8			⑳	Utilities*	Remarks
	Width (LF)	Length (LF)	Area (SF)	Width (LF)	Length (LF)	Area (SF)		Length (LF)	6"-12" dia.	13"-24" dia.			
10539 Corley Dr	4	25	100	27	9	243	3	35	-	-	-	-	-
10516 Corley Dr	-	-	-	23	9	207	3	-	-	-	-	-	-
10514 Corley Dr	4	16	64	18	9	162	3	-	-	-	1	-	-
10510 Corley Dr	4	20	80	22	9	198	3	-	-	-	-	-	-
10507 Corley Dr	4	40	160	24	9	216	3	-	-	-	-	-	-
Sheet total			404			1026		35	0	0	1	0	

SHEET 67


LOCATION	⑤			⑭			Case (see Sheet 76)	① A2-8			⑳	Utilities*	Remarks
	Width (LF)	Length (LF)	Area (SF)	Width (LF)	Length (LF)	Area (SF)		Length (LF)	6"-12" dia.	13"-24" dia.			
14712 Dunton Dr	4	35	140	-	-	-	-	-	-	-	-	-	-
14716 Dunton Dr	4	26	104	27	7	189	1	-	-	-	-	-	-
14720 Dunton Dr	-	-	-	27	7	189	1	-	-	-	-	-	-
14724 Dunton Dr	4	16	64	16	7	112	1	-	-	-	-	-	-
14730 Dunton Dr	4	18	72	18	7	126	1	-	-	-	-	-	-
14736 Dunton Dr	4	16	64	-	-	-	-	-	-	-	-	-	-
14743 Dunton Dr	4	48	192	24	7	168	1	-	-	-	-	-	-
14758 Dunton Dr	4	23	92	23	7	161	1	-	-	-	-	-	-
Sheet total			728			945		0	0	0	0	0	

\* UTILITIES TO BE ADJUSTED BY OWNER


§ SUBURBAN WATER SYSTEMS

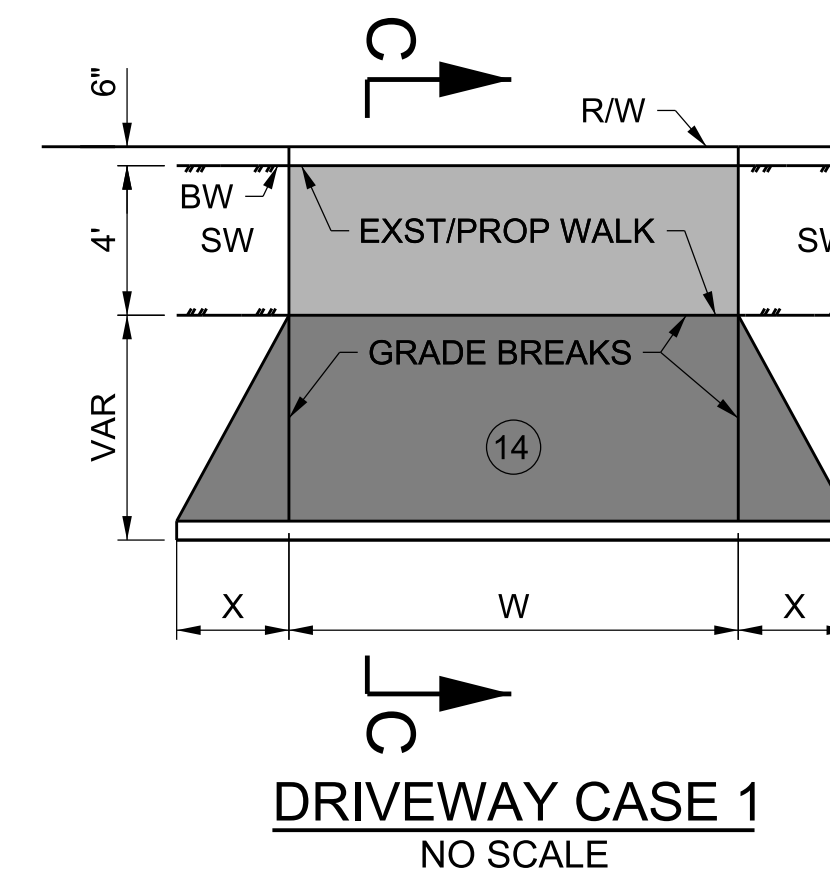


DRIVEWAY CASE 1  
NO SCALE

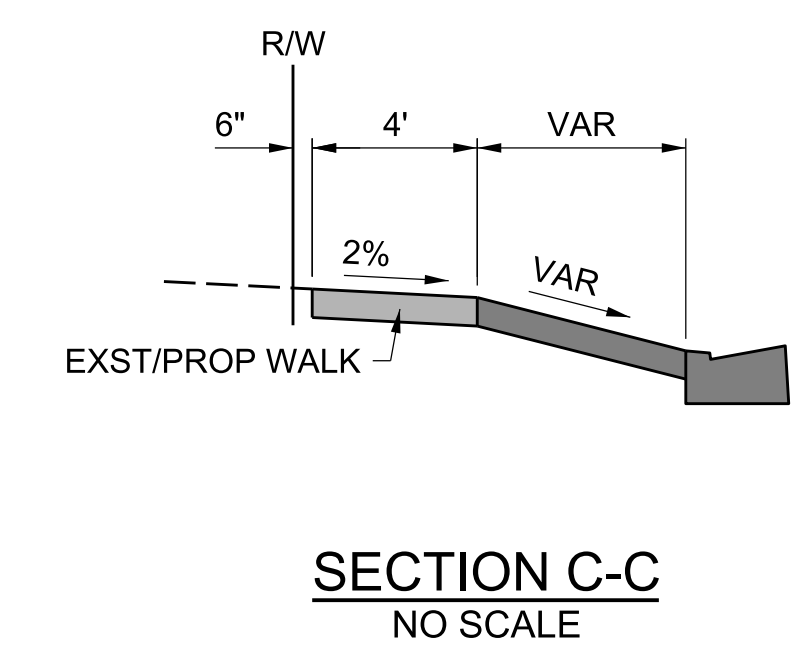


SECTION C-C  
NO SCALE

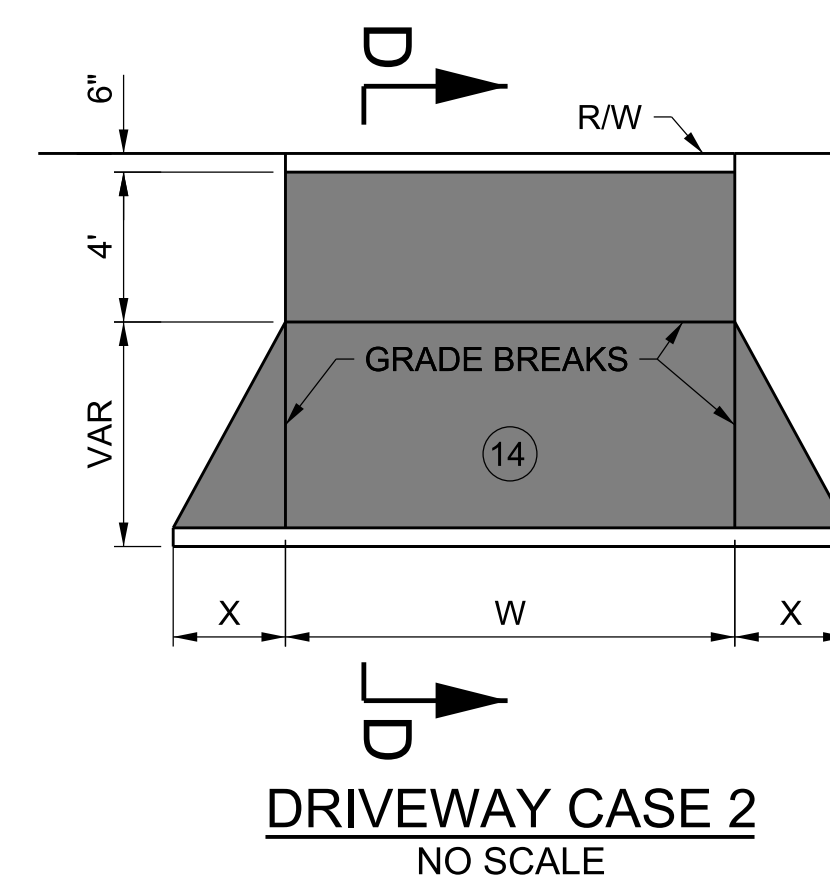


DRIVEWAY CASE 2  
NO SCALE

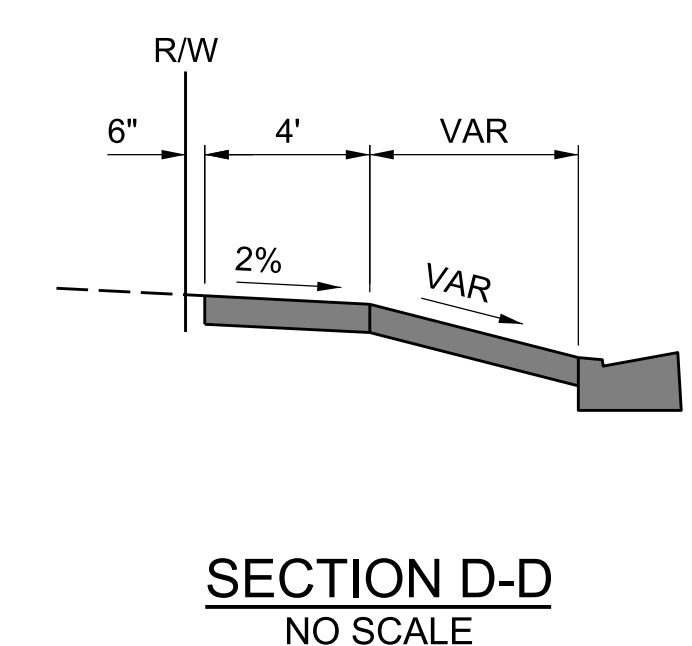

SECTION D-D  
NO SCALE

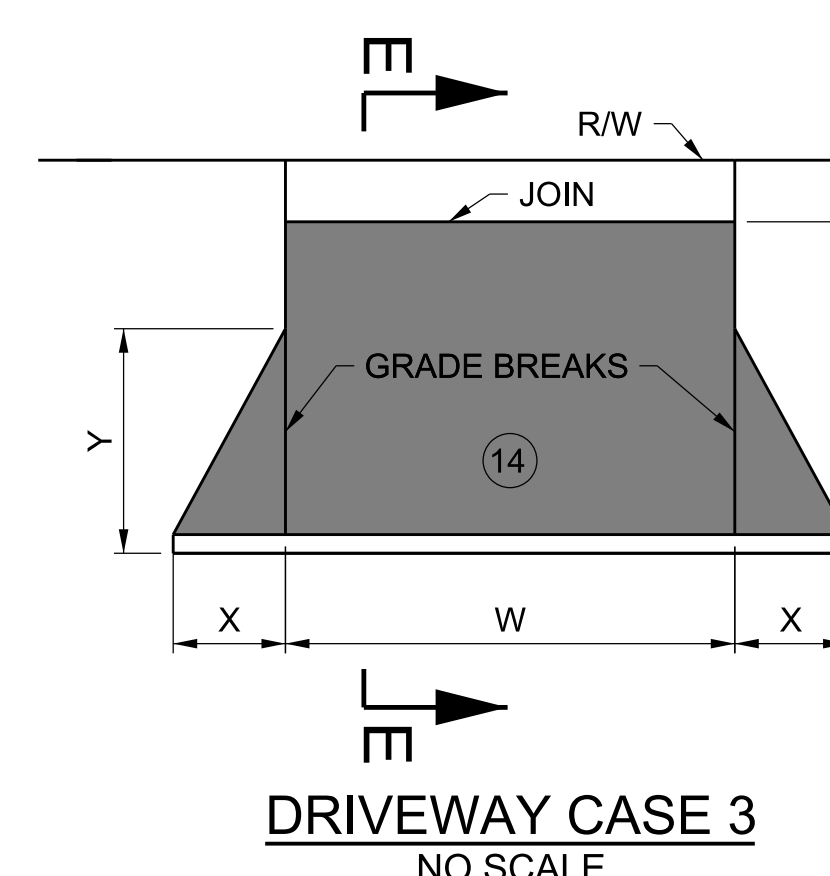

DRIVEWAY CASE 3  
NO SCALE

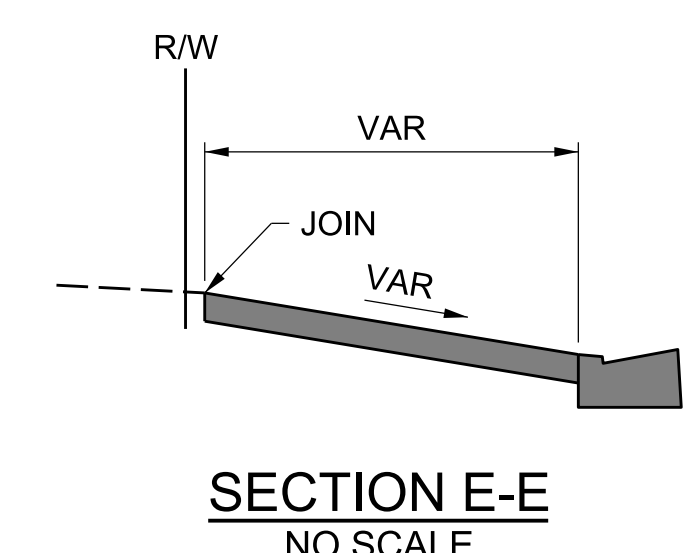

SECTION E-E  
NO SCALE

CADD PROJECT FILE NAME: RMD4408001-PLAN-RD.DGN  
 CHECKER: B. FUNG  
 DESIGNER: J. GARCIA  
 DRAFTER: J. GARCIA

10/25/2021		AS-BUILT		LOS ANGELES COUNTY PUBLIC WORKS	
DATE	MARK	DESCRIPTION		SOUTH WHITTIER LOS NIETOS KEITH DRIVE, ET AL.	
REVISIONS				PARKWAY IMPROVEMENT TABLES AND DETAILS	
DATE	MARK	DESCRIPTION		PROJECT ENGINEER	DATE: 6/24/19