


BENCH MARK NO. 11 PWLB 3711 0001  
 SPK IN N SIDE PP (NO#) 1FT UP 19FT S/O C/L PINE CYN  
 RD & 1.3MI SE/O THREE POINTS RD @ WIRE FENCE  
 ELEV.=3719.240  
 LA CO DPW BENCH MARK LIST  
 LANCASTER WEST 1998 OUAD  
 NAVD '88 DATUM

SEE SHEET 5  
 MATCHLINE STA 646+00


MATCHLINE STA 669+00  
 SEE BELOW LEFT

SEE ABOVE RIGHT  
 MATCHLINE STA 699+00

MATCHLINE STA 692+00  
 SEE SHEET 7

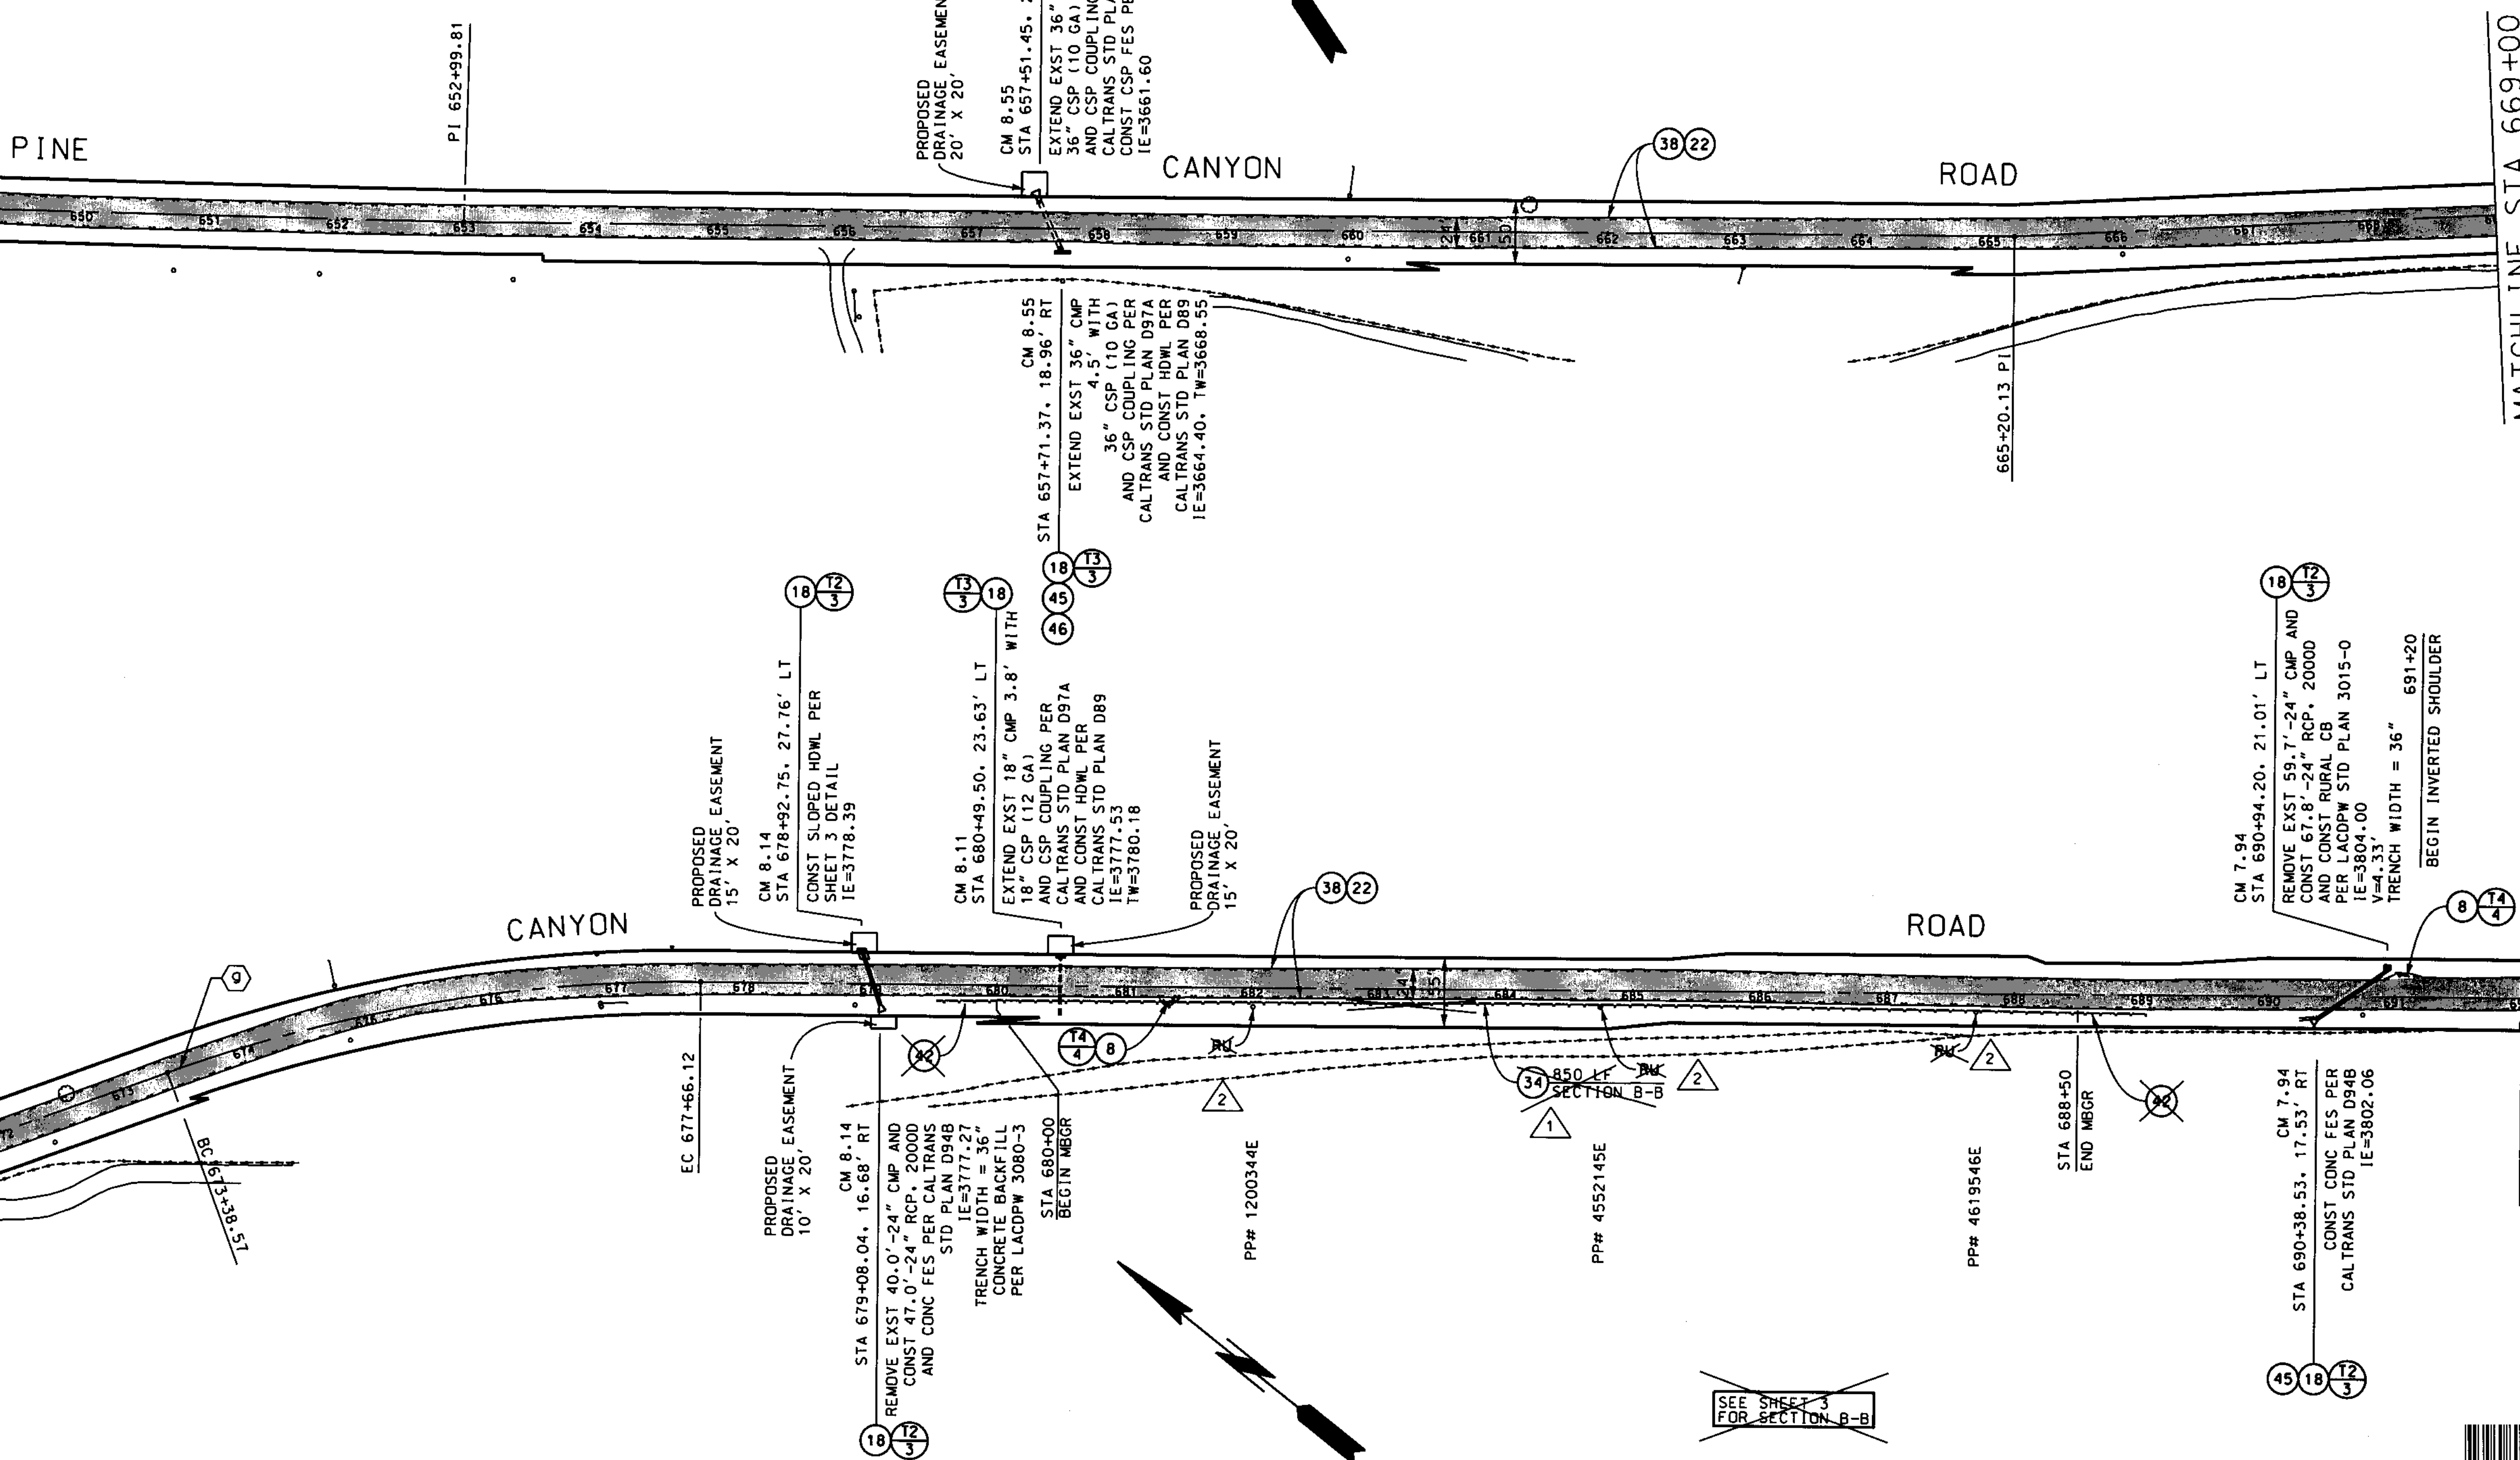

CURVE	CENTRAL ANGLE	RADIUS	LENGTH	TANGENT	PWFB PAGES
(f)	17°00'30"	1000.00'	296.85'	149.53'	3711-26
(g)	20°24'50"	1200.00'	427.55'	216.06'	3711-23

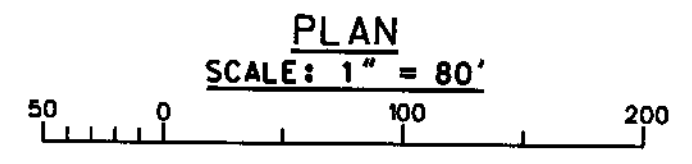

DESIGNER MO	CHECKER MC	REVIEWED BY	DATE
PROJECT FILE NAME RDC0014131.CGN			

DATE	MK	DESCRIPTION
9/2/14	1	DELETE GUARDRAILS PER T&A'S TRAFFIC ENGINEERING REPORT DATED 5-14-14
	2	DELETE RU

REGISTERED PROFESSIONAL ENGINEER  
 REGAN D. FANEY  
 C 69742  
 CIVIL  
 STATE OF CALIFORNIA

Regan D. Faney  
 PROJECT ENGINEER

COUNTY OF LOS ANGELES DEPARTMENT OF PUBLIC WORKS

PINE CANYON RD., ET AL.  
 STA 646+00 TO STA 692+00  
 PLAN  
 PROJECT ID NO. RDC0014131

PCA DWG SHEET 6 OF 16

