

SEE SHEET 7
MATCHLINE STA 741+00

SEE ABOVE RIGHT
MATCHLINE STA 764+00


MATCHLINE STA 764+00
SEE BELOW LEFT

MATCHLINE STA 787+00
SEE SHEET 9


BENCH MARK NO. 24 PwLB 3711 0003
L&N IN NW COR OF ELY MOST (GTE) CONC PAD 31FT
S/O C/L PINE CYN RD & 3.14MI SE/O THREE POINTS RD
11FT E/O PP (NO#) 130FT W/O ROAD TO #21001
ELEV.=4048.574

BENCH MARK NO. 25 PwLB 3711 0003
SPK IN N SIDE PP (NO#) 1FT UP 31FT S/O C/L PINE CYN
RD & 3.25MI SE/O THREE POINTS RD 300FT W/O DIRT
RD TO (S)
ELEV.=4033.760

LA CO DPW BENCH MARK LIST
LANCASTER WEST 1998 OUD
NAVD '88 DATUM

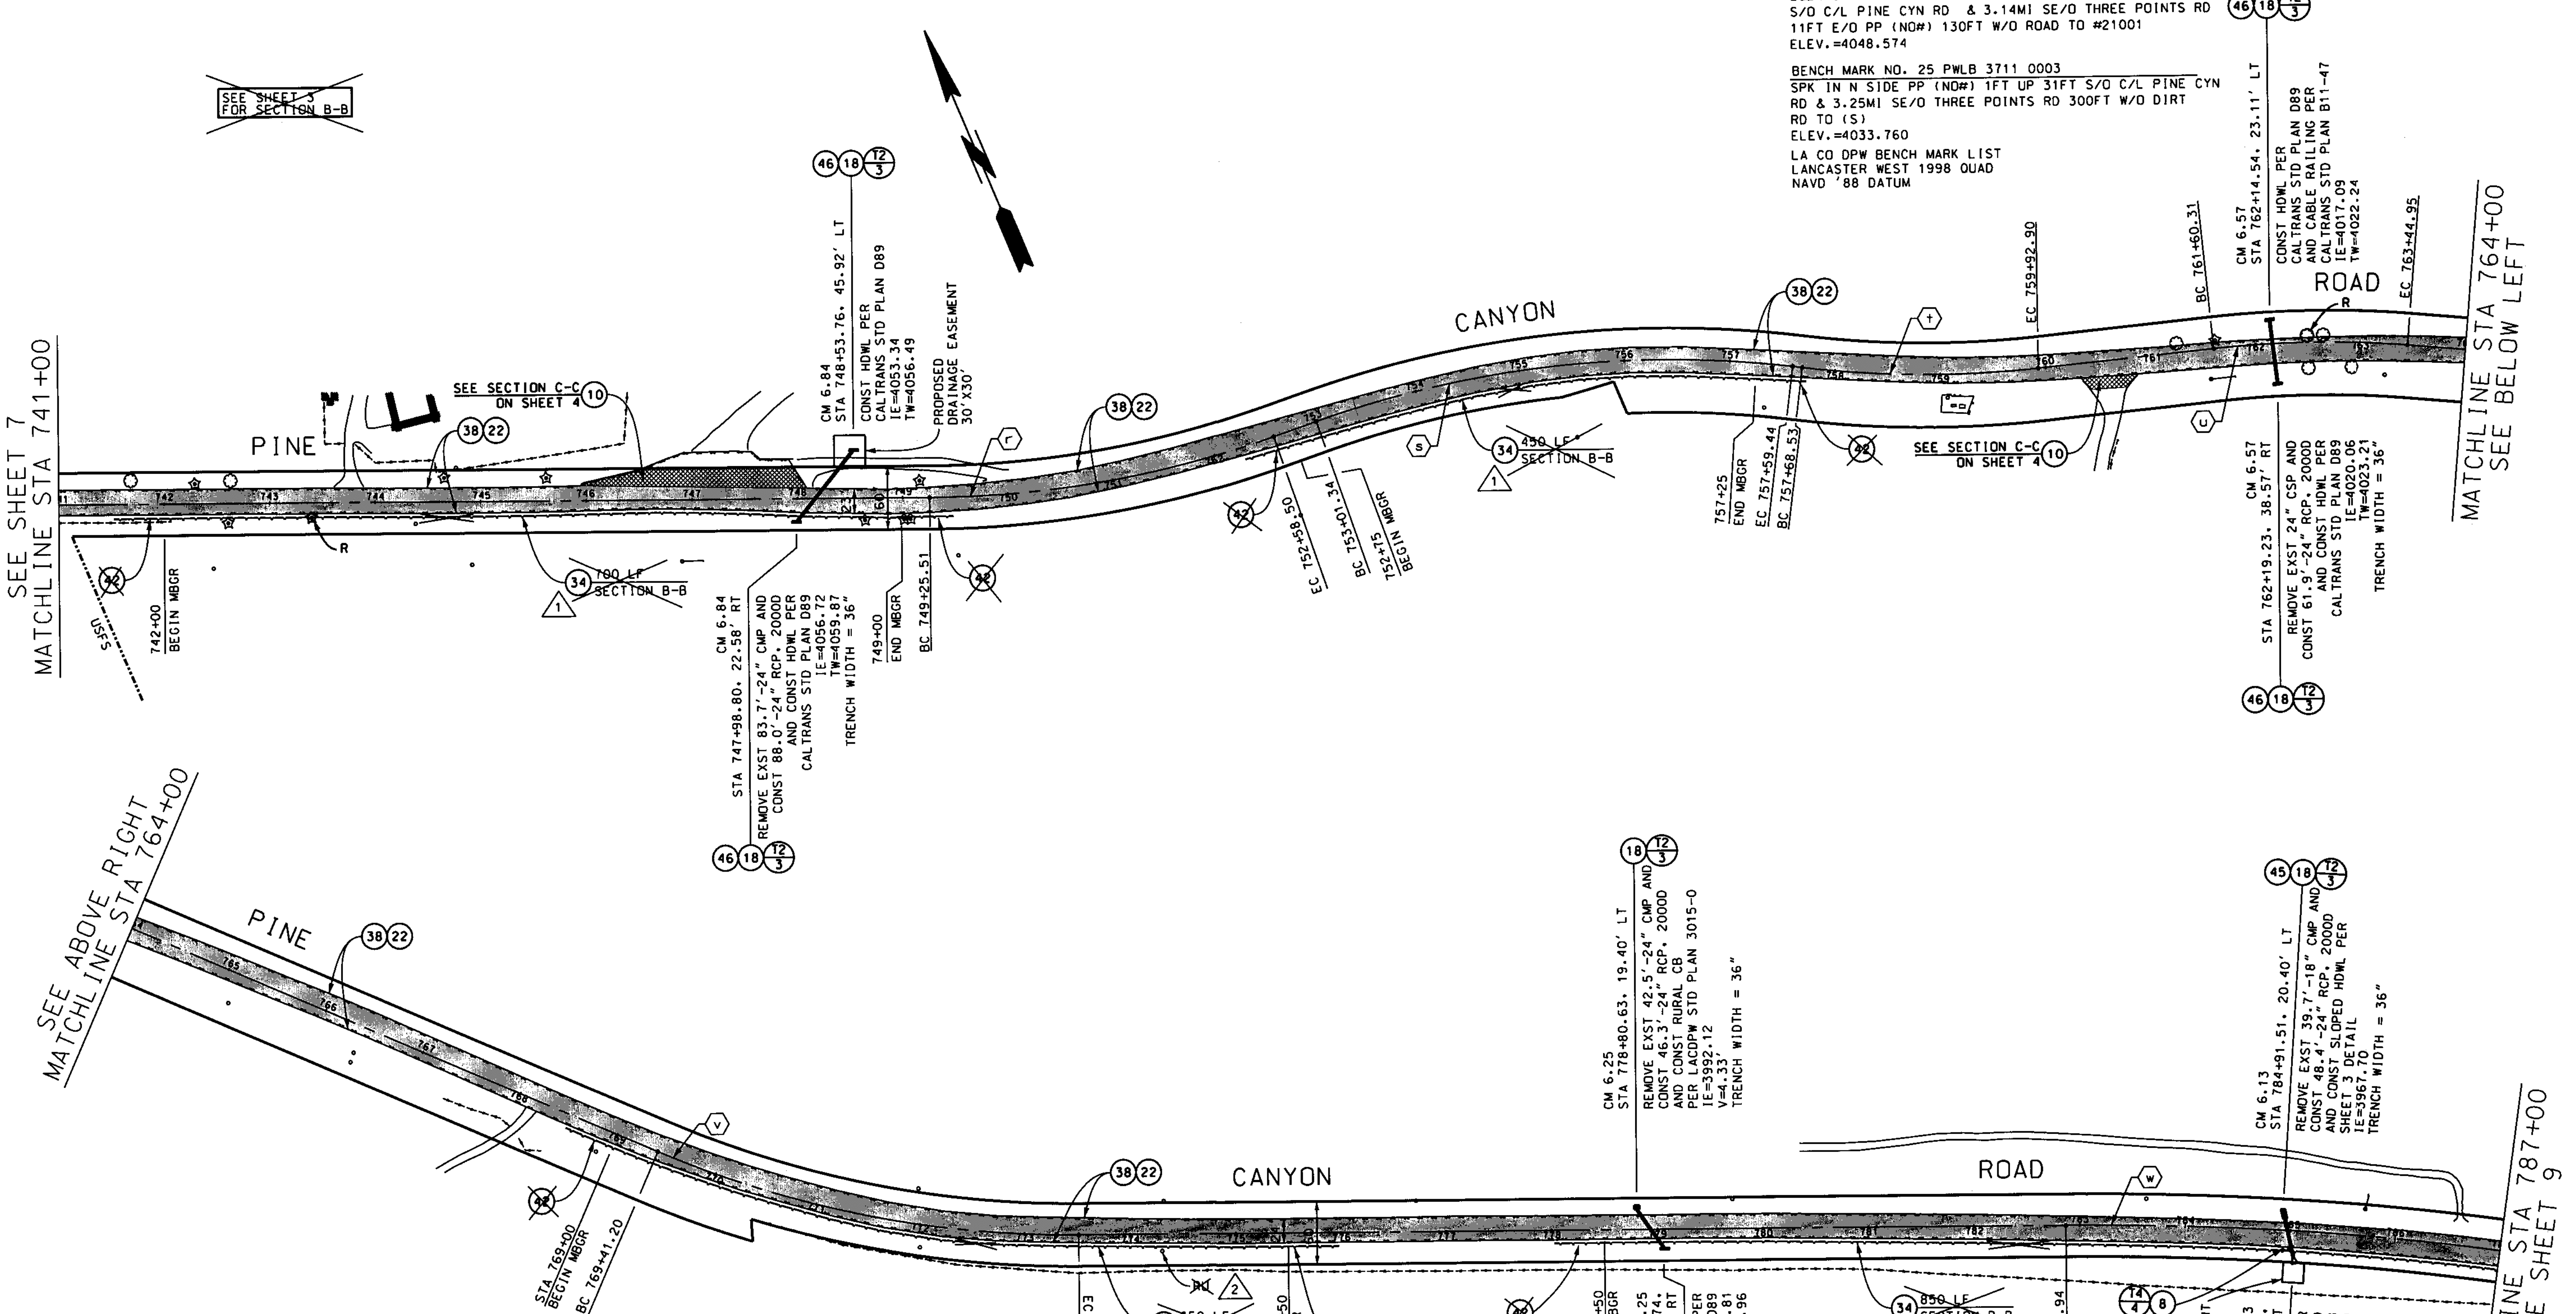

SURVEY CL CURVE DATA					
CURVE	CENTRAL ANGLE	RADIUS	LENGTH	TANGENT	PWFB PAGES
(r)	19° 04' 45"	1000.00'	332.99'	168.05'	3711-05
(s)	26° 14' 50"	1000.00'	458.10'	233.14'	3711-04
(t)	12° 51' 20"	1000.00'	224.37'	112.66'	3711-03
(u)	10° 34' 45"	1000.00'	184.64'	92.58'	3711-02
(v)	23° 29' 55"	1000.00'	410.13'	207.99'	3712-08
(w)	11° 22' 00"	3000.00'	595.16'	298.56'	3712-04,05,06

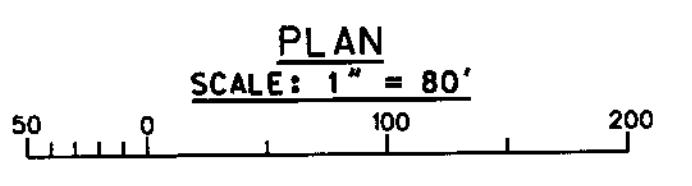

DATE	REVIEWED	BY
CAD PROJECT FILE NAME		
RDC0014131-C9M		
CHECKER	MO	
DESIGNER	MO	
DRAFTER	KF	

DATE	MR	DESCRIPTION
9/2/14	2	DELETE RU
	1	DELETE GUARDRAILS PER T&L'S TRAFFIC ENGINEERING REPORT DATED 5-14-14

PH083756

Megan D. Faney
PROJECT ENGINEER

COUNTY OF LOS ANGELES DEPARTMENT OF PUBLIC WORKS

PINE CANYON RD, ET AL.
STA 741+00 TO STA 787+00
PLAN
PROJECT ID NO. RDC0014131

PCA DWG SHEET 8 OF 16