SCALE: HOR. 1"= 40'
VERT. 1"= 8'

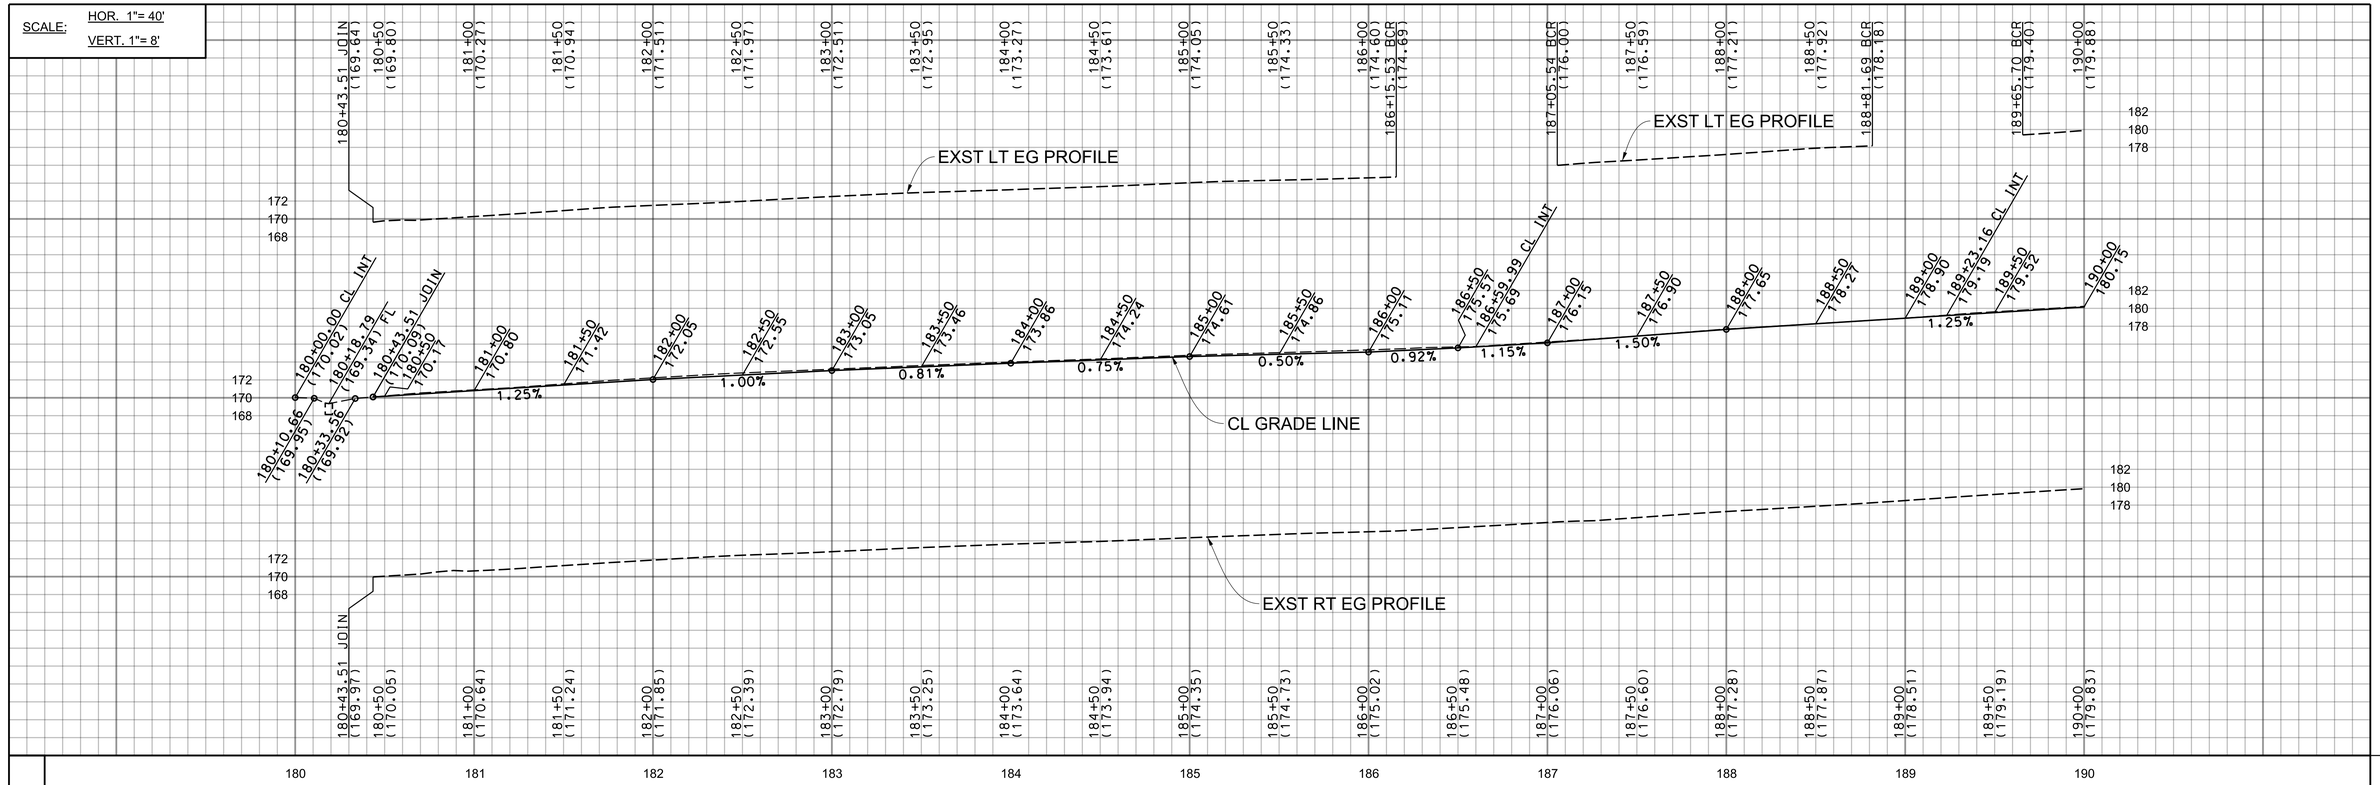

SEE SHEET 69 FOR PARKWAY IMPROVEMENTS

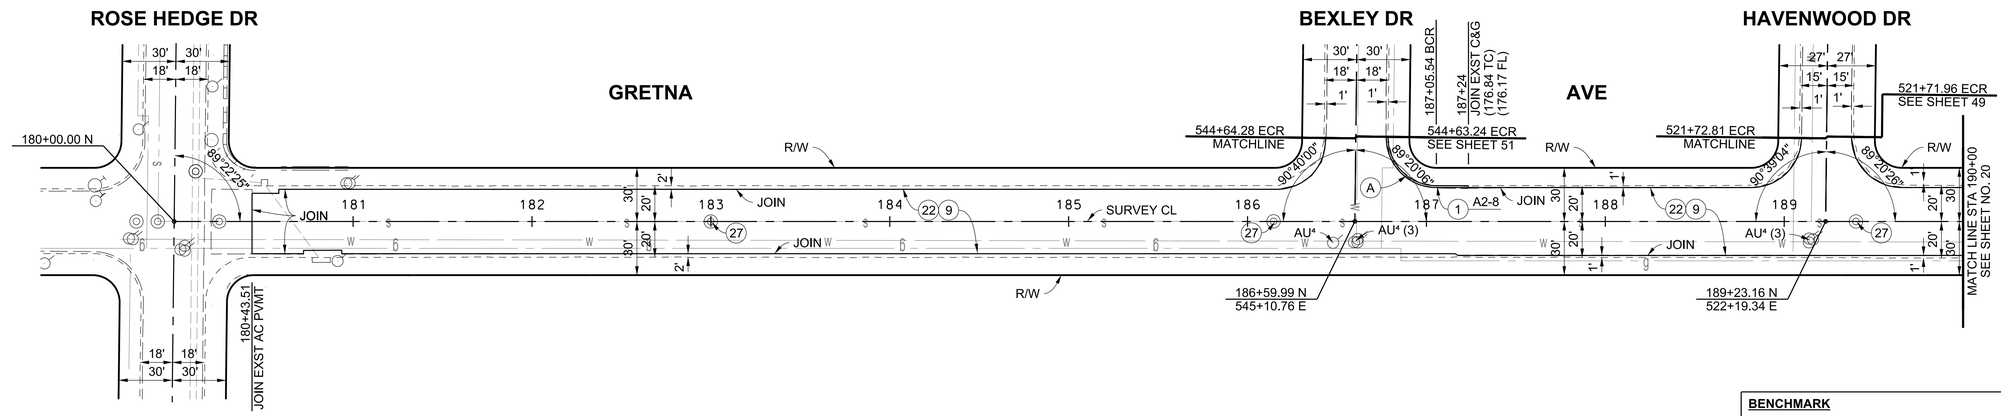

PLAN
SCALE: 1" = 40'
20 0 40 80

CURVE DATA

CURVE	RADIUS	CENTRAL ANGLE	LENGTH	TANGENT
Ⓐ	27.00'	90° 39' 54"	42.72'	27.32'

ELEVATIONS

CURVE	BCR	Δ/2	ECR
Ⓐ	176.69 TC 176.02 FL	176.51 TC 175.84 FL	176.32 TC 175.65 FL

BENCHMARK

PT 500, ELEV 170.02 (WHITTIER & BASELINE QUAD 2005), PWFB 1027, PG 979
CL INT ROSE HEDGE DR & GRETNA AVE FD SPK&W, R4, DN 3"

DATE	MARK	DESCRIPTION
10/25/2021	■	AS-BUILT

REVISIONS

REGISTERED PROFESSIONAL ENGINEER BRIAN FUNG C 76772 CIVIL STATE OF CALIFORNIA

PROJECT ENGINEER 6/24/19 DATE

LOS ANGELES COUNTY PUBLIC WORKS

SOUTH WHITTIER LOS NIETOS
KEITH DRIVE, ET AL.

PROJECT ID NO. RMD4408001
PLAN AND PROFILE

PD PH086538 | SHEET 19 OF 79

DRAFTER J. GARCIA
DESIGNER J. GARCIA
CHECKER B. FUNG
CADD PROJECT FILE NAME RMD4408001-PLAN-RD.DGN

PLAN RD

DATE: $DATE$ TIME: $TIME$ FILE: $FILEL$